

GENERAL NOTES

1. THIS IS A REPORT OF LOCATING MARKS (IRON ROD AND CAP, NAIL AND DISK OR X-CUT) OF SUBSURFACE UTILITIES WITHIN THE PROJECT LIMITS DEFINED BY THE FLORIDA DEPARTMENT OF TRANSPORTATION (FDOT) TO BE USED FOR THE DESIGN IMPROVEMENTS ALONG SR 29 FROM SOUTH OF NEW MARKET ROAD TO SR 82.

2. ELEVATIONS ARE RELATIVE TO THE NORTH AMERICAN VERTICAL DATUM OF 1988 (NAVD 88).

3. STATION AND OFFSETS SHOWN IN THE SUMMARY OF VERIFIED UTILITIES TABLE ARE RELATIVE TO THE "BL\_29" BASELINE IN ALIGNMENT FILE ALGNRD01.DGN.

4. ALL MEASUREMENTS SHOWN HEREON ARE IN US SURVEY FEET WITH THE EXCEPTION OF UTILITY SIZE WHICH IS SHOWN IN INCHES.

5. THE LAST DATE OF FIELD WORK WAS COMPLETED ON OCTOBER 31, 2024.

6. SUBSURFACE UTILITIES WERE VISUALLY VERIFIED AT SPECIFIC LOCATIONS USING NON-INVASIVE VACUUM EXCAVATION TECHNIQUES. AN IRON ROD AND CAP, NAIL AND DISK OR X-CUT WERE SET AT THE GROUND SURFACE ABOVE THE HORIZONTAL LOCATION OF THE UTILITY. ONCE THE UTILITY WAS EXPOSED THE DEPTH FROM THE SET POINT AT THE GROUND SURFACE TO THE TOP OF THE UTILITY WAS RECORDED. THE HORIZONTAL AND VERTICAL POSITION OF THE SET POINT WAS THEN RECORDED. THE RECORDED DEPTH OF THE SUBSURFACE UTILITY WAS SUBTRACTED FROM THE ELEVATION TO DETERMINE THE ELEVATION OF THE TOP OF THE SUBSURFACE UTILITY.

7. UTILITY SIZE AND MATERIAL WERE RECORDED IN THE FIELD AND ARE BASED OFF THE FIELD TECHNICIANS' OBSERVATIONS. THE RECORDED INFORMATION WAS REVIEWED AND CHECKED AGAINST PICTURES TAKEN WHILE THE UTILITY WAS EXPOSED. THIS INFORMATION MAY DIFFER FROM EXISTING RECORDS AND/OR AS-BUILTS.

8. UTILITY OWNERSHIP IS BASED ON OBSERVATIONS OF ABOVEGROUND UTILITY APPURTENANCES AND MAY NOT REFLECT THE CURRENT OWNER.


9. EXISTING GROUND ELEVATIONS AND DEPTH BELOW GRADE MEASUREMENTS ARE CERTIFIED AS OF THE LAST DATE OF FIELD WORK AS NOTED ABOVE.

10. SEE SHEETS UTV-2 THRU UTV-8 FOR SUMMARY OF VERIFIED UTILITIES INFORMATION.

LEGEND OF ABBREVIATIONS

DBC	DIRECT BURIED CABLE	PE	POLYETHYLENE PIPE
F.A.C.	FLORIDA ADMINISTRATIVE CODE	PVC	POLYVINYL CHLORIDE
FOC	FIBER OPTIC CABLE	RT	RIGHT
HDPE	HIGH DENSITY POLYETHYLENE PIPE	SR	STATE ROAD
INC.	INCORPORATED	STL	STEEL
LT	LEFT	UNK	UNKNOWN
N/A	NOT APPLICABLE	US	UNITED STATES
NO.	NUMBER	Vvh	VERIFIED VERTICAL ELEVATION AND HORIZONTAL LOCATION
P.E.	PROFESSIONAL ENGINEER		

CERTIFICATION

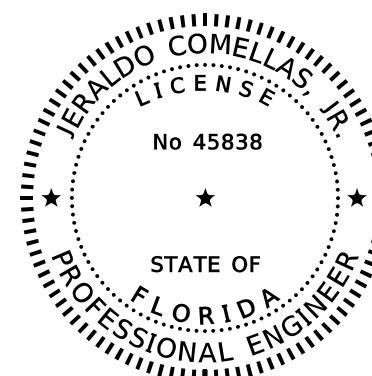

THIS ITEM HAS BEEN DIGITALLY SIGNED AND SEALED BY:

ON THE DATE ADJACENT TO THE SEAL

ECHO UES, INC.  
4803 GEORGE ROAD, SUITE 350  
TAMPA, FLORIDA 33634  
CERTIFICATE OF AUTHORIZATION 8184  
JERALDO COMELLAS, JR., P.E. 45838

PRINTED COPIES OF THIS DOCUMENT ARE NOT CONSIDERED SIGNED AND SEALED  
AND THE SIGNATURE MUST BE VERIFIED ON ANY ELECTRONIC COPIES.

THE ABOVE NAMED PROFESSIONAL ENGINEER SHALL BE RESPONSIBLE FOR THE FOLLOWING SHEETS IN ACCORDANCE WITH RULE 61G15-23.004, F.A.C.

SHEET NO.	SHEET DESCRIPTION	SHEET NO.
UTV-1 THRU UTV-8	VERIFIED UTILITY LOCATE	UTV-1
VERIFIED UTILITY LOCATE		
VERIFIED UTILITY LOCATE		

REVISIONS		DATE	DESCRIPTION
DATE	DESCRIPTION	DATE	DESCRIPTION

JERALDO COMELLAS, JR., P.E. 45838  
ECHO UES, INC.  
4803 GEORGE ROAD SUITE 350  
TAMPA, FLORIDA 33634

STATE OF FLORIDA  
DEPARTMENT OF TRANSPORTATION  
ROAD NO. COUNTY FINANCIAL PROJECT ID  
SR 29 COLLIER 417540-6-52-01

## SUMMARY OF VERIFIED UTILITIES

V vh #	UTILITY DESCRIPTION (Owner, type)	SIZE	MATERIALS	I" and/or C"			EXISTING GROUND ELEVATION	TOP ELEVATION	COMMENTS
				STATION	OFFSET	LT/RT			
1-1	CENTURYLINK, BURIED TELEPHONE	1"	DBC	2234+06.27	32.46'	LT	37.30'	35.26'	
1-2	CENTURYLINK, BURIED TELEPHONE	(2) 0.5"	DBC	2234+06.50	35.77'	LT	37.14'	34.84'	
1-3	CENTURYLINK, BURIED TELEPHONE	0.5"	DBC	2234+06.53	37.20'	LT	37.09'	33.84'	
1-4	CENTURYLINK, BURIED TELEPHONE	0.5"	DBC	2234+07.31	43.51'	LT	36.94'	33.94'	
1-5	CENTURYLINK, BURIED TELEPHONE	1"	DBC	2233+94.99	29.25'	RT	37.39'	34.17'	
1-6	CENTURYLINK, BURIED TELEPHONE	0.5"	DBC	2233+94.73	34.69'	RT	36.70'	31.60'	
1-7	SUMMIT, BURIED FOC/TELEPHONE	2"	PVC	2083+11.27	95.02'	RT	34.25'	31.75'	
1-8	CITY OF IMMOKALEE, WATER MAIN	2" TO 3"	PVC	2083+11.04	94.11'	RT	34.26'	32.16'	2" PVC WM GOES INTO 3" PVC CASING
1-9	CITY OF IMMOKALEE, WATER MAIN	8"	PVC	2083+10.46	89.99'	RT	34.23'	29.15'	POSSIBLE 8" PVC; UNABLE TO VISUALLY VERIFY DUE TO WATER AND CAVE-IN.
1-10	CENTURYLINK, BURIED FOC/TELEPHONE	2"	PVC	2202+46.18	42.94'	LT	40.76'	37.76'	
1-11	CENTURYLINK, BURIED TELEPHONE	1"	DBC	2202+47.78	66.70'	LT	40.80'	38.70'	
1-12	CENTURYLINK, BURIED TELEPHONE	0.5"	DBC	2202+53.71	34.69'	RT	40.50'	36.40'	
1-13	CENTURYLINK, BURIED TELEPHONE	(3) 0.5"	DBC	2202+47.84	76.95'	LT	40.96'	38.71'	
1-14	CENTURYLINK, BURIED TELEPHONE	1"	DBC	2202+59.95	29.37'	RT	40.59'	38.44'	
1-15	CALUMET, GAS MAIN	6"	STL	2202+56.66	89.99'	RT	40.55'	38.59'	
1-16	LEE COUNTY, STREET LIGHT	2"	PVC	2084+18.04	39.65'	LT	36.35'	33.65'	
1-17	CENTURYLINK, BURIED TELEPHONE	1"	DBC	2084+18.11	40.52'	LT	36.31'	32.01'	
1-18	CENTURYLINK, BURIED TELEPHONE	0.5"	DBC	2084+21.44	49.03'	LT	35.68'	33.58'	
1-19	CENTURYLINK, BURIED TELEPHONE	0.5"	DBC	2084+17.00	66.14'	LT	32.70'	30.70'	
1-20	CITY OF IMMOKALEE, WATER MAIN	10"	HDPE	2084+18.31	86.13'	LT	33.40'	30.64'	
1-21	CENTURYLINK, BURIED FOC/TELEPHONE	4" & 1.25"	PVC & DBC	2084+18.76	92.57'	LT	34.40'	31.60'	
1-22	COMCAST, BURIED CABLE TV	2"	PE	2088+22.65	96.58'	RT	32.99'	31.89'	
1-23	CENTURYLINK, BURIED TELEPHONE	1"	DBC	2154+75.51	79.26'	LT	35.70'	33.40'	
1-24	CENTURYLINK, BURIED TELEPHONE	0.5"	DBC	2154+72.40	57.68'	LT	36.09'	33.89'	
1-25	CENTURYLINK, BURIED TELEPHONE	0.5"	DBC	2154+75.16	69.35'	LT	35.91'	32.69'	
1-26	CALUMET, GAS MAIN	6"	STL	2154+64.28	89.27'	RT	33.07'	29.79'	
1-27	CENTURYLINK, BURIED TELEPHONE	0.5"	DBC	2154+67.92	33.80'	RT	35.47'	31.37'	
1-28	CENTURYLINK, BURIED TELEPHONE	1"	DBC	2154+68.28	29.76'	RT	35.94'	32.74'	
1-29	CENTURYLINK, BURIED FOC/TELEPHONE	1.25"	DBC	2154+75.32	94.15'	LT	35.57'	32.95'	
1-30	CENTURYLINK, BURIED TELEPHONE	1"	DBC	2129+27.35	78.64'	LT	34.21'	31.51'	
LP-1	CENTURYLINK, BURIED TELEPHONE	0.5"	DBC	2086+17.24	47.70'	LT	34.58'	32.37'	
LP-1A	EXPLORATORY - CLEARED TO 8'	N/A	N/A	2086+17.15	44.41'	LT	N/A	N/A	
LP-2	EXPLORATORY - CLEARED TO 8'	N/A	N/A	2087+53.12	46.25'	RT	N/A	N/A	
LP-2A	EXPLORATORY - CLEARED TO 8'	N/A	N/A	2087+53.12	43.49'	RT	N/A	N/A	
LP-3	EXPLORATORY - CLEARED TO 8'	N/A	N/A	2089+15.64	49.42'	LT	N/A	N/A	
LP-3A	CENTURYLINK, BURIED TELEPHONE	0.5"	DBC	2089+15.36	52.92'	LT	33.85'	31.20'	
LP-4	EXPLORATORY - CLEARED TO 8'	N/A	N/A	2090+81.78	45.84'	RT	N/A	N/A	
LP-4A	EXPLORATORY - CLEARED TO 8'	N/A	N/A	2090+81.62	48.77'	RT	N/A	N/A	
LP-5	TECO, GAS MAIN	8"	STL	2092+44.33	54.50'	LT	34.38'	25.62'	POSSIBLE 8" STL; UNABLE TO VISUALLY VERIFY DUE TO WATER, DEPTH AND CAVE-IN.
LP-5A	EXPLORATORY - CLEARED TO 8'	N/A	N/A	2092+44.19	60.49'	LT	N/A	N/A	
LP-6	EXPLORATORY - CLEARED TO 8'	N/A	N/A	2094+50.34	70.03'	RT	N/A	N/A	
LP-6A	EXPLORATORY - CLEARED TO 8'	N/A	N/A	2094+50.03	67.16'	RT	N/A	N/A	
LP-7	EXPLORATORY - CLEARED TO 8'	N/A	N/A	2094+52.18	67.06'	LT	N/A	N/A	
LP-7A	EXPLORATORY - CLEARED TO 8'	N/A	N/A	2094+52.06	70.37'	LT	N/A	N/A	
LP-7B	SUMMIT, BURIED FOC	(3) 1.5"	PE	2094+52.44	68.80'	LT	34.68'	28.68'	POSSIBLE 3-1.5" PE; UNABLE TO VISUALLY VERIFY DUE TO WATER, DEPTH AND CAVE-IN.
LP-8	EXPLORATORY - CLEARED TO 8'	N/A	N/A	2096+54.92	64.03'	RT	N/A	N/A	
LP-8A	EXPLORATORY - CLEARED TO 8'	N/A	N/A	2096+55.44	60.56'	RT	N/A	N/A	
LP-9	SUMMIT, BURIED FOC	(3) 1.5"	PE	2096+55.59	62.52'	LT	34.42'	29.56'	
LP-9A	EXPLORATORY - CLEARED TO 8'	N/A	N/A	2096+55.71	58.37'	LT	N/A	N/A	
LP-10	EXPLORATORY - CLEARED TO 7'	N/A	N/A	2098+73.23	85.50'	RT	N/A	N/A	UNABLE TO CLEAR TO 8' DUE TO HARD PAN.
LP-10A	EXPLORATORY - CLEARED TO 7'	N/A	N/A	2098+74.07	83.28'	RT	N/A	N/A	UNABLE TO CLEAR TO 8' DUE TO HARD PAN.
LP-11	EXPLORATORY - CLEARED TO 8'	N/A	N/A	2098+76.96	47.54'	LT	N/A	N/A	
LP-11A	EXPLORATORY - CLEARED TO 8'	N/A	N/A	2098+76.95	50.46'	LT	N/A	N/A	
LP-12	EXPLORATORY - CLEARED TO 8'	N/A	N/A	2099+71.38	136.57'	RT	N/A	N/A	
LP-12A	EXPLORATORY - CLEARED TO 8'	N/A	N/A	2099+73.94	136.58'	RT	N/A	N/A	
LP-13	EXPLORATORY - CLEARED TO 8'	N/A	N/A	2099+99.23	60.36'	LT	N/A	N/A	
LP-13A	EXPLORATORY - CLEARED TO 8'	N/A	N/A	2099+98.55	63.65'	LT	N/A	N/A	
LP-14	EXPLORATORY - CLEARED TO 8'	N/A	N/A	2101+47.44	130.42'	RT	N/A	N/A	
LP-14A	EXPLORATORY - CLEARED TO 8'	N/A	N/A	2101+45.72	128.03'	RT	N/A	N/A	
LP-15	EXPLORATORY - CLEARED TO 8'	N/A	N/A	2101+30.05	62.35'	LT	N/A	N/A	
LP-15A	EXPLORATORY - CLEARED TO 8'	N/A	N/A	2101+29.85	59.36'	LT	N/A	N/A	
LP-16	EXPLORATORY - CLEARED TO 8'	N/A	N/A	2102+88.87	75.98'	RT	N/A	N/A	
LP-16A	EXPLORATORY - CLEARED TO 8'	N/A	N/A	2102+87.99	74.26'	RT	N/A	N/A	
LP-17	EXPLORATORY - CLEARED TO 8'	N/A	N/A	2102+60.15	29.54'	LT	N/A	N/A	
LP-17A	EXPLORATORY - CLEARED TO 8'	N/A	N/A	2102+60.45	32.53'	LT	N/A	N/A	

THE OFFICIAL RECORD OF THIS SHEET IS THE ELECTRONIC FILE DIGITALLY SIGNED AND SEALED UNDER RULE 61G15-23.04, F.A.C.

REVISIONS	DATE	DESCRIPTION	DATE	DESCRIPTION	STATE OF FLORIDA DEPARTMENT OF TRANSPORTATION			SHEET NO. UTV-2	
DATE	ROAD NO. COUNTY FINANCIAL PROJECT ID								
					SR 29	COLLIER	417540-6-52-01		

## SUMMARY OF VERIFIED UTILITIES

V vh #	UTILITY DESCRIPTION (Owner, type)	SIZE	MATERIALS	P and/or C			EXISTING GROUND ELEVATION	TOP ELEVATION	COMMENTS
				STATION	OFFSET	LT/RT			
LP-18	EXPLORATORY - CLEARED TO 6'	N/A	N/A	2105+25.84	72.38'	RT	N/A	N/A	UNABLE TO CLEAR TO 8' DUE TO HARD PAN.
LP-18A	EXPLORATORY - CLEARED TO 6'	N/A	N/A	2105+25.35	70.79'	RT	N/A	N/A	UNABLE TO CLEAR TO 8' DUE TO HARD PAN.
LP-19	EXPLORATORY - CLEARED TO 8'	N/A	N/A	2105+29.13	64.14'	LT	N/A	N/A	
LP-19A	EXPLORATORY - CLEARED TO 8'	N/A	N/A	2105+28.74	68.00'	LT	N/A	N/A	
LP-19B	CENTURYLINK, BURIED TELEPHONE	0.5"	DBC	2105+29.17	65.95'	LT	33.63'	30.48'	
LP-20	EXPLORATORY - CLEARED TO 8'	N/A	N/A	2101+00.48	317.73'	LT	N/A	N/A	
LP-20A	EXPLORATORY - CLEARED TO 8'	N/A	N/A	2101+03.54	317.87'	LT	N/A	N/A	
LP-21	EXPLORATORY - CLEARED TO 8'	N/A	N/A	2100+88.75	171.72'	LT	N/A	N/A	
LP-21A	EXPLORATORY - CLEARED TO 8'	N/A	N/A	2100+91.68	171.93'	LT	N/A	N/A	
LP-22	EXPLORATORY - CLEARED TO 8'	N/A	N/A	2100+39.65	295.37'	RT	N/A	N/A	
LP-22A	EXPLORATORY - CLEARED TO 8'	N/A	N/A	2100+41.26	297.47'	RT	N/A	N/A	
LP-23	EXPLORATORY - CLEARED TO 8'	N/A	N/A	2098+68.23	338.02'	RT	N/A	N/A	
LP-23A	EXPLORATORY - CLEARED TO 8'	N/A	N/A	2098+69.70	339.70'	RT	N/A	N/A	
LP-98	EXPLORATORY - CLEARED TO 8'	N/A	N/A	2234+55.03	70.14'	RT	N/A	N/A	
LP-98A	EXPLORATORY - CLEARED TO 8'	N/A	N/A	2234+55.60	72.64'	RT	N/A	N/A	
LP-99	EXPLORATORY - CLEARED TO 8'	N/A	N/A	2235+74.81	67.13'	LT	N/A	N/A	
LP-99A	EXPLORATORY - CLEARED TO 8'	N/A	N/A	2235+74.78	70.49'	LT	N/A	N/A	
LP-100	EXPLORATORY - CLEARED TO 8'	N/A	N/A	2236+92.68	70.56'	RT	N/A	N/A	
LP-100A	EXPLORATORY - CLEARED TO 8'	N/A	N/A	2236+94.07	73.23'	RT	N/A	N/A	
LP-111	EXPLORATORY - CLEARED TO 8'	N/A	N/A	2238+14.75	68.90'	LT	N/A	N/A	
LP-111A	EXPLORATORY - CLEARED TO 8'	N/A	N/A	2238+14.72	72.08'	LT	N/A	N/A	
LP-113	EXPLORATORY - CLEARED TO 8'	N/A	N/A	2240+54.75	74.36'	LT	N/A	N/A	
LP-113A	EXPLORATORY - CLEARED TO 8'	N/A	N/A	2240+54.72	71.35'	LT	N/A	N/A	
LP-114	EXPLORATORY - CLEARED TO 8'	N/A	N/A	2239+35.06	73.09'	RT	N/A	N/A	
LP-114A	EXPLORATORY - CLEARED TO 8'	N/A	N/A	2239+35.14	71.79'	RT	N/A	N/A	
LP-115	EXPLORATORY - CLEARED TO 8'	N/A	N/A	2242+94.12	73.70'	LT	N/A	N/A	
LP-115A	EXPLORATORY - CLEARED TO 8'	N/A	N/A	2242+94.05	76.59'	LT	N/A	N/A	
LP-116	EXPLORATORY - CLEARED TO 8'	N/A	N/A	2241+75.58	71.00'	RT	N/A	N/A	
LP-116A	EXPLORATORY - CLEARED TO 8'	N/A	N/A	2241+74.83	73.93'	RT	N/A	N/A	
LP-117	EXPLORATORY - CLEARED TO 7.15'	N/A	N/A	2245+34.22	75.62'	LT	N/A	N/A	UNABLE TO CLEAR TO 8' DUE TO HARD PAN.
LP-117A	EXPLORATORY - CLEARED TO 7.45'	N/A	N/A	2245+33.49	77.98'	LT	N/A	N/A	UNABLE TO CLEAR TO 8' DUE TO HARD PAN.
LP-118	EXPLORATORY - CLEARED TO 8'	N/A	N/A	2244+13.97	73.45'	RT	N/A	N/A	
LP-118A	EXPLORATORY - CLEARED TO 8'	N/A	N/A	2244+13.83	76.47'	RT	N/A	N/A	
LP-119	EXPLORATORY - CLEARED TO 7'	N/A	N/A	2247+74.39	77.36'	LT	N/A	N/A	UNABLE TO CLEAR TO 8' DUE TO HARD PAN.
LP-119A	EXPLORATORY - CLEARED TO 8'	N/A	N/A	2247+74.25	74.53'	LT	N/A	N/A	
LP-120	EXPLORATORY - CLEARED TO 8'	N/A	N/A	2246+55.06	74.90'	RT	N/A	N/A	
LP-120A	EXPLORATORY - CLEARED TO 8'	N/A	N/A	2246+55.10	72.95'	RT	N/A	N/A	
LP-121	EXPLORATORY - CLEARED TO 8'	N/A	N/A	2250+13.80	75.69'	LT	N/A	N/A	
LP-121A	EXPLORATORY - CLEARED TO 5'	N/A	N/A	2250+14.14	78.71'	LT	N/A	N/A	UNABLE TO CLEAR TO 8' DUE TO HARD PAN.
LP-122	EXPLORATORY - CLEARED TO 8'	N/A	N/A	2248+94.83	72.77'	RT	N/A	N/A	
LP-122A	EXPLORATORY - CLEARED TO 8'	N/A	N/A	2248+95.31	75.77'	RT	N/A	N/A	
LP-123	EXPLORATORY - CLEARED TO 8'	N/A	N/A	2252+57.31	75.23'	LT	N/A	N/A	
LP-123A	EXPLORATORY - CLEARED TO 8'	N/A	N/A	2252+57.17	78.59'	LT	N/A	N/A	
LP-124	EXPLORATORY - CLEARED TO 5'	N/A	N/A	2251+37.26	74.54'	RT	N/A	N/A	UNABLE TO CLEAR TO 8' DUE TO HARD PAN.
LP-124A	EXPLORATORY - CLEARED TO 5'	N/A	N/A	2251+37.27	72.41'	RT	N/A	N/A	UNABLE TO CLEAR TO 8' DUE TO HARD PAN.
LP-125	EXPLORATORY - CLEARED TO 8'	N/A	N/A	2254+93.92	75.75'	LT	N/A	N/A	
LP-125A	EXPLORATORY - CLEARED TO 8'	N/A	N/A	2254+94.38	77.83'	LT	N/A	N/A	
LP-126	EXPLORATORY - CLEARED TO 8'	N/A	N/A	2253+75.08	73.47'	RT	N/A	N/A	
LP-126A	EXPLORATORY - CLEARED TO 8'	N/A	N/A	2253+75.37	76.36'	RT	N/A	N/A	
LP-127	EXPLORATORY - CLEARED TO 8'	N/A	N/A	2257+32.37	71.38'	LT	N/A	N/A	
LP-127A	EXPLORATORY - CLEARED TO 8'	N/A	N/A	2257+33.01	73.56'	LT	N/A	N/A	
LP-127B	EXPLORATORY - CLEARED TO 8'	N/A	N/A	2257+32.88	72.66'	LT	N/A	N/A	
LP-128	EXPLORATORY - CLEARED TO 8'	N/A	N/A	2256+14.77	72.94'	RT	N/A	N/A	
LP-128A	EXPLORATORY - CLEARED TO 8'	N/A	N/A	2256+14.90	75.90'	RT	N/A	N/A	
1-1A	COMCAST, BURIED CABLE TV	2"	PE	2086+90.90	61.96'	LT	33.15'	26.79'	POSSIBLE 2" PE; UNABLE TO VISUALLY VERIFY DUE WATER, DEPTH AND CAVE-IN.
1-2A	IMMOKALEE WATER, WATER MAIN	12"	HDPE	2088+36.83	84.02'	LT	32.70'	29.30'	
1-3A	SUMMIT, BURIED FOC	(3) 1.5"	PE	2088+35.63	65.73'	LT	34.10'	27.60'	POSSIBLE 3-1.5" PE; UNABLE TO VISUALLY VERIFY DUE WATER, DEPTH AND CAVE-IN.
1-4A	CENTURYLINK, BURIED FOC/TELEPHONE	1.25"	DBC	2088+37.47	94.78'	LT	33.35'	31.05'	
1-5A	SUMMIT, BURIED FOC	(3) 1.5"	PE	2088+69.62	68.18'	LT	33.72'	26.46'	POSSIBLE 3-1.5" PE; UNABLE TO VISUALLY VERIFY DUE WATER, DEPTH AND CAVE-IN.
1-6A	IMMOKALEE WATER, WATER MAIN	12"	HDPE	2088+69.14	83.70'	LT	32.89'	29.99'	
1-7A	CENTURYLINK, BURIED FOC/TELEPHONE	1.25"	DBC	2088+70.17	94.69'	LT	33.05'	30.80'	
1-8A	EXPLORATORY - CLEARED TO 8'	N/A	N/A	2094+00.00	59.70'	RT	N/A	N/A	UNABLE TO CLEAR TO 10' DUE TO HARD PAN.
1-8B	EXPLORATORY - CLEARED TO 8.45'	N/A	N/A	2093+99.63	60.96'	RT	N/A	N/A	UNABLE TO CLEAR TO 10' DUE TO HARD PAN.
1-8C	EXPLORATORY - CLEARED TO 8.22'	N/A	N/A	2094+00.36	66.71'	RT	N/A	N/A	UNABLE TO CLEAR TO 10' DUE TO HARD PAN.
1-8D	EXPLORATORY - CLEARED TO 8'	N/A	N/A	2094+00.73	69.51'	RT	N/A	N/A	

THE OFFICIAL RECORD OF THIS SHEET IS THE ELECTRONIC FILE DIGITALLY SIGNED AND SEALED UNDER RULE 61G15-23.04, F.A.C.

REVISIONS				STATE OF FLORIDA DEPARTMENT OF TRANSPORTATION			SHEET NO.
DATE	DESCRIPTION	DATE	DESCRIPTION	ROAD NO.	COUNTY	FINANCIAL PROJECT ID	
				SR 29	COLLIER	417540-6-52-01	
							UTV-3

## SUMMARY OF VERIFIED UTILITIES

V <sub>vh</sub> #	UTILITY DESCRIPTION (Owner, type)	SIZE	MATERIALS	P and/or C			EXISTING GROUND ELEVATION	TOP ELEVATION	COMMENTS
				STATION	OFFSET	LT/RT			
1-9A	IMMOKALEE WATER, WATER MAIN	12"	HDPE	2094+15.08	85.51'	LT	33.25'	29.83'	
1-10A	CENTURYLINK, BURIED FOC/TELEPHONE	1.25"	DBC	2094+14.86	95.35'	LT	33.48'	31.00'	
1-11A	IMMOKALEE WATER, WATER MAIN	12"	HDPE	2094+53.96	85.51'	LT	34.18'	31.79'	
1-12A	CENTURYLINK, BURIED FOC/TELEPHONE	1.25"	DBC	2094+54.43	93.75'	LT	32.99'	30.89'	
1-13A	IMMOKALEE WATER, WATER MAIN	12"	HDPE	2095+23.14	46.37'	LT	35.28'	29.02'	POSSIBLE 12" HDPE; UNABLE TO VISUALLY VERIFY DUE TO WATER, DEPTH AND CAVE-IN.
1-14A	IMMOKALEE WATER, WATER MAIN	12"	HDPE	2095+23.90	49.88'	RT	34.06'	28.96'	POSSIBLE 12" HDPE; UNABLE TO VISUALLY VERIFY DUE TO WATER, DEPTH AND CAVE-IN.
1-15A	CENTURYLINK, BURIED FOC/TELEPHONE	1.25"	DBC	2097+05.75	93.97'	LT	33.29'	30.29'	POSSIBLE 1.25" DBC; UNABLE TO VISUALLY VERIFY DUE TO WATER, DEPTH AND CAVE-IN.
1-16A	CENTURYLINK, BURIED TELEPHONE	1"	DBC	2097+10.68	80.14'	LT	33.97'	33.27'	
1-17A	SUMMIT, BURIED FOC	(3) 1.5"	PE	2097+09.61	65.52'	LT	34.51'	28.48'	POSSIBLE 3-1.5" PE; UNABLE TO VISUALLY VERIFY DUE TO WATER, DEPTH AND CAVE-IN.
1-18A	CENTURYLINK, BURIED TELEPHONE	0.5"	DBC	2097+10.35	75.18'	LT	34.17'	31.07'	
1-19A	IMMOKALEE SEWER, SANITARY SEWER	8"	PVC	2097+10.45	70.92'	LT	34.06'	25.77'	POSSIBLE 8" PVC; UNABLE TO VISUALLY VERIFY DUE TO WATER, DEPTH AND CAVE-IN.
1-20A	CENTURYLINK, BURIED FOC/TELEPHONE	1.25"	DBC	2099+05.73	94.18'	LT	32.92'	30.34'	
1-21A	CENTURYLINK, BURIED TELEPHONE	(2) 0.5" & 1"	DBC	2099+03.13	80.36'	LT	33.75'	31.19'	
1-22A	CENTURYLINK, BURIED TELEPHONE	0.5"	DBC	2099+03.15	76.73'	LT	33.87'	29.23'	
1-23A	SUMMIT, BURIED FOC	(3) 1.5"	PE	2099+07.02	67.07'	LT	34.46'	31.54'	
1-24A	IMMOKALEE SEWER, SANITARY SEWER	8"	PVC	2099+06.12	72.29'	LT	34.19'	26.39'	POSSIBLE 8" PVC; UNABLE TO VISUALLY VERIFY DUE TO WATER, DEPTH AND CAVE-IN.
1-25A	TECO, GAS MAIN	8"	STL	2099+07.44	56.11'	LT	35.03'	26.43'	POSSIBLE 8" STL; UNABLE TO VISUALLY VERIFY DUE TO WATER, DEPTH AND CAVE-IN.
1-26A	CENTURYLINK, BURIED TELEPHONE	0.5"	DBC	2099+07.76	38.50'	LT	36.12'	30.38'	
1-27A	CENTURYLINK, BURIED TELEPHONE	1"	DBC	2099+07.60	43.78'	LT	35.69'	31.59'	
1-28A	CENTURYLINK, BURIED TELEPHONE	0.5"	DBC	2099+97.67	72.60'	LT	34.20'	28.86'	POSSIBLE 0.5" DBC; UNABLE TO VISUALLY VERIFY DUE TO WATER, DEPTH AND CAVE-IN.
1-29A	CENTURYLINK, BURIED TELEPHONE	0.5"	DBC	2100+28.83	38.44'	LT	36.75'	29.97'	POSSIBLE 0.5" DBC; UNABLE TO VISUALLY VERIFY DUE TO WATER, DEPTH AND CAVE-IN.
1-30A	EXPLORATORY - CLEARED TO 10'	N/A	N/A	2100+84.48	72.75'	LT	N/A	N/A	
1-31	CENTURYLINK, BURIED TELEPHONE	1" & 0.5"	DBC	2100+84.32	80.57'	LT	35.48'	30.72'	POSSIBLE 1" & 0.5" DBC; UNABLE TO VISUALLY VERIFY DUE TO WATER, DEPTH AND CAVE-IN.
1-31A	CENTURYLINK, BURIED TELEPHONE	0.5"	DBC	2100+84.31	79.82'	LT	35.55'	28.21'	POSSIBLE 0.5" DBC; UNABLE TO VISUALLY VERIFY DUE TO WATER, DEPTH AND CAVE-IN.
1-32	CENTURYLINK, BURIED TELEPHONE	0.5"	DBC	2101+13.01	77.53'	LT	33.24'	29.90'	POSSIBLE 0.5" DBC; UNABLE TO VISUALLY VERIFY DUE TO WATER, DEPTH AND CAVE-IN.
1-33	CENTURYLINK, BURIED FOC/TELEPHONE	1.25"	DBC	2101+09.06	92.05'	LT	32.92'	28.68'	POSSIBLE 1.25" DBC; UNABLE TO VISUALLY VERIFY DUE TO WATER, DEPTH AND CAVE-IN.
1-33A	IMMOKALEE WATER, WATER MAIN	UNK	UNK	2101+11.52	88.00'	LT	32.96'	29.70'	UNKNOWN SIZE AND MATERIAL; UNABLE TO VISUALLY VERIFY DUE TO WATER, DEPTH AND CAVE-IN.
1-34	CENTURYLINK, BURIED TELEPHONE	1" & 0.5"	DBC	2101+16.37	79.59'	LT	33.37'	30.52'	POSSIBLE 1" & 0.5" DBC; UNABLE TO VISUALLY VERIFY DUE TO WATER, DEPTH AND CAVE-IN.
1-35	LEE COUNTY, STREET LIGHT	2"	PVC	2101+10.35	49.25'	LT	35.76'	33.31'	
1-36	CENTURYLINK, BURIED TELEPHONE	1"	DBC	2101+17.90	43.13'	LT	36.27'	31.27'	
1-37	CENTURYLINK, BURIED TELEPHONE	(2) 0.5" & 1"	DBC	2101+50.30	79.57'	LT	33.07'	30.57'	
1-38	CENTURYLINK, BURIED TELEPHONE	0.5"	DBC	2101+49.25	74.16'	LT	33.37'	29.93'	POSSIBLE 0.5" DBC; UNABLE TO VISUALLY VERIFY DUE TO WATER, DEPTH AND CAVE-IN.
1-39	CENTURYLINK, BURIED FOC/TELEPHONE	1.25"	DBC	2102+01.69	91.37'	LT	32.92'	29.28'	POSSIBLE 1.25" DBC; UNABLE TO VISUALLY VERIFY DUE TO WATER, DEPTH AND CAVE-IN.
1-40	CENTURYLINK, BURIED TELEPHONE	1" & 0.5"	DBC	2102+04.04	79.03'	LT	33.01'	30.21'	POSSIBLE 1" & 0.5" DBC; UNABLE TO VISUALLY VERIFY DUE TO WATER, DEPTH AND CAVE-IN.
1-41	CENTURYLINK, BURIED TELEPHONE	0.5"	DBC	2102+04.55	72.34'	LT	33.50'	29.96'	POSSIBLE 0.5" DBC; UNABLE TO VISUALLY VERIFY DUE TO WATER, DEPTH AND CAVE-IN.
1-42	SUMMIT, BURIED FOC	(3) 1.5"	PE	2102+04.21	69.35'	LT	33.74'	26.41'	POSSIBLE 3-1.5" PE; UNABLE TO VISUALLY VERIFY DUE TO WATER, DEPTH AND CAVE-IN.
1-43	IMMOKALEE SEWER, SANITARY SEWER	8"	PVC	2102+02.97	65.30'	LT	33.99'	27.21'	POSSIBLE 8" PVC; UNABLE TO VISUALLY VERIFY DUE TO WATER, DEPTH AND CAVE-IN.
1-44	TECO, GAS MAIN	8"	STL	2102+06.81	57.49'	LT	34.57'	26.83'	POSSIBLE 8" STL; UNABLE TO VISUALLY VERIFY DUE TO WATER, DEPTH AND CAVE-IN.
1-45	CENTURYLINK, BURIED TELEPHONE	1"	DBC	2102+04.57	41.70'	LT	36.24'	31.58'	POSSIBLE 1" DBC; UNABLE TO VISUALLY VERIFY DUE TO WATER, DEPTH AND CAVE-IN.
1-46	CENTURYLINK, BURIED TELEPHONE	0.5"	DBC	2102+02.17	38.39'	LT	36.33'	29.87'	POSSIBLE 0.5" DBC; UNABLE TO VISUALLY VERIFY DUE TO WATER, DEPTH AND CAVE-IN.
1-47	CENTURYLINK, BURIED TELEPHONE	1"	DBC	2103+37.34	42.22'	LT	35.88'	30.46'	
1-48	CENTURYLINK, BURIED TELEPHONE	0.5"	DBC	2103+36.65	39.08'	LT	36.04'	30.79'	POSSIBLE 0.5" DBC; UNABLE TO VISUALLY VERIFY DUE TO WATER, DEPTH AND CAVE-IN.
1-49	CENTURYLINK, BURIED TELEPHONE	0.5"	DBC	2103+80.50	39.06'	LT	36.12'	32.27'	POSSIBLE 0.5" DBC; UNABLE TO VISUALLY VERIFY DUE TO WATER, DEPTH AND CAVE-IN.
1-50	CENTURYLINK, BURIED FOC/TELEPHONE	1.25"	DBC	2104+01.76	92.68'	LT	32.90'	28.48'	POSSIBLE 1.25" DBC; UNABLE TO VISUALLY VERIFY DUE TO WATER, DEPTH AND CAVE-IN.
1-51	CENTURYLINK, BURIED TELEPHONE	1" & 0.5"	DBC	2104+01.18	79.87'	LT	33.36'	30.91'	POSSIBLE 1" & 0.5" DBC; UNABLE TO VISUALLY VERIFY DUE TO WATER, DEPTH AND CAVE-IN.
1-52	CENTURYLINK, BURIED TELEPHONE	0.5"	DBC	2104+01.01	73.68'	LT	33.90'	29.92'	POSSIBLE 0.5" DBC; UNABLE TO VISUALLY VERIFY DUE TO WATER, DEPTH AND CAVE-IN.
1-53	SUMMIT, BURIED FOC	(3) 1.5"	PE	2104+00.99	66.69'	LT	34.25'	26.29'	POSSIBLE 3-1.5" PE; UNABLE TO VISUALLY VERIFY DUE TO WATER, DEPTH AND CAVE-IN.
1-54	IMMOKALEE SEWER, SANITARY SEWER	8"	PVC	2103+99.86	63.70'	LT	34.32'	28.10'	POSSIBLE 8" PVC; UNABLE TO VISUALLY VERIFY DUE TO WATER, DEPTH AND CAVE-IN.
1-55	TECO, GAS MAIN	8"	STL	2104+00.20	56.48'	LT	34.56'	30.56'	POSSIBLE 8" STL; UNABLE TO VISUALLY VERIFY DUE TO WATER, DEPTH AND CAVE-IN.
1-56	CENTURYLINK, BURIED TELEPHONE	1"	DBC	2103+99.13	41.89'	LT	35.38'	31.58'	POSSIBLE 1" DBC; UNABLE TO VISUALLY VERIFY DUE TO WATER, DEPTH AND CAVE-IN.
1-57	CENTURYLINK, BURIED TELEPHONE	0.5"	DBC	2103+99.46	39.08'	LT	35.68'	30.40'	POSSIBLE 0.5" DBC; UNABLE TO VISUALLY VERIFY DUE TO WATER, DEPTH AND CAVE-IN.
1-58	TECO, GAS MAIN	8"	STL	2104+79.49	54.83'	LT	33.97'	28.13'	POSSIBLE 8" STL; UNABLE TO VISUALLY VERIFY DUE TO WATER, DEPTH AND CAVE-IN.
1-59	SUMMIT, BURIED FOC	(3) 1.5"	PE	2106+17.81	58.97'	LT	33.71'	25.69'	POSSIBLE 3-1.5" PE; UNABLE TO VISUALLY VERIFY DUE TO WATER, DEPTH AND CAVE-IN.
1-60	TECO, GAS MAIN	8"	STL	2105+98.03	53.69'	LT	33.96'	26.52'	POSSIBLE 8" STL; UNABLE TO VISUALLY VERIFY DUE TO WATER, DEPTH AND CAVE-IN.
1-61	TECO, GAS MAIN	8"	STL	2106+47.51	54.32'	LT	33.94'	26.48'	POSSIBLE 8" STL; UNABLE TO VISUALLY VERIFY DUE TO WATER, DEPTH AND CAVE-IN.
1-61A	SUMMIT, BURIED FOC	(3) 1.5"	PE	2106+49.67	60.88'	LT	33.65'	24.93'	POSSIBLE 3-1.5" PE; UNABLE TO VISUALLY VERIFY DUE TO WATER, DEPTH AND CAVE-IN.
1-61B	EXPLORATORY - CLEARED TO 8'	N/A	N/A	2106+47.73	65.10'	LT	N/A	N/A	UNABLE TO CLEAR TO 10' DUE TO HARD PAN.
1-61C	EXPLORATORY - CLEARED TO 10'	N/A	N/A	2106+48.04	57.87'	LT	N/A	N/A	
1-62	EXPLORATORY - CLEARED TO 10'	N/A	N/A	2106+99.11	40.63'	LT	N/A	N/A	
1-62A	CENTURYLINK, BURIED TELEPHONE	0.5"	DBC	2106+96.26	38.99'	LT	35.99'	29.36'	POSSIBLE 0.5" DBC; UNABLE TO VISUALLY VERIFY DUE TO WATER, DEPTH AND CAVE-IN.
1-63	CENTURYLINK, BURIED TELEPHONE	2"	STL CASING	2106+99.12	42.69'	LT	35.61'</td		

## SUMMARY OF VERIFIED UTILITIES

V <sub>vh</sub> #	UTILITY DESCRIPTION (Owner, type)	SIZE	MATERIALS	P and/or C			EXISTING GROUND ELEVATION	TOP ELEVATION	COMMENTS
				STATION	OFFSET	LT/RT			
1-66A	CENTURYLINK, BURIED TELEPHONE	0.5"	DBC	2108+53.72	56.96'	LT	33.78'	29.92'	POSSIBLE 0.5" DBC; UNABLE TO VISUALLY VERIFY DUE TO WATER, DEPTH AND CAVE-IN.
1-67	CENTURYLINK, BURIED TELEPHONE	0.5"	DBC	2108+52.47	68.77'	LT	33.41'	30.25'	POSSIBLE 0.5" DBC; UNABLE TO VISUALLY VERIFY DUE TO WATER, DEPTH AND CAVE-IN.
1-68	SUMMIT, BURIED FOC	(3) 1.5"	PE	2110+08.59	53.55'	LT	33.90'	24.78'	POSSIBLE 3-1.5" PE; UNABLE TO VISUALLY VERIFY DUE TO WATER, DEPTH AND CAVE-IN.
1-68A	CENTURYLINK, BURIED TELEPHONE	0.5"	DBC	2110+06.50	58.95'	LT	33.70'	26.52'	POSSIBLE 0.5" DBC; UNABLE TO VISUALLY VERIFY DUE TO WATER, DEPTH AND CAVE-IN.
1-69	CENTURYLINK, BURIED TELEPHONE	0.5"	DBC	2110+08.64	71.54'	LT	33.23'	30.53'	POSSIBLE 0.5" DBC; UNABLE TO VISUALLY VERIFY DUE TO WATER, DEPTH AND CAVE-IN.
1-70	CENTURYLINK, BURIED TELEPHONE	0.5"	DBC	2110+08.02	61.75'	LT	33.76'	30.46'	
1-71	CENTURYLINK, BURIED TELEPHONE	1" & 0.5"	DBC	2110+77.93	79.61'	LT	32.94'	30.92'	POSSIBLE 1" & 0.5" DBC; UNABLE TO VISUALLY VERIFY DUE TO WATER, DEPTH AND CAVE-IN.
1-72	CENTURYLINK, BURIED TELEPHONE	0.5"	DBC	2111+77.76	62.42'	LT	34.02'	30.52'	
1-73	CALUMET, GAS MAIN	6"	STL	2112+60.83	90.41'	RT	32.70'	29.90'	POSSIBLE 6" STL; UNABLE TO VISUALLY VERIFY DUE TO WATER, DEPTH AND CAVE-IN.
1-74	SUMMIT, BURIED FOC	(3) 1.5"	PE	2112+88.75	58.77'	LT	34.15'	30.19'	POSSIBLE 3-1.5" PE; UNABLE TO VISUALLY VERIFY DUE TO WATER, DEPTH AND CAVE-IN.
1-75	SUMMIT, BURIED FOC	(3) 1.5"	PE	2113+98.64	61.16'	LT	34.33'	31.45'	
1-76	CENTURYLINK, BURIED FOC/TELEPHONE	1.25"	DBC	2114+14.52	92.59'	LT	32.53'	28.71'	POSSIBLE 1.25" DBC; UNABLE TO VISUALLY VERIFY DUE TO WATER, DEPTH AND CAVE-IN.
1-77	CALUMET, GAS MAIN	6"	STL	2114+03.81	90.56'	RT	34.80'	30.02'	POSSIBLE 6" STL; UNABLE TO VISUALLY VERIFY DUE TO WATER, DEPTH AND CAVE-IN.
1-78	CALUMET, GAS MAIN	6"	STL	2114+21.90	89.85'	RT	32.94'	30.36'	
1-79	CENTURYLINK, BURIED FOC/TELEPHONE	1.25"	DBC	2114+59.56	92.47'	LT	32.50'	29.90'	POSSIBLE 1.25" DBC; UNABLE TO VISUALLY VERIFY DUE TO WATER, DEPTH AND CAVE-IN.
1-80	CENTURYLINK, BURIED FOC/TELEPHONE	1.25"	DBC	2114+90.24	92.14'	LT	32.50'	29.14'	POSSIBLE 1.25" DBC; UNABLE TO VISUALLY VERIFY DUE TO WATER, DEPTH AND CAVE-IN.
1-81	CENTURYLINK, BURIED TELEPHONE	1" & 0.5"	DBC	2114+86.96	79.36'	LT	33.59'	31.79'	POSSIBLE 1" & 0.5" DBC; UNABLE TO VISUALLY VERIFY DUE TO WATER, DEPTH AND CAVE-IN.
1-82	CENTURYLINK, BURIED TELEPHONE	0.5"	DBC	2114+87.33	75.81'	LT	33.85'	30.79'	POSSIBLE 0.5" DBC; UNABLE TO VISUALLY VERIFY DUE TO WATER, DEPTH AND CAVE-IN.
1-83	SUMMIT, BURIED FOC	(3) 1.5"	PE	2114+87.95	60.29'	LT	34.25'	29.50'	POSSIBLE 3-1.5" PE; UNABLE TO VISUALLY VERIFY DUE TO WATER, DEPTH AND CAVE-IN.
1-83A	CENTURYLINK, BURIED TELEPHONE	0.5"	DBC	2114+88.53	63.12'	LT	34.18'	31.16'	
1-84	CALUMET, GAS MAIN	6"	STL	2128+35.31	90.52'	RT	32.24'	30.92'	
1-85	CENTURYLINK, BURIED TELEPHONE	1"	DBC	2129+00.35	30.01'	RT	35.91'	32.95'	
1-86	CENTURYLINK, BURIED TELEPHONE	0.5"	DBC	2129+00.14	34.71'	RT	35.55'	31.67'	
1-87	CENTURYLINK, BURIED TELEPHONE	1"	DBC	2131+00.95	29.09'	RT	35.68'	32.94'	
1-88	CENTURYLINK, BURIED TELEPHONE	0.5"	DBC	2131+00.78	35.12'	RT	35.21'	31.25'	
1-89	CENTURYLINK, BURIED TELEPHONE	1"	DBC	2133+28.25	64.95'	LT	31.90'	27.74'	POSSIBLE 1" DBC; UNABLE TO VISUALLY VERIFY DUE TO WATER, DEPTH AND CAVE-IN.
1-90	CENTURYLINK, BURIED TELEPHONE	0.5"	DBC	2133+28.32	61.66'	LT	32.36'	26.42'	POSSIBLE 0.5" DBC; UNABLE TO VISUALLY VERIFY DUE TO WATER, DEPTH AND CAVE-IN.
1-91	EXPLORATORY - CLEARED TO 10'	N/A	N/A	2133+42.64	34.30'	LT	N/A	N/A	
1-92	TECO, GAS MAIN	8"	STL	2133+41.68	38.27'	LT	35.71'	25.87'	POSSIBLE 8" STL; UNABLE TO VISUALLY VERIFY DUE TO WATER, DEPTH AND CAVE-IN.
1-93	CENTURYLINK, BURIED TELEPHONE	1"	DBC	2132+92.46	17.31'	RT	37.24'	34.44'	
1-94	CENTURYLINK, BURIED TELEPHONE	0.5"	DBC	2132+92.50	36.12'	RT	36.47'	30.91'	
1-95	CENTURYLINK, BURIED TELEPHONE	1"	DBC	2135+00.08	28.99'	RT	35.98'	32.82'	
1-96	CENTURYLINK, BURIED TELEPHONE	0.5"	DBC	2134+99.86	34.60'	RT	35.29'	31.91'	
1-97	CALUMET, GAS MAIN	6"	STL	2135+94.29	90.59'	RT	32.41'	30.39'	
1-98	CALUMET, GAS MAIN	6"	STL	2139+63.95	91.52'	RT	32.90'	30.60'	
1-99	CALUMET, GAS MAIN	6"	STL	2140+13.63	91.12'	RT	33.12'	30.56'	
1-100	CENTURYLINK, BURIED FOC/TELEPHONE	1.25"	DBC	2170+82.84	94.68'	LT	34.45'	32.99'	
1-101	CENTURYLINK, BURIED FOC	1.5"	PE	2170+85.74	84.72'	LT	34.93'	32.85'	
1-101A	CENTURYLINK, BURIED TELEPHONE	1"	DBC	2170+84.25	85.84'	LT	34.62'	32.70'	
1-102	CENTURYLINK, BURIED FOC/TELEPHONE	1.25"	DBC	2171+22.28	95.52'	LT	34.30'	32.10'	
1-103	CENTURYLINK, BURIED TELEPHONE	0.5"	DBC	2173+01.69	60.47'	LT	34.60'	31.26'	POSSIBLE 0.5" DBC; UNABLE TO VISUALLY VERIFY DUE TO WATER, DEPTH AND CAVE-IN.
1-104	SUMMIT, BURIED FOC	(3) 1.5"	PE	2173+02.10	39.43'	LT	36.13'	27.41'	POSSIBLE 3-1.5" PE; UNABLE TO VISUALLY VERIFY DUE TO WATER, DEPTH AND CAVE-IN.
1-105	SUMMIT, BURIED FOC	(3) 1.5"	PE	2174+01.64	38.35'	LT	35.40'	29.48'	POSSIBLE 3-1.5" PE; UNABLE TO VISUALLY VERIFY DUE TO WATER, DEPTH AND CAVE-IN.
1-106	CENTURYLINK, BURIED TELEPHONE	0.5"	DBC	2173+91.94	59.75'	LT	33.56'	28.58'	POSSIBLE 0.5" DBC; UNABLE TO VISUALLY VERIFY DUE TO WATER, DEPTH AND CAVE-IN.
1-107	SUMMIT, BURIED FOC	(3) 1.5"	PE	2174+90.77	38.01'	LT	35.94'	26.68'	POSSIBLE 3-1.5" PE; UNABLE TO VISUALLY VERIFY DUE TO WATER, DEPTH AND CAVE-IN.
1-108	TECO, GAS MAIN	8"	STL	2174+91.33	30.59'	LT	36.41'	26.59'	POSSIBLE 8" STL; UNABLE TO VISUALLY VERIFY DUE TO WATER, DEPTH AND CAVE-IN.
1-109	CENTURYLINK, BURIED TELEPHONE	1"	DBC	2175+23.80	16.37'	RT	37.39'	34.81'	
1-110	CENTURYLINK, BURIED TELEPHONE	0.5"	DBC	2175+11.34	34.50'	RT	36.33'	32.13'	POSSIBLE 0.5" DBC; UNABLE TO VISUALLY VERIFY DUE TO WATER, DEPTH AND CAVE-IN.
1-111	CENTURYLINK, BURIED FOC/TELEPHONE	1.25"	DBC	2175+03.22	81.20'	LT	33.49'	30.39'	POSSIBLE 1.25" DBC; UNABLE TO VISUALLY VERIFY DUE TO WATER, DEPTH AND CAVE-IN.
1-112	CENTURYLINK, BURIED TELEPHONE	0.5"	DBC	2175+03.10	70.28'	LT	33.49'	30.89'	POSSIBLE 0.5" DBC; UNABLE TO VISUALLY VERIFY DUE TO WATER, DEPTH AND CAVE-IN.
1-113	CALUMET, GAS MAIN	6"	STL	2175+01.53	88.23'	RT	33.30'	29.24'	POSSIBLE 6" STL; UNABLE TO VISUALLY VERIFY DUE TO WATER, DEPTH AND CAVE-IN.
1-114	CENTURYLINK, BURIED FOC/TELEPHONE	1.25"	DBC	2178+03.36	85.87'	LT	34.49'	32.79'	
1-115	CENTURYLINK, BURIED FOC/TELEPHONE	1"	DBC	2178+06.83	82.96'	LT	35.54'	34.02'	
1-116	CENTURYLINK, BURIED TELEPHONE	0.5"	DBC	2178+06.82	99.47'	LT	34.97'	33.09'	
1-117	CENTURYLINK, BURIED FOC	0.5"	DBC	2178+48.87	87.92'	LT	35.68'	33.78'	
1-118	COLLIER COUNTY, BURIED ELECTRIC	2"	PVC	2178+51.37	88.43'	LT	35.33'	33.75'	
1-119	CENTURYLINK, BURIED FOC/TELEPHONE	1"	DBC	2178+51.45	81.48'	LT	35.54'	33.94'	
1-120	CENTURYLINK, BURIED FOC/TELEPHONE	1"	DBC	2178+56.76	98.42'	LT	34.18'	31.90'	
1-121	TECO, GAS MAIN	8"	STL	2179+98.89	28.85'	LT	36.05'	32.89'	
1-122	CENTURYLINK, BURIED TELEPHONE	1"	DBC	2179+99.51	29.20'	RT	36.29'	33.53'	
1-123	EXPLORATORY - CLEARED TO 10'	N/A	N/A	2179+98.76	36.57'	RT	N/A	N/A	
1-124	CENTURYLINK, BURIED TELEPHONE	1"	DBC	2180+02.04	68.57'	LT	35.14'	32.64'	
1-125	CALUMET, GAS MAIN	6"	STL	2180+01.35	89.15'	RT	34.35'	30.85'	POSSIBLE 6" STL; UNABLE TO VISUALLY VERIFY DUE TO WATER, DEPTH AND CAVE-IN.
1-126	CENTURYLINK, BURIED TELEPHONE	1"	DBC	2188+02.54	69.48'	LT	37.26'	34.86'	
1-127	CENTURYLINK, BURIED TELEPHONE	0.5"	DBC	2188+68.82	81.00				

## SUMMARY OF VERIFIED UTILITIES

V_h #	UTILITY DESCRIPTION (Owner, type)	SIZE	MATERIALS	P and/or Q			EXISTING GROUND ELEVATION	TOP ELEVATION	COMMENTS
				STATION	OFFSET	LT/RT			
1-128	EXPLORATORY - CLEARED TO 10'	N/A	N/A	2188+69.31	86.27'	LT	N/A	N/A	
1-129	CENTURYLINK, BURIED FOC/TELEPHONE	2"	PVC	2188+71.86	69.88'	LT	37.84'	34.62'	
1-130	CENTURYLINK, BURIED TELEPHONE	0.5" & 1"	DBC	2189+19.48	77.80'	LT	37.58'	35.70'	
1-131	EXPLORATORY - CLEARED TO 10'	N/A	N/A	2189+28.95	85.95'	LT	N/A	N/A	
1-132	CENTURYLINK, BURIED TELEPHONE	1"	DBC	2199+03.34	71.04'	LT	38.77'	36.93'	
1-133	EXPLORATORY - CLEARED TO 10'	N/A	N/A	2199+56.72	89.08'	LT	N/A	N/A	
1-134	EXPLORATORY - CLEARED TO 10'	N/A	N/A	2200+11.63	91.96'	LT	N/A	N/A	
1-135	CENTURYLINK, BURIED TELEPHONE	1"	DBC	2200+76.53	66.57'	LT	38.83'	37.43'	
1-136	CENTURYLINK, BURIED TELEPHONE	1"	DBC	2202+53.53	67.08'	LT	40.89'	38.81'	
1-137	CENTURYLINK, BURIED TELEPHONE	1"	DBC	2202+82.95	66.38'	LT	40.92'	38.62'	
1-137A	CENTURYLINK, BURIED TELEPHONE	0.5"	DBC	2202+81.43	67.48'	LT	40.96'	39.34'	
1-137B	CENTURYLINK, BURIED TELEPHONE	0.5"	DBC	2202+81.17	67.53'	LT	40.90'	39.32'	
1-138	CENTURYLINK, BURIED TELEPHONE	(2) 1"	DBC	2202+86.27	59.57'	LT	40.95'	38.39'	
1-139	CENTURYLINK, BURIED TELEPHONE	(2) 1"	DBC	2212+39.82	53.54'	LT	39.36'	35.42'	
1-140	CENTURYLINK, BURIED FOC/TELEPHONE	2"	PVC	2212+39.33	58.81'	LT	38.80'	33.18'	POSSIBLE 2" PVC; UNABLE TO VISUALLY VERIFY DUE TO WATER, DEPTH AND CAVE-IN.
1-141	CENTURYLINK, BURIED FOC/TELEPHONE	2"	PVC	2212+96.93	61.69'	LT	38.07'	35.03'	
1-142	CENTURYLINK, BURIED TELEPHONE	(2) 1"	DBC	2213+02.40	53.56'	LT	38.39'	35.75'	
1-143	SUMMIT, BURIED FOC	(3) 1.5"	PE	2215+17.78	46.34'	LT	37.69'	34.01'	POSSIBLE 3-1.5" PE; UNABLE TO VISUALLY VERIFY DUE TO WATER, DEPTH AND CAVE-IN.
1-144	CENTURYLINK, BURIED TELEPHONE	(2) 1"	DBC	2215+18.18	52.25'	LT	37.58'	35.27'	POSSIBLE 2-1" DBC; UNABLE TO VISUALLY VERIFY DUE TO WATER, DEPTH AND CAVE-IN.
1-145	SUMMIT, BURIED FOC	(3) 1.5"	PE	2216+99.18	39.29'	LT	37.51'	30.16'	POSSIBLE 3-1.5" PE; UNABLE TO VISUALLY VERIFY DUE TO WATER, DEPTH AND CAVE-IN.
1-146	CENTURYLINK, BURIED TELEPHONE	1"	DBC	2217+04.85	47.23'	LT	37.22'	35.48'	
1-147	SUMMIT, BURIED FOC	(3) 1.5"	PE	2218+05.19	27.16'	LT	39.49'	31.69'	POSSIBLE 3-1.5" PE; UNABLE TO VISUALLY VERIFY DUE TO WATER, DEPTH AND CAVE-IN.
1-148	CENTURYLINK, BURIED TELEPHONE	1"	DBC	2218+03.64	46.97'	LT	38.01'	36.01'	
1-149	EXPLORATORY - CLEARED TO 10'	N/A	N/A	2118+93.62	50.62'	LT	N/A	N/A	
1-150	SUMMIT, BURIED FOC	(3) 1.5"	PE	2118+93.56	47.59'	LT	33.50'	29.90'	
1-151	CENTURYLINK, BURIED TELEPHONE	1"	DBC	2219+41.91	41.04'	LT	37.69'	34.57'	
1-152	CENTURYLINK, BURIED TELEPHONE	(2) 1"	DBC	2219+42.21	42.55'	LT	37.63'	35.50'	POSSIBLE 2-1" DBC; UNABLE TO VISUALLY VERIFY DUE TO WATER, DEPTH AND CAVE-IN.
1-153	EXPLORATORY - CLEARED TO 10'	N/A	N/A	2219+41.90	40.39'	LT	N/A	N/A	
1-153A	CENTURYLINK, BURIED TELEPHONE	0.5"	DBC	2219+42.99	61.71'	LT	37.28'	34.32'	
1-154	SUMMIT, BURIED FOC	(3) 1.5"	PE	2219+44.51	30.86'	LT	38.88'	31.19'	POSSIBLE 3-1.5" PE; UNABLE TO VISUALLY VERIFY DUE TO WATER, DEPTH AND CAVE-IN.
1-155	SUMMIT, BURIED FOC	(3) 1.5"	PE	2219+82.17	29.53'	LT	38.96'	32.26'	POSSIBLE 3-1.5" PE; UNABLE TO VISUALLY VERIFY DUE TO WATER, DEPTH AND CAVE-IN.
1-156	CENTURYLINK, BURIED TELEPHONE	(2) 1"	DBC	2219+81.55	40.29'	LT	37.73'	35.37'	
1-157	EXPLORATORY - CLEARED TO 10'	N/A	N/A	2220+99.35	46.78'	LT	N/A	N/A	
1-157A	SUMMIT, BURIED FOC	(3) 1.5"	PE	2221+00.72	27.09'	LT	39.47'	33.33'	POSSIBLE 3-1.5" PE; UNABLE TO VISUALLY VERIFY DUE TO WATER, DEPTH AND CAVE-IN.
1-158	TECO, GAS MAIN	8"	STL	2220+99.43	39.37'	LT	37.25'	29.29'	POSSIBLE 8" STL; UNABLE TO VISUALLY VERIFY DUE TO WATER, DEPTH AND CAVE-IN.
1-159	EXPLORATORY - CLEARED TO 10'	N/A	N/A	2221+69.98	90.06'	RT	N/A	N/A	
1-160	SUMMIT, BURIED FOC	(3) 1.5"	PE	2222+59.71	31.13'	LT	38.31'	33.51'	POSSIBLE 3-1.5" PE; UNABLE TO VISUALLY VERIFY DUE TO WATER, DEPTH AND CAVE-IN.
1-161	EXPLORATORY - CLEARED TO 10'	N/A	N/A	2222+29.23	71.50'	RT	N/A	N/A	
1-162	EXPLORATORY - CLEARED TO 10'	N/A	N/A	2222+60.54	42.01'	LT	N/A	N/A	
1-163	CENTURYLINK, BURIED TELEPHONE	0.5"	DBC	2222+60.69	38.33'	LT	37.42'	35.02'	POSSIBLE 0.5" DBC; UNABLE TO VISUALLY VERIFY DUE TO WATER, DEPTH AND CAVE-IN.
1-164	SUMMIT, BURIED FOC	(3) 1.5"	PE	2223+89.95	28.72'	LT	38.88'	32.70'	POSSIBLE 3-1.5" PE; UNABLE TO VISUALLY VERIFY DUE TO WATER, DEPTH AND CAVE-IN.
1-165	EXPLORATORY - CLEARED TO 10'	N/A	N/A	2223+89.77	43.33'	LT	N/A	N/A	
1-166	SUMMIT, BURIED FOC	(3) 1.5"	PE	2225+18.00	30.81'	LT	38.20'	32.55'	POSSIBLE 3-1.5" PE; UNABLE TO VISUALLY VERIFY DUE TO WATER, DEPTH AND CAVE-IN.
1-167	CENTURYLINK, BURIED TELEPHONE	0.5"	DBC	2225+19.07	41.47'	LT	37.20'	34.37'	POSSIBLE 0.5" DBC; UNABLE TO VISUALLY VERIFY DUE TO WATER, DEPTH AND CAVE-IN.
1-168	CENTURYLINK, BURIED FOC/TELEPHONE	2"	PVC	2226+54.90	47.14'	LT	36.84'	34.34'	
1-169	CENTURYLINK, BURIED TELEPHONE	0.5"	DBC	2226+56.22	45.01'	LT	37.00'	34.60'	
1-170	SUMMIT, BURIED FOC	(3) 1.5"	PE	2227+91.15	30.09'	LT	37.92'	32.34'	POSSIBLE 3-1.5" PE; UNABLE TO VISUALLY VERIFY DUE TO WATER, DEPTH AND CAVE-IN.
1-171	CENTURYLINK, BURIED TELEPHONE	0.5"	DBC	2227+91.83	42.89'	LT	36.63'	33.63'	
1-172	SUMMIT, BURIED FOC	(3) 1.5"	PE	2229+28.34	27.44'	LT	37.76'	34.70'	
1-173	CENTURYLINK, BURIED FOC/TELEPHONE	1" & (2) 0.5"	DBC	2229+26.42	40.93'	LT	36.78'	36.34'	
1-174	SUMMIT, BURIED FOC	(3) 1.5"	PE	2230+62.91	24.70'	LT	38.04'	32.72'	
1-174A	CENTURYLINK, BURIED TELEPHONE	0.5"	DBC	2230+61.87	31.02'	LT	37.13'	35.09'	
1-175	CENTURYLINK, BURIED TELEPHONE	0.5"	DBC	2230+60.17	37.66'	LT	36.81'	34.65'	
1-176	SUMMIT, BURIED FOC	(3) 1.5"	PE	2231+98.44	23.96'	LT	38.14'	32.74'	
1-177	CENTURYLINK, BURIED FOC/TELEPHONE	1" & (2) 0.5"	DBC	2231+99.17	37.62'	LT	36.66'	34.82'	
1-178	CENTURYLINK, BURIED TELEPHONE	(2) 0.5"	DBC	2231+99.35	36.10'	LT	36.70'	33.50'	
1-179	CENTURYLINK, BURIED TELEPHONE	0.5"	DBC	2231+99.30	35.14'	LT	36.87'	34.23'	
1-180	TECO, GAS MAIN	8"	STL	2231+99.07	36.98'	LT	36.67'	28.27'	POSSIBLE 8" STL; UNABLE TO VISUALLY VERIFY DUE TO WATER, DEPTH AND CAVE-IN.
1-181	EXPLORATORY - CLEARED TO 8.22'	N/A	N/A	2231+98.58	28.48'	LT	N/A	N/A	UNABLE TO CLEAR TO 10' DUE TO HARD PAN.
1-181A	CENTURYLINK, BURIED TELEPHONE	0.5"	DBC	2231+98.68	31.74'	LT	37.27'	35.45'	
1-182	CENTURYLINK, BURIED TELEPHONE	(2) 0.5"	DBC	2232+02.68	38.24'	LT	36.75'	36.35'	
1-183	CENTURYLINK, BURIED TELEPHONE	1"	DBC	2232+01.00	28.82'	RT	37.53'	34.58'	
1-184	CENTURYLINK, BURIED TELEPHONE	0.5"	DBC	2232+00.92	34.55'	RT	36.87'	32.97'	
1-185	SUMMIT, BURIED FOC	(3) 1.5"	PE	2233+19.72	28.38'	LT	38.21'	32.21'	POSSIBLE 3-1.5" PE; UNABLE TO VISUALLY VERIFY DUE TO WATER, DEPTH AND CAVE-IN.
1-186	CENTURYLINK, BURIED TELEPHONE	0.5"	DBC	2233+16.21	39.17'	LT	36.63'	28.99'	POSSIBLE 0.5" DBC; UNABLE TO VISUALLY VERIFY DUE TO WATER, DEPTH AND CAVE-IN.

THE OFFICIAL RECORD OF THIS SHEET IS THE ELECTRONIC FILE DIGITALLY SIGNED AND SEALED UNDER RULE 61G15-23.04, F.A.C.

REVISIONS				STATE OF FLORIDA DEPARTMENT OF TRANSPORTATION			VERIFIED UTILITY LOCATE	
DATE	DESCRIPTION	DATE	DESCRIPTION	ROAD NO.	COUNTY	FINANCIAL PROJECT ID	SHEET NO.	
<tbl\_info cols="

## SUMMARY OF VERIFIED UTILITIES

V <sub>vh</sub> #	UTILITY DESCRIPTION (Owner, type)	SIZE	MATERIALS	P and/or C			EXISTING GROUND ELEVATION	TOP ELEVATION	COMMENTS
				STATION	OFFSET	LT/RT			
1-187	SUMMIT, BURIED FOC	(3) 1.5"	PE	2235+01.91	43.13'	LT	37.19'	33.47'	POSSIBLE 3-1.5" PE; UNABLE TO VISUALLY VERIFY DUE TO WATER, DEPTH AND CAVE-IN.
1-188	EXPLORATORY - CLEARED TO 10'	N/A	N/A	2235+99.27	96.58'	RT	N/A	N/A	
1-189	EXPLORATORY - CLEARED TO 10'	N/A	N/A	2235+98.64	99.35'	RT	N/A	N/A	
1-190	CALUMET, GAS MAIN	6"	STL	2235+99.84	89.24'	RT	34.60'	32.40'	POSSIBLE 6" STL; UNABLE TO VISUALLY VERIFY DUE TO WATER, DEPTH AND CAVE-IN.
1-191	EXPLORATORY - CLEARED TO 10'	N/A	N/A	2235+99.85	87.49'	RT	N/A	N/A	
1-192	EXPLORATORY - CLEARED TO 10'	N/A	N/A	2235+99.82	92.75'	RT	N/A	N/A	
1-193	SUMMIT, BURIED FOC	(3) 1.5"	PE	2237+01.68	42.37'	LT	36.95'	29.59'	POSSIBLE 3-1.5" PE; UNABLE TO VISUALLY VERIFY DUE TO WATER, DEPTH AND CAVE-IN.
1-194	CALUMET, GAS MAIN	6"	STL	2237+99.97	88.33'	RT	34.34'	31.24'	POSSIBLE 6" STL; UNABLE TO VISUALLY VERIFY DUE TO WATER, DEPTH AND CAVE-IN.
1-195	EXPLORATORY - CLEARED TO 10'	N/A	N/A	2237+99.96	89.79'	RT	N/A	N/A	
1-196	EXPLORATORY - CLEARED TO 10'	N/A	N/A	2237+99.80	91.60'	RT	N/A	N/A	
1-197	SUMMIT, BURIED FOC	(3) 1.5"	PE	2238+99.54	48.66'	LT	37.28'	30.83'	POSSIBLE 3-1.5" PE; UNABLE TO VISUALLY VERIFY DUE TO WATER, DEPTH AND CAVE-IN.
1-198	CALUMET, GAS MAIN	6"	STL	2240+10.45	89.23'	RT	34.82'	33.16'	
1-199	EXPLORATORY - CLEARED TO 10'	N/A	N/A	2240+11.04	91.31'	RT	N/A	N/A	
1-200	EXPLORATORY - CLEARED TO 10'	N/A	N/A	2240+11.44	94.36'	RT	N/A	N/A	
1-201	SUMMIT, BURIED FOC	(3) 1.5"	PE	2240+99.58	50.34'	LT	37.38'	30.48'	POSSIBLE 3-1.5" PE; UNABLE TO VISUALLY VERIFY DUE TO WATER, DEPTH AND CAVE-IN.
1-202	CALUMET, GAS MAIN	6"	STL	2241+99.55	89.07'	RT	34.77'	32.15'	
1-203	EXPLORATORY - CLEARED TO 10'	N/A	N/A	2241+99.29	84.80'	RT	N/A	N/A	
1-204	EXPLORATORY - CLEARED TO 10'	N/A	N/A	2241+99.92	92.53'	RT	N/A	N/A	
1-205	SUMMIT, BURIED FOC	(3) 1.5"	PE	2242+99.78	59.15'	LT	37.04'	31.24'	POSSIBLE 3-1.5" PE; UNABLE TO VISUALLY VERIFY DUE TO WATER, DEPTH AND CAVE-IN.
1-206	CALUMET, GAS MAIN	6"	STL	2244+00.22	87.72'	RT	34.78'	33.28'	
1-207	EXPLORATORY - CLEARED TO 10'	N/A	N/A	2243+99.76	85.61'	RT	N/A	N/A	
1-208	EXPLORATORY - CLEARED TO 10'	N/A	N/A	2243+99.82	82.99'	RT	N/A	N/A	
1-209	SUMMIT, BURIED FOC	(3) 1.5"	PE	2244+99.59	61.28'	LT	37.28'	31.53'	POSSIBLE 3-1.5" PE; UNABLE TO VISUALLY VERIFY DUE TO WATER, DEPTH AND CAVE-IN.
1-210	EXPLORATORY - CLEARED TO 10'	N/A	N/A	2246+00.34	82.81'	RT	N/A	N/A	
1-211	EXPLORATORY - CLEARED TO 10'	N/A	N/A	2246+00.28	86.83'	RT	N/A	N/A	
1-212	CALUMET, GAS MAIN	6"	STL	2245+99.94	90.97'	RT	35.49'	32.17'	
1-213	LEE COUNTY, STREET LIGHT	2.5"	PVC	2246+98.91	55.90'	LT	38.10'	35.41'	
1-214	CENTURYLINK, BURIED TELEPHONE	1" & 0.5"	DBC	2247+00.26	60.06'	LT	37.70'	34.84'	
1-214A	SUMMIT, BURIED FOC	(3) 1.5"	PE	2247+00.22	60.50'	LT	37.70'	32.20'	POSSIBLE 3-1.5" PE; UNABLE TO VISUALLY VERIFY DUE TO WATER, DEPTH AND CAVE-IN.
1-215	CENTURYLINK, BURIED TELEPHONE	0.5"	DBC	2247+51.14	56.91'	LT	37.89'	37.89'	BT LINE WAS CUT AND EXPOSED.
1-216	CENTURYLINK, BURIED TELEPHONE	0.5"	DBC	2247+56.43	58.52'	LT	37.74'	34.84'	
1-217	CENTURYLINK, BURIED TELEPHONE	1" & 0.5"	DBC	2247+56.44	58.08'	LT	37.81'	34.91'	
1-217A	LEE COUNTY, STREET LIGHT	2.5"	PVC	2247+54.07	56.98'	LT	37.86'	35.16'	
1-218	EXPLORATORY - CLEARED TO 10'	N/A	N/A	2248+01.20	84.41'	RT	N/A	N/A	
1-219	EXPLORATORY - CLEARED TO 10'	N/A	N/A	2248+01.31	80.47'	RT	N/A	N/A	
1-220	CALUMET, GAS MAIN	6"	STL	2248+00.31	89.12'	RT	34.88'	32.12'	
1-221	SUMMIT, BURIED FOC	(3) 1.5"	PE	2249+00.56	61.66'	LT	36.90'	31.55'	POSSIBLE 3-1.5" PE; UNABLE TO VISUALLY VERIFY DUE TO WATER, DEPTH AND CAVE-IN.
1-222A	EXPLORATORY - CLEARED TO 10'	N/A	N/A	2249+12.07	74.01'	LT	N/A	N/A	
1-222B	EXPLORATORY - CLEARED TO 10'	N/A	N/A	2249+12.06	76.68'	LT	N/A	N/A	
1-222C	EXPLORATORY - CLEARED TO 10'	N/A	N/A	2249+12.23	79.03'	LT	N/A	N/A	
1-222D	EXPLORATORY - CLEARED TO 10'	N/A	N/A	2249+12.39	81.92'	LT	N/A	N/A	
1-223	EXPLORATORY - CLEARED TO 9.60'	N/A	N/A	2249+97.74	77.23'	RT	N/A	N/A	
1-224	EXPLORATORY - CLEARED TO 6.41'	N/A	N/A	2249+97.24	81.88'	RT	N/A	N/A	UNABLE TO CLEAR TO 10' DUE TO HARD PAN.
1-225	CALUMET, GAS MAIN	6"	STL	2249+97.89	88.78'	RT	34.87'	31.65'	POSSIBLE 6" STL; UNABLE TO VISUALLY VERIFY DUE TO WATER, DEPTH AND CAVE-IN.
1-226	SUMMIT, BURIED FOC	(3) 1.5"	PE	2250+96.98	65.00'	LT	36.53'	32.94'	POSSIBLE 3-1.5" PE; UNABLE TO VISUALLY VERIFY DUE TO WATER, DEPTH AND CAVE-IN.
1-227	EXPLORATORY - CLEARED TO 6.76'	N/A	N/A	2251+99.79	77.76'	RT	N/A	N/A	UNABLE TO CLEAR TO 10' DUE TO HARD PAN.
1-228	EXPLORATORY - CLEARED TO 7.60'	N/A	N/A	2251+99.20	82.10'	RT	N/A	N/A	UNABLE TO CLEAR TO 10' DUE TO HARD PAN.
1-229	CALUMET, GAS MAIN	6"	STL	2252+00.15	87.95'	RT	34.72'	31.90'	
1-230	SUMMIT, BURIED FOC	(3) 1.5"	PE	2252+99.70	65.34'	LT	36.46'	31.16'	POSSIBLE 3-1.5" PE; UNABLE TO VISUALLY VERIFY DUE TO WATER, DEPTH AND CAVE-IN.
1-231	EXPLORATORY - CLEARED TO 10'	N/A	N/A	2254+00.79	76.71'	RT	N/A	N/A	
1-232	EXPLORATORY - CLEARED TO 10'	N/A	N/A	2253+99.41	81.98'	RT	N/A	N/A	
1-233	CALUMET, GAS MAIN	6"	STL	2253+97.25	88.83'	RT	34.71'	32.01'	
1-234	SUMMIT, BURIED FOC	(3) 1.5"	PE	2255+07.98	59.17'	LT	37.66'	25.76'	POSSIBLE 3-1.5" PE; UNABLE TO VISUALLY VERIFY DUE TO WATER, DEPTH AND CAVE-IN.
1-235	EXPLORATORY - CLEARED TO 7.82'	N/A	N/A	2256+01.84	76.37'	RT	N/A	N/A	UNABLE TO CLEAR TO 10' DUE TO HARD PAN.
1-236	EXPLORATORY - CLEARED TO 7.91'	N/A	N/A	2256+02.50	82.83'	RT	N/A	N/A	UNABLE TO CLEAR TO 10' DUE TO HARD PAN.
1-237	CALUMET, GAS MAIN	6"	STL	2256+02.78	91.17'	RT	33.39'	31.69'	
1-238	SUMMIT, BURIED FOC	(3) 1.5"	PE	2257+00.31	63.65'	LT	37.60'	24.35'	POSSIBLE 3-1.5" PE; UNABLE TO VISUALLY VERIFY DUE TO WATER, DEPTH AND CAVE-IN.
1-239	EXPLORATORY - CLEARED TO 6.10'	N/A	N/A	2257+21.97	77.68'	RT	N/A	N/A	UNABLE TO CLEAR TO 10' DUE TO HARD PAN.
1-240	EXPLORATORY - CLEARED TO 6.68'	N/A	N/A	2257+21.67	83.26'	RT	N/A	N/A	UNABLE TO CLEAR TO 10' DUE TO HARD PAN.
1-241	CALUMET, GAS MAIN	6"	STL	2257+21.83	89.76'	RT	33.57'	31.42'	POSSIBLE 6" STL; UNABLE TO VISUALLY VERIFY DUE TO WATER, DEPTH AND CAVE-IN.
1-242	EXPLORATORY - CLEARED TO 10'	N/A	N/A	2099+93.88	325.85'	RT	N/A	N/A	
1-243	CALUMET, GAS MAIN	6"	STL	2099+95.08	322.20'	RT	34.07'	31.73'	
1-244	TECO, GAS MAIN	8"	STL	2096+98.44	55.64'	LT	34.76'	29.56'	POSSIBLE 8" STL; UNABLE TO VISUALLY VERIFY DUE TO WATER, DEPTH AND CAVE-IN.
1-245	TECO, GAS MAIN	8"	STL	2109+52.33	52.10'	LT	33.34'	30.77'	
1-246	TECO, GAS MAIN	8"	STL	2110+08.84	51.42'	LT	33.98'	30.84'	

THE OFFICIAL RECORD OF THIS SHEET IS THE ELECTRONIC FILE DIGITALLY SIGNED AND SEALED UNDER RULE 61G15-23.04, F.A.C.

## REVISIONS

||
||
||

## SUMMARY OF VERIFIED UTILITIES

V <sub>vh</sub> #	UTILITY DESCRIPTION (Owner, type)	SIZE	MATERIALS	P and/or C			EXISTING GROUND ELEVATION	TOP ELEVATION	COMMENTS
				STATION	OFFSET	LT/RT			
1-247	TECO, GAS MAIN	8"	STL	2110+82.67	51.29'	LT	34.06'	30.87'	
1-248	TECO, GAS MAIN	8"	STL	2111+80.14	51.29'	LT	34.04'	31.30'	
1-249	TECO, GAS MAIN	8"	STL	2113+98.26	50.27'	LT	34.21'	31.21'	
1-250	TECO, GAS MAIN	8"	STL	2117+88.81	47.91'	LT	33.86'	30.62'	
1-251	TECO, GAS MAIN	8"	STL	2173+01.09	31.95'	LT	37.17'	27.23'	POSSIBLE 8" STL; UNABLE TO VISUALLY VERIFY DUE TO WATER, DEPTH AND CAVE-IN.
1-252	TECO, GAS MAIN	8"	STL	2174+00.08	31.89'	LT	36.20'	27.28'	POSSIBLE 8" STL; UNABLE TO VISUALLY VERIFY DUE TO WATER, DEPTH AND CAVE-IN.
1-253	TECO, GAS MAIN	8"	STL	2177+50.45	30.82'	LT	35.88'	26.22'	POSSIBLE 8" STL; UNABLE TO VISUALLY VERIFY DUE TO WATER, DEPTH AND CAVE-IN.
1-254	TECO, GAS MAIN	8"	STL	2188+02.21	26.01'	LT	38.76'	33.28'	POSSIBLE 8" STL; UNABLE TO VISUALLY VERIFY DUE TO WATER, DEPTH AND CAVE-IN.
1-255	TECO, GAS MAIN	8"	STL	2188+66.96	26.97'	LT	40.10'	33.64'	POSSIBLE 8" STL; UNABLE TO VISUALLY VERIFY DUE TO WATER, DEPTH AND CAVE-IN.
1-256	TECO, GAS MAIN	8"	STL	2199+02.35	29.18'	LT	39.76'	35.21'	POSSIBLE 8" STL; UNABLE TO VISUALLY VERIFY DUE TO WATER, DEPTH AND CAVE-IN.
1-257	TECO, GAS MAIN	8"	STL	2200+66.51	30.53'	LT	40.29'	35.01'	POSSIBLE 8" STL; UNABLE TO VISUALLY VERIFY DUE TO WATER, DEPTH AND CAVE-IN.
1-258	TECO, GAS MAIN	8"	STL	2202+86.83	31.75'	LT	41.20'	35.18'	POSSIBLE 8" STL; UNABLE TO VISUALLY VERIFY DUE TO WATER, DEPTH AND CAVE-IN.
1-259	TECO, GAS MAIN	8"	STL	2212+22.90	32.20'	LT	39.52'	34.70'	
1-260	TECO, GAS MAIN	8"	STL	2213+05.50	32.44'	LT	39.38'	34.60'	
1-261	TECO, GAS MAIN	8"	STL	2215+19.71	34.13'	LT	37.95'	34.31'	
1-262	TECO, GAS MAIN	8"	STL	2217+00.06	33.34'	LT	37.64'	33.82'	
1-263	TECO, GAS MAIN	8"	STL	2218+04.60	34.38'	LT	38.88'	34.10'	POSSIBLE 8" STL; UNABLE TO VISUALLY VERIFY DUE TO WATER, DEPTH AND CAVE-IN.
1-264	TECO, GAS MAIN	8"	STL	2219+29.03	37.74'	LT	38.01'	30.26'	POSSIBLE 8" STL; UNABLE TO VISUALLY VERIFY DUE TO WATER, DEPTH AND CAVE-IN.
1-265	TECO, GAS MAIN	8"	STL	2219+81.83	39.21'	LT	37.65'	28.99'	POSSIBLE 8" STL; UNABLE TO VISUALLY VERIFY DUE TO WATER, DEPTH AND CAVE-IN.
1-266	CENTURYLINK, BURIED TELEPHONE	1"	DBC	2220+01.14	36.84'	LT	38.01'	34.81'	
1-266A	TECO, GAS MAIN	8"	STL	2220+00.60	38.38'	LT	37.76'	25.08'	POSSIBLE 8" STL; UNABLE TO VISUALLY VERIFY DUE TO WATER, DEPTH AND CAVE-IN.
1-267	TECO, GAS MAIN	8"	STL	2221+98.71	40.20'	LT	37.84'	29.64'	POSSIBLE 8" STL; UNABLE TO VISUALLY VERIFY DUE TO WATER, DEPTH AND CAVE-IN.
1-268	TECO, GAS MAIN	8"	STL	2223+94.47	40.80'	LT	37.23'	28.59'	POSSIBLE 8" STL; UNABLE TO VISUALLY VERIFY DUE TO WATER, DEPTH AND CAVE-IN.
1-269	TECO, GAS MAIN	8"	STL	2225+20.89	41.50'	LT	37.28'	25.23'	POSSIBLE 8" STL; UNABLE TO VISUALLY VERIFY DUE TO WATER, DEPTH AND CAVE-IN.
1-269A	CENTURYLINK, BURIED TELEPHONE	0.5"	DBC	2225+19.37	37.35'	LT	37.54'	34.32'	
1-270	TECO, GAS MAIN	8"	STL	2226+56.95	42.94'	LT	36.85'	32.50'	
1-271	CENTURYLINK, BURIED TELEPHONE	0.5"	DBC	2226+56.76	40.23'	LT	37.03'	34.98'	
1-271A	CENTURYLINK, BURIED TELEPHONE	0.5"	DBC	2226+56.85	39.63'	LT	37.10'	36.65'	
1-272	TECO, GAS MAIN	8"	STL	2227+99.45	40.17'	LT	36.88'	28.48'	POSSIBLE 8" STL; UNABLE TO VISUALLY VERIFY DUE TO WATER, DEPTH AND CAVE-IN.
1-273	TECO, GAS MAIN	8"	STL	2229+26.40	37.81'	LT	36.84'	28.44'	POSSIBLE 8" STL; UNABLE TO VISUALLY VERIFY DUE TO WATER, DEPTH AND CAVE-IN.
1-274	TECO, GAS MAIN	8"	STL	2230+64.74	36.75'	LT	36.95'	28.73'	POSSIBLE 8" STL; UNABLE TO VISUALLY VERIFY DUE TO WATER, DEPTH AND CAVE-IN.
1-275	TECO, GAS MAIN	8"	STL	2233+38.67	38.08'	LT	37.61'	28.41'	POSSIBLE 8" STL; UNABLE TO VISUALLY VERIFY DUE TO WATER, DEPTH AND CAVE-IN.
1-276	TECO, GAS MAIN	8"	STL	2235+02.82	50.77'	LT	36.47'	29.17'	POSSIBLE 8" STL; UNABLE TO VISUALLY VERIFY DUE TO WATER, DEPTH AND CAVE-IN.
1-277	TECO, GAS MAIN	8"	STL	2237+02.50	57.36'	LT	35.86'	26.10'	POSSIBLE 8" STL; UNABLE TO VISUALLY VERIFY DUE TO WATER, DEPTH AND CAVE-IN.
1-278	TECO, GAS MAIN	8"	STL	2239+02.37	61.44'	LT	35.53'	25.85'	POSSIBLE 8" STL; UNABLE TO VISUALLY VERIFY DUE TO WATER, DEPTH AND CAVE-IN.
1-279	TECO, GAS MAIN	8"	STL	2241+01.94	63.95'	LT	35.33'	28.05'	POSSIBLE 8" STL; UNABLE TO VISUALLY VERIFY DUE TO WATER, DEPTH AND CAVE-IN.
1-280	TECO, GAS MAIN	8"	STL	2243+00.39	65.65'	LT	35.96'	31.96'	POSSIBLE 8" STL; UNABLE TO VISUALLY VERIFY DUE TO WATER, DEPTH AND CAVE-IN.
1-281	TECO, GAS MAIN	8"	STL	2244+99.83	67.02'	LT	36.39'	27.49'	POSSIBLE 8" STL; UNABLE TO VISUALLY VERIFY DUE TO WATER, DEPTH AND CAVE-IN.
1-282	TECO, GAS MAIN	8"	STL	2246+98.81	63.30'	LT	37.62'	28.77'	POSSIBLE 8" STL; UNABLE TO VISUALLY VERIFY DUE TO WATER, DEPTH AND CAVE-IN.
1-283	TECO, GAS MAIN	8"	STL	2249+00.18	66.75'	LT	36.61'	25.95'	POSSIBLE 8" STL; UNABLE TO VISUALLY VERIFY DUE TO WATER, DEPTH AND CAVE-IN.
1-284	TECO, GAS MAIN	8"	STL	2250+97.51	68.73'	LT	36.05'	29.21'	POSSIBLE 8" STL; UNABLE TO VISUALLY VERIFY DUE TO WATER, DEPTH AND CAVE-IN.
1-285	TECO, GAS MAIN	8"	STL	2252+99.00	69.44'	LT	35.89'	30.69'	POSSIBLE 8" STL; UNABLE TO VISUALLY VERIFY DUE TO WATER, DEPTH AND CAVE-IN.
1-286	TECO, GAS MAIN	8"	STL	2255+04.21	70.10'	LT	35.82'	25.82'	POSSIBLE 8" STL; UNABLE TO VISUALLY VERIFY DUE TO WATER, DEPTH AND CAVE-IN.
1-287	EXPLORATORY - CLEARED TO 10'	N/A	N/A	2256+99.41	71.49'	LT	N/A	N/A	
5-1	CENTURYLINK, BURIED TELEPHONE	(2) 0.5"	DBC	2240+89.12	39.35'	LT	38.66'	33.28'	POSSIBLE 2-0.5" DBC; UNABLE TO VISUALLY VERIFY DUE TO WATER, DEPTH AND CAVE-IN.
5-2	CENTURYLINK, BURIED TELEPHONE	1"	DBC	2240+91.15	56.59'	LT	36.46'	34.42'	
5-2A	CENTURYLINK, BURIED TELEPHONE	0.5"	DBC	2240+91.19	56.24'	LT	36.54'	34.26'	
5-3	CENTURYLINK, BURIED TELEPHONE	(2) 0.5"	DBC	2244+54.01	53.73'	LT	38.28'	34.07'	POSSIBLE 2-0.5" DBC; UNABLE TO VISUALLY VERIFY DUE TO WATER, DEPTH AND CAVE-IN.
5-4	CENTURYLINK, BURIED TELEPHONE	1"	DBC	2244+52.78	63.06'	LT	37.03'	34.94'	POSSIBLE 1" DBC; UNABLE TO VISUALLY VERIFY DUE TO WATER, DEPTH AND CAVE-IN.
5-5	CENTURYLINK, BURIED TELEPHONE	0.5"	DBC	2239+46.58	52.58'	LT	37.12'	33.62'	
5-6	CENTURYLINK, BURIED TELEPHONE	0.5"	DBC	2242+49.05	54.51'	LT	37.58'	32.63'	
5-7	CENTURYLINK, BURIED TELEPHONE	0.5"	DBC	2238+57.44	34.10'	RT	38.47'	32.37'	POSSIBLE 0.5" DBC; UNABLE TO VISUALLY VERIFY DUE TO WATER, DEPTH AND CAVE-IN.
5-9	CENTURYLINK, BURIED TELEPHONE	0.5"	DBC	2252+22.81	50.20'	LT	38.64'	33.58'	

THE OFFICIAL RECORD OF THIS SHEET IS THE ELECTRONIC FILE DIGITALLY SIGNED AND SEALED UNDER RULE 61G15-23.04, F.A.C.

REVISIONS				STATE OF FLORIDA DEPARTMENT OF TRANSPORTATION			SHEET NO.
DATE	DESCRIPTION	DATE	DESCRIPTION	ROAD NO.	COUNTY	FINANCIAL PROJECT ID	
				SR 29	COLLIER	417540-6-52-01	
							UTV-8