# Index 17352 Typical Placement of Reflective Pavement Markers

#### **ORIGINATION**

**Date:** 7/13/2017 **Name:** Ed Cashman **Phone:** (850)414-4314

Email: edward.cashman@dot.state.fl.us

#### **COMMENTARY**

Sheet 1: Changed title to "Typical Placement Of Raised Pavement Markers". Changed labels. Changed Note 1 to "Raised". Deleted Note 5.

Sheet 2: Changed title to "Typical Placement Of Raised Pavement Markers". Changed labels. Deleted blowup detail.

Sheet 3: Added new sheet. Sheet 4: Added new sheet.

#### **COMMENTS AND RESPONSES**

**BLACK** = Industry Review Comments **RED** = Standard Plans Response

Name: Pete Yauch, P.E.

Date: Friday, September 1, 2017 2:19 PM

#### **COMMENT:**

On new sheets 3 and 4, where RPMs are located along the radius of a median nose, the orientation of the markers should be specified – i.e., oriented toward approaching traffic, and not necessarily with the reflective faces perpendicular to the edge line or curb face.

#### **RESPONSE:**

September 13, 2017

Agree, notes have been added to these sheets and details have been revised. Changes made.

Name: Stephanie Sharp

Date: Thursday, September 14, 2017 11:26 AM

#### **COMMENT:**

Sheet 1: Alternating Skip Line detail inconsistent with 17346.

#### **RESPONSE:**

September 13, 2017

Sheet 1: This is consistent. This shows Two-Lane, Two-Way. No change made.

1 of 2

# Index 17352 Typical Placement of Reflective Pavement Markers

Name: Karina Fuentes, P.E.

Date: Monday, September 25, 2017 5:30 PM

#### **COMMENT:**

Sheet 2: (See Markup)

a. Suggest to remove text from Direction of Travel Arrow as it is already included in the legend.

b. 12" White line in the PLACEMENT OF RPMs ON SHOULDER MARKINGS detail is in conflict with Index 711-003 Sheet 1.

Sheet 4: Show arrow 25' for the gore area in DETAIL "G" as per Index 17346 Sheet 7. (See Markup)


#### **RESPONSE:**

September 27, 2017


#### Sheet 2:

- a. Agreed. Change made.
- b. Agreed. Change made.


Sheet 4: Clarified that those symbols are only for illustrative purpose. Change made.

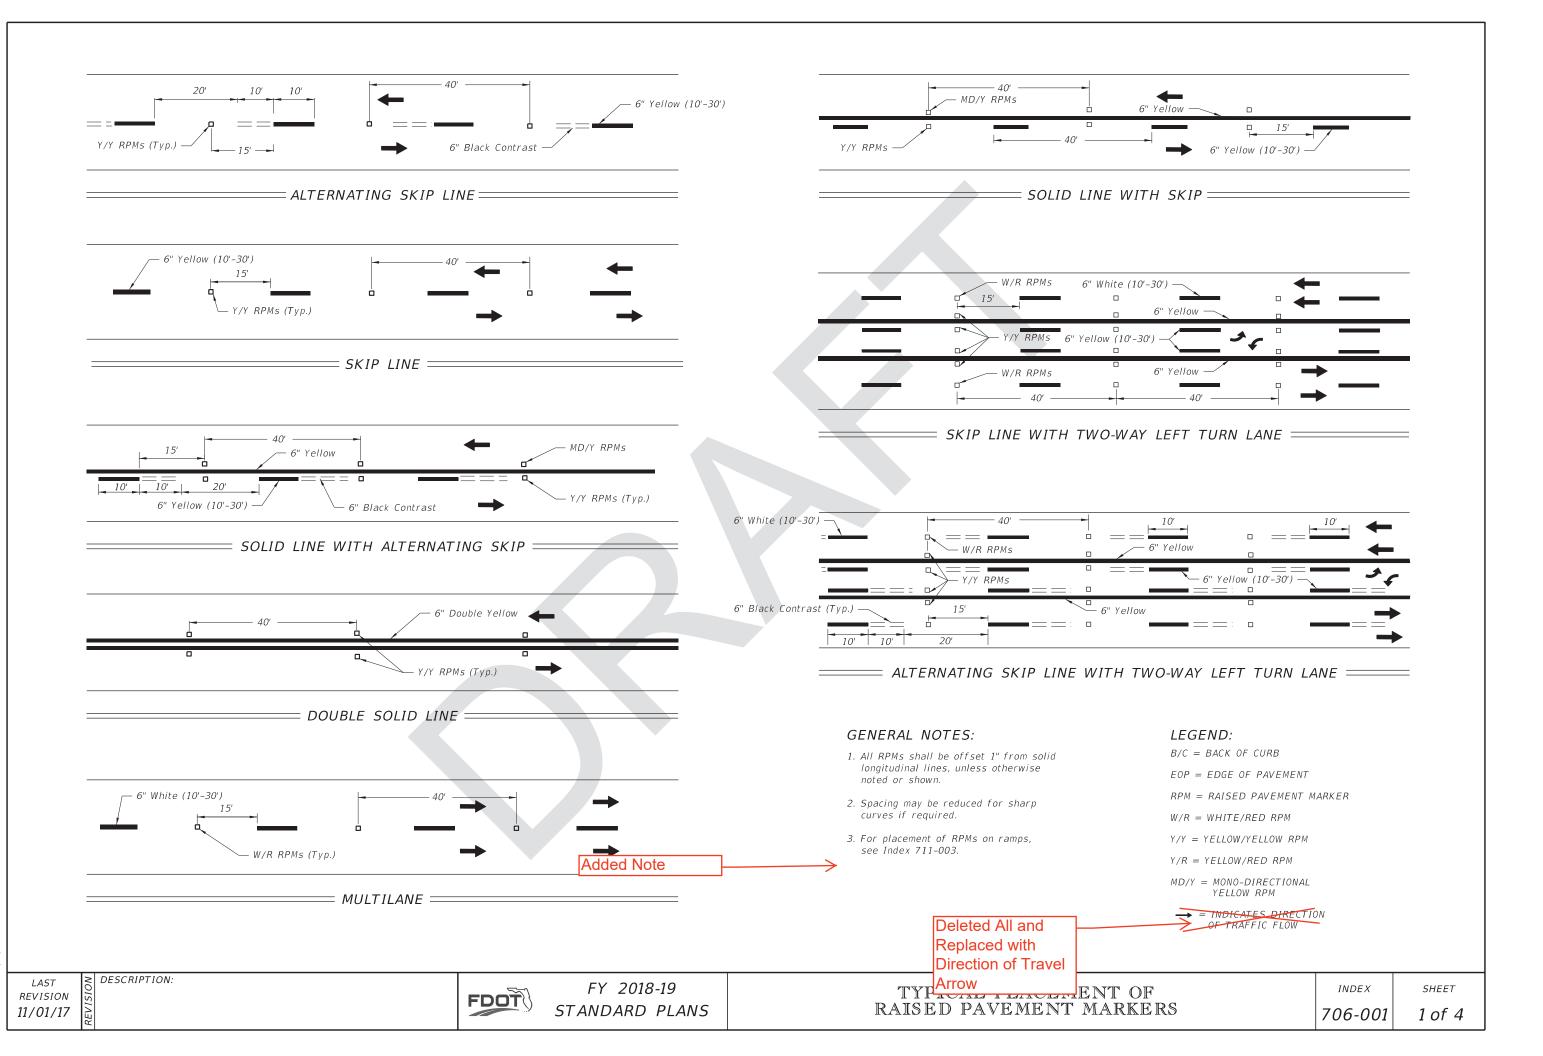



8/23/2017

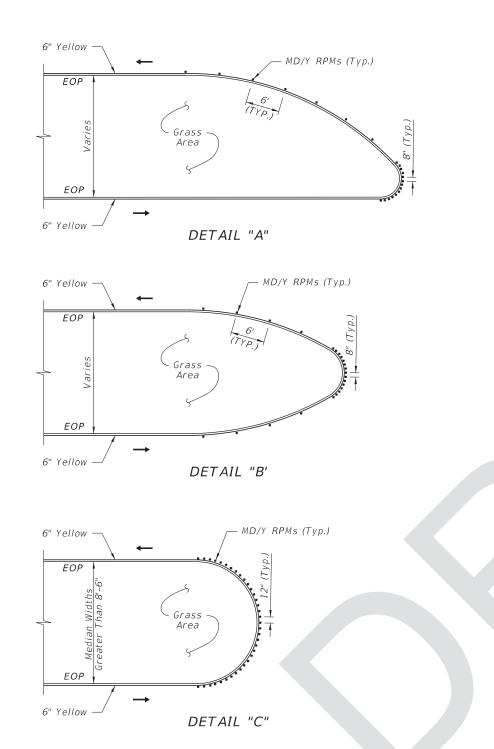

FLUSH MEDIAN OPENINGS

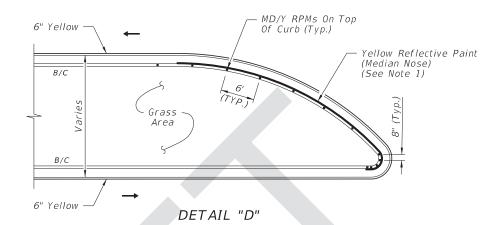

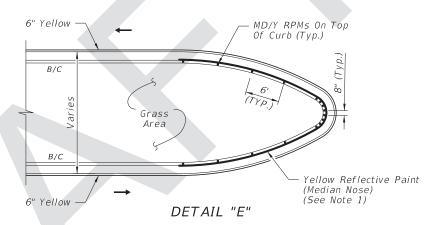

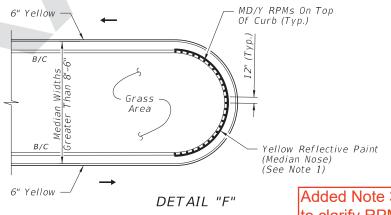

TYPE "D" OR "F" CURB

Added Note 3 to clarify RPMs orientation along the radius of the

median nose

Added Nose Detail

"Y" FEET
10
20
20
30
40

#### LEGEND:

B/C = BACK OF CURB

EOP = EDGE OF PAVEMENT

RPM = RAISED PAVEMENT MARKER

W/R = WHITE/RED RPM

Y/Y = YELLOW/YELLOW RPM

Y/R = YELLOW/RED RPM

MD/Y = MONO-DIRECTIONALYELLOW RPM

→ = !NDICATES DIRECTION
OF TRAFFIC FLOW

#### NOTES:

- 1. Furnish and install reflective paint on the face of curb for the limits shown in the above details.
- 2. For Type "E" Curb, install RPMs along the pavement edge marking using the same spacing shown.

PLACEMENT OF RPMS AT MEDIAN OPENINGS

LAST 11/01/17

≥ DESCRIPTION:

FDOT


FY 2018-19 STANDARD PLANS TYPICAL PLACEMENT OF RAISED PAVEMENT MARKERS

INDEX

706-001

SHEET

3 of 4

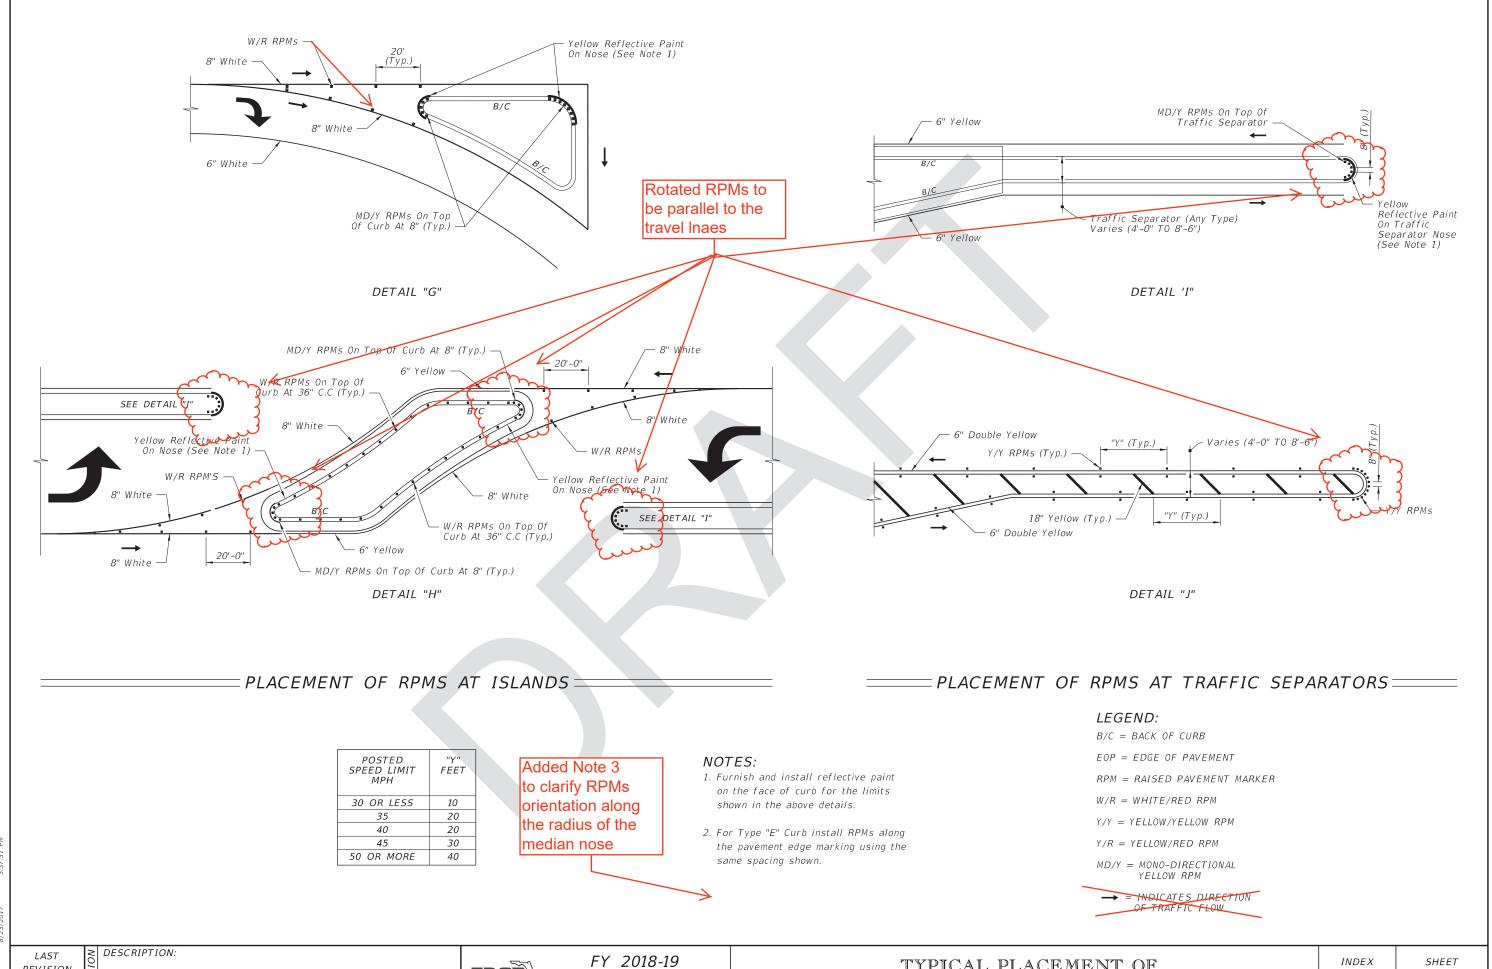

8/23/2017 3


LAST REVISION 11/01/17


FDOT

FY 2018-19 STANDARD PLANS TYPICAL PLACEMENT OF RAISED PAVEMENT MARKERS


706-001

4 of 4

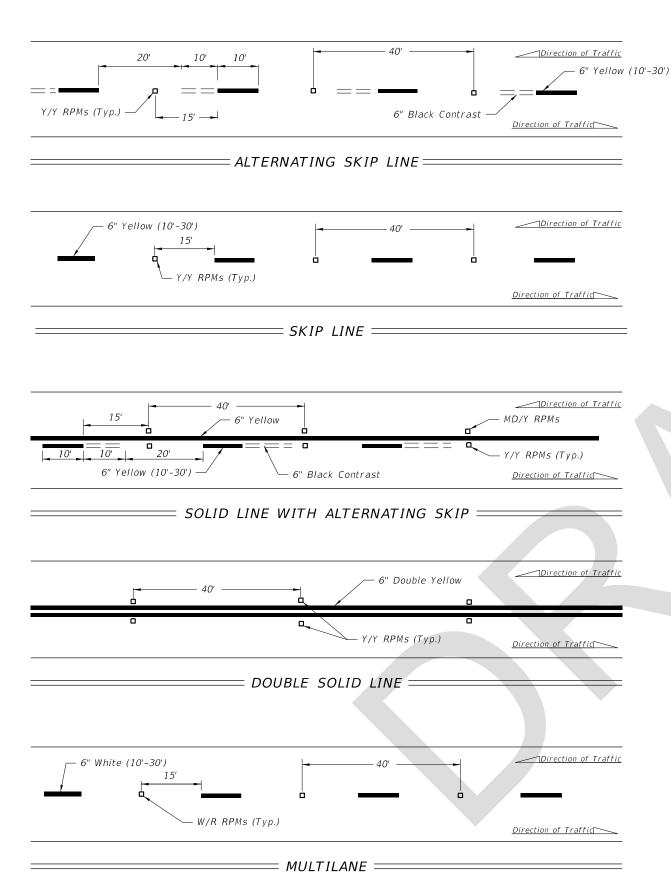


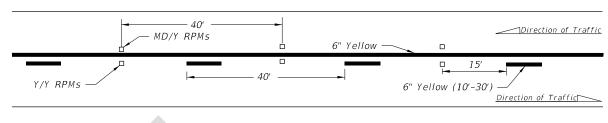

#### = SOLID LINE WITH SKIP ===

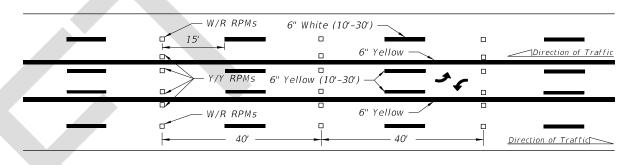

SKIP LINE WITH TWO-WAY LEFT TURN LANE =

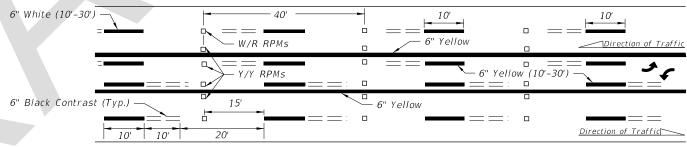

#### == ALTERNATING SKIP LINE WITH TWO-WAY LEFT TURN LANE ===

#### **GENERAL NOTES:**

- 1. Offset all RPMs 1" from solid longitudinal lines unless otherwise noted or shown.
- 2. Spacing may be reduced for sharp curves if required.
- 3. For placement of RPMs on ramps, see Index 711-003.
- 4. Make the traffic face of the RPM the same color as the pavement marking that it is supplementing.

#### LEGEND:

B/C = BACK OF CURB

EOP = EDGE OF PAVEMENT

RPM = RAISED PAVEMENT MARKER

W/R = WHITE/RED RPM

Y/Y = YELLOW/YELLOW RPM

Y/R = YELLOW/RED RPM

MD/Y = MONO-DIRECTIONAL YELLOW RPM

**REVISION** 11/01/17

DESCRIPTION:




FY 2018-19 STANDARD PLANS


TYPICAL PLACEMENT OF RAISED PAVEMENT MARKERS INDEX

SHEET


706-001 1 of 4

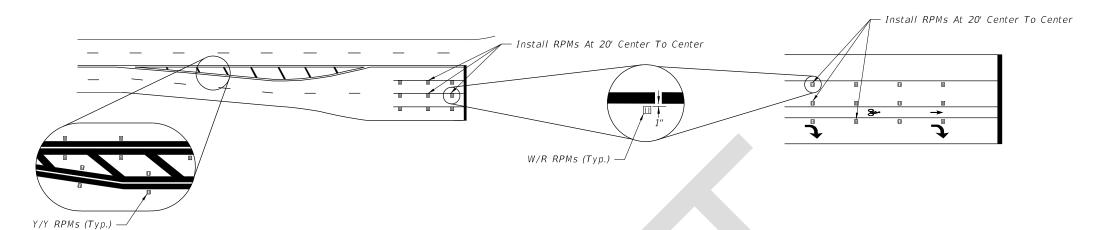


### RPM PLACEMENT AT INTERSECTIONS

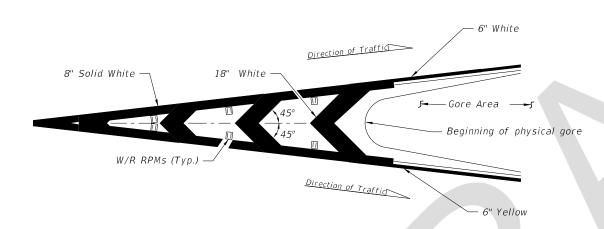

### = RPM PLACEMENT AT TRAFFIC CHANNELIZATION AT GORE (Traffic Flows In Same Direction)

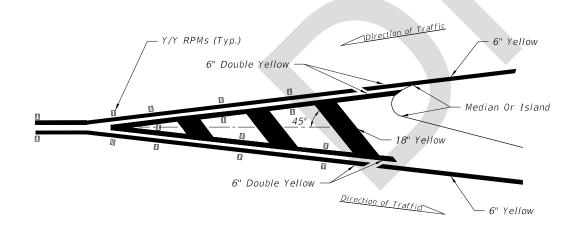

RPM PLACEMENT AT TRAFFIC SEPARATION = (Traffic Flows In Opposite Direction)

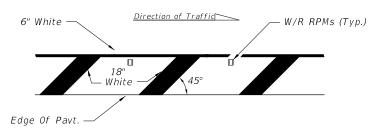

Right side of the roadway shown. For the left side of roadway, the pavement marking is yellow and oriented opposite hand.

#### RPM PLACEMENT AT ROADSIDE CROSSHATCHING

#### *NOTE:*

1. Center the Raised Pavement Markers between chevrons and crosshatching.

#### LEGEND:

B/C = BACK OF CURB

EOP = EDGE OF PAVEMENT

RPM = RAISED PAVEMENT MARKER

W/R = WHITE/RED RPM

Y/Y = YELLOW/YELLOW RPM

Y/R = YELLOW/RED RPM

MD/Y = MONO-DIRECTIONAL YELLOW RPM

FDOT


FY 2018-19 STANDARD PLANS

TYPICAL PLACEMENT OF


INDEX

SHEET


DESCRIPTION: REVISION 11/01/17

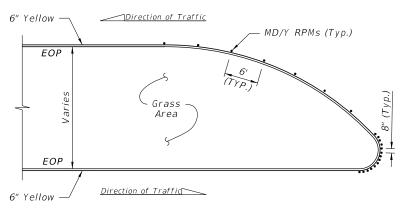


DETAIL "A"

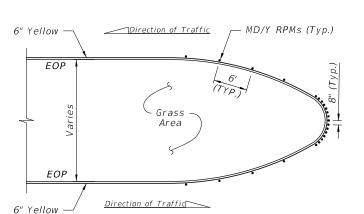


DETAIL "B'

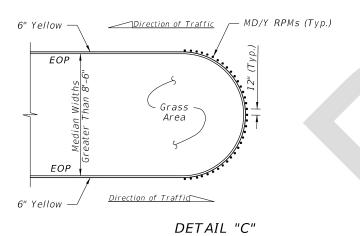


FLUSH MEDIAN OPENINGS

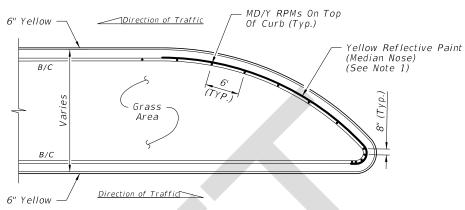

DETAIL "D"

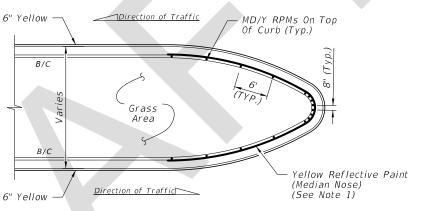


DETAIL "E"

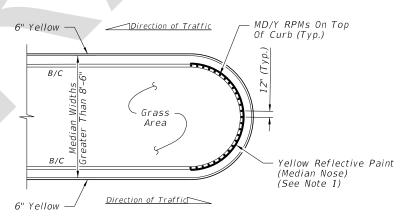

DETAIL "F"

TYPE "D" OR "F" CURB

= RPM PLACEMENT AT MEDIAN OPENINGS =

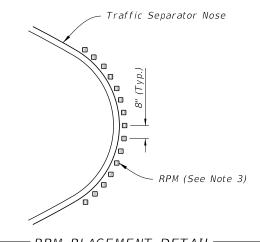

RPM PLACEMENT DETAIL

POSTED SPEED LIMIT MPH	"Y" FEET
30 OR LESS	10
35	20
40	20
45	30
50 OR MORE	40

#### LEGEND:

B/C = BACK OF CURB

EOP = EDGE OF PAVEMENT

RPM = RAISED PAVEMENT MARKER

W/R = WHITE/RED RPM

Y/Y = YELLOW/YELLOW RPM

Y/R = YELLOW/RED RPM

MD/Y = MONO-DIRECTIONALYELLOW RPM

#### NOTES:

- 1. Furnish and install reflective paint on the face of curb for the limits shown in the above details.
- 2. For Type "E" Curb, install RPMs along the pavement edge marking using the same spacing shown.
- 3. Orient traffic faces of RPMs in curb median radii to be parallel to direction of travel lanes.

**REVISION** 11/01/17

DESCRIPTION:





FY 2018-19 STANDARD PLANS

TYPICAL PLACEMENT OF RAISED PAVEMENT MARKERS INDEX


SHEET


706-001 3 of 4

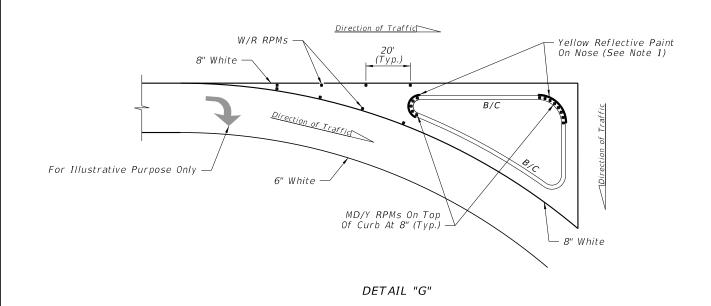

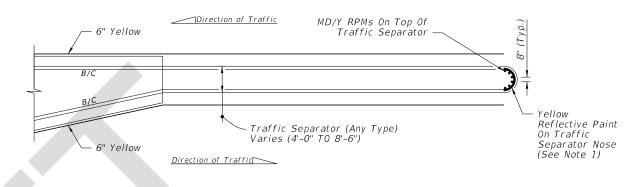

DETAIL "I"

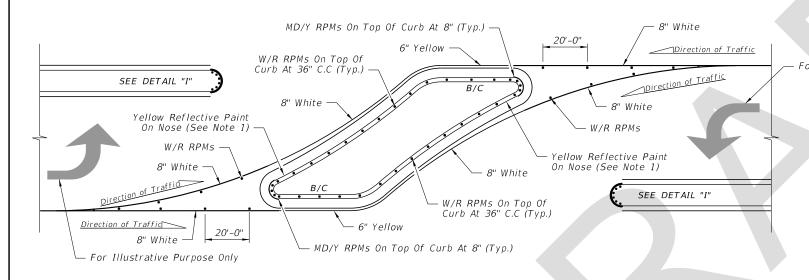

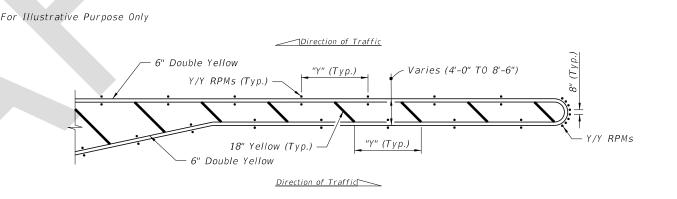

DETAIL "J"

## RPM PLACEMENT AT ISLANDS

DETAIL "H"

# RPM PLACEMENT AT TRAFFIC SEPARATORS =

#### NOTES:

- 1. Furnish and install reflective paint on the face of curb for the limits shown in the above details.
- 2. For Type "E" Curb install RPMs along the pavement edge marking using the same spacing shown.
- 3. Orient traffic faces of RPMs in median radii to be parallel to direction of travel lanes.

B/C = BACK OF CURB

LEGEND:

EOP = EDGE OF PAVEMENT

RPM = RAISED PAVEMENT MARKER

W/R = WHITE/RED RPM

Y/Y = YELLOW/YELLOW RPM

Y/R = YELLOW/RED RPM

MD/Y = MONO-DIRECTIONALYELLOW RPM

POSTED SPEED LIMIT MPH	"Y" FEET
30 OR LESS	10
35	20
40	20
45	30
50 OR MORE	40

**REVISION** 11/01/17

DESCRIPTION:

FDOT

FY 2018-19 STANDARD PLANS

TYPICAL PLACEMENT OF RAISED PAVEMENT MARKERS INDEX

SHEET 4 of 4

706-001