
Index 18111 Steel CCTV Pole

ORIGINATION

Date: 7/27/17

Name: Derwood Sheppard

Phone: (850) 414-4334

Email: Derwood.Sheppard@dot.state.fl

COMMENTARY

All Sheets: Redeveloped Index.

Consolidated relevant information from Indexes 18100, 18101, 18102, 18104, 18105, 18107, and 18108, which were deleted for the Standards Plans for the FY 2018-19 release.

COMMENTS AND RESPONSES

BLACK = Industry Review Comments **RED** = Standard Plans Response

Name: Katie King, P.E.

Date: Thursday, September 14, 2017 10:17 AM

COMMENT:

Sheet 1 of 6 – Check the lettering under General Note 3 Materials. It starts with B instead of A.

RESPONSE:

Date: 9/18/17

Agreed. Change made.

GENERAL NOTES:

1. Work this Index with Specification 649.
2. This Index is considered fully detailed and no shop drawings are necessary. Submit Shop Drawings for minor modifications not detailed in the Plans.
3. Materials: Re-labeled starting with A.
 - B. Pole: ASTM A1011 Grade 50, 55, 60 or 65 (less than 1/4") or ASTM A572 Grade 50, 60 or 65 (greater than or equal to 1/4") or ASTM A595 Grade A (55 ksi yield) or Grade B (60 ksi yield).
 - C. Steel Plates and Pole Cap: ASTM A36 or ASTM A709 Grade 50.
 - D. Weld Metal: E70XX.
 - E. Bolts: ASTM F3125, Grade A325, Type 1.
 - F. Nuts: ASTM A563.
 - G. Washers: ASTM F-436.
 - H. Anchor Bolts: ASTM F1554 Grade 55 with ASTM A563 Grade A heavy-hex nuts and plate washers. ASTM F2329 galvanization.
 - I. Handhole Frame: ASTM A709 Grade 36 or ASTM A36.
 - J. Handhole Cover: ASTM A1011 Grade 50, 55, 60 or 65.
 - K. Stainless Steel Screws: AISI Type 316.
 - L. Reinforcing Steel: ASTM A615 Grade 60.
 - M. Galvanization: Bolts, nuts and washers: ASTM F2329 All other steel: ASTM A123
 - N. Concrete: Class IV (Drilled Shaft) for all environment classifications.

4. Pole Fabrication:

- A. Provide either a round or 16 sided pole with a constant taper of 0.14 inches per foot
- B. Pole shaft may be either One or Two sections (with telescopic field splice)
- C. Up to two longitudinal seam welds are permitted.
- D. Use only circumferential welds at base.
- E. Use a complete penetrator weld for longitudinal seam welds within 6" of circumferential welds. Use a complete penetrator weld on female section of telescopic field splices, splice length plus six inches. All other areas, size the partial penetration welds to at least 60% of the pole tube thickness.
- F. Perform all welding in accordance with the American Welding Society Structural Welding Code (Steel) ANSI/AWS D1.1 (current edition). For additional welding requirements see AASHTO Standard Specifications for Structural Supports for Highway Signs, Luminaires and Traffic Signals, Section 5.15, Welded Connections.
- G. Provide a 2"x4" (Max.) aluminum identification tag on the pole. Secured tag to pole with stainless steel screws. Locate the tag inside pole and visible from handhole. Include the following information:
 - Financial Project ID,
 - Pole Height
 - Manufacturer's Name
 - Yield Strength (Fy of Steel)
 - Pole Base Wall Thickness
- H. Except for Anchor Bolts, all bolt hole diameters are equal to the bolt diameter plus 1/16", prior to galvanizing. Hole diameters for anchor bolts are not exceed the bolt diameter plus 1/2".

5. Pole Installation:


- A. Do not install additional wire access holes (not shown in this Index) with a diameter that exceeds 1 1/2" in diameter.
- B. Install Anchor Bolts in accordance with Specification 649-5
- C. Cable Supports: Electrical Cable Guides and Eyebolts.
 - a. Locate top and bottom cable guides within the pole aligned with each other.
 - b. Position one cable guide 2" below the handhole.
 - c. Position other cable guide 1" directly below the top of the tenon.
 - d. Position Park Stands 2" below the top of the handhole.

6. Cabinet Installation:

- A. Splice fiber optic cables in cabinet to preterminator patch panel.
- B. Furnish and install TVSS protection on all cabling in cabinet.
- C. Furnish and install secondary TVSS protection on outlets for equipment in cabinet.
- D. Ensure that all electronic equipment power is protected and conditioned with TVSS devices.
- E. Ensure that equipment cabinet is bonded to CCTV pole grounding system.
- F. Install the pole mounted cabinet with the hinges next to the pole.
- G. Sizes and types of conduits and innerducts for network communications between the pullbox and cabinet are stated in the Contract Documents.


7. Lowering Device Installation:

- A. Place the lowering cable that moves within the pole in an interior conduit to prevent it from tangling or interfering with any electrical wire that is in the pole. Ensure that any electrical wire within the pole is routed securely and free from slack.
- B. Mount lowering device perpendicular to the roadway or as shown in the plans. Position CCTV pole so that the camera can be safely lowered without requiring lane closures.
- C. Coordinate all lowering device hardware requirements (including Tenon, Tenon mounting plates, parking stands, etc.) with lowering device manufacturer.

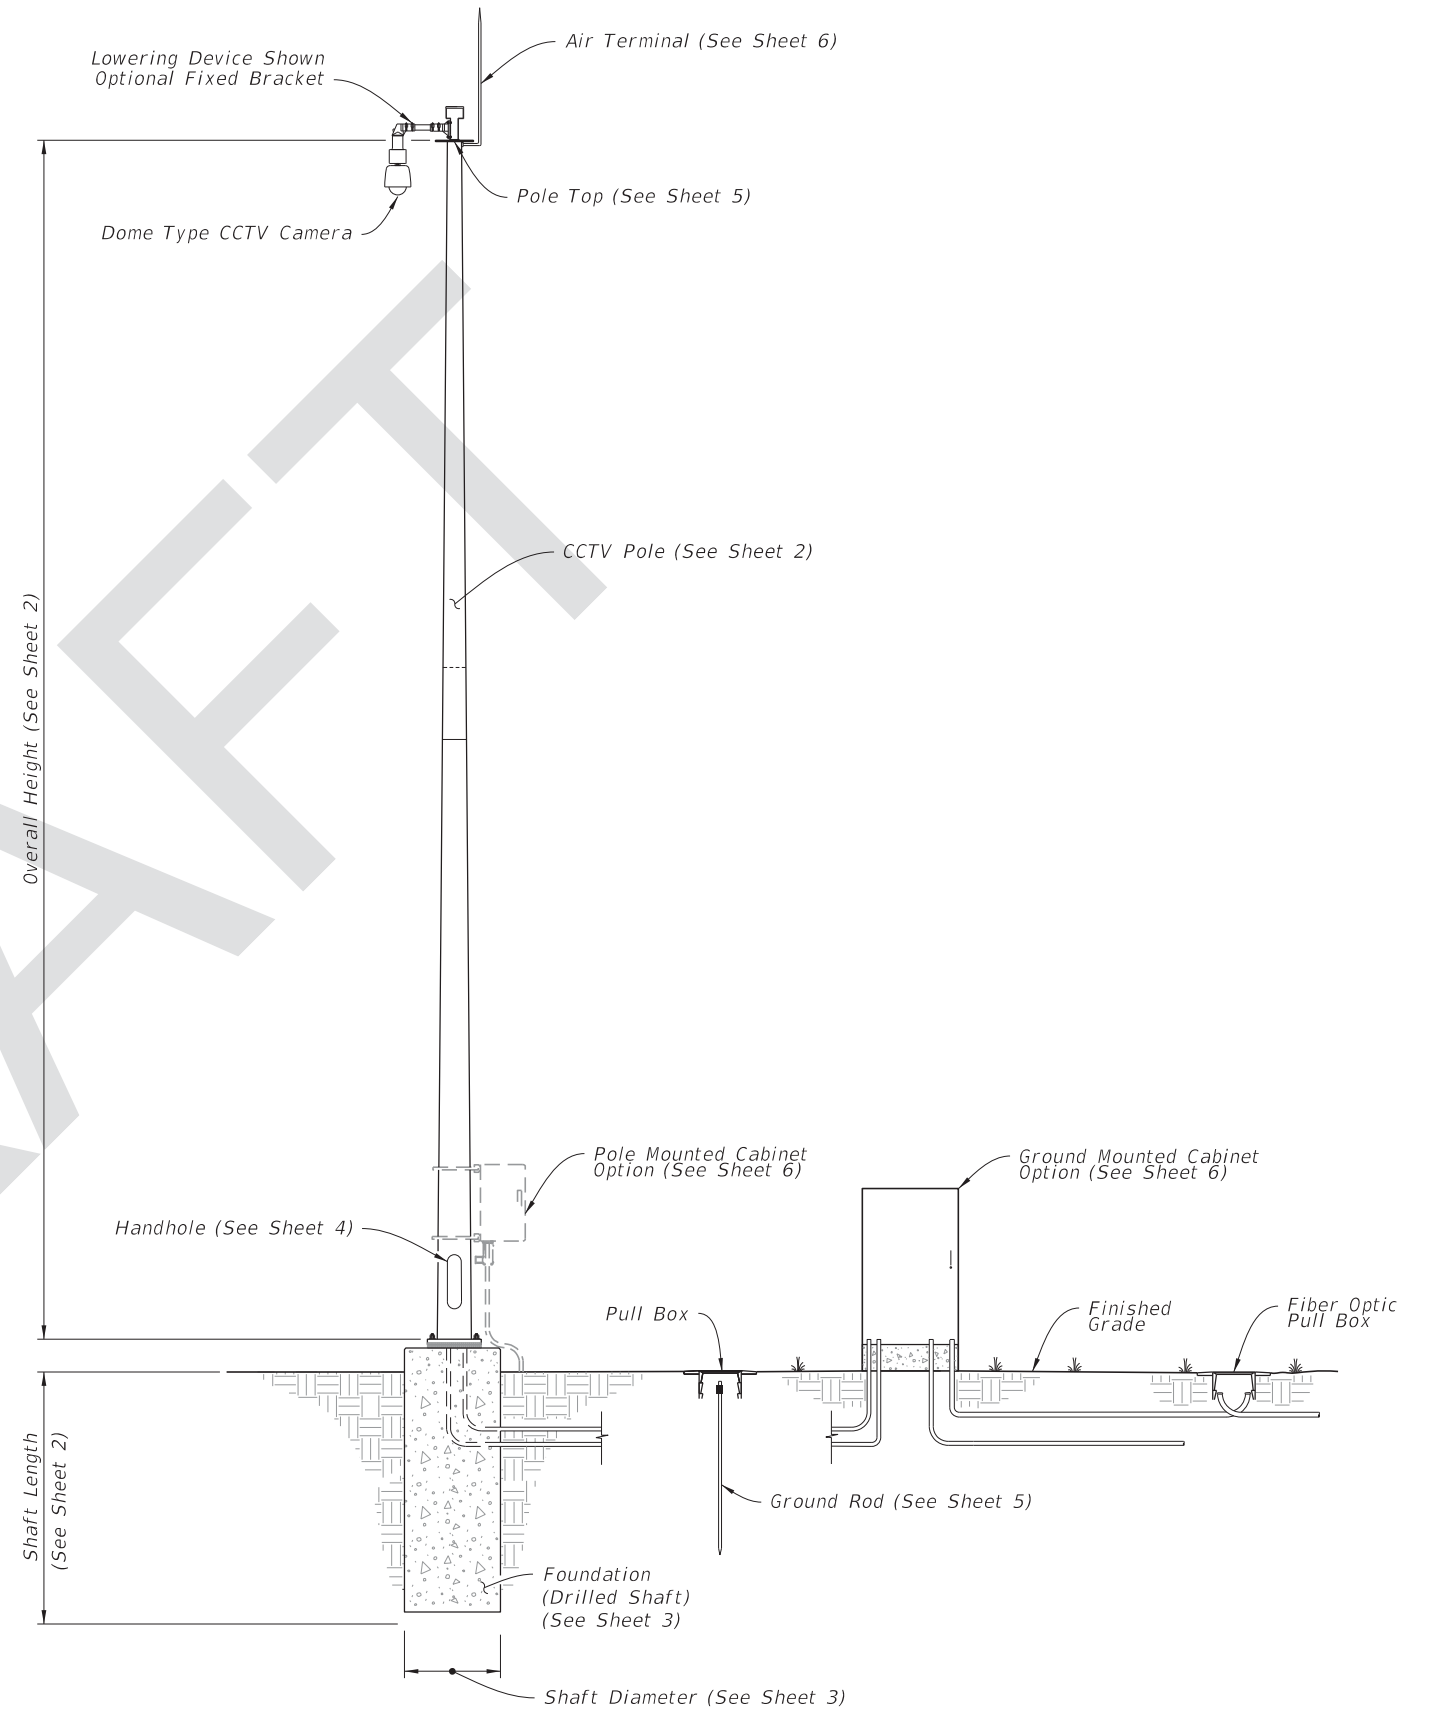

STEEL CCTV POLE ASSEMBLY

8/28/2017 8:00:38 AM

LAST REVISION 11/01/17	REVISION	DESCRIPTION:	 FY 2018-19 STANDARD PLANS	STEEL CCTV POLE	INDEX 649-020	SHEET 1 of 6
---------------------------	----------	--------------	---	-----------------	------------------	-----------------

GENERAL NOTES:

1. Work this Index with Specification 649.

2. This Index is considered fully detailed and no shop drawings are necessary. Submit Shop Drawings for minor modifications not detailed in the Plans.

3. Materials:

- A. Pole: ASTM A1011 Grade 50, 55, 60 or 65 (less than 1/4") or ASTM A572 Grade 50, 60 or 65 (greater than or equal to 1/4") or ASTM A595 Grade A (55 ksi yield) or Grade B (60 ksi yield).
- B. Steel Plates and Pole Cap: ASTM A36 or ASTM A709 Grade 50.
- C. Weld Metal: E70XX.
- D. Bolts: ASTM F3125, Grade A325, Type 1.
Nuts: ASTM A563.
Washers: ASTM F-436.
- E. Anchor Bolts: ASTM F1554 Grade 55 with ASTM A563 Grade A heavy-hex nuts and plate washers. ASTM F2329 galvanization.
- F. Handhole Frame: ASTM A709 Grade 36 or ASTM A36.
- G. Handhole Cover: ASTM A1011 Grade 50, 55, 60 or 65.
- H. Stainless Steel Screws: AISI Type 316.
- I. Reinforcing Steel: ASTM A615 Grade 60.
- J. Galvanization: Bolts, nuts and washers: ASTM F2329 All other steel: ASTM A123
- K. Concrete: Class IV (Drilled Shaft) for all environment classifications.

4. Pole Fabrication:

- A. Provide either a round or 16 sided pole with a constant taper of 0.14 inches per foot
- B. Pole shaft may be either One or Two sections (with telescopic field splice)
- C. Up to two longitudinal seam welds are permitted.
- D. Use only circumferential welds at base.
- E. Use a complete penetraton weld for longitudinal seam welds within 6" of circumferential welds. Use a complete penetraton weld on female section of telescopic field splices, splice length plus six inches. All other areas, size the partial penetration welds to at least 60% of the pole tube thickness.
- F. Perform all welding in accordance with the American Welding Society Structural Welding Code (Steel) ANSI/AWS D1.1 (current edition). For additional welding requirements see AASHTO Standard Specifications for Structural Supports for Highway Signs, Luminaires and Traffic Signals, Section 5.15, Welded Connections.
- G. Provide a 2"x4" (Max.) aluminum identification tag on the pole. Secured tag to pole with stainless steel screws. Locate the tag inside pole and visible from handhole. Include the following information:

Financial Project ID,
Pole Height
Manufacturer's Name
Yield Strength (Fy of Steel)
Pole Base Wall Thickness

H. Except for Anchor Bolts, all bolt hole diameters are equal to the bolt diameter plus 1/16", prior to galvanizing. Hole diameters for anchor bolts are not exceed the bolt diameter plus 1/2".

5. Pole Installation:


- A. Do not install additional wire access holes (not shown in this Index) with a diameter that exceeds 1 1/2" in diameter.
- B. Install Anchor Bolts in accordance with Specification 649-5
- C. Cable Supports: Electrical Cable Guides and Eyebolts.
 - a. Locate top and bottom cable guides within the pole aligned with each other.
 - b. Position one cable guide 2" below the handhole.
 - c. Position other cable guide 1" directly below the top of the tenon.
 - d. Position Park Stands 2" below the top of the handhole.

6. Cabinet Installation:

- A. Splice fiber optic cables in cabinet to preterminater patch panel.
- B. Furnish and install TVSS protection on all cabling in cabinet.
- C. Furnish and install secondary TVSS protection on outlets for equipment in cabinet.
- D. Ensure that all electronic equipment power is protected and conditioned with TVSS devices.
- E. Ensure that equipment cabinet is bonded to CCTV pole grounding system.
- F. Install the pole mounted cabinet with the hinges next to the pole.
- G. Sizes and types of conduits and innerducts for network communications between the pullbox and cabinet are stated in the Contract Documents.

7. Lowering Device Installation:

- A. Place the lowering cable that moves within the pole in an interior conduit to prevent it from tangling or interfering with any electrical wire that is in the pole. Ensure that any electrical wire within the pole is routed securely and free from slack.
- B. Mount lowering device perpendicular to the roadway or as shown in the plans. Position CCTV pole so that the camera can be safely lowered without requiring lane closures.
- C. Coordinate all lowering device hardware requirements (including Tenon, Tenon mounting plates, parking stands, etc.) with lowering device manufacturer.

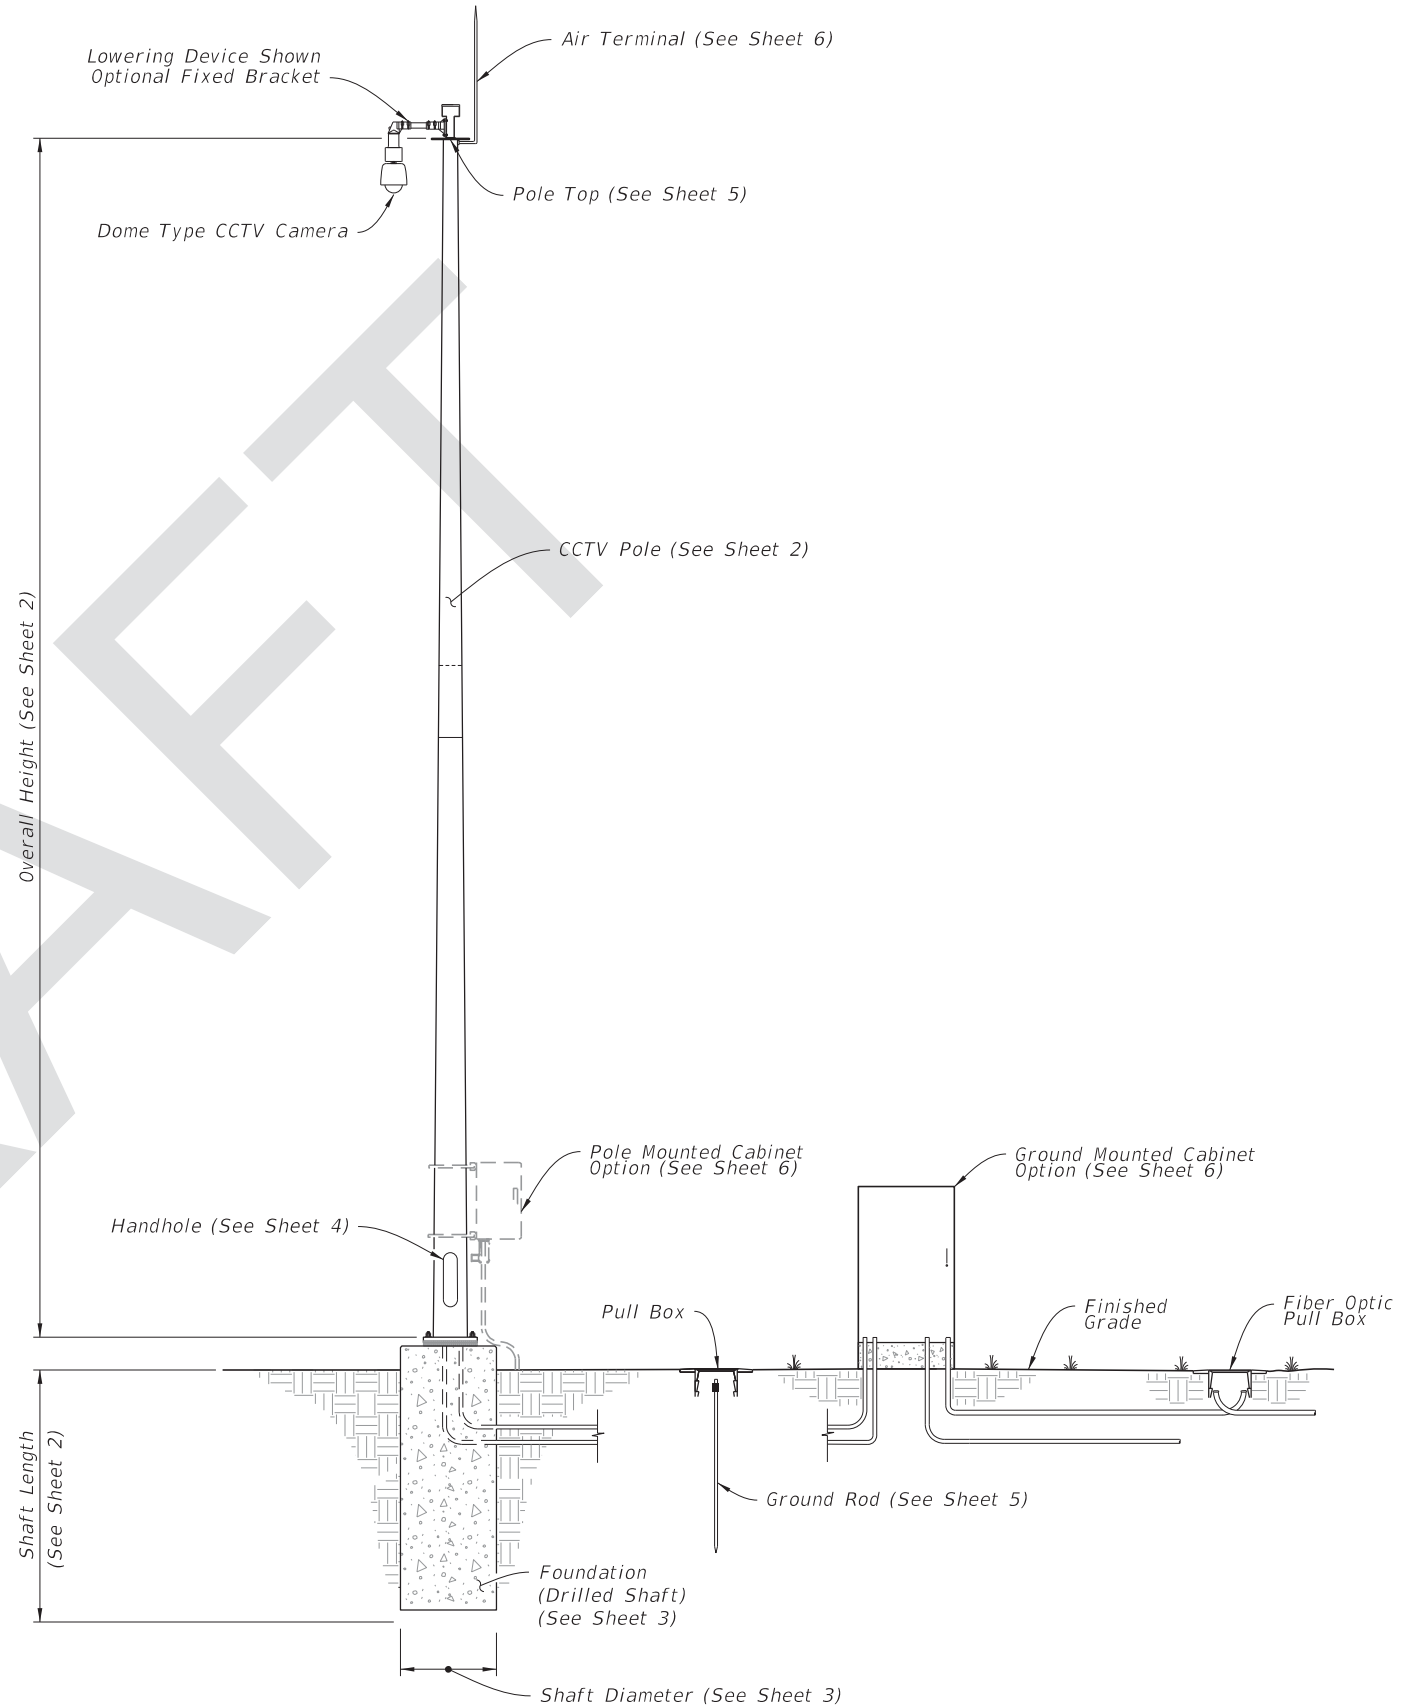

STEEL CCTV POLE ASSEMBLY

8:08:40 AM
9/18/2017

LAST REVISION 11/01/17	REVISION	DESCRIPTION:	 FY 2018-19 STANDARD PLANS	STEEL CCTV POLE	INDEX 649-020	SHEET 1 of 6
---------------------------	----------	--------------	---	-----------------	------------------	-----------------