



**WIND BEAM CONNECTION NOTES:**

1.  $\frac{5}{16}$ "  $\varnothing$  Stainless Steel Hex **Changed to 2"** under Head and Lockwasher under Nut may be used in lieu of  $\frac{3}{8}$ "  $\varnothing$  Aluminum Button Head Bolts.
2. Use Nylon washers (provided by the sheeting supplier) under the button bolt heads to protect sign sheeting.
3. Slots up to 1" long are allowed in wind beams to accommodate U-Bolts for varying Column (Post) diameters.
4. Wind beams may be oriented in either direction.

BRACKET DETAIL

WIND BEAM CONNECTIONS DETAILS


SECTION A-A

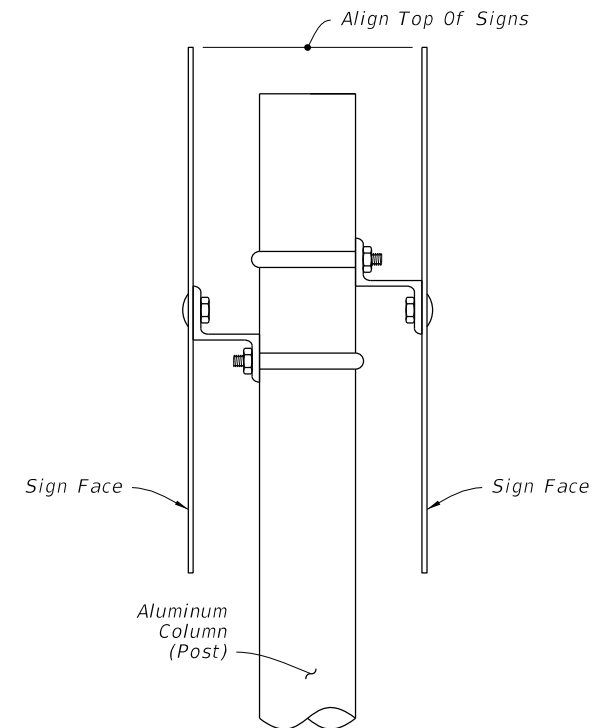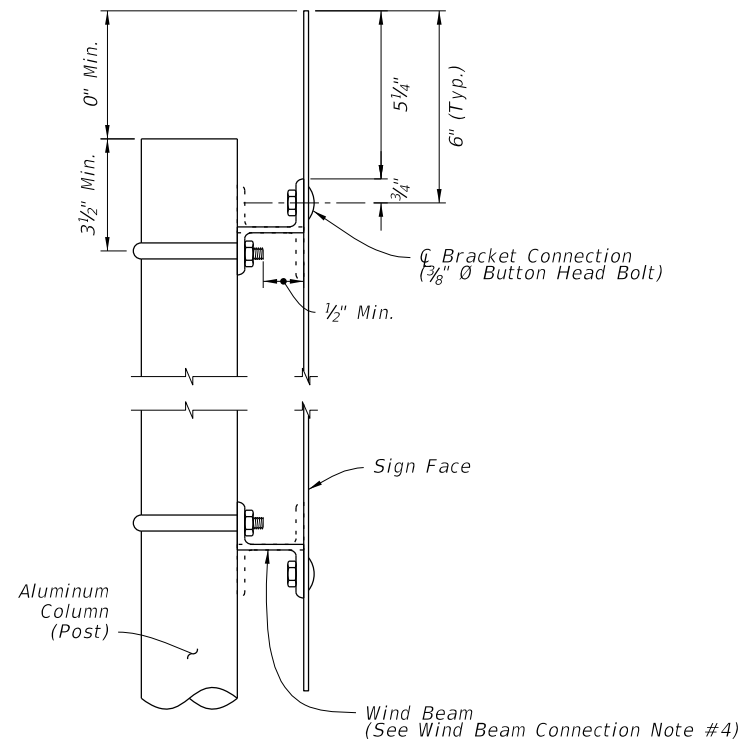


**BACK-TO-BACK SIGN NOTE:**

Use the area and the centroid location of the largest sign to determine aluminum column (post) size.


BACK-TO-BACK SIGN DETAIL

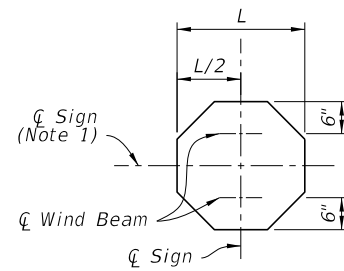


STOP

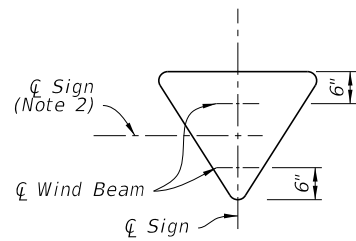


YIELD

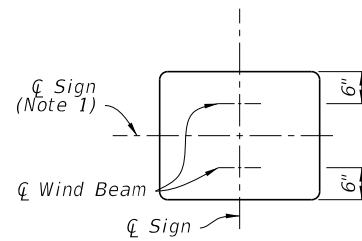


RECTANGLE

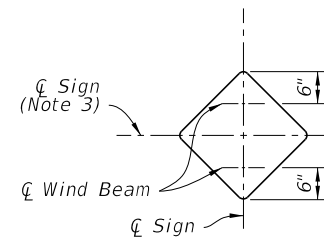


DIAMOND

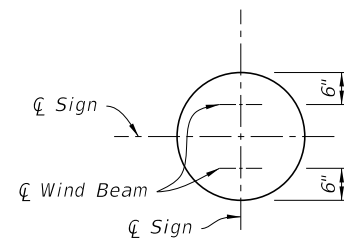


RAILROAD

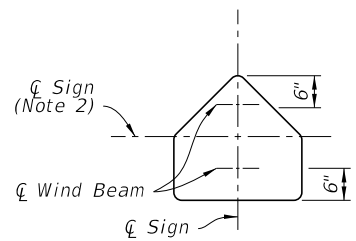

SCHOOL

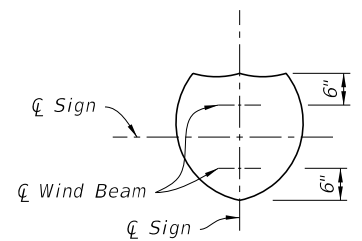

SHIELD

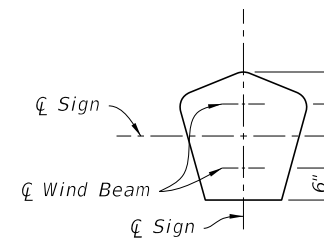

COUNTY

WIND BEAM PLACEMENT DETAILS

**WIND BEAM PLACEMENT NOTES:**

1. Install an additional third wind beam along the  $\varnothing$  for signs with heights greater than 30" and less than 72". For rectangular signs greater than 72" maintain a maximum wind beam spacing of 2'-6", with the additional wind beams spaced evenly between the top and bottom wind beams. For rectangular signs up to 12" in height, use only one wind beam at  $\varnothing$  Sign.
2. Install an additional third wind beam along the  $\varnothing$  for Yield and School signs greater than 36".
3. Install an additional third wind beam along the  $\varnothing$  for Diamond signs 30" or greater.

**CONNECTION AND WIND BEAMS**

4/11/2016 2:15:34 PM

LAST REVISION 01/01/16	DESCRIPTION:		FY 2016-17 DESIGN STANDARDS	SINGLE COLUMN GROUND SIGNS	INDEX NO. 11860	SHEET NO. 6 of 9
REVISION						