



TYPICAL POST

STANDARD POST REINFORCEMENT

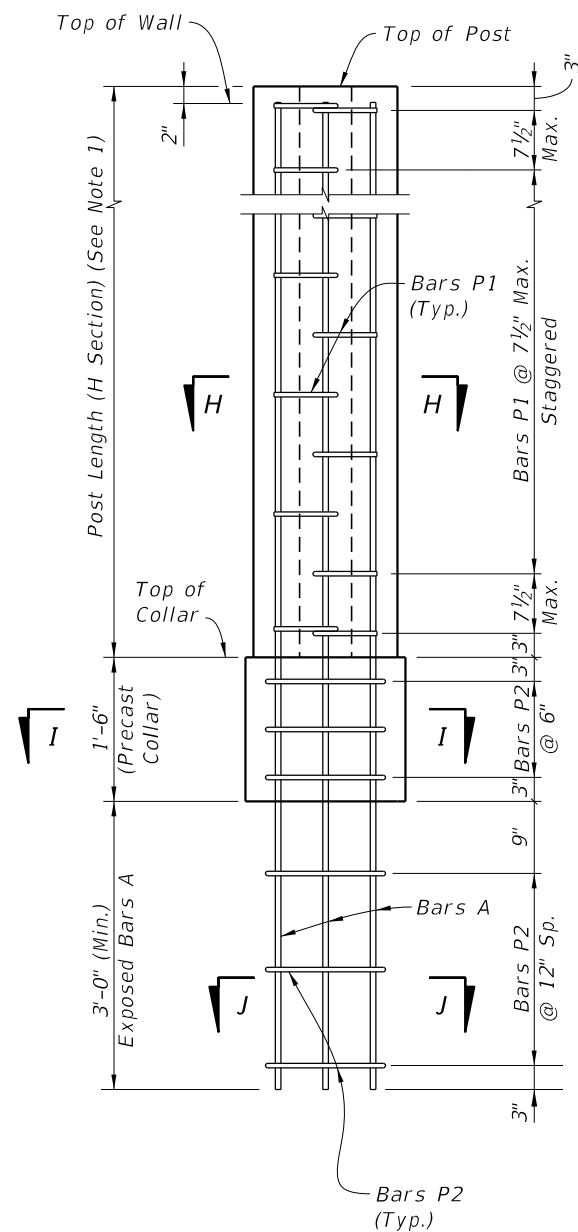


LOW CLEARANCE OPTION

NOTES:
1. See Shop Drawing for Post Lengths.

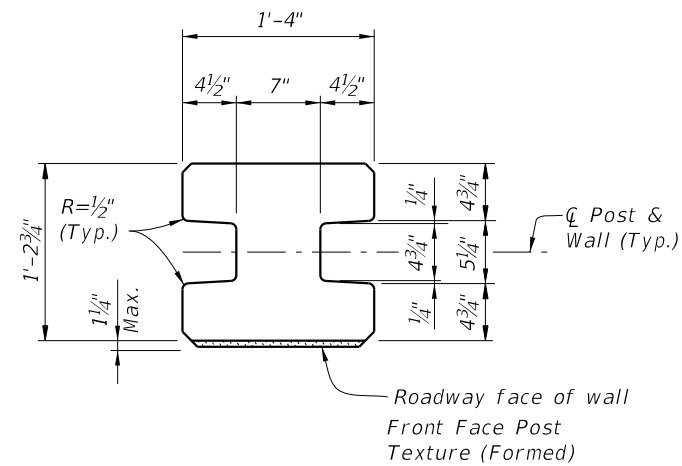


TYPICAL POST SECTION (H Section)

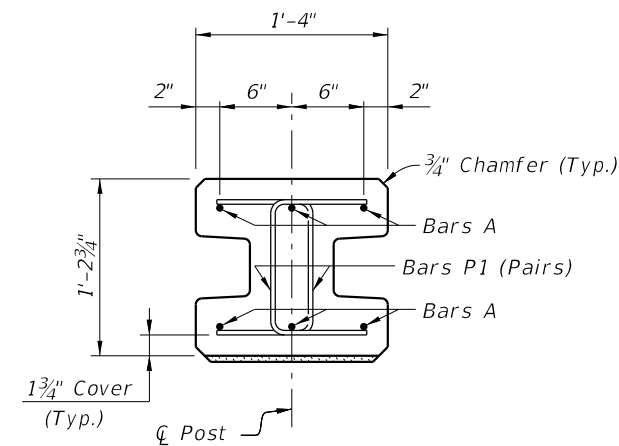


SECTION H-H (H Section - Above Collar)




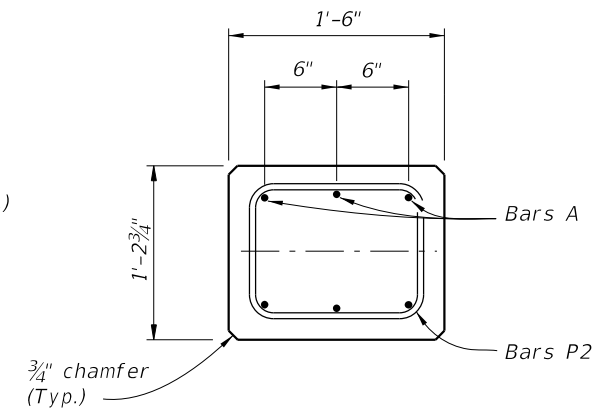

SECTION I-I Precast Collar

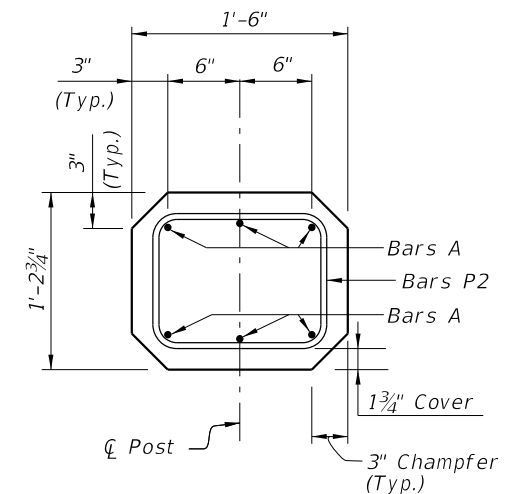

SECTION I-I (for Low Clearance Option)

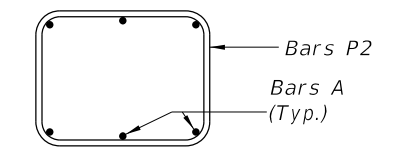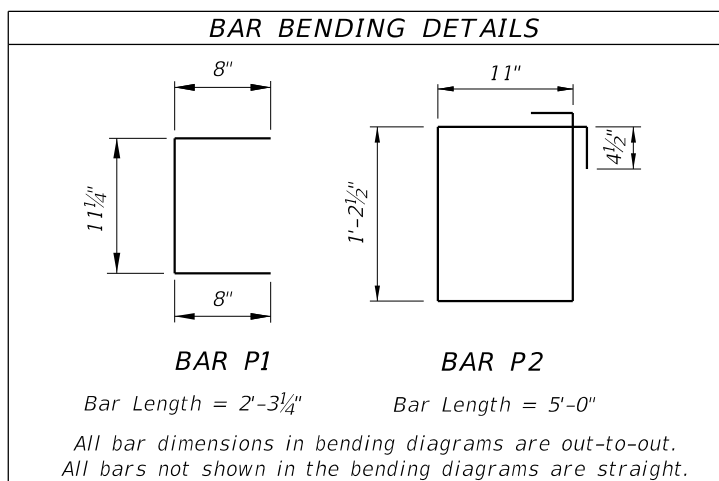

SECTION J-J

PRECAST OPTION - STANDARD POST DETAILS

10/26/2016 8:39:21 AM

LAST REVISION	DESCRIPTION:
11/01/16	