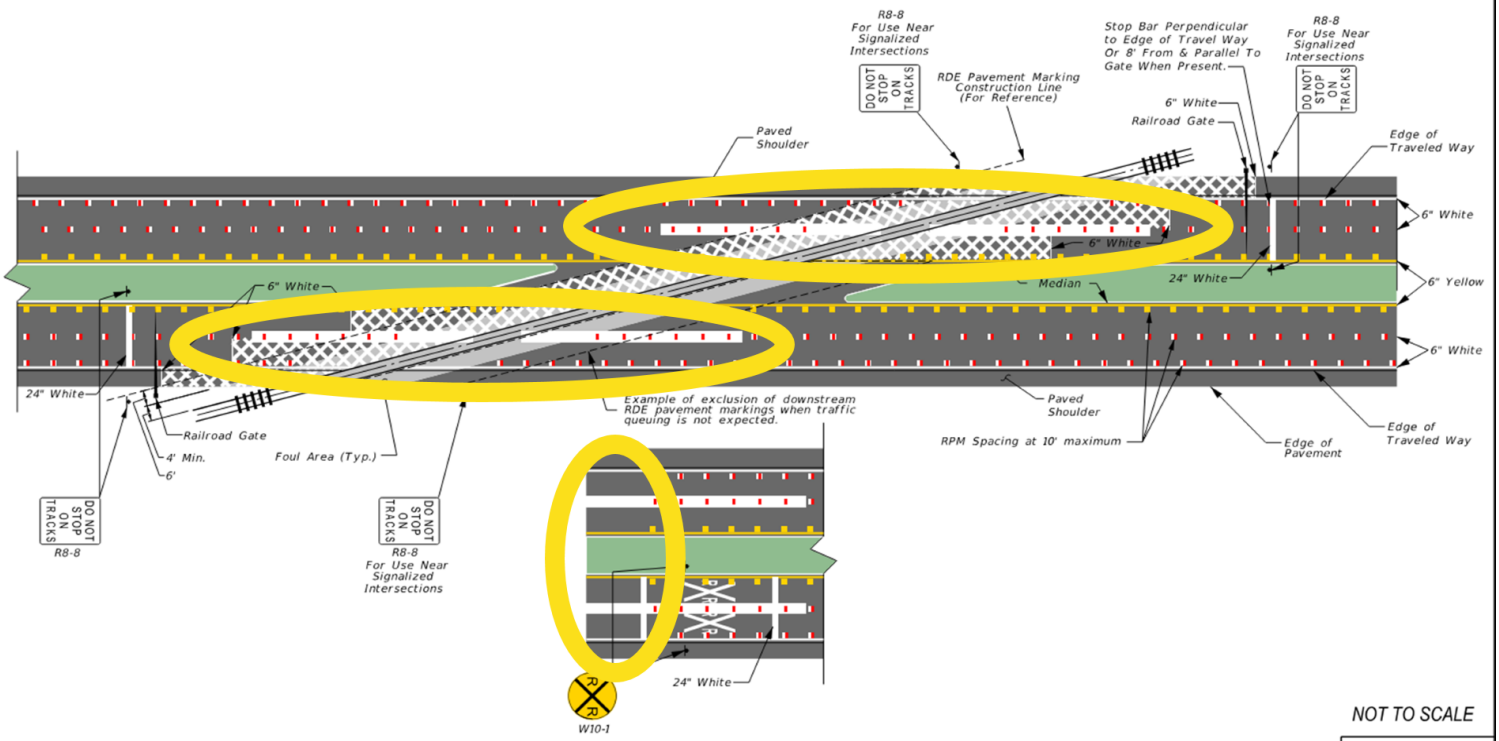

Dimensions not shown for clarity, see Exhibit 220-1.

EXHIBIT 220-4