

CONTRACT PLANS COMPONENTS

ROADWAY
SIGNING AND PAVEMENT MARKING
SIGNALIZATION
INTELLIGENT TRANSPORTATION SYSTEMS
LIGHTING
LANDSCAPE
ARCHITECTURAL
STRUCTURES
TOLL FACILITIES
UTILITY WORK BY HIGHWAY CONTRACTOR PLANS

INDEX OF ROADWAY PLANS

| SHEET NO. | SHEET DESCRIPTION |
|-----------|---------------------------------|
| 1 | KEY SHEET |
| 2 | SIGNATURE SHEET |
| 3 | DRAINAGE MAP |
| 4 - 5 | TYPICAL SECTIONS |
| 6 | TYPICAL SECTION DETAILS |
| 7 - 9 | MODEL MANAGEMENT |
| 10 | PROJECT CONTROL |
| 11 | GENERAL NOTES |
| 12 - 14 | ROADWAY PLAN-PROFILE |
| 15 - 16 | TRAFFIC MONITORING SITE |
| 17 | SPECIAL DETAILS |
| 18 - 19 | DRAINAGE NETWORK PLAN |
| 20 - 21 | DRAINAGE NETWORK PROFILE |
| 22 | DRAINAGE NETWORK CROSS SECTIONS |
| 23 | OPTIONAL MATERIALS TABULATION |
| 24 | DRAINAGE SPECIAL DETAILS |
| 25 - 34 | ROADWAY CROSS SECTIONS |
| 35 - 38 | VERIFIED UTILITY LOCATE |
| 39 - 46 | TEMPORARY TRAFFIC CONTROL PLAN |
| 47 - 52 | UTILITY ADJUSTMENTS |
| 53 - 56 | SELECTIVE CLEARING AND GRUBBING |
| 57 | MISCELLANEOUS STRUCTURES |
| GR-1* | ROADWAY SOIL SURVEY |
| GR-2* | REPORT OF CORE BORINGS |

* These sheets are included in the Index of Roadway Plans only to indicate that they are part of the Roadway Plans. These sheets are contained in a separate digitally signed and sealed document.

DEVELOPMENTAL STANDARD PLANS (DSPs):

D591-001 LANDSCAPE IRRIGATION SLEEVES

GOVERNING STANDARD PLANS:

Florida Department of Transportation, FY2026-27 Standard Plans for Road and Bridge Construction and applicable Interim Revisions (IRs).

Standard Plans for Road Construction and associated IRs are available at the following website: <http://www.fdot.gov/design/standardplans>

APPLICABLE IRs: IR536-001-01, IR521-001-01

Standard Plans for Bridge Construction are included in the Structures Plans Component

GOVERNING STANDARD SPECIFICATIONS:

Florida Department of Transportation, FY2026-27 Standard Specifications for Road and Bridge Construction at the following website: <http://www.fdot.gov/programmanagement/Implemented/SpecBooks>


STATE OF FLORIDA
DEPARTMENT OF TRANSPORTATION

ROADWAY PLANS

FINANCIAL PROJECT ID 123456-1-52-01

WAKULLA COUNTY (59010)

STATE ROAD NO. 61 (US 319)
FROM SR 30 (US 98) TO NORTH OF ALASKA WAY
MISCELLANEOUS CONSTRUCTION

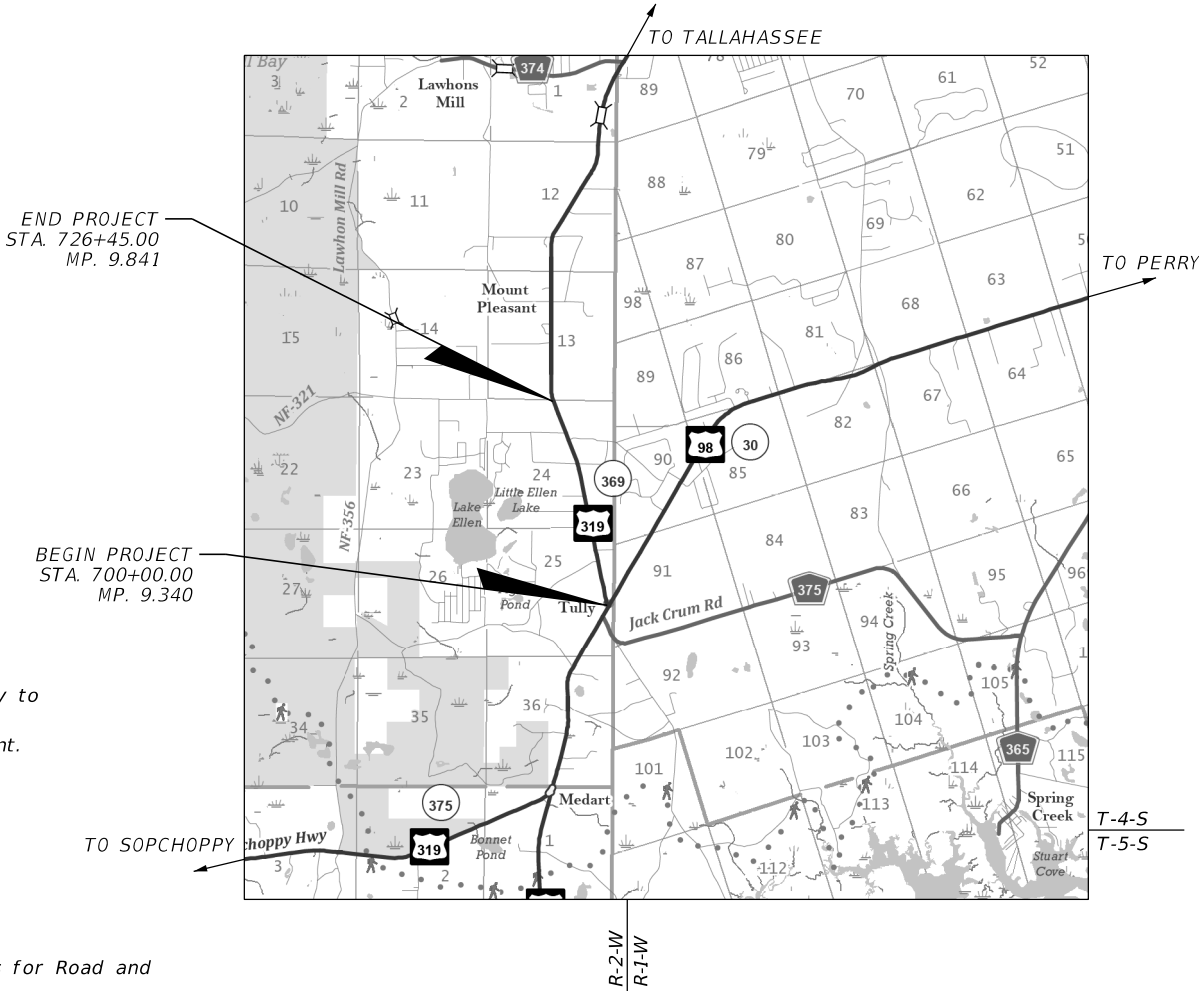

| REVISIONS: | |
|------------|--|
| 1 | FINANCIAL PROJECT ID 123456-1-52-01 Roadway Sheets 1, 2A, 5 & 19 (Revised 05-27-26) |

| KEY SHEET REVISIONS | |
|---------------------|--|
| DATE | DESCRIPTION |
| 05-27-26 | Added Sheet Number 2A to the Index and Revised Sheet Numbers 5 & 19. |

| CONSTRUCTION CONTRACT NO. | FISCAL YEAR | SHEET NO. |
|---------------------------|-------------|-----------|
| T0000 | 26 | 1 |

THIS PROJECT TO BE LET TO CONTRACT
WITH FINANCIAL PROJECT ID(S):
123456-1-56-01, 123457-1-52-01, 123457-1-56-01

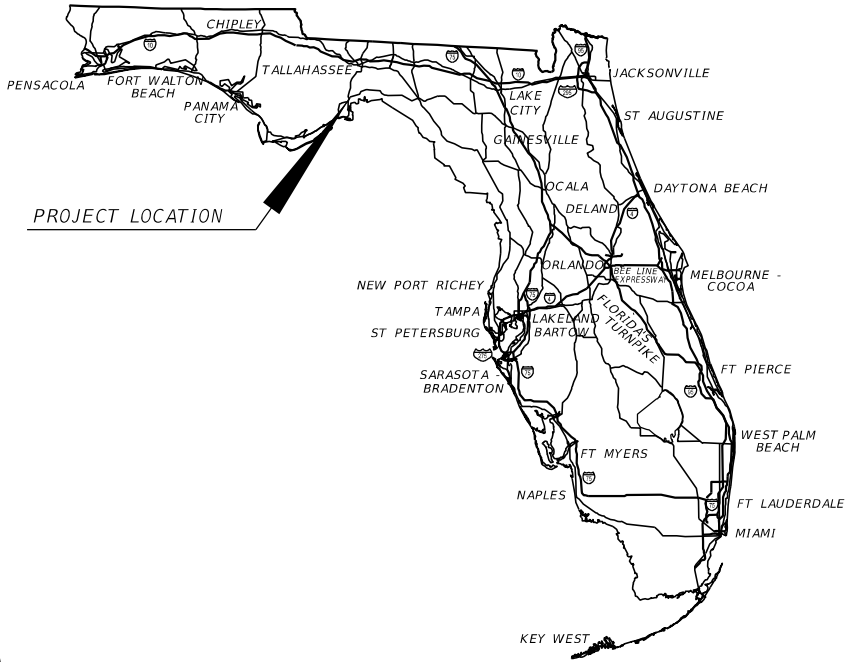


Exhibit 910-2
Revised Lead Key Sheet
Date: 1/1/2026

ROADWAY PLANS
ENGINEER OF RECORD:

JOE ENGINEER, P.E.
P.E. LICENSE NUMBER 12345
FLORIDA ENGINEERING, LLC.
PO BOX 125
ANYTOWN, FL 12345
850-123-4567
CONTRACT NO.: C0000
VENDOR NO.: 99-999999

FDOT PROJECT MANAGER:

JOHN SMITH, P.E.