

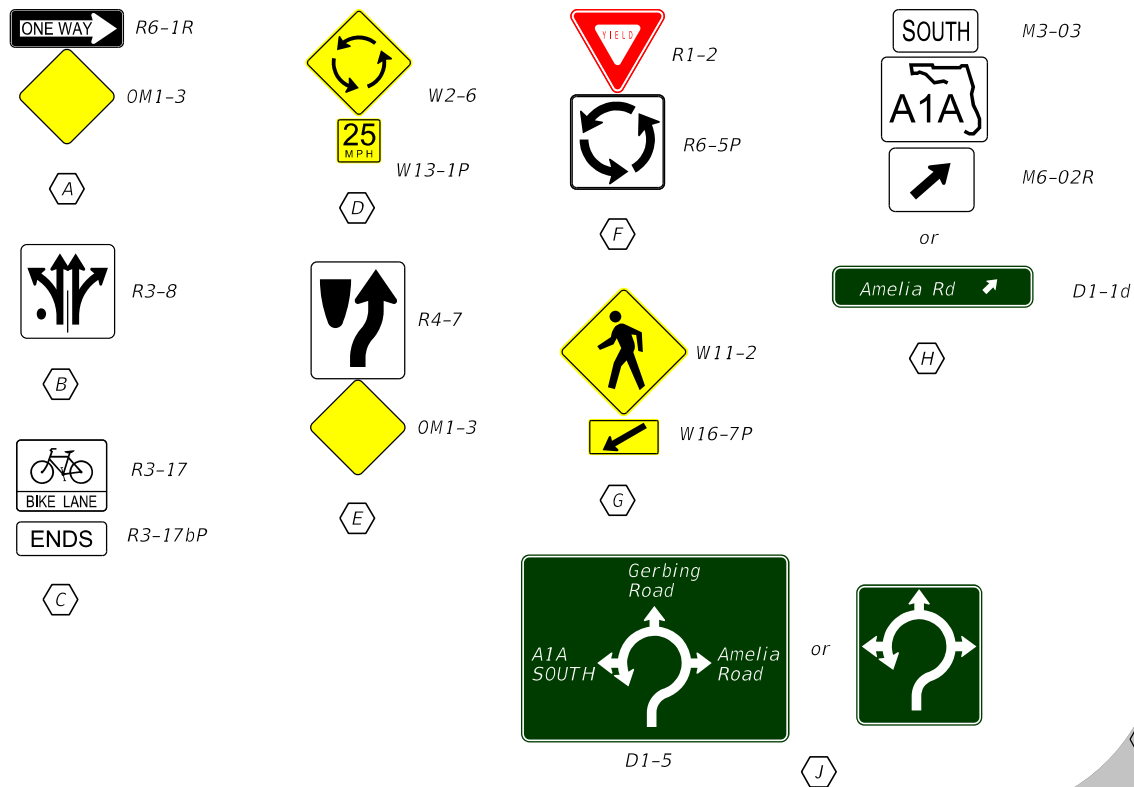


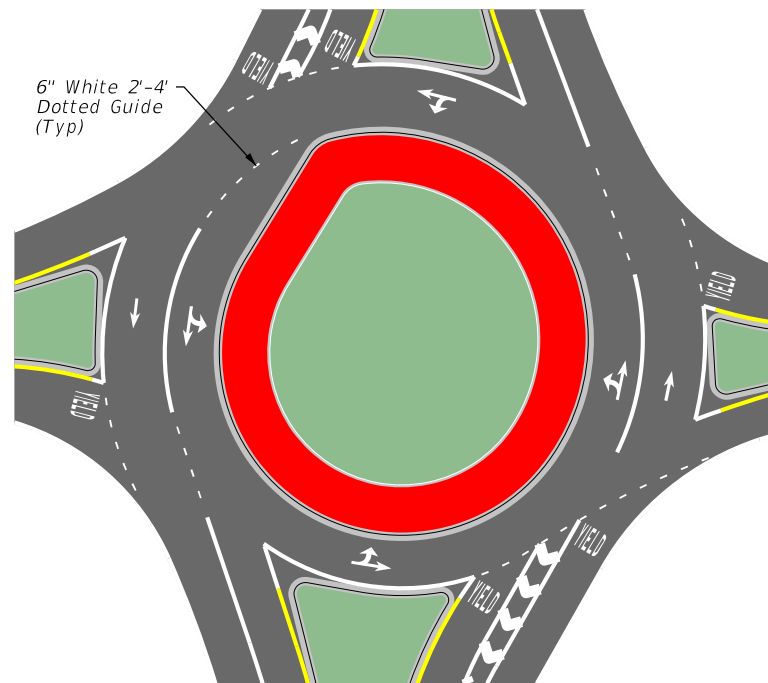

Posted Speed (MPH)	Typical Sign Location	
	Distance Between Signs (ft)	
	A (min)	B
55	800	200
50	700	200
45	600	200
40	500	200
35	400	200
30	300	200
25	150	200

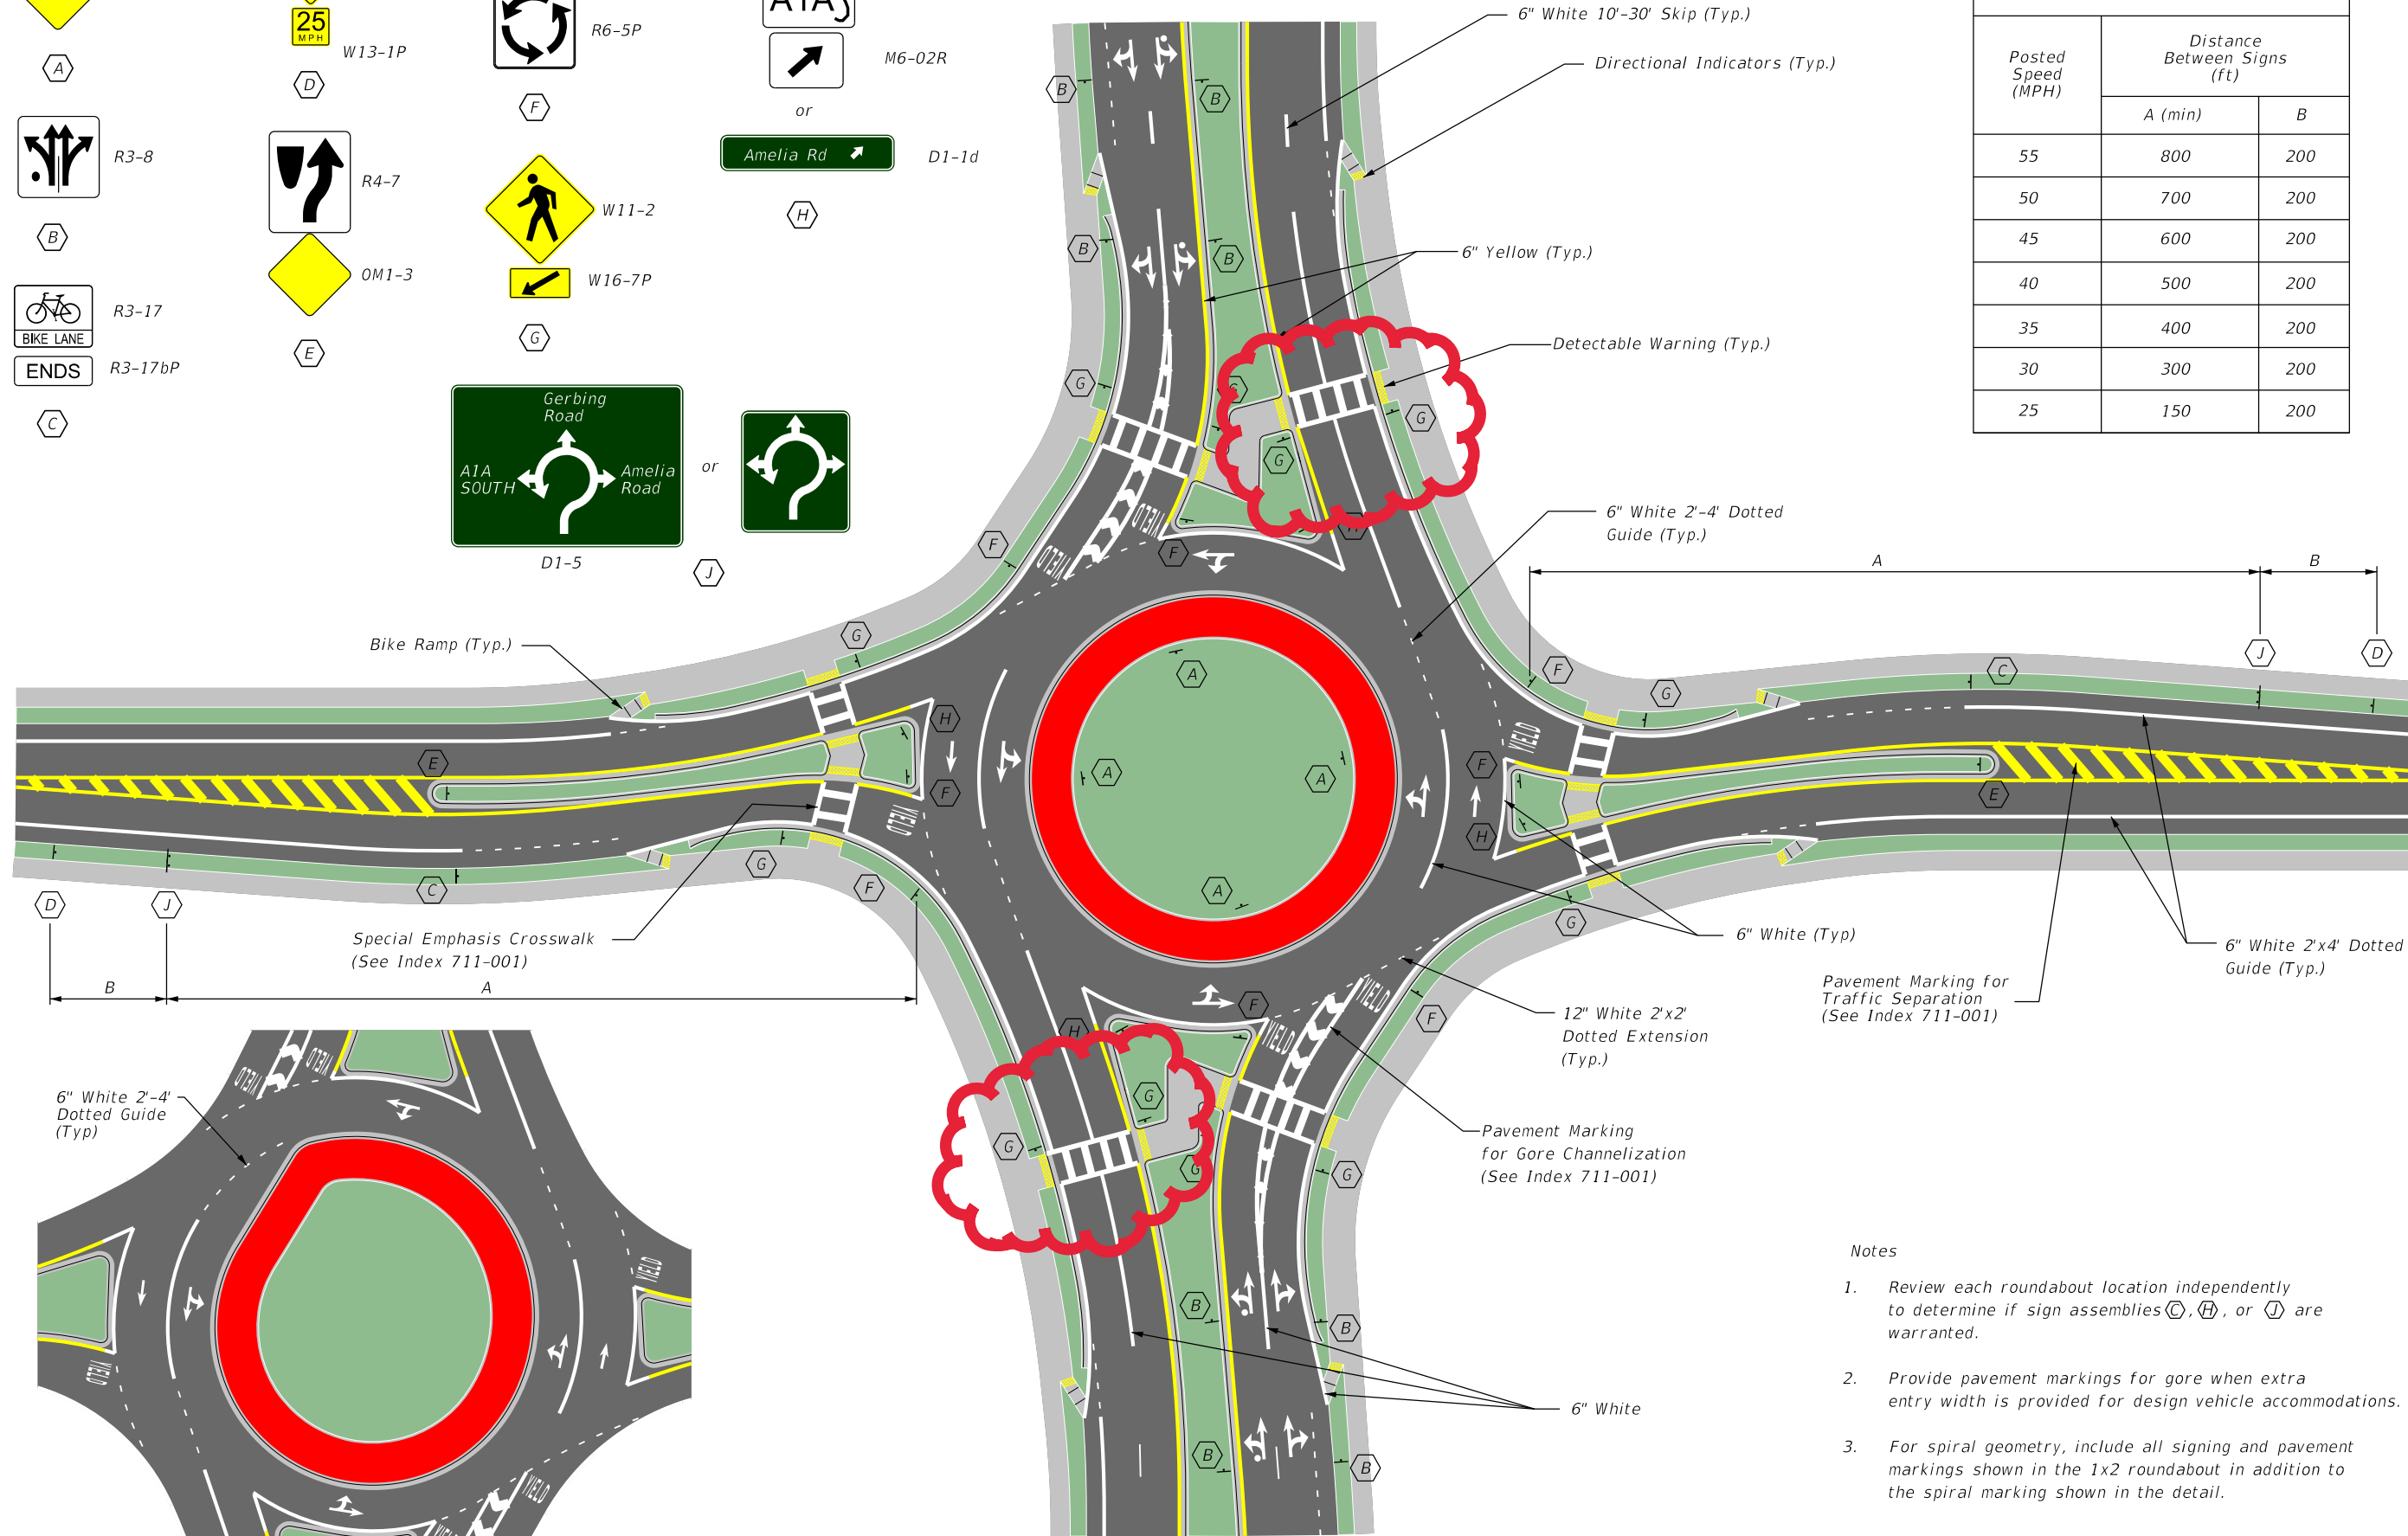

Notes

- Review each roundabout location independently to determine if sign assemblies **C**, **H**, or **J** are warranted.
- Provide pavement markings for gore when extra entry width is provided for design vehicle accommodations.
- For spiral geometry, include all signing and pavement markings shown in the 1x2 roundabout in addition to the spiral marking shown in the detail.

1x2 ROUNDABOUT SIGNING AND PAVEMENT MARKINGS

NOT TO SCALE

EXHIBIT 213-3
01/01/2026