


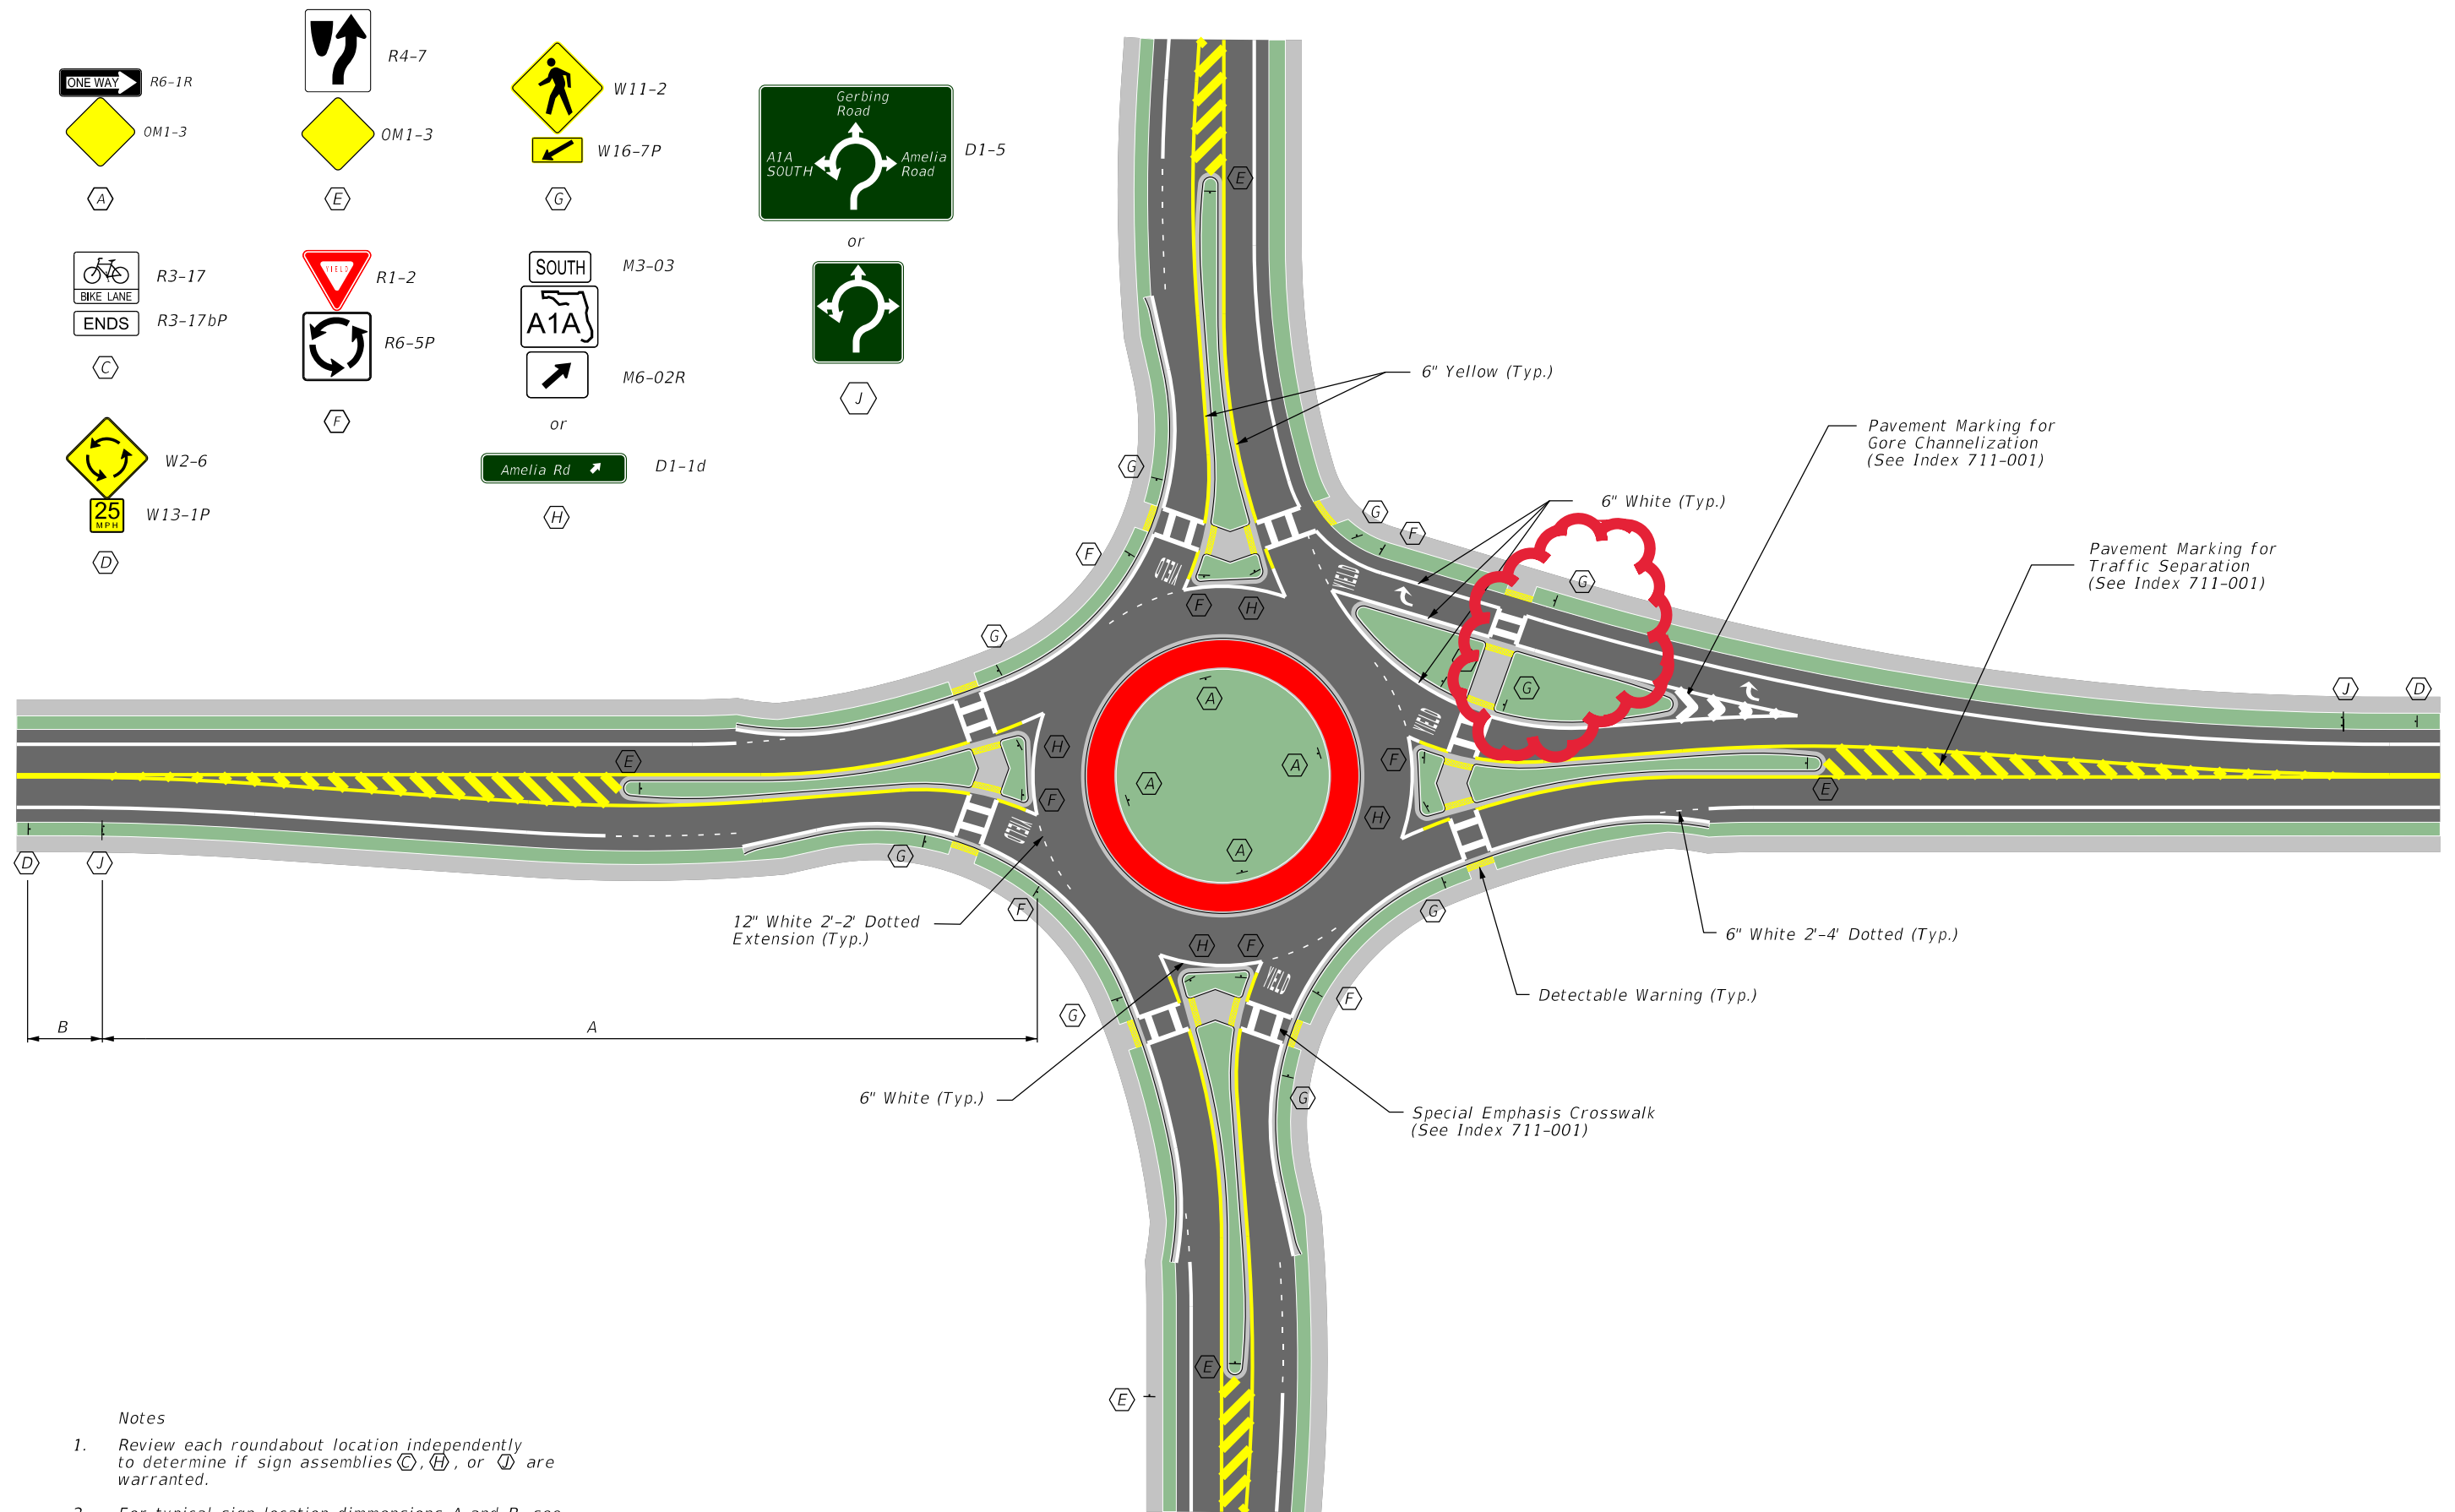

1X1 ROUNDABOUT WITH BYPASS LANE TYPICAL SIGNING AND PAVEMENT MARKINGS

NOT TO SCALE

EXHIBIT 213-4
01/01/2026