
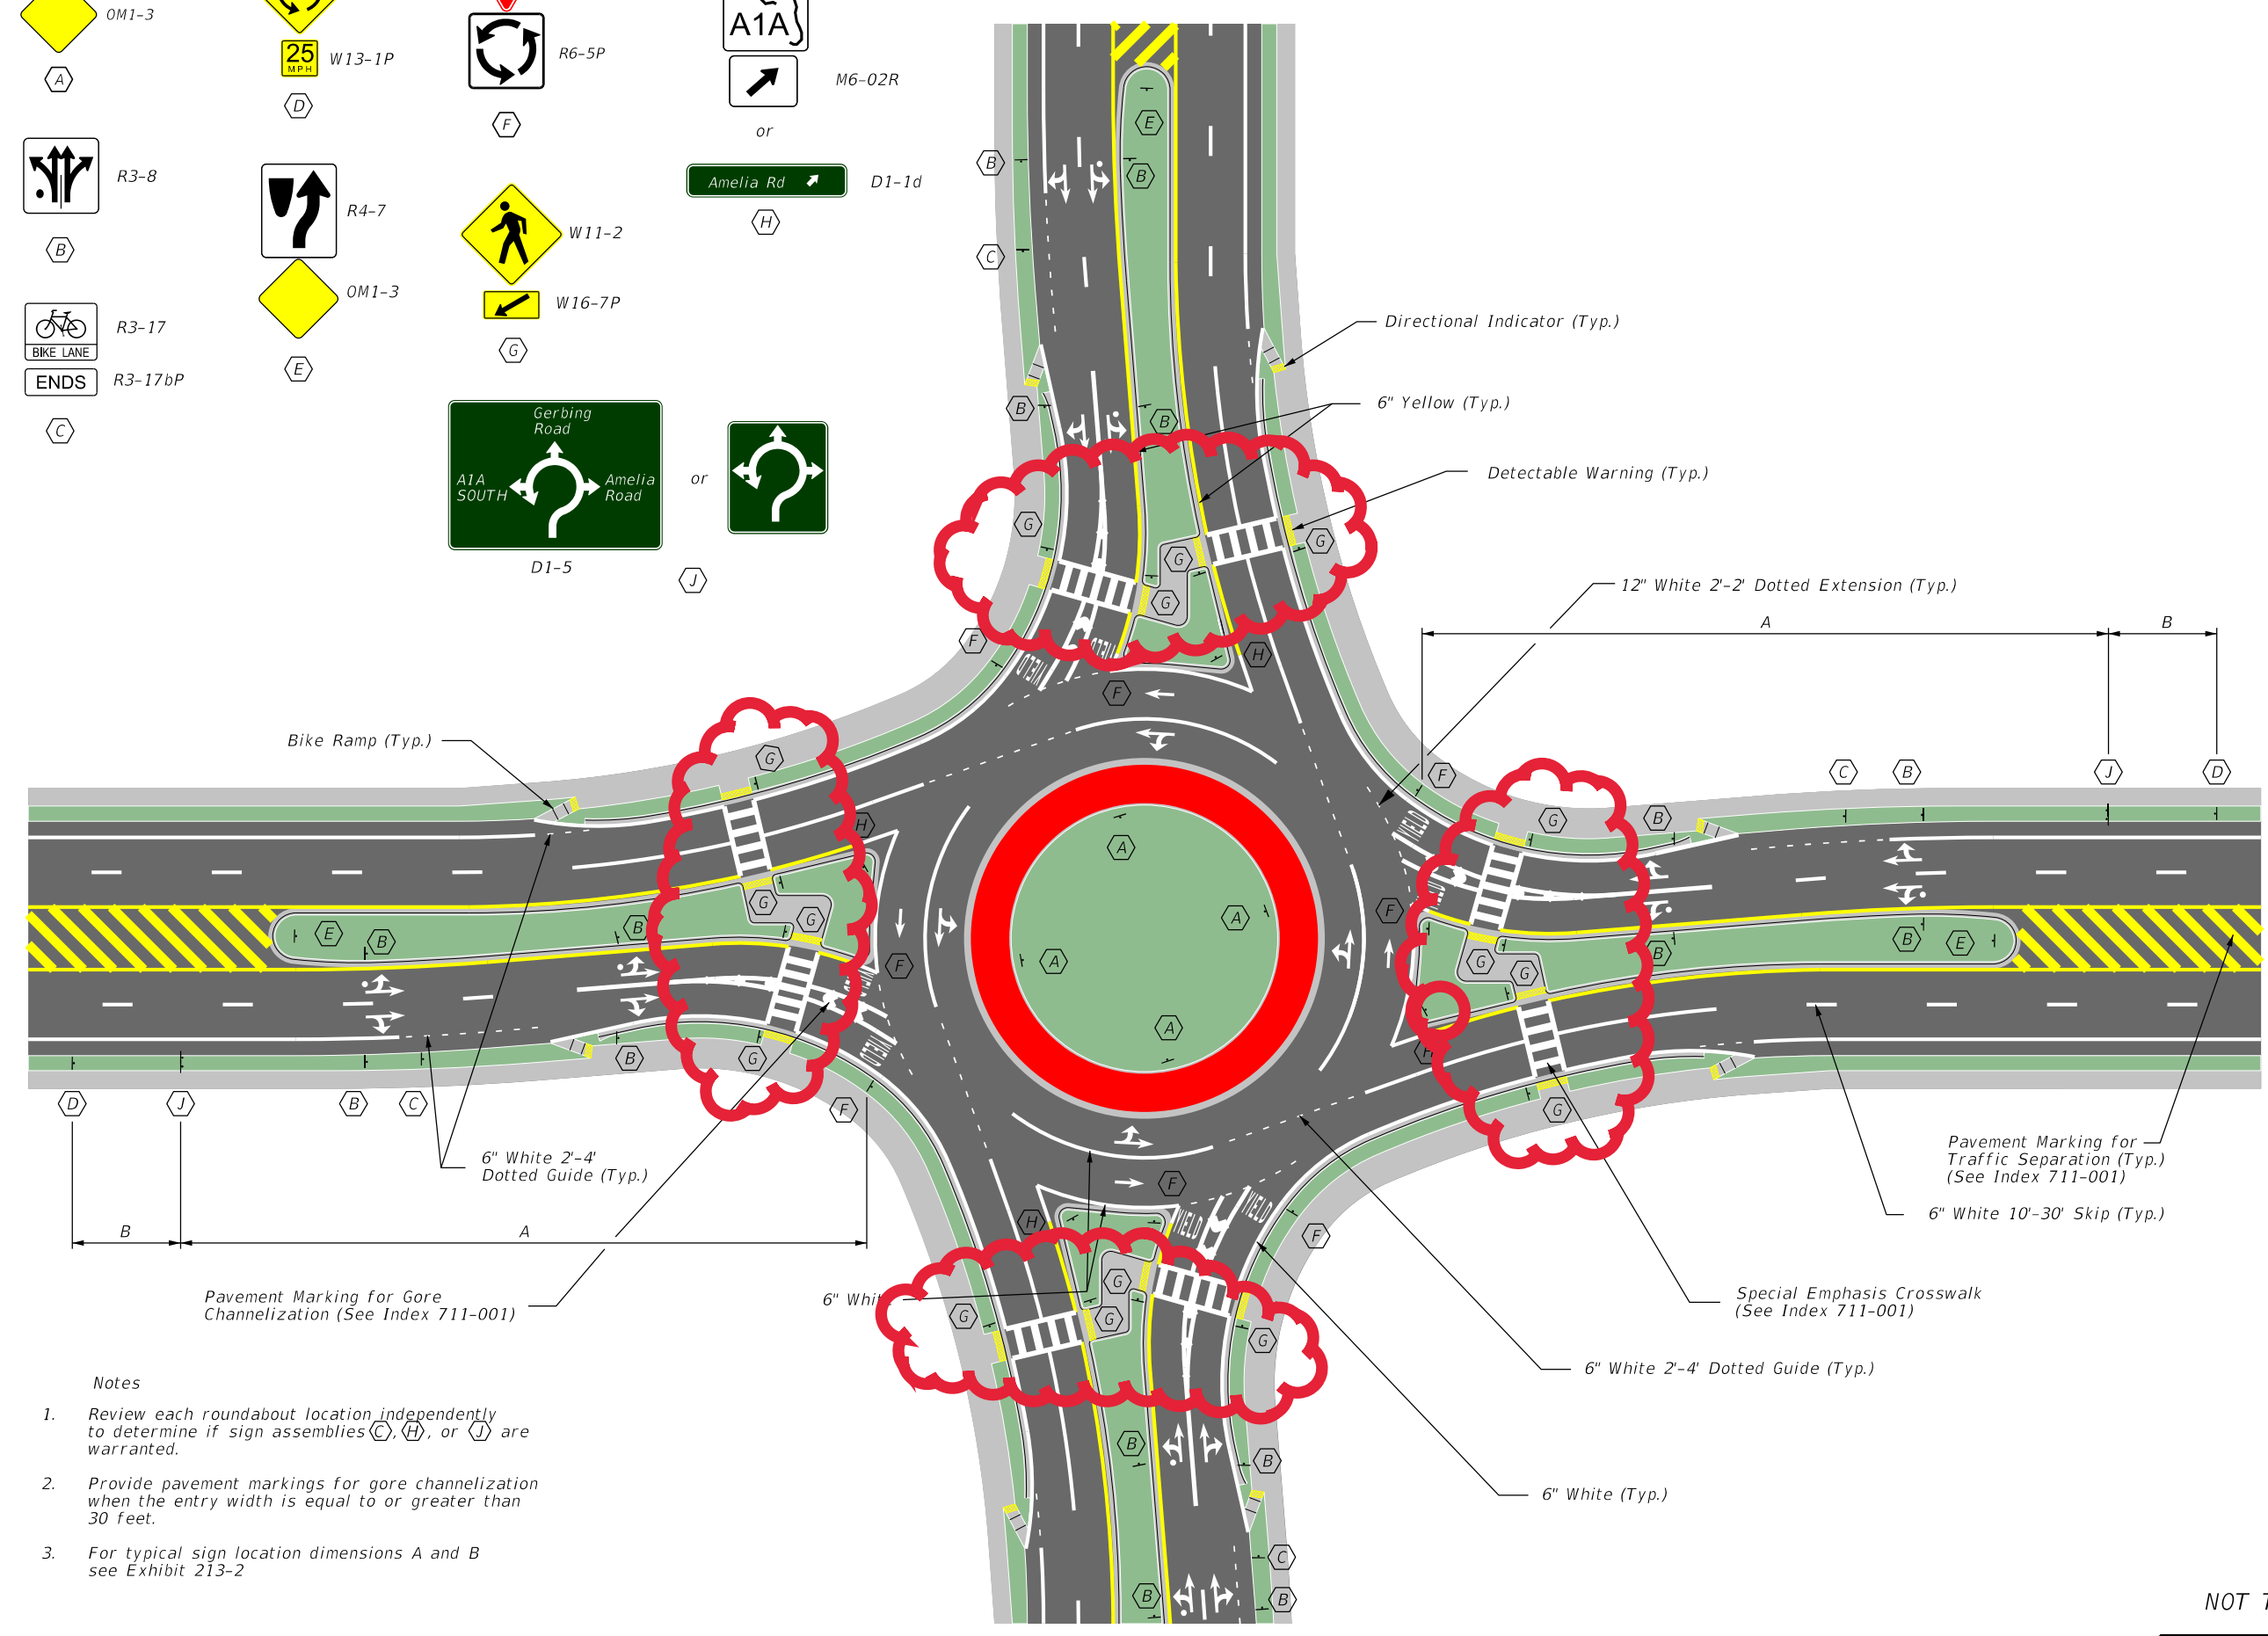


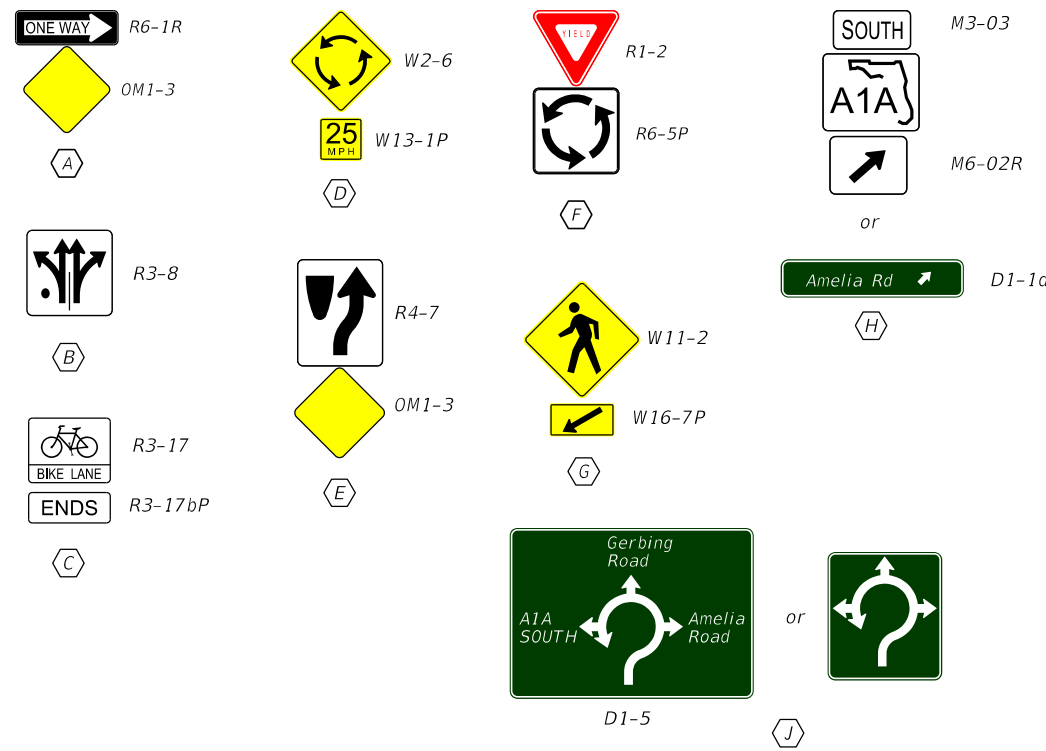

- Notes
1. Review each roundabout location independently to determine if sign assemblies (C), (H), or (J) are warranted.
 2. Provide pavement markings for gore channelization when the entry width is equal to or greater than 30 feet.
 3. For typical sign location dimensions A and B see Exhibit 213-2

2X2 ROUNDABOUT SIGNING AND PAVEMENT MARKINGS