

# *FY 2018-19 Standard Plans* Update Training

Derwood Sheppard, P.E.  
Standard Plans Publication Engineer  
Central Office, Roadway Design  
(850) 414-4334  
[Derwood.Sheppard@dot.state.fl.us](mailto:Derwood.Sheppard@dot.state.fl.us)

## Update Training Agenda

- **General Overview and Website Changes**
- **Revision History Log**
- **Deleted Indexes**
- **Standard Plans Updates**
  - **Derwood Sheppard**
    - Misc. Indexes – Turnouts, Utility Adjustments, Traffic Separators, Sidewalk, & Curb Ramps
    - Intelligent Transportation Systems (ITS) Indexes – CCTV Poles and DMS
  - **Richard Stepp**
    - Guardrail and Single-Slope Concrete Barrier Indexes
  - **Ed Cashman**
    - Temporary Barrier & Temporary Traffic Control Indexes
    - Signing, Signal & Pavement Marking Indexes
  - **Steve Nolan**
    - Structures Related Indexes

## General Overview and Website Changes

### ➤ “*Design Standards*” to “*Standard Plans*”

- **Bulletins/Memos**

- General Information – [RDM 17-01](#)
- Crosswalk & Nomenclature – [RDB 17-06](#)
- Bridge Standard Plans – [SDB 17-09](#)
- Lead Key Sheet Reference – [RDM 17-04](#)

- **Webinars/Training**

- [\*Standard Plans for Road and Bridge Construction Implementation\*](#)

### ➤ **Website Updates**

- <http://www.fdot.gov/design/standardplans/>



# Standard Plans – New Website

## New Website:

The screenshot shows the FDOT Standard Plans website. The browser address bar displays <http://www.fdot.gov/design/standardplans/>. The page features the FDOT logo and the text "Florida Department of TRANSPORTATION". A search bar is located in the top right corner with the placeholder text "Search FDOT...". Below the logo, a navigation menu includes links for Home, About FDOT, Contact Us, Maps & Data, Offices, Performance, and Projects. The main content area is titled "Office of Design" and "Standard Plans for Road and Bridge Construction". It lists several sections: Standard Plans (marked with a "NEW" badge), Design Standards, Support, Industry Review, and Contact Information. Each section has a list of sub-links.

**Standard Plans** NEW

- Standard Plans for Road and Bridge Construction
- Developmental Standard Plans

**Design Standards**

- Design Standards (FY 2017-18 and earlier)
- Developmental Design Standards

**Support**

- Standard Plans CADD - DGN and Cell Libraries
- Standard Plans Training
- Standard Plans History

**Industry Review**

- Modification Request Origination Form - Form to Propose Revisions to a Standard Plans Index
- Industry Review - Review and Response Packages for Proposed Revisions to a Standard Plans Index

**Contact Information**

- Roadway Design
- Structures Design
- Drainage Design
- Landscape Architecture
- Traffic Engineering and Operations (Traffic Ops)
- Transportation Monitoring Program (TMP)

<http://www.fdot.gov/design/standardplans/>

## Revision Log & Deleted Indexes:

### STANDARD PLANS FY 2018-19 REVISIONS LOG


<i>Design Standards Index</i>	<i>Standard Plans Index</i>	<i>Description</i>
N/A	All	Updated to align with the "Design Standards" to "Standard Plans" Implementation; Updated to align with the "PPM" to "FDM" Implementation.
001	N/A	Deleted abbreviations not used in the Standard Plans (i.e Not an Abbrev. List for anything that could be in a set of Plans). Changed to a Cover Document and no longer an Index.
002	N/A	Deleted Index. Refer to FDOT CADD Manual for Line Types, Cells, and Symbols used in a set of Plans.
258	N/A	Deleted. No longer Supported for New Construction by State Drainage.
268	N/A	Deleted. No longer Supported for New Construction by State Drainage.
301	N/A	Deleted Index and moved content to FDOT Design Manual (FDM) Section 212, Intersections, Exhibit 212-1; Moved the MEDIAN CURB AND TRAFFIC SEPARATOR JUNCTURE DETAILS to Index 520-020.
303	N/A	Deleted Index.
424	N/A	Deleted Index.
425	N/A	Deleted Index.
530	N/A	Deleted Index.
535	N/A	Deleted Index.
420	N/A	Deleted Index.
421	N/A	Deleted Index.
526	N/A	Deleted Index (Content moved to FDM 212, Intersections, Exhibits 212-2 & 212-3).
527	N/A	Deleted Index (Content moved to FDM 212, Intersections, Exhibits 212-8 thru 212-10).
546	N/A	Deleted Index (Content moved to FDM 212.2.7, Clear Sight Triangles).
17344	N/A	Deleted Index. <b>Sheet 1:</b> SCHOOL pavement marking details moved to Index 711-001 (Previously Design Standards, Index 17346). <b>Sheet 5:</b> Moved all overhead school sign assembly details to Index 700-120 (Previously Design Standards, Index 11862). <b>All Other Sheets:</b> Moved Content to the Speed Zoning for Highways, Roads and Streets in Florida, Rule 14-15.012, F.A.C.

## Standard Plans – Primary Updates

- ✓ 1) *General Overview and Website*
- 2) *Misc. Indexes*
  - ➔ a) *Indexes 000-515 & 000-516 – Turnouts & Driveways*
  - b) *Index 125-0001 – Utility Adjustments thru Existing Pavement*
  - c) *Index 520-020 – Traffic Separators*
  - d) *Index 522-001 – Concrete Sidewalks*
  - e) *Index 522-002 – Detectable Warnings and Sidewalk Curb Ramps*
- 3) *ITS Indexes*
  - a) *Index 641-020 – Concrete CCTV Poles*
  - b) *Index 649-020 – Steel CCTV Poles*
  - c) *Index 700-090 – Dynamic Message Sign Walk-in*

## Turnouts Resurfacing Projects – Index 000-516 (Sheet 1 of 1):

- 5-ft is no longer the maximum paved shoulder width.
- 7-ft now possible with buffered bike lanes.
- Updated Index to remove reference to 5-ft turnout construction limit (4-ft Min.)

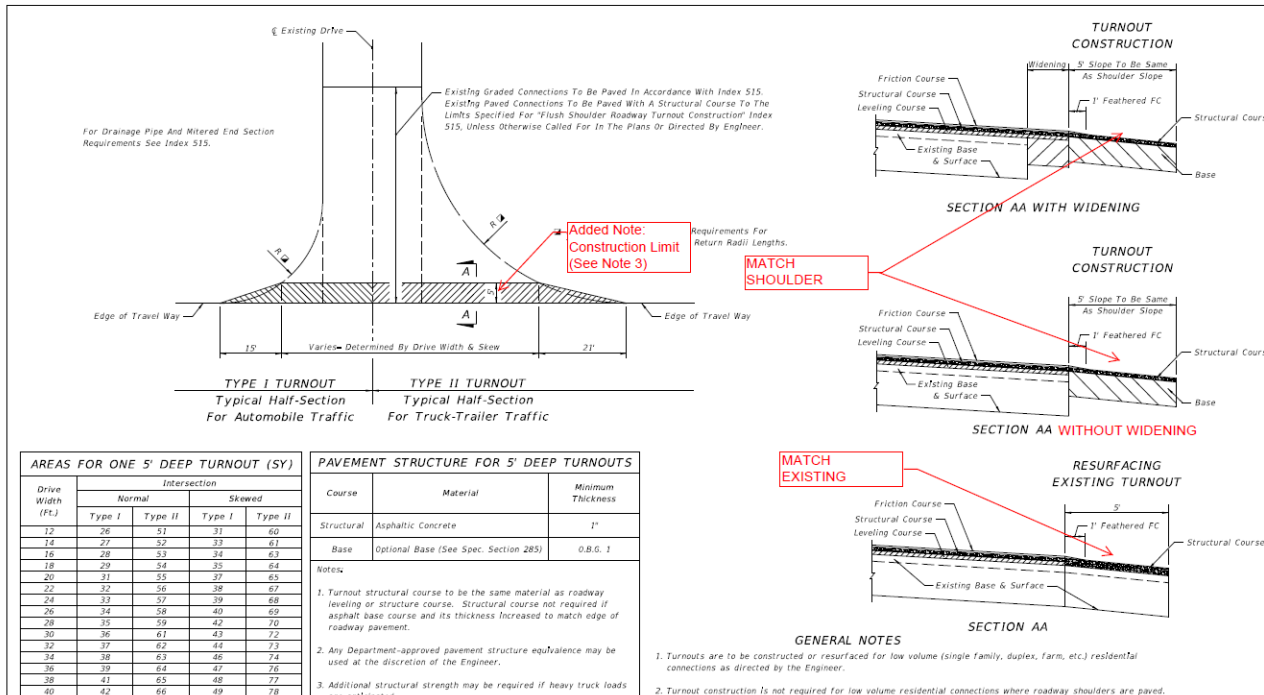

AREAS FOR ONE 5' DEEP TURNOUT (SY)

Drive Width (Ft.)	Intersection			
	Normal		Skewed	
	Type I	Type II	Type I	Type II
12	26	51	31	60
14	27	52	33	61
16	28	53	34	63
18	29	54	35	64
20	31	55	37	65
22	32	56	38	67
24	33	57	39	68
26	34	58	40	69
28	35	59	42	70
30	36	61	43	72
32	37	62	44	73
34	38	63	46	74
36	39	64	47	76
38	41	65	48	77
40	42	66	49	78

PAVEMENT STRUCTURE FOR 5' DEEP TURNOUTS

Course	Material	Minimum Thickness
Structural	Asphaltic Concrete	1"
Base	Optional Base (See Spec. Section 285)	0.B.G. 1


Notes:

1. Turnout structural course to be the same material as roadway leveling or structure course. Structural course not required if asphalt base course and its thickness increased to match edge of roadway pavement.
2. Any Department-approved pavement structure equivalence may be used at the discretion of the Engineer.
3. Additional structural strength may be required if heavy truck loads are anticipated.

3. Match existing paved shoulder widths  $\geq 4'$ . For all other shoulders conditions, construct at 5' wide.

## Turnouts and Driveways – Index 000-515 (Sheet 5 of 7):

- 5-ft is no longer the maximum paved shoulder width.
- 7-ft now possible with buffered bike lanes.
- Updated Index to remove reference to 5-ft turnout construction limit (4-ft Min.)

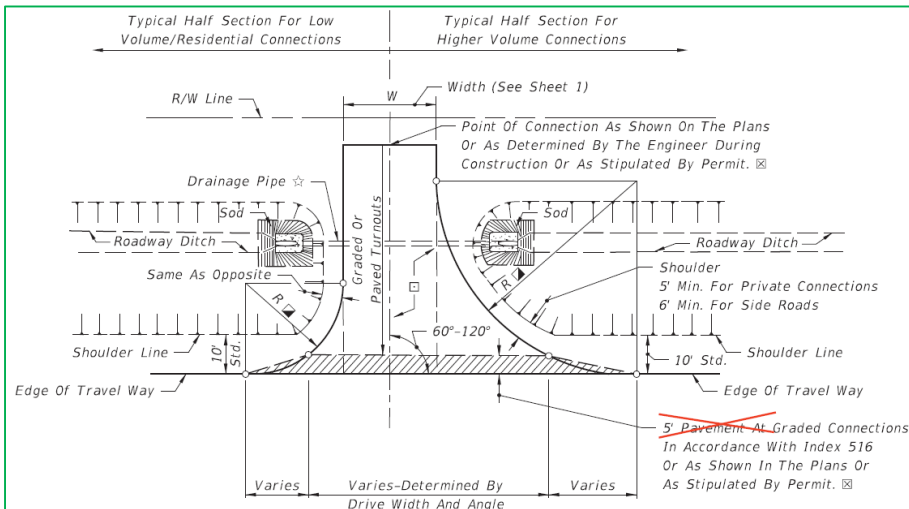

### DRIVE ENTRANCES NOTES:

☆ Drainage pipe size and length shall be that shown on the plans, or as stipulated by permit, or, as determined by the Engineer during construction. The size shall be at least that established by the FDOT District, but not less than 15" diameter or equivalent. For minimum cover over drainage pipe see Specification Section 125. Pipe arch or elliptical pipe may be required to obtain necessary cover. At minimal cover applications a modified pavement apron is permitted. See 'PERMISSIBLE PAVEMENT MODIFICATION' Index 273. For spacing between adjacent pipe end treatments see Index 273.

☐ Stable material may be required for graded turnouts to private property as directed by the Engineer in accordance with Section 102-8 of the Standard Specifications.

☒ The turnout pavement requirement at graded connections may be waived for connections serving one or two homes or field entrances with less than 20 trips per day, or 5 trips per hour as approved by permit or by the Engineer, or when not itemized in the plans.

Paved turnouts shall be constructed for all paved connecting facilities. The connecting point will be determined by the Engineer.




## Standard Plans – Primary Updates

- ✓ 1) *General Overview and Website*
- 2) *Misc. Indexes*
  - ✓ a) *Indexes 000-515 & 000-516 – Turnouts & Driveways*
  - ➔ b) *Index 125-001 – Utility Adjustments thru Existing Pavement*
  - c) *Index 520-020 – Traffic Separators*
  - d) *Index 522-001 – Concrete Sidewalks*
  - e) *Index 522-002 – Detectable Warnings and Sidewalk Curb Ramps*
- 3) *ITS Indexes*
  - a) *Index 641-020 – Concrete CCTV Poles*
  - b) *Index 649-020 – Steel CCTV Poles*
  - c) *Index 700-090 – Dynamic Message Sign Walk-in*

## Utility Adjustments thru Existing Pavement – Index 125-001 (Sheet 2 of 2):

- Require adjustments be made prior to placing Friction Course; and
- Place joints outside of wheel path.

Old  
Index 307

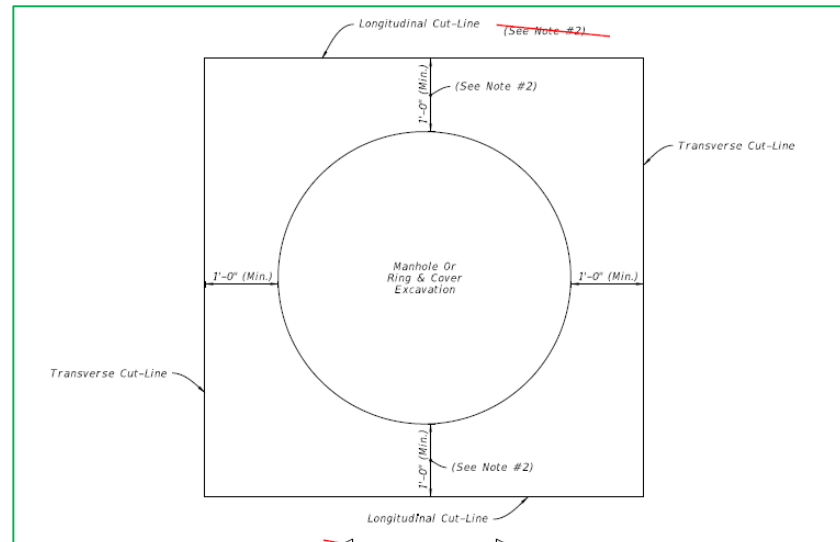

### NOTES

1. Cut-Lines must be straight and cleanly sawed.
2. See Sheet 1 for replacement pavement.
3. Adjust manholes prior to placing friction course when pavement resurfacing is occurring in the area adjacent to the manhole.
4. Align Longitudinal Cut-Lines with pavement joint or center of traffic lane to avoid wheel path.
5. For rigid pavement, align Transverse Cut-Lines with nearest existing joint.



## Standard Plans – Primary Updates

- ✓ 1) *General Overview and Website*
- 2) *Misc. Indexes*
  - ✓ a) *Indexes 000-515 & 000-516 – Turnouts & Driveways*
  - ✓ b) *Index 125-001 – Utility Adjustments thru Existing Pavement*
  - ➔ c) *Index 520-020 – Traffic Separators*
  - d) *Index 522-001 – Concrete Sidewalks*
  - e) *Index 522-002 – Detectable Warnings and Sidewalk Curb Ramps*
- 3) *ITS Indexes*
  - a) *Index 641-020 – Concrete CCTV Poles*
  - b) *Index 649-020 – Steel CCTV Poles*
  - c) *Index 700-090 – Dynamic Message Sign Walk-in*


## Traffic Separators – Index 520-020 (All Sheets):

- Reorganized to add **MEDIAN CURB AND TRAFFIC SEPARATOR JUNCTURE DETAILS** from the deleted Design Standards, Index 301 (*Turn Lanes*).

Old Index 302

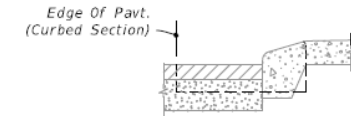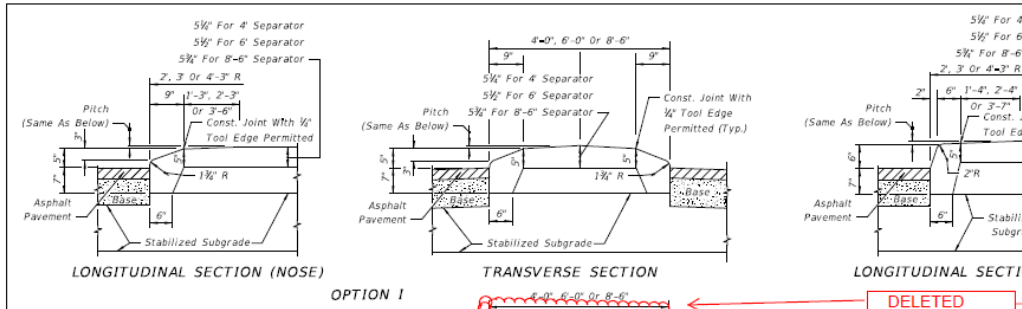


TYPE E

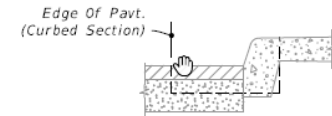


TYPE F


CURB AND GUTTER

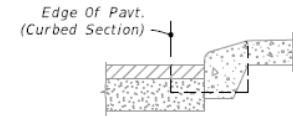

TYPE A

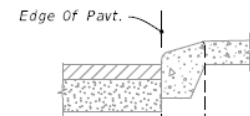

TYPE B

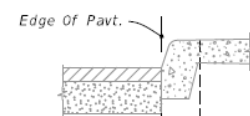


TYPE D

**MEDIAN CURB AND TRAFFIC SEPARATOR JUNCTURE DETAILS**  
(Option I Separator Shown, For Curb Details see Index 520-001)

DELETED

4'-0" 6'-0" Or 8'-6"

Cost Of The Asphalt Pavt. and Base Under The Option II Separator Included In The Cost Of The Separator.

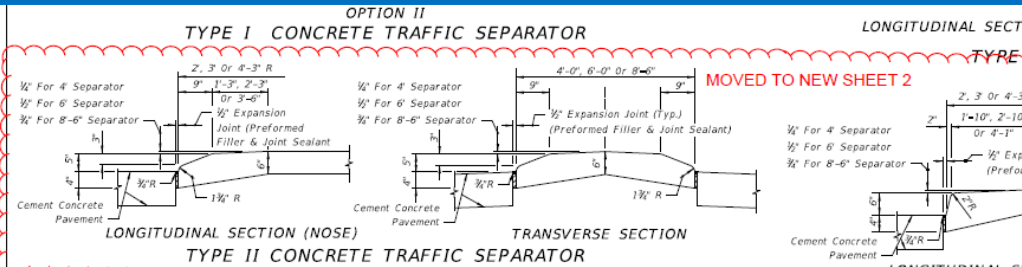

**NOTES**

- Separators Type I and IV are to be used with flexible pavement. Separators Types II and V are to be used with rigid pavement.
- Either Option I or Option II may be used for Types I and IV separators except when a specific option is called for in the plans.
- For all separators provide  $\frac{1}{8}$ "- $\frac{1}{4}$ " contraction joints adjacent to concrete pavement on tangents and flat curves are to match the pavement joints, with intermediate joints not to.
- Separators having widths of 4', 6' or 8'-6" shall be paid for under the contract unit price for Concrete Traffic Separator (Type I, Wide LF). Separators having widths other than 4', 6' or 8'-6" shall be detailed to the plans as Special Separators and paid for under the contract unit price for Concrete Traffic Separator (Special SF).

Changed Notes

LAST REVISION 07/01/14	REVISION 11/01/17		FY 2017-18 <b>DESIGN STANDARDS</b>
		TRAFFIC	

## Standard Plans – Primary Updates

- ✓ 1) *General Overview and Website*
- 2) *Misc. Indexes*
  - ✓ a) *Indexes 000-515 & 000-516 – Turnouts & Driveways*
  - ✓ b) *Index 125-001 – Utility Adjustments thru Existing Pavement*
  - ✓ c) *Index 520-020 – Traffic Separators*
  - ➔ d) *Index 522-001 – Concrete Sidewalks*
  - e) *Index 522-002 – Detectable Warnings and Sidewalk Curb Ramps*
- 3) *ITS Indexes*
  - a) *Index 641-020 – Concrete CCTV Poles*
  - b) *Index 649-020 – Steel CCTV Poles*
  - c) *Index 700-090 – Dynamic Message Sign Walk-in*



## Concrete Sidewalk – Index 522-001 (Sheet 1 of 2):

Old  
Index 310

- Clarified 4" vs 6" thickness
- Add Example of Different Curb Ramp

### GENERAL NOTES:


1. Construct sidewalks in accordance with Specification 522. Use 6" concrete for Sidewalks and Curb Ramps Located within Curb Returns (See Plan View). Install all other concrete with thickness as shown, unless otherwise detailed in the Plans.
2. Include detectable warnings on sidewalk curb ramps in accordance with Index 522-002.
3. For TURNOUTS see Index 000-515.
4. Bond breaker material can be any impermeable coated or sheet membrane or preformed material having a thickness of not less than 6 mils not more than 1/2".
5. Construct sidewalks with Edge Beam through the limits of any surface mounted Pedestrian/Bicycle Railing or Pipe Guiderail shown in the plans. (See RAILING DETAIL)
6. When roadways or driveways are newly constructed, reconstructed or altered, construct the cross slopes for crosswalks and discontinuous sidewalks as follows:
  - A. Max. 0.02 cross slope for roadways or driveway controlled by "STOP" Sign or "YIELD" sign.
  - B. Max. 0.05 cross slope for roadways or driveways controlled by traffic signal.

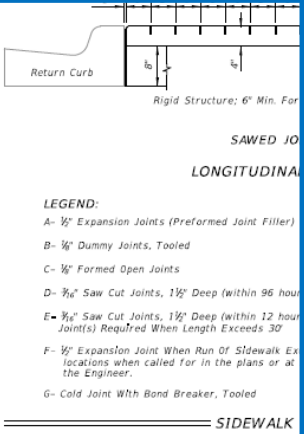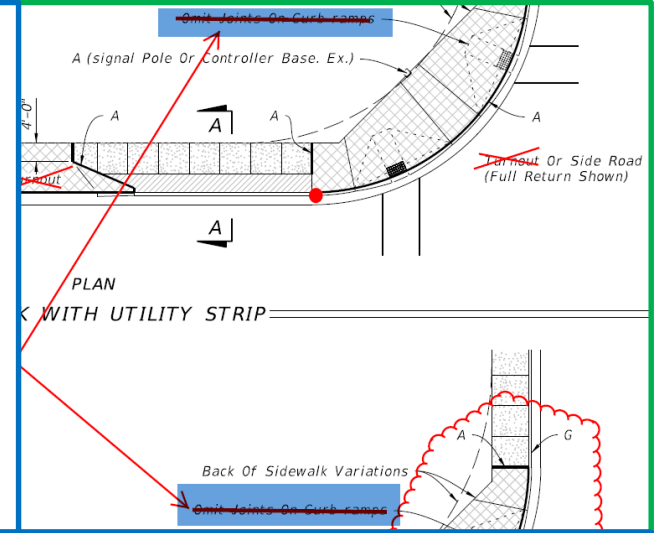

### LEGEND:

- 4" Thick Sidewalk
- 6" Thick Sidewalk
- Utility Strip

- LEGEND:**
- A- 1/2" Expansion Joints (Preformed Joint Filler)
  - B- 3/8" Dummy Joints, Tooled
  - C- 1/2" Formed Open Joints
  - D- 3/8" Saw Cut Joints, 1 1/2" Deep (within 96 hour)
  - E- 1/2" Saw Cut Joints, 1 1/2" Deep (within 12 hour Joint(s) Required When Length Exceeds 30')
  - F- 1/2" Expansion Joint When Run Of Sidewalk Exceeds 100' or as called for in the plans or at the Engineer.
  - G- Cold Joint With Bond Breaker, Tooled

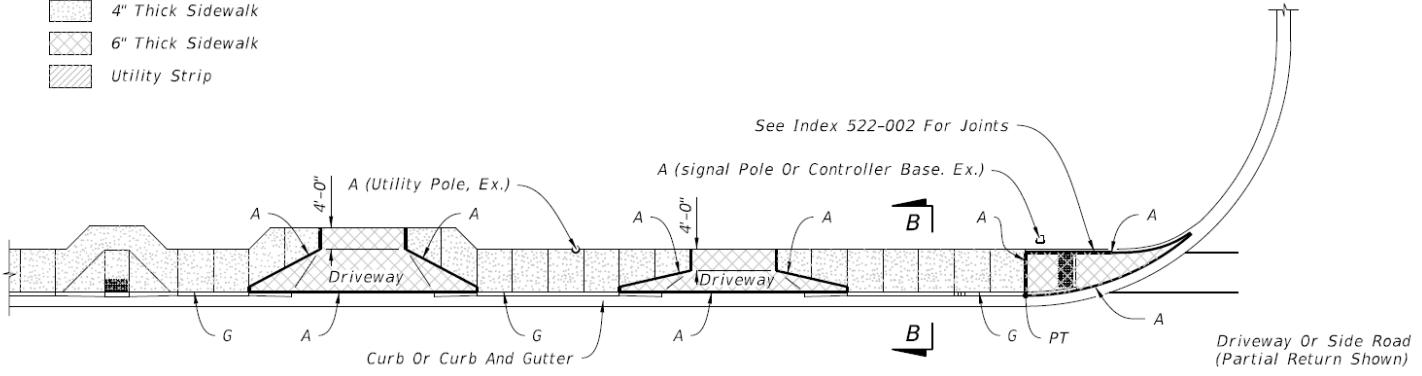

11/17/2016 10:05 AM

LAST REVISION	DESCRIPTION	DATE
11/01/16		
11/01/17		

## Standard Plans – Primary Updates

- ✓ 1) *General Overview and Website*
- 2) *Misc. Indexes*
  - ✓ a) *Indexes 000-515 & 000-516 – Turnouts & Driveways*
  - ✓ b) *Index 125-001 – Utility Adjustments thru Existing Pavement*
  - ✓ c) *Index 520-020 – Traffic Separators*
  - ✓ d) *Index 522-001 – Concrete Sidewalks*
  - ➔ e) *Index 522-002 – Detectable Warnings and Sidewalk Curb Ramps*
- 3) **ITS Indexes**
  - a) *Index 641-020 – Concrete CCTV Poles*
  - b) *Index 649-020 – Steel CCTV Poles*
  - c) *Index 700-090 – Dynamic Message Sign Walk-in*

## Detectable Warnings and Sidewalk Curb Ramps – Index 522-002 (Sheet 1 of 2):

- Clarified 4" vs 6" thickness
- Add Example of Different Curb Ramp

Old  
Index 304

**GENERAL NOTES**

1. Cross Slopes and Grades:

A. Sidewalk, ramp, and landing slopes (i.e. 0:02, 0:05, and 1:12) shown in this index are maximums. Steeper slopes are not permitted unless otherwise detailed in the Plans.

B. Landings must have slopes less than or equal to 0:02 in any direction.

C. Install ramp slopes along a single linear plane (i.e. no warps or varying slope)

2. Grade Breaks:

Grade breaks at the top and bottom of ramps must be parallel to each other and perpendicular to the direction of the ramp slope.

3. Existing Curb, Curb and Gutter and/or Sidewalk: CHANGED to: 522-001

~~B~~ Remove any existing curb or curb and gutter to the nearest joint beyond the curb transition or to the extent that no remaining section of curb and gutter is less than 5 feet long. Remove any existing sidewalk to the nearest joint beyond the transition slope or to the extent that no remaining section of sidewalk is less than 5 feet long.

~~A~~ Refer to Index ~~304~~ for Concrete Sidewalk details.

4. Curb Ramp Alpha-Identification:

A. Sidewalk curb ramp alpha-identifications (for purposes in the Plans). ADDED: thickness and

B. Alpha-identifications CR-I and CR-J are intentionally omitted.

5. Detectable Warnings:

A. Install detectable warnings in accordance with Specification ~~Section~~ ADDED: Minimum 527.

B. Place detectable warnings across the full width of the ramp or landing, to a depth of 2 feet measured perpendicular to the curb line and no greater than 5 feet from the back of the curb or edge of pavement.

C. If detectable warnings are shown in the Plans on slopes greater than 5%, align the truncated domes with the centerline of the ramp; otherwise, the truncated domes are not required to be aligned.

6. Detectable Warnings – Acceptance Criteria:

A. Color and texture shall be complete and uniform.

B. 90% of individual truncated domes shall be in accordance with the Americans with Disabilities Act Standards for Transportation Facilities, Section 705.

C. There shall be no more than 4 non-compliant domes in any one square foot.

D. Non-compliant domes shall not be adjacent to other non-compliant domes.

E. Surfaces shall not deviate more than 0.10" from a true plane.

CURB RAMP NOMENCLATURE

LAST REVISION  
**11/01/17**

Changed all:  
522-002

DS 03/08/17

INDEX NO.  
~~304~~

SHEET NO.  
1 of 8

	<p>FY 2017-18 DESIGN STANDARDS</p>	<p>DETECTABLE WARNINGS AND SIDEWALK CURB RAMPS</p>	<p>INDEX NO. <del>304</del></p>	<p>SHEET NO. 1 of 8</p>
--	--	--	-------------------------------------	-----------------------------



## Standard Plans – Primary Updates

✓ 1) *General Overview and Website*

✓ 2) *Misc. Indexes*

a) *Indexes 000-515 & 000-516 – Turnouts & Driveways*

b) *Index 125-001 – Utility Adjustments thru Existing Pavement*

c) *Index 520-020 – Traffic Separators*

d) *Index 522-001 – Concrete Sidewalks*

e) *Index 522-002 – Detectable Warnings and Sidewalk Curb Ramps*

➔ 3) **ITS Indexes**

a) *Index 641-020 – Concrete CCTV Poles*

b) *Index 649-020 – Steel CCTV Poles*

c) *Index 700-090 – Dynamic Message Sign Walk-in*

- **Concrete CCTV Poles Steel – Index 641-020**
- **Steel CCTV Poles Steel – Index 649-020**
- **Dynamic Message Sign Walk-in – Index 700-090**


## Summary of Changes:

- **Consolidated All Previous ITS Indexes**
- **Deleted the Following Old *Design Standards*:**
  - Index 18100 – CCTV Pole Placement <- **Location Controlled by FDM 215**
  - Index 18101 – Typical CCTV Site <- **Layout is Project Specific**
  - Index 18102 – Grounding and Lighting Protection <- **Consolidated w/Above**
  - Index 18104 – Typical CCTV Cabinet Equipment Layout <- **Consolidated w/Above**
  - Index 18105 – CCTV Block Diagram <- **Obsolete**
  - Index 18107 – Ground Mounted CCTV Cabinet <- **Consolidated w/Above**
  - Index 18109 – Pole Mounted CCTV Cabinet <- **Consolidated w/Above**

Old  
Index 18000's  
Series

## Dynamic Message Sign Walk-in – Index 700-090 (Sheets 6, 7, & 8 of 9 Deleted):

Old  
Index 18300

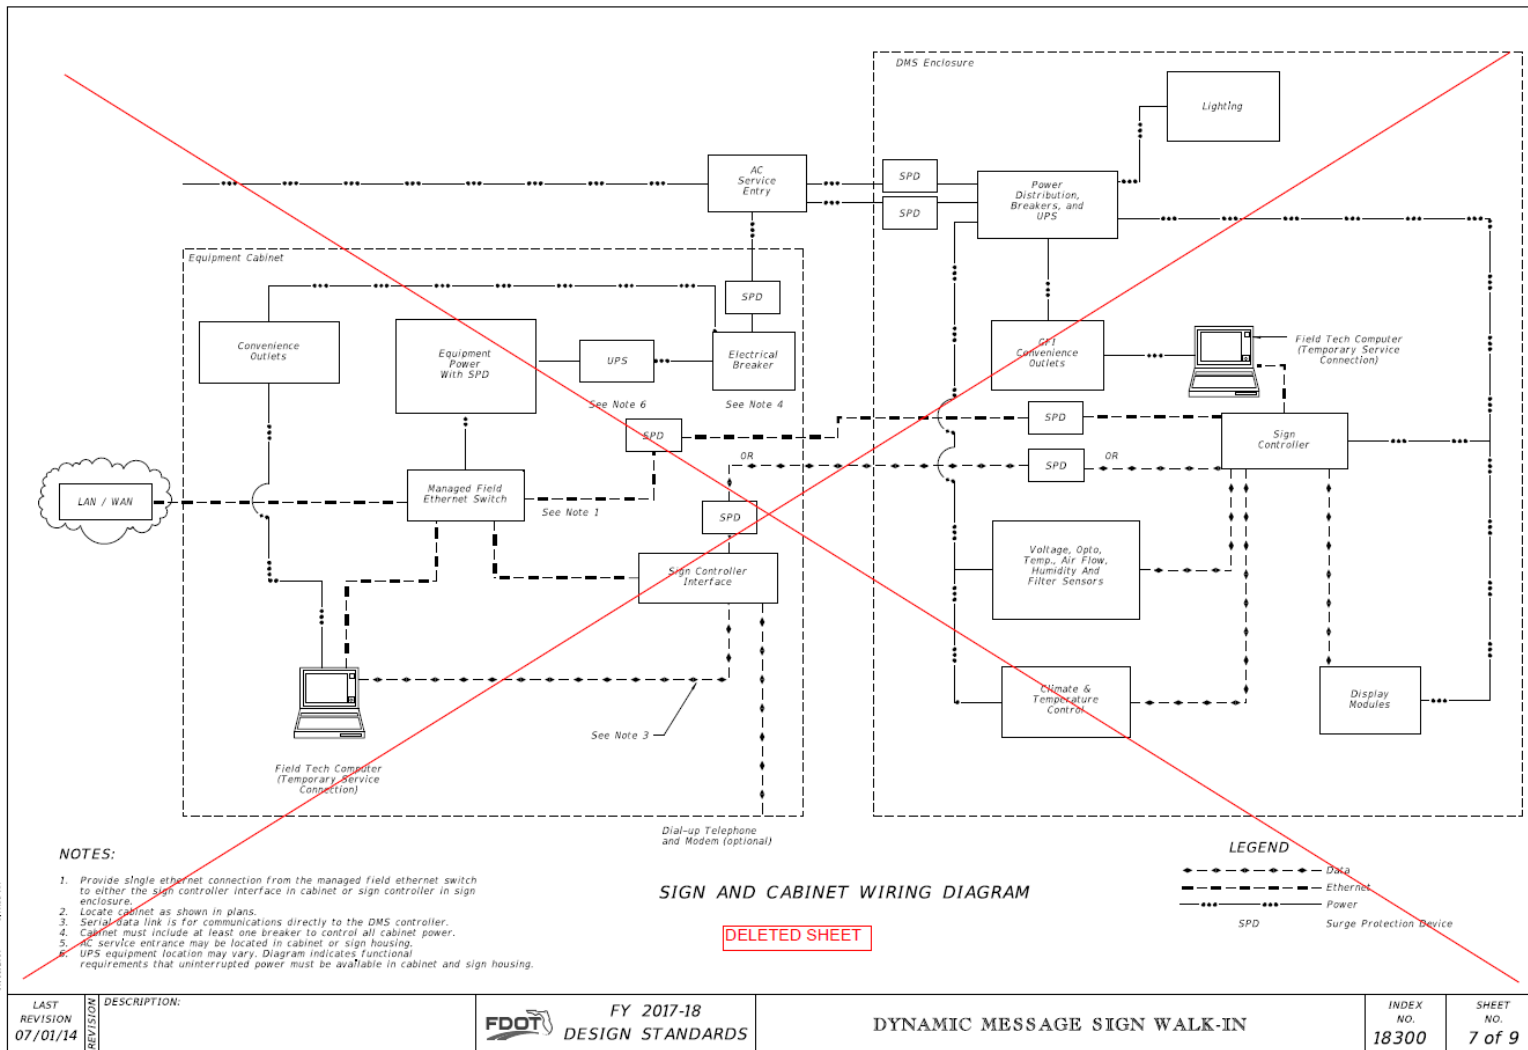


10/11/2016 4:46:53 AM

LAST REVISION 07/01/14	DESCRIPTION:	FY 2017-18 DESIGN STANDARDS	DYNAMIC MESSAGE SIGN WALK-IN	INDEX NO. 18300	SHEET NO. 7 of 9
---------------------------	--------------	--------------------------------	------------------------------	--------------------	---------------------

## Dynamic Message Sign Walk-in – Index 700-090 (Sheets 6, 7, & 8 of 9 Deleted):

Old  
Index 18300

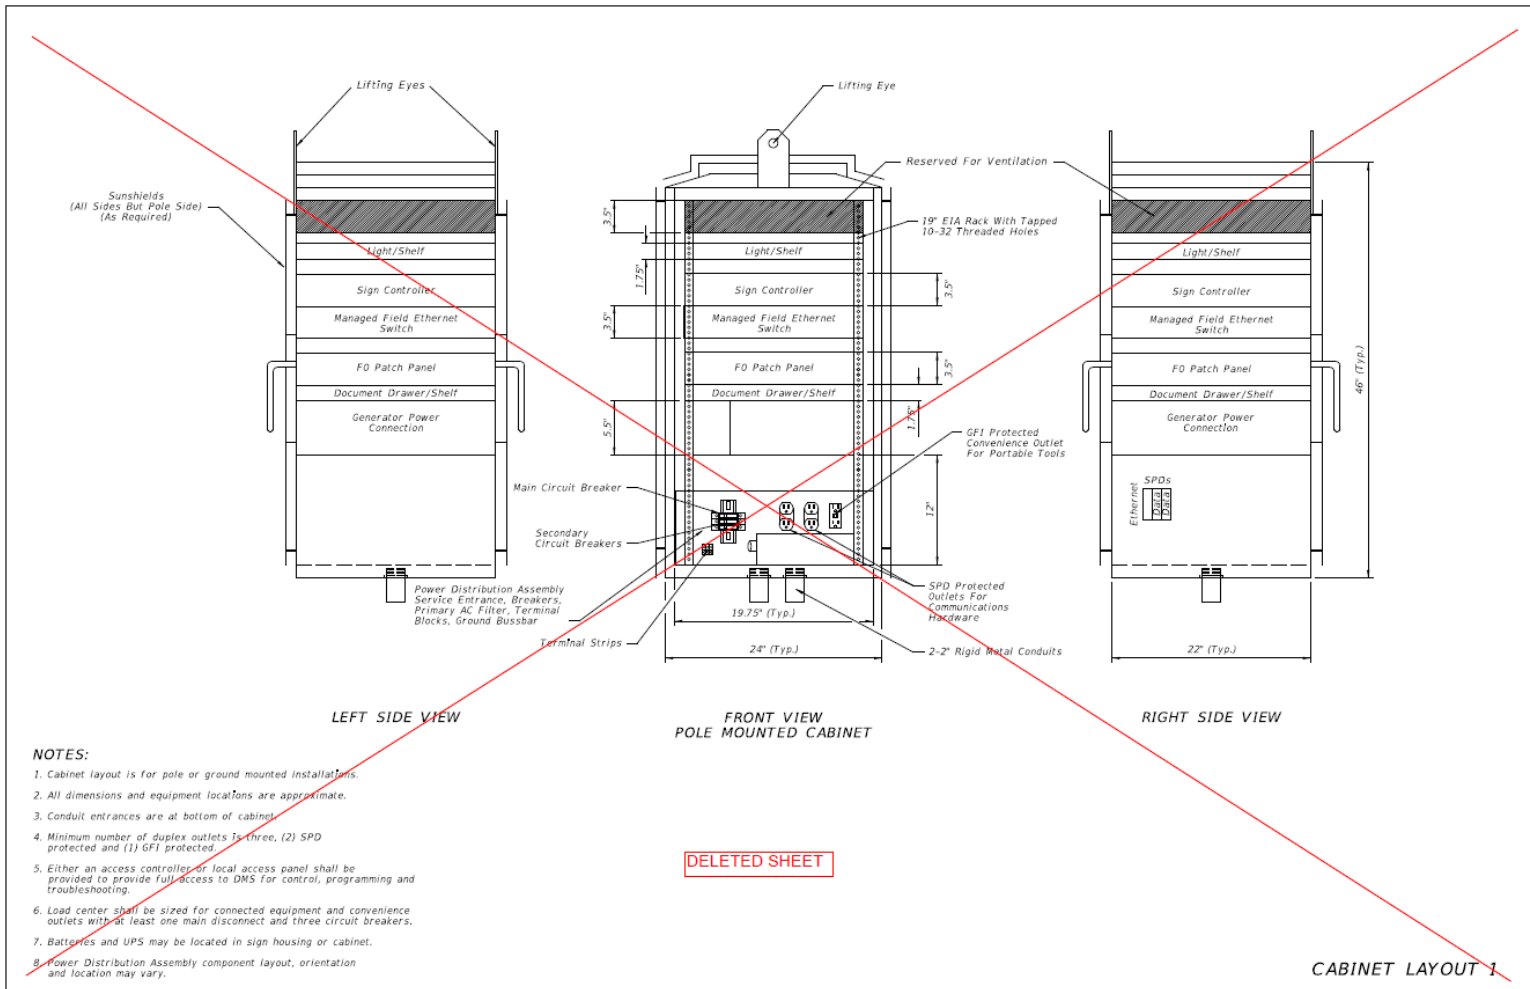

DELETED SHEET

**NOTES:**

1. Cabinet layout is for pole or ground mounted installations.
2. All dimensions and equipment locations are approximate.
3. Conduit entrances are at bottom of cabinet.
4. Minimum number of duplex outlets is three, (2) SPD protected and (1) GFI protected.
5. Either an access controller or local access panel shall be provided to provide full access to DMS for control, programming and troubleshooting.
6. Load center shall be sized for connected equipment and convenience outlets with at least one main disconnect and three circuit breakers.
7. Batteries and UPS may be located in sign housing or cabinet.
8. Power Distribution Assembly component layout, orientation and location may vary.


CABINET LAYOUT 1

10/11/2016 6:46:56 AM

LAST REVISION 07/01/14	DESCRIPTION:	 FY 2017-18 DESIGN STANDARDS	DYNAMIC MESSAGE SIGN WALK-IN	INDEX NO. 18300	SHEET NO. 8 of 9
---------------------------	--------------	------------------------------------	------------------------------	--------------------	---------------------

## Dynamic Message Sign Walk-in – Index 700-090 (Sheets 6, 7, & 8 of 9 Deleted):

Old  
Index 18300

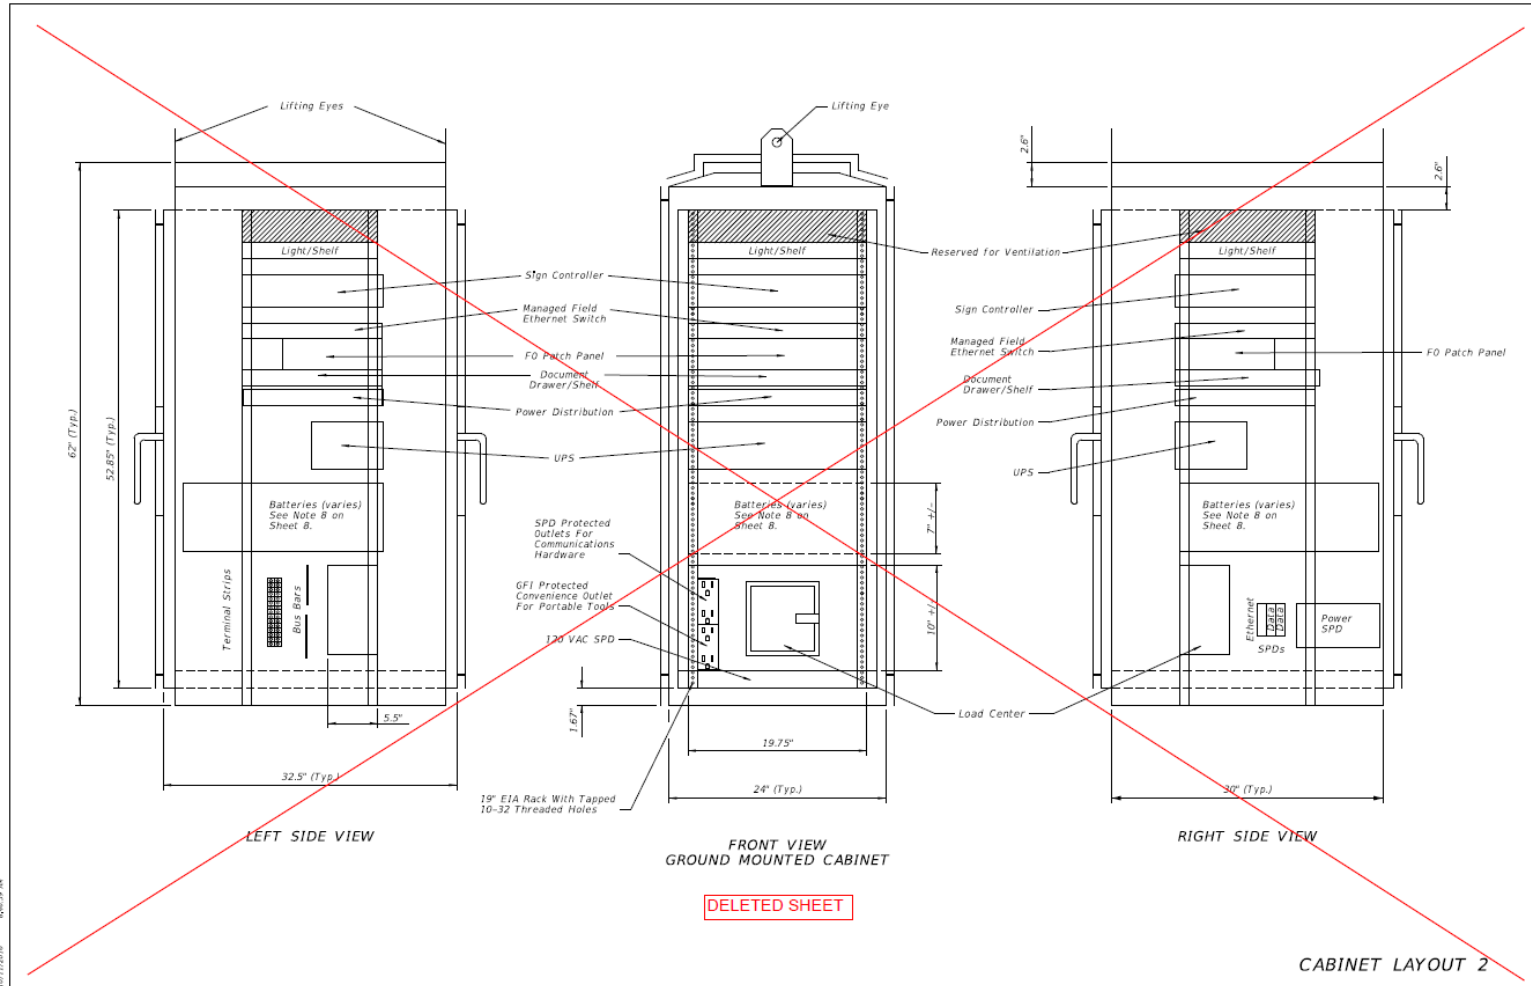

19/11/2016 6:46:39 AM

LAST REVISION 07/01/14	DESCRIPTION:	FY 2017-18 DESIGN STANDARDS	DYNAMIC MESSAGE SIGN WALK-IN	INDEX NO. 18300	SHEET NO. 9 of 9
---------------------------	--------------	--------------------------------	------------------------------	--------------------	---------------------

## Standard Plans – Primary Updates

- ✓ 1) ***General Overview and Website***
- ✓ 2) ***Misc. Indexes***
  - a) *Indexes 000-515 & 000-516 – Turnouts & Driveways*
  - b) *Index 125-001 – Utility Adjustments thru Existing Pavement*
  - c) *Index 520-020 – Traffic Separators*
  - d) *Index 522-001 – Concrete Sidewalks*
  - e) *Index 522-002 – Detectable Warnings and Sidewalk Curb Ramps*
- ✓ 3) ***ITS Indexes***
  - a) *Index 641-020 – Concrete CCTV Poles*
  - b) *Index 649-020 – Steel CCTV Poles*
  - c) *Index 700-090 – Dynamic Message Sign Walk-in*

## Questions?



**Derwood Sheppard, P.E.**  
**Standard Plans Publication Engineer**  
**Central Office, Roadway Design**  
**(850) 414-4334**  
**[Derwood.Sheppard@dot.state.fl.us](mailto:Derwood.Sheppard@dot.state.fl.us)**

# *FY 2018-19 Standard Plans* Update Training

Richard Stepp, P.E.  
Standard Plans Engineer  
Central Office, Roadway Design  
(850) 414-4313  
[richard.stepp@dot.state.fl.us](mailto:richard.stepp@dot.state.fl.us)



## Standard Plans – Primary Index Updates:

- 1) **Index 536-001 – Guardrail**
  - Miscellaneous Updates
- 2) **Index 521-001 – Concrete Barrier**
  - Complete Redevelopment – **Single-Slope Barrier**
- 3) **Index 521-002 – Pier Protection Barrier**
  - Extensive Redevelopment – **Single-Slope Barrier**
- 4) **Index 425-030 – Median Barrier Inlets Types 1 & 2**
  - Modified – **Single-Slope Barrier**
  - Removed Approach and Trailing “Throats”
- 5) **Index 425-031 – Shoulder Barrier Inlet**
  - Modified – **Single-Slope Barrier**
- 6) **Index 425-032 – Curb & Gutter Barrier Inlet**
  - Modified – **Single-Slope Barrier**
  - New PVC Drainage Pipes from Sidewalk
- 7) **Index 715-002 – Standard Aluminum Lighting**
  - Modified – **Single-Slope Barrier**


## Standard Plans – Primary Index Updates:

- ➔ 1) *Index 536-001* – Guardrail
  - Miscellaneous Updates


## Guardrail - Summary of Changes:

- Single-Slope Barriers – updated all connecting barrier and offset blocks details throughout
- Miscellaneous updates for constructability and clarity
- Today’s presentation covers select items of interest for designers
- For complete red lines of all changes, see the Office of Design - Industry Review website at:  
<http://www.fdot.gov/design/standardplans/IRR/Default.shtm>


## Sheets 6, 7, & 8; Example Sections Throughout:

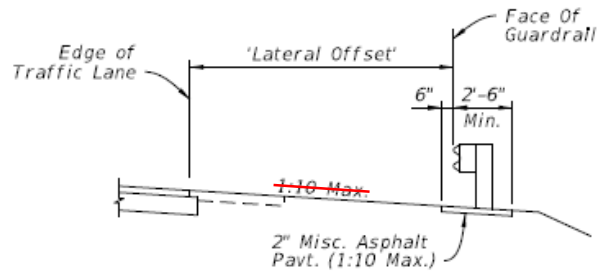


UNPAVED OR PARTIALLY  
PAVED SHOULDER

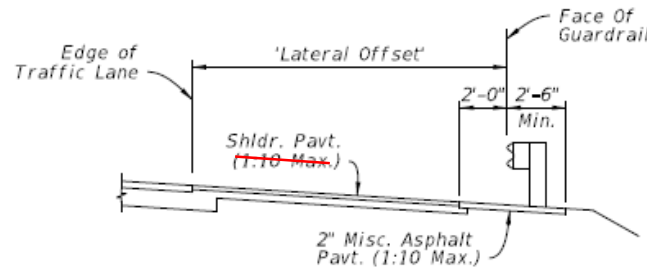

FULLY PAVED SHOULDER

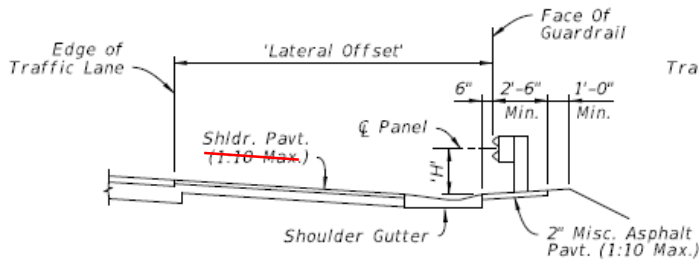


SHOULDER GUTTER

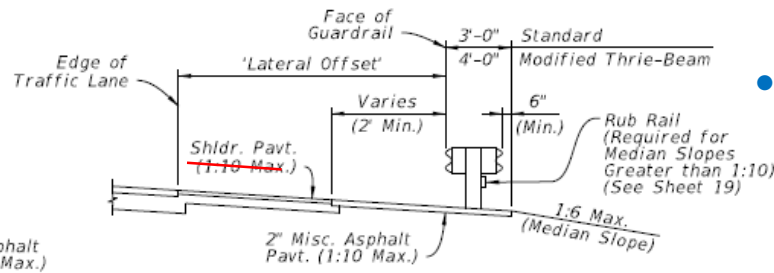


DOUBLE FACED GUARDRAIL  
(Shown In Median)

- Removed “1:10 Max.” cross-slope on Shoulder Depictions
- “1:10 Max.” does not conflict with FDM requirements, but...
- Removal avoids misconception that “1:10 Max.” supersedes Plans and FDM requirements

## Sheet 6:

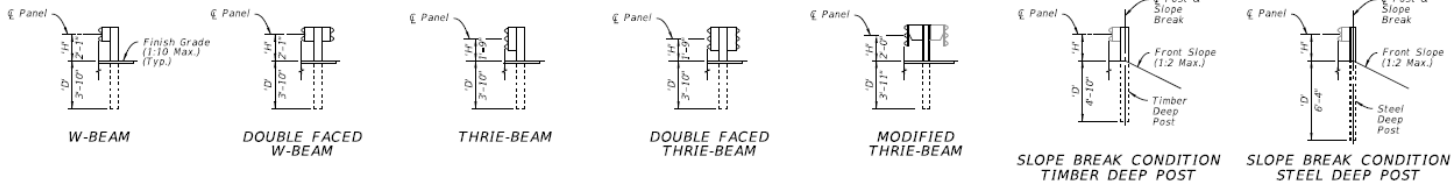


GUARDRAIL TYPES - MOUNTING HEIGHTS & POST DEPTHS

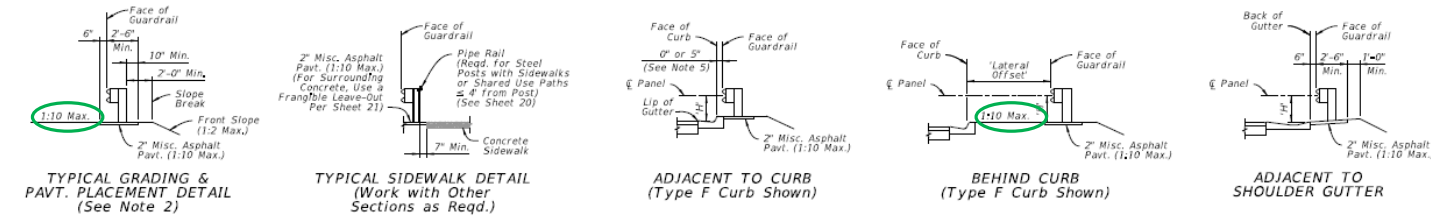

GUARDRAIL SECTIONS - TYPICAL

GUARDRAIL SECTIONS - CURB & GUTTER

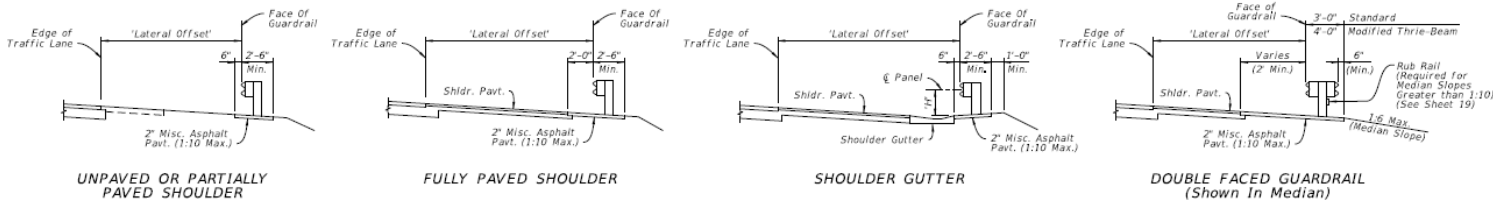

GUARDRAIL SECTIONS - SHOULDERS

GUARDRAIL HEIGHT SUMMARY TABLE:			
Type:	Min. Depth 'D':	Mounting Height 'H':	Post Length 'L':
W-Beam (Single and Double Faced)	3'-10"	2'-1"	6'-6"
Thrie-Beam (Single and Double Faced)	3'-10"	1'-9"	6'-6"
Modified Thrie-Beam	3'-11"	2'-0"	6'-9"
Timber Deep Post	4'-10"	See Above	7'-6"
Steel Deep Post	6'-4"	See Above	9'-0"

**NOTES:**

- GUARDRAIL SECTIONS:** Construct Sections as indicated in the plans. The details shown here depict W-Beam Guardrail, but are applicable to the other defined steel and timber post types are interchangeable unless otherwise noted. The 1:10 Max. cross slope shown is the maximum slope for proper guardrail function, but project-specific cross slope requirements are governed per the plans.
- TYPICAL GRADING & PAVEMENT PLACEMENT DETAIL:** Construct features as depicted except where superseded by specific Guardrail Sections or the plans. Place the Slope Break a Minimum of 2' behind the post. For Deep Posts, the slope break may be placed at the  $\epsilon$  Post with the 2" Miscellaneous Asphalt Pavement omitted.
- SLOPE BREAK CONDITION:** Install Deep Posts only where called for in the plans. Deep Posts are only permitted where post spacing is 6'-3" or less.
- LATERAL OFFSETS:** The Lateral Offsets shown are governed by the station and offset call outs for Face of Guardrail, as shown in the plans.
- ADJACENT TO CURB:** Place the Face of Guardrail consistently either flush with the Face of Curb or 5" behind the Face of Curb, as indicated by the plans station and offset callout. For offset changes, transition the Face of Guardrail as shown in the plans.


**New** →

GUARDRAIL SECTIONS


- "1:10 Max." label remains on generic approach, sidewalk, and misc. asphalt details
- Added new note explaining "1:10 Max." is for guardrail function only; the slope shown in Plans governs (FDM requirements)

## Sheet 16:

- Example of Changes for Single-Slope Barrier (which show up on numerous other Sheets)
- Barrier Height now Tapers Down for GR Connection
- Offset Blocks Revised
- Overall Guardrail System Width Unchanged!

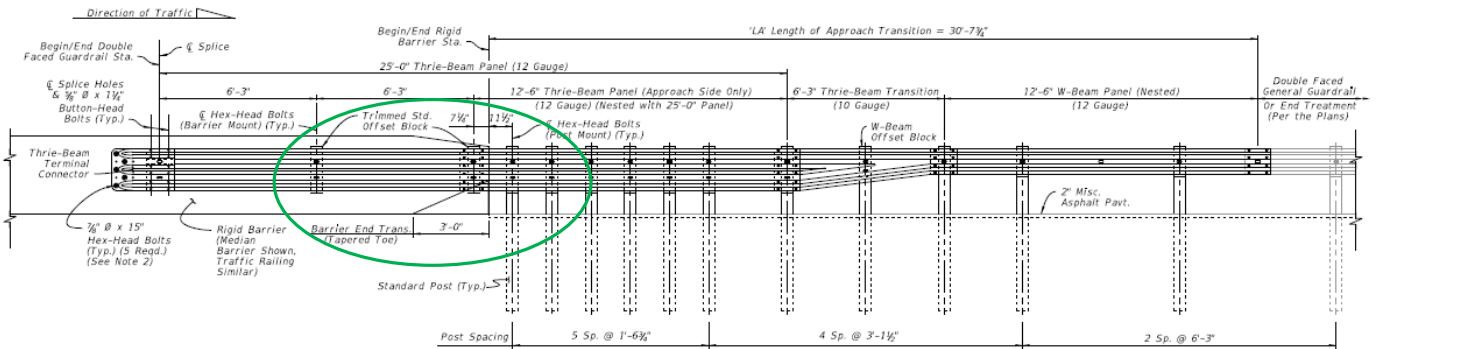







TL-3 DOUBLE FACED APPROACH TRANSITION  
INSTALLED ELEVATION

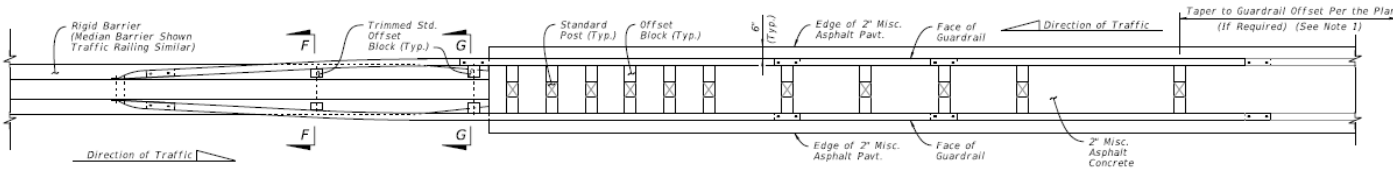

TL-3 DOUBLE FACED APPROACH TRANSITION  
INSTALLED PLAN

**NOTES:**

- INSTALLATION:** Construct the Approach Transition segment where indicated in the plans. The required offset of the connecting adjacent guardrail is shown in the plans.  
The Layouts given on Sheet 18 provide basic schemes for connections to adjacent guardrail, where a taper to a differing guardrail offset may be required. If the adjacent guardrail has the same offset as the Approach Transition segment, then no taper is required.
- THRIE-BEAM TERMINAL CONNECTOR:** See Sheet 15 for Details. The installed bolts threaded portion is not permitted to extend beyond  $\frac{3}{8}$ " from the face of the nut; trim the threaded portion as needed and galvanize in accordance with Specification Section 562.
- GENERAL GUARDRAIL:** General Guardrail typically includes Panels and Post Spacing as shown on Sheet 2, including parallel and tapered segments. End Treatments or Reduced Post Spacing Guardrail segments may be substituted for the General Guardrail shown herein if indicated in the plans.

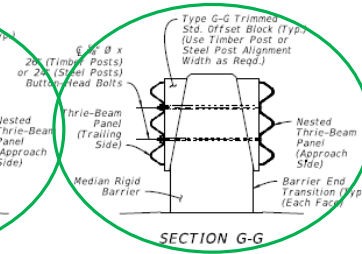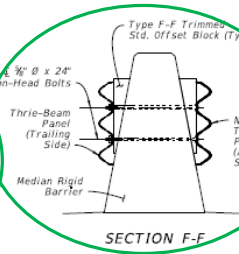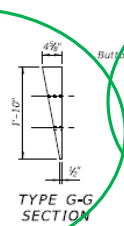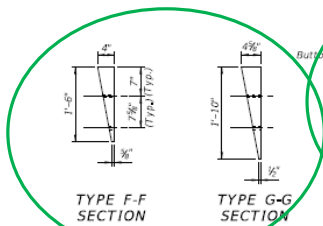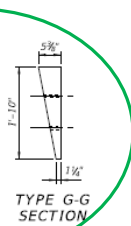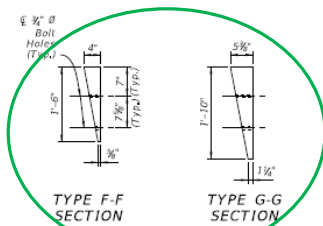


TRIMMED STD. OFFSET BLOCKS  
TIMBER POST ALIGNMENT WIDTH

TRIMMED STD. OFFSET BLOCKS  
STEEL POST ALIGNMENT WIDTH


APPROACH TRANSITION CONNECTION TO  
RIGID BARRIER WITH DOUBLE FACED GUARDRAIL

LAST REVISION 11/01/17	DESCRIPTION	FDOT FY 2018-19 STANDARD PLANS	GUARDRAIL	INDEX 536-001	SHEET 16 of 22
---------------------------	-------------	--------------------------------------	-----------	------------------	-------------------


## Sheet 20:

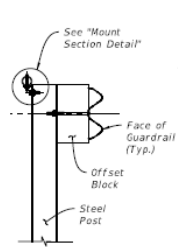


GENERAL PIPE RAIL SECTION

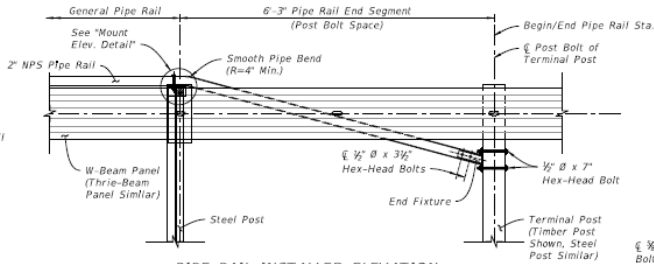

PIPE RAIL INSTALLED ELEVATION (End Segment Shown)

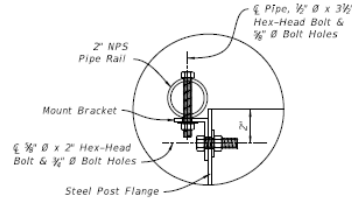


MOUNT SECTION DETAIL

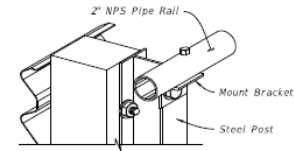


MOUNT ISOMETRIC CUT-AWAY

**NOTES:**


1. GENERAL: Install General Pipe Rail where indicated in the plans or when existing sidewalks or shared use paths are located less than 4'-0" from the back of Steel Posts as shown on Sheet 6.
2. PIPE RAIL END SEGMENTS: Place End Segments on both ends of General Pipe Rail runs, with End Fixtures mounted to Terminal Posts located outside of Approach Terminal Assembly ('LE'), Trailing Anchorage Assembly ('LT'), and Approach Transition ('LA') segments.
3. MATERIALS: Use steel brackets, fixtures, and pipes in accordance with Specification Section 967.
4. RAIL SPLICES: Install Rail Splices to join pieces of 2" NPS Pipe Rail into a continuous system. Place splices as needed, at a spacing of 18'-0" or greater. Orient the head of bolt on the top of the pipe.

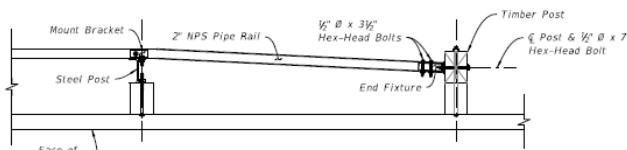


PIPE RAIL INSTALLED PLAN END AT TIMBER POST OPTION

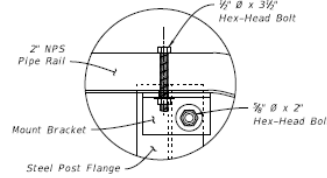


MOUNT ELEVATION DETAIL (Back View - Mirrored)

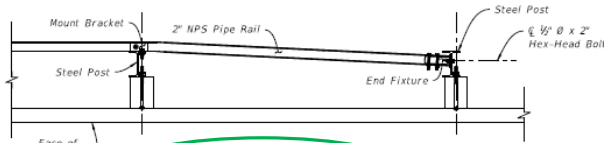


PIPE RAIL INSTALLED PLAN END AT STEEL POST OPTION

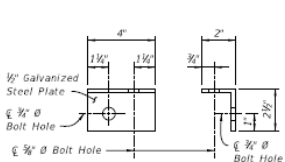

ELEVATION SECTION

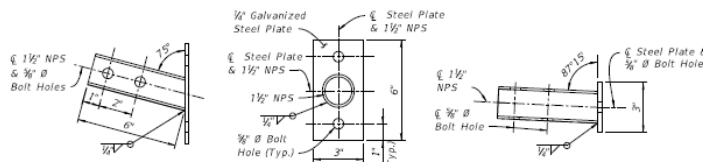

ELEVATION SECTION PLAN

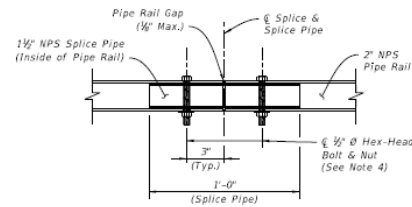

RAIL SPLICE DETAIL

PEDESTRIAN SAFETY TREATMENT - PIPE RAIL

- Added Option to Terminate Pipe Rail on Steel Post
- If Pipe Rail is no longer needed because a sidewalk veers greater than 4 feet from guardrail, a timber post is no longer required within the steel post run.

LAST REVISION 11/01/17	DESCRIPTION:	FDOT FY 2018-19 STANDARD PLANS	GUARDRAIL	INDEX 536-001	SHEET 20 of 22
------------------------	--------------	--------------------------------	-----------	---------------	----------------

## Standard Plans – Primary Index Updates:

- ✓ 1) **Index 536-001 – Guardrail**
  - Miscellaneous Updates

- ➔ 2) **Index 521-001 – Concrete Barrier**
  - Complete Redevelopment – **Single-Slope Barrier**



## Concrete Barrier - Summary of Changes:

- All barriers upgraded to **Single-Slope** sections to accommodate larger vehicles for MASH compliance
- “Standard Plans” sheets were completely redrawn, rewritten, and reorganized to improve clarity of notes and details for designers and contractors
- **New** “Standard Plans Instructions (SPIs)” for improved clarity of process for designers
- **New** “Length of Need (LON) Design Tool” to assist designers with learning the *AASHTO Roadside Design Guide* barrier length process
- Today’s presentation covers select items of interest for designers

## Sheet 1: All new!

SHEET NO.	CONTENTS
1	Index Contents; General Notes
2	Median Barrier
3	Median Barrier – Reinforcing Details
4	Median Barrier – Sloped End Treatment
5	Median Barrier – Grade Separated
6	Median Barrier – 56" Height Section for Barrier-Mounted Sign Support Shielding – Symmetrical
7	Median Barrier – 56" Height Section for Barrier-Mounted Sign Support Shielding – Asymmetrical
8	Median Barrier – 38" Height Split Section for Stand-Alone Sign Support Shielding
9	Median Barrier – 44" Height Split Section for Pier Shielding
10	Median Barrier – 44" Height Split Section for Pier Shielding – Details
11	Median Barrier – Connection to F-Shape
12	Shoulder Barrier
13	Shoulder Barrier – Reinforcing Details
14	Shoulder Barrier – Section Options
15	Shoulder Barrier – Section Options (Continued)
16	Shoulder Barrier – 38" Height Rear-Flush Section for Reduced Setback Pier Shielding (Low-Speed)
17	Shoulder Barrier – 44" Height Rear-Flush Section for Reduced Setback Pier Shielding
18	Shoulder Barrier – Connection to F-Shape
19	Curb and Gutter Barrier
20	Curb and Gutter Barrier – Reinforcing Details
21	Curb and Gutter Barrier – Sloped End Treatment
22	Reinforcing Bar Bending Diagrams

### GENERAL NOTES:

- CONCRETE:** Use Class II concrete for all barriers constructed in slightly aggressive environments, and use Class IV Concrete for all barriers constructed in moderately or extremely aggressive environments. On all exposed surfaces, apply a Class 3 surface finish in accordance with Specification 400.
- STEEL BAR REINFORCEMENT:** Where required to maintain continuity, provide lap splices of at least 18 inches for No. 4 bars and 20 inches for No. 5 bars, unless otherwise shown herein (including shorter splices as provided by the default bar bending diagrams).  
  
*The default reinforcing details shown herein, including bar shapes and lap splice positions, are intended to show required steel locations and provide for a constructible design. However, with the approval of the Engineer, alternate steel configurations may be used in the same locations shown herein, given that the equivalent strength reinforcing is provided and the cover, maximum spacing, and continuity requirements are maintained.*
- OPTIONAL WELDED WIRE REINFORCEMENT:** With the approval of the Engineer, steel welded wire reinforcement in accordance with Specification 415 may be substituted for the steel bars shown herein. Place the welded wire in the same locations specified for the steel bars, and maintain the equivalent strength, cover, maximum spacing, and continuity requirements.
- TOP FACE LONGITUDINAL REINFORCEMENT:** Unless otherwise specified, the longitudinal reinforcement shown closest to the top face of the barrier has a maximum cover of 4½", measured from the top face of the barrier.
- MINIMUM BARRIER LENGTH:** Unless otherwise shown in the Plans, the minimum Concrete Barrier length is 40 feet.
- CONSTRUCTION JOINTS:** Install Construction Joints only as needed for discontinuous concrete casting or cold joints. Maintain continuity of steel reinforcement across Construction Joints. Construction Joints are classified herein as Transverse Joints or Longitudinal Joints.  
  
*Transverse Joints are permitted at 20-foot or greater intervals along the barrier. For Tall Grade-Separated Sections, see Sheet 5 for additional Transverse Joint requirements.*  
  
*Longitudinal Joints are only permitted where indicated in the following details and notes, with a vertical position tolerance of ± 1½" from the locations shown.*
- DOWELED JOINTS:** As shown in the Dowel Details on Sheets 2 & 12, install ¾" Doweled Joints for Concrete Barrier connections to Pier Protection Barrier and Traffic Railings. Doweled Joints are also required for expansion mitigation in Median Barrier as defined per Sheets 2 & 5. Doweled Joints are not permitted within Grade-Separated Median Barrier.
- CRACK CONTROL V-GROOVES:** At 20-foot intervals, place ¾" depth V-grooves that run vertically and/or transversely in the front, top, and back faces of barriers. The V-grooves can be either molded or scored while the concrete is still plastic.
- SUBGRADE:** Compact the top layer of subgrade with Type B Stabilization, LBR 40 (12 in.).
- FOOTING BOTTOM CONCRETE COVER:** At the bottom of barrier footings shown throughout this Index, up to 2 inches of additional concrete cover is permitted beyond what is shown herein to accommodate soil grade irregularities.
- FINISH GRADE ELEVATION:** At the barrier face location, the finish grade pavement has a vertical position tolerance of ± ½" from the locations shown herein, relative to the barrier elevation. Maintain visually smooth and even pavement at the barrier face, per the approval of the Engineer.
- DRAINAGE INLETS:** Where called for in the Plans, install corresponding inlets per Indexes 425-030 thru 425-032.
- LIGHT POLE MOUNTING:** Where called for in the Plans, install aluminum light poles per Index 715-002.
- OPAQUE VISUAL BARRIER:** Where called for in the Plans, install Opaque Visual Barrier per Index 521-010.
- BARRIER END MARKERS:** For all free ends of concrete barriers that are not shielded with an end treatment or connection to another barrier or traffic railing type, install a Type 3 Object Marker on the end face per Specification 705.
- BARRIER DELINEATORS:** Install Barrier Delineators in accordance with Specification 705. For median barriers, mount the delineator on the top of the barrier, at the centerline of barrier, with reflective sheeting facing traffic on both approaches. For shoulder barriers and split sections, mount the delineators on the top of the barrier, with the roadway side of the delineator located 2' from the front face of the barrier and the reflective sheeting facing traffic of the nearest approach.

- New Table of Contents
- Three Distinct Barrier Types
- Re-written notes throughout—Concise active voice with headings
- New welded-wire reinforcement option

## Sheet 1: All new!


SHEET NO.	CONTENTS
1	Index Contents; General Notes
2	Median Barrier
3	Median Barrier – Reinforcing Details
4	Median Barrier – Sloped End Treatment
5	Median Barrier – Grade Separated
6	Median Barrier – 56" Height Section for Barrier-Mounted Sign Support Shielding – Symmetrical
7	Median Barrier – 56" Height Section for Barrier-Mounted Sign Support Shielding – Asymmetrical
8	Median Barrier – 38" Height Split Section for Stand-Alone Sign Support Shielding
9	Median Barrier – 44" Height Split Section for Pier Shielding
10	Median Barrier – 44" Height Split Section for Pier Shielding – Details
11	Median Barrier – Connection to F-Shape
12	Shoulder Barrier
13	Shoulder Barrier – Reinforcing Details
14	Shoulder Barrier – Section Options
15	Shoulder Barrier – Section Options (Continued)
16	Shoulder Barrier – 38" Height Rear-Flush Section for Reduced Setback Pier Shielding (Low-Speed)
17	Shoulder Barrier – 44" Height Rear-Flush Section for Reduced Setback Pier Shielding
18	Shoulder Barrier – Connection to F-Shape
19	Curb and Gutter Barrier
20	Curb and Gutter Barrier – Reinforcing Details
21	Curb and Gutter Barrier – Sloped End Treatment
22	Reinforcing Bar Bending Diagrams

### GENERAL NOTES:

- CONCRETE:** Use Class II concrete for all barriers constructed in slightly aggressive environments, and use Class IV Concrete for all barriers constructed in moderately or extremely aggressive environments. On all exposed surfaces, apply a Class 3 surface finish in accordance with Specification 400.
- STEEL BAR REINFORCEMENT:** Where required to maintain continuity, provide lap splices of at least 18 inches for No. 4 bars and 20 inches for No. 5 bars, unless otherwise shown herein (including shorter splices as provided by the default bar bending diagrams).  
  
The default reinforcing details shown herein, including bar shapes and lap splice positions, are intended to show required steel locations and provide for a constructible design. However, with the approval of the Engineer, alternate steel configurations may be used in the same locations shown herein, given that the equivalent strength reinforcing is provided and the cover, maximum spacing, and continuity requirements are maintained.
- OPTIONAL WELDED WIRE REINFORCEMENT:** With the approval of the Engineer, steel welded wire reinforcement in accordance with Specification 415 may be substituted for the steel bars shown herein. Place the welded wire in the same locations specified for the steel bars, and maintain the equivalent strength, cover, maximum spacing, and continuity requirements.
- TOP FACE LONGITUDINAL REINFORCEMENT:** Unless otherwise specified, the longitudinal reinforcement shown closest to the top face of the barrier has a maximum cover of 4½", measured from the top face of the barrier.
- MINIMUM BARRIER LENGTH:** Unless otherwise shown in the Plans, the minimum Concrete Barrier length is 40 feet.
- CONSTRUCTION JOINTS:** Install Construction Joints only as needed for discontinuous concrete casting or cold joints. Maintain continuity of steel reinforcement across Construction Joints. Construction Joints are classified herein as Transverse Joints or Longitudinal Joints.  
  
Transverse Joints are permitted at 20-foot or greater intervals along the barrier. For Tall Grade-Separated Sections, see Sheet 5 for additional Transverse Joint requirements.  
  
Longitudinal Joints are only permitted where indicated in the following details and notes, with a vertical position tolerance of ± 1½" from the locations shown.
- DOWELED JOINTS:** As shown in the Dowel Details on Sheets 2 & 12, install ¾" Doweled Joints for Concrete Barrier connections to Pier Protection Barrier and Traffic Railings. Doweled Joints are also required for expansion mitigation in Median Barrier as defined per Sheets 2 & 5. Doweled Joints are not permitted within Grade-Separated Median Barrier.
- CRACK CONTROL V-GROOVES:** At 20-foot intervals, place ¾" depth V-grooves that run vertically and/or transversely in the front, top, and back faces of barriers. The V-grooves can be either molded or scored while the concrete is still plastic.
- SUBGRADE:** Compact the top layer of subgrade with Type B Stabilization, LBR 40 (12 in.).
- FOOTING BOTTOM CONCRETE COVER:** At the bottom of barrier footings shown throughout this Index, up to 2 inches of additional concrete cover is permitted beyond what is shown herein to accommodate soil grade irregularities.
- FINISH GRADE ELEVATION:** At the barrier face location, the finish grade pavement has a vertical position tolerance of ± ½" from the locations shown herein, relative to the barrier elevation. Maintain visually smooth and even pavement at the barrier face, per the approval of the Engineer.
- DRAINAGE INLETS:** Where called for in the Plans, install corresponding inlets per Indexes 425-030 thru 425-032.
- LIGHT POLE MOUNTING:** Where called for in the Plans, install aluminum light poles per Index 715-002.
- OPAQUE VISUAL BARRIER:** Where called for in the Plans, install Opaque Visual Barrier per Index 521-010.
- BARRIER END MARKERS:** For all free ends of concrete barriers that are not shielded with an end treatment or connection to another barrier or traffic railing type, install a Type 3 Object Marker on the end face per Specification 705.
- BARRIER DELINEATORS:** Install Barrier Delineators in accordance with Specification 705. For median barriers, mount the delineator on the top of the barrier, at the centerline of barrier, with reflective sheeting facing traffic on both approaches. For shoulder barriers and split sections, mount the delineators on the top of the barrier, with the roadway side of the delineator located 2' from the front face of the barrier and the reflective sheeting facing traffic of the nearest approach.

- Minimum Barrier Length is 40 feet (dead load required to resist barrier overturn)
- Other miscellaneous details for contractors

## Sheet 2: All new!

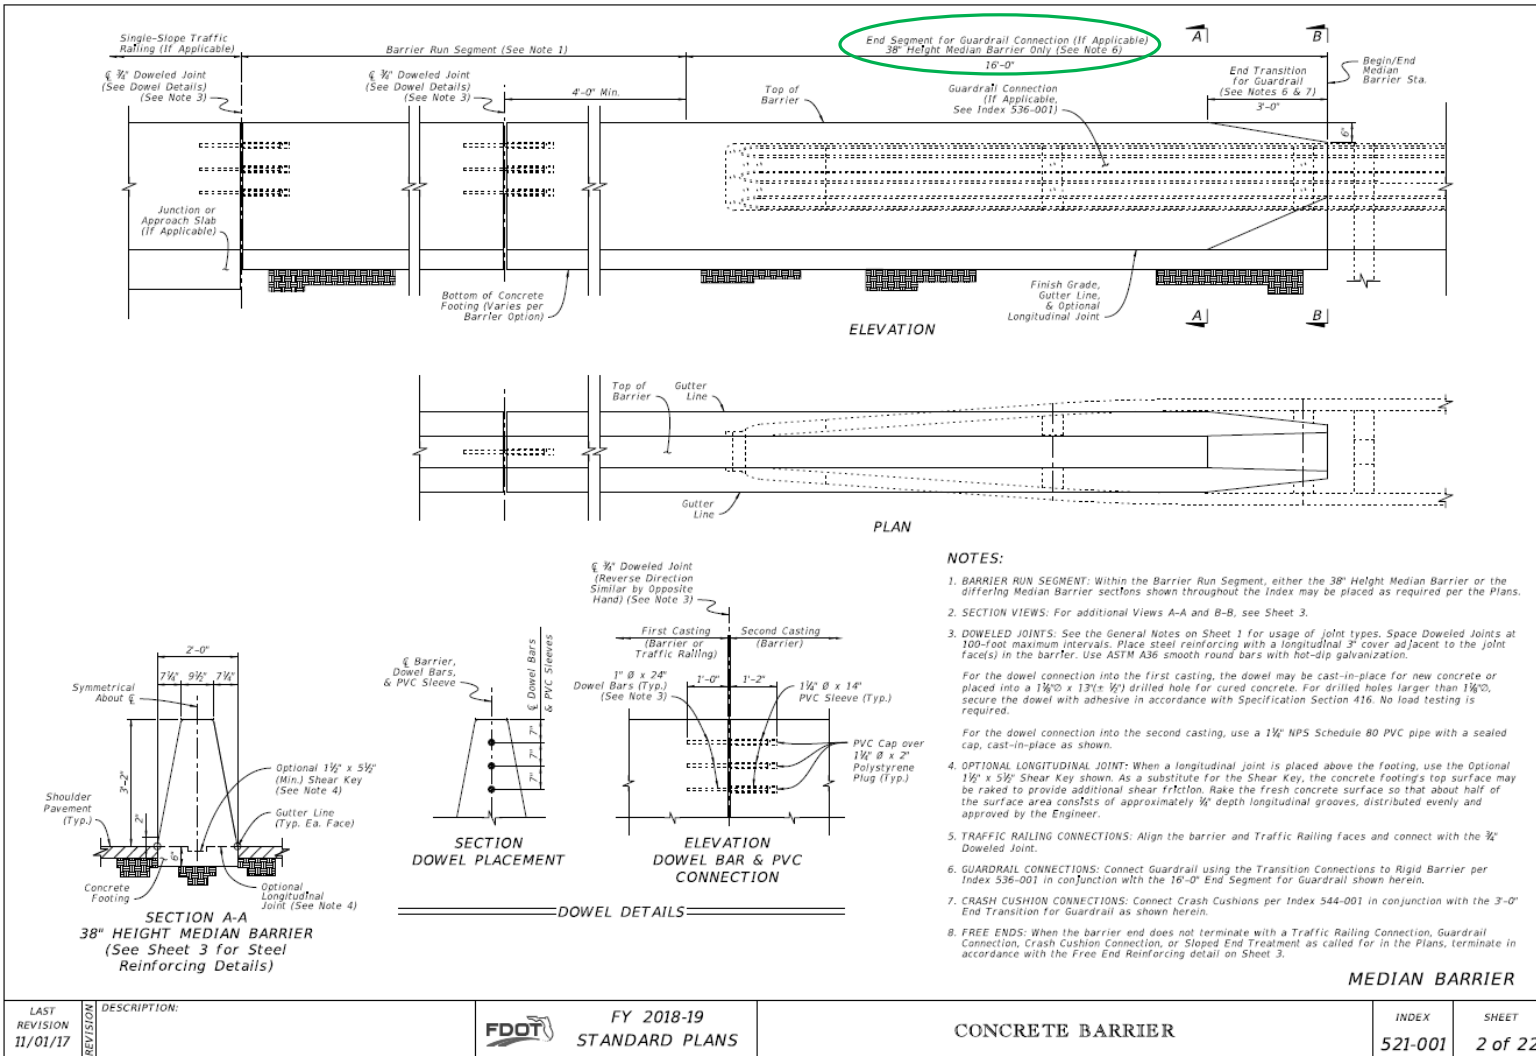



- Shows a basic Plan, Elevation, & Section at the start of each barrier type grouping
- Shows connection to guardrail and bridge Traffic Railing as applicable
- 16'-0" end segment for guardrail connection

LAST REVISION 11/01/17	DESCRIPTION:	FY 2018-19 STANDARD PLANS	CONCRETE BARRIER	INDEX 521-001	SHEET 2 of 22
---------------------------	--------------	------------------------------	------------------	------------------	------------------

## Sheet 2: All new!

### 4 Pay Items for Median Barrier:



- 38" Height Symmetrical (Shown here)
- Short Grade-Separated (Upcoming Slides)
- Tall Grade-Separated (Upcoming Slides)
- Variable Section for Sign or Pier Shielding (Upcoming Slides)

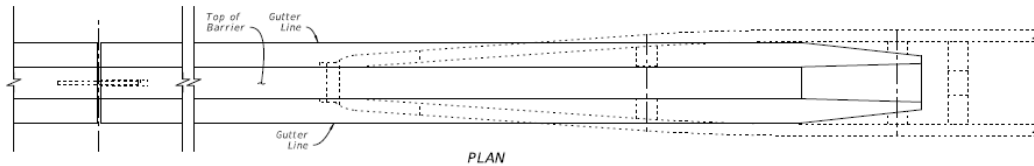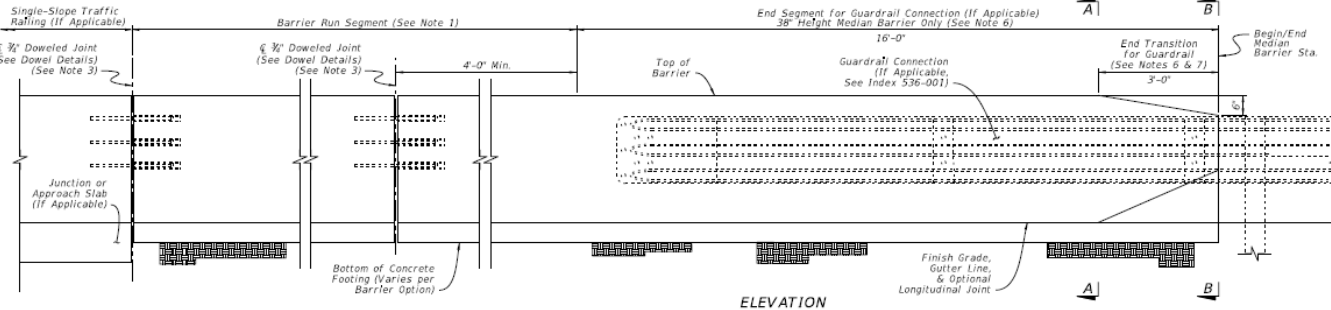

**NOTES:**

- BARRIER RUN SEGMENT:** Within the Barrier Run Segment, either the 38" Height Median Barrier or the differing Median Barrier sections shown throughout the Index may be placed as required per the Plans.
- SECTION VIEWS:** For additional Views A-A and B-B, see Sheet 3.
- DOWELED JOINTS:** See the General Notes on Sheet 1 for usage of joint types. Space Doweled Joints at 100-foot maximum intervals. Place steel reinforcing with a longitudinal 3" cover adjacent to the joint faces in the barrier. Use ASTM A36 smooth round bars with hot-dip galvanization.
  - For the dowel connection into the first casting, the dowel may be cast-in-place for new concrete or placed into a 1 1/2" x 13 1/2" x 1/2" drilled hole for cured concrete. For drilled holes larger than 1 1/2", secure the dowel with adhesive in accordance with Specification Section 416. No load testing is required.
  - For the dowel connection into the second casting, use a 1 1/2" NPS Schedule 80 PVC pipe with a sealed cap, cast-in-place as shown.
- OPTIONAL LONGITUDINAL JOINT:** When a longitudinal joint is placed above the footing, use the Optional 1 1/2" x 5 1/2" Shear Key shown. As a substitute for the Shear Key, the concrete footings' top surface may be raked to provide additional shear friction. Rake the fresh concrete surface so that about half of the surface area consists of approximately 1/2" depth longitudinal grooves, distributed evenly and approved by the Engineer.
- TRAFFIC RAILING CONNECTIONS:** Align the barrier and Traffic Railing faces and connect with the 3/4" Doweled Joint.
- GUARDRAIL CONNECTIONS:** Connect Guardrail using the Transition Connections to Rigid Barrier per Index 536-001 in conjunction with the 16'-0" End Segment for Guardrail shown herein.
- CRASH CUSHION CONNECTIONS:** Connect Crash Cushions per Index 544-001 in conjunction with the 3'-0" End Transition for Guardrail as shown herein.
- FREE ENDS:** When the barrier end does not terminate with a Traffic Railing Connection, Guardrail Connection, Crash Cushion Connection, or Sloped End Treatment as called for in the Plans, terminate in accordance with the Free End Reinforcing detail on Sheet 3.


**MEDIAN BARRIER**

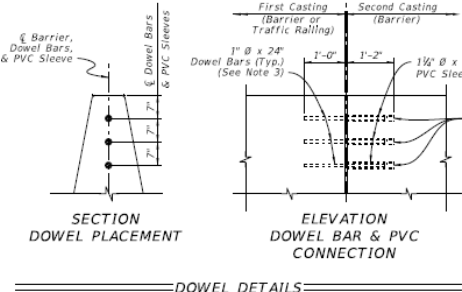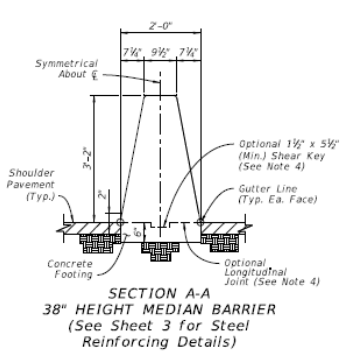


**DOWEL DETAILS**

LAST REVISION 11/01/17	DESCRIPTION:	FY 2018-19 STANDARD PLANS	CONCRETE BARRIER	INDEX 521-001	SHEET 2 of 22
---------------------------	--------------	------------------------------	------------------	------------------	------------------


## Sheet 3: All new!

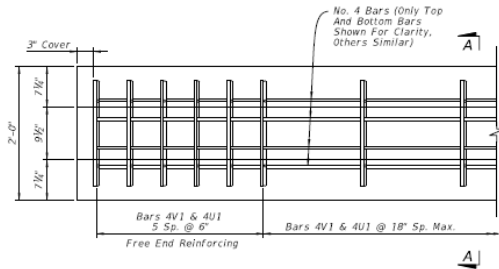


PLAN VIEW - 38" HEIGHT MEDIAN BARRIER  
FREE END REINFORCING (See Note 3)

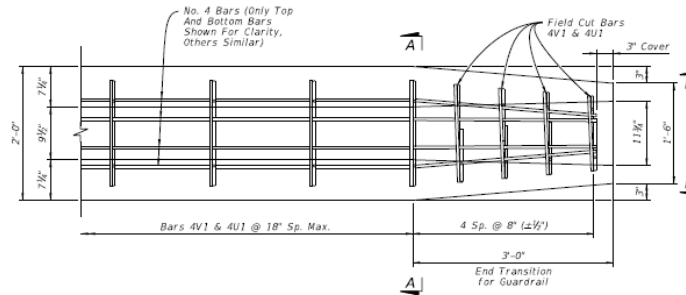

PLAN VIEW - END SEGMENT FOR  
GUARDRAIL CONNECTION (See Note 3)

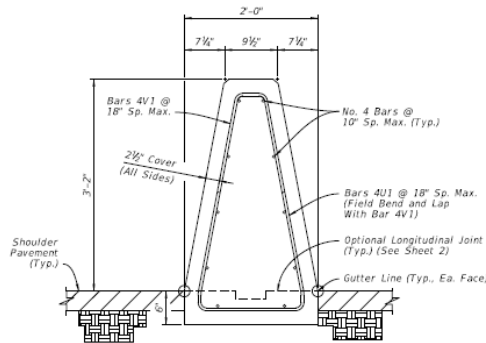

SECTION A-A  
38" HEIGHT  
MEDIAN BARRIER  
Concrete Qty. = 0.20 CY/FT  
Steel Qty. = 11.8 LB/FT

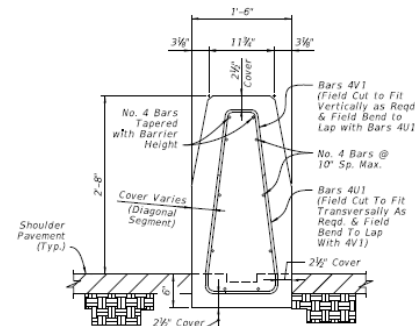

VIEW B-B  
REDUCED SECTION  
OF END TRANSITION  
FOR GUARDRAIL  
(End of Barrier)

### MEDIAN BARRIER - REINFORCING DETAILS






#### NOTES:

1. GENERAL: Work with the Plan and Elevation Views on Sheet 2.
2. BAR BENDING DIAGRAMS: For additional information on Bars 4V1 and 4U1, see the details on Sheet 22.
3. PLAN VIEWS: Only top and bottom longitudinal reinforcing is shown for clarity. For all longitudinal steel locations, see the section views.

- New reinforcing details for normal run and connection to guardrail
- Provides minimum reinforcing required for slip-forming

LAST REVISION 11/01/17	DESCRIPTION:	FY 2018-19 STANDARD PLANS	CONCRETE BARRIER	INDEX 521-001	SHEET 3 of 22
---------------------------	--------------	------------------------------	------------------	------------------	------------------

## Sheet 4: All new!

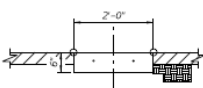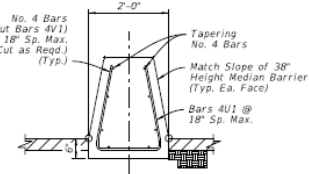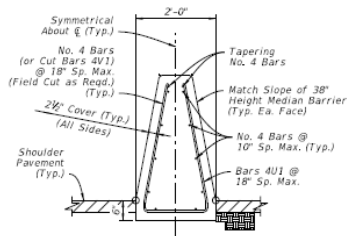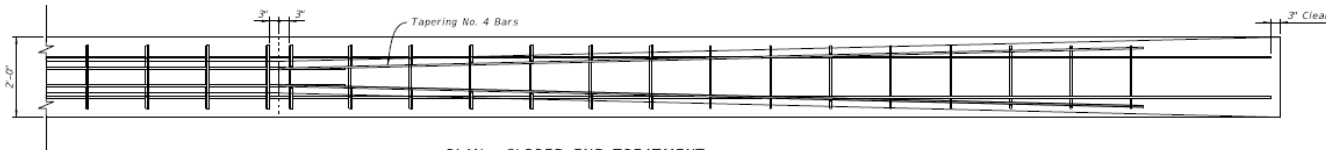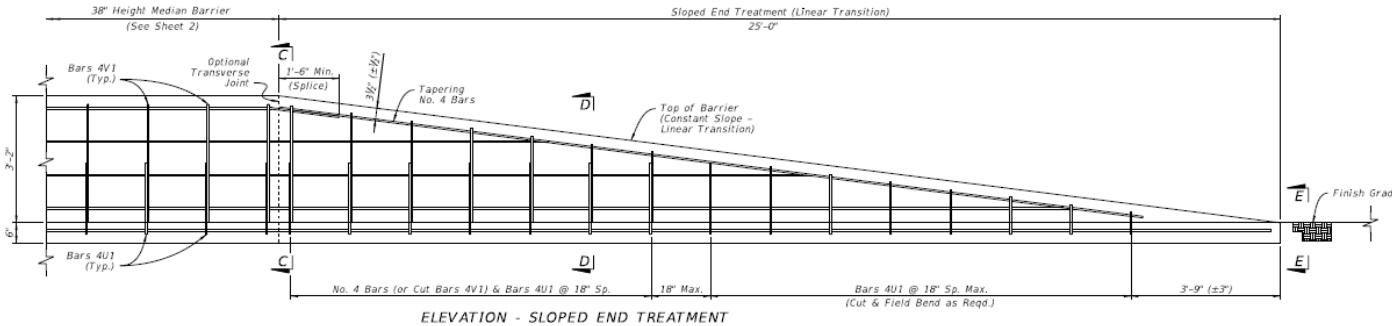


- NOTES:**
1. GENERAL: Install Sloped End Treatment only where called for in the plans.
  2. JOINTS: Construction or Doweled Joints are not permitted within the Sloped End Treatment segment.

**MEDIAN BARRIER - SLOPED END TREATMENT**

- Permitted for Median Barriers on the Trailing End or outside of any approaching lane's Clear Zone.
- Usage explained in the Standard Plans Instructions (SPI) table

LAST REVISION 11/01/17	DESCRIPTION:	FDOT FY 2018-19 STANDARD PLANS	CONCRETE BARRIER	INDEX 521-001	SHEET 4 of 22
---------------------------	--------------	--------------------------------------	------------------	------------------	------------------

## Sheet 5: All new!

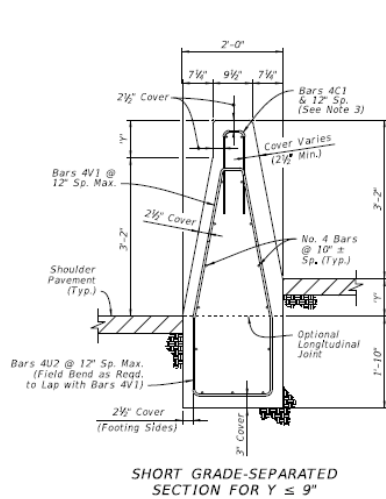

**NOTES:**



- GENERAL:** Install the Grade-Separated sections where shown in the Plans and as required to accommodate vertical offsets in pavement of Height  $Y$ . Doweled Joints are not permitted within Grade-Separated sections.
- CONNECTIONS BETWEEN DIFFERENT SECTIONS:** Connect Short Grade-Separated sections and Tall Grade-Separated sections using a continuous pour or Transverse Joint, where longitudinal steel that aligns within the adjacent section is maintained continuously between sections or has a full lap splice with the adjacent section's longitudinal steel. Connect Short Grade-Separated sections and 38" Height Median Barrier sections of Sheet 2 using a  $\frac{3}{4}$ " Doweled Joint.
- SHORT GRADE-SEPARATED SECTIONS:** Bars 4C1 and the two uppermost longitudinal bars may be omitted for segments where  $Y < 2"$ .
- TALL GRADE-SEPARATED SECTIONS:** For the vertical and transverse steel reinforcement shown in the Tall Grade-Separated Sections, bar bending diagrams are not provided due to varying section dimensions and Longitudinal Joint locations. Use any combination of spaced reinforcing steel to position the reinforcement with the same cover, spacing, continuity, and equivalent strength shown herein, as approved by the Engineer.

Longitudinal Joints are permitted between the vertical limits shown, and must remain level and at a consistent height per each continuous casting of concrete. Longitudinal Joints may change elevations at Transverse Joint locations. Field bending of bars is permitted at Longitudinal Joint locations.

Transverse Joints between Tall Grade-Separated Sections do not require continuous steel across the joint if the following conditions are met:

- The barrier length on both sides  $L_s$  is at least 40 feet, where each segment has continuous steel reinforcement.
- The barrier's vertical steel spacing is reduced to 4" O.C. for a total of 12 spaces on both sides of the joint.

Grade separation Heights of  $Y \leq 9"$  are permitted on a limited basis using the Tall Grade-Separated section; this is to accommodate cases where maintaining the spread footing through lower height segments is more practical than changing to the Short Grade-Separated section.

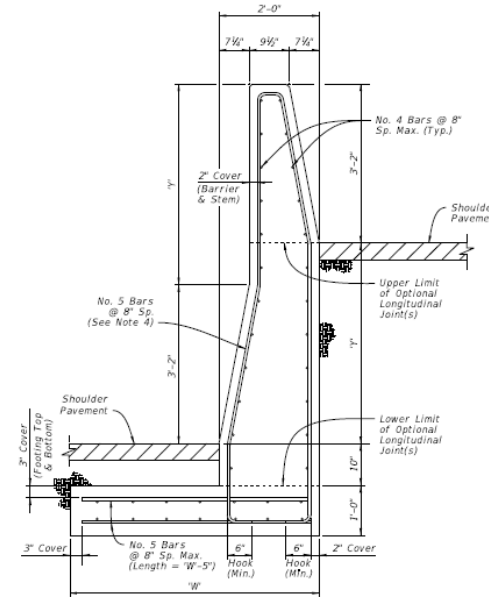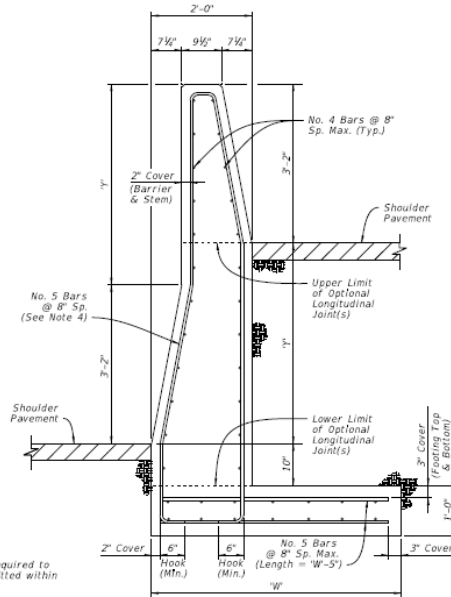

**TALL GRADE-SEPARATED SECTIONS DIMENSION TABLE**


Max. Height, $Y$	1'-0"	1'-6"	2'-0"	2'-6"	3'-0"	3'-6"	4'-0"
Footing Width, $W$	3'-3"	3'-6"	3'-9"	4'-0"	4'-3"	4'-6"	4'-6"

**MEDIAN BARRIER - GRADE-SEPARATED**

- Similar to Previous Standard from Design Standpoint
- Larger foundations and footings for MASH



## Sheet 6: All new!


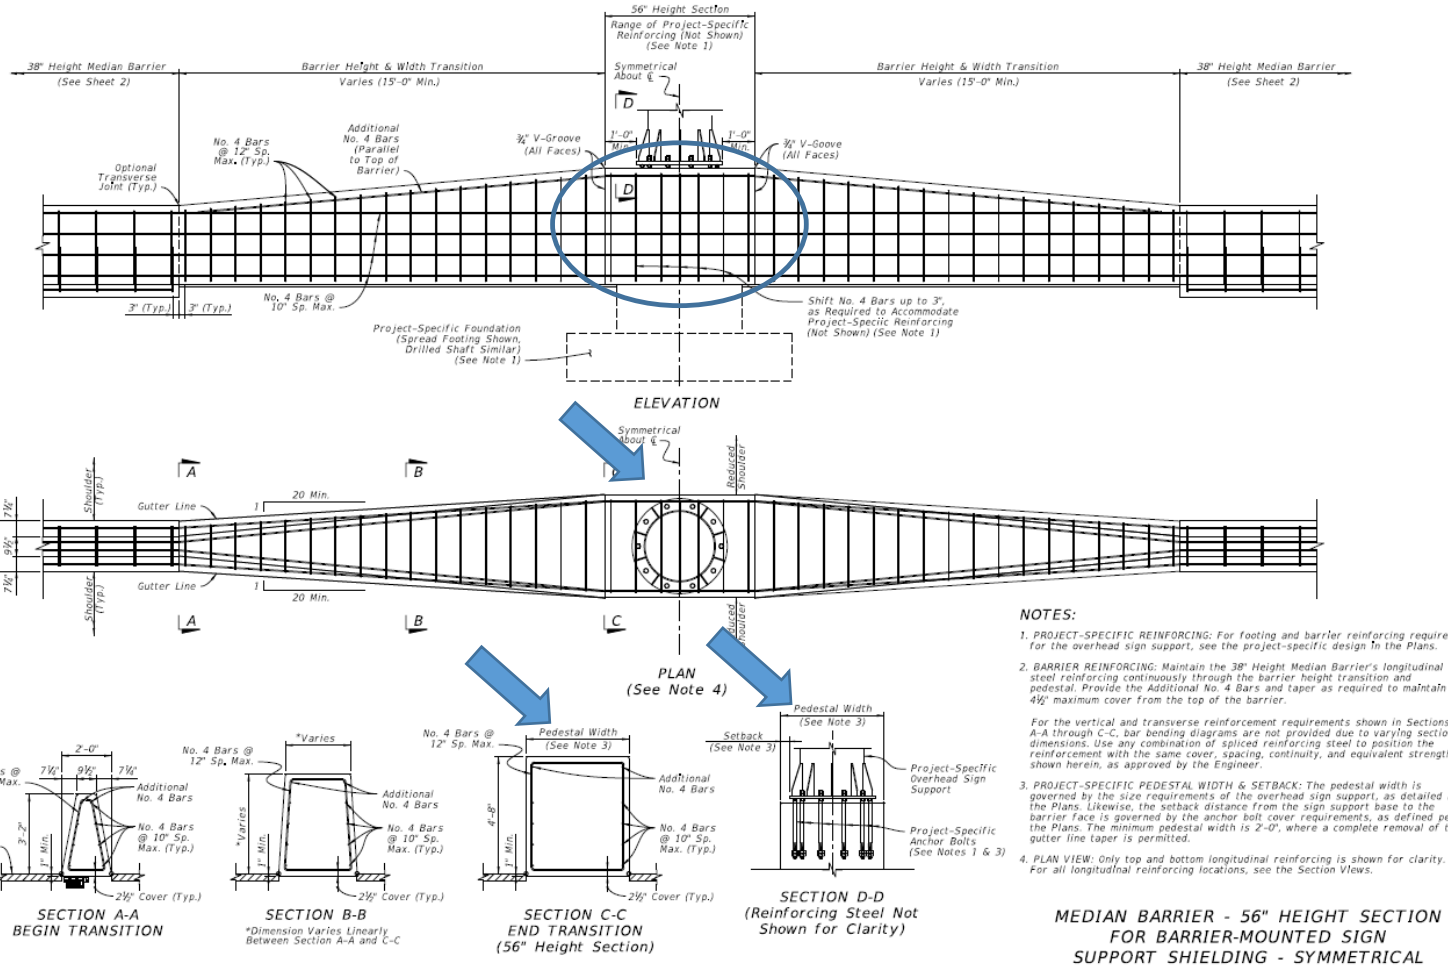


- Clarified where project-specific steel design is required for connection to sign support foundation
- Pedestal Width varies as required
- May be used at 2'-0" wide Pedestal Width (zero taper)

LAST REVISION 11/01/17	DESCRIPTION:	FDOT FY 2018-19 STANDARD PLANS	CONCRETE BARRIER	INDEX 521-001	SHEET 6 of 22
---------------------------	--------------	--------------------------------------	------------------	------------------	------------------





## Sheet 7: All new!

- Similar to previous sheet, but asymmetrical – shoulder reduction only on one side

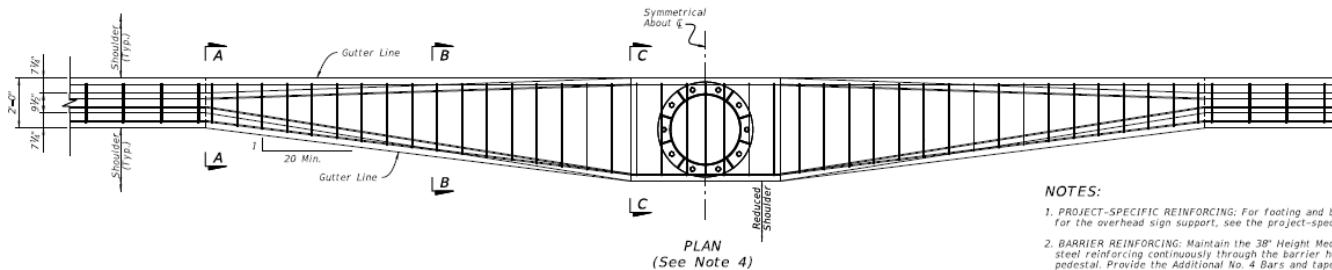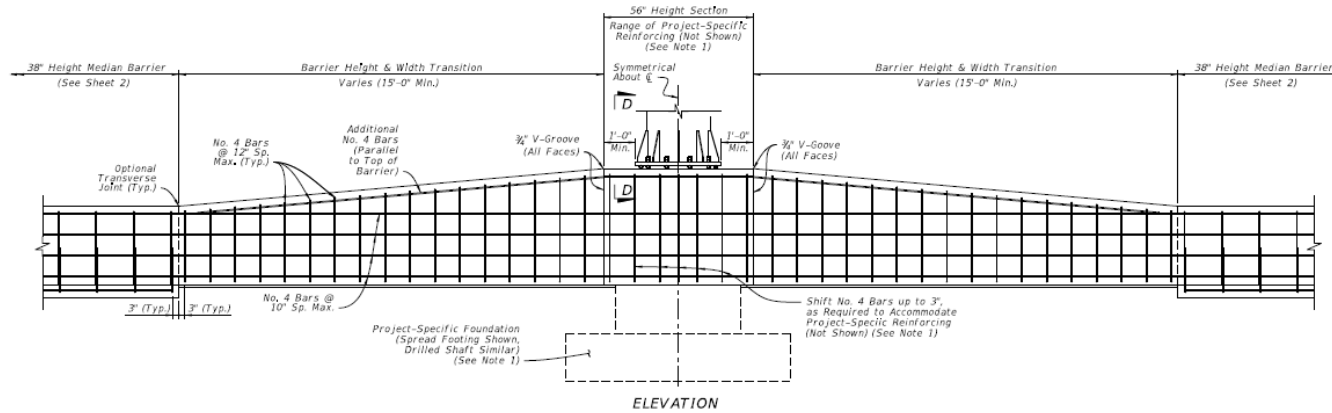

**NOTES:**

- PROJECT-SPECIFIC REINFORCING:** For footing and barrier reinforcing required for the overhead sign support, see the project-specific design in the Plans.
- BARRIER REINFORCING:** Maintain the 38" Height Median Barrier's longitudinal steel reinforcing continuously through the barrier height transition and pedestal. Provide the Additional No. 4 Bars and taper as required to maintain a 4 1/2" maximum cover from the top of the barrier.  
*For the vertical and transverse reinforcement requirements shown in Sections A-A through C-C, bar bending diagrams are not provided due to varying section dimensions. Use any combination of spliced reinforcing steel to position the reinforcement with the same cover, spacing, continuity, and equivalent strength shown herein, as approved by the Engineer.*
- PROJECT-SPECIFIC PEDESTAL WIDTH & SETBACK:** The pedestal width is governed by the size requirements of the overhead sign support, as detailed in the Plans. Likewise, the setback distance from the sign support base to the barrier face is governed by the anchor bolt cover requirements, as defined per the Plans. The minimum pedestal width is 2'-0", where a complete removal of the gutter line taper is permitted.
- PLAN VIEW:** Only top and bottom longitudinal reinforcing is shown for clarity. For all longitudinal reinforcing locations, see the Section Views.

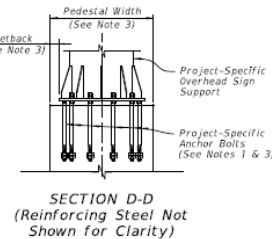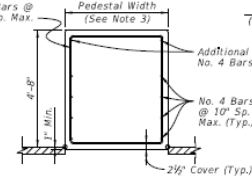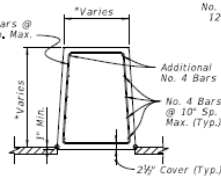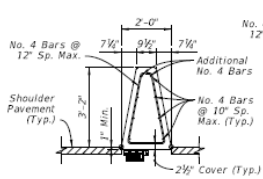

**MEDIAN BARRIER - 56" HEIGHT SECTION  
FOR BARRIER-MOUNTED SIGN  
SUPPORT SHIELDING - ASYMMETRICAL**

LAST REVISION 11/01/17	DESCRIPTION:	FY 2018-19 STANDARD PLANS	CONCRETE BARRIER	INDEX	SHEET
				521-001	7 of 22


## Sheet 8: All new!

An alternative for sign support shielding where...


- Shielding an existing sign support, or...

- Designer prefers independent foundation for sign support


- Lateral space is available

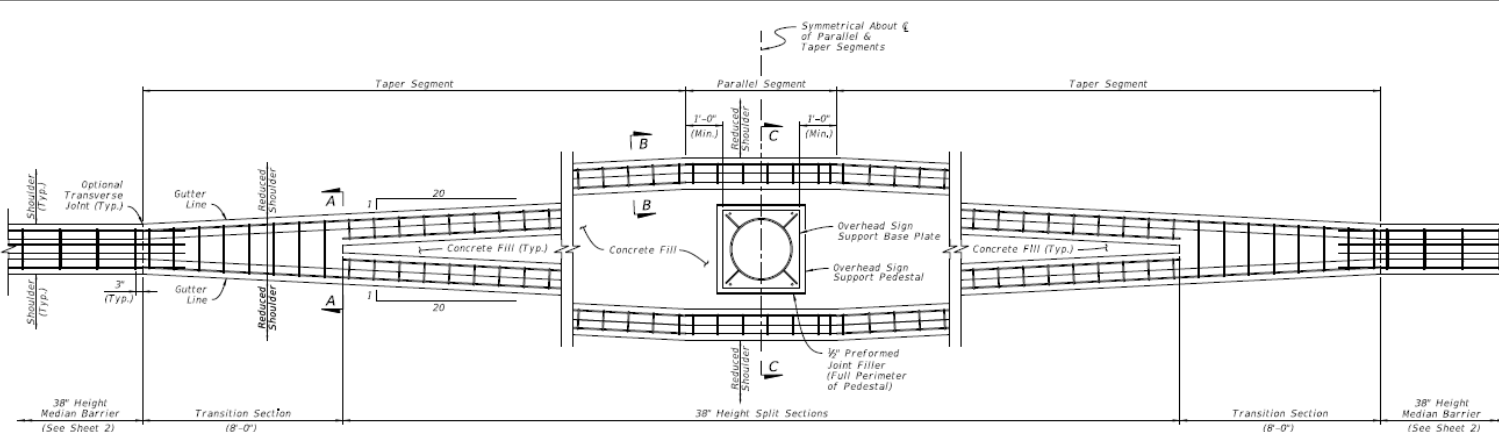


PLAN  
(See Note 4)

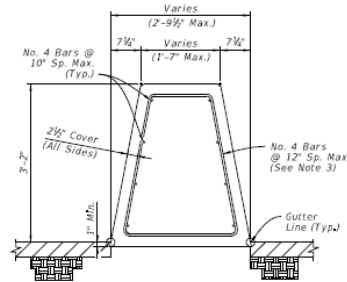

SECTION A-A  
TRANSITION SECTION  
(AT BEGIN  
SPLIT SECTIONS)

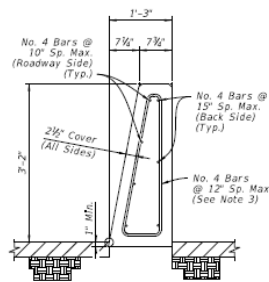

SECTION B-B  
38" HEIGHT SPLIT SECTION  
(OPPOSITE SIDE SIMILAR  
BY OPPOSITE HAND)

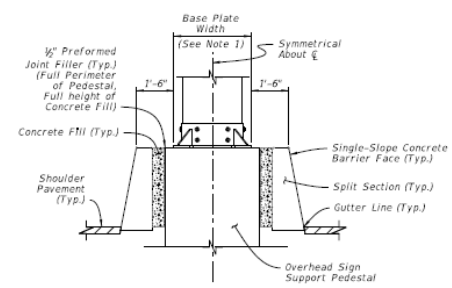


SECTION C-C

- NOTES:**
- OVERHEAD SIGN SUPPORT:** The overhead sign support shown is an example only; see the Plans for the actual shape dimensions and requirements. The overall length and width of the split barrier system is governed by the project-specific overhead sign support dimensions, as defined in the Plans.
  - MULTIPLE SIGN SUPPORTS:** The parallel segment may be lengthened to accommodate multiple sign supports, with the approach and trailing tapers located 1 foot, measured longitudinally, upstream and downstream from the first and last sign support bases, respectively.
  - STIRRUP BARS:** For the vertical and transverse reinforcement requirements shown in Sections A-A and B-B, bar bending diagrams are not provided due to varying section dimensions. Use any combination of spliced reinforcing steel to position the reinforcement with the same cover, spacing, continuity, and equivalent strength shown herein, as approved by the Engineer.
  - PLAN VIEW:** Only outermost longitudinal reinforcing is shown for clarity. For all longitudinal reinforcing locations, see the Section Views.

MEDIAN BARRIER - 38" HEIGHT SPLIT SECTION  
FOR STAND-ALONE SIGN SUPPORT SHIELDING

LAST REVISION 11/01/17	DESCRIPTION:	FDOT FY 2018-19 STANDARD PLANS	CONCRETE BARRIER	INDEX 521-001	SHEET 8 of 22
---------------------------	--------------	--------------------------------------	------------------	------------------	------------------

## Sheet 9: All new!

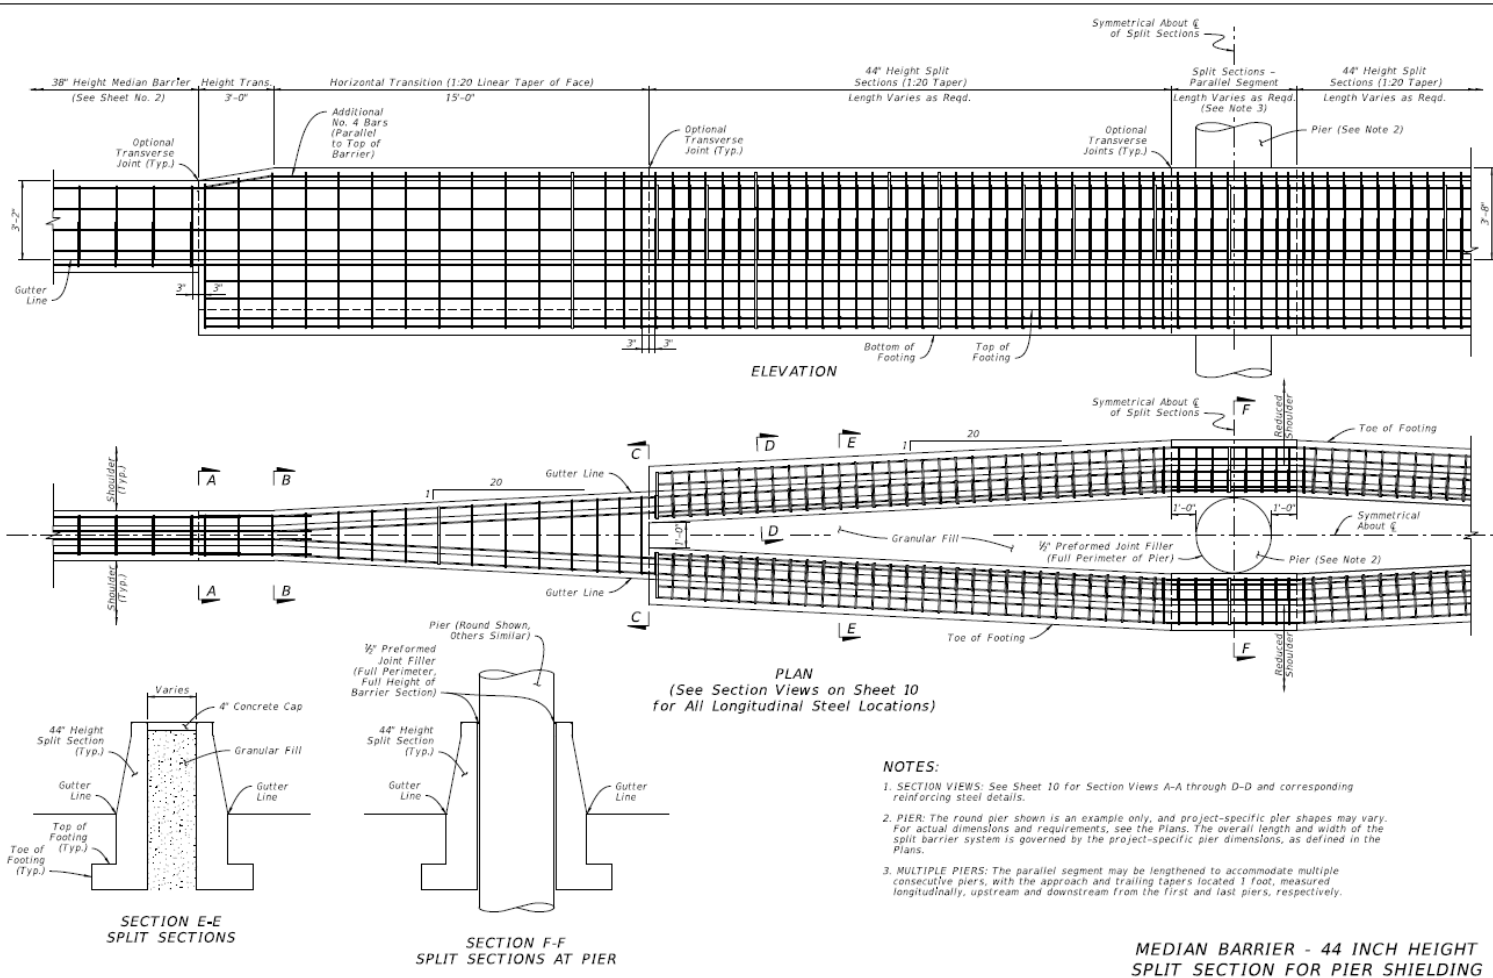

**NOTES:**

- SECTION VIEWS: See Sheet 10 for Section Views A-A through D-D and corresponding reinforcing steel details.
- PIER: The round pier shown is an example only, and project-specific pier shapes may vary. For actual dimensions and requirements, see the Plans. The overall length and width of the split barrier system is governed by the project-specific pier dimensions, as defined in the Plans.
- MULTIPLE PIERS: The parallel segment may be lengthened to accommodate multiple consecutive piers, with the approach and trailing tapers located 1 foot, measured longitudinally, upstream and downstream from the first and last piers, respectively.


**MEDIAN BARRIER - 44 INCH HEIGHT  
SPLIT SECTION FOR PIER SHIELDING**

- For shielding pier for crash-worthiness benefit to vehicle only (assumes pier is designed to withstand impact)
- Where a pier is not designed to withstand impacts, use "Pier Protection Barrier" per 521-002 (See SPI & FDM for Guidance)




LAST REVISION 11/01/17	DESCRIPTION:	FY 2018-19 STANDARD PLANS	CONCRETE BARRIER	INDEX 521-001	SHEET 9 of 22
---------------------------	--------------	------------------------------	------------------	------------------	------------------

## Sheet 10: All new!

- Required Section dimensions and reinforcing details for the previous sheet

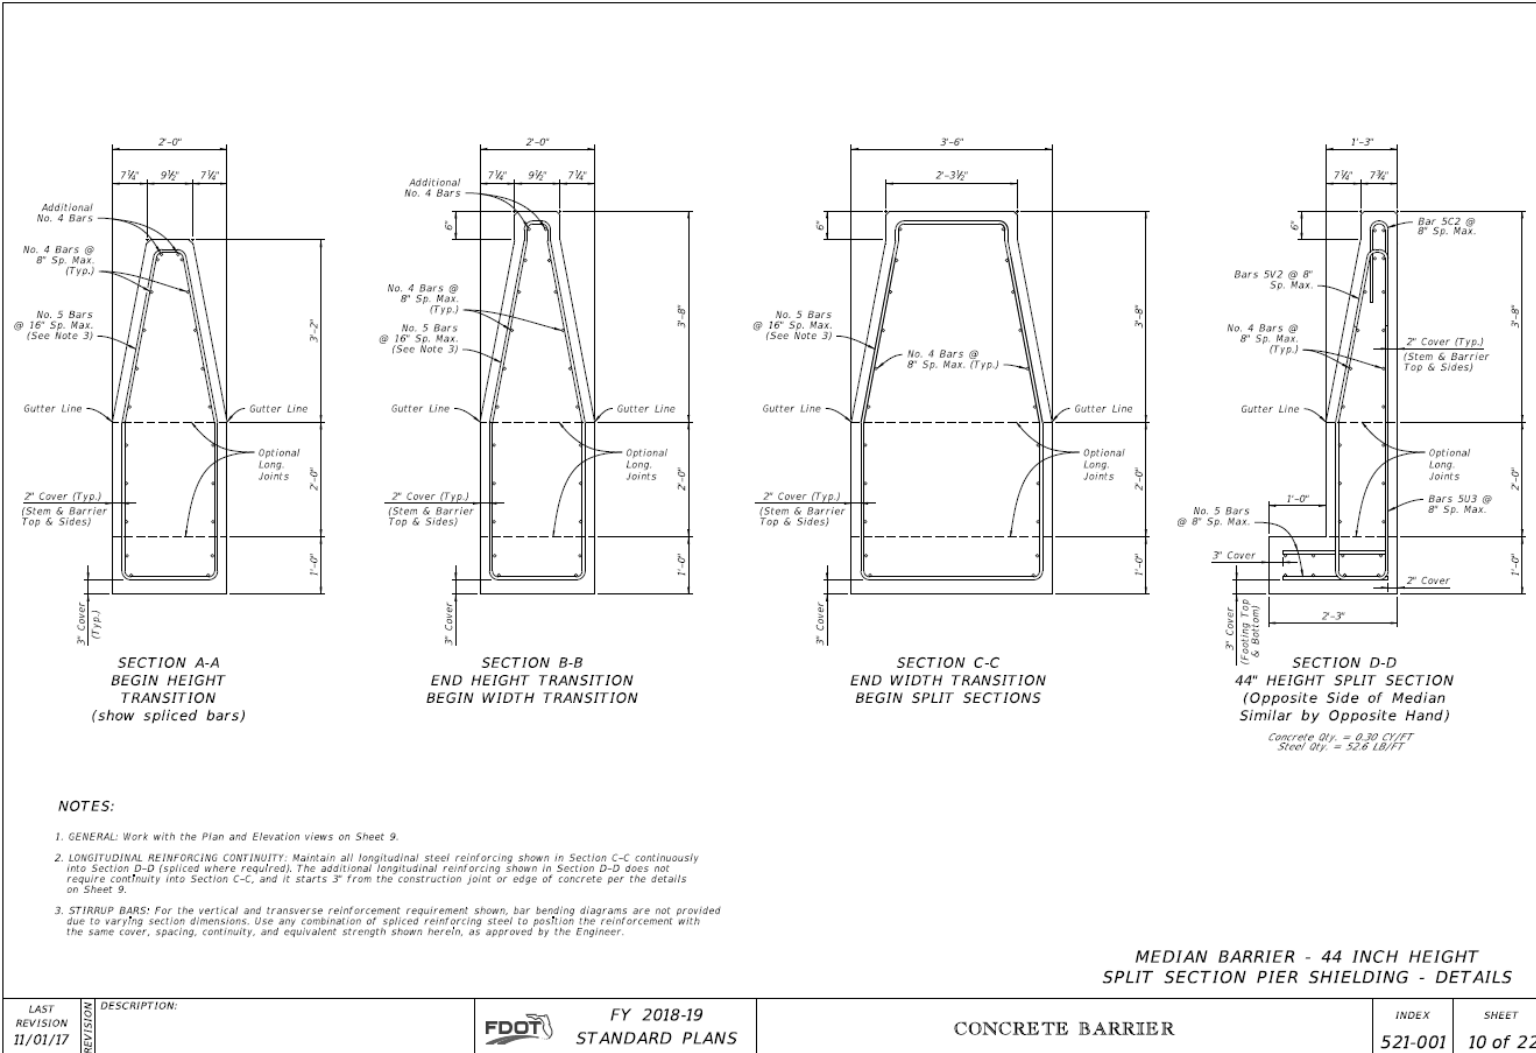

## Sheet 11: All new!

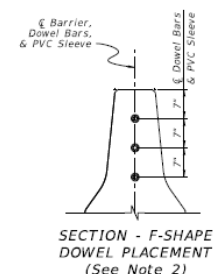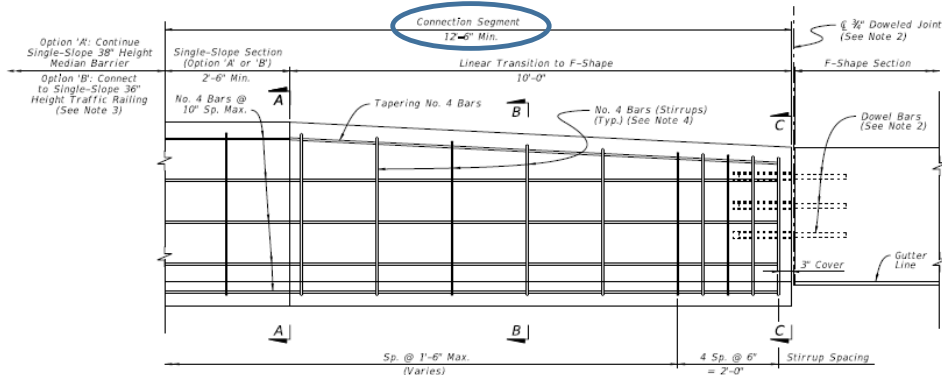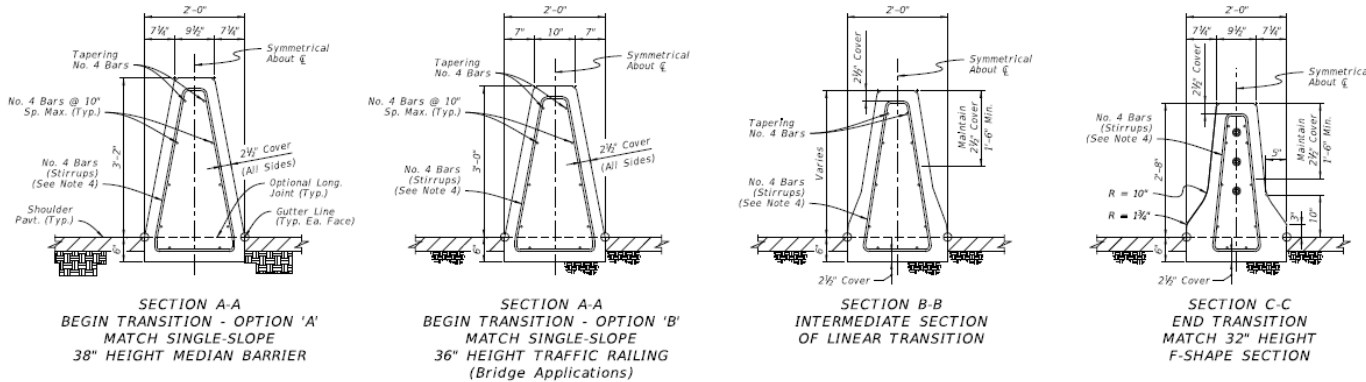


- NOTES:**
1. GENERAL: Construct the Connection Segment as required per the Plans to connect existing F-Shape sections to Single-Slope Median Barrier or Traffic Railing sections. Construct Option 'A' or 'B' as required to match the heights of the connecting sections.
  2. DOWELED JOINT: Install Dowel Bars per the Dowel Details on Sheet 2.
  3. TRAFFIC RAILING CONNECTION: For the Option 'B' connection, use a Doweled Joint per Sheet 2 and the additional Free End Reinforcing with reduced bar spacing per Sheet 3.
  4. STIRRUP BARS: For the vertical and transverse reinforcement requirements shown, bar bending diagrams are not provided due to varying section dimensions. Use any combination of spliced reinforcing steel to position the reinforcement with the same cover, spacing, continuity, and equivalent strength shown herein, as approved by the Engineer.

- For transitioning any existing F-Shape to Single-Slope Section
- Requires 12'-6" minimum length between connecting section types

MEDIAN BARRIER - CONNECTION TO F-SHAPE


LAST REVISION 11/01/17	DESCRIPTION:	FY 2018-19 STANDARD PLANS	CONCRETE BARRIER	INDEX 521-001	SHEET 11 of 22
---------------------------	--------------	------------------------------	------------------	------------------	-------------------

## Sheet 12: All new!

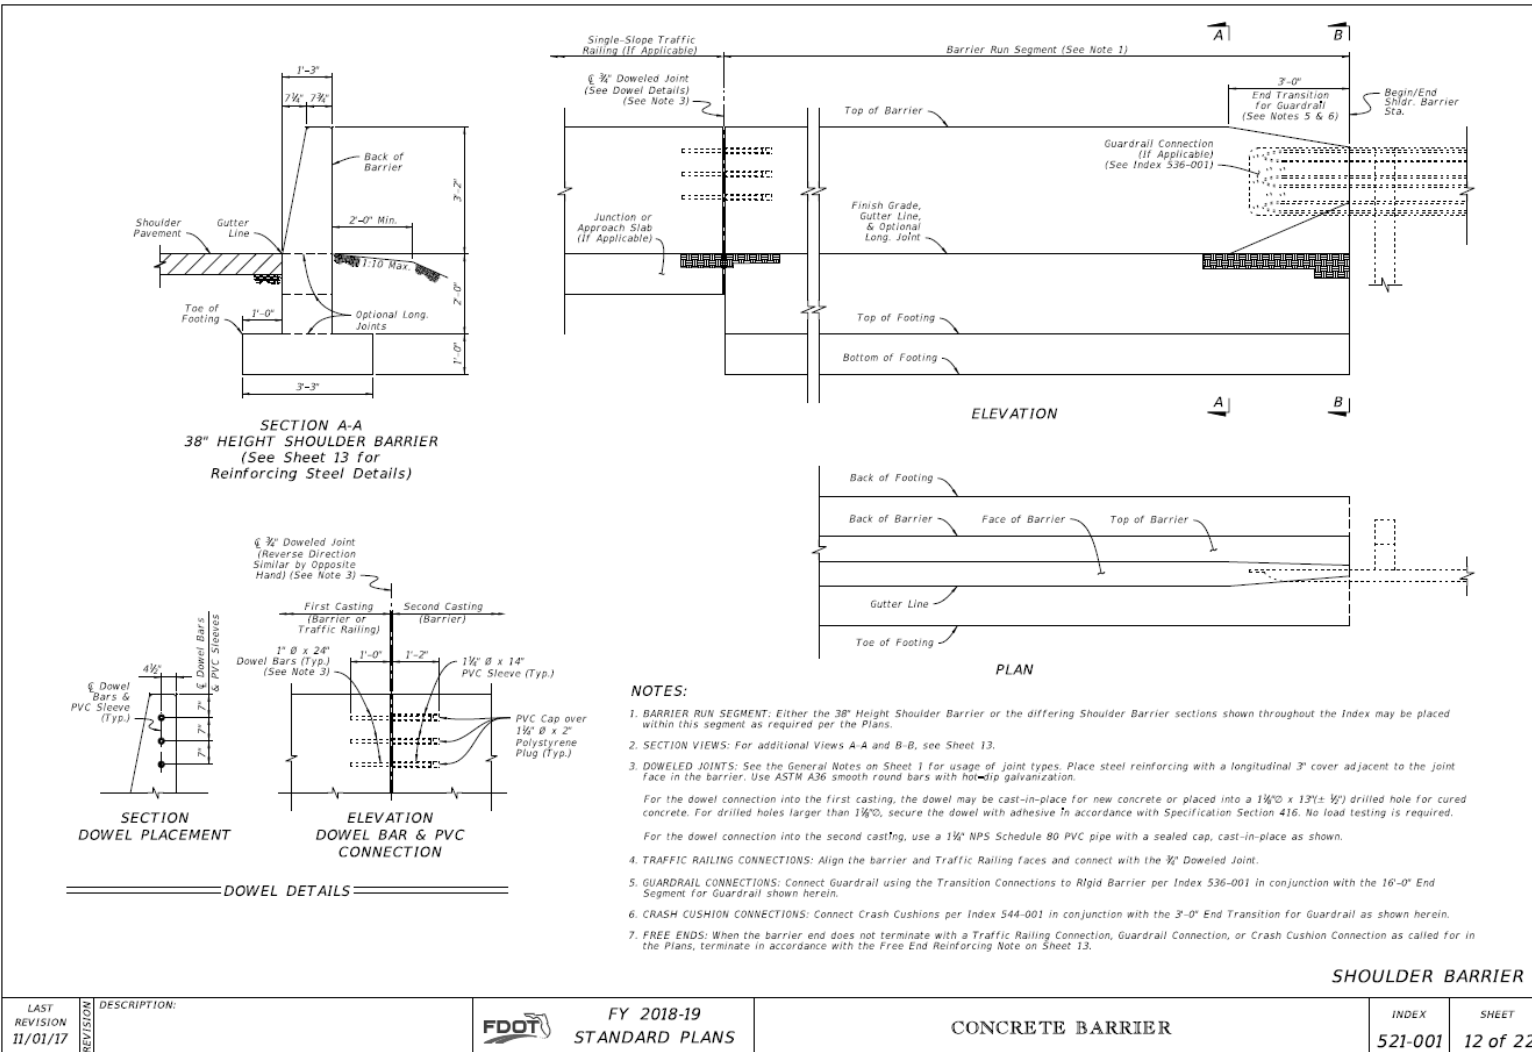

- This sheet begins the “Shoulder Barrier” grouping with basic Plan, Elevation, & Section
- Typically used on “outside” shoulders (where Median Barrier or Curb & Gutter Barrier is not used)

## Sheet 12: All new!

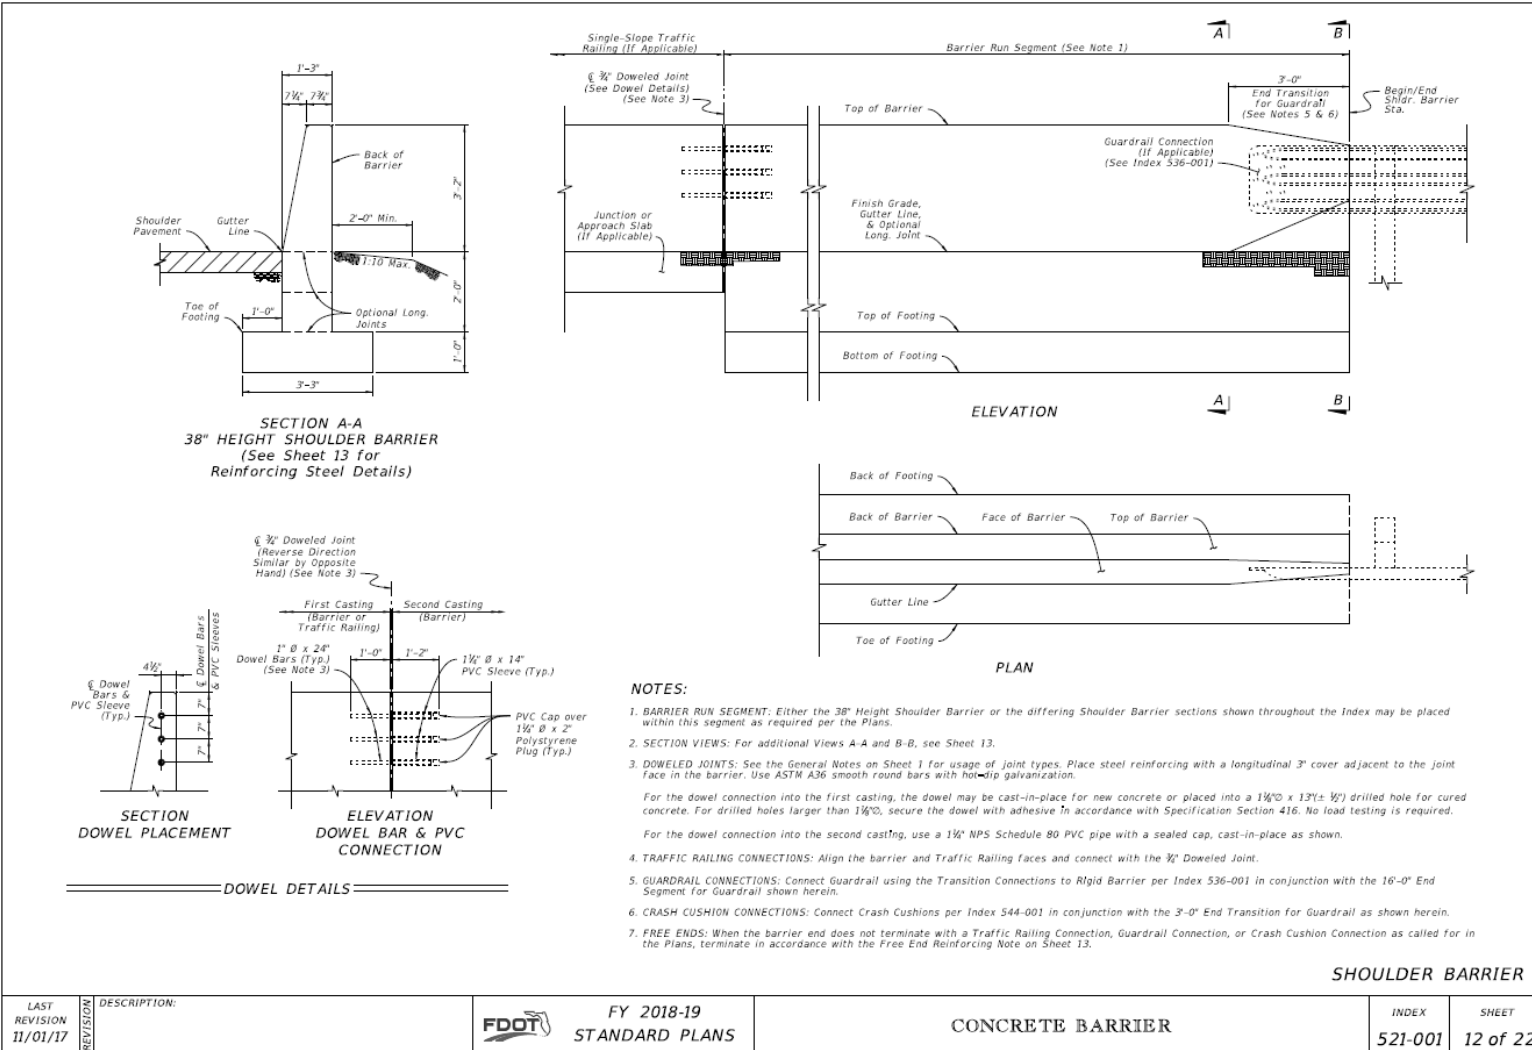


### 3 Pay Items for Shoulder Barrier:

- 38" or 44" Height (Shown here)
- Retaining Section (Upcoming Slides)
- Trench Footing Section (Upcoming Slides)




## Sheet 13: All new!

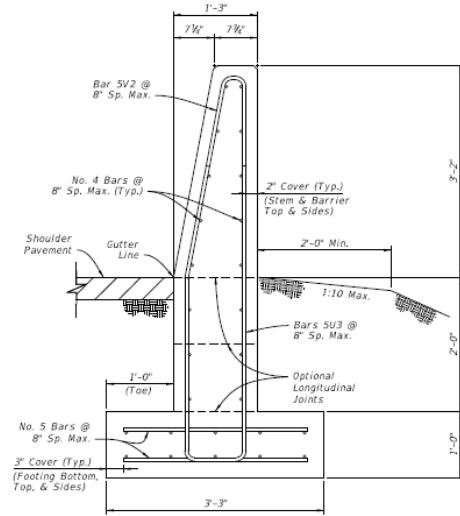


**SECTION A-A**  
**38" HEIGHT SHOULDER BARRIER**

Concrete Qty. = 0.32 CY/FT  
Steel Qty. = 50.9 LB/FT

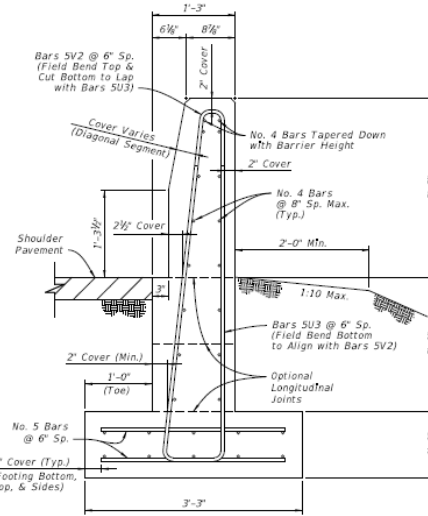

**VIEW B-B**  
**REDUCED SECTION OF**  
**END TRANSITION**  
**FOR GUARDRAIL**  
**(End of Barrier)**

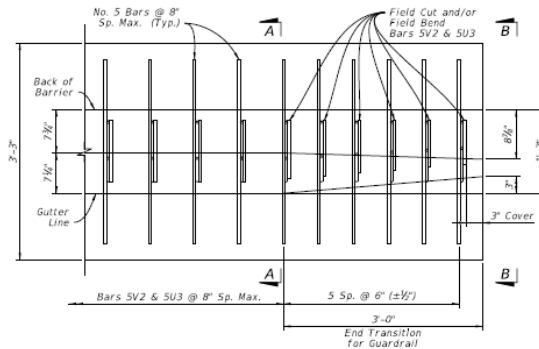

**PLAN VIEW - END SEGMENT FOR GUARDRAIL CONNECTION**  
**(Longitudinal Steel Not Shown for Clarity)**

**SHOULDER BARRIER - REINFORCING DETAILS**





- Sheet shows reinforcing details, both in a normal run and as required to taper down for a guardrail connection

**NOTES:**

- GENERAL:** Work with the Plan and Elevation Views on Sheet 12. The Section Option Footings shown on Sheet 14 may be substituted where called for in the Plans.
- FREE END REINFORCING:** Where shown in the Plans, terminate the 38" Height Barrier section with a transverse vertical end face. Reduce the spacing of Bars SV2 and SV3 to 6" for 5 Spaces, placed with 3" cover from the barrier's end face.
- BAR BENDING DIAGRAMS:** For additional details for bars SV2 and SV3, see the Bar Bending Diagrams on Sheet 22.

LAST REVISION 11/01/17	REVISION	DESCRIPTION	FY 2018-19 STANDARD PLANS	CONCRETE BARRIER	INDEX	SHEET
					521-001	13 of 22

## Sheet 14: All new!

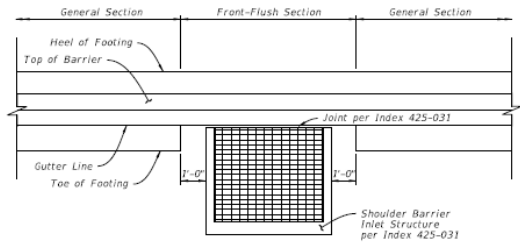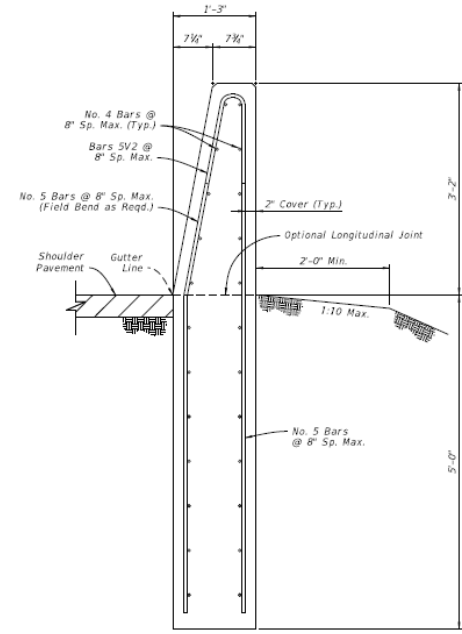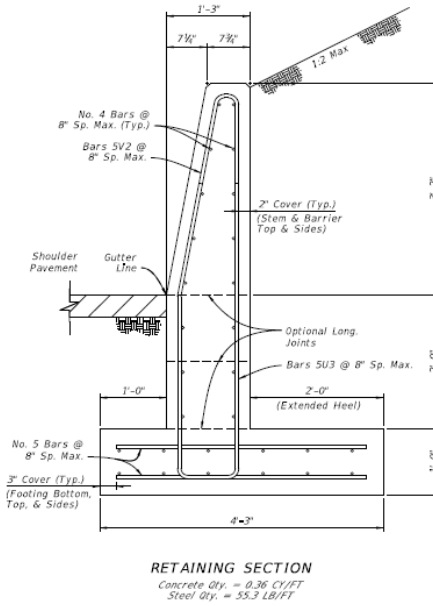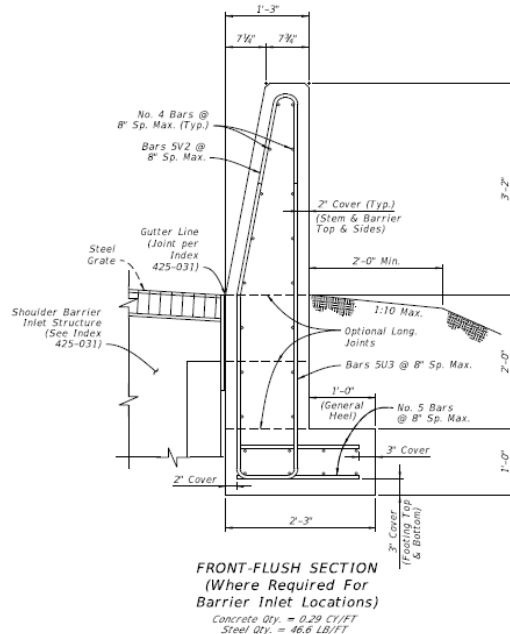


- NOTES:**
1. GENERAL: Install the differing Section Options as required per the Plans.
  2. CONNECTIONS BETWEEN DIFFERENT SECTIONS: Connect differing Shoulder Barrier sections using a continuous pour or Transverse Joint, where longitudinal steel that aligns within the adjacent section is maintained continuously between sections. Alternatively, a Doweled Joint may be used as shown on Sheet 12.
  3. FLUSH RETAINING SECTION COMBINATION: Where Barrier Inlets are required in retaining segments, install the Flush Section, except replace the 1'-0" General Heel with the 2'-0" Extended Heel as shown in the Retaining Section. Use longer lateral reinforcing bars of 2'-10" length to maintain the cover shown.

**SHOULDER BARRIER - SECTION OPTIONS**

- Section alternatives as required
- Retaining Section Heel larger than previous
- New Trench footing option

## Sheet 15: All new!

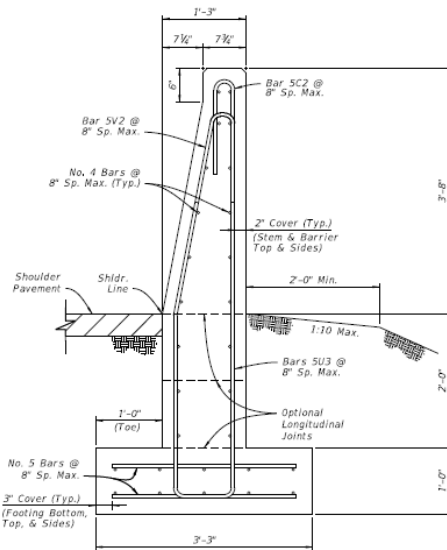


**44" HEIGHT SECTION**  
(For Use Adjacent to Rear-Flush Section on Sheet 17)

Concrete Qty. = 0.34 CY/FT  
Steel Qty. = 36.6 LB/FT

**NOTE:**

1. GENERAL: See the applicable Notes on Sheet 14.

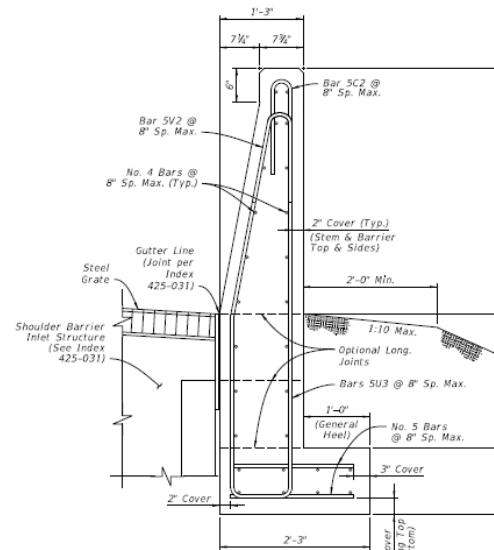

**44" HEIGHT FRONT-FLUSH SECTION**  
(For Use Adjacent to Rear-Flush Section on Sheet 17, as Required for Barrier Inlets)


Concrete Qty. = 0.30 CY/FT  
Steel Qty. = 52.6 LB/FT

SHOULDER BARRIER - SECTION OPTIONS (CONTINUED)

- A few more sections as they work with pier shielding on following sheets
- 44" Height Section has same Pay Item as "regular" 38" Height Section (named: 38" or 44" Height Shoulder Barrier in BOE)

LAST REVISION 11/01/17	DESCRIPTION:		FY 2018-19 STANDARD PLANS	CONCRETE BARRIER	INDEX 521-001	SHEET 15 of 22
---------------------------	--------------	--	------------------------------	------------------	------------------	-------------------







## Sheet 16: All new!

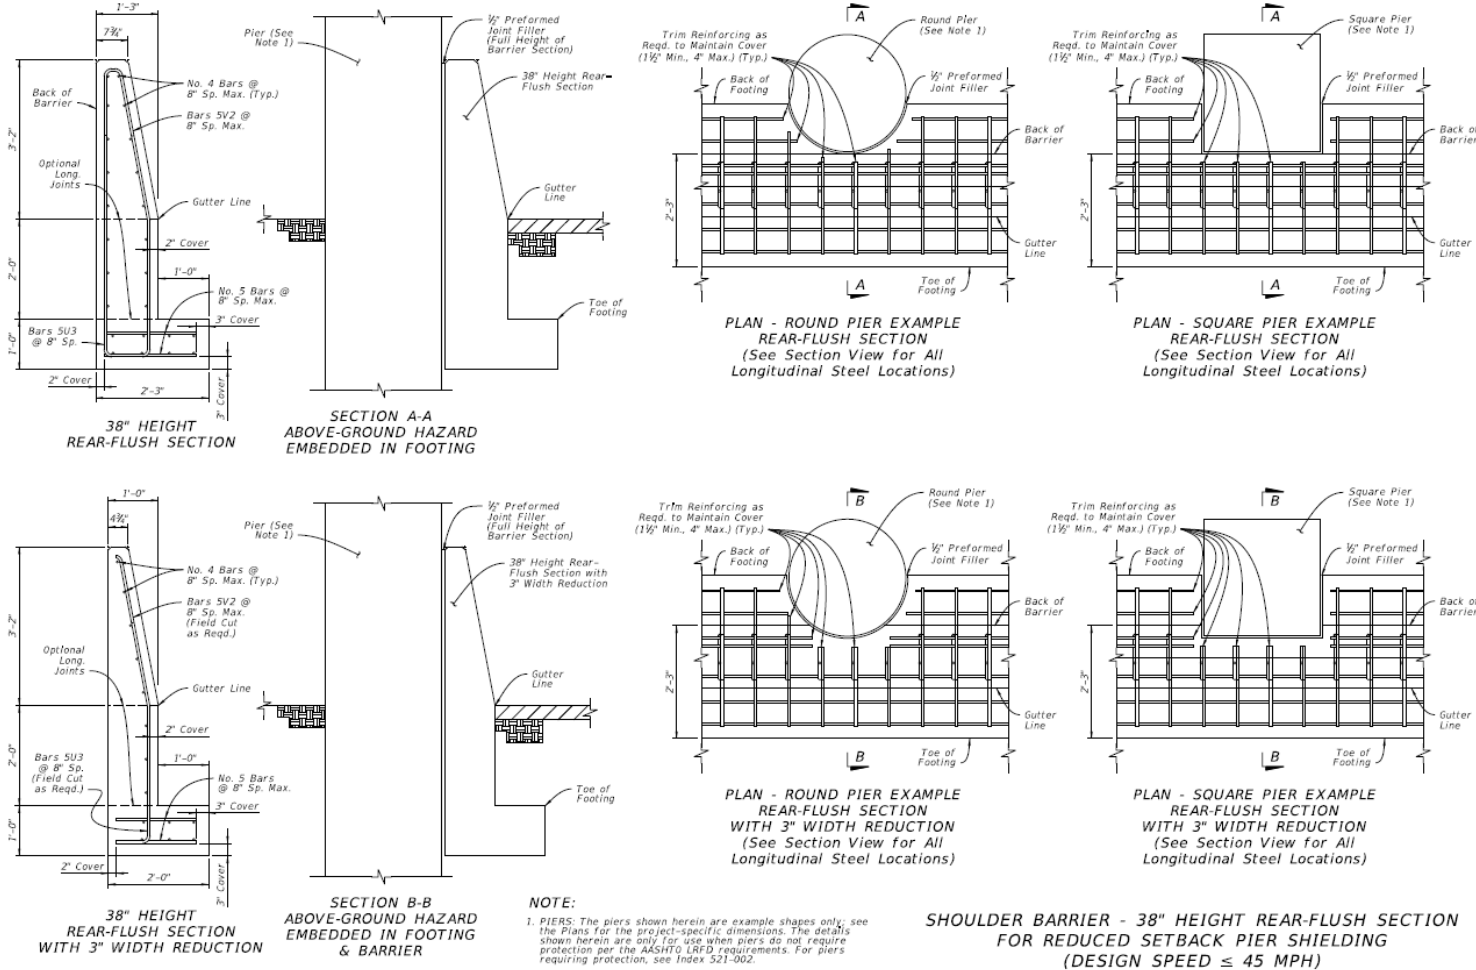

- For shielding pier for crash-worthiness benefit to vehicle only (assumes pier is designed to withstand impact)
- Where a pier is not designed to withstand impacts, use “Pier Protection Barrier” per 521-002 (See SPI & FDM for Guidance)

LAST REVISION 11/01/17	DESCRIPTION:	FDOT FY 2018-19 STANDARD PLANS	CONCRETE BARRIER	INDEX 521-001	SHEET 16 of 22
---------------------------	--------------	--------------------------------------	------------------	------------------	-------------------

## Sheet 16: All new!

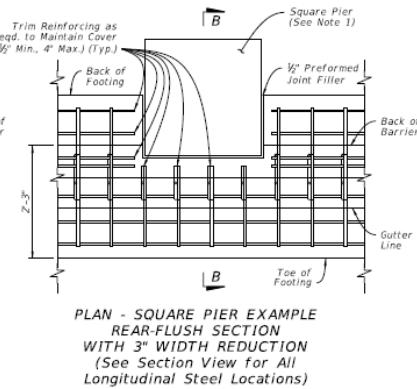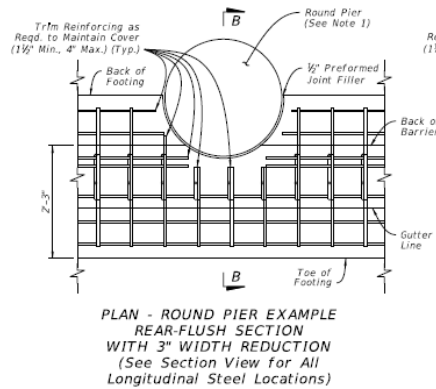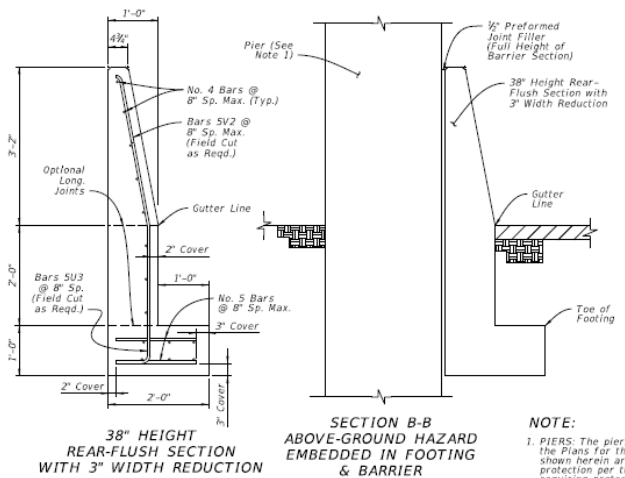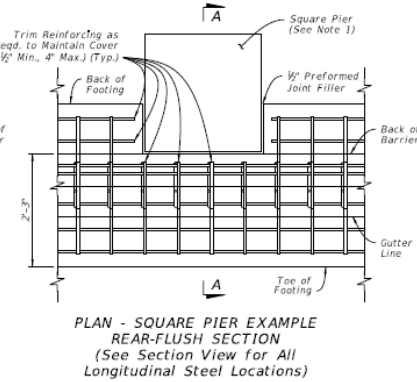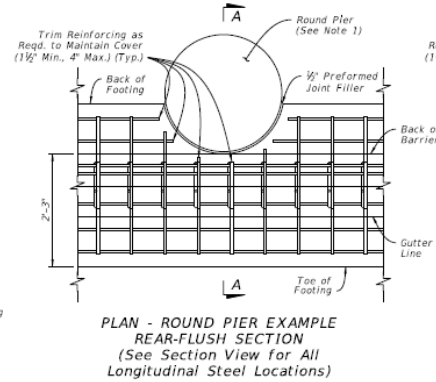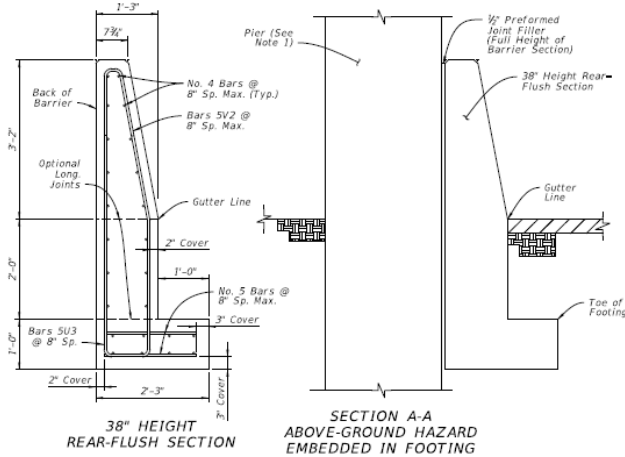

**NOTE:**  
1. PIERS: The piers shown herein are example shapes only; see the Plans for the project-specific dimensions. The details shown herein are only for use when piers do not require protection per the AASHTO LRFD requirements. For piers requiring protection, see Index 521-002.


**SHOULDER BARRIER - 38\"/>**

- For “Low Speed” Pier Shielding ( $\leq 45$  mph)
- Setback requirement is 0 feet for “Low-Speed”, so height maintained at 38”
- Two options: Full Barrier Width (when space permits) or 3” width reduction.

LAST REVISION 11/01/17	DESCRIPTION:	FDOT FY 2018-19 STANDARD PLANS	CONCRETE BARRIER	INDEX 521-001	SHEET 16 of 22
---------------------------	--------------	--------------------------------------	------------------	------------------	-------------------


## Sheet 17: All new!

- Same width options as previous
- Used for all design speeds.
- Difference from previous... The Barrier height is raised to reduce setback requirement for Zone of Intrusion (ZOI) per FDM Table 215.4.2

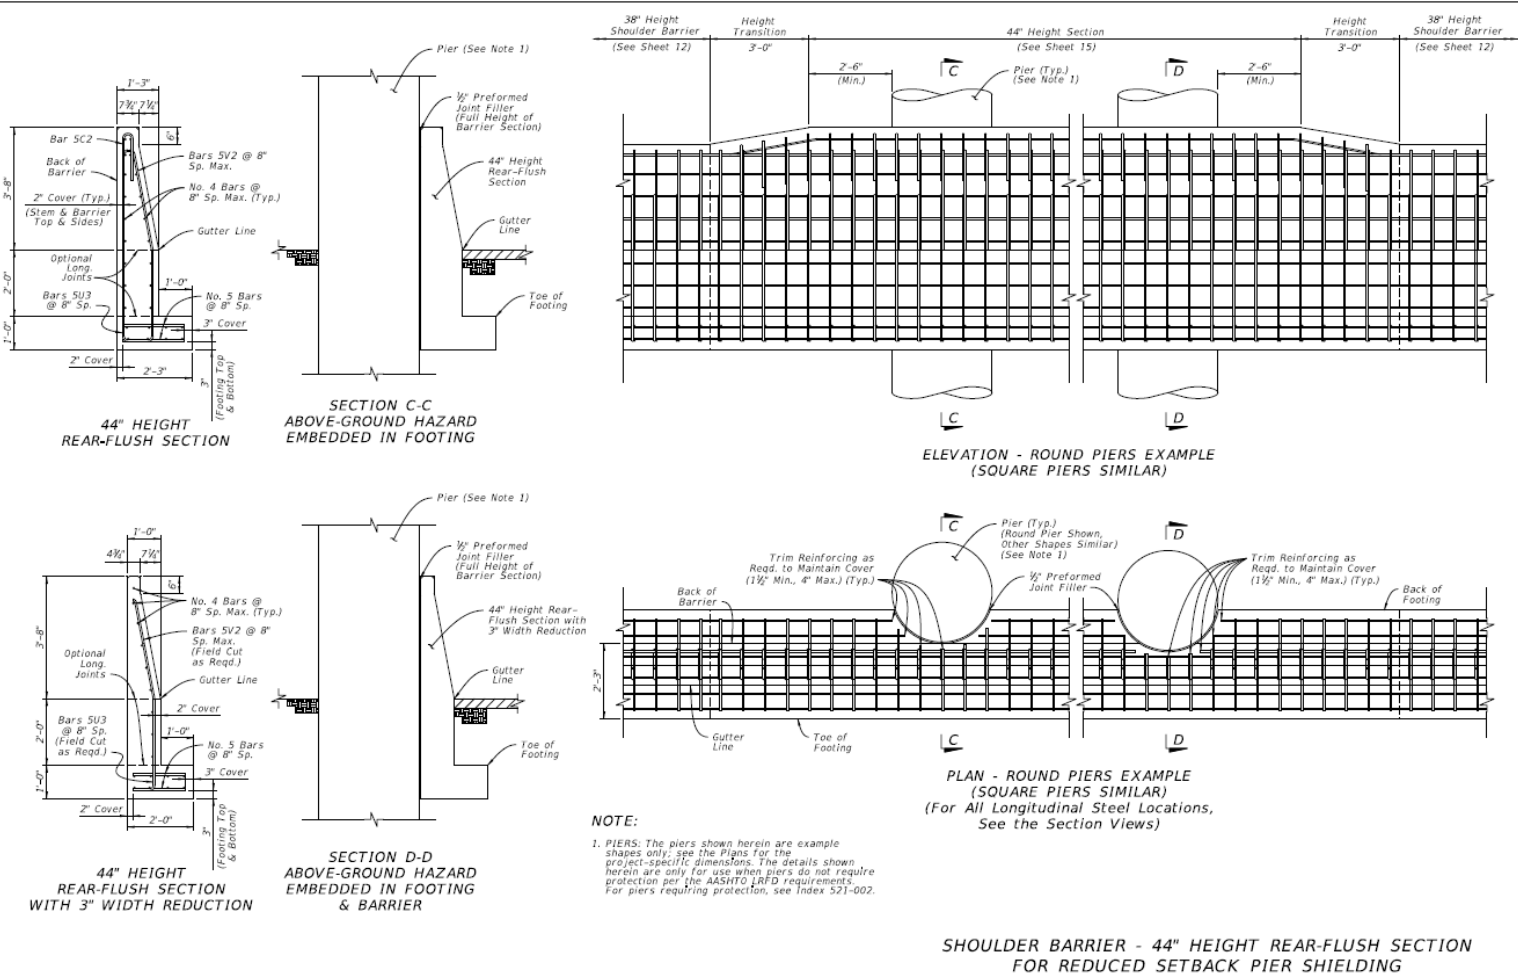

LAST REVISION 11/01/17	DESCRIPTION:	<b>FY 2018-19 STANDARD PLANS</b>	<b>CONCRETE BARRIER</b>	INDEX	SHEET
				521-001	17 of 22

## Sheet 18: All new!

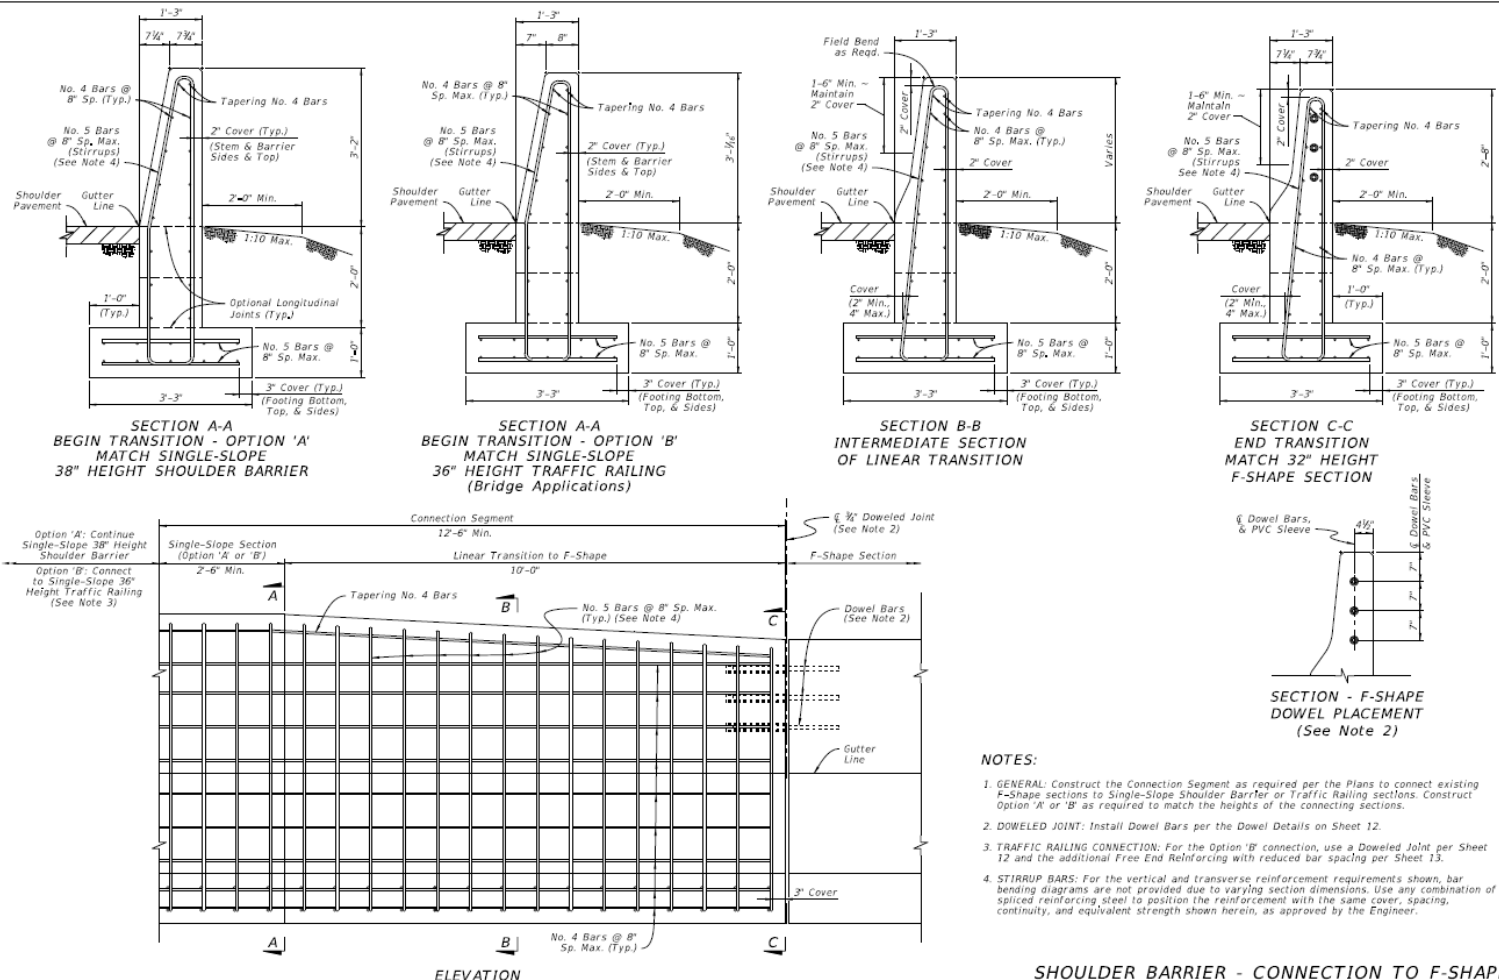


- NOTES:**
1. GENERAL: Construct the Connection Segment as required per the Plans to connect existing F-shape sections to Single-Slope Shoulder Barrier or Traffic Railing sections. Construct Option 'A' or 'B' as required to match the heights of the connecting sections.
  2. DOWELED JOINT: Install Dowel Bars per the Dowel Details on Sheet 12.
  3. TRAFFIC RAILING CONNECTION: For the Option 'B' connection, use a Doweled Joint per Sheet 12 and the additional Free End Reinforcing with reduced bar spacing per Sheet 13.
  4. STIRRUP BARS: For the vertical and transverse reinforcement requirements shown, bar bending diagrams are not provided due to varying section dimensions. Use any combination of spliced reinforcing steel to position the reinforcement with the same cover, spacing, continuity, and equivalent strength shown herein, as approved by the Engineer.

- Transition to F-Shape for Single-Faced Barrier
- Similar concept to double-faced Median Barrier already seen on Sheet 11!

LAST REVISION 11/01/17	DESCRIPTION:		FY 2018-19 STANDARD PLANS	CONCRETE BARRIER	INDEX	SHEET
					521-001	18 of 22

## Sheet 19: All new!



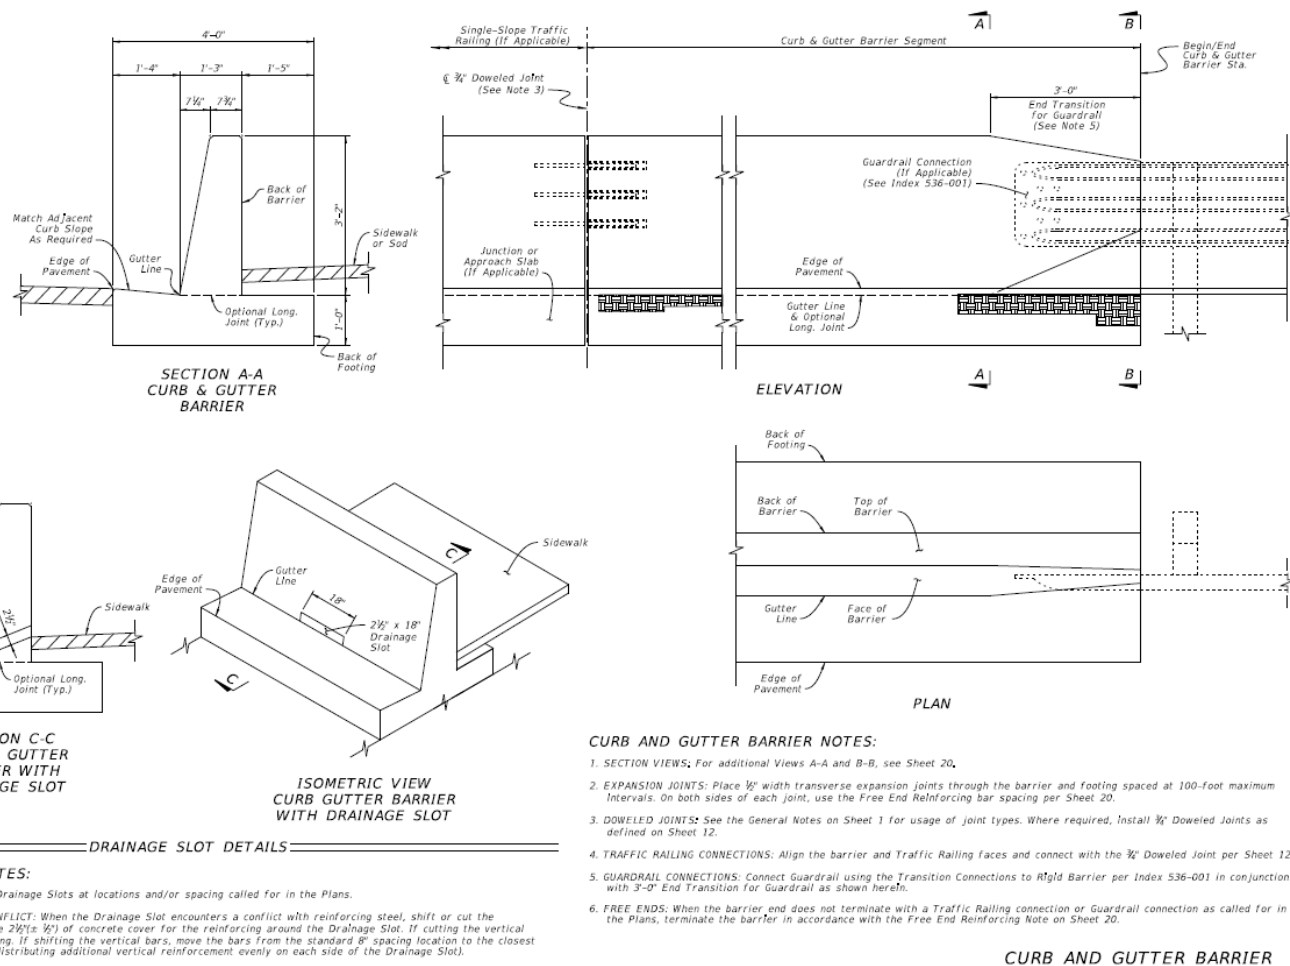


- “Curb & Gutter Barrier” is the third category of concrete barrier.
- Typically used in urban areas
- Design Speed (≤45 mph)
- Aligns with “Type F” curb for water conveyance

LAST REVISION 11/01/17	DESCRIPTION:	FY 2018-19 STANDARD PLANS	CONCRETE BARRIER	INDEX 521-001	SHEET 19 of 22
---------------------------	--------------	------------------------------	------------------	------------------	-------------------



## Sheet 19: All new!

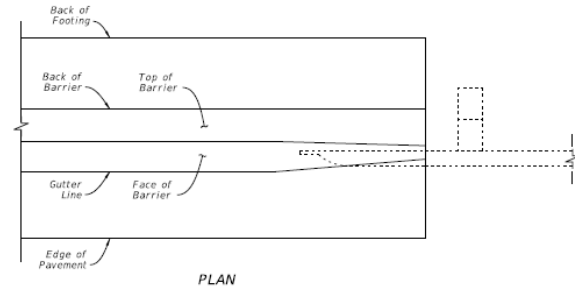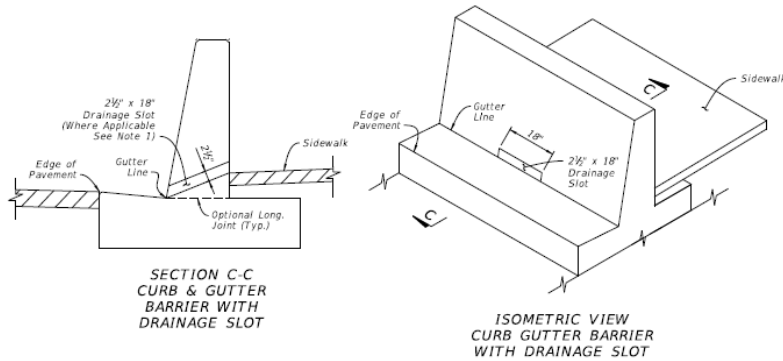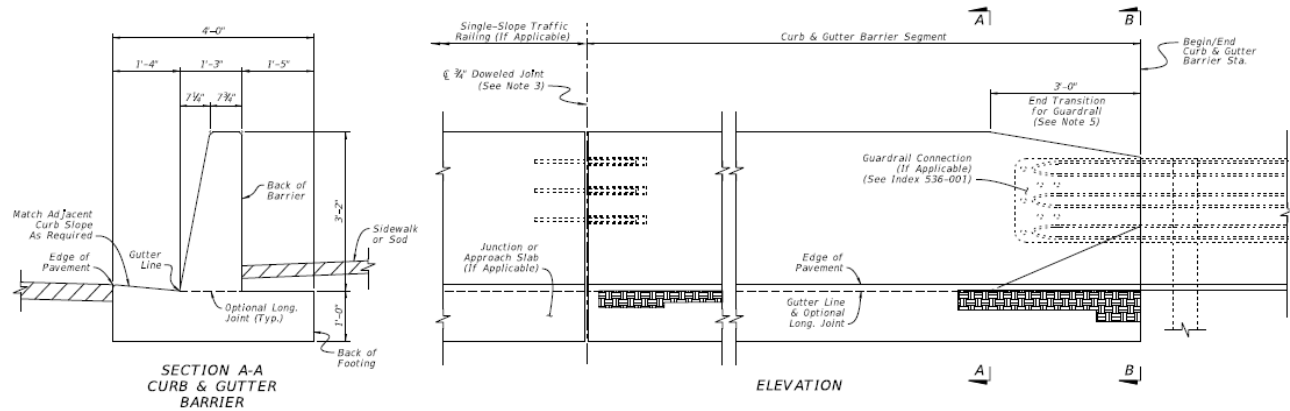

**CURB AND GUTTER BARRIER NOTES:**

- SECTION VIEWS: For additional Views A-A and B-B, see Sheet 20.
- EXPANSION JOINTS: Place 1/2" width transverse expansion joints through the barrier and footing spaced at 100-foot maximum intervals. On both sides of each joint, use the Free End Reinforcing bar spacing per Sheet 20.
- DOWELED JOINTS: See the General Notes on Sheet 1 for usage of joint types. Where required, install 3/4" Doweled Joints as defined on Sheet 12.
- TRAFFIC RAILING CONNECTIONS: Align the barrier and Traffic Railing faces and connect with the 3/4" Doweled Joint per Sheet 12.
- GUARDRAIL CONNECTIONS: Connect Guardrail using the Transition Connections to R/gld Barrier per Index 536-001 in conjunction with 3'-0" End Transition for Guardrail as shown herein.
- FREE ENDS: When the barrier end does not terminate with a Traffic Railing connection or Guardrail connection as called for in the Plans, terminate the barrier in accordance with the Free End Reinforcing Note on Sheet 20.

**CURB AND GUTTER BARRIER**

- Has its own "Curb and Gutter Barrier" Pay Item
- New Guardrail connection details
- Guardrail Approach Terminal is primary "first-choice" End Treatment (where space permits)

**DRAINAGE SLOT NOTES:**



- GENERAL: Place 2 1/2" x 18" Drainage Slots at locations and/or spacing called for in the Plans.
- STEEL REINFORCEMENT CONFLICT: When the Drainage Slot encounters a conflict with reinforcing steel, shift or cut the reinforcing steel to provide 2 1/2"(± 3/8") of concrete cover for the reinforcing around the Drainage Slot. If cutting the vertical bars, maintain 8" bar spacing. If shifting the vertical bars, move the bars from the standard 8" spacing location to the closest end of the drainage slot (distributing additional vertical reinforcement evenly on each side of the Drainage Slot).

**DRAINAGE SLOT DETAILS**

LAST REVISION 11/01/17	DESCRIPTION:	<b>FY 2018-19 STANDARD PLANS</b>	<b>CONCRETE BARRIER</b>	<b>INDEX 521-001</b>	<b>SHEET 19 of 22</b>
---------------------------	--------------	--------------------------------------	-------------------------	--------------------------	---------------------------

## Sheet 20: All new!

- Reinforcing details for general run and connection to guardrail




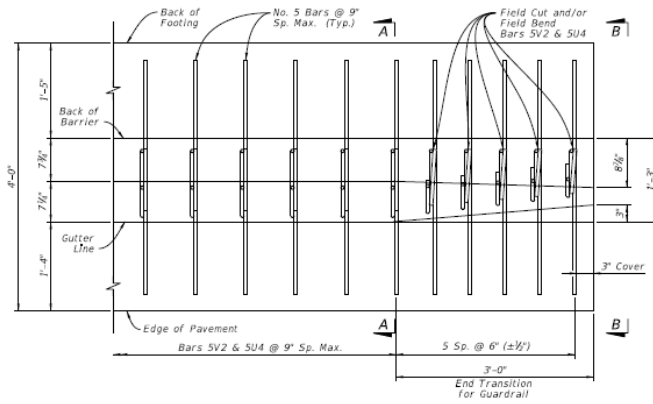
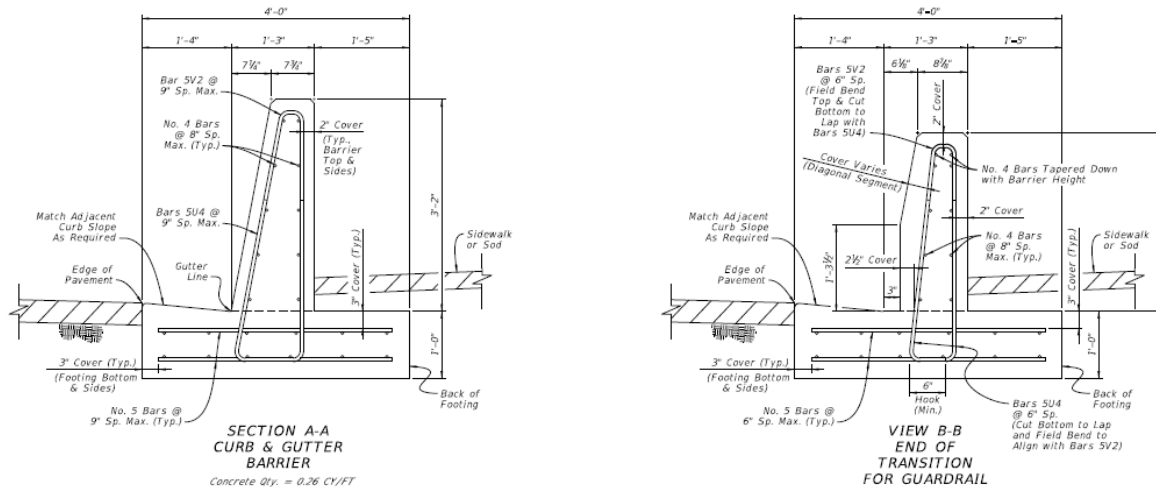


- NOTES:**
- GENERAL: Work with the Plan and Elevation Views on Sheet 19.
  - FREE END REINFORCING: Where shown in the Plans, terminate the 36" Curb & Gutter Barrier section with a transverse vertical end face. Reduce the spacing of Bars SV2 and SU4 to 6" for 5 Spaces, placed with 3" cover from the barrier's end face.
  - BAR BENDING DIAGRAMS: For additional details for bars SV2 and SU4, see the Bar Bending Diagrams on Sheet 22.

**CURB AND GUTTER BARRIER - REINFORCING DETAILS**

LAST REVISION 11/01/17	DESCRIPTION:	FY 2018-19 STANDARD PLANS	CONCRETE BARRIER	INDEX 521-001	SHEET 20 of 22
---------------------------	--------------	------------------------------	------------------	------------------	-------------------

## Sheet 21: All new!

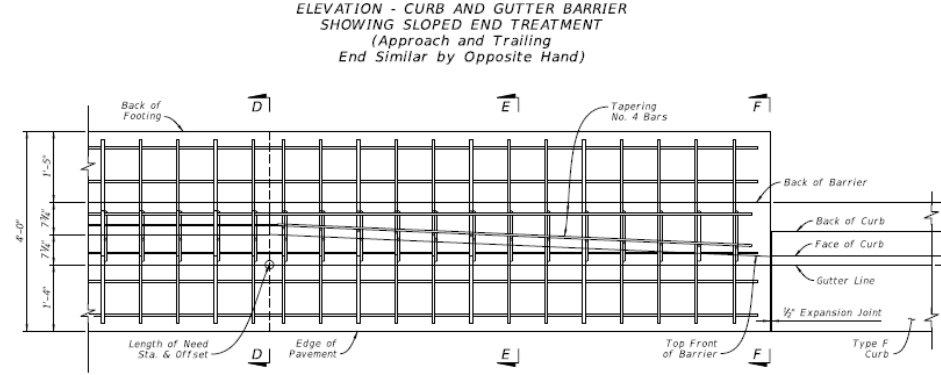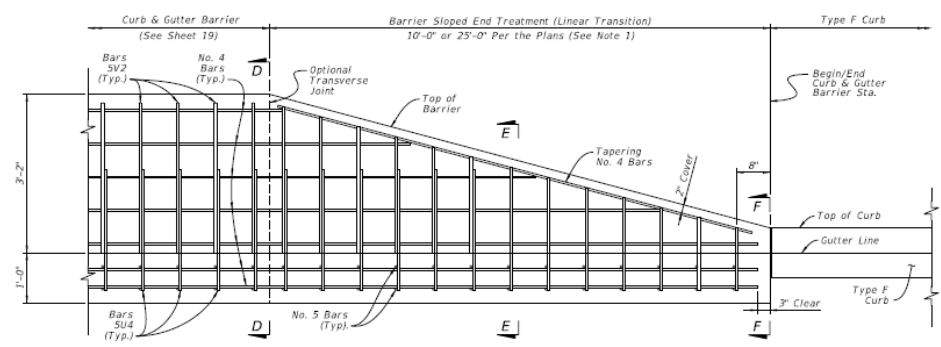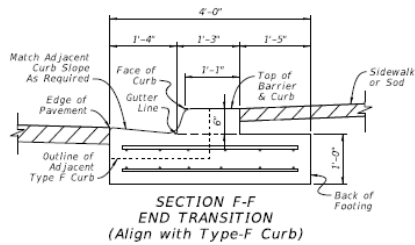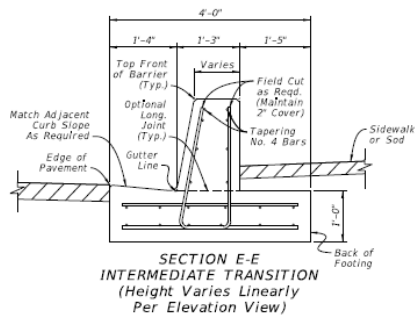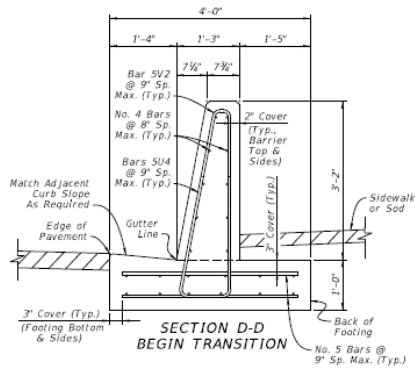

- NOTES:**
1. GENERAL: Install a Sloped End Treatment only where called for in the Plans, using either a 10'-0" length or 25'-0" length treatment as specified in the Plans. The 10'-0" length option is shown herein, while the 25'-0" length option requires additional trimmed Bars 5U4 & 5V2 at the same 9" longitudinal spacing.
  2. BAR BENDING DIAGRAMS: For additional details on Bars 5V2 & 5U4, see the Bar Bending Diagrams on Sheet 22.

CURB AND GUTTER BARRIER - SLOPED END TREATMENT


- Use Sloped End Treatment only where Guardrail Approach Terminal will not fit
- Design Speed ( $\leq 35$  mph)
- Requires DDE approval per FDM 215
- Requirements explained in SPI

LAST REVISION 11/01/17	DESCRIPTION:	FDOT FY 2018-19 STANDARD PLANS	CONCRETE BARRIER	INDEX 521-001	SHEET 21 of 22
---------------------------	--------------	--------------------------------------	------------------	------------------	-------------------


## Sheet 22: All new!

- Reinforcing details for contractors!


BILL OF REINFORCING STEEL		
MARK	SIZE	LENGTH
C1	4	3'-8"
C2	5	3'-0"
U1	4	5'-1"
U2	4	7'-8"
U3	5	9'-7"
U4	5	5'-9"
V1	4	6'-4"
V2	5	6'-3"

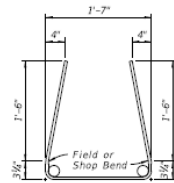


BARS 4U1

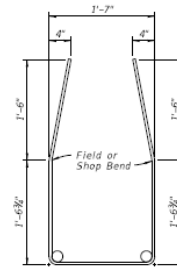


BAR 4U2

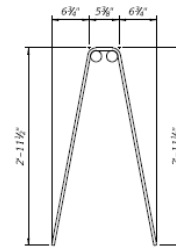


BAR 4V1

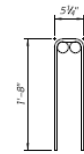


BAR 4C1

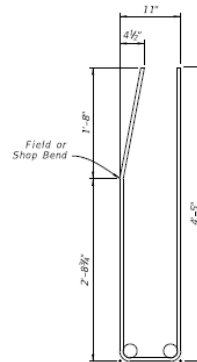


BAR 5U3

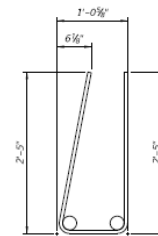

BAR 5U4

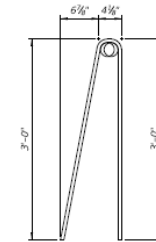

BAR 5V2

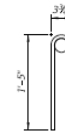

BAR 5C2

**NOTES:**

1. Work with the Standard Bar Bending Details per Index 415-001.
2. All bar dimensions in the bending diagrams are out to out.

REINFORCING BAR BENDING DIAGRAMS


LAST REVISION 11/01/17	DESCRIPTION:	FY 2018-19 STANDARD PLANS	CONCRETE BARRIER	INDEX 521-001	SHEET 22 of 22
---------------------------	--------------	------------------------------	------------------	------------------	-------------------



## STANDARD PLANS INSTRUCTIONS:

All new!

Standard Plans Website: <http://www.fdot.gov/design/standardplans/current/default.shtm>



Concrete Barriers, Traffic Railings, and Parapets						
521-001		Concrete Barrier	410	SPI	XLS	Roadway
521-002		Pier Protection Barrier	411	SPI	XLS	
521-010		Opaque Visual Barrier	461			

<http://www.fdot.gov/design/standardplans/current/SPI/SPI-521-001.pdf>



## DESIGN TOOL – ‘Length of Need’ (Excel): **All new!**

Standard Plans Website: <http://www.fdot.gov/design/standardplans/current/default.shtm>

Concrete Barriers, Traffic Railings, and Parapets						
521-001		Concrete Barrier	410	SPI	XLS	Roadway
521-002		Pier Protection Barrier	411	SPI	XLS	
521-010		Opaque Visual Barrier	461			



<http://www.fdot.gov/design/standardplans/current/XLS/ConcreteBarrier-LON.XLSM>

## Standard Plans – Primary Index Updates:

- ✓ 1) **Index 536-001 – Guardrail**
  - Miscellaneous Updates
- ✓ 2) **Index 521-001 – Concrete Barrier**
  - Complete Redevelopment – **Single-Slope Barrier**
- ➔ 3) **Index 521-002 – Pier Protection Barrier**
  - Extensive Redevelopment – **Single-Slope Barrier**

## Sheet 1: Revised!

SHEET NO.	CONTENTS
1	Index Contents; General Notes
2	Example Layouts – Footing Placement and Connections
3	Barrier Plan and Elevation – Connection to Concrete Barrier – Connection to Guardrail
4	Barrier Details – Connection to Concrete Barrier
5	Barrier Details – Connection to Guardrail
6	Barrier Footing Options
7	Crash Wall Details
8	Reinforcing Bar Bending Diagrams

### GENERAL NOTES:


- CONCRETE:** Use Class III or IV concrete unless otherwise called for in the Plans.
- CONSTRUCTION JOINTS:** Maintain continuity of reinforcement steel across Construction Joints; reinforcement lap splices are permitted immediately adjacent to joints. Construct all Pier Protection Barrier continuously, with no expansion or contraction joints. Construction joints are classified herein as Transverse Joints or Longitudinal Joints.  
  
Transverse Joints are permitted at 40 foot or greater intervals along the barrier.  
  
Longitudinal Joints may only be installed where indicated in the following details and notes, with a location tolerance of  $\pm 1"$  from the locations shown.
- SUBGRADE:** Compact the top layer of subgrade with Type B Stabilization, LBR 40 (12 in.).
- DRAINAGE INLETS:** See Index 425-001 for Shoulder Barrier Inlets, and isolate these structures from Pier Protection Barriers and Footings with 1" Preformed Joint Filler.
- BARRIER END MARKERS:** For all free ends of barriers that are not connected to guardrail or concrete barrier, install a Type 3 Object Marker on the end face per Specification 705.
- BARRIER DELINEATORS:** Install Barrier Delineators in accordance with Specification Section 705. Mount the delineators on the top face of the barrier, with the roadway side of the delineator located 2" from the front face of the barrier and the reflective sheeting facing traffic of the nearest approach.
- CRACK CONTROL:** Provide  $\frac{1}{2}"$  depth crack control V-Grooves at 15' to 30' spacing. Locate V-Grooves above any joint or discontinuity in the barrier footing. Align V-Grooves perpendicular to the longitudinal axis of the Pier Protection Barrier and make continuous across the top surface and both side faces. For slip formed barriers, score  $\frac{1}{2}"$  V-Grooves while the concrete is still plastic, otherwise pre-form the joints when stationary forms are utilized.

- New Table of Contents
- Revised some notes for clarity.
- Added note headings




## Sheet 2: Revised!

- More detail added to example layouts
- Now shows Station & Offset Points to correspond with Plans
- Now shows optional Crash Wall

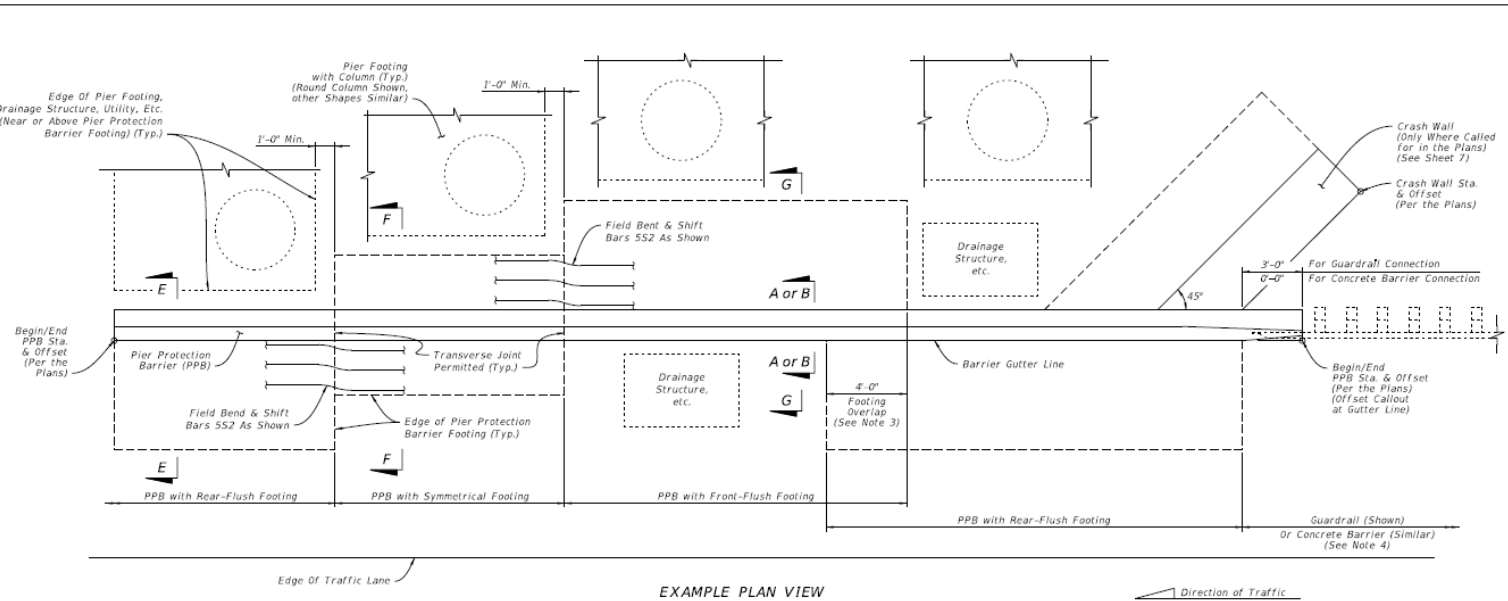

EXAMPLE PLAN VIEW

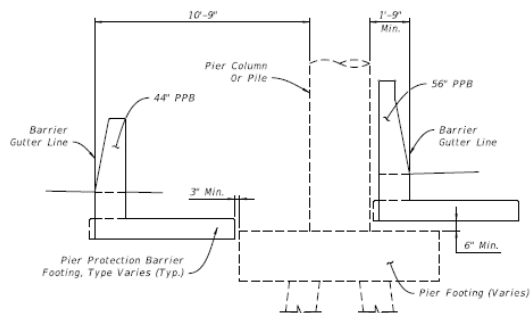

EXAMPLE SECTION VIEW

**NOTES:**


1. GENERAL: The views shown herein are schematic only, showing example layouts for Pier Protection Barrier (PPB) footings and Crash Wall placement in relation to adjacent miscellaneous structures (including bridge piers, footings, drainage structures, etc.). The actual PPB footing placement depends on the project-specific configuration of adjacent structures and obstacles. For project-specific locations of PPB and adjacent features, see the Plans.
2. MINIMUM FOOTING LENGTH: The minimum length of a single footing option (i.e. Symmetrical Footing, Rear-Flush Footing, Front-Flush Footing), is 8'-0", measured longitudinally. See Sheet 6 for the footing option details.
3. FOOTING OVERLAP: When a Front-Flush Footing section connects to a Rear-Flush Footing section, a 4'-0" footing overlap is required as shown. In footing overlap segments, place all lateral steel reinforcement continuously for the entire width of the combined footing while maintaining the cover requirements per Sheet 6.
4. CONNECTING GUARDRAIL OR CONCRETE BARRIER: Connect the PPB to either Guardrail or Concrete Barrier as specified in the Plans. For additional Guardrail Details, see Sheet 3 and Index 536-001. For additional Concrete Barrier Details, see Sheet 3 and Index 521-001.

EXAMPLE LAYOUTS - FOOTING PLACEMENT AND CONNECTIONS


## Sheet 2: Revised!

Crash Wall connection to PPB location differs per Guardrail or Concrete Barrier connection:

- Guardrail Connection:  
3 Ft. Offset
- Concrete Barrier Connection:  
Zero Offset

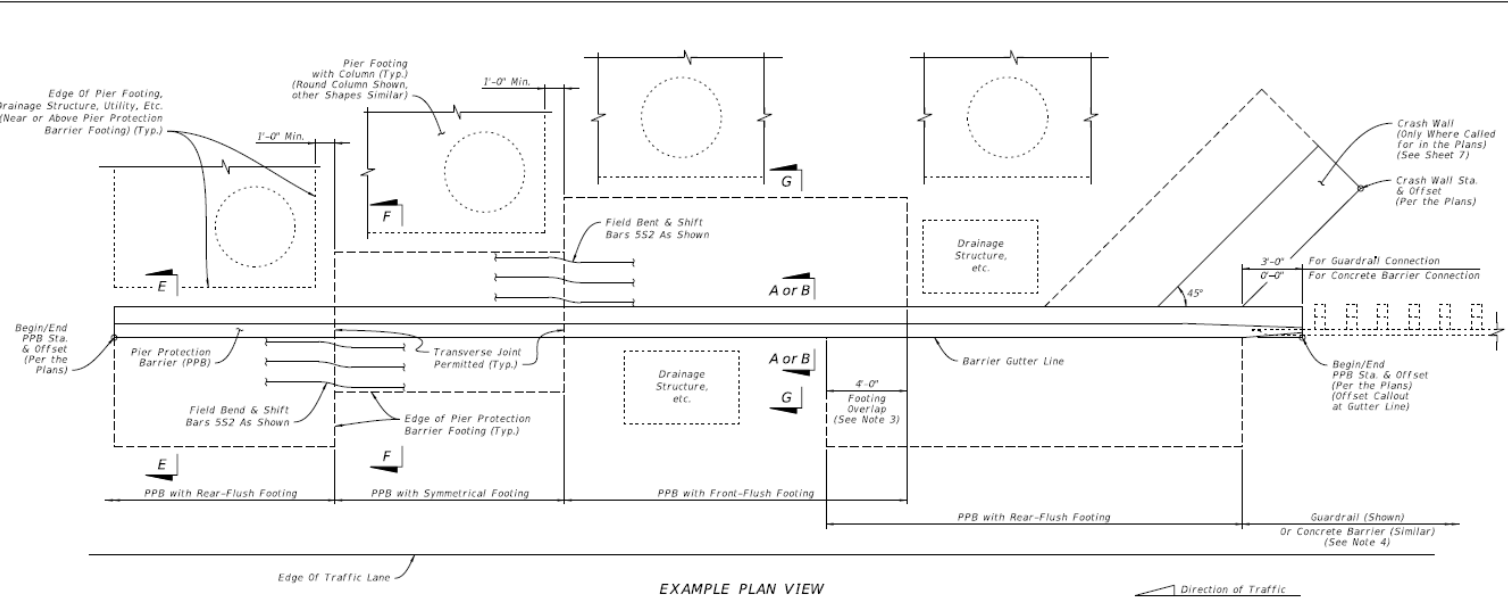

EXAMPLE PLAN VIEW

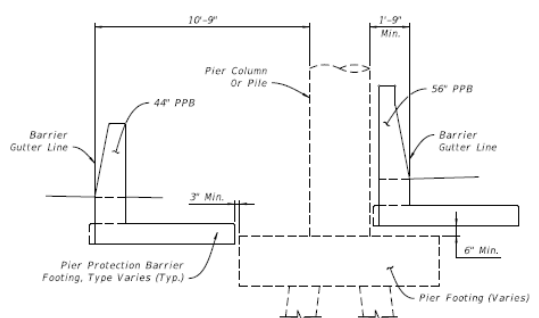

EXAMPLE SECTION VIEW




**NOTES:**

1. GENERAL: The views shown herein are schematic only, showing example layouts for Pier Protection Barrier (PPB) footings and Crash Wall placement in relation to adjacent miscellaneous structures (including bridge piers, footings, drainage structures, etc.). The actual PPB footing placement depends on the project-specific configuration of adjacent structures and obstacles. For project-specific locations of PPB and adjacent features, see the Plans.
2. MINIMUM FOOTING LENGTH: The minimum length of a single footing option (i.e. Symmetrical Footing, Rear-Flush Footing, Front-Flush Footing), is 8'-0", measured longitudinally. See Sheet 6 for the footing option details.
3. FOOTING OVERLAP: When a Front-Flush Footing section connects to a Rear-Flush Footing section, a 4'-0" footing overlap is required as shown. In footing overlap segments, place all lateral steel reinforcement continuously for the entire width of the combined footing while maintaining the cover requirements per Sheet 6.
4. CONNECTING GUARDRAIL OR CONCRETE BARRIER: Connect the PPB to either Guardrail or Concrete Barrier as specified in the Plans. For additional Guardrail Details, see Sheet 3 and Index 536-001. For additional Concrete Barrier Details, see Sheet 3 and Index 521-001.

EXAMPLE LAYOUTS - FOOTING PLACEMENT AND CONNECTIONS





## Sheet 4: All new!

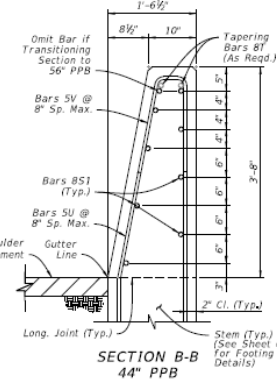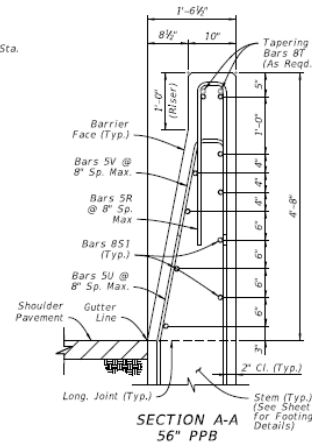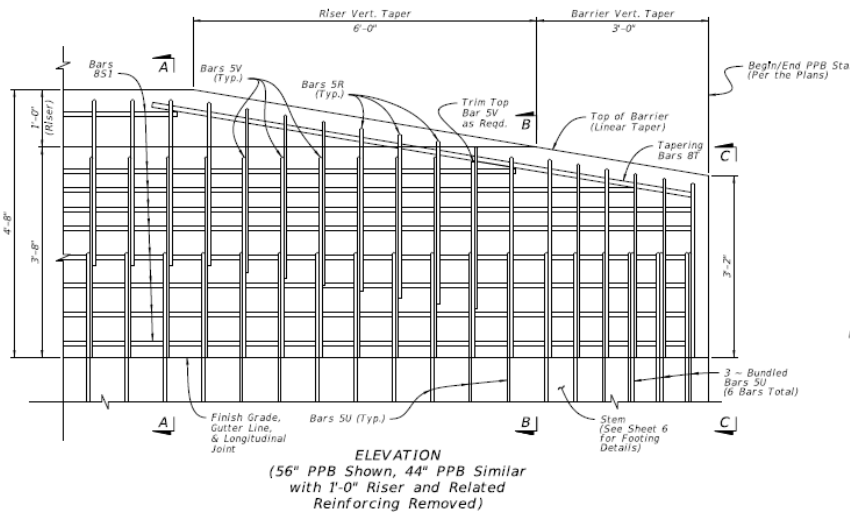

Concrete Qty. = 0.19 CY/FT (Above Gutter Line)  
Steel Qty. = 47.7 LB/FT (Excluding Bars SU & ST)

Concrete Qty. = 0.16 CY/FT (Above Gutter Line)  
Steel Qty. = 35.7 LB/FT (Excluding Bars SU & ST)

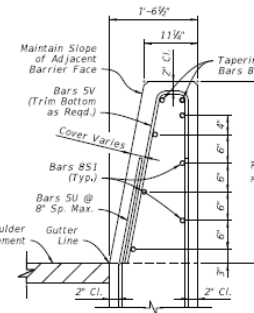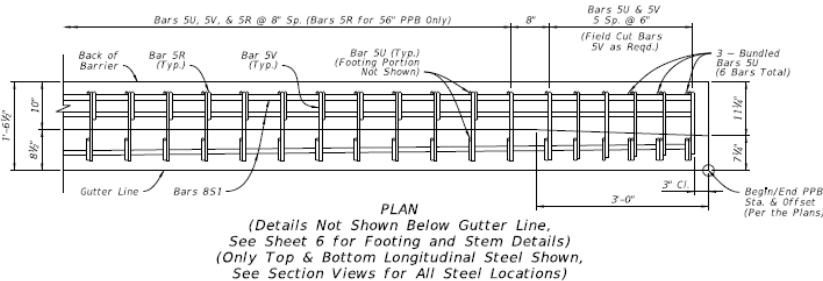

BARRIER DETAILS - CONNECTION TO CONCRETE BARRIER

- Reinforcing details when connecting to Concrete Barrier (38" height at end)


**NOTES:**

- GENERAL: Construct either the 56" PPB or the 44" PPB height as called for in the Plans. See Sheets 2 & 3 for additional plan and elevation details.
- FOOTING OPTIONS: See Sheet 6 for the supporting stem and footing details.

LAST REVISION 11/01/17	DESCRIPTION:	FY 2018-19 STANDARD PLANS	PIER PROTECTION BARRIER	INDEX 521-002	SHEET 4 of 8
---------------------------	--------------	------------------------------	-------------------------	------------------	-----------------

## Sheet 5: All new!

- Reinforcing details when connecting to Guardrail (32" Height at end)

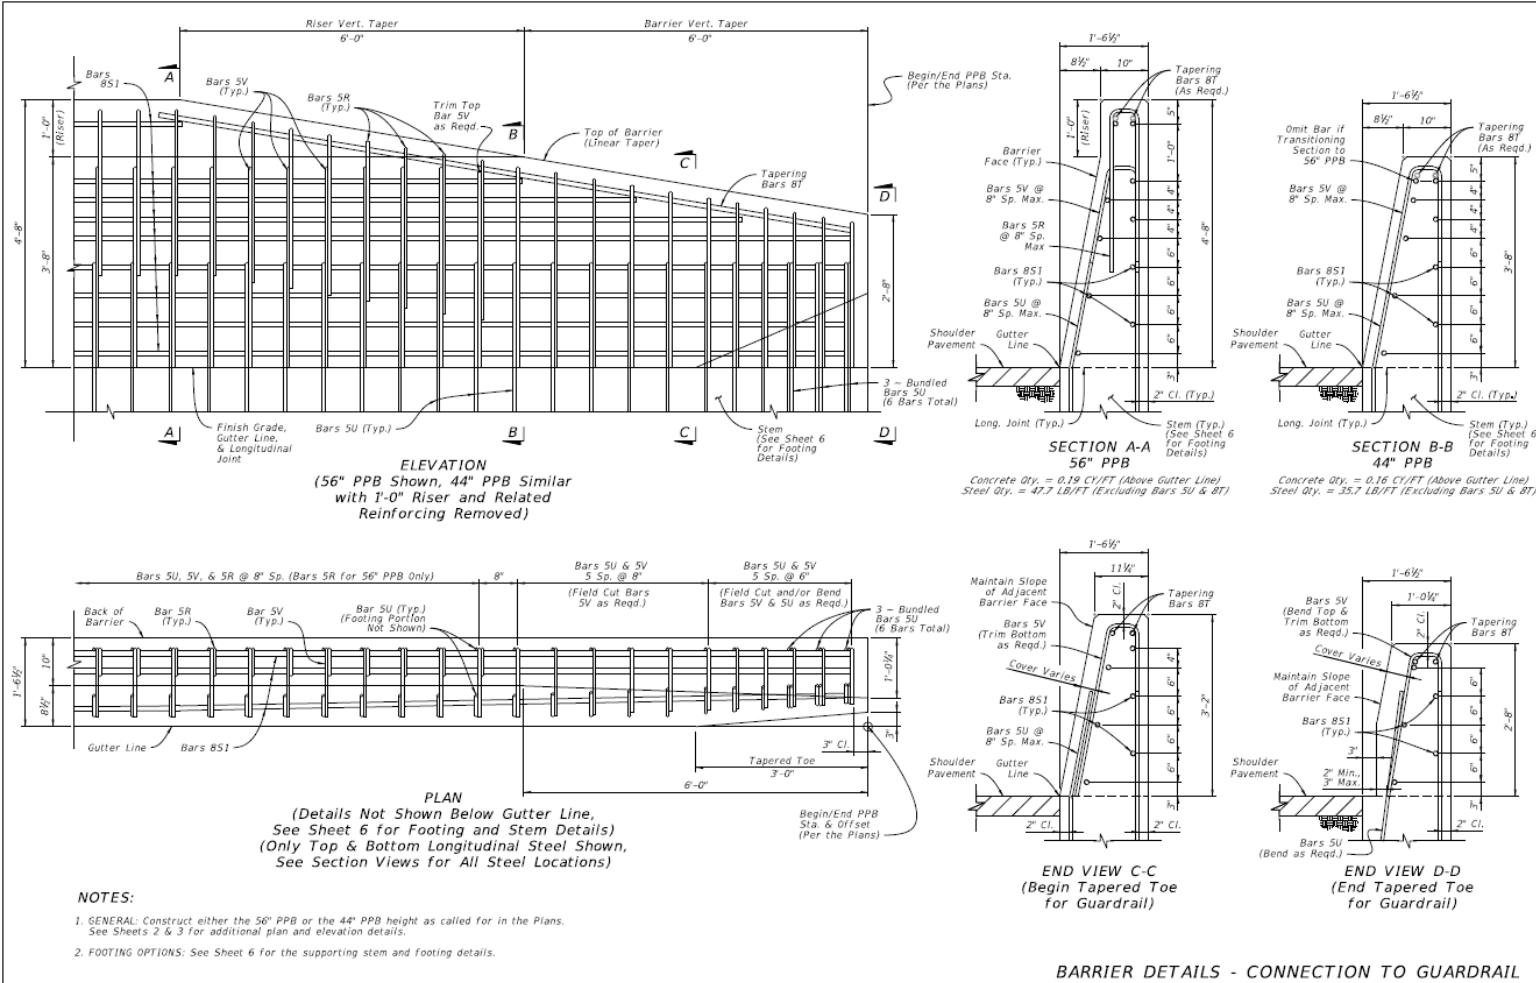


- NOTES:**
- GENERAL: Construct either the 56" PPB or the 44" PPB height as called for in the Plans. See Sheets 2 & 3 for additional plan and elevation details.
  - FOOTING OPTIONS: See Sheet 6 for the supporting stem and footing details.


**BARRIER DETAILS - CONNECTION TO GUARDRAIL**

LAST REVISION 11/01/17	DESCRIPTION:		FY 2018-19 STANDARD PLANS	PIER PROTECTION BARRIER	INDEX 521-002	SHEET 5 of 8
---------------------------	--------------	--	------------------------------	-------------------------	------------------	-----------------


## Sheet 6: Revised!

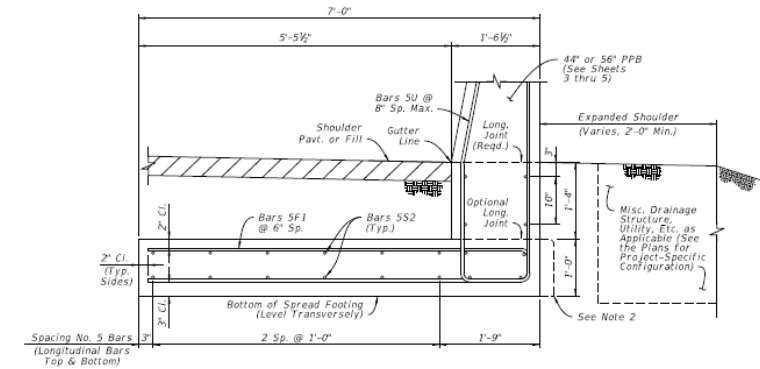

**SECTION E-E  
FRONT-FLUSH FOOTING OPTION**  
Concrete Qty. = 0.34 CY/FT (Below Gutter Line)  
Steel Qty. = 63.5 LB/FT (Including Bars SU)

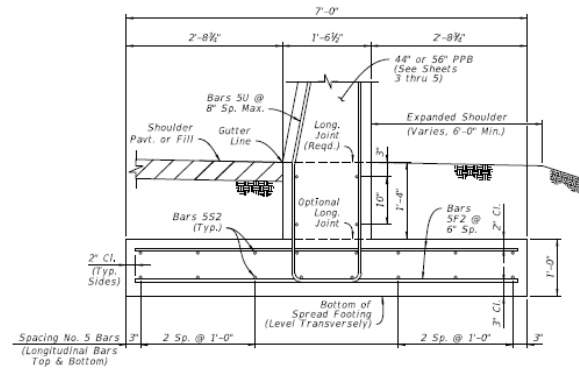

**SECTION F-F  
SYMMETRICAL FOOTING OPTION**  
Concrete Qty. = 0.34 CY/FT (Below Gutter Line)  
Steel Qty. = 62.6 LB/FT (Including Bars SU)

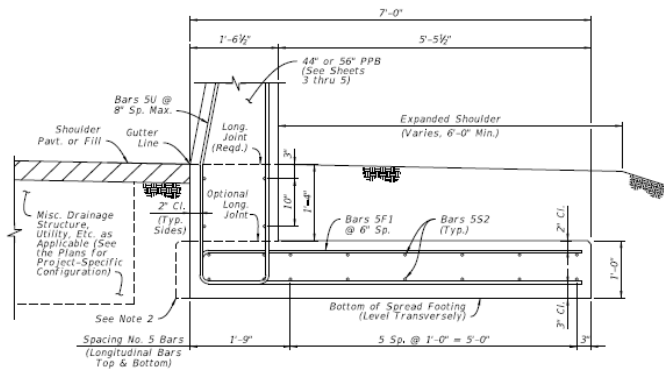

**SECTION G-G  
REAR-FLUSH FOOTING OPTION**  
Concrete Qty. = 0.34 CY/FT (Below Gutter Line)  
Steel Qty. = 63.5 LB/FT (Including Bars SU)

**NOTES:**




- GENERAL:** Install the footing options per project-specific requirements, as defined on Sheet 2 and specified per the Plans.
- OPTIONAL SLIP FORMING SUPPORT:** The 1'-0" depth spread footing may be extended by 3" laterally beyond the face of the stem to provide support for a subsequent slip forming operation above. Do not adjust the steel reinforcement location for the additional concrete.
- GUARDRAIL CONNECTION TAPERED TOE:** For tapering the barrier as shown on Sheet 5, View D-D, bend Bars U away from the stem face as required. For this case, the cover requirement is variable for one side of the stem (only at the tapered toe locations).

**BARRIER FOOTING OPTIONS**

- Differing footing options for fitting around piers, drainage, utilities, etc...
- Same dimensions as FY 2017-18 Standard

LAST REVISION 11/01/17	DESCRIPTION:		FY 2018-19 STANDARD PLANS	PIER PROTECTION BARRIER	INDEX 521-002	SHEET 6 of 8
---------------------------	--------------	--	------------------------------	-------------------------	------------------	-----------------

## Sheet 7:

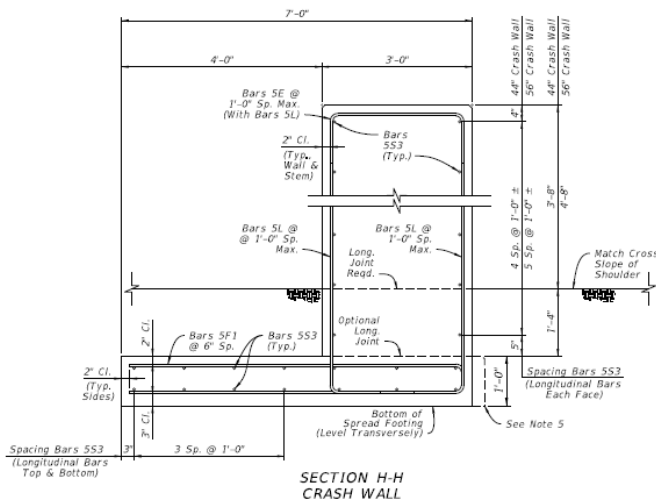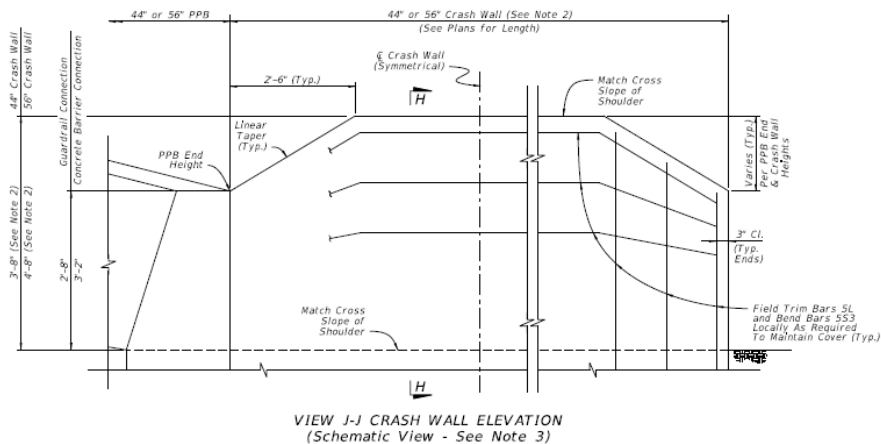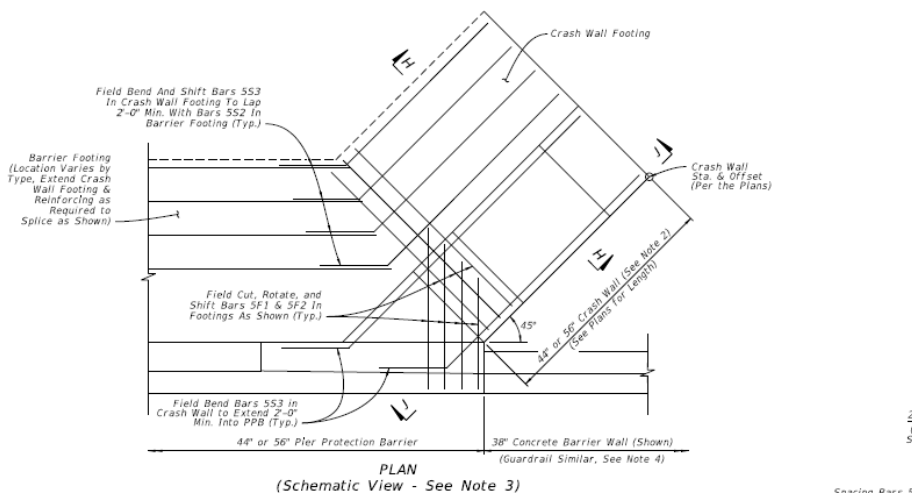

Concrete Qty. = 0.82 CY/FT (44" Crash Wall) or 0.93 CY/FT (56" Crash Wall)  
Steel Qty. = 71.8 LB/FT (44" Crash Wall) or 76.0 LB/FT (56" Crash Wall)

**NOTES:**

- GENERAL: Only where called for in the Plans, install the Crash Wall as a supplement for PPB. If applicable, see the Plans for the corresponding Station and Offset required.  
For additional layout details, see Sheets 2 & 3.
- CRASH WALL HEIGHT: Install the Crash Wall at a height which matches the adjacent PPB (either 44" or 56").
- SCHEMATIC VIEWS: Only partial reinforcing is shown in the Schematic Views to establish a trend while keeping clarity. For all reinforcing steel locations and spacing requirements, see Section H-H.
- GUARDRAIL CONNECTIONS: To facilitate guardrail connections, shift the Crash Wall 3 feet from the end of the PPB as shown on Sheets 2 & 3.
- OPTIONAL SLIP FORMING SUPPORT: The 1'-0" depth spread footing may be extended by 3" laterally beyond the face of the wall to provide support for a subsequent slip forming operation above. Do not adjust the steel reinforcement location for the additional concrete.

**CRASH WALL DETAILS**

- Crash Wall used to reduce Length of Need and overall system length of barrier
- Same design dimensions as FY 2017-18 Standard
- New Crash Wall Sta. and Offset Point to corresponds to Plans

LAST REVISION	DESCRIPTION:
11/01/17	


FDOT	FY 2018-19
STANDARD PLANS	

PIER PROTECTION BARRIER	INDEX	SHEET
	521-002	7 of 8


## Sheet 8: All new!

- Reinforcing details for contractors!


BILL OF REINFORCING STEEL		
MARK	SIZE	LENGTH
V	5	7'-5"
U	5	8'-11"
R	5	6'-0"
F1	5	13'-9"
F2	5	Varies (Straight)
L	5	6'-5" / 7'-5"
E	5	4'-6"
S1	8	Varies (Straight)
S2, S3	5	Varies (Straight)

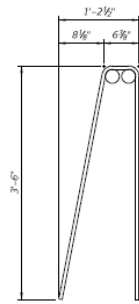

BARS SV

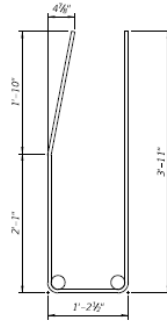


BARS SU

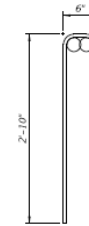


BARS 5R

**NOTES:**


- Work with the Standard Bar Bending Details per Index 415-001.
- All bar dimensions in the bending diagrams are out to out.

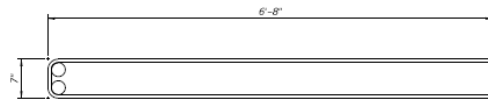

BARS 5F1

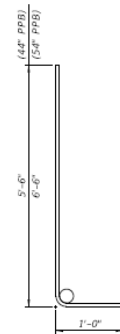

BARS 5L

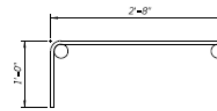

BARS 5E

BAR BENDING DIAGRAMS






# Index 521-002 – Pier Protection Barrier

**STANDARD PLANS INSTRUCTIONS:      Redeveloped!**

Standard Plans Website: <http://www.fdot.gov/design/standardplans/current/default.shtm>

		Concrete Barriers, Traffic Railings, and Parapets				
<b>521-001</b>		Concrete Barrier	410	PI	XLS	Roadway
<b>521-002</b>		Pier Protection Barrier	411	SPI	XLS	
<b>521-010</b>		Opaque Visual Barrier	461			

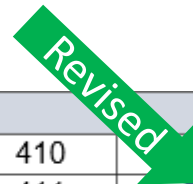

<http://www.fdot.gov/design/standardplans/current/SPI/SPI-521-002.pdf>




# Index 521-002 – Pier Protection Barrier

**DESIGN TOOL – ‘Length of Need’ (Excel):** **All new!**

Standard Plans Website: <http://www.fdot.gov/design/standardplans/current/default.shtm>

Concrete Barriers, Traffic Railings, and Parapets						
521-001		Concrete Barrier	410	SPI	XLS	Roadway
521-002		Pier Protection Barrier	411	SPI	XLS	
521-010		Opaque Visual Barrier	461			




<http://www.fdot.gov/design/standardplans/current/XLS/PierProtectionBarrier-LON.XLSM>

## Standard Plans – Primary Index Updates:

- ✓ 1) **Index 536-001 – Guardrail**
  - Miscellaneous Updates
- ✓ 2) **Index 521-001 – Concrete Barrier**
  - Complete Redevelopment – **Single-Slope Barrier**
- ✓ 3) **Index 521-002 – Pier Protection Barrier**
  - Extensive Redevelopment – **Single-Slope Barrier**
- ➔ 4) **Index 425-030 – Median Barrier Inlets Types 1 & 2**
  - Modified – **Single-Slope Barrier**
  - Removed Approach and Trailing “Throats”

## Sheet 1: Revisions for Single-Slope

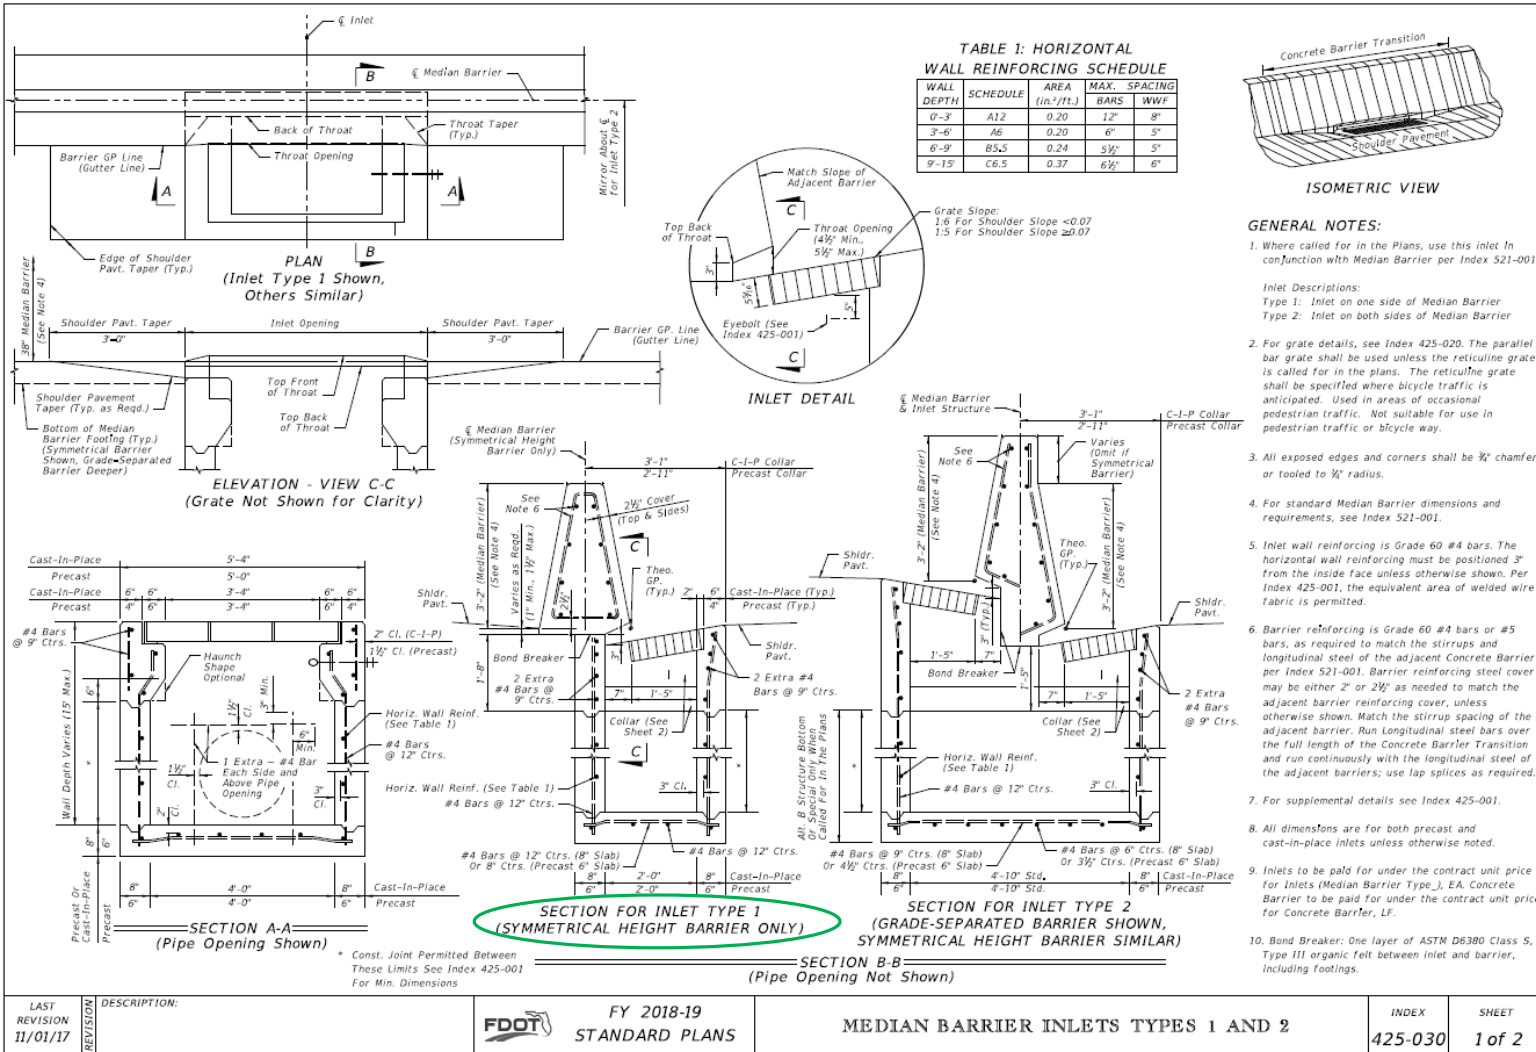

- Clarified Usage Note, Plan, Elevation, and Section Views
- Removed upstream "throat" indentation
- Reduced inlet Type quantity from 5 to 2
- Clarified Label: Type 1 inlet for symmetrical barrier only

LAST REVISION	DESCRIPTION
11/01/17	







REVISION	DESCRIPTION

## Standard Plans – Primary Index Updates:



- ✓ 1) **Index 536-001 – Guardrail**
  - Miscellaneous Updates
- ✓ 2) **Index 521-001 – Concrete Barrier**
  - Complete Redevelopment – **Single-Slope Barrier**
- ✓ 3) **Index 521-002 – Pier Protection Barrier**
  - Extensive Redevelopment – **Single-Slope Barrier**
- ✓ 4) **Index 425-030 – Median Barrier Inlets Types 1 & 2**
  - Modified – **Single-Slope Barrier**
  - Removed Approach and Trailing “Throats”
- ➔ 5) **Index 425-031 – Shoulder Barrier Inlet**
  - Modified – **Single-Slope Barrier**



## Standard Plans – Primary Index Updates:




- 
**1) Index 536-001 – Guardrail**
  - Miscellaneous Updates
- 
**2) Index 521-001 – Concrete Barrier**
  - Complete Redevelopment – **Single-Slope Barrier**
- 
**3) Index 521-002 – Pier Protection Barrier**
  - Extensive Redevelopment – **Single-Slope Barrier**
- 
**4) Index 425-030 – Median Barrier Inlets Types 1 & 2**
  - Modified – **Single-Slope Barrier**
  - Removed Approach and Trailing “Throats”
- 
**5) Index 425-031 – Shoulder Barrier Inlet**
  - Modified – **Single-Slope Barrier**
- 
**6) Index 425-032 – Curb & Gutter Barrier Inlet**
  - Modified – **Single-Slope Barrier**
  - New PVC Drainage Pipes from Sidewalk

## Sheet 1: Revised for Single-Slope

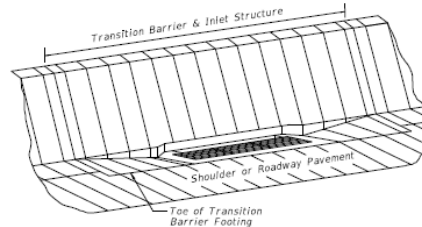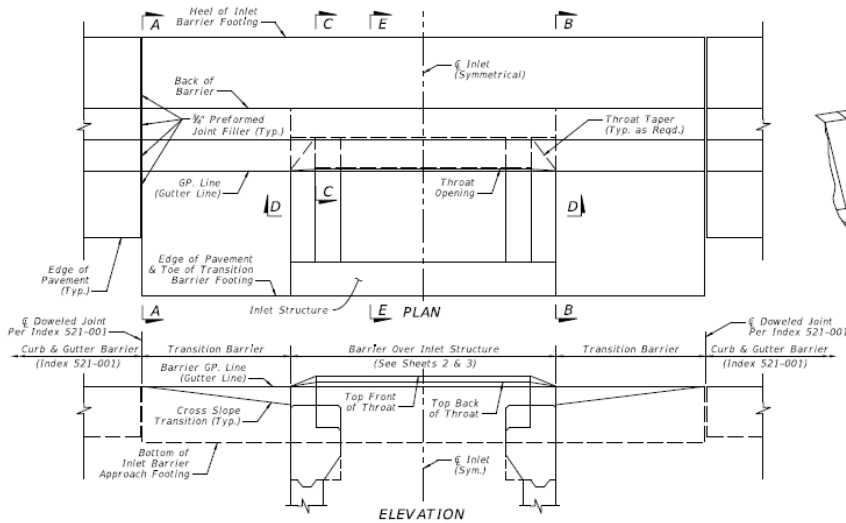

### GENERAL NOTES:

- Where called for in the Plans, use this inlet in conjunction with Curb and Gutter Barrier per Index 521-001. Construct Barrier segments shown herein in accordance with requirements of Index 521-001, including connections to adjacent barrier segments using the Doweled Joint.
- Reinforcing shown is grade 60 steel bars. For the equivalent area of welded wire reinforcement for the inlet, see Index 425-001. Reinforcing shall have 2" minimum cover unless otherwise shown. Trim or bend bars to provide 1/2" clearance around pipe openings. The cost for additional reinforcing in the barrier is included in the cost of the concrete barrier.
- All barrier is Class II or IV concrete per Index 521-001.
- Apply a 1/4" chamfer or 1/4" radius to all exposed concrete edges.
- For pipe connections to inlet structure bottoms, the recommended maximum pipe sizes are 18" longitudinal and 30" transverse. For larger pipe, use Alternate B bottoms, Index 425-010.
- Grates may be fabricated with reticulate bars or with either 1/2" welded or 3/8" electroformed cross bars and bearing bars as detailed on Sheet 3.
- When Alternate G grate is specified in the plans, the grate is to be hot-dip galvanized after fabrication, in accordance with Specification 962-9.
- For Pay Item purposes, the depth of the barrier inlet shall be computed using the center of box grate elevation, minus either the flow line elevation of the lowest pipe flow line or the top of the sump floor elevation.
- All dimensions are for both precast and cast in place (C-I-P) inlets unless otherwise indicated.
- For inlets placed in areas of bicycle traffic, provide the extended crossbar or bar stub (see Insets "A" and "B ALTERNATE").
- Inlets to be paid for under the contract unit price for Inlets, Barrier Rigid, Curb and Gutter, Each.
- Concrete Barrier to be paid for under the contract unit price for Shoulder Concrete Barrier, Rigid-curb & Gutter, LF.

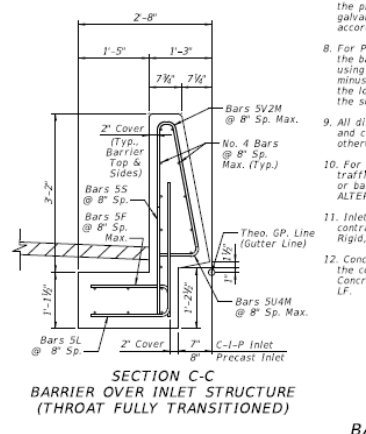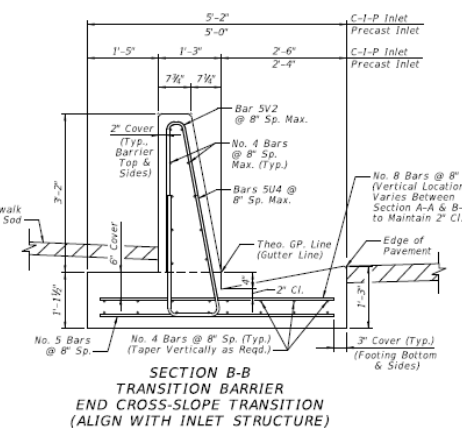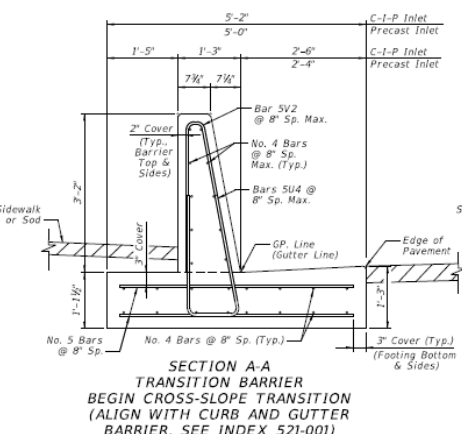


### BARRIER SECTIONS

- Clarified Usage Note 1, Plan, Elevation, and Section Views
- Removed upstream "throat" indentation

LAST REVISION 11/01/17	DESCRIPTION:	FY 2018-19 STANDARD PLANS	CURB AND GUTTER BARRIER INLET	INDEX 425-032	SHEET 1 of 3
---------------------------	--------------	------------------------------	-------------------------------	------------------	-----------------



## Sheet 2: Revised for Single-Slope

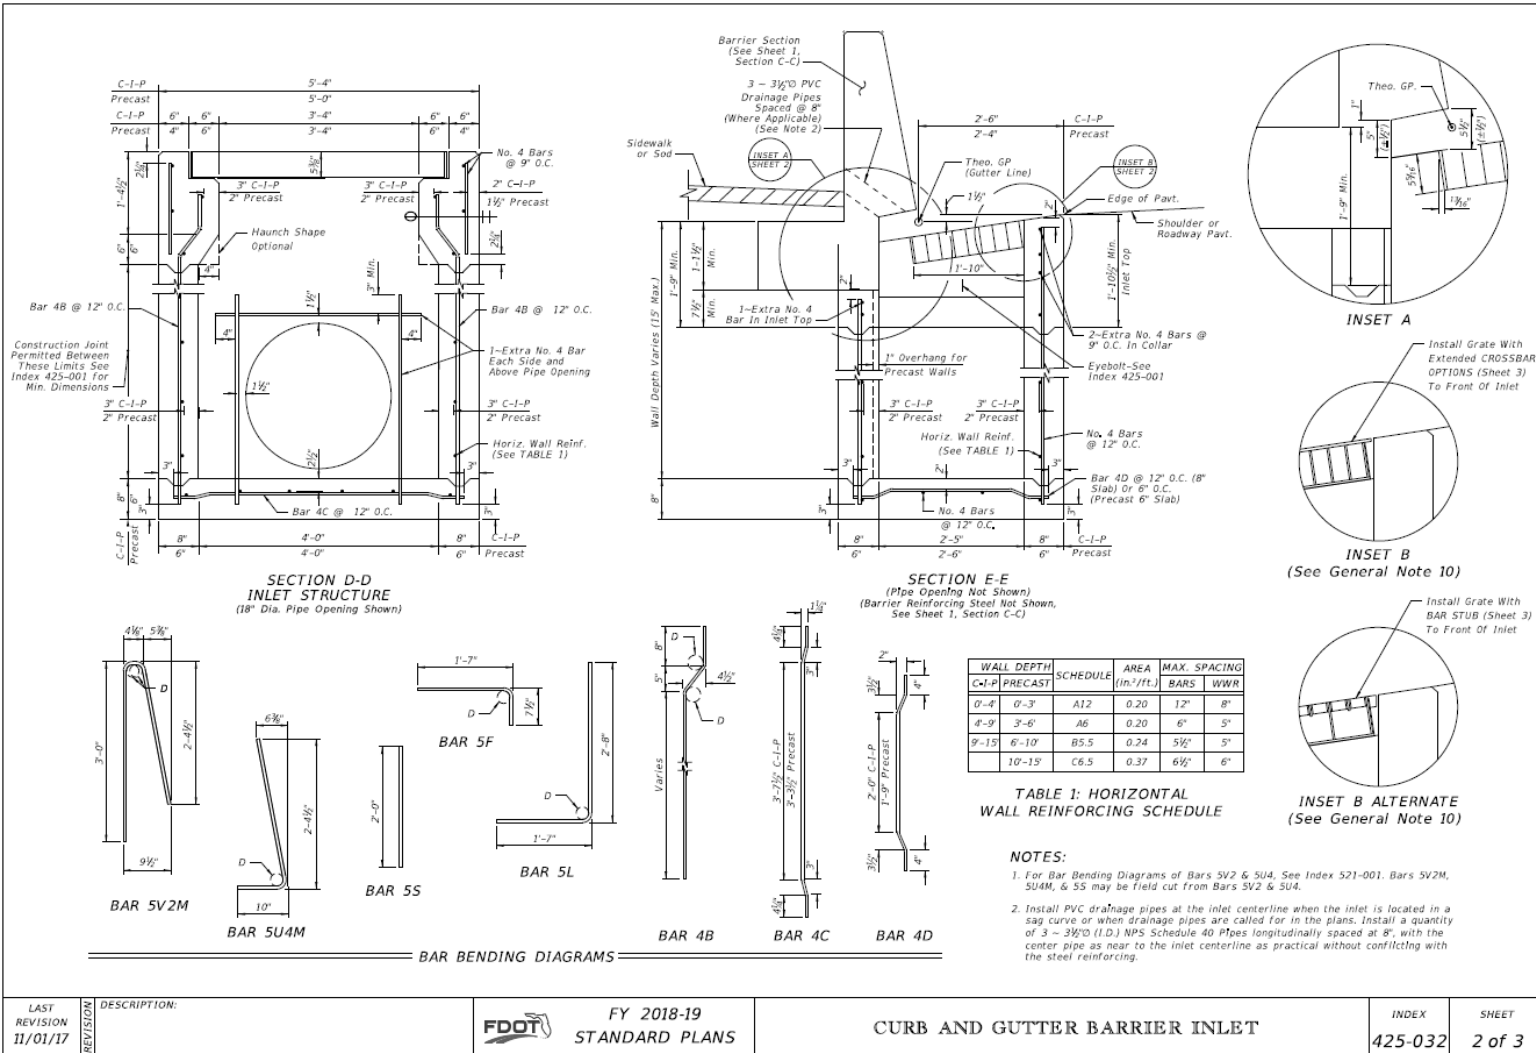


- Replaced 18" drainage slot with 3 ~ 3.5" PVC pipes (improved constructability, less interference with rebar)
- Revised reinforcing

## Standard Plans – Primary Index Updates:

- ✓ 1) **Index 536-001 – Guardrail**
  - Miscellaneous Updates
- ✓ 2) **Index 521-001 – Concrete Barrier**
  - Complete Redevelopment – **Single-Slope Barrier**
- ✓ 3) **Index 521-002 – Pier Protection Barrier**
  - Extensive Redevelopment – **Single-Slope Barrier**
- ✓ 4) **Index 425-030 – Median Barrier Inlets Types 1 & 2**
  - Modified – **Single-Slope Barrier**
  - Removed Approach and Trailing “Throats”
- ✓ 5) **Index 425-031 – Shoulder Barrier Inlet**
  - Modified – **Single-Slope Barrier**
- ✓ 6) **Index 425-032 – Curb & Gutter Barrier Inlet**
  - Modified – **Single-Slope Barrier**
  - New PVC Drainage Pipes from Sidewalk
- ➡ 7) **Index 715-002 – Standard Aluminum Lighting**
  - Modified – **Single-Slope Barrier**




## Sheet 7: Revised for Single-Slope

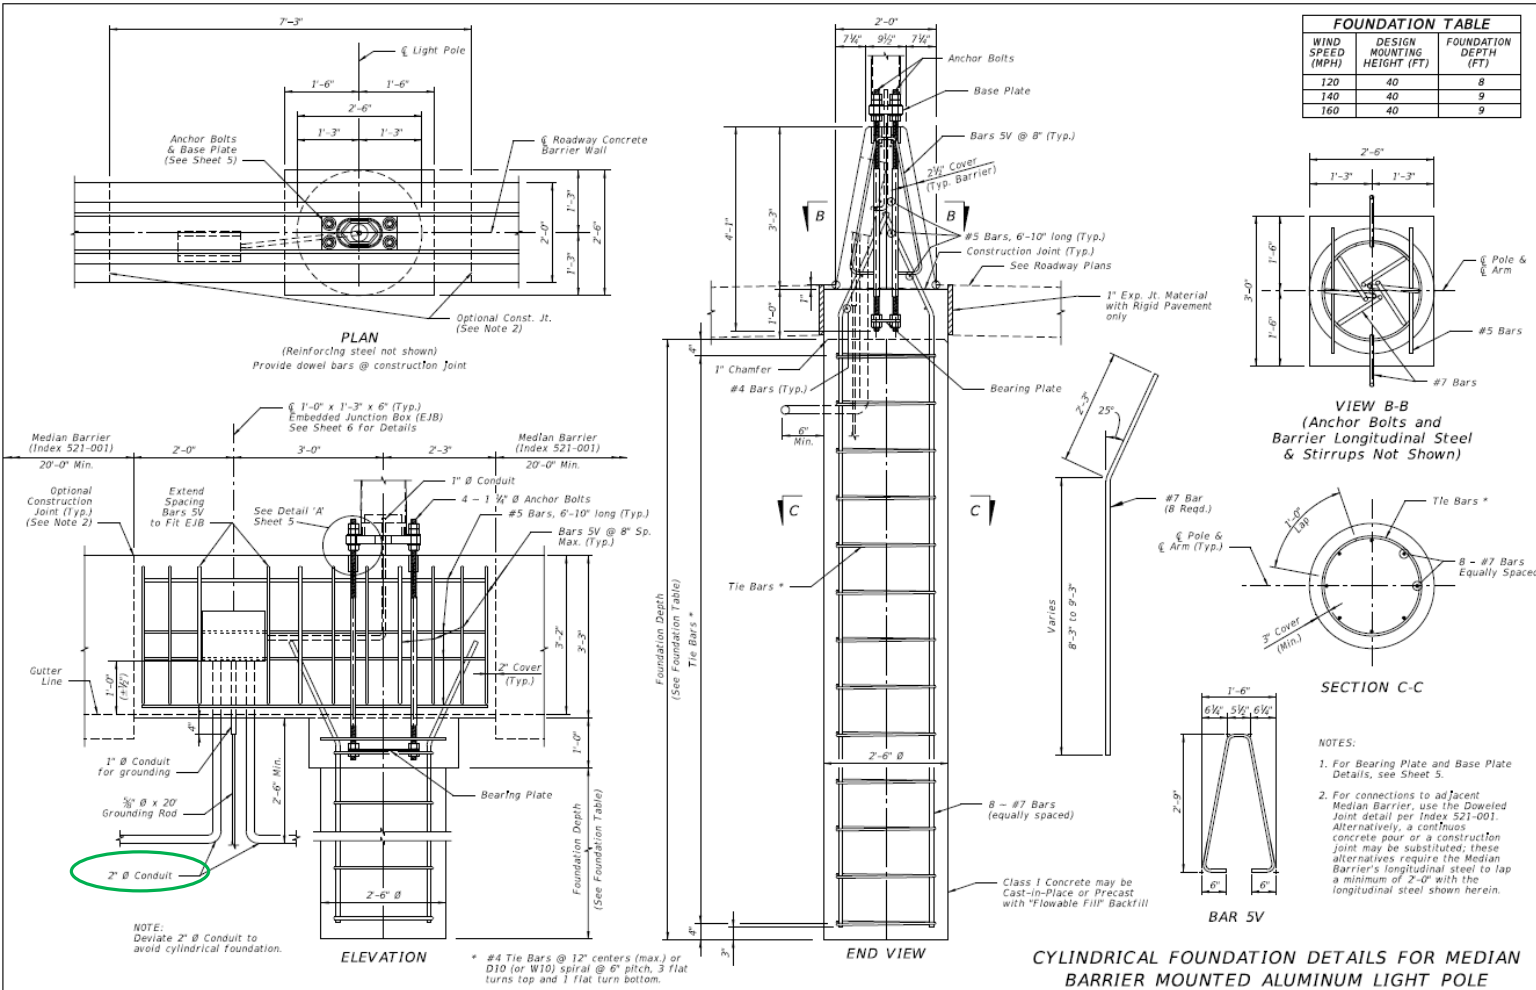


- Updated reinforcing: vertical bars now throughout
- Reminder: For roadside Concrete Barrier, longitudinal conduit runs underground (not in the barrier itself!)

## Sheet 8: Revised for Single-Slope

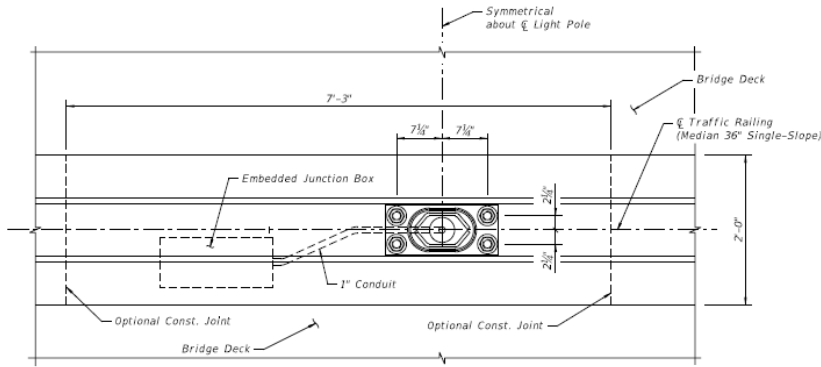

PLAN  
(Reinforcing steel and 2" Ø Conduit not shown)


\*At the Contractor's option, Bars 5W may be fabricated as a two piece bar with a 1'-2" lap splice at the bottom legs.

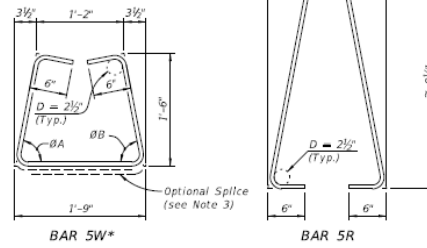

BAR 5W\*


BAR 5R

\*\* Shift horizontally to avoid Anchor Bolts

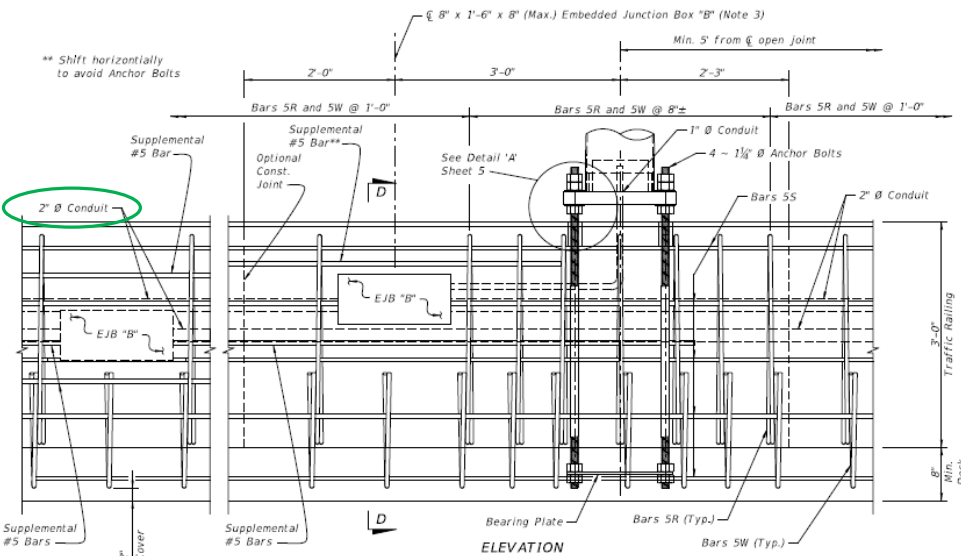

ELEVATION

(Longitudinal and transverse deck reinforcing steel not shown)

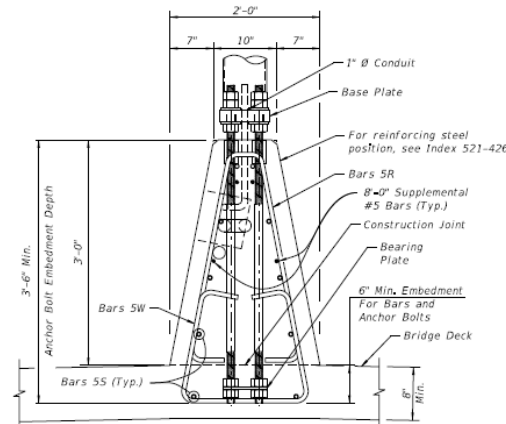

SECTION D-D

(Longitudinal and transverse deck reinforcing steel not shown)

NOTES:

1. For Base Plate Details, Bearing Plate Details, and Detail 'A', see Sheet 5.
2. See Index 521-426 for details of adjacent Traffic Railing (Median 36° Single-Slope) and for angles OA and OB.
3. See Index 630-010 for Conduit, EJB and supplemental reinforcing details.

DETAILS FOR TRAFFIC RAILING (MEDIAN 36° SINGLE-SLOPE) MOUNTED ALUMINUM LIGHT POLE

- Updated reinforcing
- Reminder: For bridge deck Traffic Railing, longitudinal conduit runs within the Traffic Railing

LAST REVISION	DESCRIPTION
11/01/17	

## Standard Plans – Primary Index Updates:

- ✓ 1) **Index 536-001 – Guardrail**
  - Miscellaneous Updates
- ✓ 2) **Index 521-001 – Concrete Barrier**
  - Complete Redevelopment – **Single-Slope Barrier**
- ✓ 3) **Index 521-002 – Pier Protection Barrier**
  - Extensive Redevelopment – **Single-Slope Barrier**
- ✓ 4) **Index 425-030 – Median Barrier Inlets Types 1 & 2**
  - Modified – **Single-Slope Barrier**
  - Removed Approach and Trailing “Throats”
- ✓ 5) **Index 425-031 – Shoulder Barrier Inlet**
  - Modified – **Single-Slope Barrier**
- ✓ 6) **Index 425-032 – Curb & Gutter Barrier Inlet**
  - Modified – **Single-Slope Barrier**
  - New PVC Drainage Pipes from Sidewalk
- ✓ 7) **Index 715-002 – Standard Aluminum Lighting**
  - Modified – **Single-Slope Barrier**

## Questions?



**Richard Stepp, P.E.**  
**Standard Plans Engineer**  
**Central Office, Roadway Design**  
**(850) 414-4313**  
**[richard.stepp@dot.state.fl.us](mailto:richard.stepp@dot.state.fl.us)**



## FY 2018-19 Standard Plans Update Training

Ed Cashman, P.E.  
Standard Plans Engineer  
State Roadway Design Office  
(850) 414-4314  
[edward.cashman@dot.state.fl.us](mailto:edward.cashman@dot.state.fl.us)



## Index 102-100 (previously Index 415) “Temporary Barrier”

- This index is now generic to multiple types of temporary barrier systems.

~~1. Temporary concrete barrier systems on roadways may be any of the following:~~

- ~~a. The FDOT Type K Temporary Concrete Barrier system (Design Standard Index 414), F-Shape Units. For temporary concrete barrier systems on bridges see Design Standard Index No. 414.~~
- ~~b. Proprietary temporary concrete barrier systems meeting NCHRP Report 350 Test Level 3 criteria which are included on the Approved Products List.~~
- ~~c. Water Filled Barrier (Free-standing)~~


- “Deflection Space” is now “Setback Distance” and the previous table has been revised and simplified. Anchored “Setback Distance” was previously as low as 1’ and is now 2’.

<i>INSTALLATION DATA</i>			
<i>CONDITION</i>	<i>LATERAL OFFSET</i>	<i>SETBACK DISTANCE</i>	<i>PAVEMENT/ ASPHALT WIDTH</i>
<i>Anchored</i>	<i>2' Min.</i>	<i>2' Min.*</i>	<i>1' Min.</i>
<i>Free-standing</i>	<i>2' Min.</i>	<i>4' Min.</i>	<i>4' Min.</i>

*\* For Bridge Decks see Index 102-110 or APL.*


## Index 102-100 (previously Index 415) "Temporary Barrier"

- Length of need has been removed from the index. See the Standard Plan Instructions for length of need calculations.

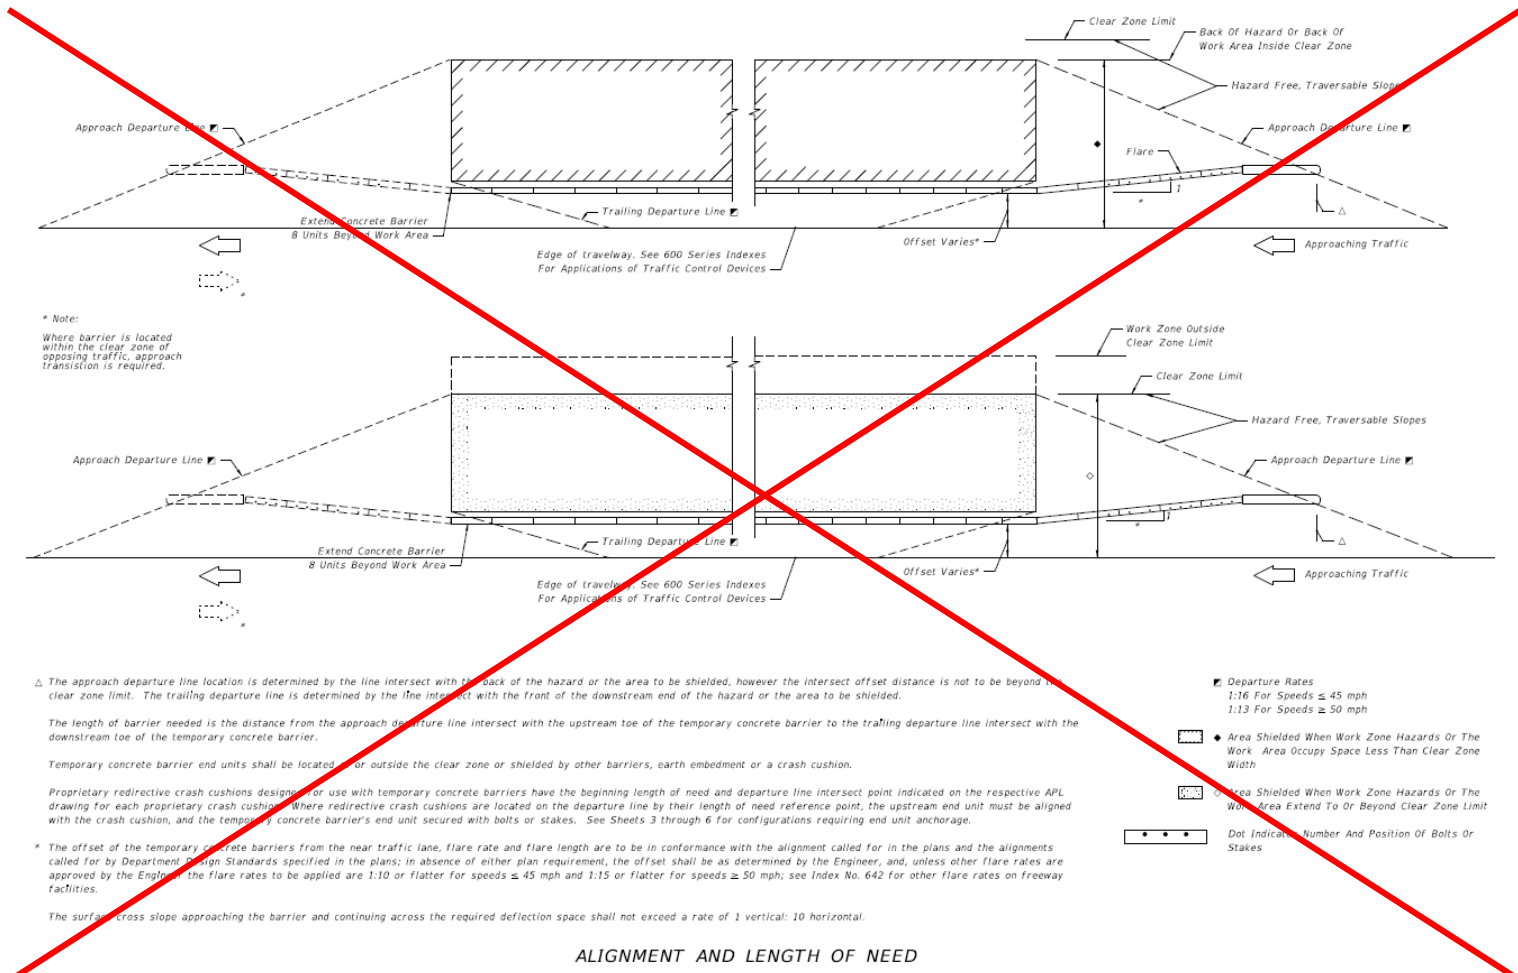

## Index 102-100 (previously Index 415) “Temporary Barrier”

- Crash cushion details have been moved to Index 102-110. See APL drawings for crash cushion details related to proprietary barriers.

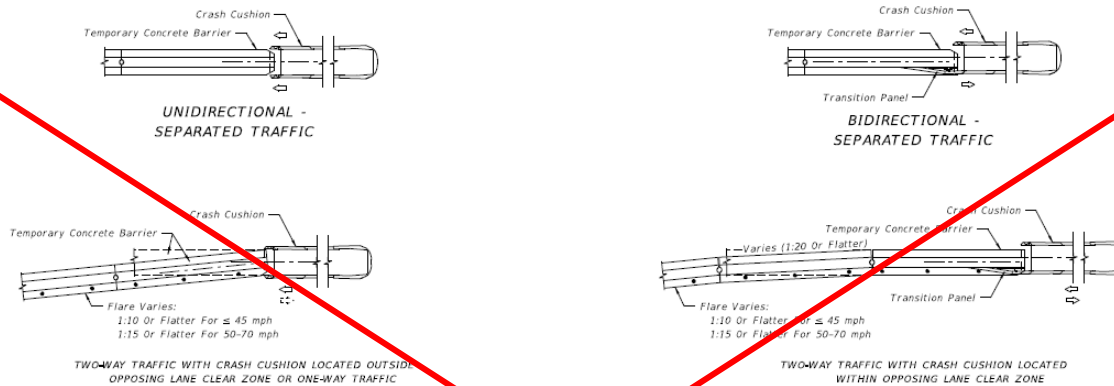

SHOULDER - RIGHT OR LEFT (RIGHT SIDE SHOWN)  
END TREATMENT WHEN SHIELDED BY A CRASH CUSHION

### NOTES FOR END SHIELDING

1. Redirective crash cushions are the principal (standard) device to be used for shielding approach ends of temporary concrete barriers. The contractor has the option to construct any of the redirective crash cushions listed on the Approved Products List at "102 Temporary Crash Cushion", subject to the uses and limitations described on their respective drawings. The last four Temporary Concrete Barrier units abutting crash cushions must be anchored to a paved surface in accordance with Design Standards Index 414.
2. Temporary redirective crash cushions shall be installed in accordance with the manufacturer's specifications and recommendations. Temporary crash cushions can be either new or functionally equivalent used devices. Performance of intended function is the only condition for acceptance, whether the crash cushion is new, used, refurbished, purchased, leased, rented, on loan, shared between projects, or made up of mixed new and used components.
3. Temporary Crash Cushions shall not be bolted down on bridge superstructures that contain post-tensioned tendons within the concrete deck (top flange of concrete box girders) or on bridge superstructures consisting of longitudinally prestressed, transversely post-tensioned, solid or voided concrete slab units. Gating crash cushions shall be used where bolting is not allowed.
4. Assemble and install Crash Cushions according to the limitations noted on the Approved Products List (APL) webpage, the manufacturer's specifications, and the applicable crash cushion drawings posted on the APL.
5. Optional temporary redirective crash cushions are to be paid for per locations under the contract unit price for Crash Cushion (Redirective Option) (Temporary), LO.
6. A yellow Type I Object Marker shall be centered 3' in front of the crash cushion nose. Mounting hardware shall be in conformance with Section 993 of the Standard Specifications for Road and Bridge Construction.  
  
As an option, the contractor may install reflective sheeting on the nose of the crash cushion. The sheeting to be used must be some yellow, Type III or better and must be a product listed on the Department's Approved Products List (APL). The sheeting to be applied to the nose of the crash cushion shall be a minimum of 360 square inches with a minimum height of 15 inches.
7. Equipment, stockpile material, etc., shall not be placed behind the crash cushion.
8. When subjected to reverse direction hits, construct Transition Panels from Temporary Concrete Barrier to Crash Cushions; for additional details refer to the applicable crash cushion drawings on the APL.
9. Galvanize metallic components to meet the requirements for Steel Guardrail, Section 967 of the Standard Specifications for Road and Bridge Construction.

### LEGEND

Dot Indicates Number And Position Of Bolts Or Stakes




SHIELDING ENDS WITH REDIRECTIVE CRASH CUSHIONS (REDIRECTIVE OPTION)

## Index 102-110 (previously Index 414) “Type K Temporary Concrete Barrier System”

- There are Index-wide revisions, but they are mostly minor and relate to the temporary barrier changes. Some information that was previously shown (e.g., setback distance) is now located solely in Index 102-100 “Temporary Barrier”.
- The fabrication details that were on sheets 1-3 of 15 are now shown on sheets 15-17 of 17.
- Significantly, added a “3-3-2-1 Anchorage Transition Detail” on sheet 1 of 17.

**LEGEND:**

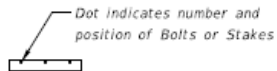

3-3-2-1 ANCHORAGE TRANSITION DETAIL

## Index 102-600 (previously Index 600)

### “General Information for Traffic Control Through Work Zones”

#### Sheet 1 of 12

- Revised Preface to General Notes along with the information contained therein.

#### ~~PRE GENERAL NOTES:~~

~~All projects and works on highways, roads and streets shall have a traffic control plan. All work shall be executed under the established plan and Department-approved procedures. This Index contains information specific to the Federal and State guidelines and standards for the preparation of traffic control plans and for the execution of traffic control in work zones, for construction and maintenance operations and utility work on highways, roads and streets on the State Highway System. Certain requirements in this Index are based on the high volume nature of State Highways. For highways, roads and streets off the State Highway System, the local agency (City/County) having jurisdiction may adopt requirements based on the minimum requirements provided in the MUTCD.~~

~~Indexes 102-601 through 102-670 are Department-specific typical applications of commonly encountered situations. Adjust device location or number thereof as recommended by the Worksite Traffic Supervisor and approved by the Engineer. Devices include, but are not limited to, flaggers, portable temporary signals, signs, pavement markings, and channelizing devices. Comply with MUTCD or applicable Department criteria for any changes and document the reason for the change.~~

~~These 3. Except for emergencies, any road closure on State Highway System in order shall comply with Section 335.15, F.S.~~


~~Except for emergencies, any road closure on State Highway System shall comply with Section 335.15, F.S.~~

#### ~~MANUAL ON UNIFORM TRAFFIC CONTROL DEVICES~~

~~The Florida Department of Transportation has adopted the "Manual On Uniform Traffic Control Devices For Streets And Highways" (MUTCD) and subsequent revisions and addendums, as published by the U.S. Department of Transportation, Federal Highway Administration, for mandatory use on the State Maintained Highway System whenever there exists the need for construction, maintenance operations or utility work.~~

## Index 102-600 (previously Index 600) “General Information for Traffic Control Through Work Zones” Sheet 12 of 12

- Removed Temporary Substitution of RPM's for Paint or Removable Tape.

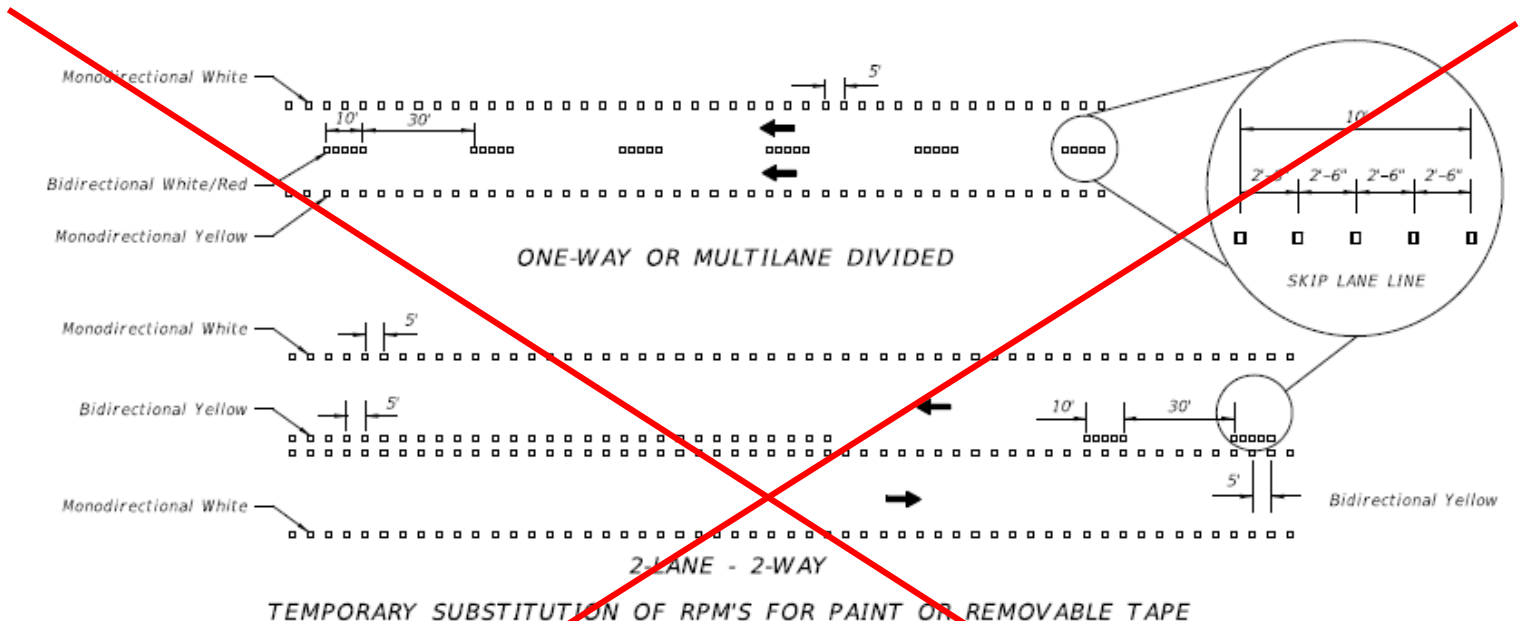

### TEMPORARY SUBSTITUTION OF RPM'S FOR PAINT OR REMOVABLE TAPE

1. Paint or removable tape are the required work zone markings and shall be placed in accordance with the plans and specifications. If these work zone markings can not be placed due to weather restrictions identified in the appropriate specification, temporary substitution of RPM's for work zone markings will be allowed until the weather condition permits the placement of appropriate work zone marking. Temporary substitution of RPM's for work zone markings will be allowed for equipment malfunction, placement of the appropriate work zone marking shall be made within 3 days, or sooner if possible. When RPM's are used as a temporary substitution for work zone markings the following shall apply:
  - a. Lane widths identified in the plans must be maintained. Placement of RPM's should consider where work zone markings will be placed as soon as conditions allow. If the RPM's can not be placed so that the lane width is maintained after the placement of the work zone markings, the conflicting RPM's must be removed.
  - b. The color of the RPM body and the reflective face shall conform to the color of the marking for which they substitute.
  - c. In work zones, B RPM's must be used to form lane lines, edge lines and temporary gore areas as a temporary substitute for paint or removable tape at the spacing shown above.



# Standard Plans Update Training

## Index 102-606 (previously Index 606) “Two-Lane, Two-Way, Work Within the Travel Way – Signal Control” Sheet 1 of 4

- Revised General Notes. Added another option for a 0.50 mile closure.

### GENERAL NOTES

- ~~1. Work operations shall be confined to the traffic lanes except for haul road crossings.~~  
~~Temporary Signals shall be used to control traffic during work operations.~~  
  
*Temporary Signals can either be portable signals or span wire signals and shall include two signal faces for each approach.*
- 1. The installation and timing of signals shall be approved by the District Traffic Operations Engineer prior to signals being placed in operation.**  
  
*Where sight distance to the signal is limited, the temporary traffic signals may be relocated at the discretion of the Engineer. Timing adjustments must be made by the Worksite Traffic Supervisor based on changing field conditions. Changes to timing (either reoccurring or lasting more than 24 hours) must be approved by the District Traffic Operation Engineer.*
- Whether the signals are in automatic mode or being controlled manually, in no case will the distance between the portable signals (receiver/controllers) exceed the maximum distance at which the portable signals can be positively and safely operated in accordance with manufacturer's recommendations. When distances between signals exceed 0.25 miles, a combination of a pilot vehicle with manually controlled temporary traffic signals are required.*
- ~~3. Additional signals or flaggers may be required to assure safe movements between traffic and operating equipment as determined by the Engineer.~~
- ~~4. Additional warning signs may be required in advance of the ROAD WORK AHEAD signs as determined by the Engineer. The distance between successive signs shall be 300 feet.~~
- 5. The SIGNAL AHEAD legend sign may be substituted for the symbol sign.*
- 6. SIGNAL AHEAD and EQUIPMENT CROSSING AHEAD signs are to be removed or fully covered when no work is being performed and the highway is open to two-way traffic. Type III Barricades shall be in place to block haul road access when the haul road is not in operation and a flagger/signal operator is not on duty, except when the haul road is an existing properly marked road.*
- ~~6. When a side road intersects the highway within the 200' construction zone, the contractor shall install and maintain appropriate T-29 signs.~~  
~~For general T-29 requirements and additional information, refer to Index No. 604.~~
- 7. Temporary traffic signals are to be used only in work zones with workers present, where the contractor can monitor signal operation and maintain traffic with flaggers in the event of a power failure.*
- 10. Use Temporary Raised Rumble Strips in accordance with Index 603.*






## Index 102-660 (previously Index 660) “Pedestrian Control for Closure of Sidewalks”


- Revised “General Notes”. The most significant change being shown below.
- Revised “Sidewalk Diversion” detail to show temporary sidewalk instead of a diversion into the traveled way. A diversion into the traveled way is still allowed, but the feasibility is limited.

~~6. When construction activities involve sidewalks on both sides of the street, stage the construction so that one sidewalk is in service at all times. If this is not feasible and both sidewalks must be closed, as determined by the Engineer, provide a detour to guide pedestrians around the construction zone.~~

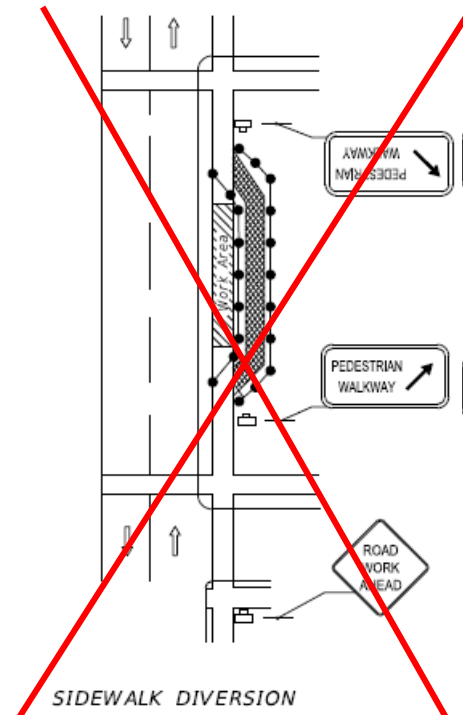


## Index 546-010 (previously Index 518) “Ground-In Rumble Strips”

- As part of the effort to remove design information from the Standard Plans, the “Shoulder Ground-In Rumble Strip Placement” detail has been removed and placed into the FDM 211.4.4. For the time being, the placement details are also described in the “General Notes”.

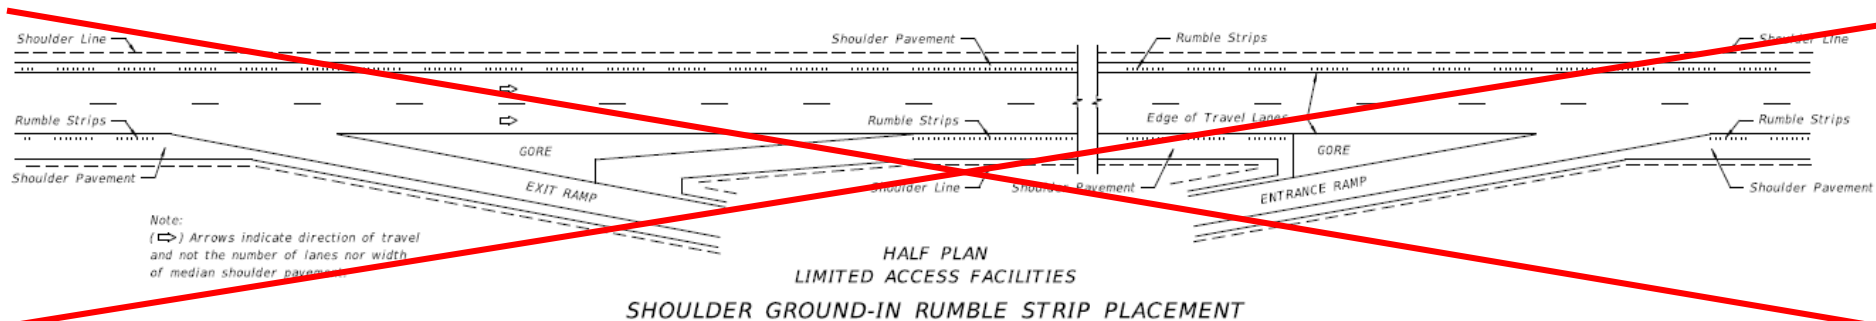


## Index 546-010 (previously Index 518) “Ground-In Rumble Strips”

- The concrete pavement details on the old sheet 2 of 2 have been removed. The “Rigid Pavement with Flexible Pavement Shoulder” detail has been incorporated into “Detail ‘A’” of the Standard Plan. The Profiled Thermoplastic criteria has been moved to FDM 211.4.4.2.

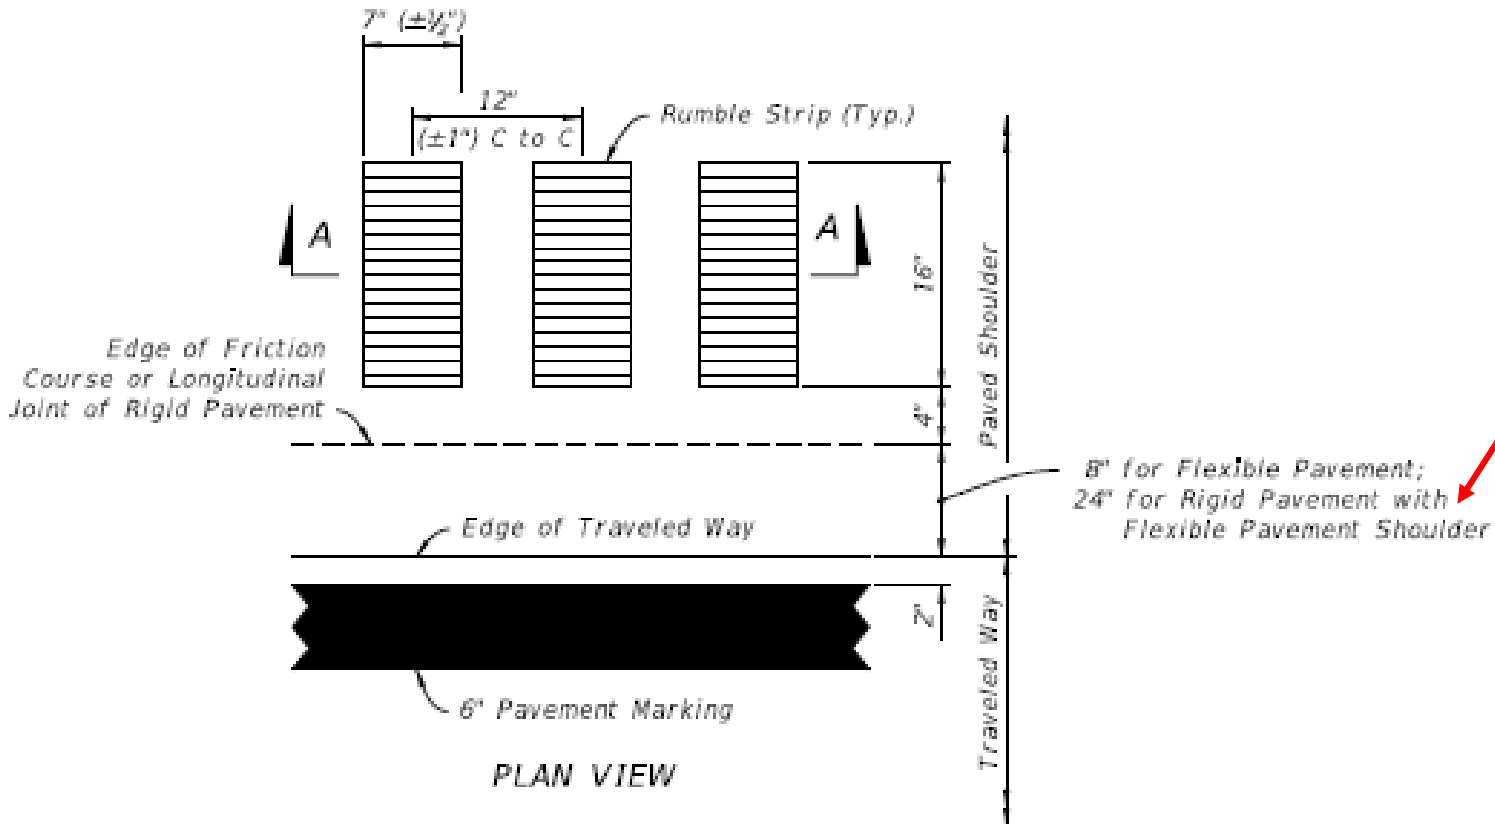

## Index 665-001 (previously Index 17784) “Pedestrian Detector Assembly Installation Details”


- The entire Index has been reconfigured, but, in general, the content is the same.
- Removed sheet with sign details and pushbutton location details (old sheet 2 of 2).

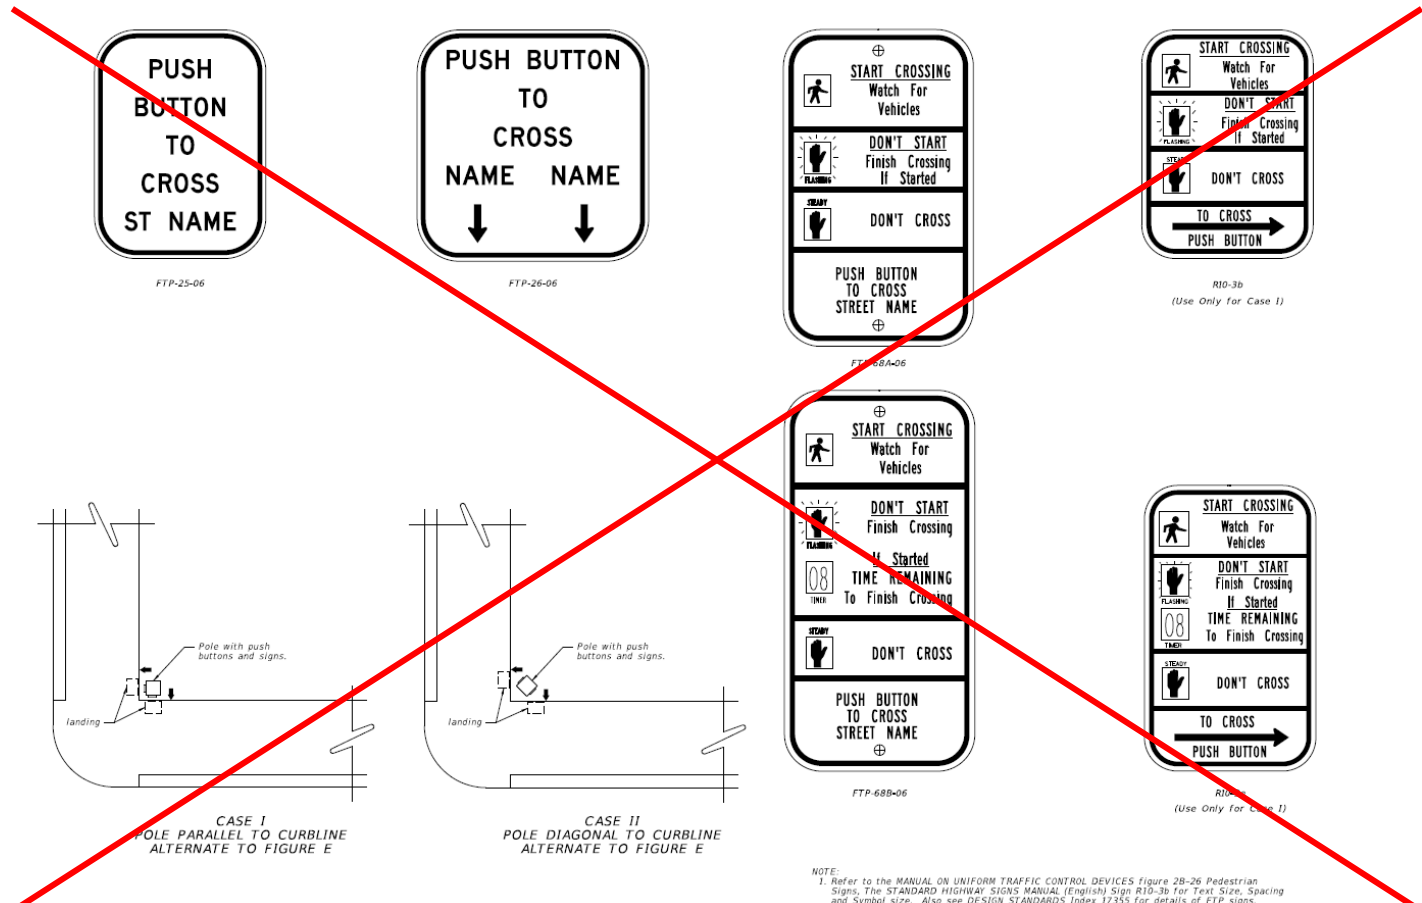

NOTE:  
 1. Refer to the MANUAL ON UNIFORM TRAFFIC CONTROL DEVICES Figure 2B-26 Pedestrian Signs, The STANDARD HIGHWAY SIGNS MANUAL (English) Sign R10-3b for Text Size, Spacing and Symbol size. Also see DESIGN STANDARDS Index 17355 for details of FTP signs.

## Index 700-010 (previously Index 11860) “Single Column Ground Signs” Sheet 5 of 9

- Removed “Concrete/Stub Detail”.
- Revised “Driven Post Detail”.

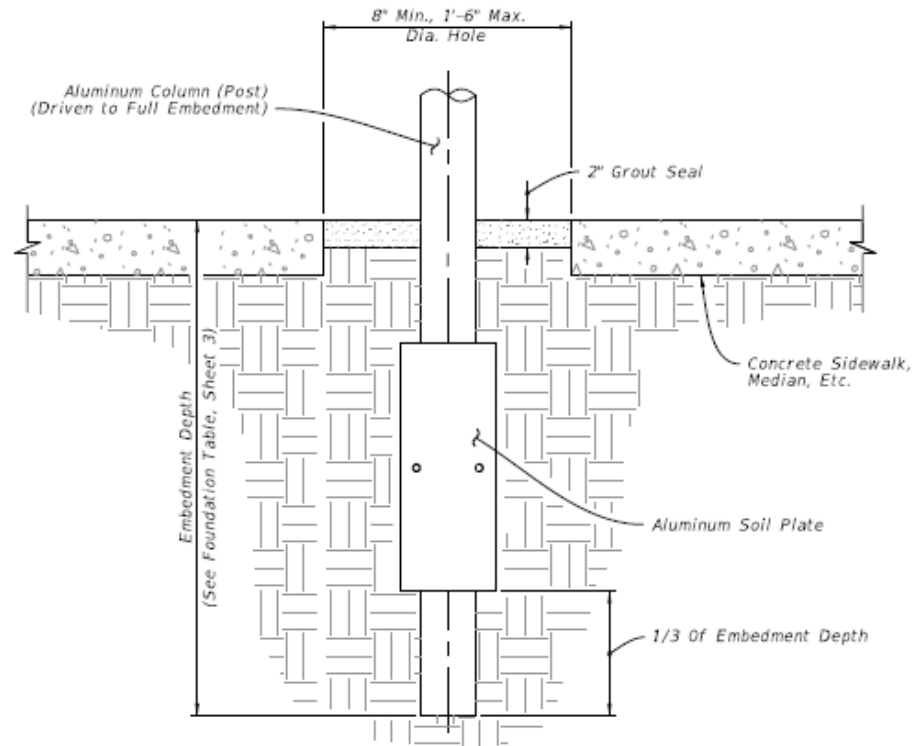


ELEVATION

DRIVEN POST DETAIL

(Frangible Post In Crossovers, Medians & Sidewalks)

## Index 700-020 (previously Index 11200) “Multi-Column Ground Sign” Sheet 1 of 3


- Deleted 8' (Max.) requirement.
- Added 7' (Min.) requirement for length of post from base connection to bottom of sign panel.

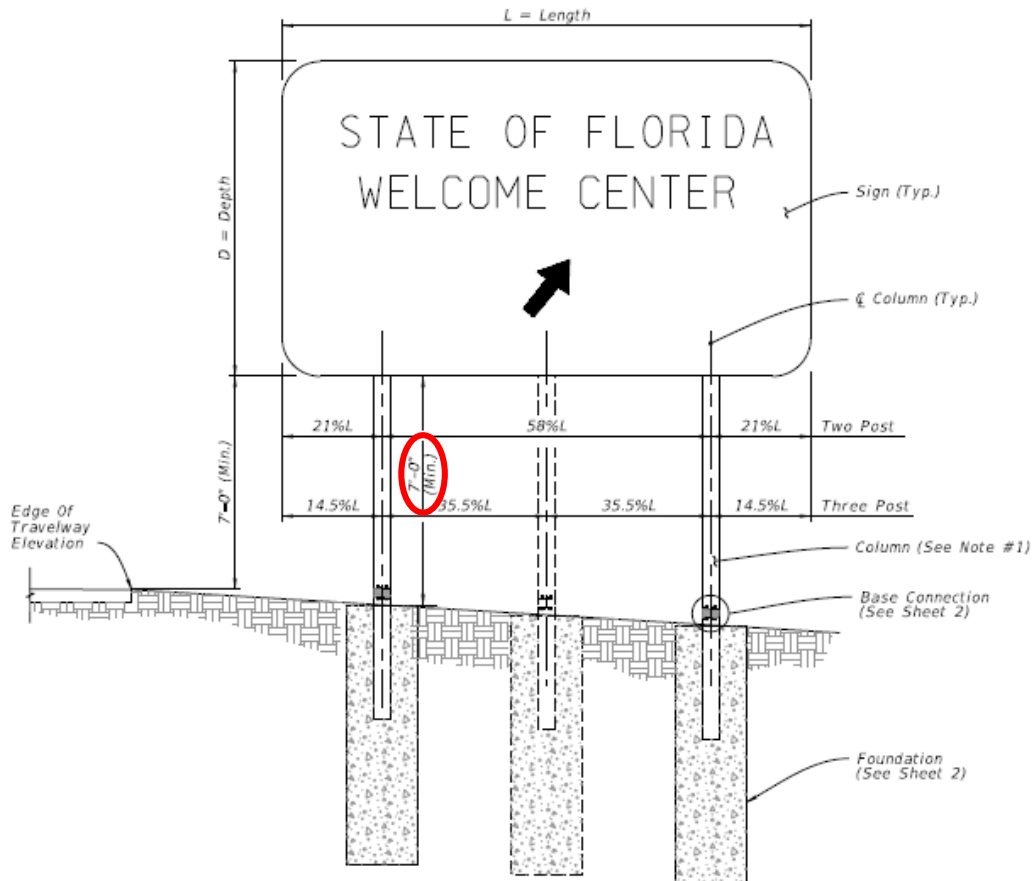

## Index 700-101 (previously Index 17302)

### “Typical Sections for Placement of Single & Multi-Column Signs”

- There are Index-wide changes for consistency, but most are relatively minor.
- Removed wrong way sign criteria out of the “Case II” detail and created a “Case X” detail specifically for wrong way signs.




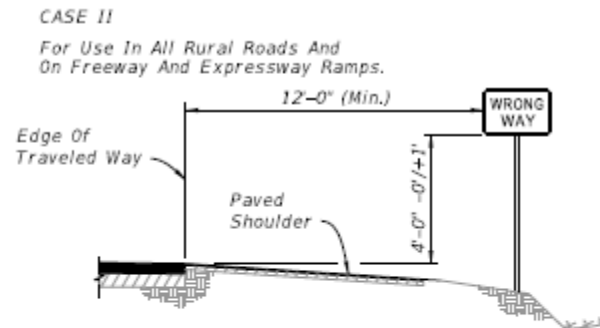


14' Horizontal Clearance Standard On All Freeway And Expressway Ramps.

~~\* 4' For Wrong Way Signs  
On Interstate Exit Ramps~~

## Index 706-001 (previously Index 17352) “Typical Placement of Raised Pavement Markers”

- There are Index-wide changes, but most are relatively minor (e.g., “Reflective” to “Raised”, note changes, etc.).
- Two new sheets have optional RPM details for median openings, islands, and traffic separators that, if used, should be called for in the Plans.

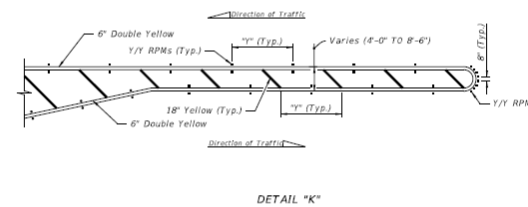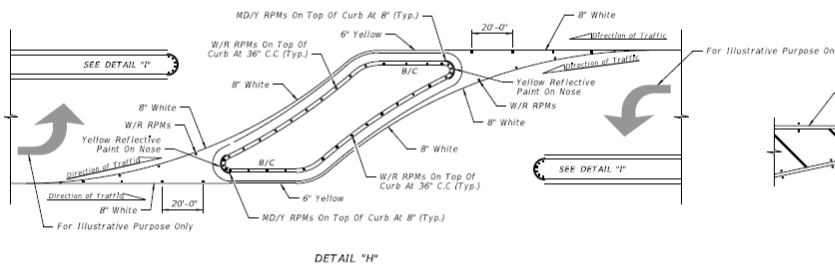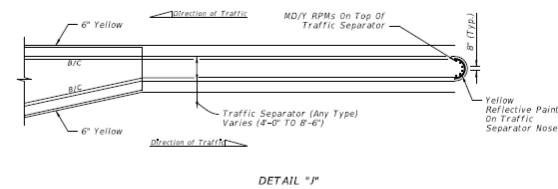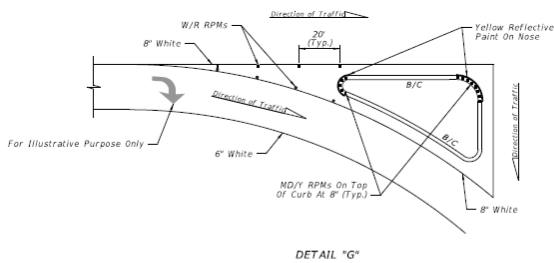

RPM PLACEMENT AT ISLANDS  
 (When called for in the Plans)

RPM PLACEMENT AT TRAFFIC SEPARATORS  
 (When called for in the Plans)

POSTED SPEED LIMIT MPH	"Y" FEET
30 OR LESS	10
35	20
40	20
45	30
50 OR MORE	40

**NOTES:**

- For Type "E" Curb install RPMs along the pavement edge marking using the same spacing shown.
- Orient traffic faces of RPMs in median radii to be parallel to direction of travel lanes.


**LEGEND:**

- B/C = BACK OF CURB
- EOP = EDGE OF PAVEMENT
- RPM = RAISED PAVEMENT MARKER
- W/R = WHITE/RED RPM
- Y/Y = YELLOW/YELLOW RPM
- Y/R = YELLOW/RED RPM
- MD/Y = MONO-DIRECTIONAL YELLOW RPM




## Index 711-001 (previously Index 17346) "Pavement Markings"

- There are Index-wide changes for consistency, but most are relatively minor.
- Two new sheets have been added to clearly show longitudinal markings.

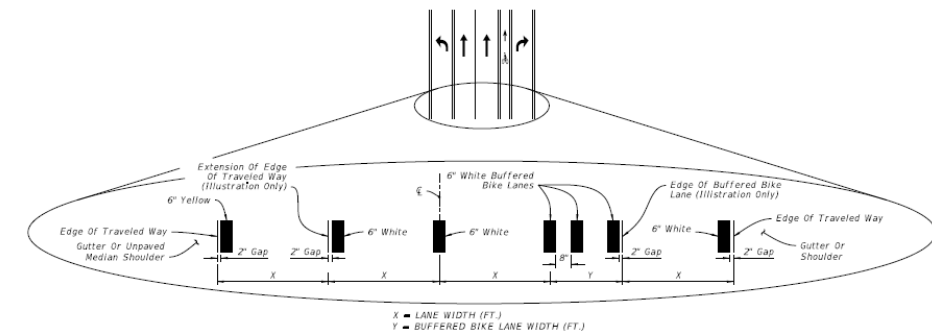

INTERSECTION APPROACH STRIPING WITH TURN LANES AND BUFFERED BIKE LANE KEY HOLE

- NOTES:**
1. Lane widths (X) may not be same for each lane in the section.
  3. For placement of RPMS, see Index 706-001.
  4. For placement of Express Lane markers and associated RPMS, see the Plans.

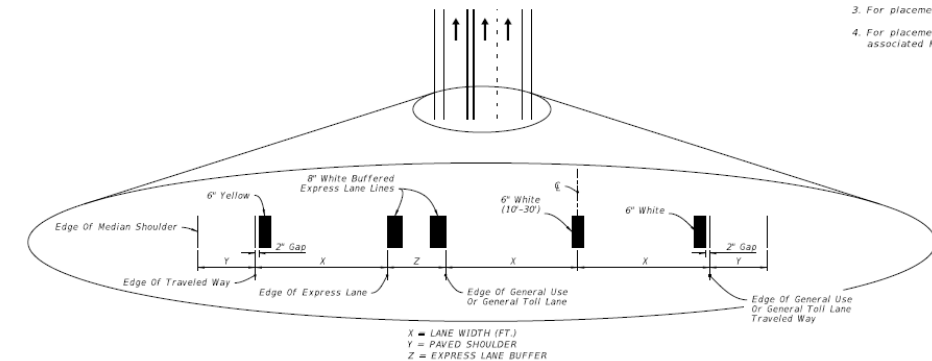


BUFFERED EXPRESS LANE STRIPING

## Index 711-001 (previously Index 17346) "Pavement Markings"

➤ Removed the following details:

- "Typical Crosswalk Markings for Curb Ramps" on sheet 6 of 17 (old)
- "Restricted Left Turn Marking" on sheet 7 of 17 (old)
- "Typical Intersection 2 Thru Lanes Plus Left Turn Lane, with Crosswalk" on sheet 7 of 17 (old)
- "Stop Bars, Crosswalks and Double Center Line Details" on sheet 7 of 17 (old)

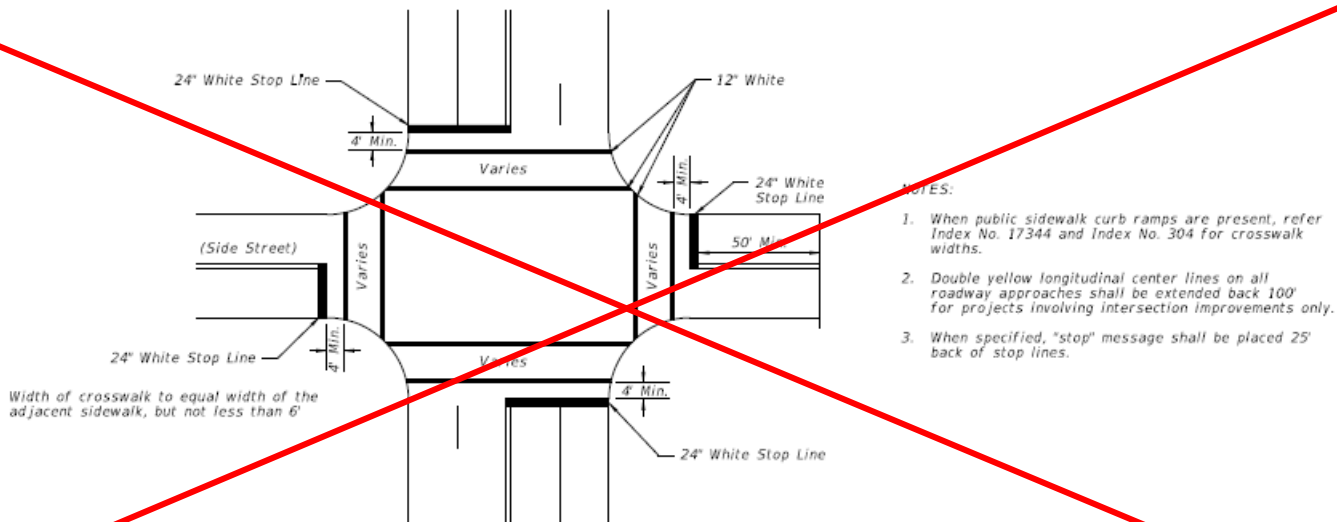


STOP BARS, CROSSWALKS AND DOUBLE CENTER LINE DETAILS

TYPICAL INTERSECTION 2 THRU LANES  
PLUS LEFT TURN LANE, WITH CROSSWALK


## Index 711-001 (previously Index 17346) “Pavement Markings”

- Removed the “One-Way Signs on Divided Highway Intersections” detail on sheet 8 of 17 (old) placed it in FDM 230 as an exhibit.
- Removed the sheet with Midblock Crossing details (old sheet 13 of 17) and placed it in FDM 230 as an exhibit.

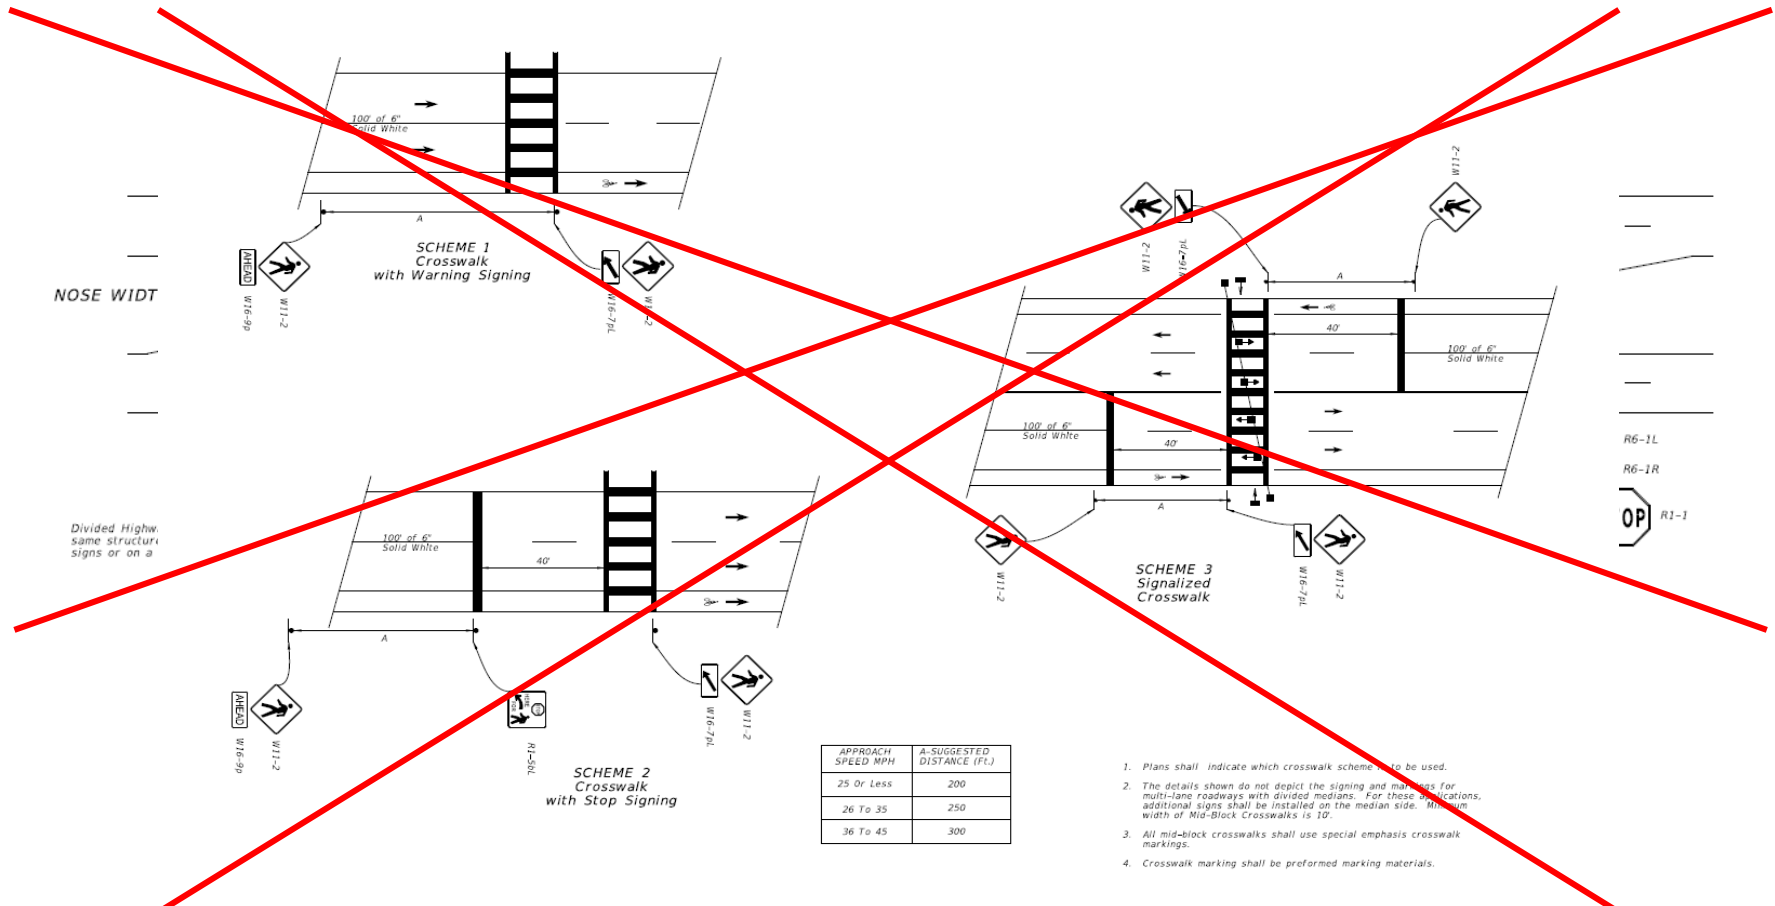

## Index 711-001 (previously Index 17346) “Pavement Markings”


- Removed the signing details from “Schemes for Transition – 2 Lane / 4 Lane Roadway” on sheet 9 of 17 (old) and placed them in FDM 230 as an exhibit.

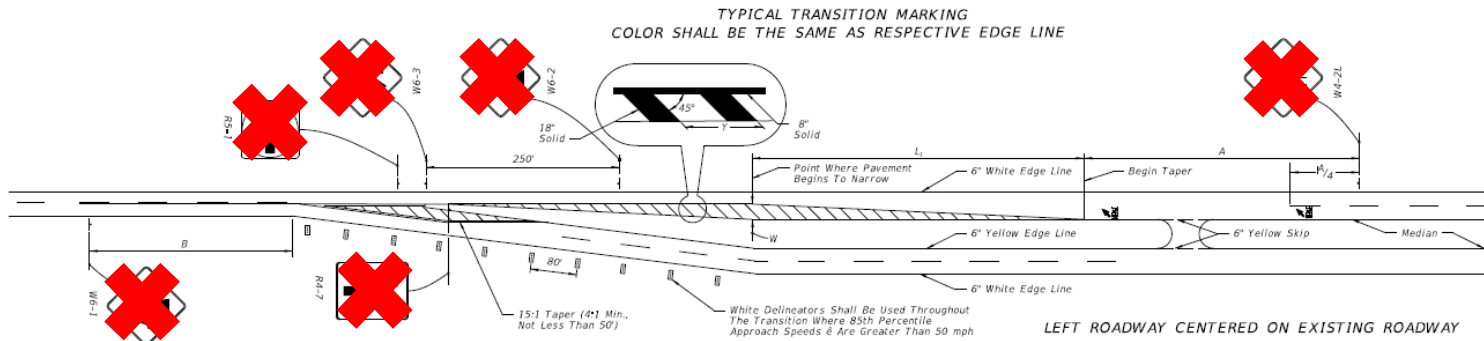

**W *S	TRANSITION DISTANCE L <sub>t</sub> (FEET)						
	8	9	10	11	12	13	14
30	120	135	150	165	180	195	210
35	165	185	205	225	245	265	285
40	215	240	270	295	320	350	375
45	360	405	450	495	540	585	630
50	400	450	500	550	600	650	700
55	440	495	550	605	660	715	770
60	480	540	600	660	720	780	840
65	520	585	650	715	780	845	910

SPEED* MPH	"A" (FT.)	"B" (FT.)
60	---	640
55	950	595
50	850	550
45	750	500
40	650	455
30	450	365


POSTED (DAY) SPEED LIMIT MPH	"y" (FT.)
30 OR LESS	10
35	20
40	20
45	30
50 OR MORE	40

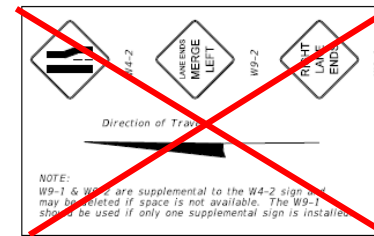

L<sub>t</sub> = WS (45 MPH or Greater)  
L<sub>t</sub> = WS<sup>2</sup> (≥40 MPH)


\*Design Speed  
\*\*Lateral offset

White Delineators Shall Be Used Throughout The Transition Where 85th Percentile Approach Speeds\* Are Greater Than 50 mph.

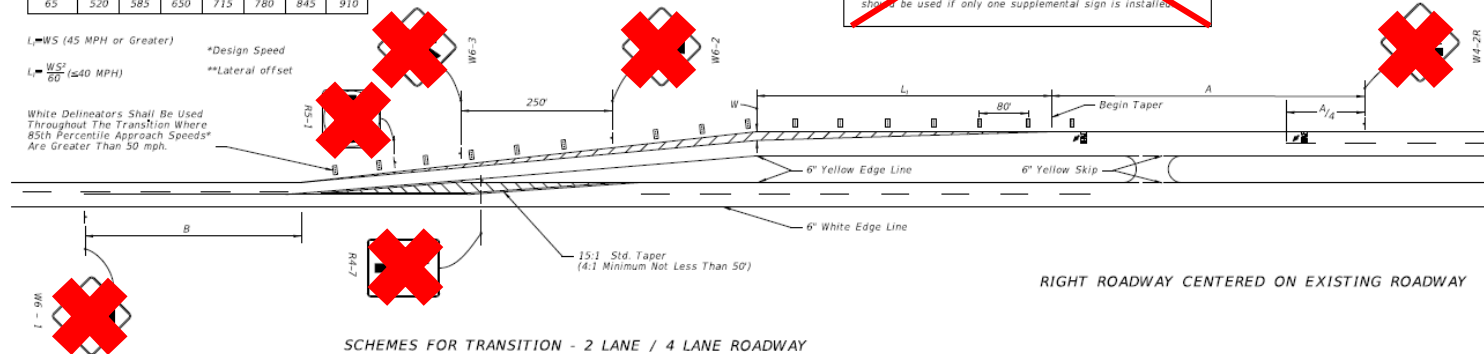

## Index 711-001 (previously Index 17346) "Pavement Markings"

- Removed sheet with exit number details (old sheet 10 of 17) and placed it in Index 711-003.

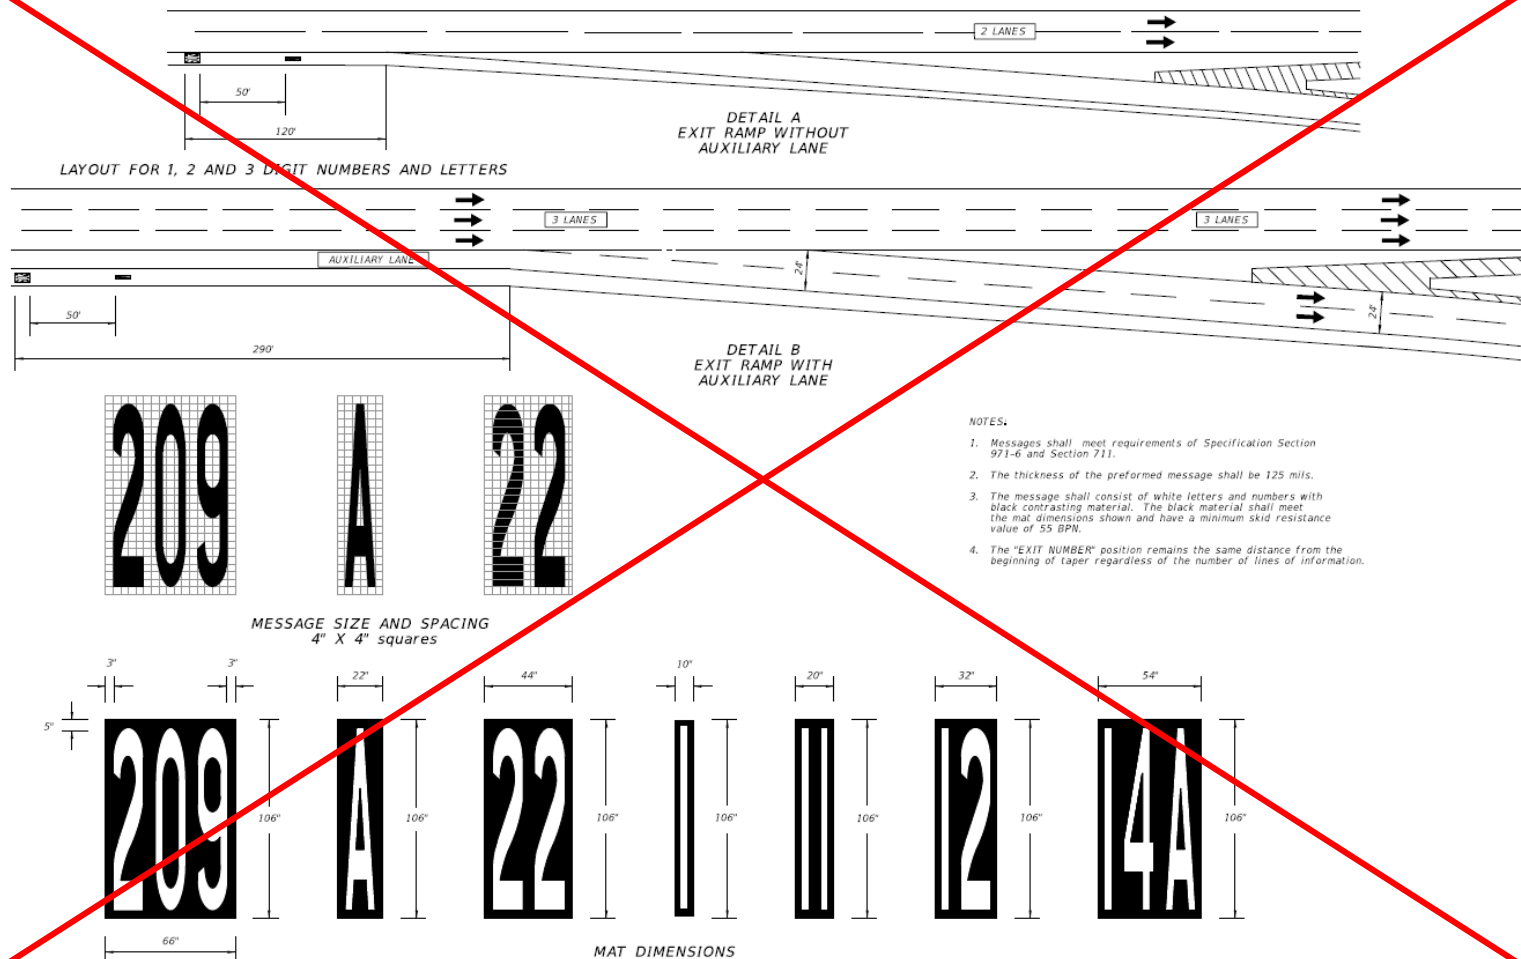





## Index 711-001 (previously Index 17346) “Pavement Markings”

- Removed sheets with Profiled Thermoplastic details (old sheets 16-17 of 17). See FDM Figure 210.4.4 for the placement of audible and vibratory treatment.


REFERENCE:  
See Profiled Thermoplastic Markings General Notes on Sheet 13.

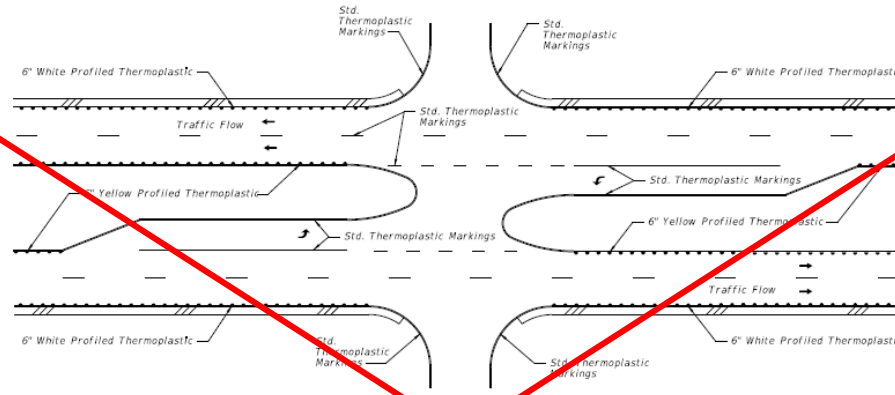

TYPICAL RURAL INTERSECTION

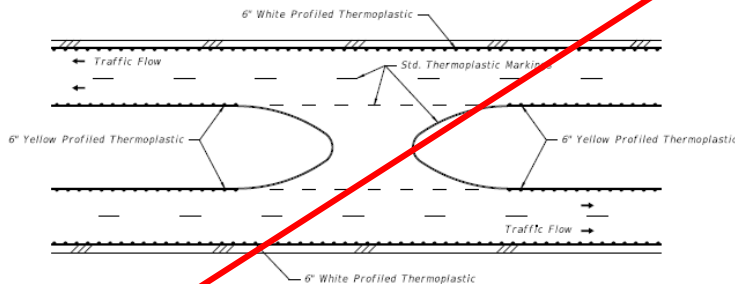


TYPICAL RURAL MEDIAN OPENING

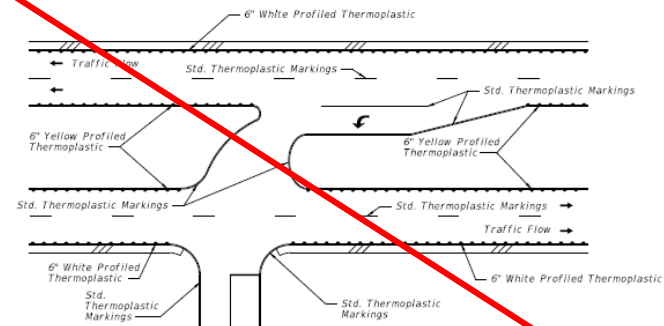

TYPICAL RURAL DIRECTIONAL INTERSECTION

## Index 711-001 (previously Index 17346) “Pavement Markings”


- Added sheet with “Markings for School Zones” details (new sheet 14 of 14).

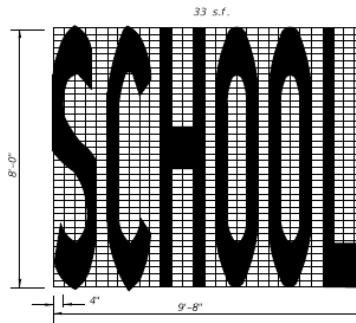


**NOTES:**

1. All grids are 4' x 4'.
2. Pavement Marking Should Not Extend Into Opposing Lane.
3. Center School Pavement Marking in lane.


SCHOOL PAVEMENT MARKING

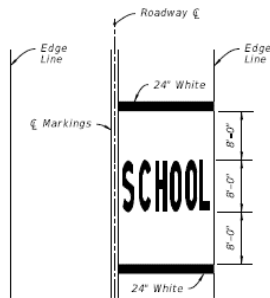

SINGLE-LANE APPROACH

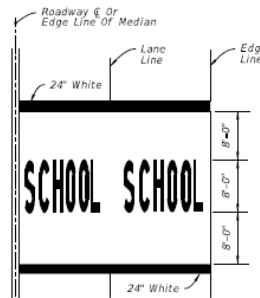

TWO-LANE APPROACH

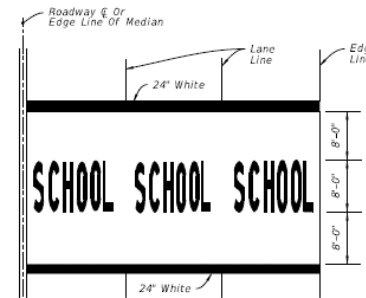


MULTI-LANE APPROACH  
(Three or More)




## Index 711-002 (previously Index 17347) “Bicycle Markings”

- Removed sheet with “Shared Lane Markings” details (previously sheet 2 of 5). See FDM 223.3 for guidance on Shared Lane Markings.
- Removed sheets with bike lane typical layouts (previously sheets 4-5 of 5). See FDM 223 exhibits for updated bike lane typical layouts.

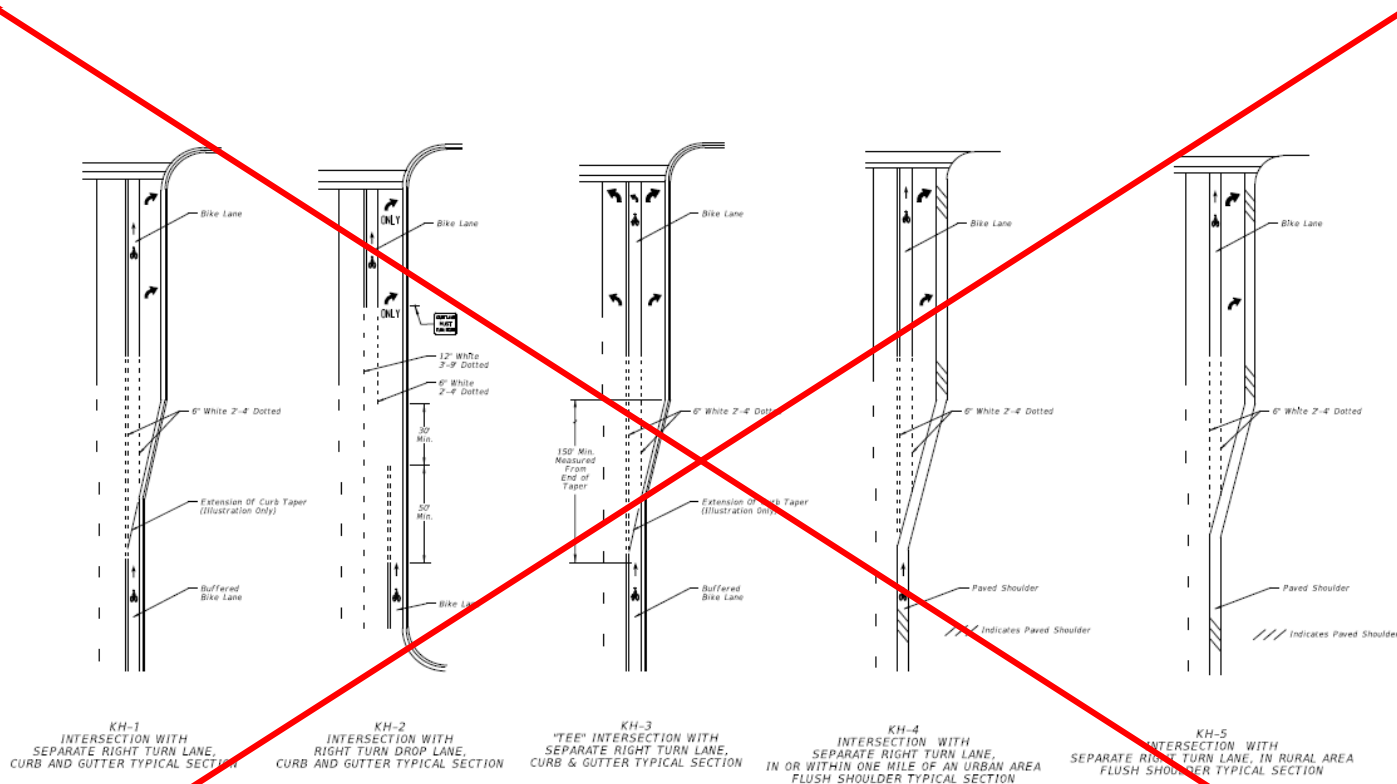


## Index 711-003 (previously Index 17345) "Interchange Markings"

- There are Index-wide changes for consistency, but most are relatively minor.
- Revised the chevron spacing chart on sheet 1 of 1. All chevron spacing is now 60'.

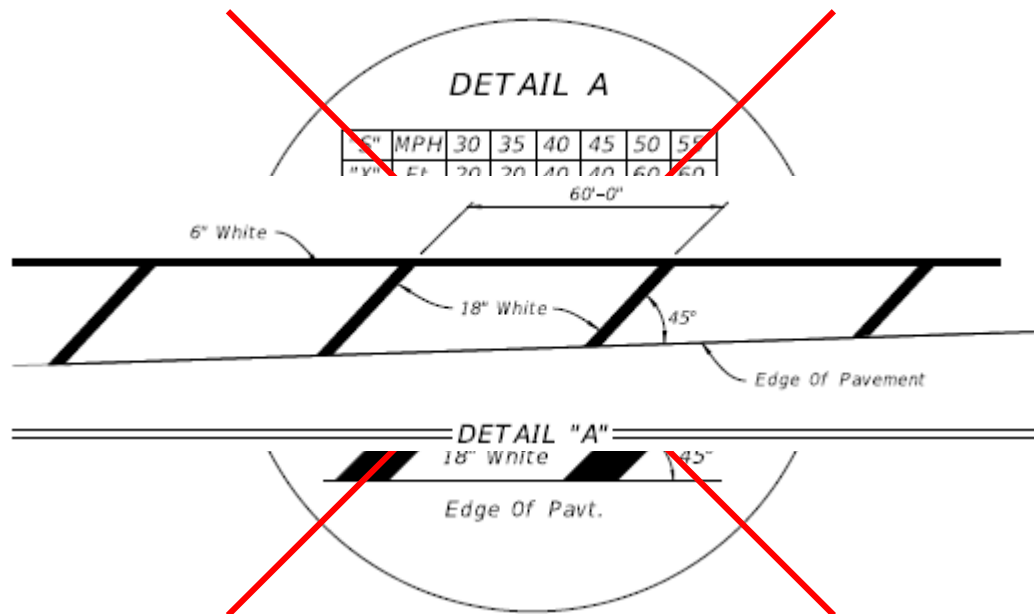

## Index 711-003 (previously Index 17345) “Interchange Markings”

- Added new sheet with a interchange intersection (sheet 6 of 7).




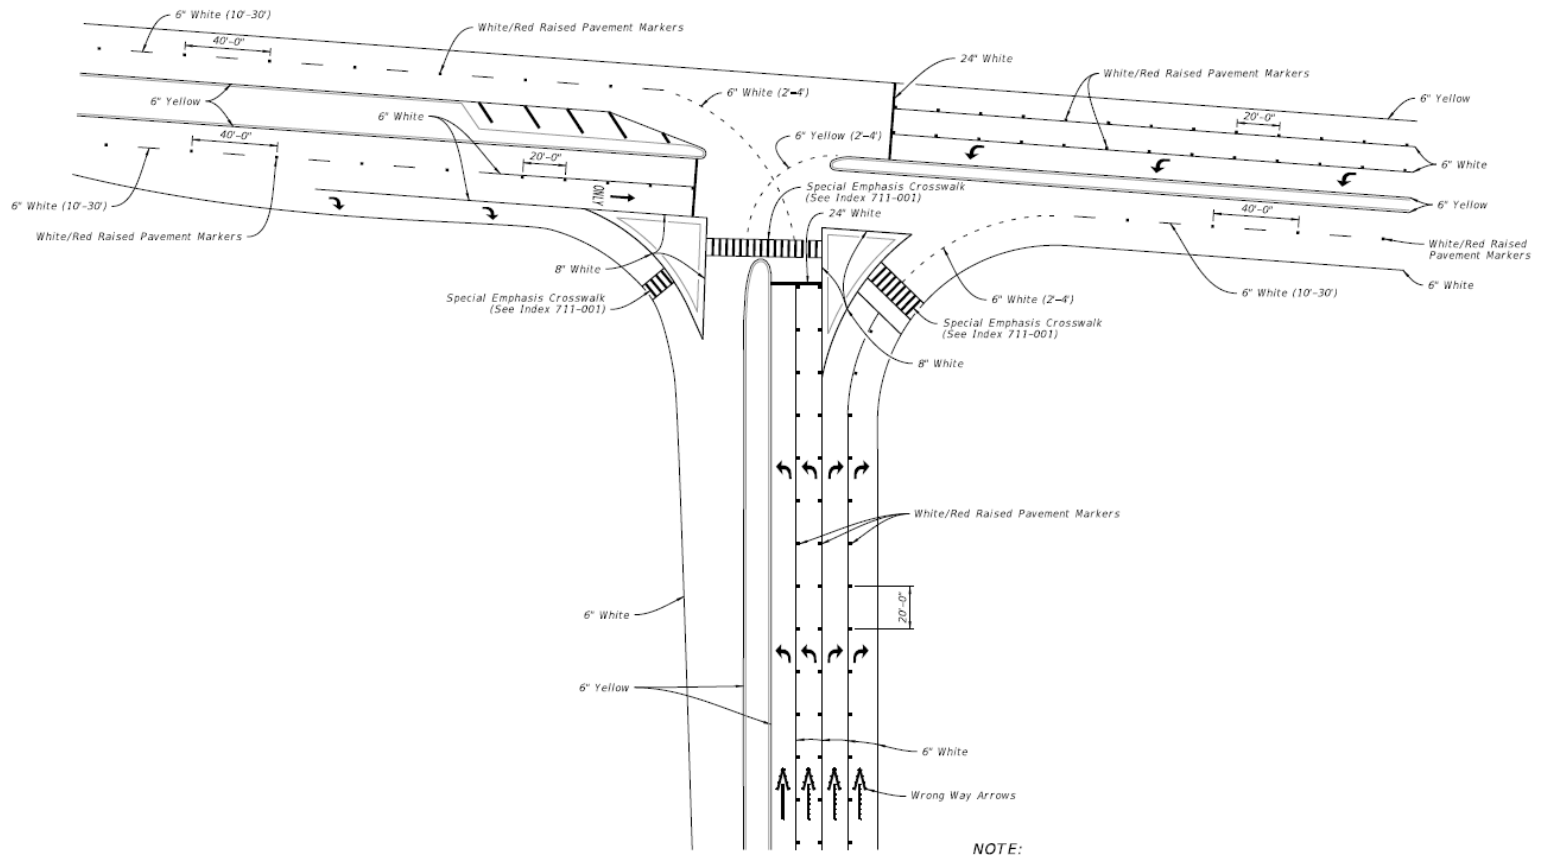


**NOTE:**

Do not place wrong way arrows in between consecutive directional arrows.

## Index 711-003 (previously Index 17345) “Interchange Markings”

- Added new sheet with exit number details (sheet 7 of 7).

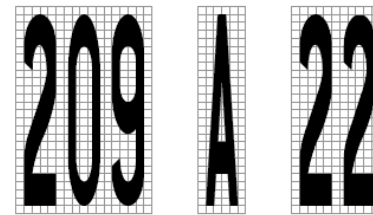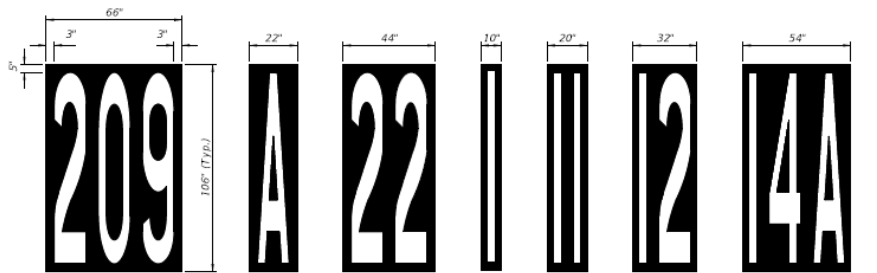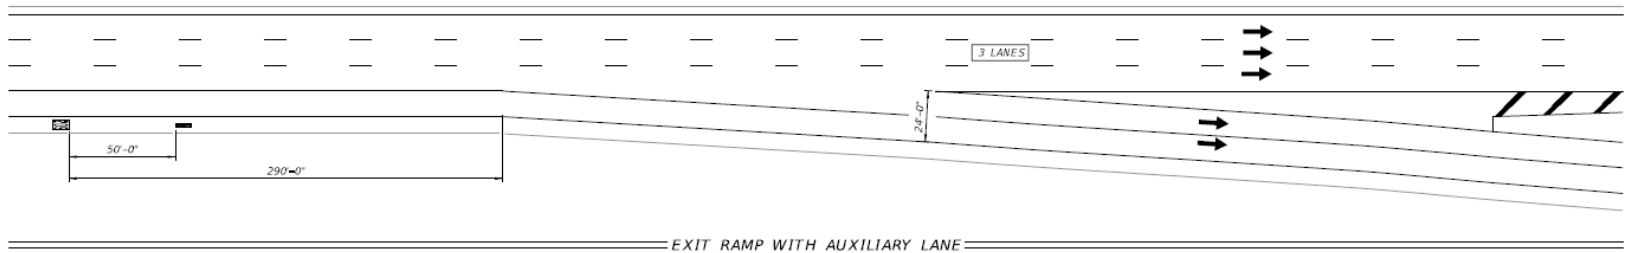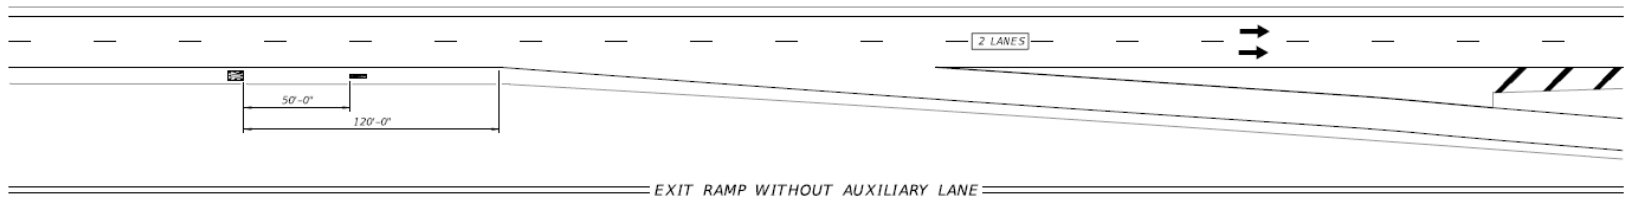

**NOTES:**

1. This Index shows layouts for 1, 2, and 3 digit numbers and letters.
2. The message consist of white letters and numbers with black contrasting material.
3. The "EXIT NUMBER" position remains the same distance from the beginning of taper regardless of the number of lines of information.
4. All Grids are 4" x4".

MAT DIMENSIONS


MESSAGE SIZE AND SPACING

## Questions



Ed Cashman, P.E.  
Standard Plans Engineer  
State Roadway Design Office  
(850) 414-4314  
[edward.cashman@dot.state.fl.us](mailto:edward.cashman@dot.state.fl.us)

# *FY 2018-19 Standard Plans Update Training*

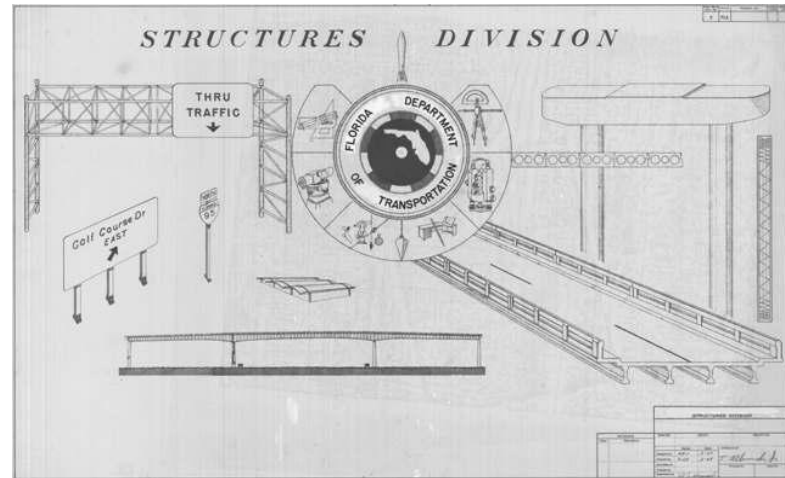

## Structures Design Office Updates (December, 2017)

Steven Nolan, P.E.

Structures Design Standards Group

[steven.nolan@dot.state.fl.us](mailto:steven.nolan@dot.state.fl.us)

(850) 414-4272

- **Global Changes**

- ✓ Numbers, Titles, & Abbreviations

- ✓ Standard Plans in Structures Component Plan Set

- Brief **BriExit** Overview

- Discontinued *Design Standards*

- Minor *Standard Plans* Revisions

- Major *Standard Plans* Revisions

- *SPI* Revisions

- *Cell* Revisions (Data Tables)

- *Developmental Design Standards/Standard Plans*

- Looking Ahead



<http://www.fdot.gov/roadway/StandardPlans/Standards.shtm>

## Welcome to BriExit 2018



*For Construction and Maintenance Operations  
on the State Highway System  
Topic No. 625-010-003*

*of Florida Department of Transportation  
Office of Design  
Mail Station 32  
605 Suwannee Street  
Tallahassee, Florida 32399-0450*



## Including **Bridge *Design Standards*** in **Structures Plans** component



**FDOT**

**OUR MISSION**  
The department will provide a safe transportation system that ensures the mobility of people and goods, enhances economic prosperity and preserves the quality of our environment and communities.

**Our Vision**  
Serving the people of Florida by delivering a transportation system that is fatality and congestion free.

**Our Values**  
The fundamental principles which guide the behavior and actions of our employees and our organization.

**Integrity**  
"We always do what is right"

**Respect**  
"We value diversity, talent and ideas"

**Commitment**  
"We do what we say we are going to do"

**One FDOT**  
"We are one agency, one team"

**Trust**  
"We are open and fair"

**Customer Driven**  
"We listen to our customers"

### ◆ Why?

#### ✓ Satisfy customer needs:

- **Maintenance Office's** custodian of bridge records for preservation of assets;
- **Contractor's** convenience for construction;
- **Designer's** reliability for developing future rehabilitation or widening projects based on accurate bridge records.
- and more...

### ◆ How?

...and still be true to the **One FDOT** principle.



Index Number	Title
861	Bridge Pedestrian/Bicycle Railing (Aluminum)
862	Aluminum Pedestrian/Bicycle Railing
870	Aluminum Pipe Gullderail
880	Steel Pipe Gullderail

### NOISE AND PERIMETER WALL SYSTEMS

5200	Precast Noise Walls
5210	Traffic Railing/Noise Wall (8'-0")
5211	Traffic Railing/Noise Wall (14'-0")
5212	Traffic Railing/Noise Wall (8'-0") Junction Slab
5213	Traffic Railing/Noise Wall T-Shaped Spread Footing
5214	Traffic Railing/Noise Wall L-Shaped Spread Footing
5215	Traffic Railing/Noise Wall Trench Footing
5250	Perimeter Walls

### WALL SYSTEMS

6010	C-I-P Cantilever Retaining Wall
6011	Gravity Wall
6020	Permanent MSE Retaining Wall Systems
6030	Temporary MSE Retaining Wall Systems
6040	Precast Concrete Sheet Pile Wall
6100	MSE Wall Coping (Precast or C-I-P)
6110	Wall Coping With Traffic Railing/Junction Slab
6120	Wall Coping With Traffic Railing/Raised Sidewalk

420	Traffic Railing - (32" F Shape)
421	Traffic Railing - (Median 32" F Shape)
422	Traffic Railing - (42" Vertical Shape)
423	Traffic Railing - (32" Vertical Shape)
424	Traffic Railing - (Corral Shape)
425	Traffic Railing - (42" F Shape)
426	Traffic Railing - (Median 36" Single Slope)
427	Traffic Railing - (36" Single Slope)
428	Traffic Railing - (42" Single Slope)
430	Crash Cushion Details
461	Crash Cushion Details
470	Traffic Railing-(Thrie Beam Retrofit) General Note & Details
471	Traffic Railing-(Thrie Beam Retrofit) Narrow Curb
472	Traffic Railing-(Thrie Beam Retrofit) Wide Strong Curb Type 1
473	Traffic Railing-(Thrie Beam Retrofit) Wide Strong Curb Type 2
474	Traffic Railing-(Thrie Beam Retrofit) Intermediate Curb
475	Traffic Railing-(Thrie Beam Retrofit) Wide Curb Type 1
476	Traffic Railing-(Thrie Beam Retrofit) Wide Curb Type 2
477	Thrie-Beam Panel Retrofit (Concrete Handrail)
480	Traffic Railing-(Vertical Face Retrofit) General Notes & Details
481	Traffic Railing-(Vertical Face Retrofit) Narrow Curb
482	Traffic Railing-(Vertical Face Retrofit) Wide Curb
483	Traffic Railing-(Vertical Face Retrofit) Intermediate Curb
484	Traffic Railing-(Vertical Face Retrofit) Spread Footing Approach

Adding: **CONCRETE BRIDGE CULVERTS**  
**289 Concrete Box Bridge Culvert Details**

17502	High Mast Lighting
17504	Service Point Details
17505	External Lighting For Signs
17515	Standard Aluminum Lighting

18101	Typical CCTV Site
18102	Grounding And Lightning Protection
18104	Typical CCTV Cabinet Equipment Layout
18105	CCTV Block Diagram
18107	Ground Mounted CCTV Cabinet
18108	Pole Mounted CCTV Cabinet
18110	Camera Mounting Details
18111	Steel CCTV Pole
18113	Concrete CCTV Pole
18300	Dynamic Message Sign Walk-In

### PRESTRESSED CONCRETE BEAMS

20010	Typical Florida-I Beam Details and Notes
20036	Florida-I 36 Beam - Standard Details
20045	Florida-I 45 Beam - Standard Details
20054	Florida-I 54 Beam - Standard Details
20063	Florida-I 63 Beam - Standard Details
20072	Florida-I 72 Beam - Standard Details
20078	Florida-I 78 Beam - Standard Details
20084	Florida-I 84 Beam - Standard Details
20096	Florida-I 96 Beam - Standard Details
20120	AASHTO Type II Beam
20199	Build-Up & Deflection Data For Prestressed I-Beams
20210	Typical Florida-U Beam Details and Notes
20248	Florida-U 48 Beam - Standard Details
20254	Florida-U 54 Beam - Standard Details
20263	Florida-U 63 Beam - Standard Details
20272	Florida-U 72 Beam - Standard Details
20299	Build-Up and Deflection Data For Florida-U Beams

### BRIDGE BEARINGS

20502	Beveled Bearing Plate Details - Prestressed Florida-U Beams
20510	Composite Elastomeric Bearing Pads-Prestressed Florida-I & AASHTO Type II Beams
20511	Bearing Plates (Type 1) - Prestressed Florida-I & AASHTO Type II Beams
20512	Bearing Plates (Type 2) - Prestressed Florida-I & AASHTO Type II Beams

Index Number	Title
--------------	-------

### SQUARE AND ROUND CONCRETE PILES (WITH CARBON STEEL)

20600	Notes and Details For Square Prestressed Concrete Piles
20601	Square Prestressed Concrete Pile Splices
20602	EDC Instrumentation For Square Prestressed Concrete Piles
20612	12" Square Prestressed Concrete Pile
20614	14" Square Prestressed Concrete Pile
20618	18" Square Prestressed Concrete Pile
20620	20" Square Prestressed Concrete Pile
20624	24" Square Prestressed Concrete Pile
20630	30" Square Prestressed Concrete Pile
20631	High Moment Capacity 30" Square Prestressed Concrete Pile
20654	54" Precast/Post-Tensioned Concrete Cylinder Pile
20660	60" Prestressed Concrete Cylinder Pile

### APPROACH SLABS

20900	Approach Slabs (Flexible Pavement Approaches)
20910	Approach Slabs (Rigid Pavement Approaches)

### BRIDGE EXPANSION JOINTS

21100	Strip Seal Expansion Joint
21110	Poured Joint With Backer Rod Expansion Joint System

### STRUCTURES ACCESS AND LIGHTING

21200	Light Pole Pedestal
21210	Conduit Details
21220	Navigation Light System Details (Fixed Bridges)
21240	Maintenance Lighting For Box Girders
21250	Access Hatch Assembly For Steel Box Sections
21251	Access Hatch Assembly For Concrete Box Sections
21252	Access Door Assembly For Concrete Box Sections

### STANDARD BAR BENDING DETAILS

21300	Standard Bar Bending Details
-------	------------------------------

### TEMPORARY DETOUR BRIDGES

21600	Temporary Detour Bridge General Notes and Details
21610	Temporary Detour Bridge Details - Timber Pile Foundations
21620	Temporary Detour Bridge Details - Steel H Pile Foundations
21630	Temporary Detour Bridge Details - Steel Pipe Pile Foundations
21640	Temporary Detour Bridge Thrie-Beam Guardrail

### POST-TENSIONING

21801	Post-Tensioning Vertical Profiles
21802	Post-Tensioning Anchorage Protection
21803	Post-Tensioning Anchorage and Grouting Details

### FENDER SYSTEM DETAILS

21930	Fender System - Prestressed Concrete Piles
-------	--

### WALL SYSTEMS (CORROSION RESISTANT)

22440	Precast Concrete Curb/Barrier - HSS/FRP Sheet Pile Wall
-------	---

### SQUARE AND ROUND CONCRETE PILES (CORROSION RESISTANT)

22600	Notes and Details for Square CFRP & SS Prestressed Concrete Piles
22601	Square CFRP and SS Prestressed Concrete Pile Splices
22612	12" Square CFRP and SS Prestressed Concrete Pile
22614	14" Square CFRP and SS Prestressed Concrete Pile
22618	18" Square CFRP and SS Prestressed Concrete Pile
22624	24" Square CFRP and SS Prestressed Concrete Pile
22630	30" Square CFRP and SS Prestressed Concrete Pile
22654	54" Square CFRP and SS Prestressed Concrete Pile
22660	60" Square CFRP and SS Prestressed Concrete Pile

## BriExit 2018


(Non-contract documents – See Structures Component of Contract Plans)

<http://www.fdot.gov/design/standardplans/current/default.shtm#Bridges>

### Standard Plans for Bridge Construction

The Standard Plans for Bridge Construction shown on this site are for designers to use in preparing contract plans only and are not for direct use by the contractor. The required Standard Plans for Bridge Construction for projects are included in the Structures Component of the Contract Plan set.

Standard Plans Index	Revision Errata	Index Title	Design Standards Index	Standard Plans Instructions	Design Tools	Contact
<b>Support Detail</b>						
Cover		FY 2018-19 Cover Sheet				
TOC Bridge		Table of Contents - Bridge Construction				
Crosswalk Revisions		Crosswalk of Design Standards Index to Standard Plans				
		Revision History Log				
<b>General Construction Operations</b>						
<b>Maintenance of Traffic</b>						
102-200		Temporary Detour Bridge General Notes and Details	2			
102-210		Temporary Detour Bridge - Timber Pile Foundations	2			
102-220		Temporary Detour Bridge - Steel H Pile Foundations	2			
102-230		Temporary Detour Bridge - Steel Pile Pipe Foundations	2			
102-240		Temporary Detour Bridge Thrie - Beam Guardrail	2			
<b>Structures</b>						
<b>Concrete Structures</b>						
400-090		Approach Slabs (30 ft.) Flexible Pavement Approaches)	2			
400-091		Approach Slabs (30 ft.) Rigid Pavement Approaches)	2			
400-289		Concrete Box Culvert Details	2			
400-291		Precast Concrete Box Culverts Supplemental Detail	2			
400-292		Standard Precast Concrete Box Culverts	2			
400-510		Composite Elastomeric Bearing Pads - Prestressed Florida-I and AASHTO Type II Beams	2			
415-001		Bar Bending Details (Steel)	2			
<b>Precast Prestressed Concrete Construction</b>						
450-010		Florida-I Beam - Typical Details and Notes	20010			

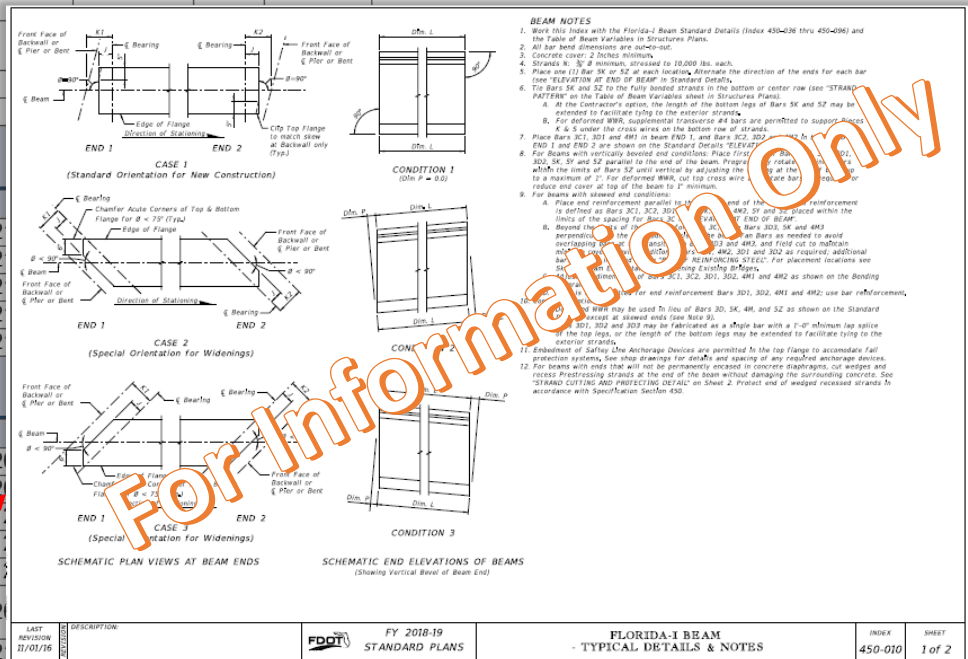



- Name changes coming for July 2018!

**FY 2018-19 Standard Plans  
- for Road and Bridge  
Construction**



## ~~FY 2016-17 Design Standards~~

Effective for Projects with Lettings in the Fiscal Year (FY) from  
July 1, ~~2016~~ through June 30, ~~2017~~

For Construction and Maintenance Operations  
~~on the State Highway System~~  
Topic No. 625-010-003

State of Florida Department of Transportation  
Office of Design  
Mail Station 32  
605 Suwannee Street  
Tallahassee, Florida 32399-0450

Also see Structures Design Bulletin 17-09/Production Support Bulletin 17-01

INDEX OF STRUCTURE PLANS

<u>SHEET NO.</u>	<u>SHEET DESCRIPTION</u>
B-1	KEY SHEET
B-2	INDEX OF SHEETS
B-3	SIGNATURE SHEET
BO1-1 AND BO1-2	SUMMARY OF STRUCTURES QUANTITIES
B-4 AND B-5	GENERAL NOTES
BI-1 THRU BI-52	SR 43 (US 301) OVER BIG BULLFROG CREEK
BW-1 AND BW-2	TEMPORARY SHEET PILE WALL PLANS
BW-3 THRU BW-17	PERMANENT RETAINING WALL PLANS
BX1-1 THRU BX1-19	EXISTING BRIDGE PLANS

**STATE OF FLORIDA**  
**DEPARTMENT OF TRANSPORTATION**

**CONTRACT PLANS**

FINANCIAL PROJECT ID 415489-3-52-01  
FINANCIAL PROJECT ID 415489-3-52-02  
FINANCIAL PROJECT ID 415489-3-52-04

HILLSBOROUGH COUNTY (10010)  
STATE ROAD NO. 43 (US 301)  
FROM SR 674 TO SOUTH OF BALM RD.

**STRUCTURE PLANS**

SR 43 (US 301) OVER BIG BULLFROG CREEK  
(BRIDGE NO. 100008)

CONSTRUCTION CONTRACT NO. T7380

LOCATION OF PROJECT

INDEX 400-090 THRU 471-030 (20010-THRU 21930) STANDARD PLANS FOR BRIDGE CONSTRUCTION

STRUCTURE SHOP DRAWINGS TO BE SUBMITTED TO:  
MARLIN A. REGISTER II, P.E.  
HDR ENGINEERING, INC.  
5426 BAY CENTER DRIVE, STE. 400  
TAMPA, FL 33609-3444  
TELEPHONE: (813) 282-2300  
FAX: (813) 282-2430

PLANS PREPARED BY:  
HDR ENGINEERING, INC.  
5426 BAY CENTER DRIVE, STE. 400  
TAMPA, FL 33609-3444  
CONTRACT NO. C-8F04  
VENDOR NO. VF-470680568  
FBPR CERTIFICATE OF AUTHORIZATION NO. 4213

NOTE: THE SCALE OF THESE PLANS MAY HAVE CHANGED BY REPRODUCTION.

THIS PROJECT TO BE LET TO CONTRACT WITH FINANCIAL PROJECT ID 415489-3-56-01

KEY SHEET REVISIONS	
DATE	DESCRIPTION

STRUCTURE PLANS  
ENGINEER OF RECORD: NELSON E. CARRERA, P.E.

P.E. NO.: 43235

FDOT PROJECT MANAGER : CHRISTINA BOULNOIS, PE, PTDE

3/2/2016

8

FISCAL YEAR	SHEET NO.
16	B-1



## BriExit Tools


Pay Item – Index Crosswalk Application (**StandardsPlansPackager**) to pull PDF's into Structures Plans Component:

Pay Item #	Pay Item Description	SPI#	DSI#	Standard Description	SPI#	DSI#	Standard Description	SPI#	DSI#	Standard Description
0400- 4- 1	Concrete Class IV, Culverts	400-289	289	Concrete Box Culvert Details	400-291	291	Precast Concrete Box Culverts Supplemental Details	400-292	292	Standard Concrete Box Culvert
0415- 1- 1	Reinforcing Steel - Roadway	400-289	289	Concrete Box Culvert Details	415-001	21300	Standard Bar Bending details (Steel)			
0521- 5- 11	Concrete Traffic Railing - Bridge, Retrofit - Post & Beam Railing	521-404	404	Guardrail Transitions - Existing Post & Beam Bridge Railings (Narrow & Recessed Curbs)	521-405	405	Guardrail Transitions - Existing Post & Beam Bridge Railings (Wide Curbs)			

2018StructuresPayItemToStandardReferences.xls

**STANDARD PLANS FOR BRIDGE CONSTRUCTION (Bridge No. 52xxxx)**

- Index 400-090 (20900) Approach Slabs (Flexible Pavement Approaches)
- Index 400-510 (20510) Composite Elastomeric Bearing Pads-Prestressed Florida-I & AASHTO Type II Beams
- Index 415-001 (21300) Standard Bar Bending Details
- Index 450-010 (20010) Typical Florida-I Beam Details and Notes
- Index 450-036 (20036) Florida-I 36 Beam - Standard Details
- Index 450-199 (20199) Build-Up & Deflection Data For Prestressed I-Beams
- Index 450-512 (20512) Bearing Plates (Type 2) - Prestressed Florida-I & AASHTO Type II Beams
- Index 455-601 (20600) Notes and Details For Square Prestressed Concrete Piles
- Index 455-602 (20601) Square Prestressed Concrete Pile Splices
- Index 455-603 (20602) EDC Instrumentation For Square Prestressed Concrete Piles
- Index 455-624 (20624) 24" Square Prestressed Concrete Pile
- Index 458-110 (21110) Poured Joint With Backer Rod Expansion Joint System
- Index 471-030 (21930) Fender System - Prestressed Concrete Piles

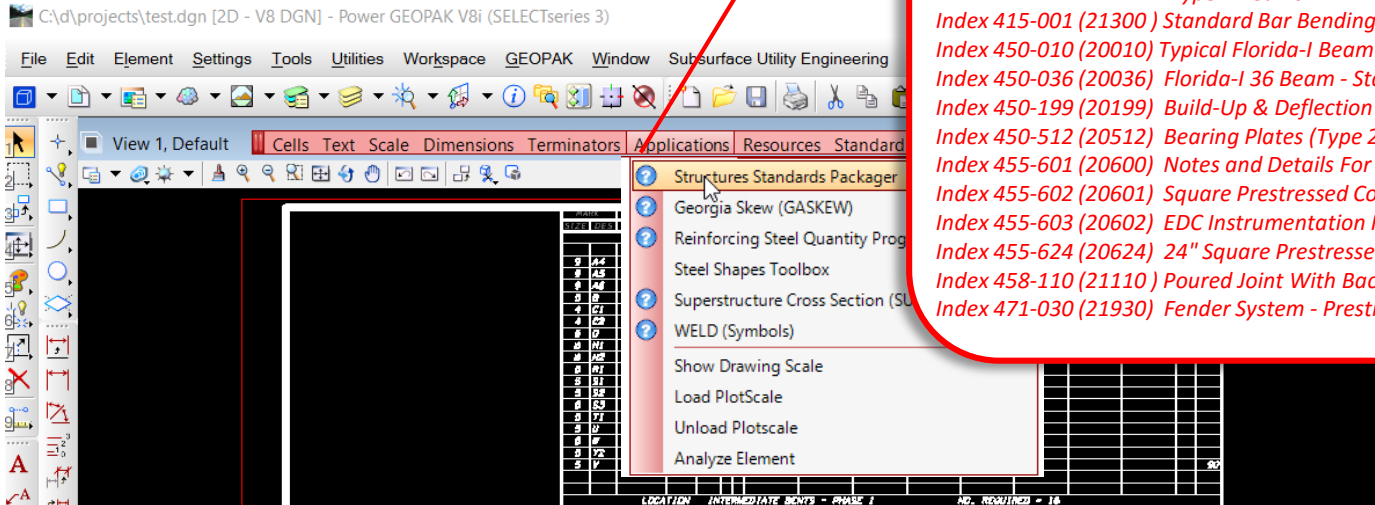



## BridgExit Tools

CADD Manual Sheet Ordering Sequence:

<http://www.fdot.gov/cadd/downloads/publications/CADDManual/CADDManual.pdf>

CADD Manual Office: Engineering/CADD Systems Effective: October 1, 2016 Update: November 1, 2016

### Structures Plans Naming Convention and Numbering Convention

Sheet Order	File Name	File Title / Description	Control File	File Group	Sheet Prefix	Drawing Prefix
		* - Design Format ** - Lead or Component Key Sheet *** - Option				
234	B#Elec-CCTVSys*	Closed Circuit Television (CCTV) System	MECHELEC	MOVABLE BRIDGE - ELECTRICAL	B1-##, B2-##, ...	BE-##
235	B#Elec-CommSys*	Communication System	MECHELEC	MOVABLE BRIDGE - ELECTRICAL	B1-##, B2-##, ...	BE-##
236	B#Elec-LighProtSyst*	Lightning Protection System	MECHELEC	MOVABLE BRIDGE - ELECTRICAL	B1-##, B2-##, ...	BE-##
237	B#Elec-GeneratorDet*	Generator Details	MECHELEC	MOVABLE BRIDGE - ELECTRICAL	B1-##, B2-##, ...	BE-##
238	B#Elec-SubCondDet*	Submarine Conduit Details	MECHELEC	MOVABLE BRIDGE - ELECTRICAL	B1-##, B2-##, ...	BE-##
239	B#Elec-FlexCableDet*	Flexible Cable Details	MECHELEC	MOVABLE BRIDGE - ELECTRICAL	B1-##, B2-##, ...	BE-##
240	B#Elec-CondSchem*	Conduit Schematic	MECHELEC	MOVABLE BRIDGE - ELECTRICAL	B1-##, B2-##, ...	BE-##
241	B#Elec-CondConductSched*	Conduit and Cable Scheduling	MECHELEC	MOVABLE BRIDGE - ELECTRICAL	B1-##, B2-##, ...	BE-##
242	B#Elec-BTRefilCeil*	Control House Reflected Ceiling Plans	MECHELEC	MOVABLE BRIDGE - ELECTRICAL	B1-##, B2-##, ...	BE-##
243	B#PedBridgeDataTable*	Pedestrian Bridge Data	STRUCTURES	TABLES	BP-1, BP-2, BP-##	***
244	B#RebarList*	Reinforcing Bar List	STRUCTURES	CONSTRUCTION	B1-##, B2-##, ...	***
245	B#DataTableLoadRating*	Load Rating Summary Table	STRUCTURES	TABLES	B1-##, B2-##, ...	***
246	B#WallControl*	Wall Control Drawing	STRUCTURES	WALLS	BW-##	W1-##, W2-##, ...
247	B#Bulkhead*	Bulkhead	STRUCTURES	WALLS	BW-##	W1-##, W2-##, ...
248	B#BulkheadDet*	Bulkhead Details	STRUCTURES	WALLS	BW-##	W1-##, W2-##, ...
249	B#SheetPileWallAnchSteel*	Anchored Steel Sheet Pile Wall	STRUCTURES	WALLS	BW-##	W1-##, W2-##, ...
250	B#SheetPileWallAnchConc*	Anchored Concrete Sheet Pile Wall	STRUCTURES	WALLS	BW-##	W1-##, W2-##, ...
251	B#SheetPileWallCantSteel*	Cantilever Steel Sheet Pile Wall	STRUCTURES	WALLS	BW-##	W1-##, W2-##, ...
252	B#SheetPileWallCantConc*	Cantilever Concrete Sheet Pile Wall	STRUCTURES	WALLS	BW-##	W1-##, W2-##, ...
253	B#SheetPileWall*	Sheet Pile Wall	STRUCTURES	WALLS	BW-##	W1-##, W2-##, ...
254	B#MSEWall*	Mechanically Stabilized Earth (MSE) Wall	STRUCTURES	WALLS	BW-##	W1-##, W2-##, ...

**STANDARD PLANS FOR BRIDGE CONSTRUCTION (20000 series for Bridges) – Formerly DESIGN STANDARDS**



## Standards Plans Packager Program (Tool):

- for compiling Structures Standard Plans (Indexes) for the Structures Component Plans  
<http://www.fdot.gov/structures/CADD/standards/CurrentStandards/MicrostationDrawings.shtm>



The screenshot shows the FDOT website header with the logo and navigation menu. The main content area is titled "Structures Design" and features a banner for "Structures Design Standards Details & Data Tables" with a background image of a bridge at night. Below the banner, there is a red warning message: "PLEASE READ THE FOLLOWING BEFORE DOWNLOADING MICROSTATION DRAWINGS".

### PLEASE READ THE FOLLOWING BEFORE DOWNLOADING MICROSTATION DRAWINGS

The official Design Standards are available at the Roadway Office website:

#### **Design Standards webpage**

Design Standards depict common structural components or elements suitable for standardization. Their use is by reference in the Contract Plans to the official Design Standards as specified in the Plans Preparation Manual (Volume II, Section 3.8). Some "Structures" Design Standards require the designer to complete a Data Table(s) and include in the Contract Plans. These Data Tables should be available on the FDOT Structures bar menu within the TTF\_V8semi-standards.cel cell library. If a Data Table is not included in the FDOT Structures bar menu, the latest cell library can be downloaded from the link provided below or individual cells can be downloaded from the [Standard Plans webpage](#) for FY2012/2013 and later.

#### **1.) Structures Related Design Standards Details:**

(see [Standard Plans website](#) for FY 2012/2013 and later Design Standards Details & Revisions)

(see [Archived Drawings](#) for 2010/2011 and earlier Design Standards Details & Interims)

**Structures Standard Plans Packager Program** (used to bundle Bridge Standard Plans into a PDF file for Structures Component)

## Standards Plans Quantities Issues:

- **Box Culverts** (See *FDM & BOE*) place in the **Structures Component Plans**
  - ✓ “Box Culvert Data Table” & Index 400-289, (400-290, 400-291 when applicable).
  - ✓ Notes & additional details
- **Box Culvert Quantities:**
  - ✓ Bridge Culvert (*Bridge #*) --> Structures Component (*similar to conventional bridge*)
  - ✓ Smaller Culverts (*no Bridge #*) --> Roadway Component (*similar to retaining walls*)

03/27/2017 11:56:10 AM

FLORIDA DEPARTMENT OF TRANSPORTATION  
PROPOSAL SUMMARY OF PAY ITEMS  
FOR PROPOSAL: T5589

These should be numbers

LEAD PROJECT : 238275-2-52-01		DISTRICT : 05		COUNTY/SECTION : 11130000					
PROJECT(S) : 23827525201, 23827535201			COUNTY : LAKE						
0001 SUMMARY OF STRUCTURES									
SPC	ALT	ITEM NUMBER	ITEM DESCRIPTION	UNIT	23827525201	23827535201	23827525201 BR# FLYOVER	23827525201 BR# POND RD	QUANTITY TOTAL
		0110- 3-	REMOVAL OF EXISTING STRUCTURES/BRIDGES 23827525201 110030, 110066	(LS)			1,000		1,000
		0400- 2- 4	CONC CLASS 11, BRIDGE SUPERSTRUCTURE	CY			776.300	114.700	891.000
		0400- 2- 5	CONCRETE CLASS 11, BRIDGE SUBSTRUCTURE	CY				50.400	50.400
		0400- 2- 10	CONCRETE CLASS 11, APPROACH SLABS	CY			115.200	96.600	211.800
		0400- 2- 25	CONCRETE CLASS 11, MASS, BRIDGE SUBSTRUCTURE	CY			375.500		375.500
		0400- 7-	BRIDGE DECK GROOVING, LESS THAN 8.5"	SY				444.000	444.000



*Don't forget to include the ~~Index 20000 series~~ + (Bridge Standards) in the Structures Component Plans.*

**For more information:**

**Steve Nolan, P.E.**

**State Structures Design Office**

**[Steven.nolan@dot.state.fl.us](mailto:Steven.nolan@dot.state.fl.us)**

**(850) 414-4272**

- Grouped by controlling **Specification Number** – NOT the *Pay Item Number*
- Last 3 number may be the same or similar to the previous *DS Index #'s*

( ### - ### )

**Bullet Railing & 27" Concrete Parapet** (*previous 800 series*) - split to relevant *Traffic Railing* and *Ped. Railing* specs:

- Concrete Parapet **521-820** ← (*DS 820*)
- Bullet Rails **515-021 & 515-022** ← (*DS 821 & 822*)

**Composite Bearing Pads** – no separate construction spec:

- **400-510** ← (*DS 20510*, associated to concrete, not with prestressed beams)

## Walls -

grouped together differently, but logically (*previously 6000 series*):

- C-I-P Cantilever & Gravity Walls **400-010 & 400-011** ← (*DS 6010 & 6011*)
- Precast Sheet Pile Walls **455-400 & 455-440** ← (*DS 6040 & 22440*)
- MSE Walls **548-020 & 548-030** ← (*DS 6020 & 6030*)

**Conventional & FRP precast elements** (*previously 22000 series*) -

grouped together by controlling specification but separated by material type:

- Piles **455-000 series & 455-100 series**
- Sheet Pile Walls **455-400 & 455-440**

## Purpose of Index Title Changes:

- Searchability
- Consistency
- Classification

### **Example: Subject - Description**

- **Typical** Florida-I Beam Details and Notes  
 → Florida-I Beam – **Typical** Details & Notes

### **Example: Subject - Classification**

- Precast Sheet Pile Walls (Conventional)
- Precast Sheet Pile Walls (CFRP/GFRP & HSSS/GFRP)

- Revision Log

<http://www.fdot.gov/design/standardplans/current/SP-Revisions.pdf>

## STANDARD PLANS FY 2018-19 REVISIONS LOG

<i>Design Standards Index</i>	<i>Standard Plans Index</i>	<i>Description</i>
220	425-040	<i>Sheet 1: Clarified Dimensions on each side of Section BB.</i>
233	425-053	<i>Sheet 1: Changed GENERAL NOTE 1 - "clearance/gap from 1" to 5/8" to be consistent with Index 425-031.</i>
280	430-001	<i>Sheet 1: Updated the Notes for the "DISSIMILAR TYPES" detail.</i>
20010	450-010	<i>Changed Title: Florida-I Beam - Typical Details and Notes.</i>
20199	450-199	<i>Changed Title: Prestressed I-Beams Build-Up and Deflection Data.</i>
20210	450-210	<i>Changed Title: Florida-U Beam - Typical Details and Notes.</i>
20299	450-299	<i>Changed Title: Florida-U Beams Build-up &amp; Deflection Data.</i>
20600	455-001	<i>Changed Title: Square Prestressed Concrete Piles - Typical Details &amp; Notes.</i>
20602	455-003	<i>Changed Title: Square Prestressed Concrete Piles - EDC Instrumentation.</i>
20631	455-031	<i>Changed Title: 30" Square Prestressed Concrete Pile - High Moment Capacity.</i>
22600	455-101	<i>Changed Title: Square CFRP &amp; SS Prestressed Concrete Piles - Typical Details &amp; Notes. Sheet 1: Corrected Note 6 (Spec 962 to 926).</i>
6040	455-400	<i>All Sheets: Changed Title: Precast Concrete Sheet Pile Wall (Conventional). Sheet 1: Changed MATERIALS note.</i>
22440	455-440	<i>Changed Title: Precast Concrete Sheet Pile Wall (CFRP/GFRP &amp; HSSS/GFRP).</i>
21100	458-100	<i>Changed Title: Expansion Joint System - Strip Seal.</i>
21110	458-110	<i>Changed Title: Expansion Joint System - Poured Joint with Backer Rod.</i>

## Discontinued the following Traffic Railings:

- 32" F Shape ( DS Index 420)
- 32" F Shape Median (DS Index 421)
- 42" F Shape ( DS Index 422)
- Corral ( DS Index 424)



*Changes to remove details for those railings and add details for Single-Slope Traffic Railings/Concrete Barriers*

- *521-660 Light Pole Pedestal – Bridge*
- *400-289 Box Culverts*
- *515 -### Bridge Railings .....etc.*

<http://www.fdot.gov/design/Training/designexpo/2017/Presentations/2017-NolanBoyd-NewSingleSlopeandRetrofitTrafficRailings.pdf>



Standard Abbreviation Changes: *SP (DS), SPI (IDS), FDM (PPM)*

Continuing to work towards consistency between Indexes, Instructions, and Specifications




**Editorial:** Revised Neoprene Pads to Bearing Pads for Ancillary Structures to match Spec. language (460-470 & 550-010, 011, 012 , & 534-250).

**Railings vs. Barriers:** Joint effort in cooperation with Roadway and Specifications - the following rule of thumb:

If located on a Bridge or Approach Slab = *Traffic Railing*  
 If located on a wall or shoulder = *Concrete Barrier*

**Examples:**

- Concrete Barriers with Junction Slab
- Concrete Barrier/Noise Wall (Junction Slab, L, T, or Trench Footings)
- Traffic Railing/Noise Wall (Bridge and Approach Slab)

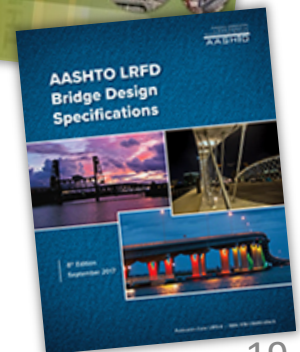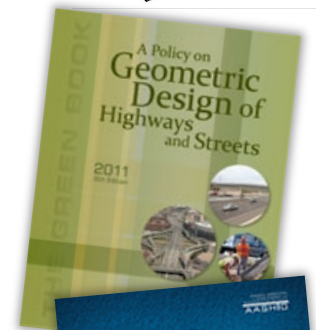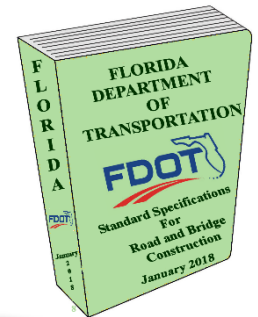



- **Index 515-021 & 022: Bullet Railing**




- Changed/Added additional post "Type" (Single-Slopes), due to change from 32" to 36" height
- Dual dimensioned as necessary

- **Index 521 series: Traffic Railings**




- Removed "Delineator Spacing" Table – see Specifications (Section 705 ?)
- Added height transitions (2" for future asphalt overlay)
- Added 3<sup>rd</sup> row of conduit
- Changed anchorage reinf. (Bars 4V)

- **Index 521-820 (27" Concrete Parapet)**


- Changed post names (changes due to single-slope)

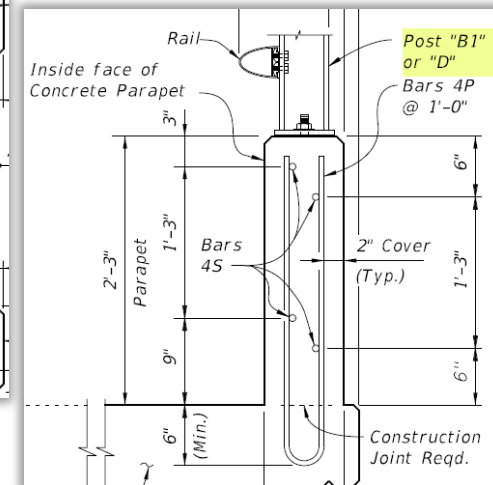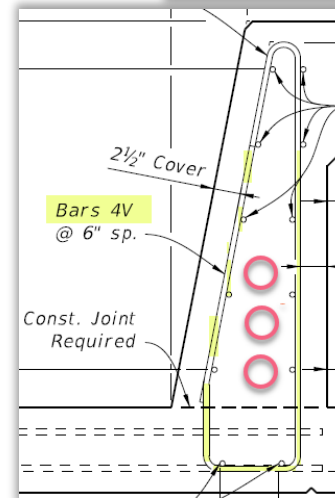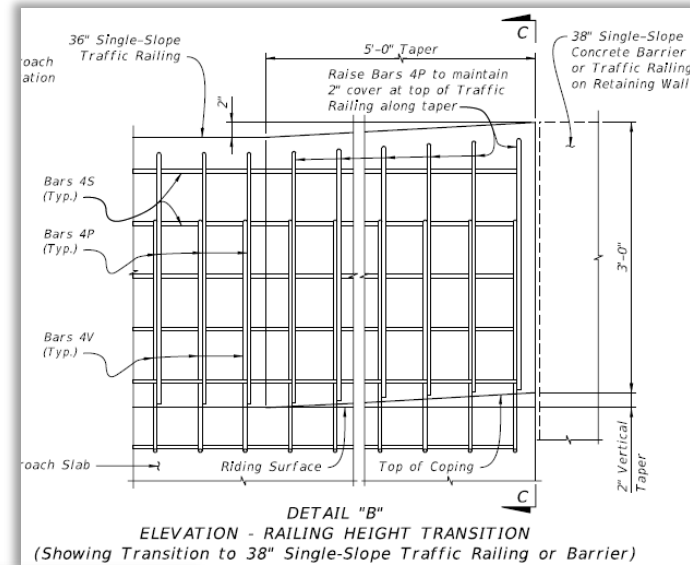

- Index 534-200: Noise Walls**
  - Updates to component tables rebar sizes and lengths
  - Cover in H-post for large size bars (#11's)
- Index 534-250: Perimeter Walls**
  - Increased distance to first shear (tie) bar below precast section for 45° corner posts.
- Index 550-010: Bridge Fencing (Vertical)**
  - Added Brace Rails to Expansion Assembly Detail
- Index 550-010 thru 550-012: Bridge Fencing**
  - Changed 32" F-Shape to 36" Single-Slope

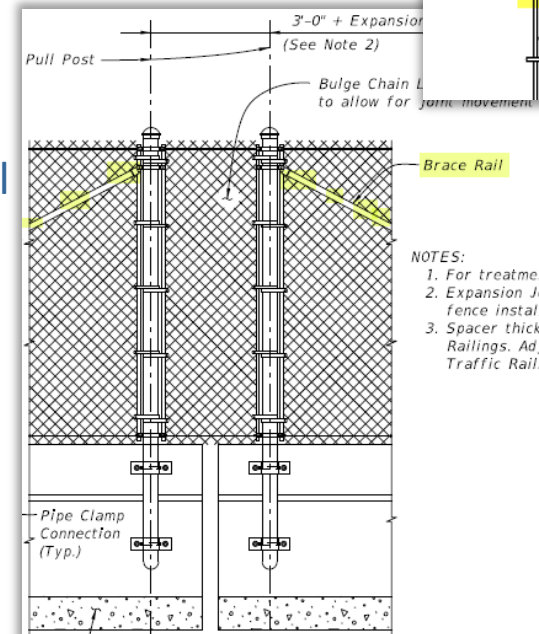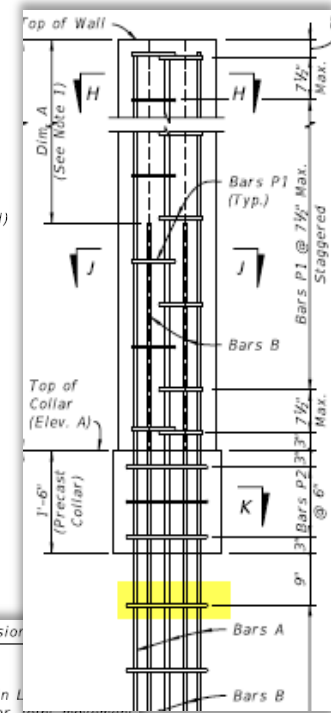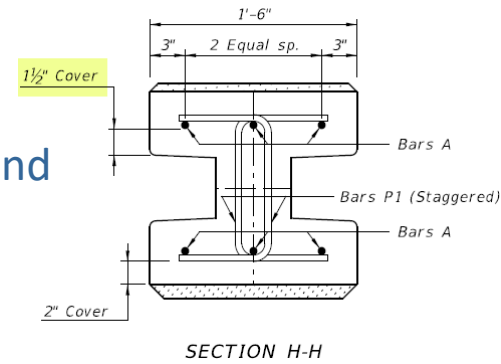

- NOTES:
- For treatment
  - Expansion J fence instal
  - Spacer thick Railings. Ad Traffic Rail

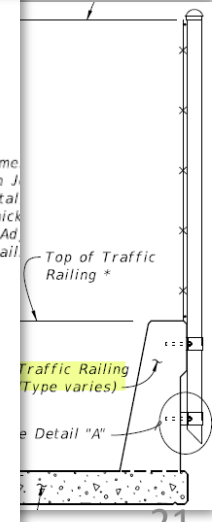


## New Bridge Fencing Type

### **Index 515-013: Bridge Fencing (Over Railroad):**

- For use when require by Railroad Permitting authority when no side walk is provided
- Curved Top adjacent to traffic


Fencing - Type R			
550-010		Bridge Fencing (Vertical)	810
550-011		Bridge Fencing (Curved Top)	811
550-012		Bridge Fencing (Enclosed)	812
550-013		Bridge Fencing (Over Railroad)	<del>812</del>

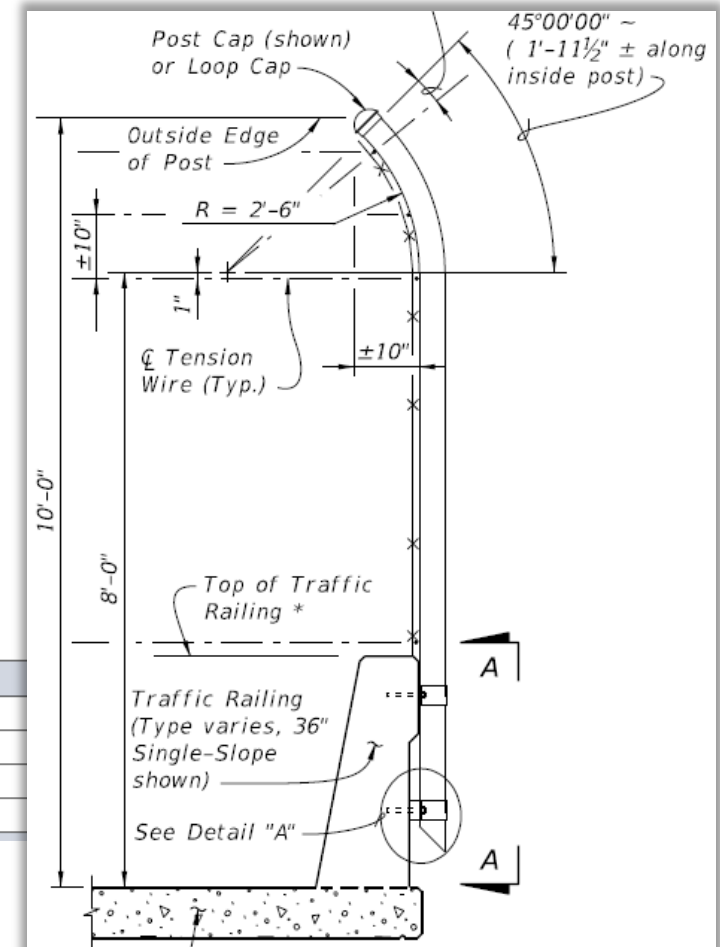

## Major Changes for Traffic Railing/Noise Walls

### **Index 521-509: Traffic Railing/Noise Wall (8'-0"):**


- *Modified lower traffic railing shape (36" Single-Slope)*
- *Wall similar to previous standards for traffic railing/noise wall*
  - ✓ *Bridge and Approach Slab*
  - ✓ *Must be included in the Structures Component Plans*
  - ✓ *Conduit can now fit in the Traffic Railing portion.*

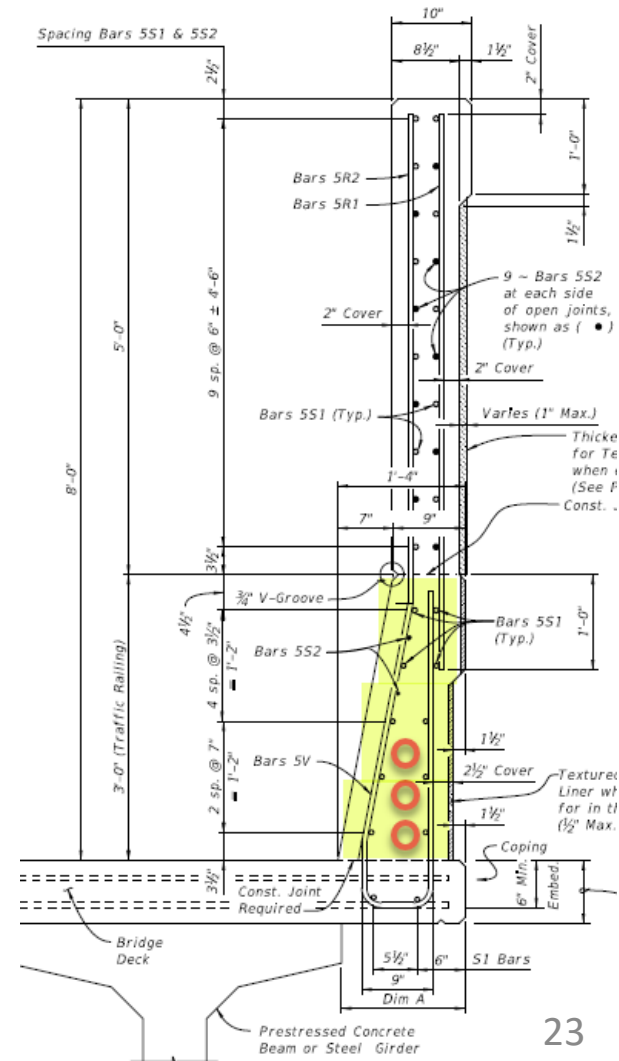

## Major Changes for Concrete Barrier/Noise Walls

### **Index 521-510 & 521-511: now called Concrete Barrier/Noise Walls**

- Concrete Barrier (36" Single-Slope)
- Wall similar to previous standards for traffic railing/noise wall (8'-0" and 14'-0")
  - ✓ Use with Index 521-512, 513, 514 or 515 (footings)
  - ✓ Roadway Component Plans (i.e. do not include Standard Plans PDF's)

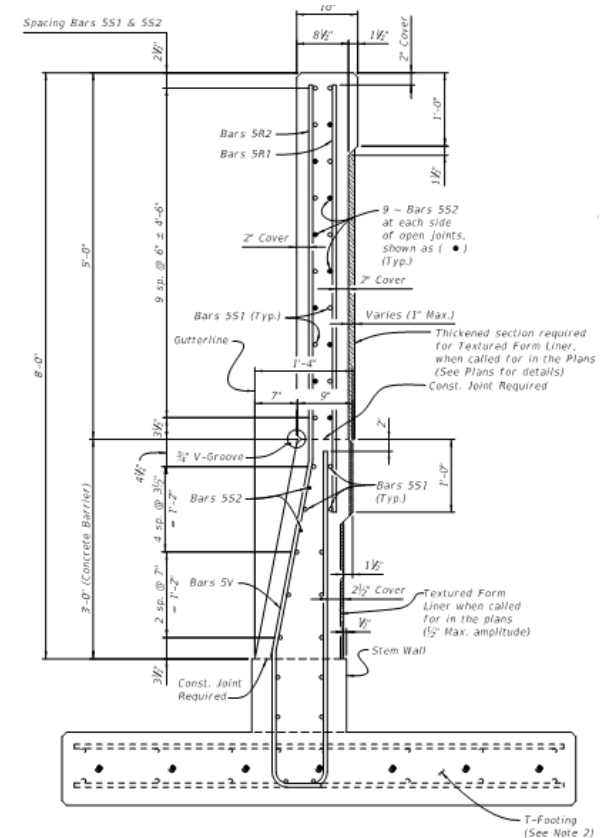


SECTION A-A  
 TYPICAL SECTION THRU CONCRETE BARRIER/NOISE WALL AT OPEN JOINT  
 (Section Thru T-Footing Shown, Section Thru  
 Junction Slab, L or Trench Footings similar)

## Toe Transitions for Traffic Railings & Concrete Barriers

**All** traffic railings and concrete barriers connected to guardrail:



✓ Toe transition is now 3" over 3'-0".

On adjacent bridges, if the railing slab may coincide, a bond breaker will be used. See Structures Plans, Details for Details.

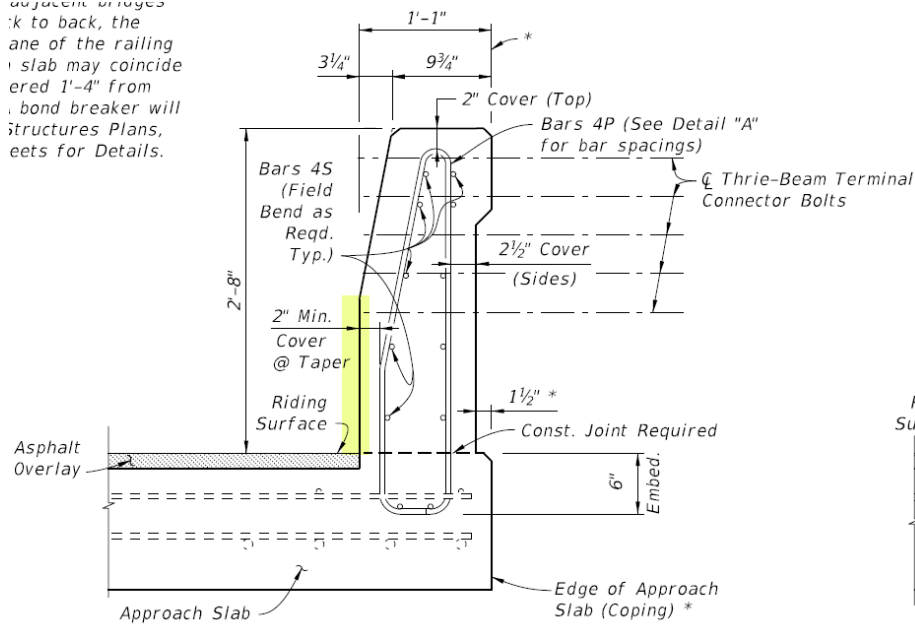

VIEW B-B  
END TRANSITION


Approach Slab

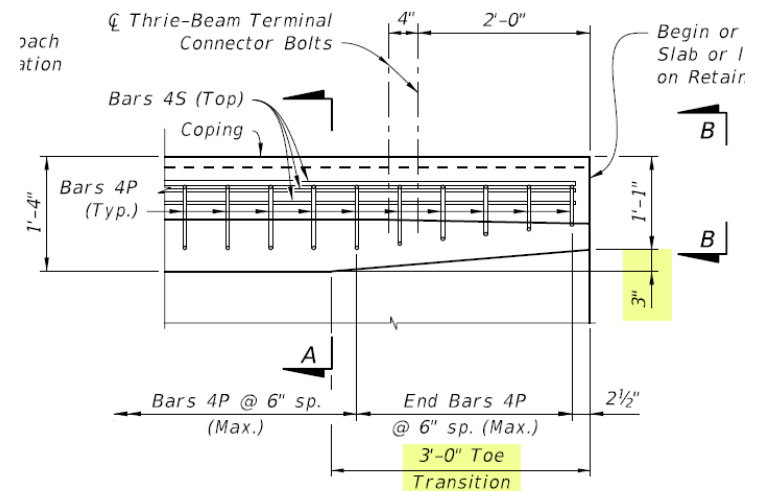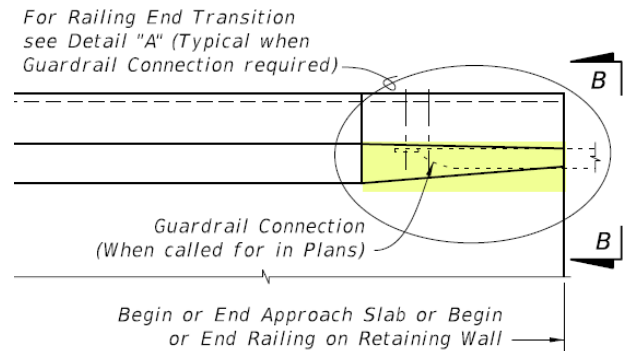

PLAN - RAILING END TRANSITION


## Height Transitions (Bridge to Roadway)

- **Index 521-427 & 521-428: Single-Slope Traffic Railings**
  - Added Height Transition from 36" Single-Slope to 38" Single-Slope
  - Changed reinforcing details for:
    - ✓ Consistency
    - ✓ Accommodate more conduits

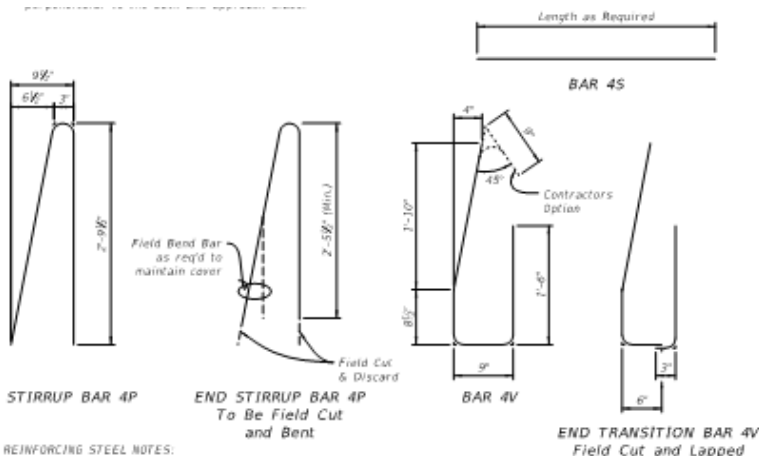

**REINFORCING STEEL NOTES:**

1. All bar dimensions in the bending diagrams are cut to cut.
2. The 8 1/2" vertical dimension shown for Bar 4V is based on a 6" embedment into the bridge deck without a raised sidewalk. If a raised sidewalk is to be provided, increase this dimension to achieve a 6" minimum embedment into the bridge deck. See Structures Plans, Superstructure and Approach Slab Sheets.
3. All reinforcing steel at the open joints shall have a 2" minimum cover.
4. Bars 4S may be continuous or spliced at the construction joints. Bar splices for Bars 4S shall be a minimum of 2'-0".

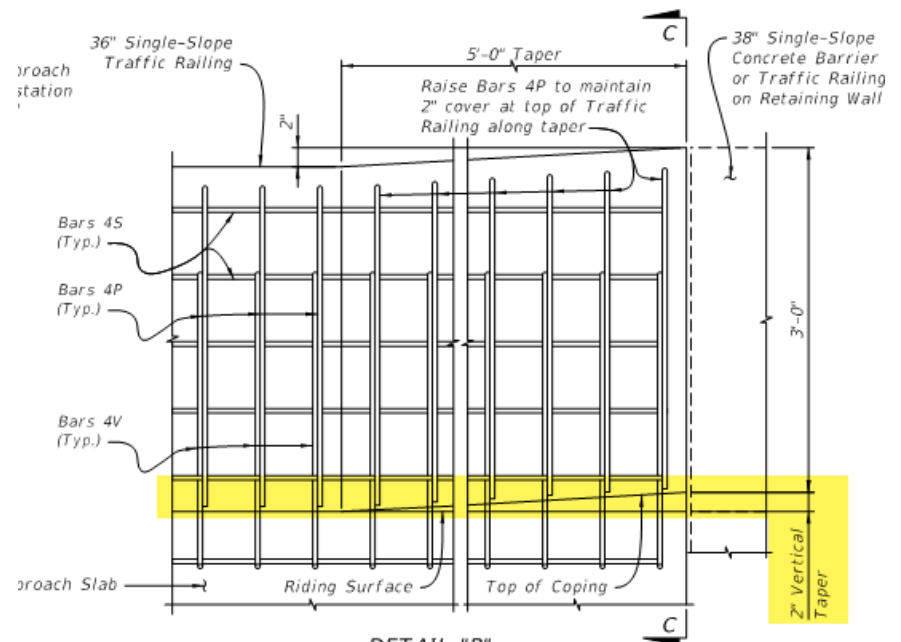



**DETAIL "B"**  
**ELEVATION - RAILING HEIGHT TRANSITION**  
 (Showing Transition to 38" Single-Slope Traffic Railing or Barrier)

## Conduit

### Index 630-010 Conduit Details

#### - Embedded:

- Payment is no longer included in the cost of the traffic railing or parapet.
  - Change made in **Specification Section 630**
  - New Pay Item Number in **BOE**
  - Revised notes and added pay item to Instructions (**SPI**)
- Added third row of conduit for traffic railings, traffic railing/noise walls and concrete parapets.

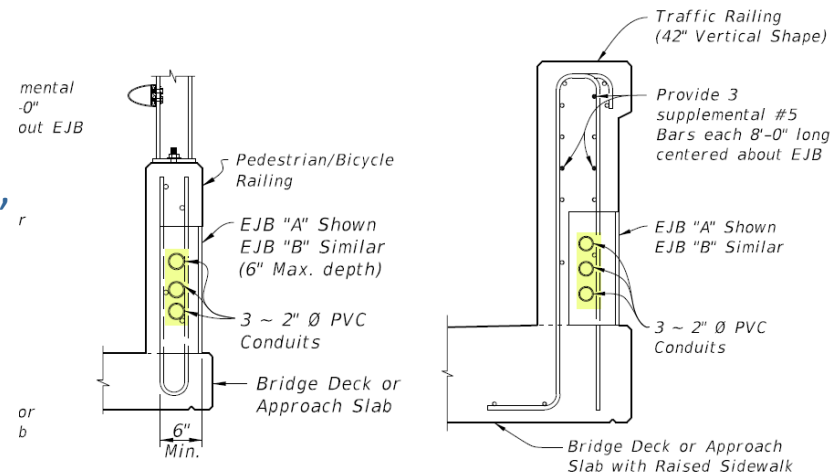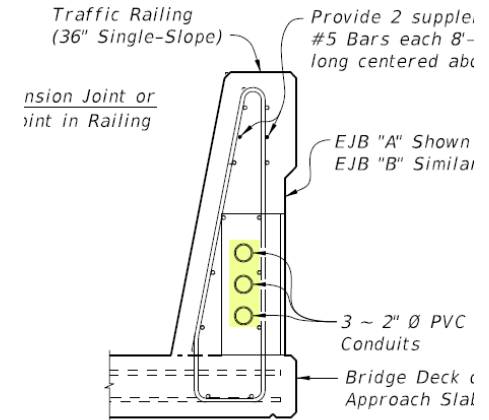




## Standard Plan Instructions (SPI)

- **Added Pay Item for Conduit Embedded (and Junction Boxes in Concrete to all applicable Indexes**



- ✓ Pay Item: 630-2-16 Conduit, Furnish & Install (Embedded – Railings)
- ✓ Include pay item and quantities for traffic railings or concrete parapets on bridges/approach slabs.


- **Added instructions for traffic railings on concrete box culverts (See Index 400-289 and “Box Culvert Data Table” Cell)**

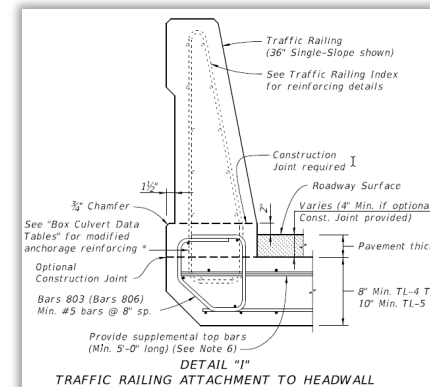

- **Added details/clarification in the Design Assumptions and Limitations about sidewalk transitions and optional base to Index 400-090 & 400-091 Approach Slabs**

In the Roadway Plans:

Include details and payment for the optional base under the approach slab. The minimum structural requirement under the approach slab is Optional Base Group 2. If the optional base group for the roadway approaches is Group 2 or better, the same base group may be continued under the approach slab. **Include embankment and optional base for the area of the approach slab in the roadway quantities.**

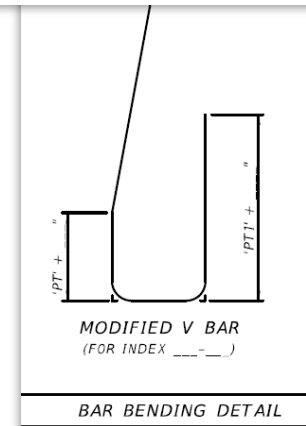




## Updates on other *Developmental Standards* in the works:


- **Index D20700 series** – [Precast Intermediate Bent Cap](#);
- **Index D30000 series** – Off-System Bridge Packages (Superstructure):
  - 4 span lengths - 30', 40', 50' (done) and 60' (pending TBA);
  - 5 bridge clear widths – 15', 24', 28, 32' and 40';



Join us June 18-20<sup>th</sup> for “FITS” (Expo) in Orlando !!

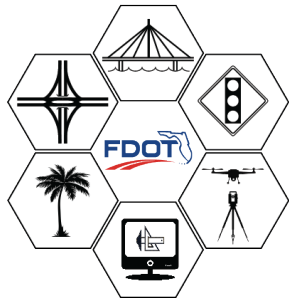


**FLORIDA**  
innovative  
TRANSPORTATION  
**SYMPOSIUM**

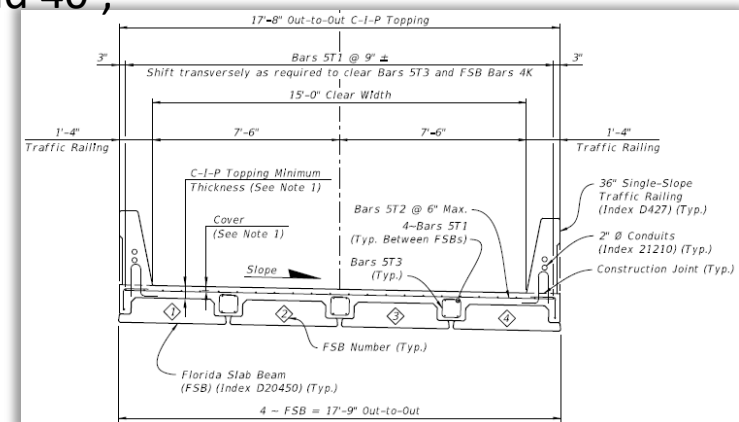

## *Message from the Design Technology Section (Structures Standards & Computer Applications)*

We are here to assist you with your questions and concerns. Please contact us:

- If you have a suggestion:
  - for a new standard or
  - for an improvement to
  - an existing standard.
- If you have any issues during design or construction:
  - Fully explain the issue (photos help);
  - Provide suggestions (if you have any);
  - Provide any documentation that might support a proposed change and assist us during development.
- Anytime you have questions or concerns (*but, we recommend always thoroughly reviewing the **SPI** first*).

 



## Contact Information:

**Steve Nolan, P.E.**

**State Structures Design Office**

**[Steven.nolan@dot.state.fl.us](mailto:Steven.nolan@dot.state.fl.us)**

**(850) 414-4272**