

DRAFT  
UTILITY ASSESSMENT PACKAGE

Florida Department of Transportation

District 4

SR 5/ US 1 at Aviation Boulevard

Indian River, Florida

Financial Management Number: 441693-1-22-02

ETDM Number: 14475

March 2024

The environmental review, consultation and other actions required by applicable federal environmental laws for this project are being, or have been, carried out by FDOT pursuant to 23 U.S.C. § 327 and a Memorandum of Understanding dated May 26, 2022, and executed by the Federal Highway Administration (FHWA) and FDOT

---



# Final Utility Assessment Package

**SR-5/US-1 at Aviation Boulevard, Indian River County, Florida**

FPID Number: 441693-1-22-02

**Prepared for:**

Florida Department of Transportation  
3400 West Commercial Boulevard  
Fort Lauderdale, FL 33309

**Submitted by:**

WGI Inc.  
2035 Vista Parkway  
West Palm Beach, FL 33411

**Prepared by:**

WGI Inc.  
2035 Vista Parkway  
West Palm Beach, FL 33411

Date: March 18, 2024

# Contents

<b>Contents</b> .....	<b>i</b>
<b>Acronyms and Abbreviations</b> .....	<b>ii</b>
<b>1. Introduction</b> .....	<b>1</b>
1.1 Project Background and Description.....	1
1.2 Proposed Build Alternatives.....	2
<b>2. Purpose</b> .....	<b>2</b>
<b>3. Methodology</b> .....	<b>3</b>
<b>4. Utility Agency Owners</b> .....	<b>3</b>
<b>5. Utility Description</b> .....	<b>5</b>
<b>6. Build Impacts</b> .....	<b>8</b>
<b>7. Cost Estimates</b> .....	<b>8</b>
<b>8. Mitigation Recommendations</b> .....	<b>13</b>

## Tables

1	Utility Contact List from Sunshine 811 Ticket.....	4
2	Utility Impacts from Proposed Build by Location.....	8

## Figures

1	Project Location Map.....	1
---	---------------------------	---

## Appendices

- A Preferred Alternative Concept Plans
- B Sample UAO Contact Letter
- C Utility Contact Plans
- D Utility Agency Owner Responses

# Acronyms and Abbreviations

BT	Buried Telephone
CATV	Cable Television
CR	County Road
ETDM	Efficient Transportation Decision-Making
F.A.C.	Florida Administrative Code
FDOT	Florida Department of Transportation
FOC	Fiber Optic Cable
FM	Force Main
FPID	Financial Project Identification
FTE	Florida's Turnpike Enterprise
No.	Number
ROW	Right-of-Way
OE	Overhead Electric
OFOC	Overhead Fiber Optic Cable
OT	Overhead Telephone
PD&E	Project Development and Environment
SEIR	State Environmental Impact Report
SR	State Route
UAM	Utility Accommodation Manual
UAO	Utility Agency Owner
UWE	Utility Work Estimate
UWHCA	Utility Work by Highway Contractor Agreement
WM	Water Main

# Introduction

## 1.1 Project Background and Description

The Florida Department of Transportation (FDOT) is conducting the SR-5/US-1 at Aviation Boulevard Project Development and Environment (PD&E) Study to evaluate potential capacity and operational improvements to the intersection of SR 5/US-1 and Aviation Boulevard/32nd Street, Indian River County, Florida. The existing roadway (Aviation Boulevard) connects to US-1 with two eastbound lanes and one westbound lane. The existing intersection has railroad crossing signals, traffic control signals, and pedestrian crossings. The west of the railroad crossing is property under the control of the Vero Beach Regional Airport. The airport has regulations that control construction for both ground (Runway Protection Zone) and aerial (Flight Surface) zones. Figure 1 shows the project location.

Figure1. Project Location Map



The project aims to improve the intersection of SR 5/US 1 and Aviation Boulevard in Vero Beach, Florida. The proposed improvements included in the SR 5/US 1 at Aviation Boulevard project are to expand Aviation Boulevard and the existing railroad grade crossing to provide four eastbound lanes (1 right, 1 through, 2 lefts), a median separator, and two westbound through lanes. A shared-use path would be along the south side of Aviation Blvd and US-1 would be expanded to provide northbound dual left turns and southbound dual right turns. The project will include Roadway, Drainage, Signalization, and Lighting Design.

The primary purpose of the project is to evaluate intersection improvement solutions to address existing and projected traffic demands, improve safety, support economic growth, and enhance modal interrelationships with rail, bicycle, and pedestrian modes.

## 1.2 Proposed Build Alternative

As a result of the alternative analyses conducted for the project, a Preferred Alternative was identified for further analysis. The Preferred Alternative includes the recommended interchange /intersection concept and the overall SR 5/Aviation Boulevard corridor typical section and alignment. Appendix A provides the preliminary concept plans for the Preferred Alternative.

The Preferred Alternative for the project includes the following proposed improvements:

- Expanding the intersection of SR 5/US 1 at Aviation Boulevard to provide four eastbound lanes (1 right, 1 through, 2 lefts), a median separator, and two westbound through lanes to improve traffic flow.
- Milling and Resurfacing of Side Streets
- Swale Regarding
- Installation of sidewalks
- Drainage improvements
- Reconfiguration of the Traffic Signals
- Lighting Improvements
- New Signing and Pavement Markings

## Purpose

A utility, as defined in FDOT's Utility Accommodation Manual (UAM), is all active, deactivated, or out-of-service electric transmission lines, telephone lines, telegraph lines, other communication services lines, pole lines, ditches, sewers, water mains, heat mains, gas mains, pipelines, gasoline tanks, and pumps owned by the Utility Agency Owner (UAO). Conflicts with utilities affect both the cost and schedule of a project and can influence the selection of the preferred alternative. FDOT must consider the potential for encountering utilities within the limits of the project, including associated pond sites and other off-site improvements. This Utility Assessment Package includes the identification of Utilities within the project area. The information can be used to avoid major utility conflicts and in choosing corridors or alternatives to carry forward. The goal of this effort is to assist with the development of project plans that avoid conflicts with major utility facilities. While it is important to determine all utility facilities within the study

limits, the focus is to identify the utility facilities that could: (a) entail lengthy or drawn-out coordination efforts, (b) may be cost-prohibitive to relocate, or (c) rise beyond the level of ordinary utility coordination.

## Methodology

The process to discover utilities during the phase consists of three stages: UAO Coordination; and Utility Assessment Package.

The PD&E Request Package consists of the concept plans overlaid on an aerial background. A request is made for each UAO to provide information for above-ground and below-ground utility facilities within the PD&E project area, for both existing and planned utility facilities. Also included is a request for each UAO to provide information pertaining to any existing easements or other property interests that may be affected by the project. The contacted UAOs are requested to review the concept plans and identify their major utility facilities and other obstructions or encroachments within or adjacent to the project. Each UAO was to identify both existing and planned utility installations in, or adjacent to, the project limits. The UAOs are requested to respond in writing and delineate their facilities and any property interests on the concept plans, in accordance with Chapter 14-46, Florida Administrative Code (F.A.C.) and the Utility Accommodation Manual (UAM).

The Utility Coordination stage includes meetings with the UAOs to discuss utility impacts related to the project alternatives. The meetings included discussions for timelines for new installations or relocations that are anticipated to be unavoidable, potential relocation costs, and any easements or property interests that could be affected. The information provided by the UAOs was used in preparing the Utility Assessment Package.

## Utility Agency Owners

The existing and proposed utility facilities within the study area were identified throughout the project corridor as part of this PD&E Study. A list of the existing Utility Agencies Owners (UAOs) was obtained by contacting Sunshine 811. A field review was also conducted to further identify any designated existing facilities in the project corridor. All the UAOs identified in the field were also noted on the Sunshine 811 list. The existing UAOs, the identified UAO contacts, and the facility type are summarized in Table 1.

Preliminary utility coordination was initiated through written communication to the listed utility contacts. The UAOs were informed of the PD&E study through notification letters and were requested to provide information regarding the location, type, dimension, and characteristics of any major utilities along or crossing the existing right-of-way. UAOs were requested to note if any utility facility is located within the FDOT right-of-way by easement or permit and to provide an order-of-magnitude worst-case estimate for the cost of relocating any utilities affected by the proposed project. The information obtained from the UAOs is documented in this technical memorandum.

**TABLE 1: UTILITY CONTACT LIST FROM SUNSHINE 811**

Utility Agency Owner	Contact	Utility Type	Comments
AT&T Florida 7747 Ellis Rd, W Melbourne, FL 32904	Mark Linscott 321-388-9376 <a href="mailto:ml9322@att.com">ml9322@att.com</a>	Telephone	Index Maps provided
AT&T Transmission 6000 Metro West Blvd Ste 201 Orlando, FL. 32835-7631	Kenneth Wagner 407-578-8000 <a href="mailto:swagner@pea-inc.com">swagner@pea-inc.com</a>	Communication Lines, Fiber	Marked plans provided
City of Vero Beach 17-17th Street PO Box 1389 Vero Beach, Florida 32961- 1389	Todd Young 772-978-5209 <a href="mailto:TYoung@covb.org">TYoung@covb.org</a>	Water, Wastewater	Marked plans and CADD provided
Comcast 1401 Northpoint Pkwy, West Palm Beach, FL 33407	Timothy Henes 561-325-2963 <a href="mailto:Timothy_Henes@comcast.com">Timothy_Henes@comcast.com</a>	CATV	Marked plans provided
Crown Castle 1601 NW 136 Avenue, Suite A-200 Sunrise, FL 33323	Danny Haskett 786-246-7827 <a href="mailto:danny.haskett@crowncastle.com">danny.haskett@crowncastle.com</a>	Fiber	Utility Maps provided
Florida City Gas/NextEra 4045 NW 97th Ave. Doral, FL. 33178	Elio A. Bustos, P.E. 786-481-9307 <a href="mailto:EBustosCaba@chpk.com">EBustosCaba@chpk.com</a>	Gas	Marked plans provided
FP&L Distribution 4406 SW Cargo Way Palm City, FL 34990	Rob Morris 772-223-4215 <a href="mailto:rob.morris@fpl.com">rob.morris@fpl.com</a>	Electric	Marked plans provided
FP&L Transmission 15430 Endeavor Dr, Jupiter, FL 33478	Martin Mikhail 561-993-6825 <a href="mailto:Martin.Mikhail@fpl.com">Martin.Mikhail@fpl.com</a>	Electric	Marked plans provided
Indian River County Utilities 1801 27th Street – Building A, Vero Beach, FL 32960	Harrison Youngblood 772-226-4343 <a href="mailto:hyoungblood@ircgov.com">hyoungblood@ircgov.com</a>	Sewer, Water	GIS Maps provided
Lumen (CenturyLink) National 7003 Presidents Dr. Suite 100, Orlando, FL 32809	Michael Hunt 716-480-2073 <a href="mailto:michael.hunt@lumen.com">michael.hunt@lumen.com</a>	Fiber	Utility Maps provided
Resurgence Infrastructure Group 608 Huck Finn Dr. Crestview, FL 32536	Laura Glass 850-826-0846 <a href="mailto:laura.glass@glass811.com">laura.glass@glass811.com</a>	Fiber	Marked plans provided



Sprint 360 S. Lake Destiny Dr., Ste. A Orlando, FL 32810	Jon Baker 352-409-5095 <a href="mailto:jabaker@cogentco.com">jabaker@cogentco.com</a>	Fiber	Email
Verizon 4700 Exchange Ct. Boca Raton, FL 33431	Donovan Carr 954-213-1959 <a href="mailto:donovan.carr@verizon.com">donovan.carr@verizon.com</a>	Communication Lines, Fiber	Marked plans provided

## Utility Description

The existing utility facilities include power, gas, water, wastewater, and communications. A preliminary plan set with the aerial background was sent to all identified UAOs within the project area. The plan set was provided for their use in documenting their facilities. Information received from the various UAOs can be found in the Appendix.

Based on the initial utility coordination effort, no proposed utility facilities were identified within the existing or proposed right-of-way. The general location of the existing utility facilities described below is based on the Utility Agency Owners' response and their accompanied documents. The exact locations of the existing utilities and the extent of impacts will be determined during the design phase of this project. Coordination with the UAOs during the design phase will assist in minimizing relocation adjustments and disruptions of service to the public.

Provided below is a summary of the existing facilities within the project corridor. All stations provided are approximate.

**AT&T Florida** owns the following facilities within the project's study area.

- (2) 1800PR Direct Buried Copper Cables west side of SR 5, running south from the ending of the project and turning east along the north side of 33rd St.
- 1800PR Direct Buried Copper Cable west side of SR 5, running south from 33rd St. and turning east along the north side of 31st St.
- Direct Buried Copper Cable on the west side of SR 5, running north-south along the entire project limit.
- 1800PR Direct Buried Copper Cable west side of SR 5, running south from approximately 100' north of 31st St. and turning east along the north side of 31st St.
- 200PR Buried Copper Cable in 1-4" PVC Conduit crossing SR 5 just south of 31st St.
- Overhead Telephone on the east side of SR 5, running north from 31st St. to the ending project limit.

**AT&T Transmission** owns the following facilities within the project's study area.

- 1-2" BFOC HDPE Duct within the FEC Railroad right of way, running north-south along the entire project limits.

**The City of Vero Beach** owns the following facilities within the project's study area.

- 8" CIP Water Main on the east side of SR 5, running north from the beginning of the project to a Gate Valve south of the Main Canal Bridge.

- 12" CIP Water Main on the east side of SR 5, running north from a Gate Valve south of the Main Canal Bridge to a Gate Valve south of 30<sup>th</sup> St.
- 8" CIP Water Main east side of SR 5, running north from Gate Valve south of 30<sup>th</sup> St. past project limits.
- 8" DIP Water Main east side of SR 5, running east along the south side of 30<sup>th</sup> St.
- 16" DIP Water Main crossing SR 5 at the north side of the Main Canal Bridge, running west from a Gate Valve on the east of SR 5 to a Gate Valve outside the right of way.
- 12" DIP Sanitary Force Main crossing SR 5 within a 20" Steel Casing, running west from 30<sup>th</sup> St. to the outside of the right of way.
- 16" PVC Water Main crossing SR 5 within a 30" Steel Casing, running west from 13<sup>th</sup> Ave, along 31<sup>st</sup> St. to the outside of the right of way.
- 8" V.C.P Sanitary Sewer Main Along 31<sup>st</sup> St., running 375' west from a Manhole on 13<sup>th</sup> Ave to another Manhole on 31<sup>st</sup> St.
- 8" V.C.P Sewer Laterals along 31<sup>st</sup> St. running between 13<sup>th</sup> Ave and SR 5.
- 16" PVC Re-Use Water Main along 31<sup>st</sup> St. running from 13<sup>th</sup> Ave to SR 5.
- 2" PE Water Laterals along 31<sup>st</sup> St. running between 13<sup>th</sup> Ave and SR 5
- 2.5" PVC Water Main along 32<sup>nd</sup> St. running from 13<sup>th</sup> Ave to SR 5.
- 1" PE Water Laterals along 32<sup>nd</sup> St. running between 13<sup>th</sup> Ave and SR 5.
- 2.5" PVC Water Laterals Casing along 32<sup>nd</sup> St. running between 13<sup>th</sup> Ave and SR 5.
- 8" V.C.P Sanitary Sewer Main along 32<sup>nd</sup> St. running between 13<sup>th</sup> Ave and SR 5.
- 8" V.C.P Sewer Laterals along 32<sup>nd</sup> St. running between 13<sup>th</sup> Ave and SR 5.
- 24" PVC Effluent Transmission Force Main crossing SR5 within a 42" Steel Casing, running east from the western right-of-way line to 13<sup>th</sup> Ave through 33<sup>rd</sup> St.
- 8" V.C.P Sanitary Sewer Main along 33<sup>rd</sup> St., running 475' west from a Manhole on 13<sup>th</sup> Ave to another Manhole on 33<sup>rd</sup> St.
- 8" V.C.P Sewer Laterals along 33<sup>rd</sup> St. running between 13<sup>th</sup> Ave and SR 5.
- 6" PVC Water Main along 33<sup>rd</sup> St. running between 13<sup>th</sup> Ave and SR 5.
- 1" PE Water Laterals along 33<sup>rd</sup> St. running between 13<sup>th</sup> Ave and SR 5.
- 2.5" PVC Water Laterals Casing along 33<sup>rd</sup> St. running between 13<sup>th</sup> Ave and SR 5.
- 14" DIP Water Main Crossing Aviation Blvd west of the FEC Railroad right of way, running from right of way to right of way.
- Water Meters on the east side of SR 5, between the beginning and ending project limits, and along 31<sup>st</sup> St., 32<sup>nd</sup> St., and 33<sup>rd</sup> St.
- Water Valves on the east side of SR 5, between the beginning and ending project limits.
- Sanitary Air Release Valves along 30<sup>th</sup> and 33<sup>rd</sup> St.
- Water Main Air Release Valve along 31<sup>st</sup> St.
- Sanitary Sewer Manholes along 32<sup>nd</sup> and 33<sup>rd</sup> St.
- Fire Hydrants on the east side of SR 5, between the beginning and ending project limits.

**Comcast** owns the following facilities within the project's study area.

- Overhead Cable TV on the east side of SR 5, running north from a pole south of 31<sup>st</sup> St., turning east and running on the northside 31<sup>st</sup> St.
- Overhead cable TV on the east side of SR 5, running north from a pole north of 32<sup>nd</sup> St. past project limits.
- Overhead cable TV on the east side of SR 5, running east from a pole at the north side of 33<sup>rd</sup> St. to 13<sup>th</sup> Ave.

**Crown Castle** owns the following facilities within the project's study area.

- 288 Count Buried FOC on the east side of SR 5, running north-south along the entire project limits.

**Florida City Gas/NextEra** owns the following facilities within the project's study area.

- 6" PE Gas Main on the east side of SR 5, running south from the end of the project and turns east on the north side of 32nd St. for approximately 50 ft to a Gas Valve. It runs west from the Valve across SR 5 and continues on the north side of Aviation Blvd past project limits.

**FP&L Distribution** owns the following facilities within the project's study area.

- 120V Overhead Electric crossing SR 5 north of 30<sup>th</sup> St., running from a pole on the west side of SR 5 to a pole on the east side of SR 5.
- 2 Phase 13KV Overhead Electric on the east side of SR 5, running from a pole north of 30<sup>th</sup> St. to a pole on the north side of 33<sup>rd</sup> St.
- 3 Phase 13KV Overhead Electric on the east side of SR 5, running north from a pole on the north side of 33<sup>rd</sup> St. past project limits.
- 3 Phase 13KV Overhead Electric crossing SR 5., running east from beyond the western right-of-way line to 13<sup>th</sup> Ave to 13<sup>th</sup> Ave along the north side of 33<sup>rd</sup> St., turning south on the west side of 13<sup>th</sup> Ave. and running past project limits.
- 3 Phase 13KV Overhead Electric Crossing Aviation Blvd just west of the FEC Railroad right of way.
- 3 Phase 13KV Buried Electric Crossing Aviation Blvd just west of the FEC Railroad right of way.

**FP&L Transmission** owns no facilities within the project's study area.

- No facilities

**Indian River County Utilities** owns no facilities within the project's study area.

- No facilities

**Lumen (CenturyLink) National** owns the following facilities within the project's study area.

- 3-2" HDPE Duct within the FEC Railroad right of way, running north-south along the entire project limits.

**Resurgence Infrastructure Group** owns the following facilities within the project's study area.

- 528 Count fiber in 1-1.5" HDPE Duct within the FEC Railroad right of way west of SR 5, running north-south along the entire project limits.

**Sprint** owns the following facilities within the project's study area.

- 96 Count fiber in 1-2" HDPE Duct within the FEC Railroad right of way, running north-south along the entire project limits.

**Verizon** owns the following facilities within the project's study area.

- 12 and 24 Count fiber in 1-2" HDPE Duct within the FEC Railroad right of way, running north-south along the entire project limits.
- 96 Count fiber in 1-2" HDPE Duct within the FEC Railroad right of way, running north-south along the entire project limits.

# Build Impacts

The estimated impacts to utility facilities resulting from the recommended Build alternative are itemized by location in Table 2, along with estimated relocation costs. It should be noted that no cross-section information has been provided at this time. The estimated impacts are based on the data provided by the UAO as previously summarized. Actual utility impacts will be verified during the design phase when a detailed survey and subsurface utility information are available.

It is anticipated the municipal water and sewer providers (City of Vero Beach) may request a Utility Work by Highway Contractor Agreement (UWHCA), as demonstrated on past projects of similar scope, dependent on the magnitude of impact to their facilities.

# Cost Estimates

Conservative utility relocation estimates based on the Preferred Alternative were requested as part of the utility coordination process and subsequent follow-up with the Utility Agency Owners. The total combined estimated cost for relocations, regardless of the UAO’s potential for reimbursement, is \$3,320,325.73.

**TABLE 2: UTILITY IMPACTS FROM PROPOSED BUILD BY LOCATION**

Utility Type	Transverse or Adjacent	General Location	Size	Approx. Conflict Length	Impacts	Cost Estimate
<b>AT&amp;T FLORIDA</b>						
(2) BT	Adjacent	West side of SR 5, running south from the end of the project and turning east along the north side of 33 <sup>rd</sup> St.	1800PR Copper	930'	Roadway construction SR 5	\$110,500.00
BT	Adjacent	West side of SR 5, running south from 33 <sup>rd</sup> St. and turning east along the north side of 31 <sup>st</sup> St.	1800PR Copper	910'	Roadway construction SR 5	\$54,750.00
BT	Adjacent	West side of SR 5, running north-south along the entire project limits.	1800PR Copper	2780'	Roadway construction SR 5	\$101,500.00
(2) BT	Adjacent	West side of SR 5, running south from approximately 100' north of 31 <sup>st</sup> St. and turning east along the north side of 31 <sup>st</sup> St.	1800PR Copper	270'	Roadway construction SR 5	\$77,500.00
BT, 1-4" PVC Conduit	Transverse	Crossing SR 5 just south of 31 <sup>st</sup> St.	200PR in 4" PVC Conduit	155'	Roadway construction SR 5	\$131,875.00
OT	Adjacent	East side of SR 5, running north from 31 <sup>st</sup> St. to the ending project limit.	1800PR Copper	1620'	Roadway construction SR 5	\$48,200.00
<b>AT&amp;T TRANSMISSION</b>						
BFOC	Transverse	Within the FECRR ROW, crossing Aviation Blvd.	1-2" HDPE	110'	Roadway construction intersection of SR 5 and Aviation Blvd.	\$20,001.12

Utility Type	Transverse or Adjacent	General Location	Size	Approx. Conflict Length	Impacts	Cost Estimate
<b>CITY OF VERO BEACH</b>						
WM	Adjacent	East side of SR 5, running north from the beginning of the project to south of the Main Canal Bridge to a Gate Valve.	8" CIP	170'	Roadway construction SR 5	\$60,644.20
WM	Adjacent	East side of SR 5, running north from a Gate Valve just south of the Main Canal Bridge to a Gate Valve south of 30th St.	12" CIP	190'	Roadway /Bridge construction SR 5	\$80,698.98
WM	Adjacent	East side of SR 5, running north from a Gate Valve south of 30th St. past project limits.	8" CIP	2420'	Roadway construction SR 5	\$798,120.40
WM	Transverse	East side of SR 5, running east along the south side of 30 <sup>th</sup> St.	8" DIP	80'	Roadway construction SR 5	\$31,358.20
WM	Transverse	Crossing SR 5 at the north side of the Main Canal Bridge running west from the Gate Valve on the east of SR 5 to a Gate Valve outside the ROW.	16 DIP	245'	Roadway/ Bridge construction SR 5	\$61,246.00
FM	Transverse	Crossing SR 5, running west from 30 <sup>th</sup> St. to the outside of the right of way.	12" DIP	390'	Roadway construction SR 5	\$54,117.08
Casing	Transverse	Crossing SR 5, running west from 30 <sup>th</sup> St. to the outside of the ROW.	20" Steel	180'	Roadway construction SR 5	\$43,120.80
WM	Transverse	Crossing SR5, running west from 13 <sup>th</sup> Ave, along 31 <sup>st</sup> St. to the outside of the ROW.	16" PVC	250'	Roadway construction SR 5	\$55,056.00
Casing	Transverse	Crossing SR 5, running west from 31 <sup>st</sup> St. to the outside of the ROW.	30" Steel	200'	Roadway construction SR 5	\$102,502.00
Sanitary Sewer Main	Adjacent	Along 31 <sup>st</sup> St., running 375' west from a Manhole on 13 <sup>th</sup> Ave to another Manhole on 31 <sup>st</sup> St.	8" V.C.P	375'	Roadway construction 31 <sup>st</sup> St.	\$17,468.75
Sewer laterals	Transverse	Along 31 <sup>st</sup> St. running between 13 <sup>th</sup> Ave and SR 5.	(8) 8" V.C.P	120"	Roadway construction 31 <sup>st</sup> St.	\$7,358.00
Reuse WM	Adjacent	Along 31 <sup>st</sup> St. running from 13 <sup>th</sup> Ave to SR 5.	16" PVC	425"	Roadway construction 31 <sup>st</sup> St.	\$87,081.00
Water laterals	Transverse	Along 31 <sup>st</sup> St. running between 13 <sup>th</sup> Ave and SR 5	2" PE	22'	Roadway construction 31 <sup>st</sup> St.	\$496.32
WM	Adjacent	Along 32 <sup>nd</sup> St. running from 13 <sup>th</sup> Ave to SR 5.	2.5 PVC	594'	Roadway construction 32 <sup>nd</sup> St.	\$13,994.64
Water Laterals	Transverse	Along 32 <sup>nd</sup> St. running between 13 <sup>th</sup> Ave and SR 5.	(10)1" PE	224'	Roadway construction 32 <sup>nd</sup> St.	\$10,447.36
Water Laterals Casing	Transverse	Along 32 <sup>nd</sup> St. running between 13 <sup>th</sup> Ave and SR 5.	(3)2.5" PVC	60'	Roadway construction 32 <sup>nd</sup> St.	\$1,413.60
Sanitary Sewer Main	Adjacent	Along 32 <sup>nd</sup> St. running between 13 <sup>th</sup> Ave and SR 5.	8" V.C.P	200'	Roadway construction 32 <sup>nd</sup> St.	\$10,530.00

Utility Type	Transverse or Adjacent	General Location	Size	Approx. Conflict Length	Impacts	Cost Estimate
<b>CITY OF VERO BEACH</b>						
Sewer laterals	Transverse	Along 32 <sup>nd</sup> St. running between 13 <sup>th</sup> Ave and SR 5.	(10)8" V.C.P	150"	Roadway construction 32 <sup>nd</sup> St.	\$8,547.50
Effluent Transmission Force Main	Transverse	Crossing SR 5, running east from the western ROW line to 13 <sup>th</sup> Ave through 33 <sup>rd</sup> St.	24" PVC	900'	Roadway construction SR 5/33 <sup>rd</sup> St.	\$203,924.78
Casing	Transverse	Crossing SR 5 and FECRR ROW at 33 <sup>rd</sup> St.	42" Steel	240'	Roadway construction SR 5	\$132,000.00
Sanitary Sewer Main	Adjacent	Along 33 <sup>rd</sup> St., running 475' west from a Manhole on 13 <sup>th</sup> Ave to another Manhole on 33 <sup>rd</sup> St.	8" V.C.P	475'	Roadway construction 33 <sup>rd</sup> St.	\$21,433.75
Sewer laterals	Transverse	Along 33 <sup>rd</sup> St. running between 13 <sup>th</sup> Ave and SR 5.	(11)8" V.C.P	165"	Roadway construction 33 <sup>rd</sup> St	\$9,142.25
WM	Adjacent	Along 33 <sup>rd</sup> St. running between 13 <sup>th</sup> Ave and SR 5.	6" PVC	686"	Roadway construction 33 <sup>rd</sup> St	\$91,265.44
Water Laterals	Transverse	Along 33 <sup>rd</sup> St. running between 13 <sup>th</sup> Ave and SR 5.	(11)1" PE	441'	Roadway construction 33 <sup>rd</sup> St.	\$20,568.24
Water Laterals Casing	Transverse	Along 33 <sup>rd</sup> St. running between 13 <sup>th</sup> Ave and SR 5.	(6)2.5" PVC	120'	Roadway construction 33 <sup>rd</sup> St.	\$2,827.20
Water Main	Transverse	Crossing Aviation Blvd west of the FECRR ROW running from right of way to right of way	14" DIP	92'	Roadway Construction Aviation Blvd.	\$18,439.60
Water / Sewer Valve	Adjacent	East side of SR 5, between the beginning and ending project limits	8" CIP, 12" PVC, 12" CIP, 2" GIP, 2" HDPE	16 each	Roadway construction SR 5	\$70,193.04
Water Meter	Adjacent	East side of SR 5, between the beginning and ending project limits	1" GIP, 2" GIP, 2" HDPE	5 each	Roadway construction SR 5	\$3,620.00
Water Main Air Release Valve	Adjacent	East side of SR 5 at the north side of 31 <sup>st</sup> St.	16" PVC	1 each	Roadway construction SR 5	\$22,081.86
Water Meter	Transverse	East side of SR 5 along 31 <sup>st</sup> St.	1" PE	2 each	Roadway construction 31 <sup>st</sup> St.	\$1,448.00
Sanitary Sewer Manhole	Adjacent	East side of SR 5 at Sta. at 32 <sup>nd</sup> St.	8" V.C.P	3 each	Roadway construction SR 5	\$5,805.45
Water Meter	Transverse	East side of SR 5 along 32 <sup>nd</sup> St.	1" PE	12 each	Roadway construction 31 <sup>st</sup> St.	\$8,688.00
Sanitary Sewer Manhole	Transverse	East side of SR 5 along 33 <sup>rd</sup> St.	8" V.C.P	3 each	Roadway construction 33 <sup>rd</sup> St.	\$5,805.45
Water Meter	Transverse	East side of SR 5 along 33 <sup>rd</sup> St.	1" PE	14 each	Roadway construction 31 <sup>st</sup> St.	\$10,136.00
Fire Hydrant	Adjacent	East side of SR 5, between the beginning and ending project limits		4 each	Roadway construction SR 5	\$31,387.48

Utility Type	Transverse or Adjacent	General Location	Size	Approx. Conflict Length	Impacts	Cost Estimate
<b>COMCAST</b>						
OFOC	Adjacent	East side of SR 5, running north from pole to pole for approximately 200' north of 30 <sup>th</sup> St.		200'	Roadway construction SR 5	\$31,739.84
OFOC	Adjacent	East side of SR 5, running east from a pole at 31 <sup>st</sup> St. past project limits along the north side of 31 <sup>st</sup> St.		90'	Roadway construction SR 5	\$31,260.24
OFOC	Adjacent	East side of SR 5, running north from a pole at 32 <sup>nd</sup> St. passing project limit		1600'	Roadway construction SR 5	\$37,843.84
OFOC	Adjacent	East side of SR 5, running east from a pole at 33 <sup>rd</sup> St. past project limits along the north side of 33 <sup>rd</sup> St.		135'	Roadway construction SR	\$31,456.44
<b>CROWN CASTLE</b>						
BFOC	Adjacent	East side of SR 5, running north-south along the entire project limits.	288 Count Fiber	2,780'	Roadway and Bridge Construction SR 5	\$136,842.24
Pull Box #205198	Adjacent	East side of SR 5, approximately 580' north of 33 <sup>rd</sup> St.		1 each	Roadway construction SR 5	\$1,849.13
Pull Box #205201	Adjacent	East side of SR 5, approximately 200' south of 32 <sup>nd</sup> St.		1 each	Roadway construction SR 5	\$1,849.13
Pull Box #280778	Adjacent	East side of SR 5, approximately 50' south of 30 <sup>th</sup> St.		1 each	Roadway construction SR 5	\$1,849.13
Pull Box #208777	Adjacent	East side of SR 5 approximately 240' south of 30 <sup>th</sup> St.		1 each	Roadway construction SR 5	\$1,849.13
Pull Box #205204	Adjacent	East side of SR 5, approximately 130' south of 29 <sup>th</sup> St.		1 each	Roadway construction SR 5	\$1,849.13
<b>FLORIDA CITY GAS/ NEXTERA</b>						
Gas Main	Adjacent	East side of SR 5, running south from the end of the project to 32 <sup>nd</sup> St. and turning east on the north side of 32 <sup>nd</sup> St. for approximately 50 ft to a Gas Valve.	6" PE	1320'	Roadway construction SR 5	\$67,232.00
Gas Main	Transverse	Crossing SR 5, running west from a Gas Valve on the north side of 32 <sup>nd</sup> St. to the north side of Aviation Blvd going past the project limit.	6" PE	1010'	Roadway construction SR 5/Aviation Blvd	\$61,154.50

Utility Type	Transverse or Adjacent	General Location	Size	Approx. Conflict Length	Impacts	Cost Estimate
<b>FPL DISTRIBUTION</b>						
OE	Transverse	Crossing SR 5, running east from a pole on the west side of SR 5 to a pole on the east side of SR 5 approximately 120' north of 30 <sup>th</sup> St.	120V	85'	Roadway construction SR 5	\$934.15
OE	Adjacent	East side of SR 5, running north for approximately 900' from a pole north of 30 <sup>th</sup> St to a pole at 33 <sup>rd</sup> St.	2 PH 13KV	900'	Roadway construction SR 5	\$36,000.00
OE	Adjacent	The east side of SR 5, running north from the north side of 33 <sup>rd</sup> St. and going past the project limit on SR 5.	3 PH 13KV	920'	Roadway construction SR 5	\$18,000.00
OE	Transverse	The east side of SR 5, running along the north side of 33 <sup>rd</sup> St., turns south on the west side of 13 <sup>th</sup> Ave. and goes past the project limit.	3 PH 13KV	550'	Roadway construction SR 5/ 33 <sup>rd</sup> St.	\$12,000.00
BE	Transverse	Crossing Aviation Blvd just west of the FECRR ROW.	3 PH 13KV	105'	Roadway Construction Aviation Blvd.	\$40,000.00
<b>LUMEN (CENTURYLINK)</b>						
BFOC	Transverse	Within the FECRR ROW, crossing Aviation Blvd.	3-2" HDPE	110'	Roadway construction intersection of SR 5 and Aviation Blvd.	\$60,003.36
<b>RESURGENCE INFRASTRUCTURE GROUP</b>						
BFOC	Adjacent	Within the FECRR ROW, crossing Aviation Blvd.	1-1.5" conduit, 528 Count BFOC	110'	Roadway construction intersection of SR 5 and Aviation Blvd.	\$61,194.54
<b>SPRINT</b>						
BFOC	Adjacent	Within the FECRR ROW, crossing Aviation Blvd.	1-2" conduit, 96 Count BFOC	110'	Roadway construction intersection of SR 5 and Aviation Blvd.	\$14,734.38
<b>VERIZON</b>						
BFOC	Adjacent	Within the FECRR ROW, crossing Aviation Blvd.	1-2" conduit, 12, 24 Count BFOC	110'	Roadway construction intersection of SR 5 and Aviation Blvd.	\$8,656.68
BFOC	Adjacent	Within the FECRR ROW, crossing Aviation Blvd.	1-2" conduit, 96 Count BFOC	110'	Roadway construction intersection of SR 5 and Aviation Blvd.	\$14,734.38



# Mitigation Recommendations

Mitigation measures should consider the following:


- The accurate location of all underground facilities to confirm a clear or conflict determination,
- The accurate location of all aerial facilities to confirm a clear or conflict determination,
- An innovative design approach to avoid the utility facilities and minimize impacts,
- The UWHCA option for unavoidable relocation of the water and sewer facilities,
- Minimizing the duration of unavoidable service disruptions,
- Allowing service disruption only during periods of no or minimum usage,
- Maintaining utility connections in temporary locations,
- Installing alternative or new facilities before disconnecting the existing facilities,
- Completion of the necessary utility work prior to the start of roadway construction, or prioritize the utility work to avoid the first phases of roadway construction,
- Removing Occupational Safety and Health Administration (OSHA) crane conflicts and utilizing low overhead construction techniques.

**Appendix A**

**Preferred Alternative Concept Plans**

CURVE DATA TABLE

ROAD	CURVE No.	RADIUS (FT)	LENGTH (FT)	SUPERELEVATION (e)	DESIGN SPEED (MPH)
US 1 (PGL RT)	1	11,290.00	431.05	NORMAL CROWN	45
US 1 (PGL RT)	2	17,044.14	1,135.56	NORMAL CROWN	45
US 1 (PGL RT)	3	8,689.68	712.34	NORMAL CROWN	45
US 1 (PGL LT)	4	15,186.97	587.43	NORMAL CROWN	45
US 1 (PGL LT)	5	17,016.14	1,098.80	NORMAL CROWN	45
US 1 (PGL LT)	6	7,706.25	800.97	NORMAL CROWN	45
AVIATION BLVD (WEST) (PGL RT)	7	701.92	459.15	REVERSE CROWN	30
AVIATION BLVD (WEST) (PGL RT)	8	446.87	400.00	REVERSE CROWN	30
AVIATION BLVD (WEST) (PGL LT)	9	654.42	440.76	REVERSE CROWN	30
AVIATION BLVD (WEST) (PGL LT)	10	470.92	404.51	REVERSE CROWN	30
AVIATION BLVD (EAST) (PGL RT)	11	396.00	471.20	REVERSE CROWN e = 0.021	30
AVIATION BLVD (EAST) (PGL LT)	12	371.00	435.91	REVERSE CROWN e = 0.025	30

 

**Preferred Alternative  
(Alternative 1)**

**State Road (SR) 5/US 1 at Aviation Boulevard**

Project Development and Environment (PD&E) Study  
 Indian River County, Florida  
 Financial Project ID: 441693-1-22-02  
 Efficient Transportation Decision Making (ETDM) Number: 14475



**Draft Alternative  
March 17<sup>th</sup>, 2024**

**Appendix B**

**Sample UAO Contact Letter**



October 25, 2022

RE: **ADJUSTMENT OF UTILITIES – STATE STATUTES CHAPTER 337.403**

**Project:** SR-5(US-1) at Aviation Boulevard PD&E Study

**Description:** Aviation Blvd PD&E Study from 27<sup>th</sup> Ave to US1/SR5 and SR5 from 21<sup>st</sup> St. to 37<sup>th</sup> St.

**County:** Indian River County

**FPID:** 441693-1-22-02

**Project Development & Environmental (PD&E) Utility Assessment Report**

The Florida Department of Transportation (FDOT), is conducting a Project Development and Environment (PD&E) Study for the improvements to the above roadway(s). The PD&E study limits begin at Aviation Blvd. & 27<sup>th</sup> Ave and go east to US1/SR5, then continue along US from 21<sup>st</sup> St., north to 37<sup>th</sup> St. (See Attached Project Location map). In order to determine the best alternative for this project, we need to determine the location and anticipated impacts for all existing, proposed and out-of-service utility facilities within the project study limits, both underground and overhead.

For this purpose we are requesting your office mark on the attached plans (plans dated September 15, 2022), all your existing, proposed and out-of-service utility facilities, both inside and along the project study right-of-way lines, and/or within the limits as shown. We are further asking you return the marked plans and requested information (hard copy or electronic) to this office before **November 22, 2022.**

Please provide with your response the following information:

- Updated contact information for your Agency/Owner, providing name, phone, email and address.
- Attached plans marked to indicate the location, type and size of your existing, proposed and out-of-service facilities within the study limits, and indicate whether underground or aerial. Along with the marked plans, provide any atlas maps, GIS or other additional plans or information that might help to describe and define your facilities.
- Marked plans to show the limits of any easements, subordinations, or other property interests you may have along or within the study limits, and any existing or proposed encroachments onto those properties.
- A lump sum order-of-magnitude relocation cost estimate that approximates the cost to adjust or relocate all of your utilities within the project study limits. This estimate will not influence any detailed estimates furnished later; it is for the purpose of addressing any major impacts.
- An estimate of the time frames to relocate all of your utilities within the project limits. This estimate will not influence any detailed time frames furnished later.
- Whether you agency would be interested in entering a Utility Work by Highway Contractor Agreement, including whether this would include affected facilities or proposed installations.
- If you do not have any utility facilities within the study limits, please provide a No Facilities Letter.


Thank you for your attention and cooperation to this matter. Your input and continued cooperation on this project is essential. Should you have any questions do not hesitate to contact me directly at 561-713-1683, or send email to [matthew.phillips@wginc.com](mailto:matthew.phillips@wginc.com).

WGI, INC.

Matthew Phillips  
Sr. Utility Coordinator

**Appendix C**

**Utility Contact Plans**

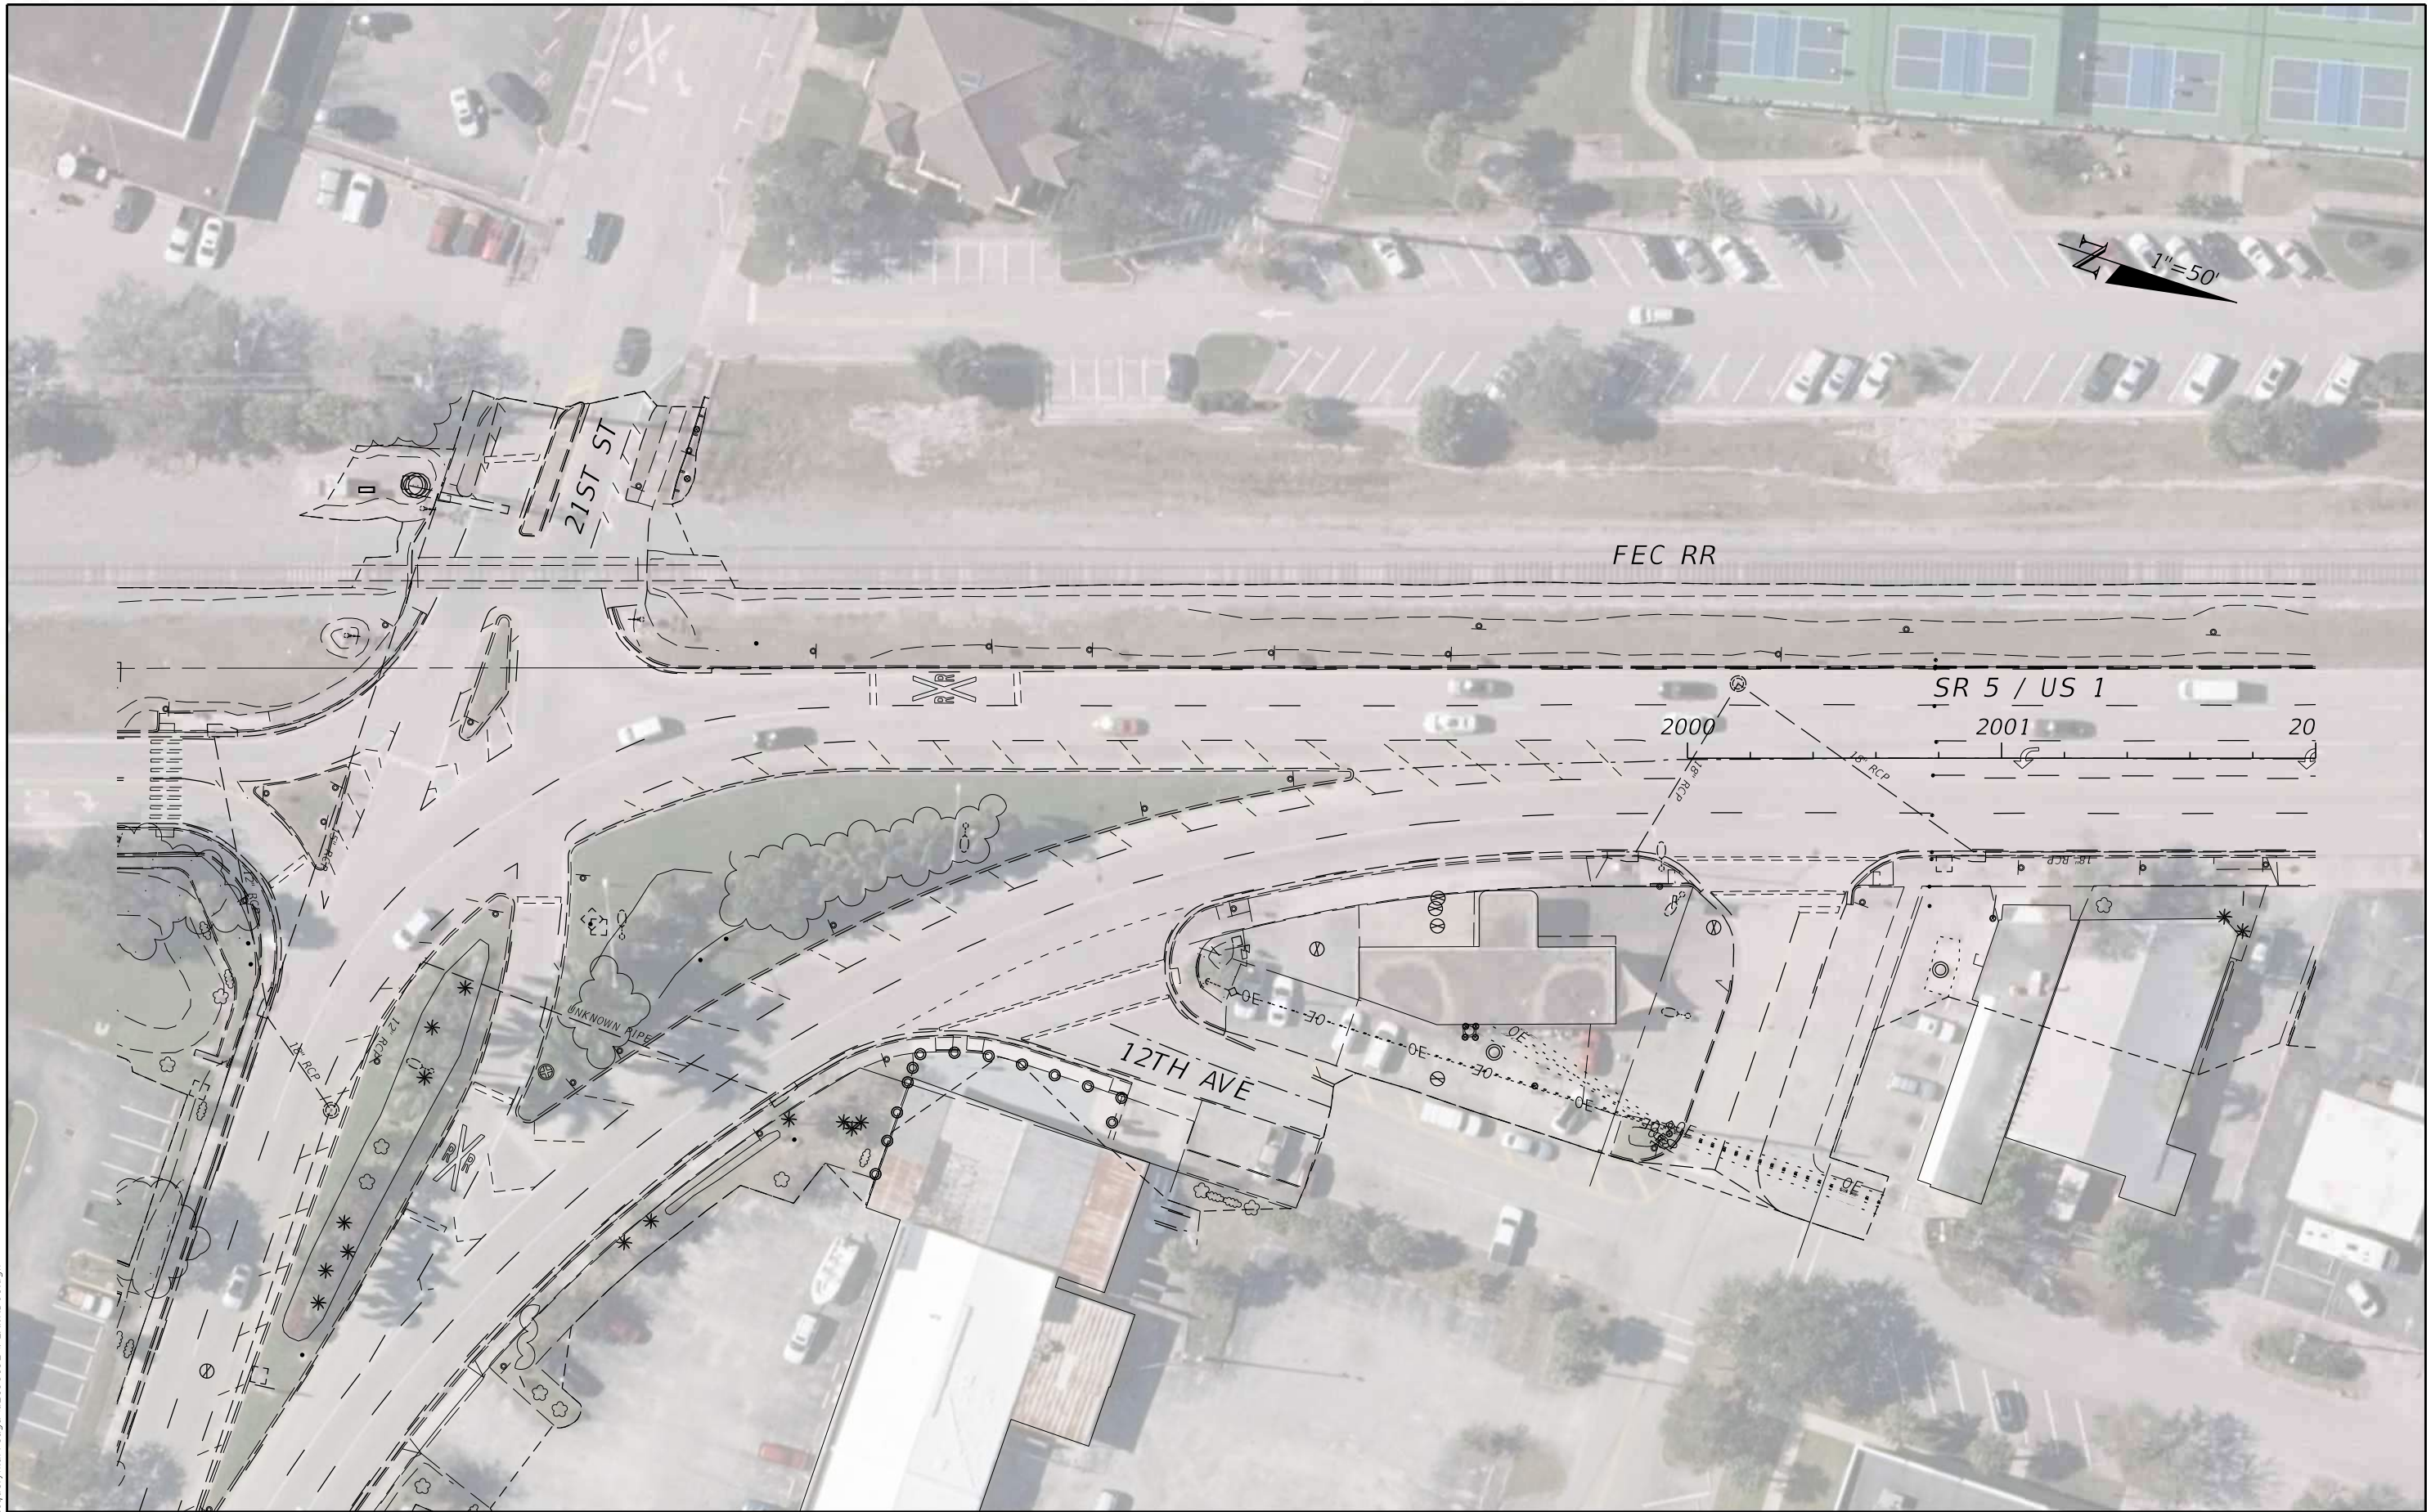

9/15/2022 10:58:52 AM Jacquelyn.Arreaga  
 c:\pwworking\wgi\jacquelyn.arreaga\d2198192\PLANRD01.dgn

REVISIONS	
DATE	DESCRIPTION


**PROFESSIONAL TYPE**  
 WILLIAM EVANS  
 LICENSE NUMBER: 45207  
 WGI, INC.  
 2035 VISTA PARKWAY  
 WEST PALM BEACH, FL 33411

STATE OF FLORIDA DEPARTMENT OF TRANSPORTATION		
ROAD NO.	COUNTY	FINANCIAL PROJECT ID
SR 5	INDIAN RIVER	441693-1-22-02

**UTILITY CONTACT PLAN (1)**

SHEET NO.  1
-----------------------

THE OFFICIAL RECORD OF THIS SHEET IS THE ELECTRONIC FILE DIGITALLY SIGNED AND SEALED UNDER RULE 61G15-23.004, F.A.C.

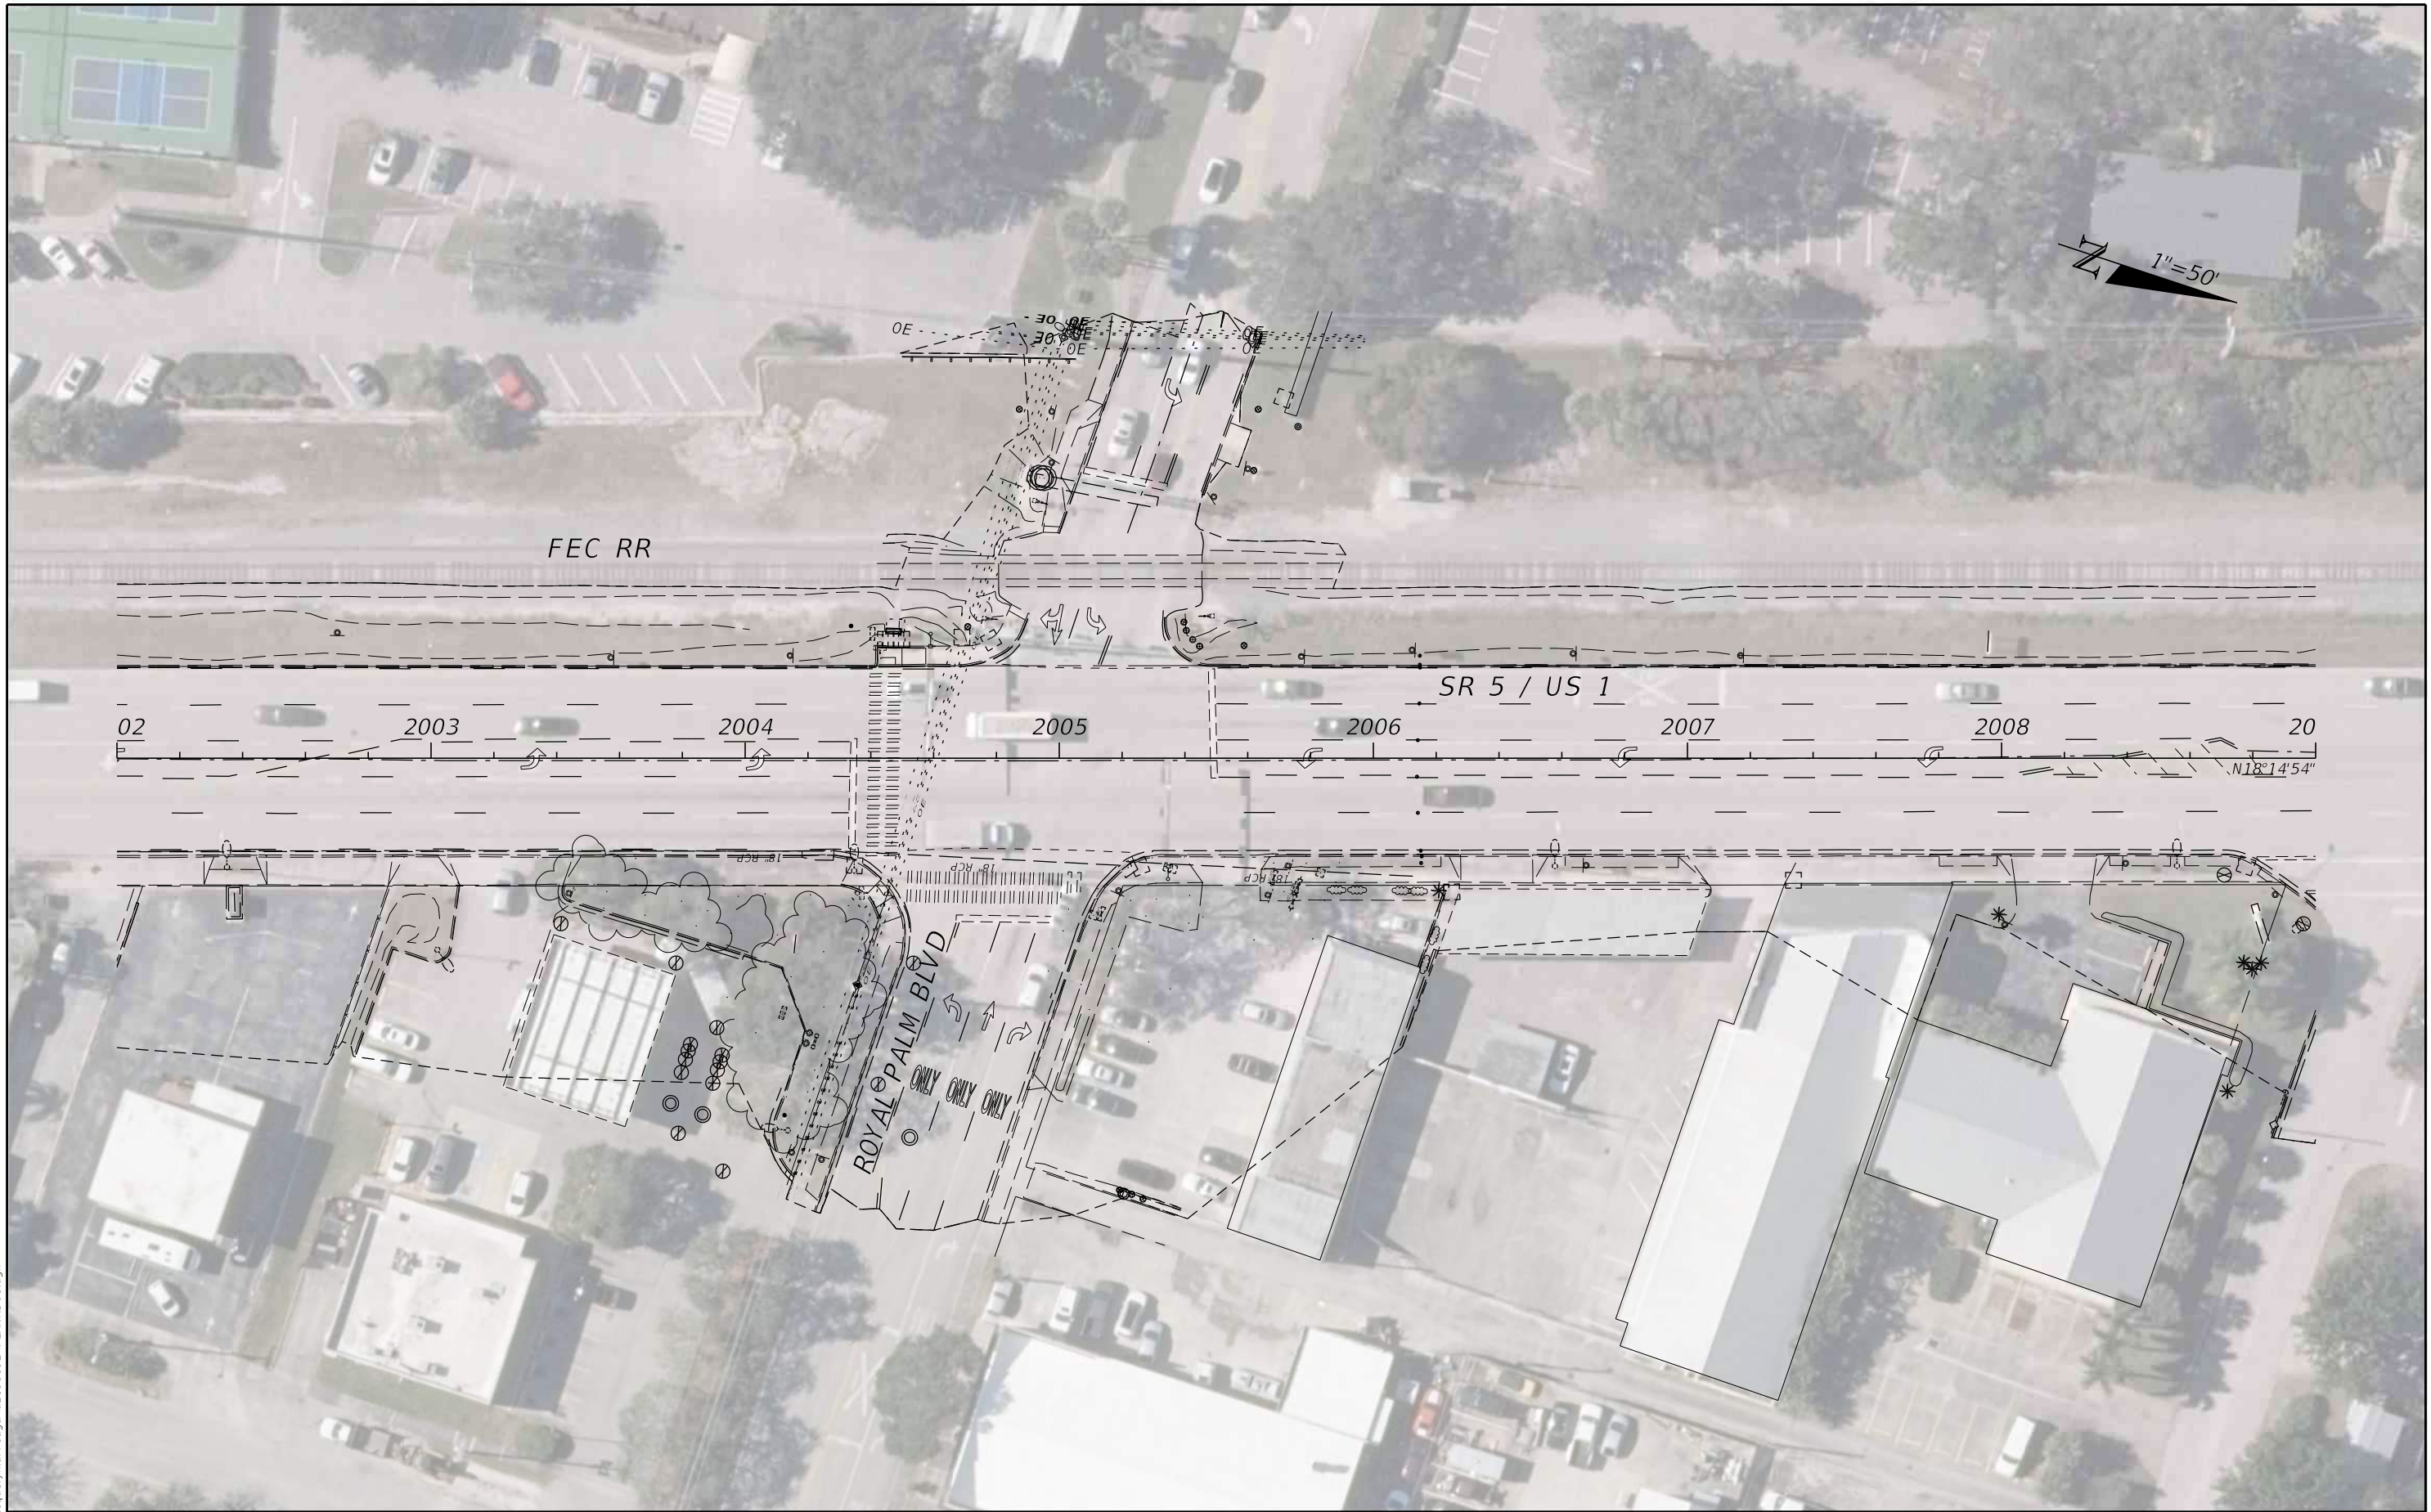


9/15/2022 10:59:58 AM Jacquelyn.Arreaga  
 c:\pwworking\wgn\jacquelyn.arreaga\d2198192\PLANRD01.dgn

REVISIONS		PROFESSIONAL TYPE		STATE OF FLORIDA DEPARTMENT OF TRANSPORTATION			SHEET NO.
DATE	DESCRIPTION	DATE	DESCRIPTION	ROAD NO.	COUNTY	FINANCIAL PROJECT ID	
				SR 5	INDIAN RIVER	441693-1-22-02	2

**UTILITY CONTACT PLAN (2)**

THE OFFICIAL RECORD OF THIS SHEET IS THE ELECTRONIC FILE DIGITALLY SIGNED AND SEALED UNDER RULE 61G15-23.004, F.A.C.



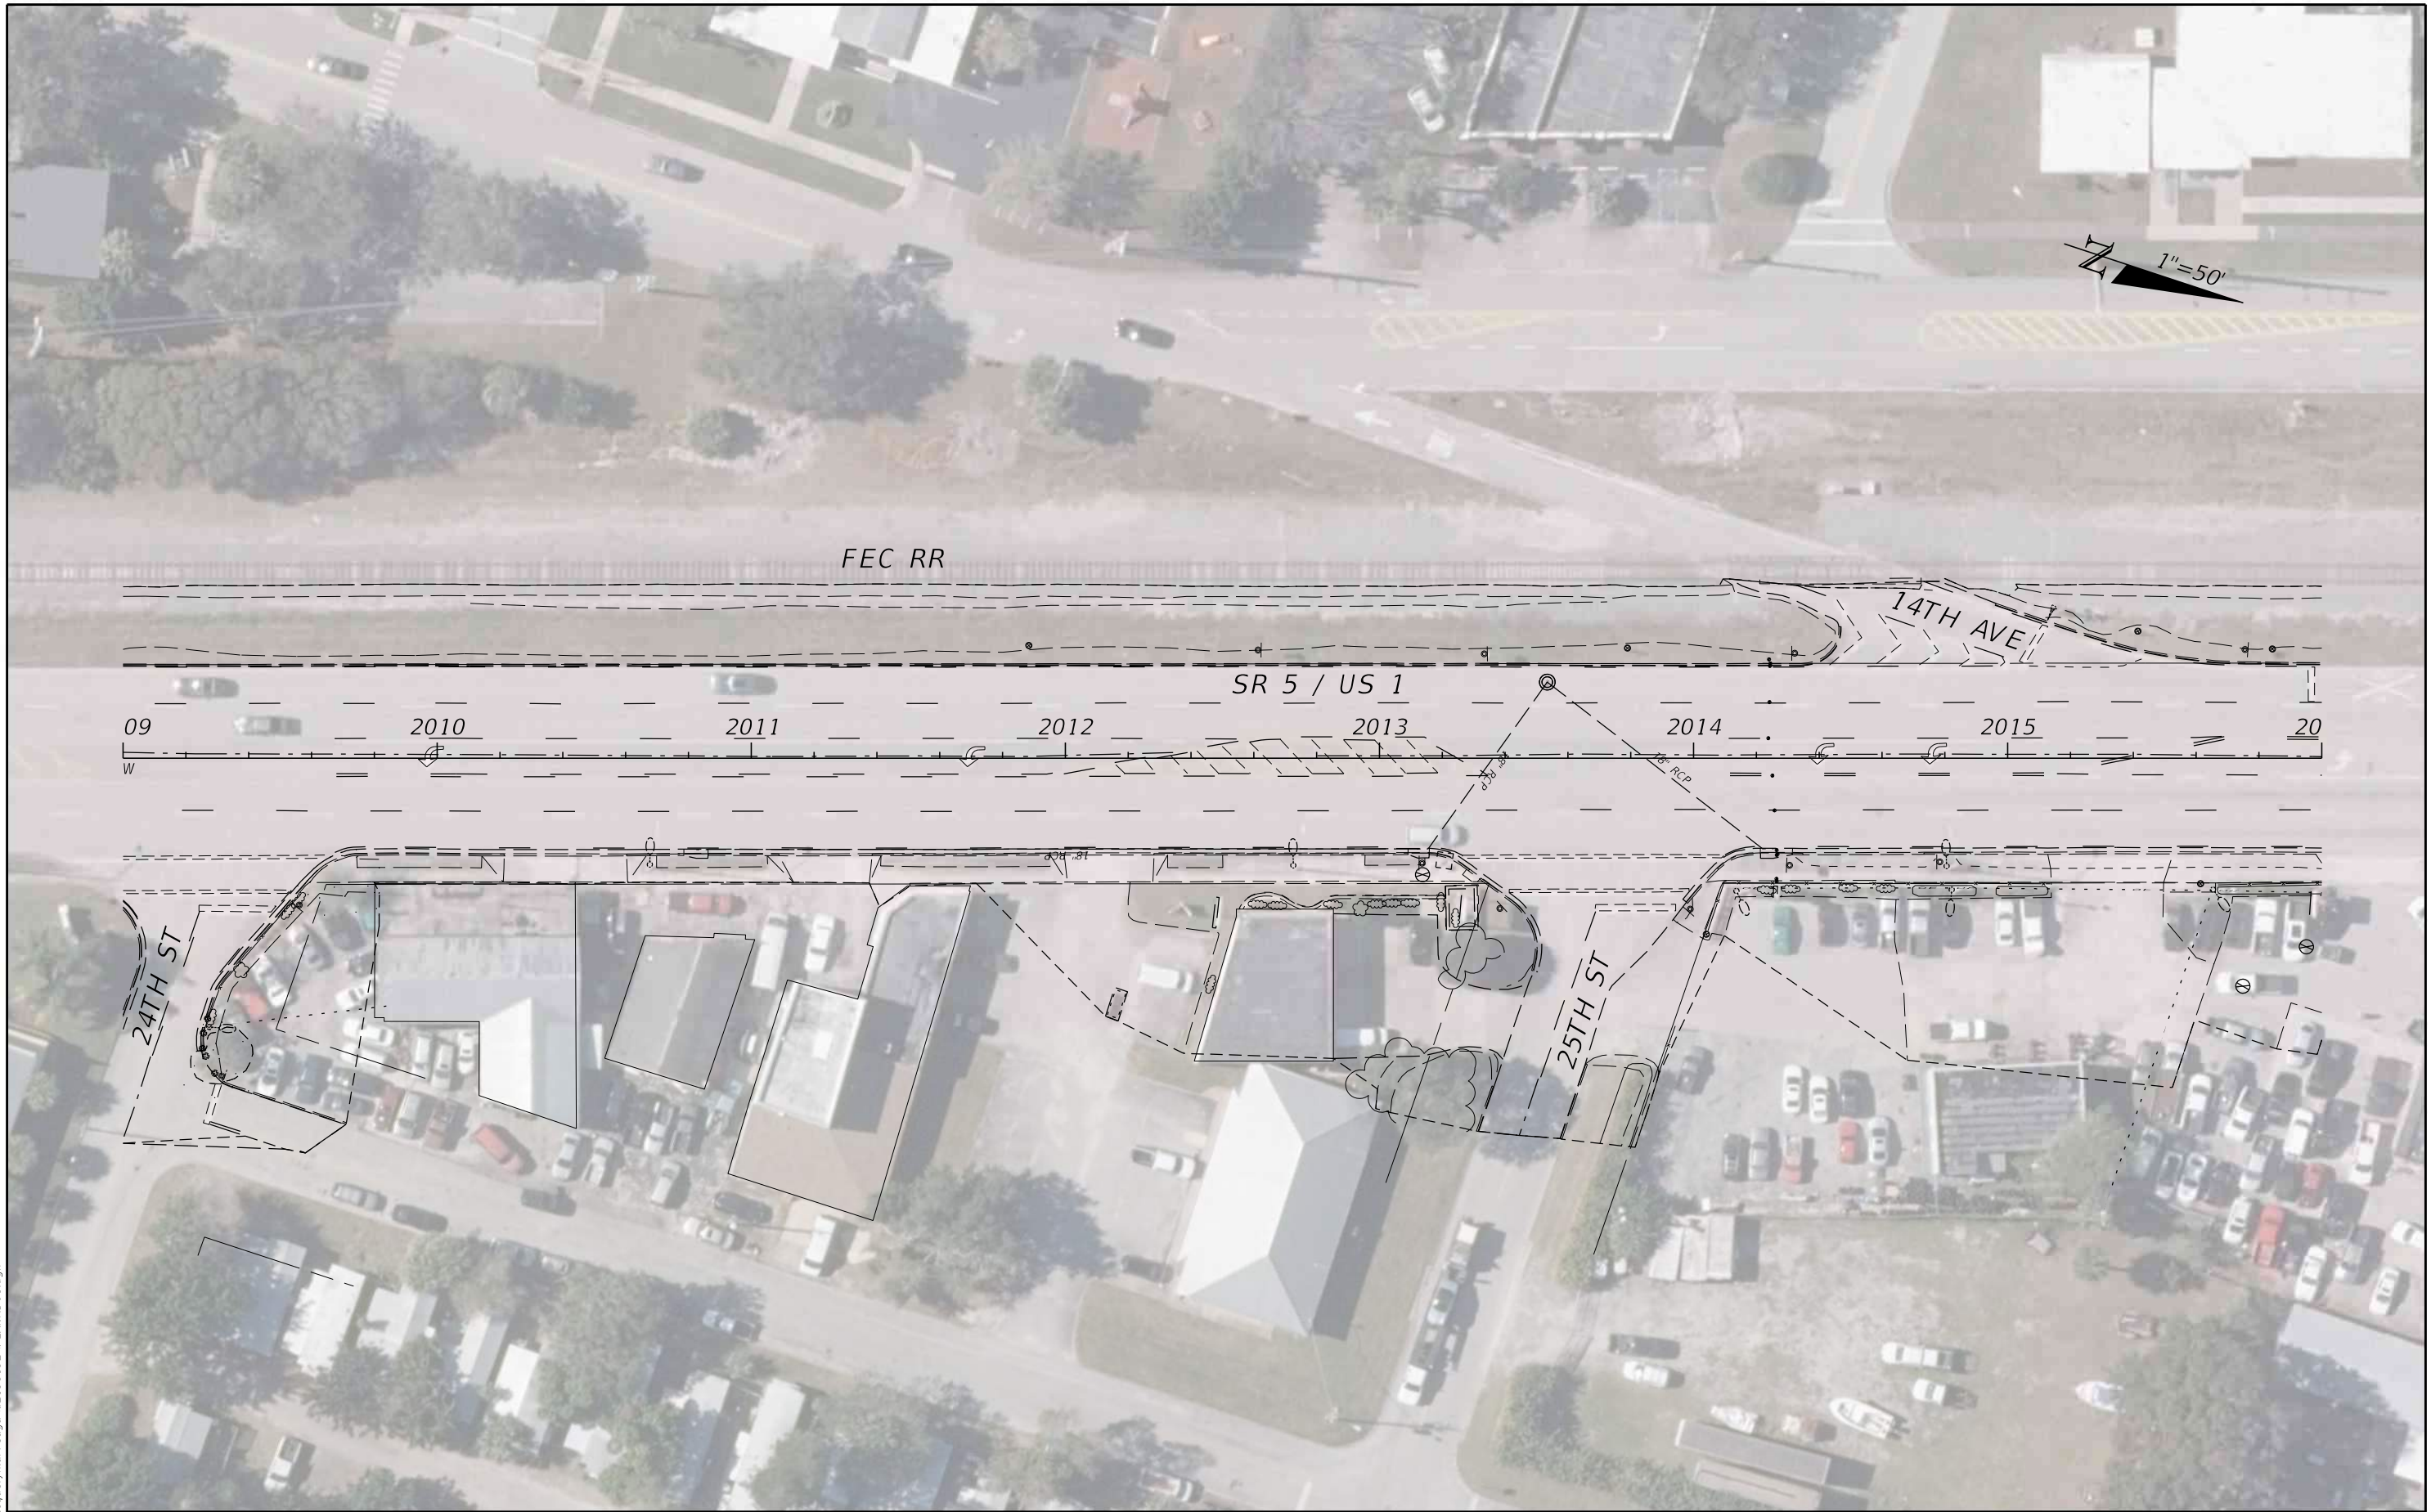

1"=50'

FEC RR

SR 5 / US 1

14TH AVE

09 2010 2011 2012 2013 2014 2015 20

24TH ST


25TH ST

9/15/2022 11:00:13 AM Jacquelyn.Arreaga c:\pwworking\wg\N\Jacquelyn.arreaga\d2198192\PLANRD01.dgn

DATE		REVISIONS		PROFESSIONAL TYPE	STATE OF FLORIDA DEPARTMENT OF TRANSPORTATION			SHEET NO.
DATE	DESCRIPTION	DATE	DESCRIPTION		ROAD NO.	COUNTY	FINANCIAL PROJECT ID	
				WILLIAM EVANS LICENSE NUMBER: 45207 WGI, INC. 2035 VISTA PARKWAY WEST PALM BEACH, FL 33411	SR 5	INDIAN RIVER	441693-1-22-02	3

**UTILITY CONTACT PLAN (3)**

THE OFFICIAL RECORD OF THIS SHEET IS THE ELECTRONIC FILE DIGITALLY SIGNED AND SEALED UNDER RULE 61G15-23.004, F.A.C.

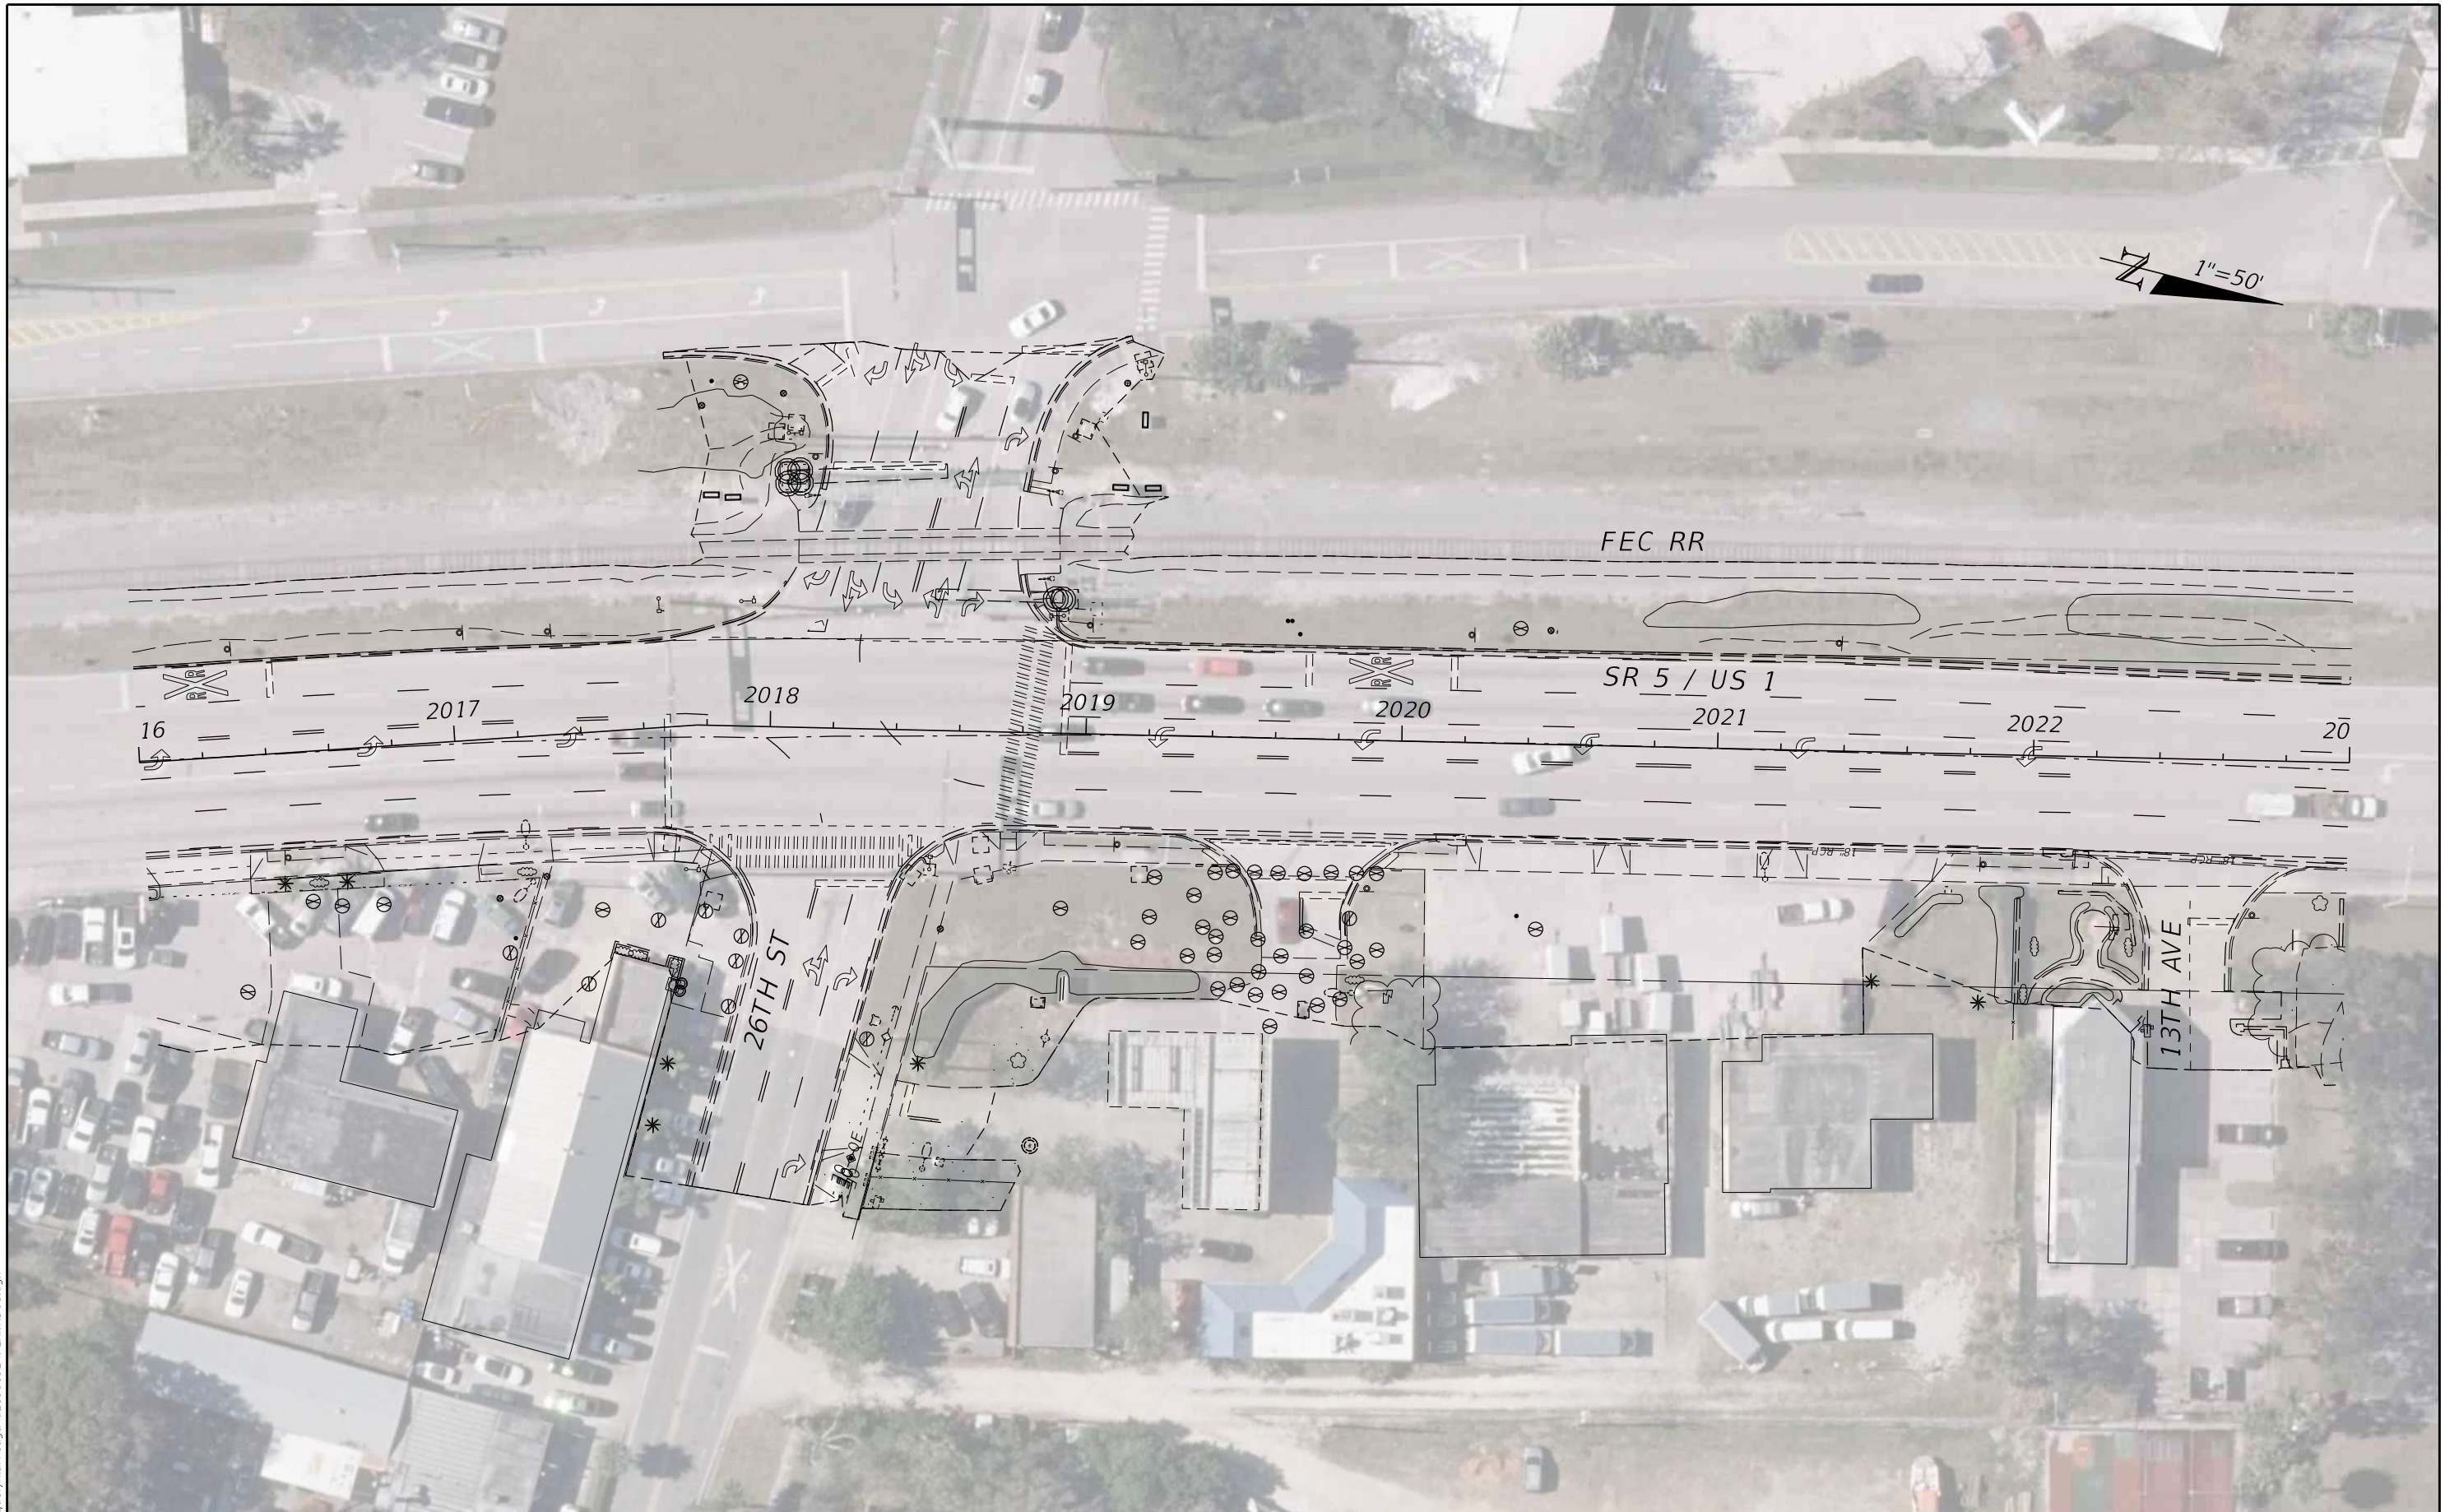


9/15/2022 11:00:42 AM Jacquelyn.Arreaga  
 c:\pwworking\wgn\jacquelyn.arreaga\d2198192\PLANRD01.dgn

REVISIONS		PROFESSIONAL TYPE		STATE OF FLORIDA DEPARTMENT OF TRANSPORTATION			SHEET NO.
DATE	DESCRIPTION	DATE	DESCRIPTION	ROAD NO.	COUNTY	FINANCIAL PROJECT ID	
				SR 5	INDIAN RIVER	441693-1-22-02	4

**UTILITY CONTACT PLAN (4)**

THE OFFICIAL RECORD OF THIS SHEET IS THE ELECTRONIC FILE DIGITALLY SIGNED AND SEALED UNDER RULE 61G15-23.004, F.A.C.

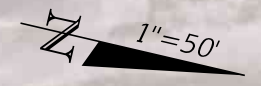


9/15/2022 11:00:51 AM Jacquelyn.Arreaga  
 c:\pwworking\wgn\jacquelyn.arreaga\d2198192\PLANRD01.dgn

REVISIONS				PROFESSIONAL TYPE		STATE OF FLORIDA DEPARTMENT OF TRANSPORTATION			<b>UTILITY CONTACT PLAN (5)</b>	SHEET NO.
DATE	DESCRIPTION	DATE	DESCRIPTION			ROAD NO.	COUNTY	FINANCIAL PROJECT ID		5
				WILLIAM EVANS LICENSE NUMBER: 45207 WGI, INC. 2035 VISTA PARKWAY WEST PALM BEACH, FL 33411		SR 5	INDIAN RIVER	441693-1-22-02		

THE OFFICIAL RECORD OF THIS SHEET IS THE ELECTRONIC FILE DIGITALLY SIGNED AND SEALED UNDER RULE 61G15-23.004, F.A.C.

CITY OF VERO BEACH AIRPORT

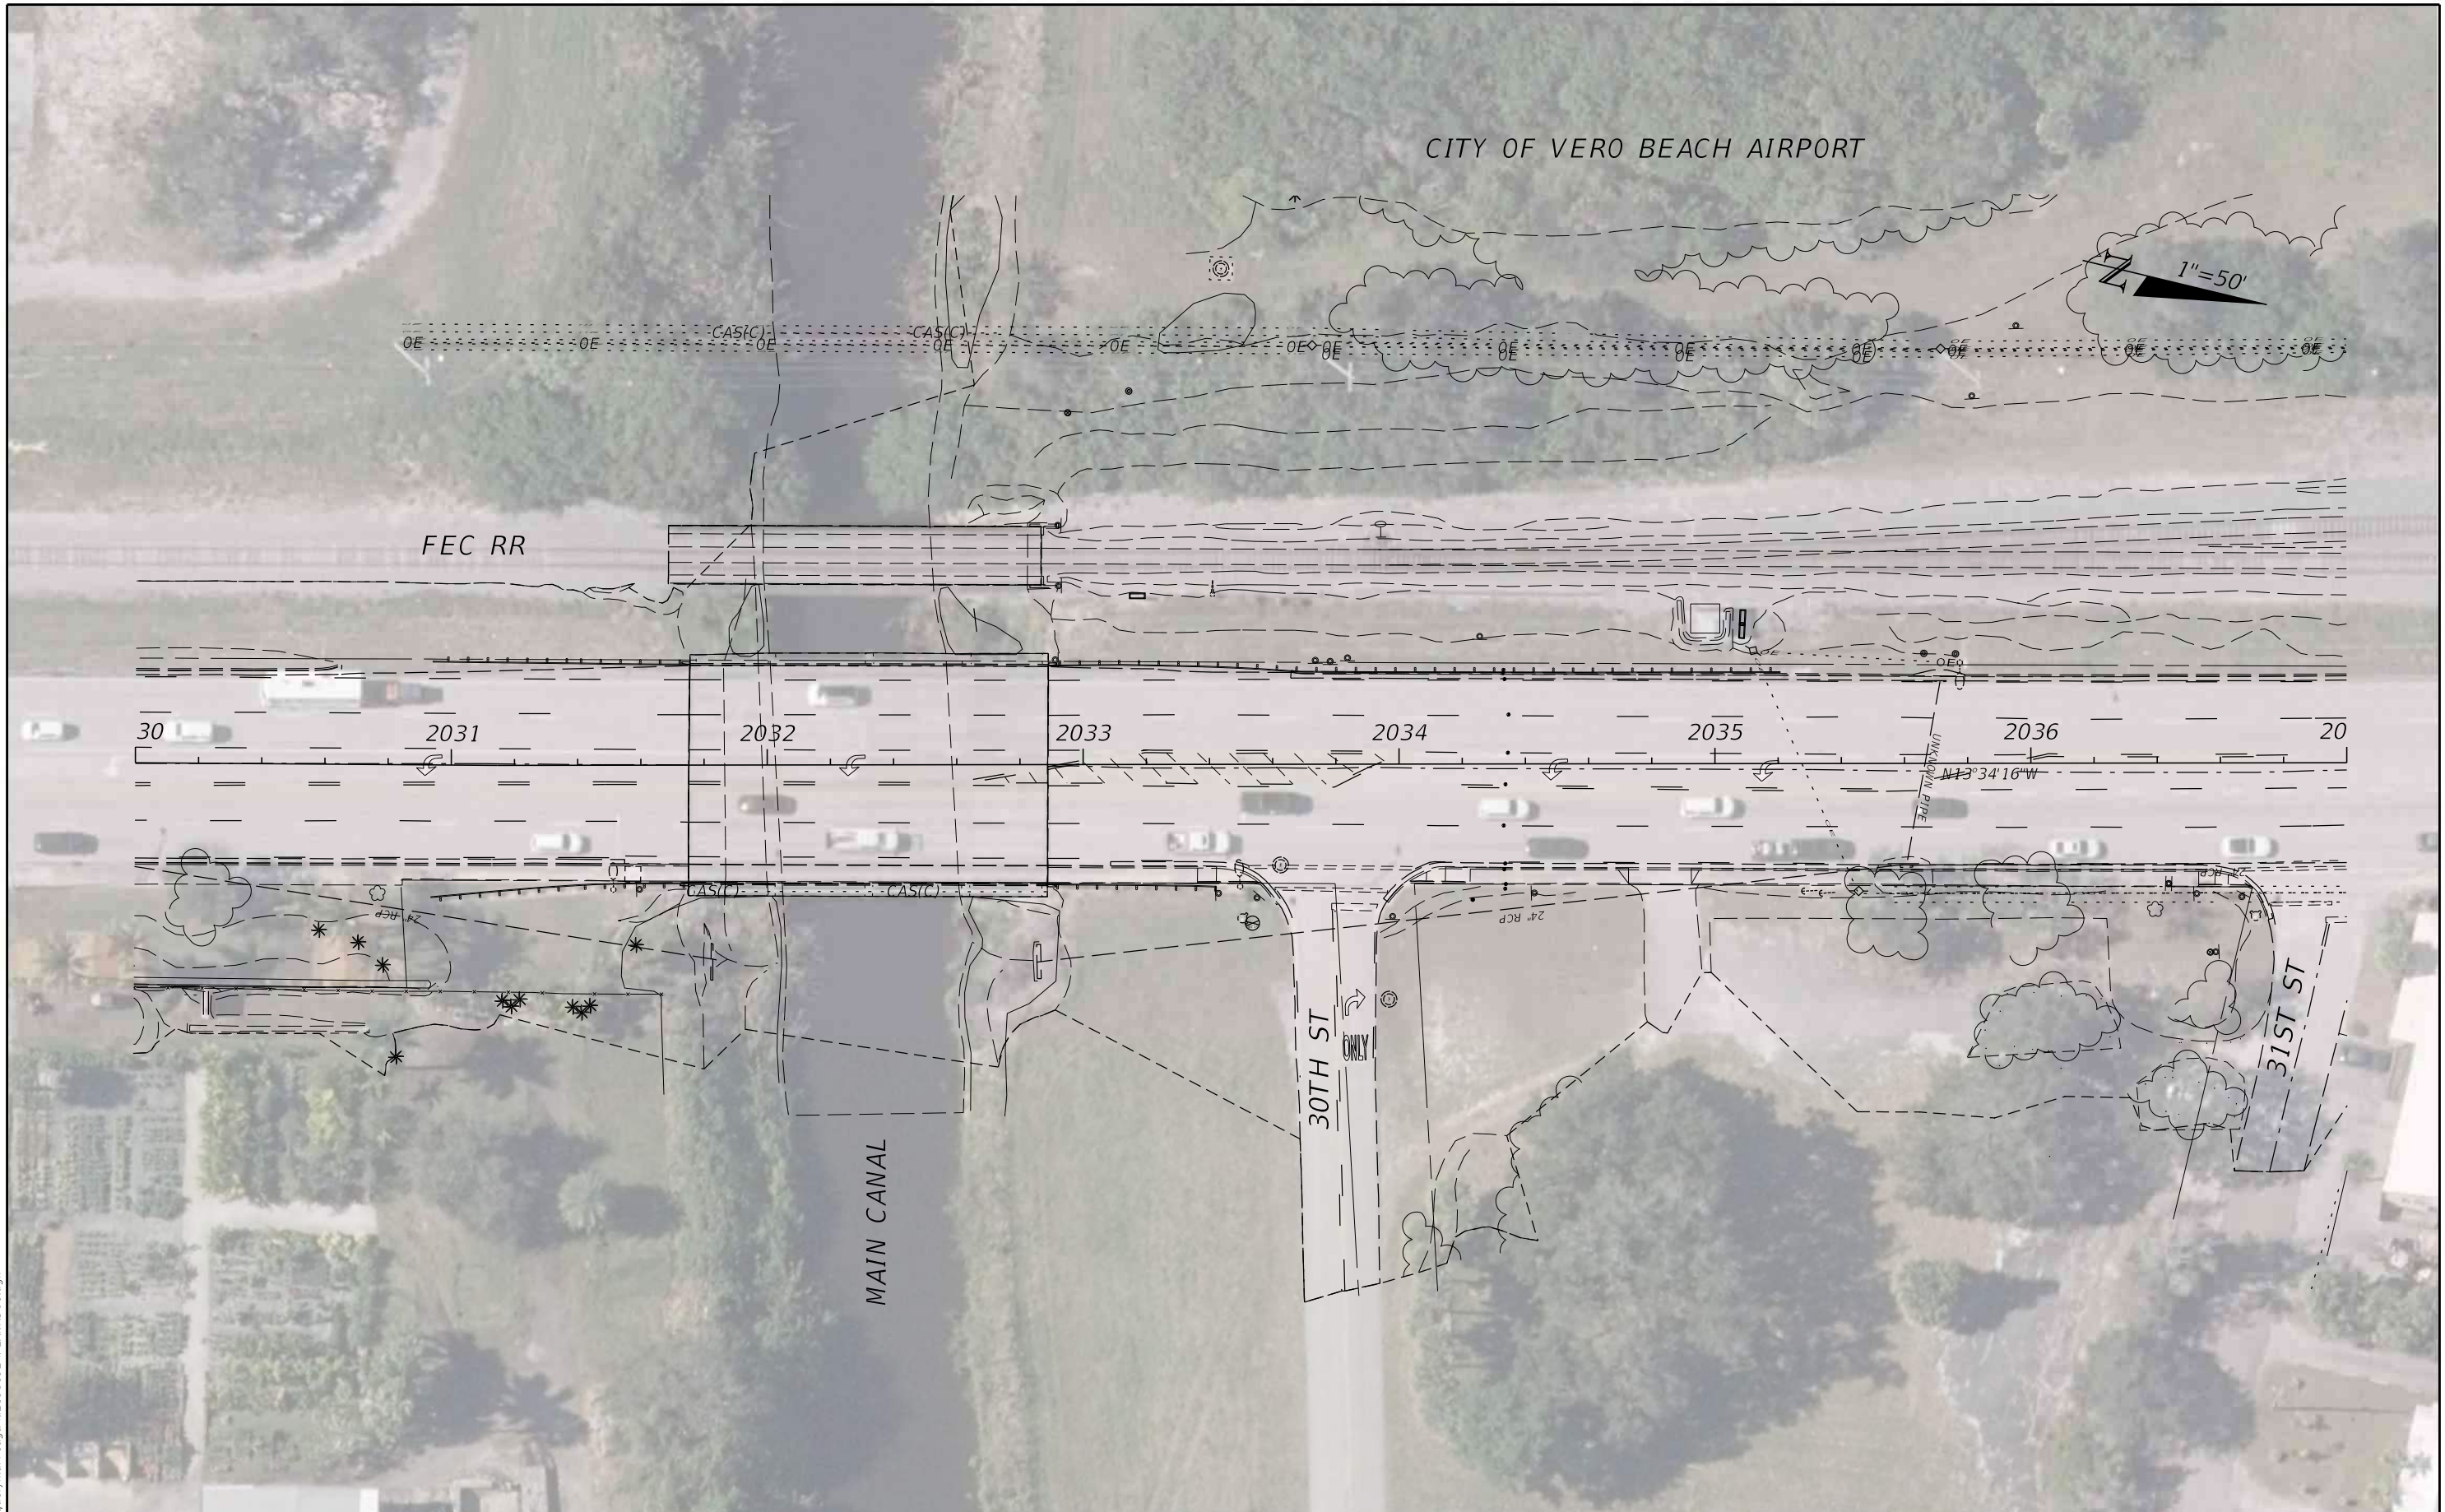


9/15/2022 11:01:04 AM Jacquelyn.Arreaga c:\pwworking\wgn\jacquelyn.arreaga\d2198192\PLANRD01.dgn

REVISIONS		PROFESSIONAL TYPE		STATE OF FLORIDA DEPARTMENT OF TRANSPORTATION			SHEET NO.
DATE	DESCRIPTION	DATE	DESCRIPTION	ROAD NO.	COUNTY	FINANCIAL PROJECT ID	
				SR 5	INDIAN RIVER	441693-1-22-02	6

**UTILITY CONTACT PLAN (6)**

THE OFFICIAL RECORD OF THIS SHEET IS THE ELECTRONIC FILE DIGITALLY SIGNED AND SEALED UNDER RULE 61G15-23.004, F.A.C.

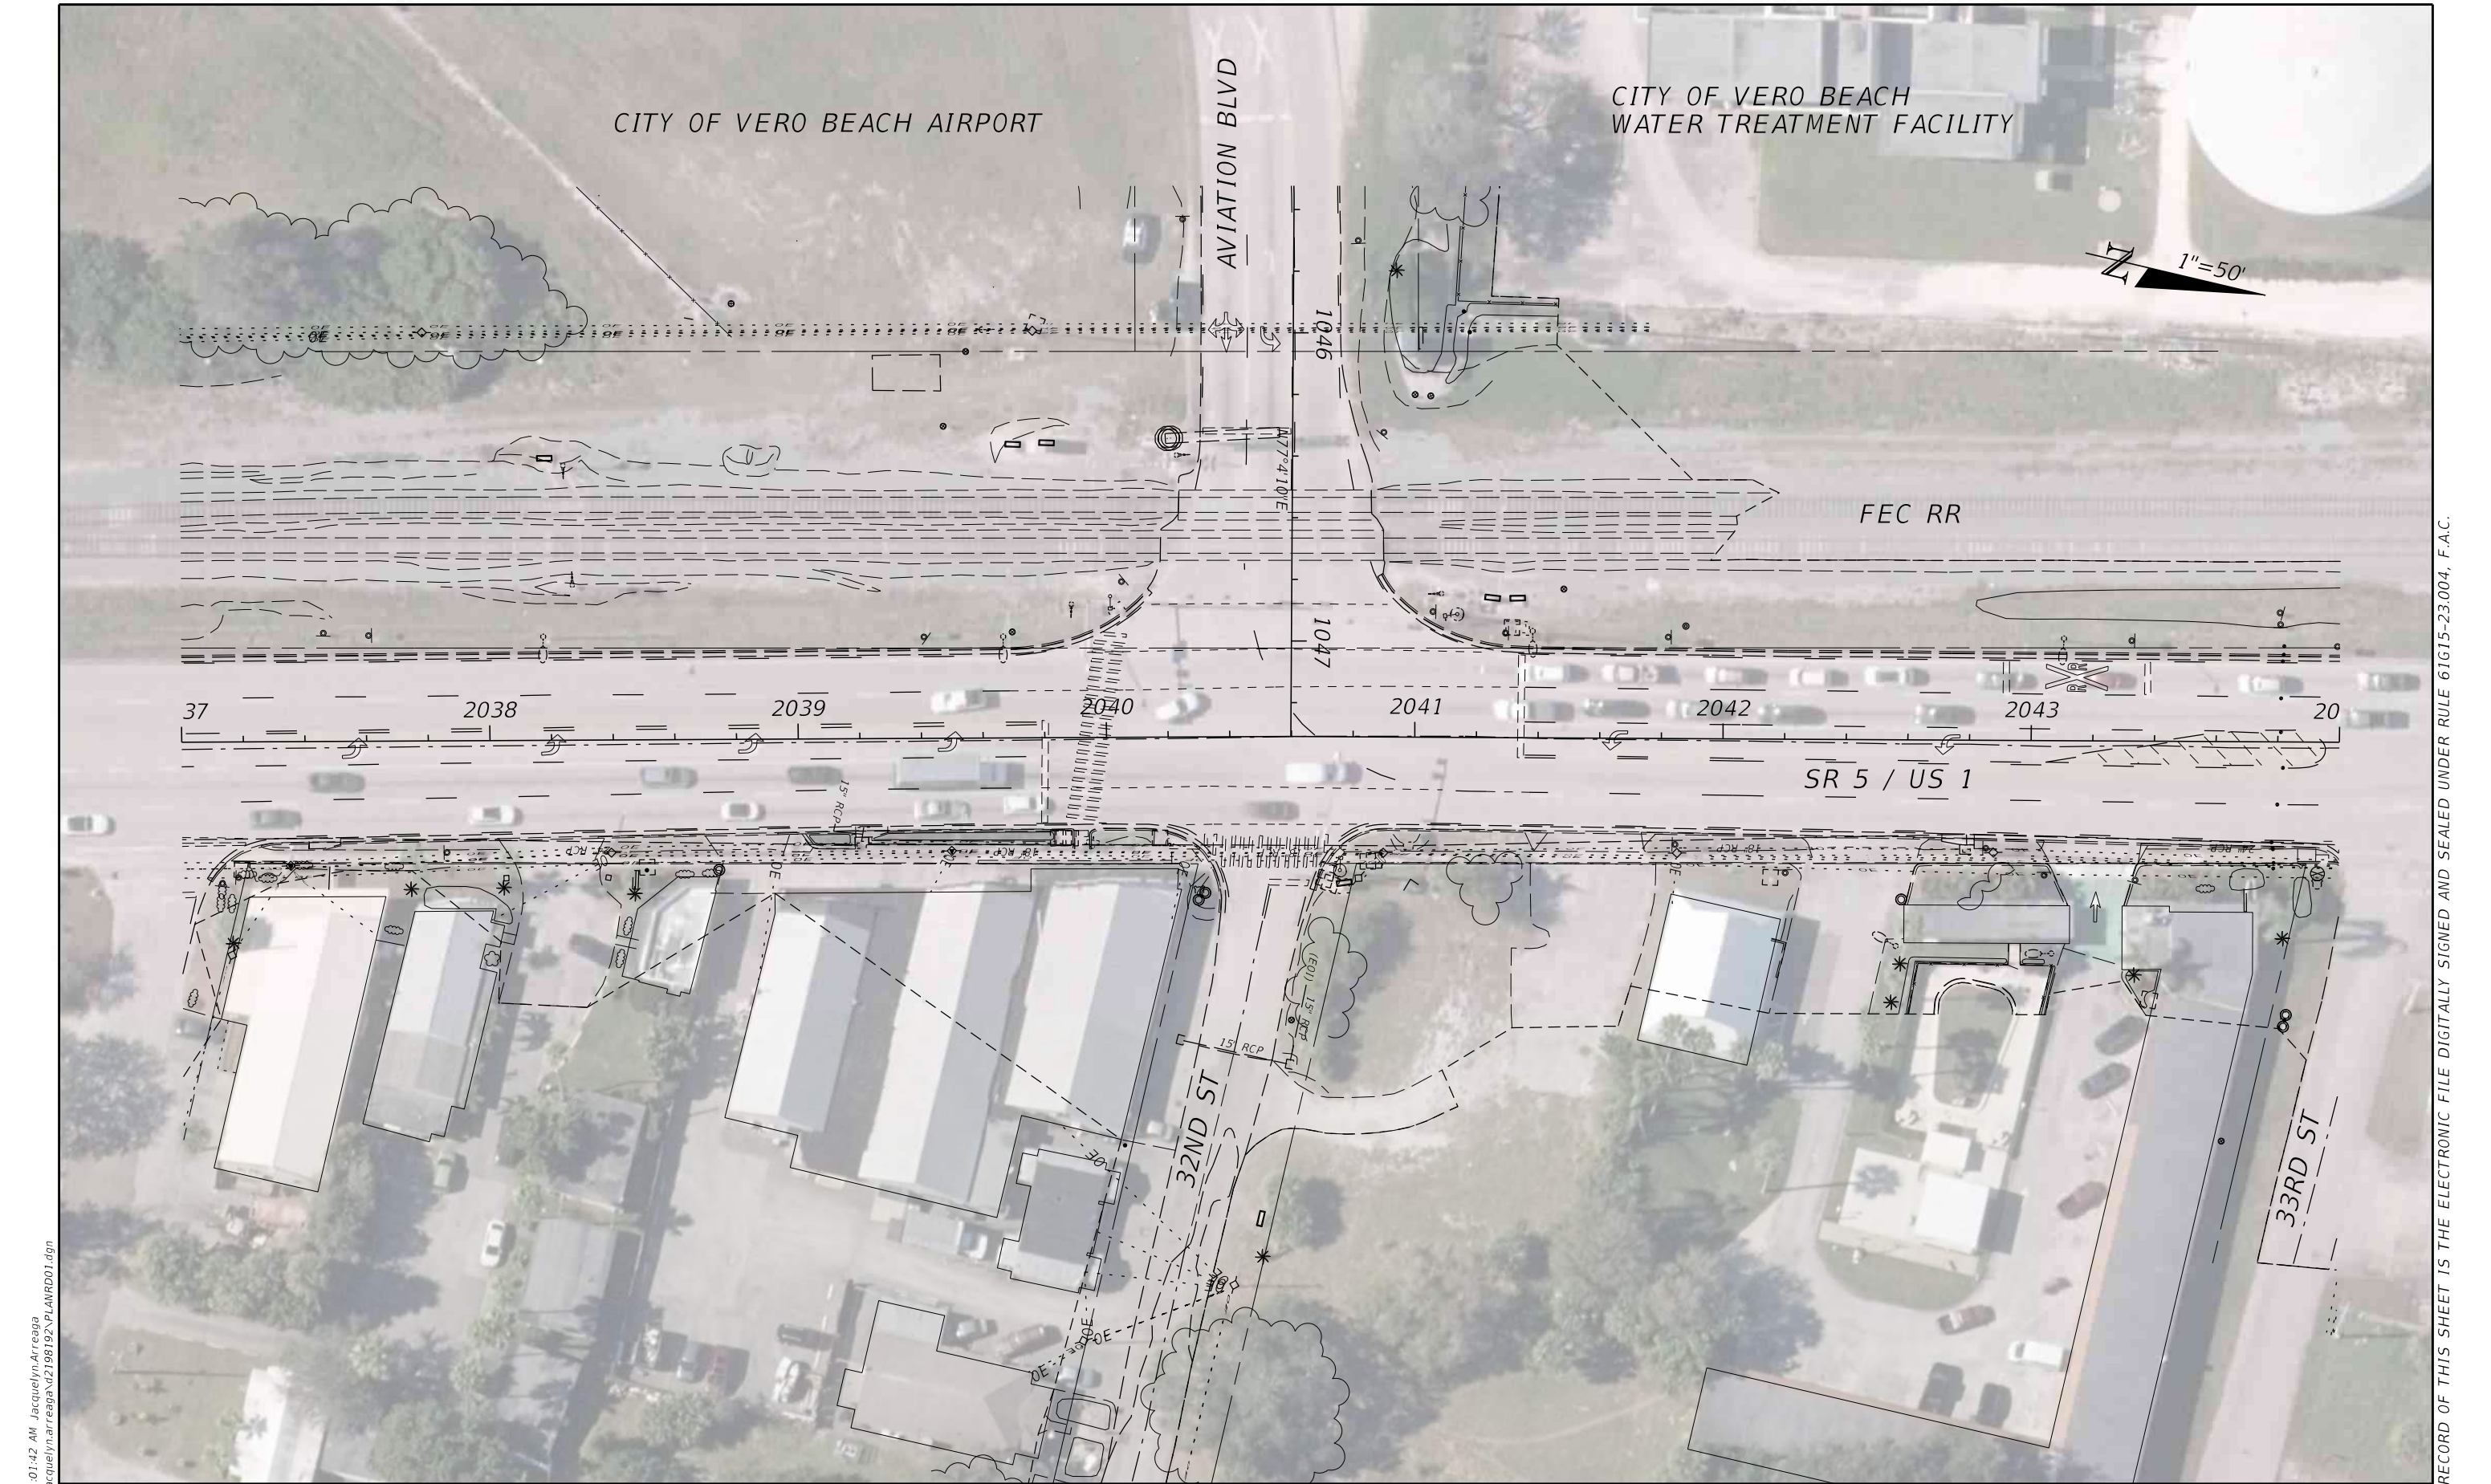


CITY OF VERO BEACH AIRPORT

CITY OF VERO BEACH  
WATER TREATMENT FACILITY

AVIATION BLVD

FEC RR

SR 5 / US 1

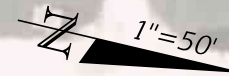

37

2038

2039

2040

2041

2042

2043

20

1046

1047

32ND ST

33RD ST


9/15/2022 11:01:42 AM Jacquelyn.Arreaga c:\pwworking\wgn\jacquelyn.arreaga\d2198192\PLANRD01.dgn

REVISIONS		PROFESSIONAL TYPE		STATE OF FLORIDA DEPARTMENT OF TRANSPORTATION			UTILITY CONTACT PLAN (7)	SHEET NO.  7
DATE	DESCRIPTION	DATE	DESCRIPTION	ROAD NO.	COUNTY	FINANCIAL PROJECT ID		
				SR 5	INDIAN RIVER	441693-1-22-02		

WILLIAM EVANS  
LICENSE NUMBER: 45207  
WGI, INC.  
2035 VISTA PARKWAY  
WEST PALM BEACH, FL 33411

THE OFFICIAL RECORD OF THIS SHEET IS THE ELECTRONIC FILE DIGITALLY SIGNED AND SEALED UNDER RULE 61G15-23.004, F.A.C.

CITY OF VERO BEACH AIRPORT

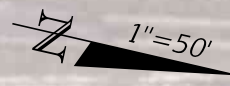

9/15/2022 11:02:24 AM Jacquelyn.Arreaga c:\pwworking\wg\N\jacquelyn.arreaga\d2198192\PLANRD01.dgn

REVISIONS				PROFESSIONAL TYPE	STATE OF FLORIDA DEPARTMENT OF TRANSPORTATION			UTILITY CONTACT PLAN (8)	SHEET NO. 8
DATE	DESCRIPTION	DATE	DESCRIPTION		ROAD NO.	COUNTY	FINANCIAL PROJECT ID		
				WILLIAM EVANS LICENSE NUMBER: 45207 WGI, INC. 2035 VISTA PARKWAY WEST PALM BEACH, FL 33411	SR 5	INDIAN RIVER	441693-1-22-02		

THE OFFICIAL RECORD OF THIS SHEET IS THE ELECTRONIC FILE DIGITALLY SIGNED AND SEALED UNDER RULE 61G15-23.004, F.A.C.

CITY OF VERO BEACH AIRPORT



FEC RR

SR 5 / US 1

51 2052 2053 2054 2055 2056 2057 20

9/15/2022 11:02:50 AM Jacquelyn.Arreaga c:\pwworking\wgn\jacquelyn.arreaga\d2198192\PLANRD01.dgn

REVISIONS		PROFESSIONAL TYPE		STATE OF FLORIDA DEPARTMENT OF TRANSPORTATION			SHEET NO.
DATE	DESCRIPTION	DATE	DESCRIPTION	ROAD NO.	COUNTY	FINANCIAL PROJECT ID	
				SR 5	INDIAN RIVER	441693-1-22-02	9

**UTILITY CONTACT PLAN (9)**

THE OFFICIAL RECORD OF THIS SHEET IS THE ELECTRONIC FILE DIGITALLY SIGNED AND SEALED UNDER RULE 61G15-23.004, F.A.C.

CITY OF VERO BEACH AIRPORT



FEC RR

58 2059 2060 2061 2062 2063 2064 20

SR 5 / US 1

PICKERILL LN


9/15/2022 11:03:08 AM Jacquelyn.Arreaga c:\pwworking\wg\N\Jacquelyn.arreaga\d2198192\PLANRD01.dgn

REVISIONS				PROFESSIONAL TYPE	STATE OF FLORIDA DEPARTMENT OF TRANSPORTATION			UTILITY CONTACT PLAN (10)	SHEET NO. 10
DATE	DESCRIPTION	DATE	DESCRIPTION		ROAD NO.	COUNTY	FINANCIAL PROJECT ID		
				WILLIAM EVANS LICENSE NUMBER: 45207 WGI, INC. 2035 VISTA PARKWAY WEST PALM BEACH, FL 33411	SR 5	INDIAN RIVER	441693-1-22-02		

THE OFFICIAL RECORD OF THIS SHEET IS THE ELECTRONIC FILE DIGITALLY SIGNED AND SEALED UNDER RULE 61G15-23.004, F.A.C.



CITY OF VERO BEACH AIRPORT

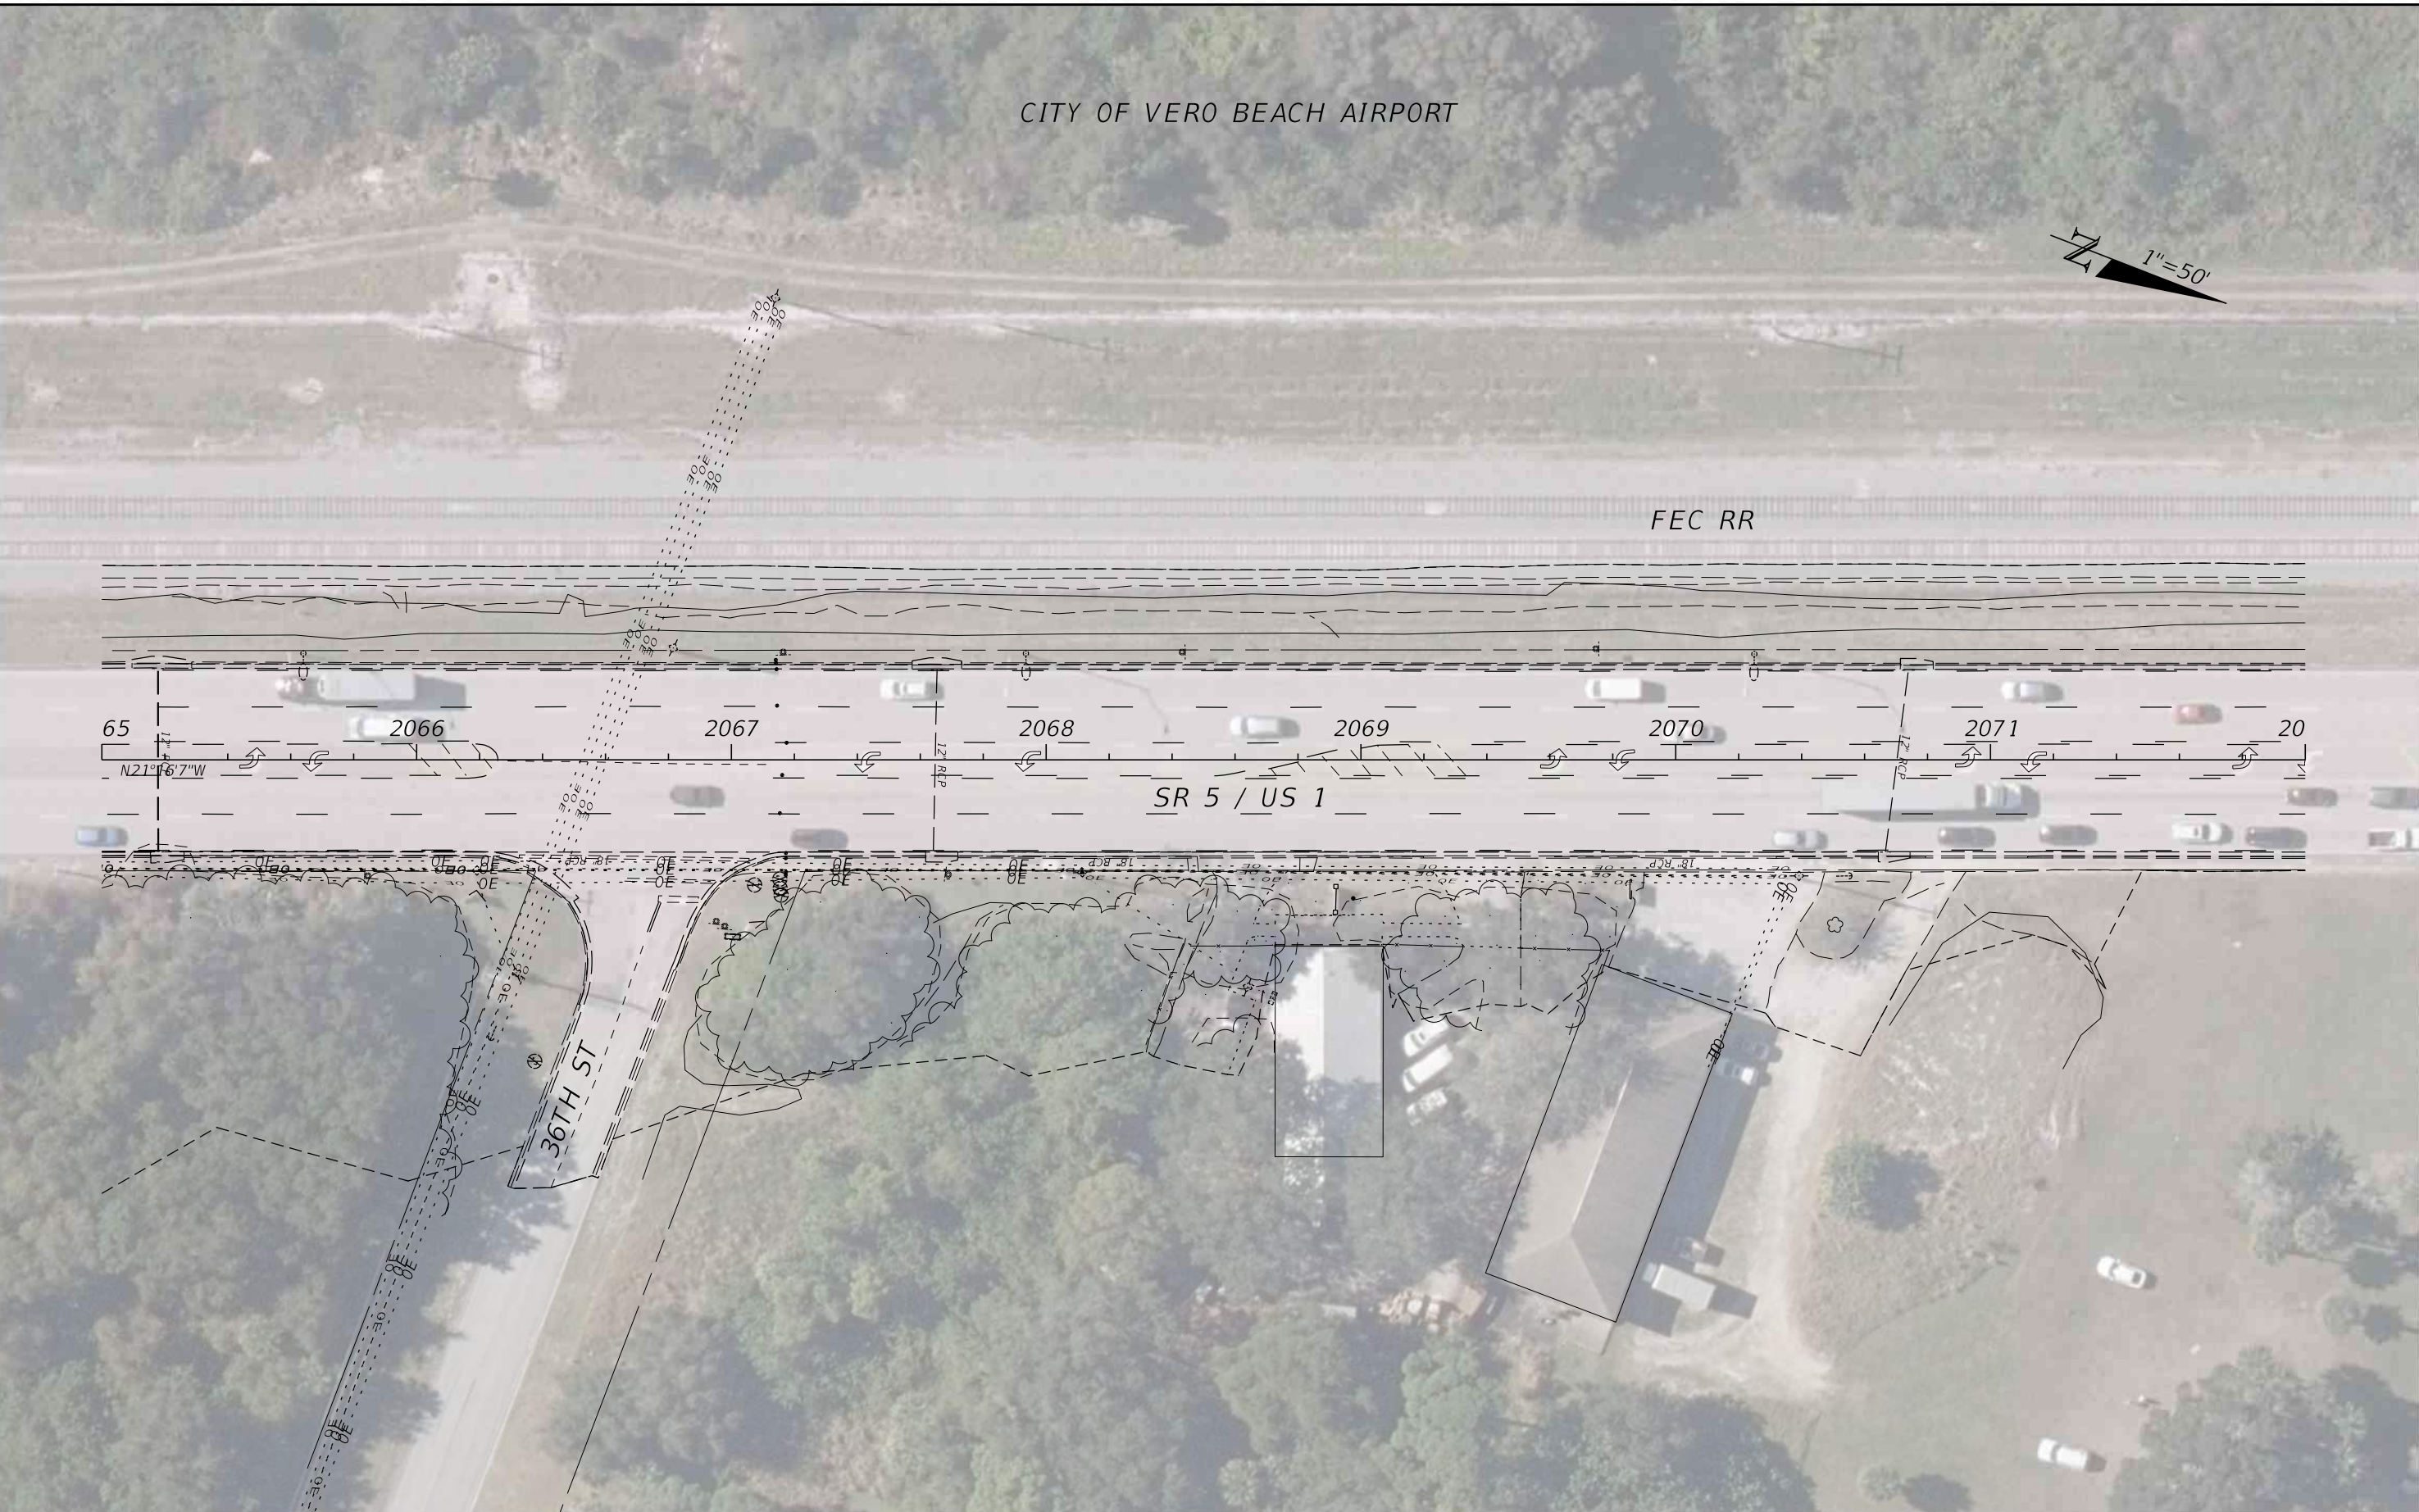

9/15/2022 11:03:42 AM Jacquelyn.Arreaga c:\pwworking\wgn\jacquelyn.arreaga\d2198192\PLANRD01.dgn

REVISIONS		PROFESSIONAL TYPE		STATE OF FLORIDA DEPARTMENT OF TRANSPORTATION			UTILITY CONTACT PLAN (11)	SHEET NO. 11
DATE	DESCRIPTION	DATE	DESCRIPTION	ROAD NO.	COUNTY	FINANCIAL PROJECT ID		
				SR 5	INDIAN RIVER	441693-1-22-02		

WILLIAM EVANS  
 LICENSE NUMBER: 45207  
 WGI, INC.  
 2035 VISTA PARKWAY  
 WEST PALM BEACH, FL 33411

THE OFFICIAL RECORD OF THIS SHEET IS THE ELECTRONIC FILE DIGITALLY SIGNED AND SEALED UNDER RULE 61G15-23.004, F.A.C.

CITY OF VERO BEACH AIRPORT




9/15/2022 11:04:09 AM Jacquelyn.Arreaga c:\pwworking\wg\N\Jacquelyn.arreaga\d2198192\PLANRD01.dgn

REVISIONS		PROFESSIONAL TYPE		STATE OF FLORIDA DEPARTMENT OF TRANSPORTATION			UTILITY CONTACT PLAN (12)	SHEET NO. 12
DATE	DESCRIPTION	DATE	DESCRIPTION	ROAD NO.	COUNTY	FINANCIAL PROJECT ID		
				SR 5	INDIAN RIVER	441693-1-22-02		

WILLIAM EVANS  
 LICENSE NUMBER: 45207  
 WGI, INC.  
 2035 VISTA PARKWAY  
 WEST PALM BEACH, FL 33411

THE OFFICIAL RECORD OF THIS SHEET IS THE ELECTRONIC FILE DIGITALLY SIGNED AND SEALED UNDER RULE 61G15-23.004, F.A.C.

9/15/2022 11:04:36 AM Jacquelyn.Arreaga  
 c:\pwworking\wgn\jacquelyn.arreaga\d2198192\PLANRD01.dgn

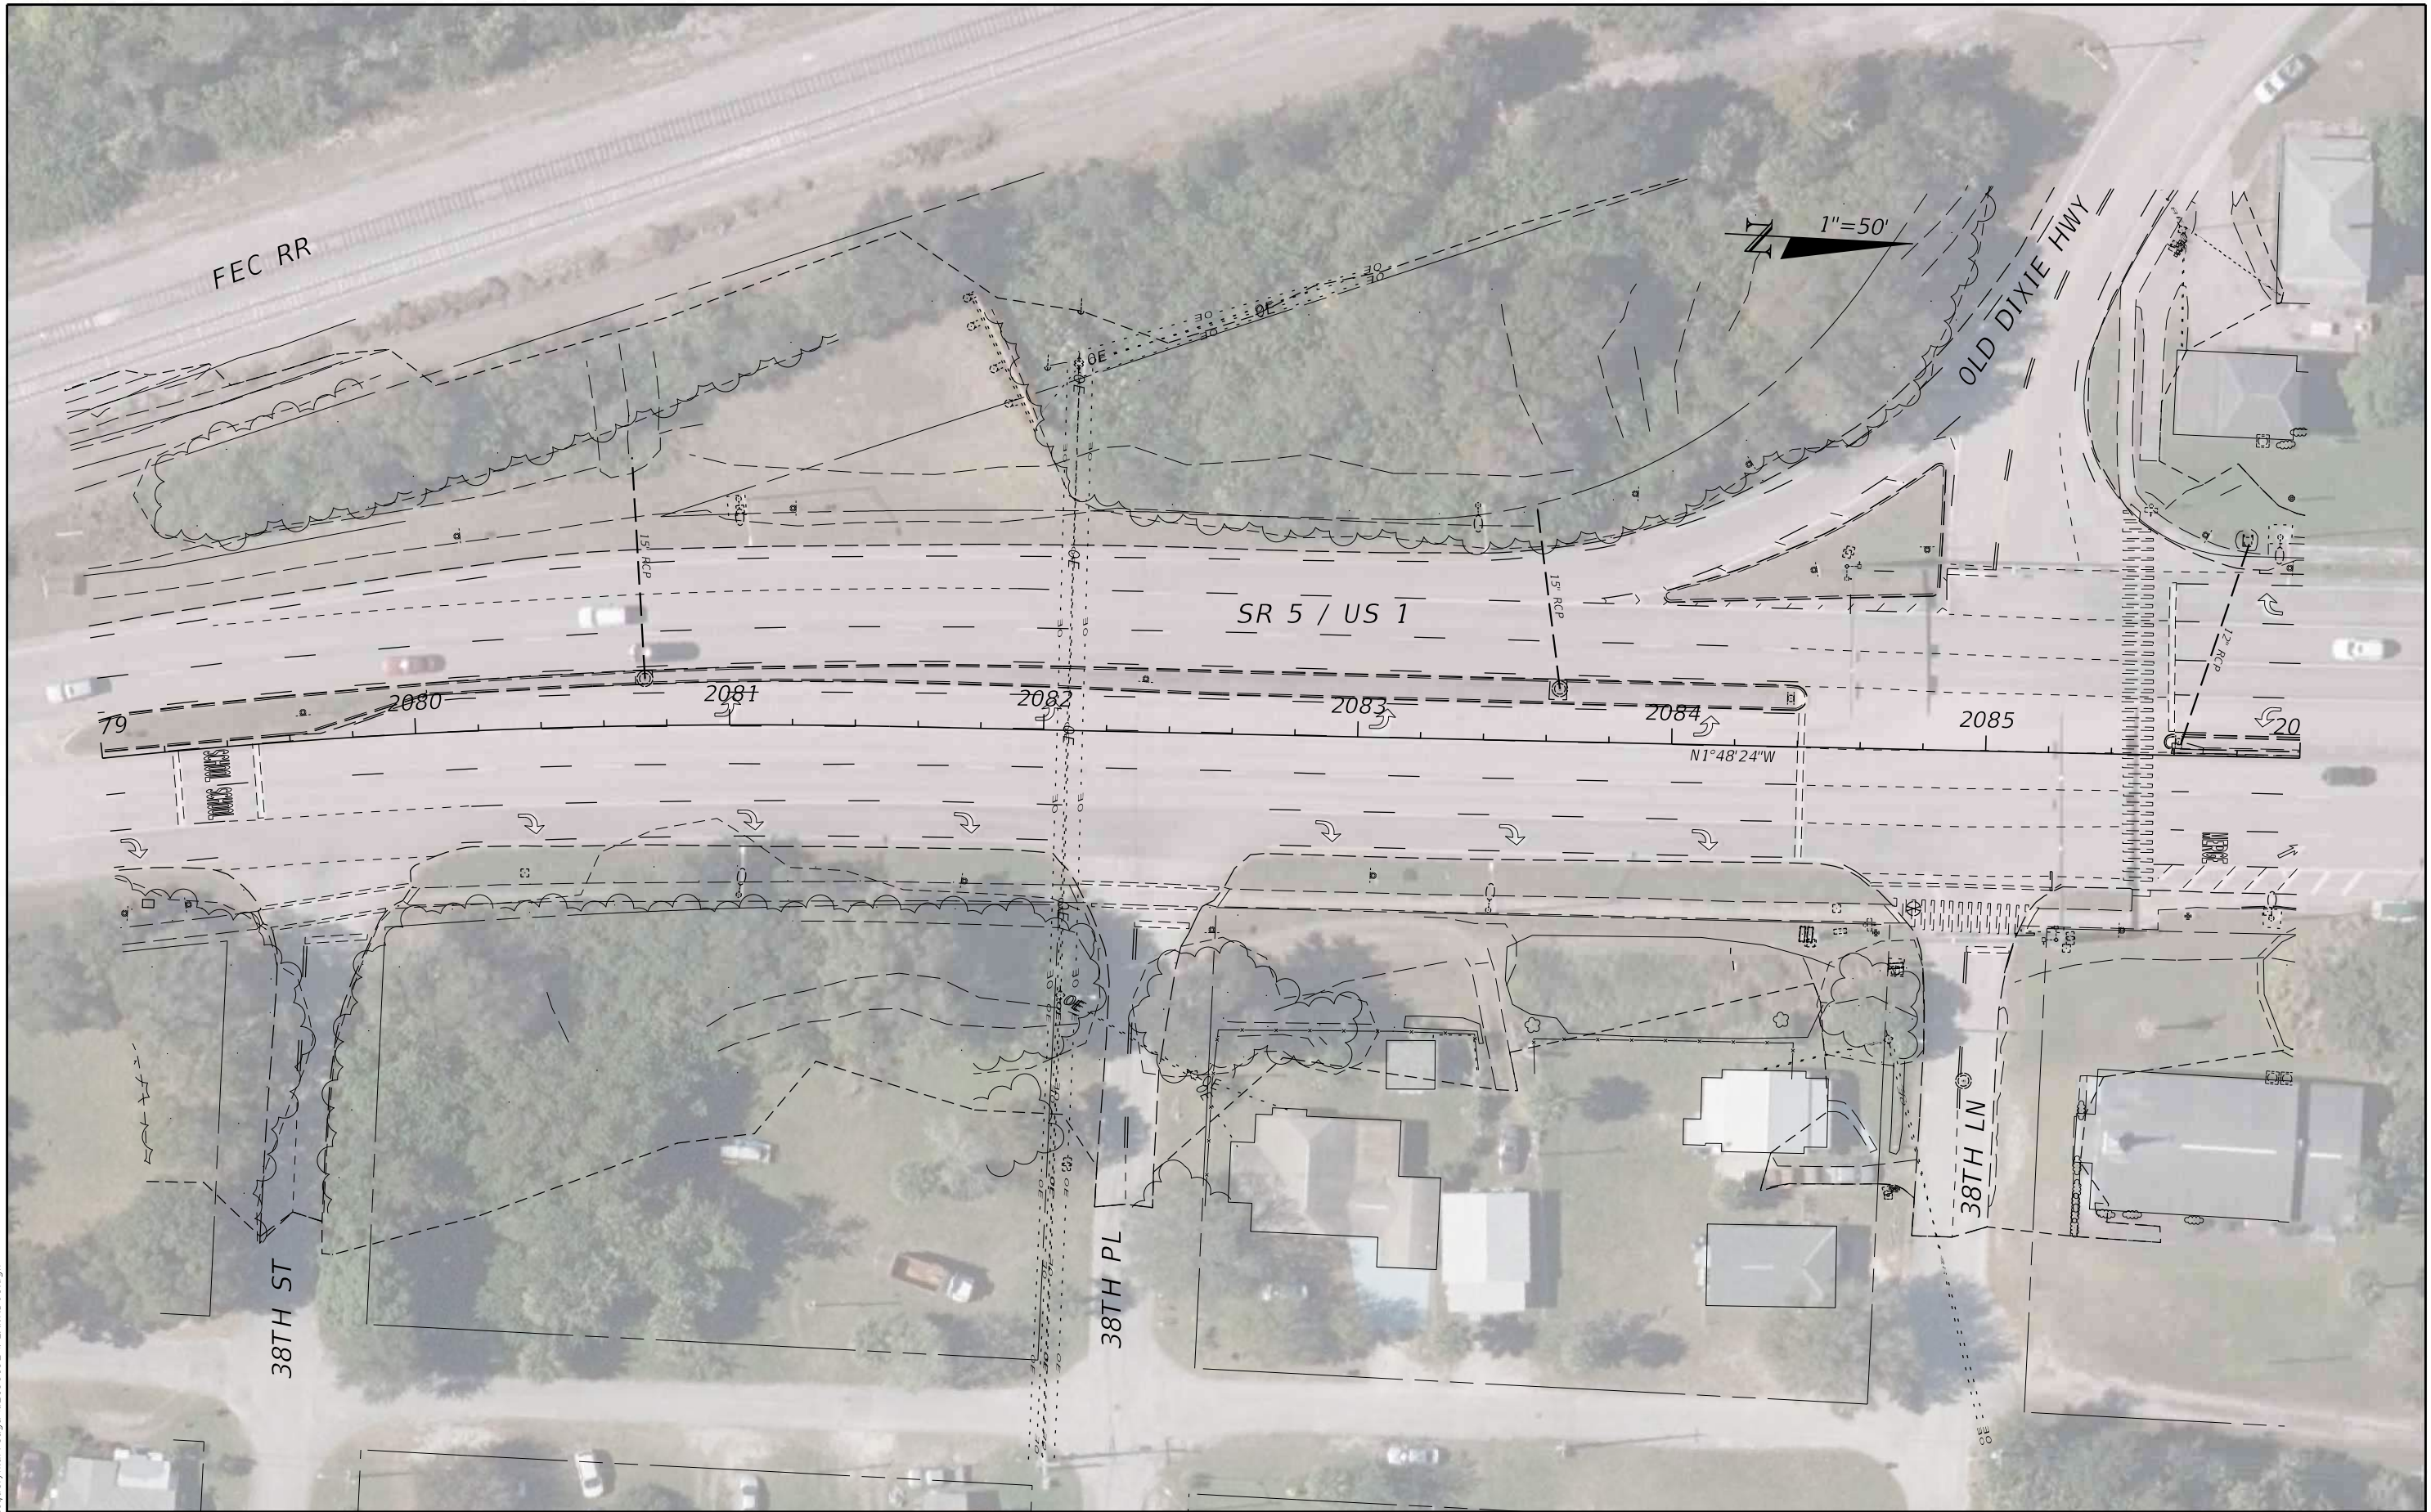

REVISIONS		PROFESSIONAL TYPE		STATE OF FLORIDA DEPARTMENT OF TRANSPORTATION			UTILITY CONTACT PLAN (13)	SHEET NO. 13
DATE	DESCRIPTION	DATE	DESCRIPTION	ROAD NO.	COUNTY	FINANCIAL PROJECT ID		
				SR 5	INDIAN RIVER	441693-1-22-02		

WILLIAM EVANS  
 LICENSE NUMBER: 45207  
 WGI, INC.  
 2035 VISTA PARKWAY  
 WEST PALM BEACH, FL 33411

THE OFFICIAL RECORD OF THIS SHEET IS THE ELECTRONIC FILE DIGITALLY SIGNED AND SEALED UNDER RULE 61G15-23.004, F.A.C.



9/15/2022 11:05:04 AM Jacquelyn.Arreaga  
 c:\pwworking\wgn\jacquelyn.arreaga\d2198192\PLANRD01.dgn

REVISIONS			
DATE	DESCRIPTION	DATE	DESCRIPTION

PROFESSIONAL TYPE  
 WILLIAM EVANS  
 LICENSE NUMBER: 45207  
 WGI, INC.  
 2035 VISTA PARKWAY  
 WEST PALM BEACH, FL 33411

STATE OF FLORIDA DEPARTMENT OF TRANSPORTATION		
ROAD NO.	COUNTY	FINANCIAL PROJECT ID
SR 5	INDIAN RIVER	441693-1-22-02

**UTILITY CONTACT PLAN (14)**  
 SHEET NO.  
 14

THE OFFICIAL RECORD OF THIS SHEET IS THE ELECTRONIC FILE DIGITALLY SIGNED AND SEALED UNDER RULE 61G15-23.004, F.A.C.



93      2094      2095      2096      2097      2098      2099      21

N15°6'28"W

SR 5 / US 1

9/15/2022 11:05:51 AM Jacquelyn.Arreaga c:\pwworking\wgn\jacquelyn.arreaga\d2198192\PLANRD01.dgn

REVISIONS				PROFESSIONAL TYPE	STATE OF FLORIDA DEPARTMENT OF TRANSPORTATION			UTILITY CONTACT PLAN (15)	SHEET NO.
DATE	DESCRIPTION	DATE	DESCRIPTION	WILLIAM EVANS LICENSE NUMBER: 45207 WGI, INC. 2035 VISTA PARKWAY WEST PALM BEACH, FL 33411	ROAD NO.	COUNTY	FINANCIAL PROJECT ID		15
						SR 5	INDIAN RIVER		441693-1-22-02

THE OFFICIAL RECORD OF THIS SHEET IS THE ELECTRONIC FILE DIGITALLY SIGNED AND SEALED UNDER RULE 61G15-23.004, F.A.C.




9/15/2022 11:06:09 AM Jacquelyn.Arreaga  
 c:\pwworking\wg\N\jacquelyn.arreaga\d2198192\PLANRD01.dgn

REVISIONS				PROFESSIONAL TYPE	STATE OF FLORIDA DEPARTMENT OF TRANSPORTATION			UTILITY CONTACT PLAN (16)	SHEET NO.
DATE	DESCRIPTION	DATE	DESCRIPTION		ROAD NO.	COUNTY	FINANCIAL PROJECT ID		
				WILLIAM EVANS LICENSE NUMBER: 45207 WGI, INC. 2035 VISTA PARKWAY WEST PALM BEACH, FL 33411	SR 5	INDIAN RIVER	441693-1-22-02	16	

THE OFFICIAL RECORD OF THIS SHEET IS THE ELECTRONIC FILE DIGITALLY SIGNED AND SEALED UNDER RULE 61G15-23.004, F.A.C.



SEE SHEET 6

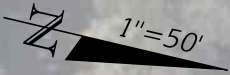

MAIN CANAL

30TH ST

13TH AVE

31ST ST

9/15/2022 11:06:48 AM Jacquelyn.Arreaga  
 c:\pwworking\wg\Jacquelyn.arreaga\d2198192\PLANRD01.dgn

REVISIONS				PROFESSIONAL TYPE	STATE OF FLORIDA DEPARTMENT OF TRANSPORTATION			UTILITY CONTACT PLAN (17)	SHEET NO. 17
DATE	DESCRIPTION	DATE	DESCRIPTION		ROAD NO.	COUNTY	FINANCIAL PROJECT ID		
				WILLIAM EVANS LICENSE NUMBER: 45207 WGI, INC. 2035 VISTA PARKWAY WEST PALM BEACH, FL 33411	SR 5	INDIAN RIVER	441693-1-22-02		

THE OFFICIAL RECORD OF THIS SHEET IS THE ELECTRONIC FILE DIGITALLY SIGNED AND SEALED UNDER RULE 61G15-23.004, F.A.C.




9/15/2022 11:07:02 AM Jacquelyn.Arreaga  
 c:\pwworking\wgn\jacquelyn.arreaga\d2198192\PLANRD01.dgn

DATE		REVISIONS		PROFESSIONAL TYPE	STATE OF FLORIDA DEPARTMENT OF TRANSPORTATION			UTILITY CONTACT PLAN (18)	SHEET NO.
DATE	DESCRIPTION	DATE	DESCRIPTION		ROAD NO.	COUNTY	FINANCIAL PROJECT ID		
				WILLIAM EVANS LICENSE NUMBER: 45207 WGI, INC. 2035 VISTA PARKWAY WEST PALM BEACH, FL 33411	SR 5	INDIAN RIVER	441693-1-22-02	6	

THE OFFICIAL RECORD OF THIS SHEET IS THE ELECTRONIC FILE DIGITALLY SIGNED AND SEALED UNDER RULE 61G15-23.004, F.A.C.



SEE SHEET 8

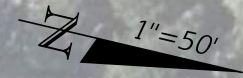

SEE SHEET 18

SEE SHEET 20

9/15/2022 11:17:13 AM Jacquelyn.Arreaga  
 c:\pwworking\wgn\jacquelyn.arreaga\d2198192\PLANRD01.dgn

REVISIONS				PROFESSIONAL TYPE	STATE OF FLORIDA DEPARTMENT OF TRANSPORTATION			UTILITY CONTACT PLAN (19)	SHEET NO.
DATE	DESCRIPTION	DATE	DESCRIPTION	ROAD NO.	COUNTY	FINANCIAL PROJECT ID	19		
				WILLIAM EVANS LICENSE NUMBER: 45207 WGI, INC. 2035 VISTA PARKWAY WEST PALM BEACH, FL 33411	SR 5	INDIAN RIVER	441693-1-22-02		

THE OFFICIAL RECORD OF THIS SHEET IS THE ELECTRONIC FILE DIGITALLY SIGNED AND SEALED UNDER RULE 61G15-23.004, F.A.C.

SEE SHEET 9




SEE SHEET 19



9/15/2022 11:17:26 AM Jacquelyn.Arreaga  
 c:\pwworking\wgn\jacquelyn.arreaga\d2198192\PLANRD01.dgn

REVISIONS				PROFESSIONAL TYPE	STATE OF FLORIDA DEPARTMENT OF TRANSPORTATION			UTILITY CONTACT PLAN (20)	SHEET NO.
DATE	DESCRIPTION	DATE	DESCRIPTION	WILLIAM EVANS LICENSE NUMBER: 45207 WGI, INC. 2035 VISTA PARKWAY WEST PALM BEACH, FL 33411	ROAD NO.	COUNTY	FINANCIAL PROJECT ID		20
					SR 5	INDIAN RIVER	441693-1-22-02		

THE OFFICIAL RECORD OF THIS SHEET IS THE ELECTRONIC FILE DIGITALLY SIGNED AND SEALED UNDER RULE 61G15-23.004, F.A.C.

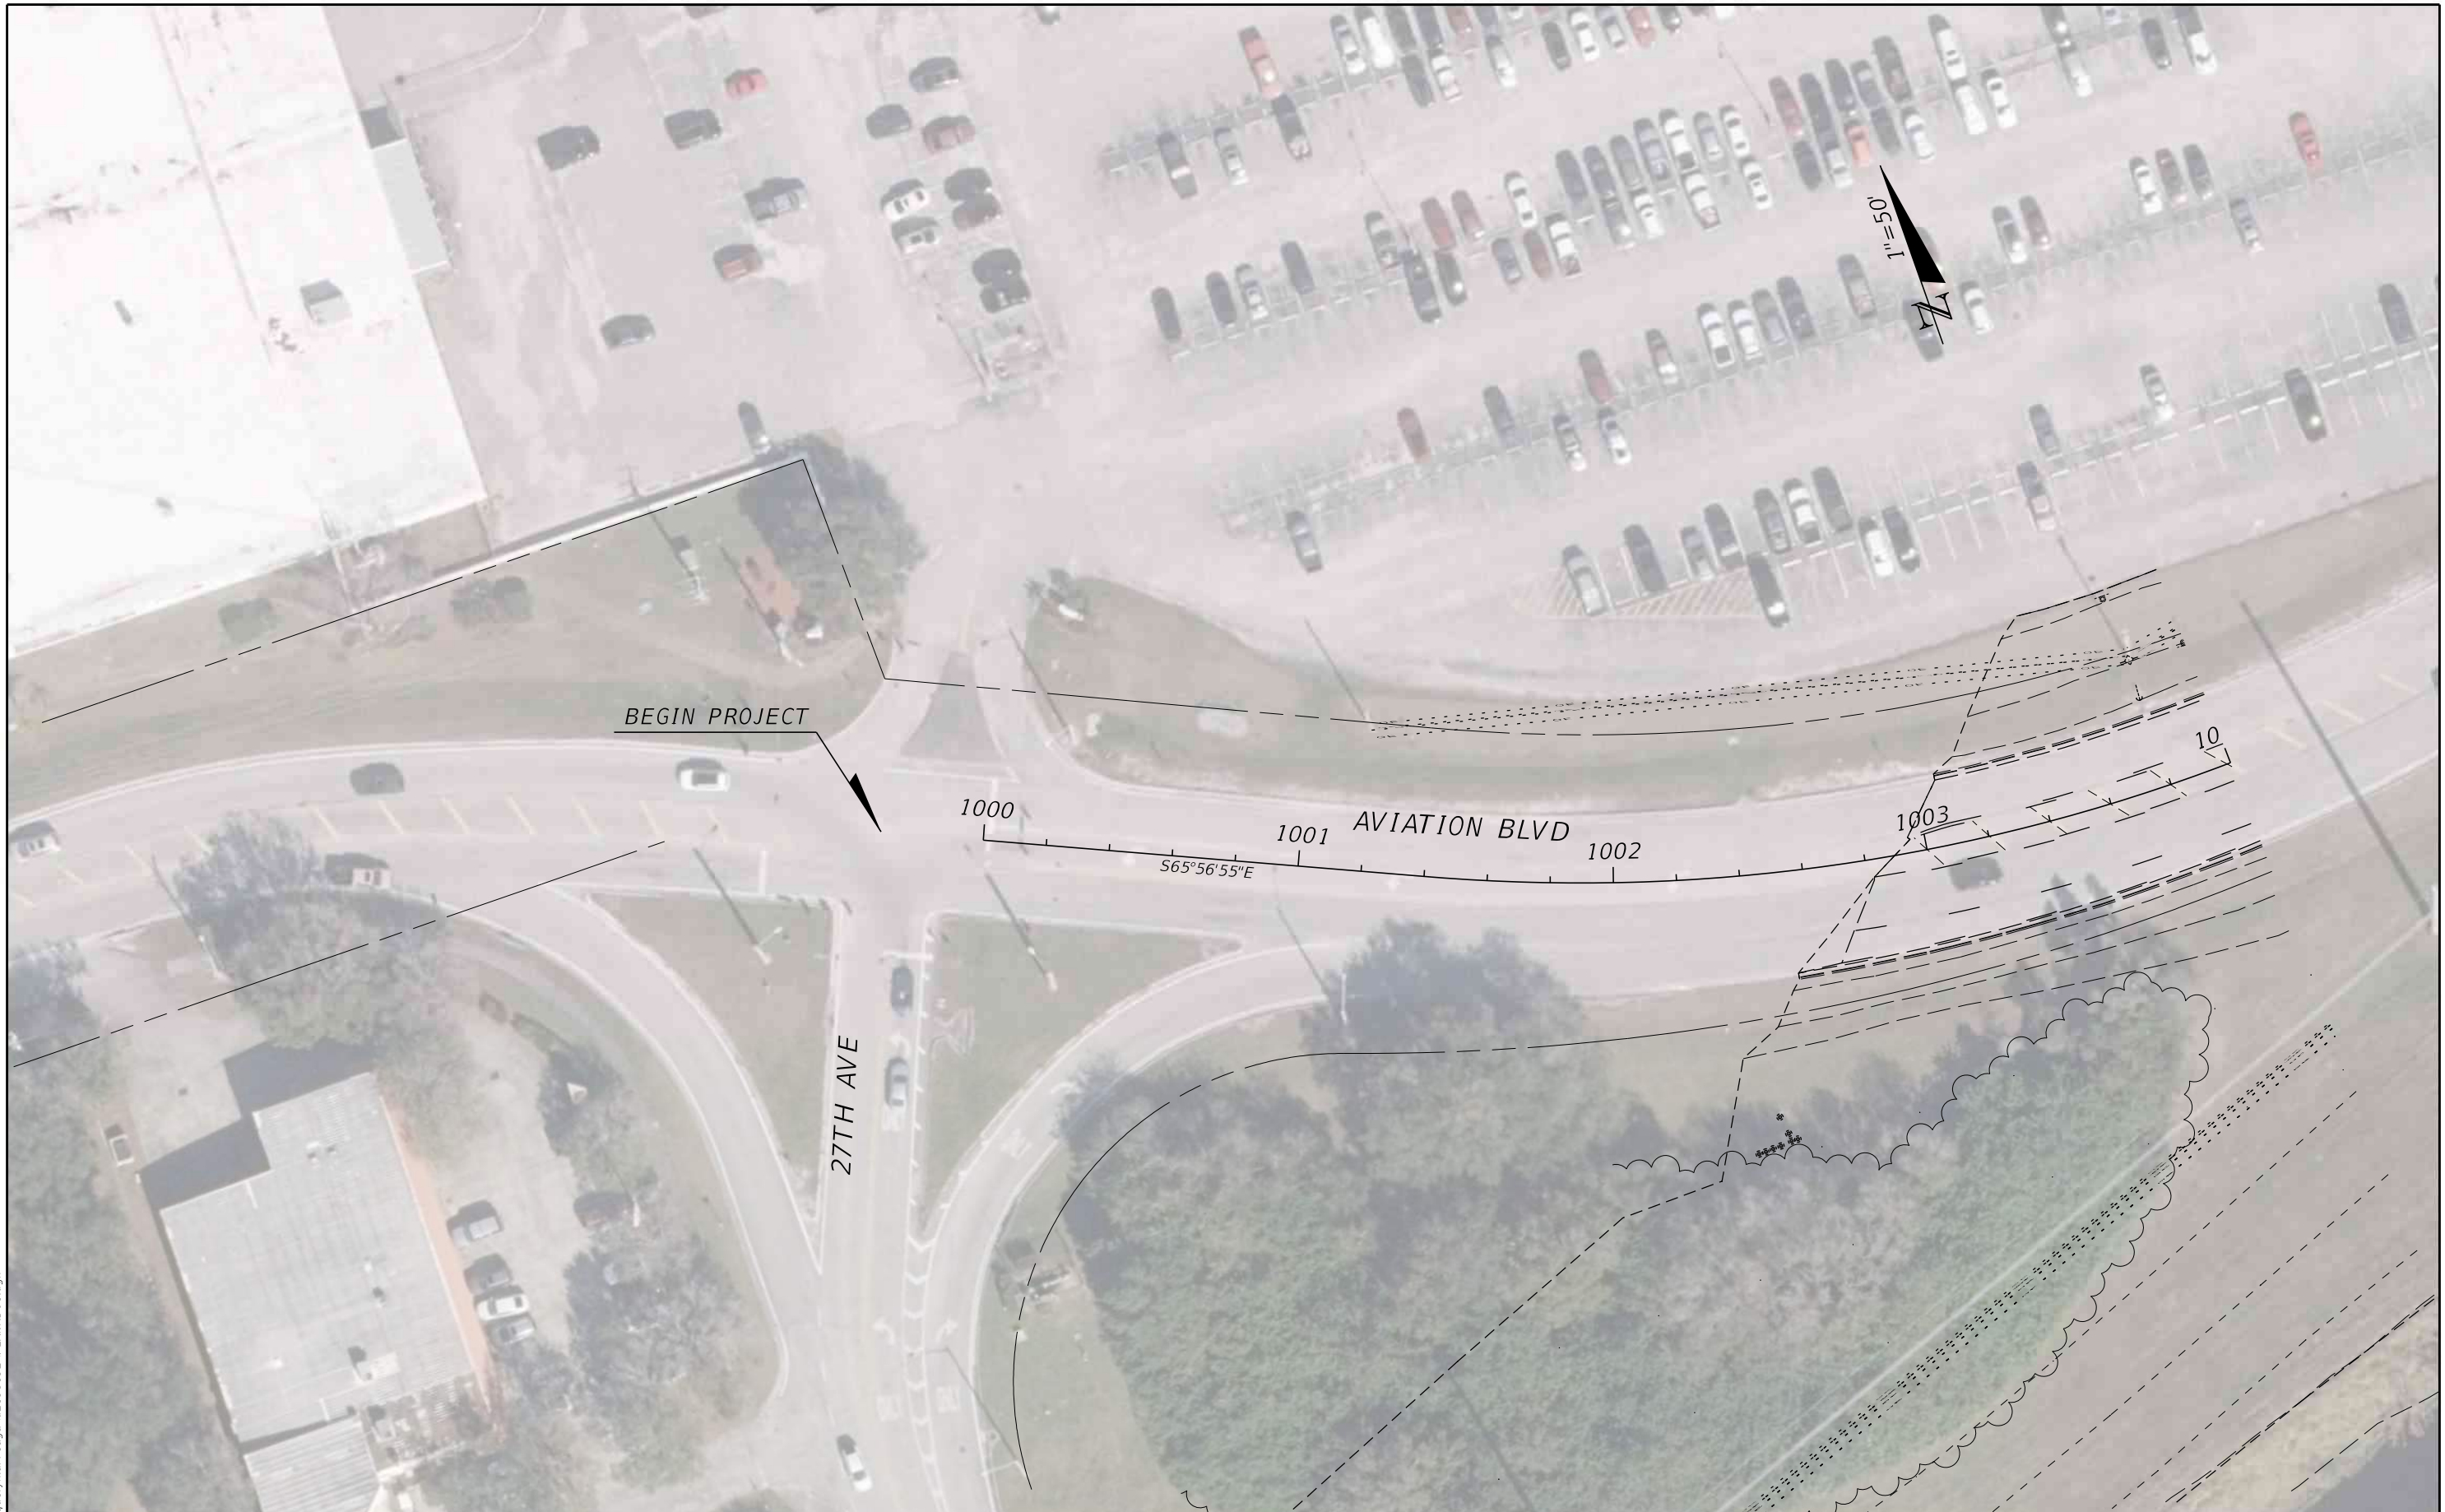

BEGIN PROJECT

27TH AVE

1000 1001 AVIATION BLVD 1002 1003

565°56'55\"/>


10

9/15/2022 11:07:58 AM Jacquelyn.Arreaga c:\pwworking\wgn\jacquelyn.arreaga\d2198192\PLAN\RD01.dgn

REVISIONS		PROFESSIONAL TYPE		STATE OF FLORIDA DEPARTMENT OF TRANSPORTATION			UTILITY CONTACT PLAN (21)	SHEET NO. 21
DATE	DESCRIPTION	DATE	DESCRIPTION	ROAD NO.	COUNTY	FINANCIAL PROJECT ID		
				SR 5	INDIAN RIVER	441693-1-22-02		

WILLIAM EVANS  
LICENSE NUMBER: 45207  
WGI, INC.  
2035 VISTA PARKWAY  
WEST PALM BEACH, FL 33411

THE OFFICIAL RECORD OF THIS SHEET IS THE ELECTRONIC FILE DIGITALLY SIGNED AND SEALED UNDER RULE 61G15-23.004, F.A.C.

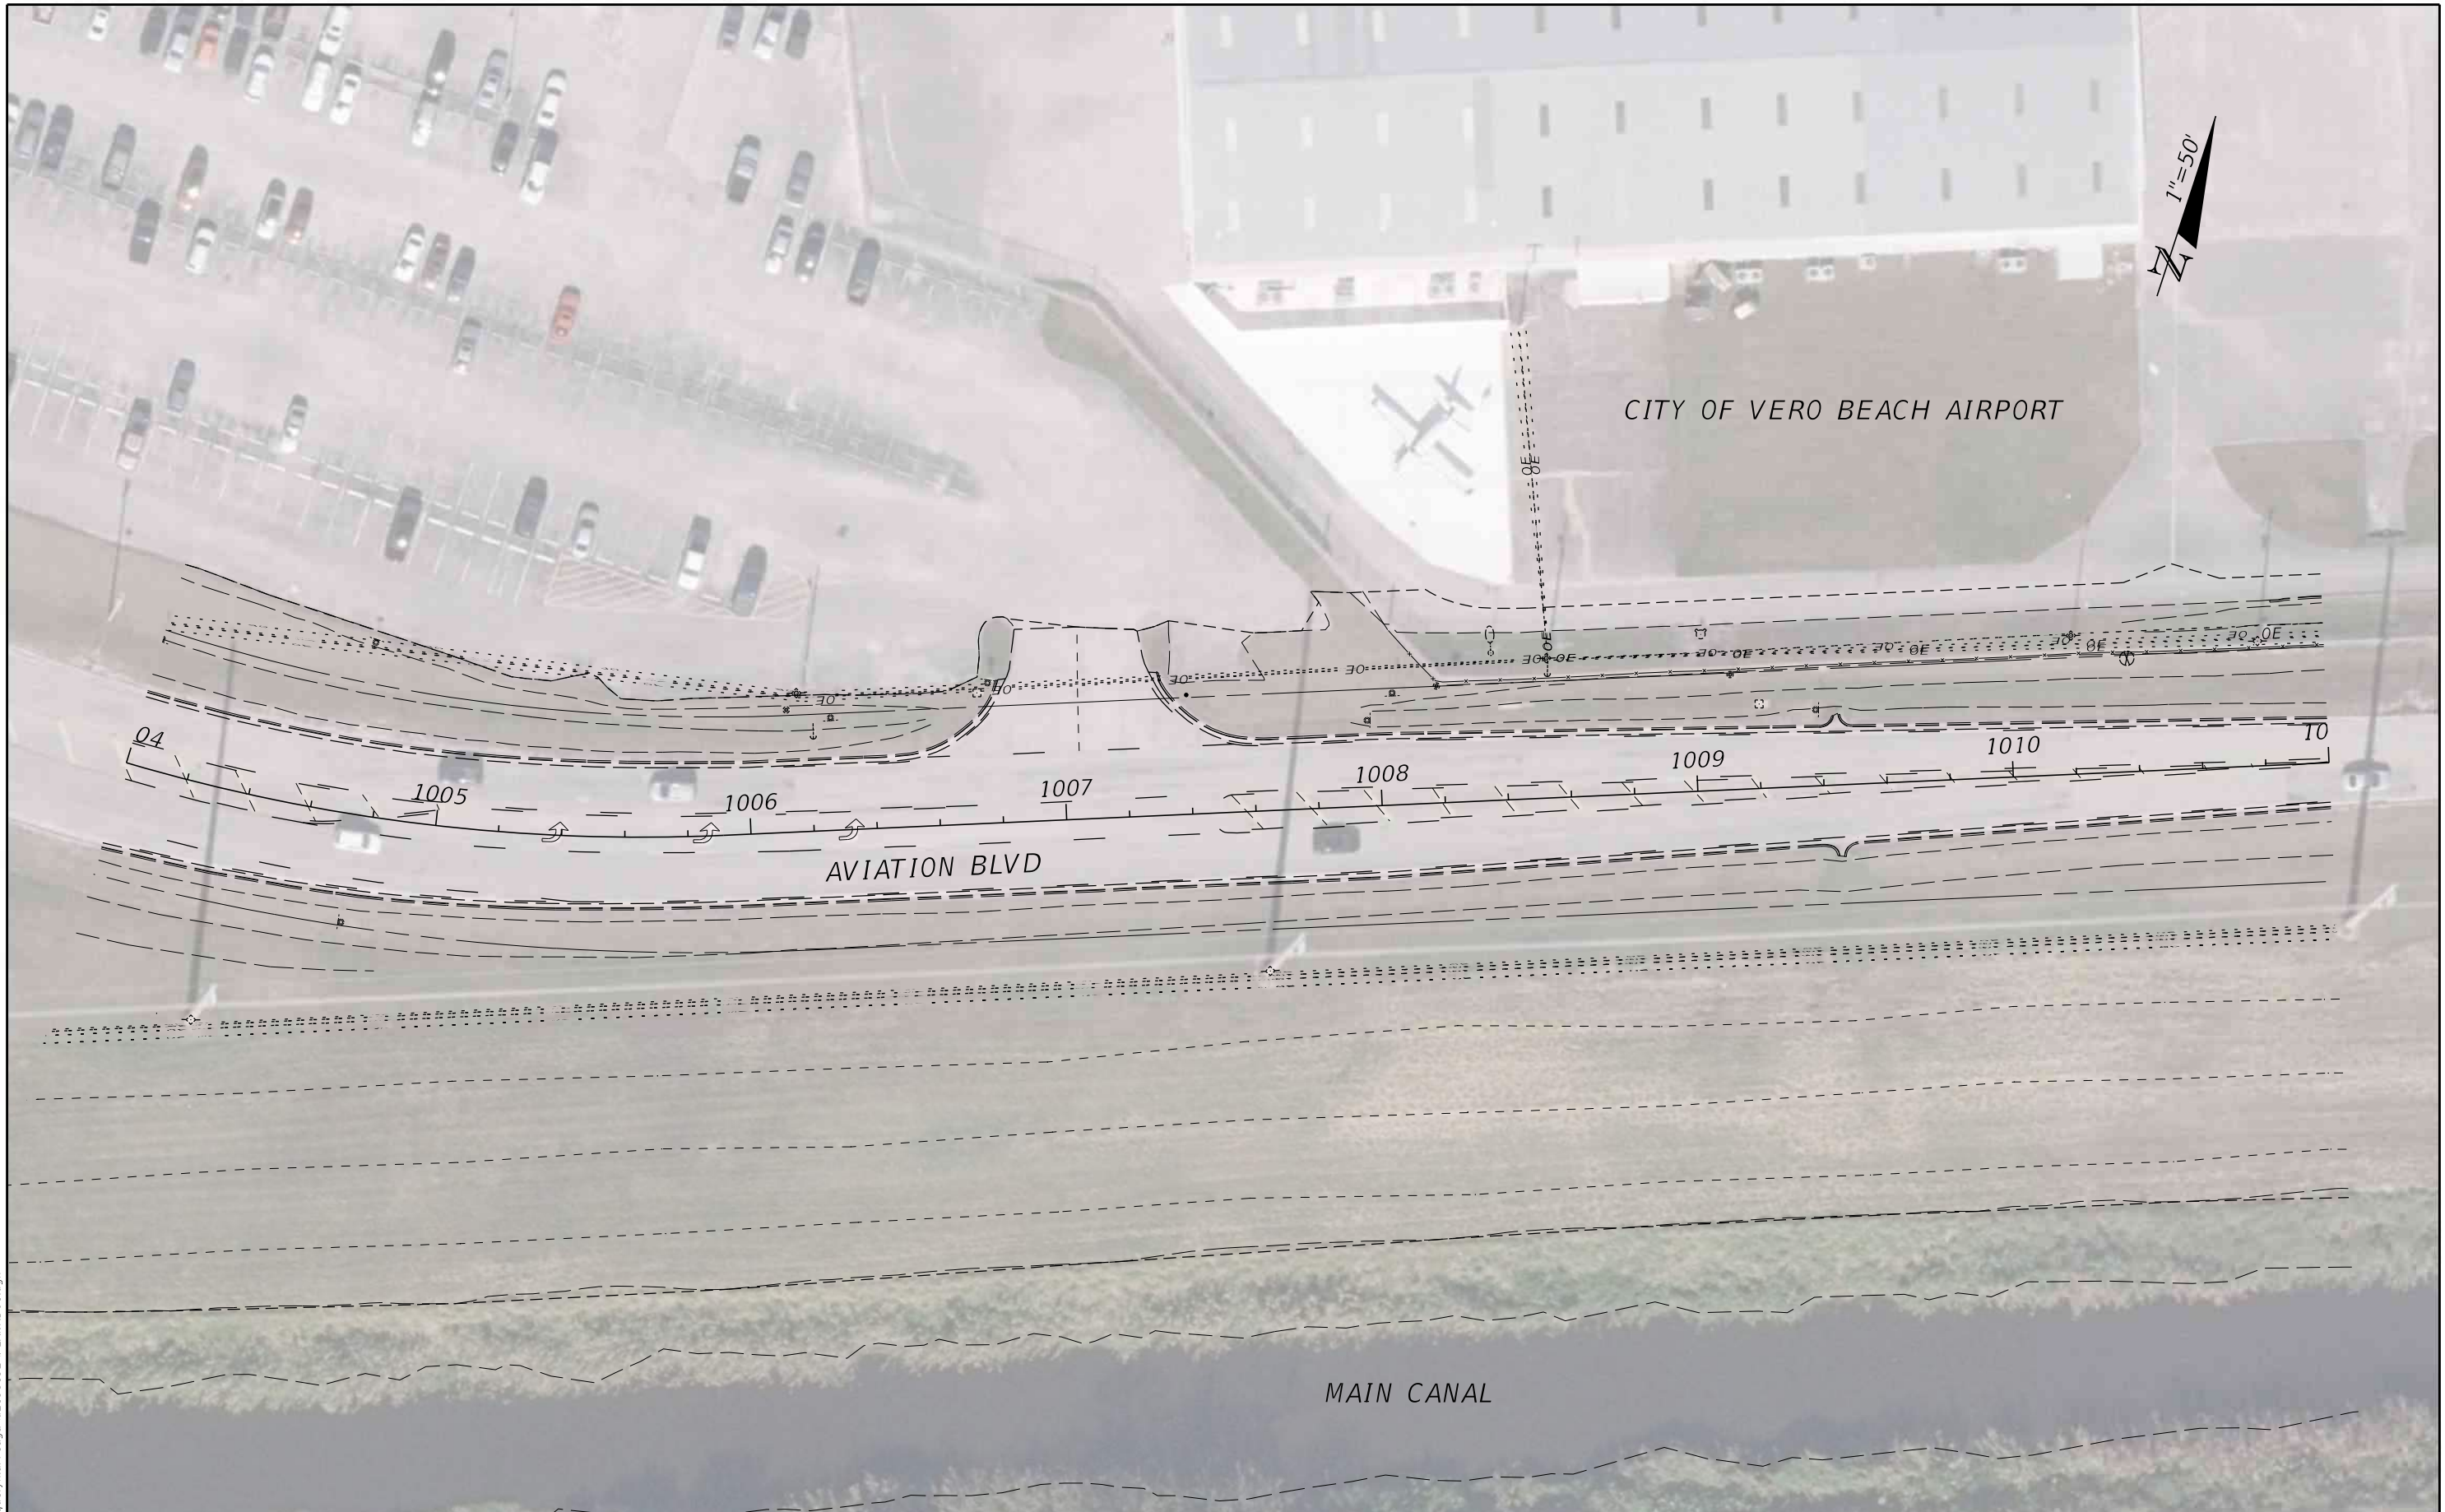

9/15/2022 11:08:27 AM Jacquelyn.Arreaga  
 c:\pwworking\wgn\jacquelyn.arreaga\d2198192\PLANRD01.dgn


THE OFFICIAL RECORD OF THIS SHEET IS THE ELECTRONIC FILE DIGITALLY SIGNED AND SEALED UNDER RULE 61G15-23.004, F.A.C.

REVISIONS		PROFESSIONAL TYPE		STATE OF FLORIDA DEPARTMENT OF TRANSPORTATION			UTILITY CONTACT PLAN (22)	SHEET NO. 22
DATE	DESCRIPTION	DATE	DESCRIPTION	ROAD NO.	COUNTY	FINANCIAL PROJECT ID		
				SR 5	INDIAN RIVER	441693-1-22-02		

WILLIAM EVANS  
 LICENSE NUMBER: 45207  
 WGI, INC.  
 2035 VISTA PARKWAY  
 WEST PALM BEACH, FL 33411



CITY OF VERO BEACH AIRPORT

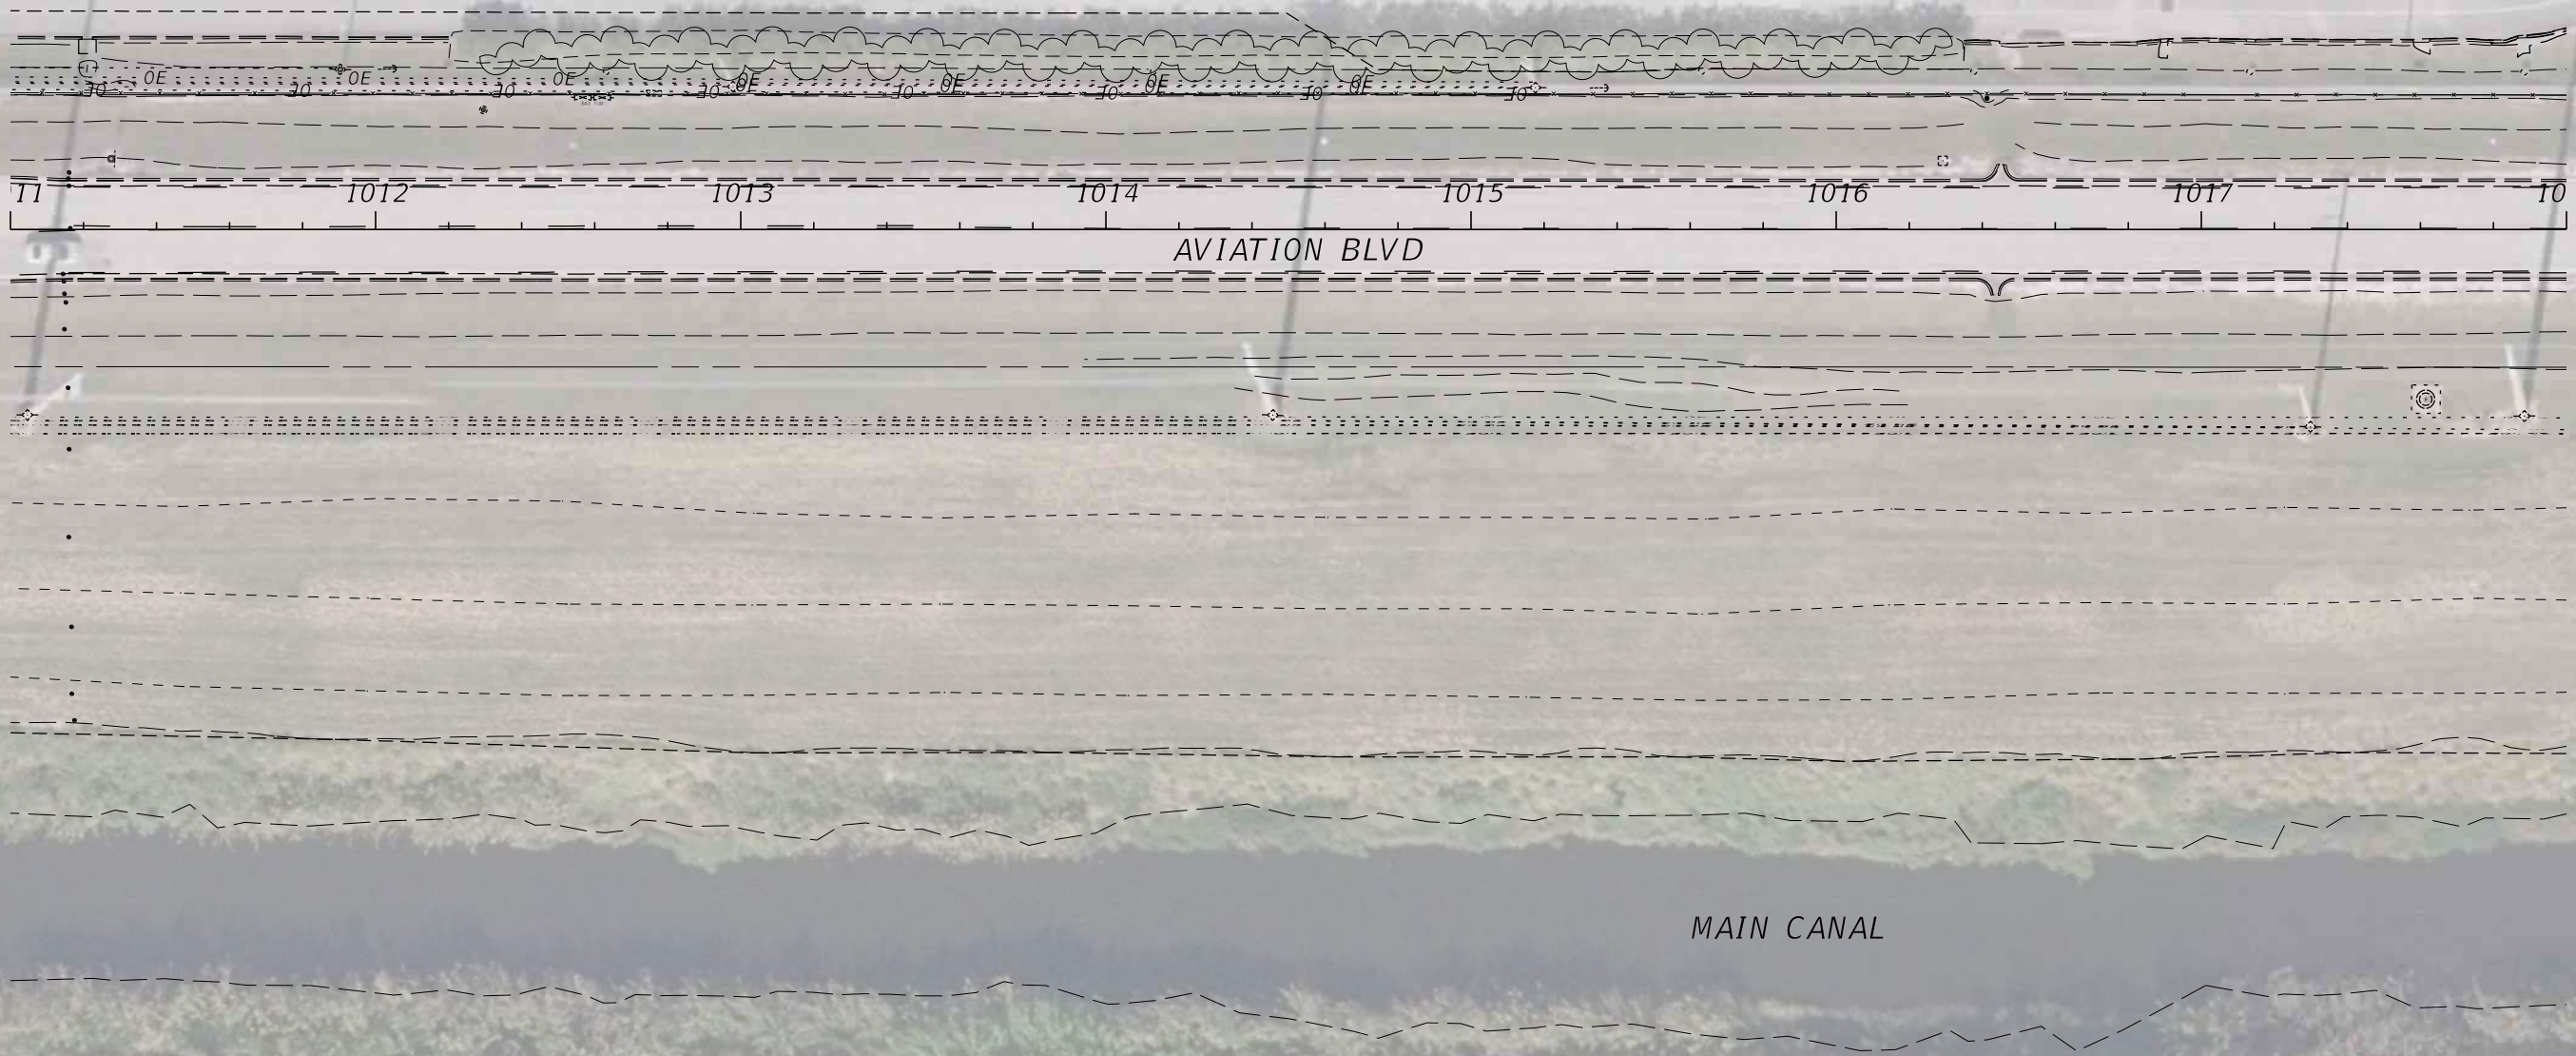


9/15/2022 11:08:39 AM Jacquelyn.Arreaga c:\pwworking\wgn\jacquelyn.arreaga\d2198192\PLANRD01.dgn

REVISIONS				PROFESSIONAL TYPE	STATE OF FLORIDA DEPARTMENT OF TRANSPORTATION			UTILITY CONTACT PLAN (23)	SHEET NO. 23
DATE	DESCRIPTION	DATE	DESCRIPTION		ROAD NO.	COUNTY	FINANCIAL PROJECT ID		
				WILLIAM EVANS LICENSE NUMBER: 45207 WGI, INC. 2035 VISTA PARKWAY WEST PALM BEACH, FL 33411	SR 5	INDIAN RIVER	441693-1-22-02		

THE OFFICIAL RECORD OF THIS SHEET IS THE ELECTRONIC FILE DIGITALLY SIGNED AND SEALED UNDER RULE 61G15-23.004, F.A.C.



CITY OF VERO BEACH AIRPORT

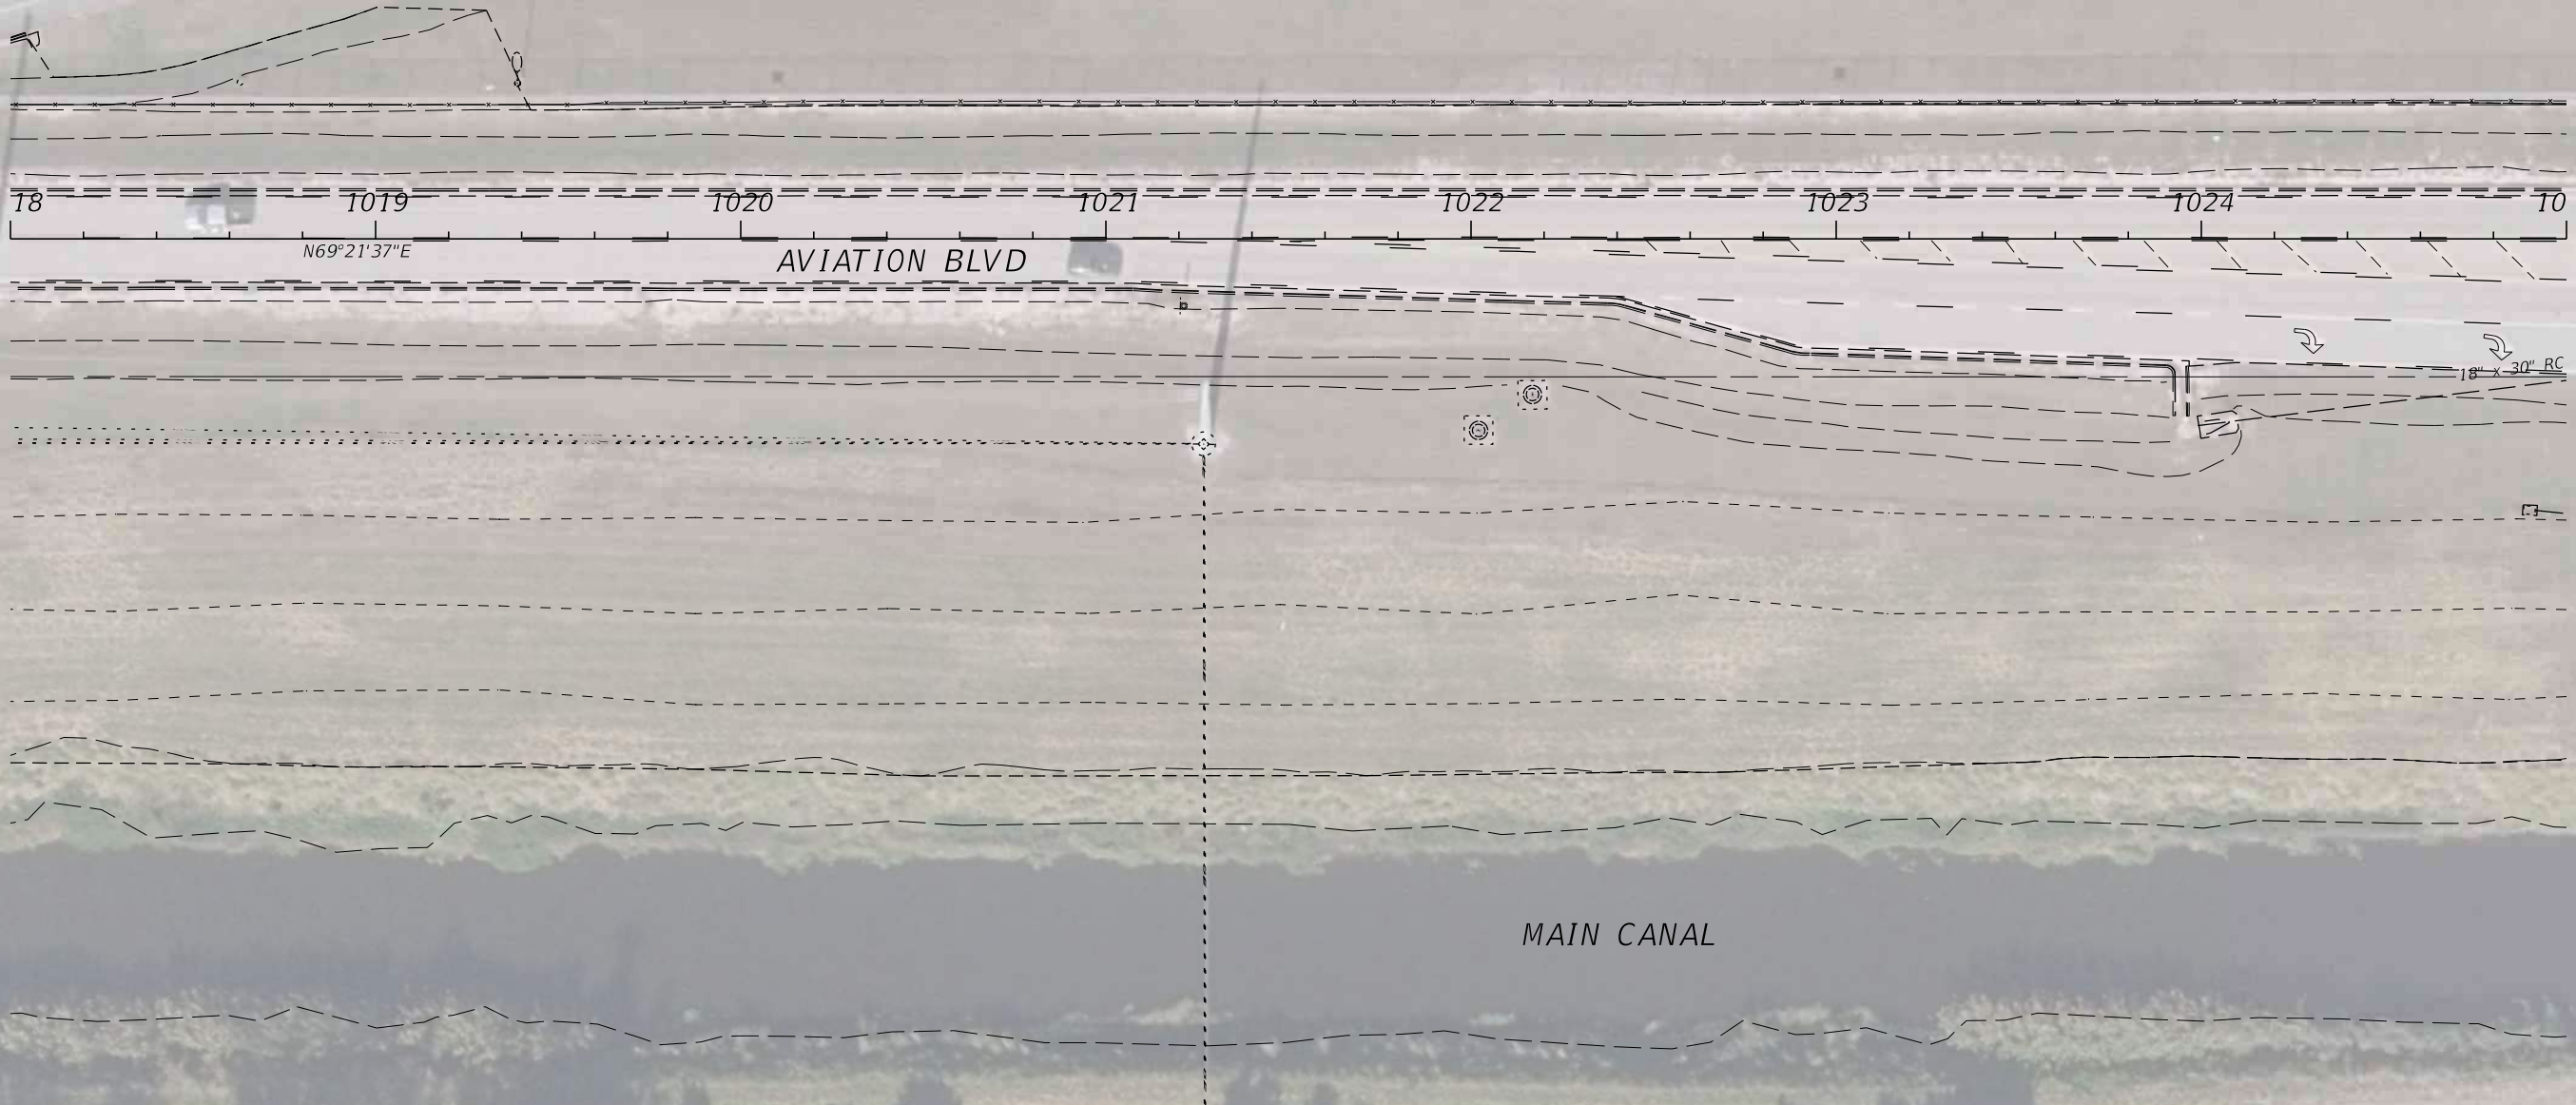


9/15/2022 11:08:55 AM Jacquelyn.Arreaga c:\pwworking\wgn\jacquelyn.arreaga\d2198192\PLANRD01.dgn

REVISIONS				PROFESSIONAL TYPE	STATE OF FLORIDA DEPARTMENT OF TRANSPORTATION			UTILITY CONTACT PLAN (24)	SHEET NO. 24
DATE	DESCRIPTION	DATE	DESCRIPTION		ROAD NO.	COUNTY	FINANCIAL PROJECT ID		
				WILLIAM EVANS LICENSE NUMBER: 45207 WGI, INC. 2035 VISTA PARKWAY WEST PALM BEACH, FL 33411	SR 5	INDIAN RIVER	441693-1-22-02		

THE OFFICIAL RECORD OF THIS SHEET IS THE ELECTRONIC FILE DIGITALLY SIGNED AND SEALED UNDER RULE 61G15-23.004, F.A.C.

CITY OF VERO BEACH AIRPORT

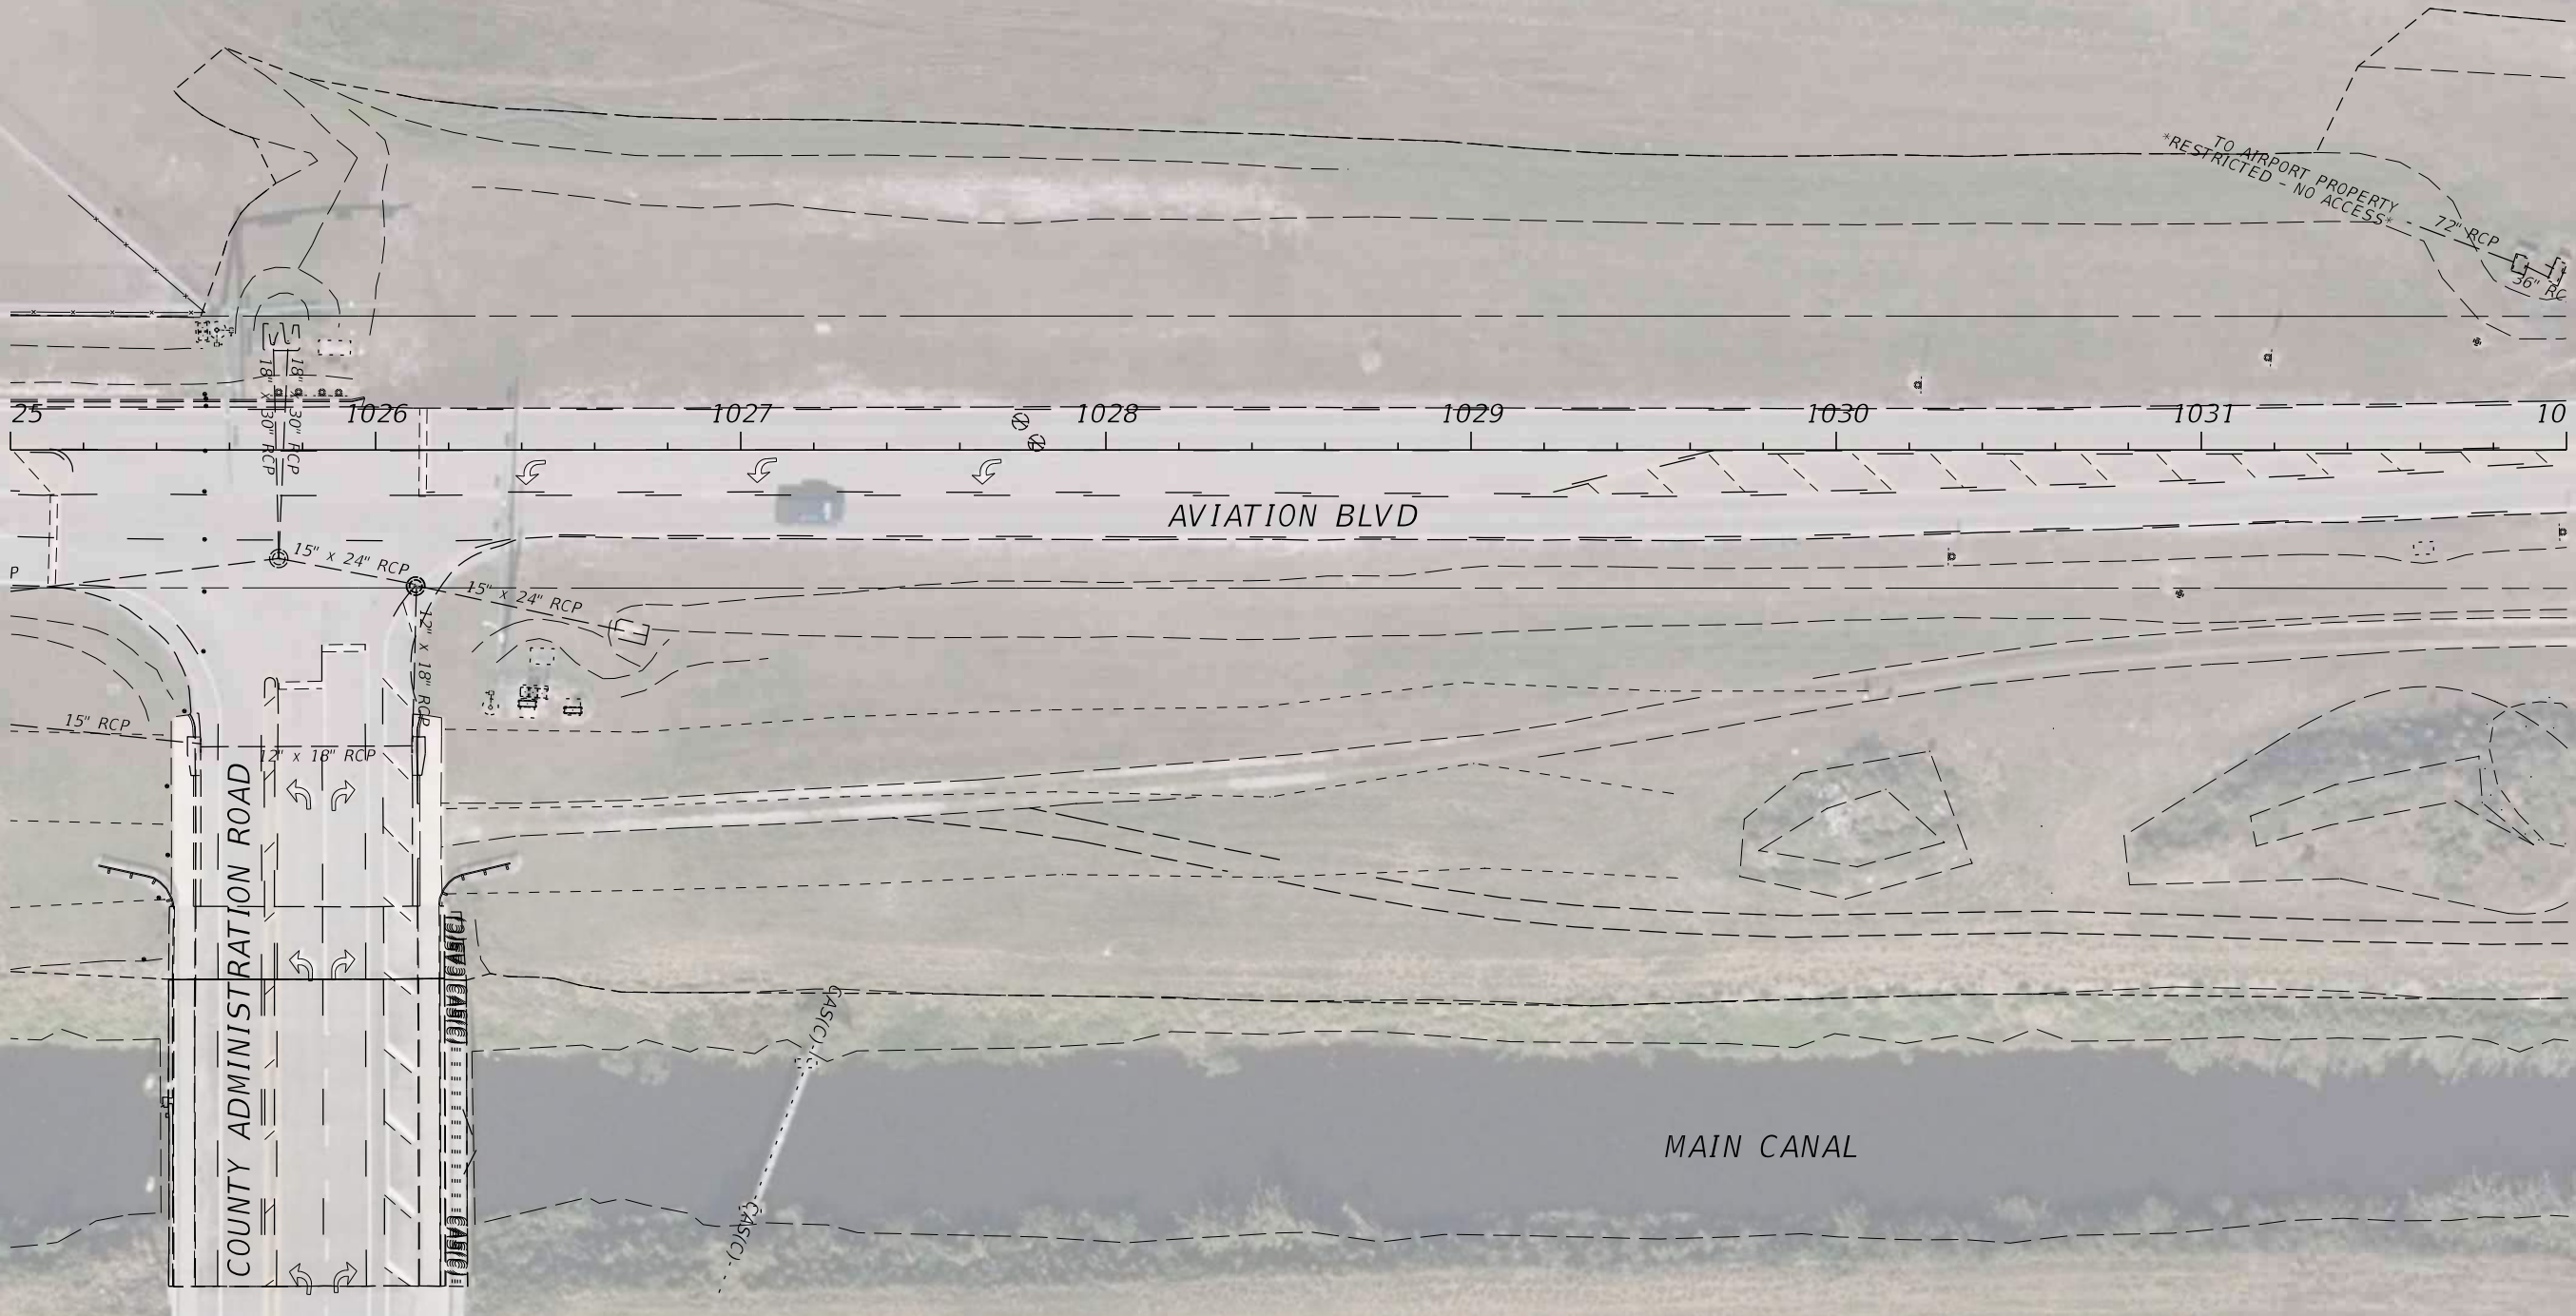


9/15/2022 11:09:17 AM Jacquelyn.Arreaga c:\pwworking\wgn\jacquelyn.arreaga\d2198192\PLAN\RD01.dgn

REVISIONS		PROFESSIONAL TYPE		STATE OF FLORIDA DEPARTMENT OF TRANSPORTATION			UTILITY CONTACT PLAN (25)	SHEET NO. 25
DATE	DESCRIPTION	DATE	DESCRIPTION	ROAD NO.	COUNTY	FINANCIAL PROJECT ID		
				SR 5	INDIAN RIVER	441693-1-22-02		

WILLIAM EVANS  
LICENSE NUMBER: 45207  
WGI, INC.  
2035 VISTA PARKWAY  
WEST PALM BEACH, FL 33411

THE OFFICIAL RECORD OF THIS SHEET IS THE ELECTRONIC FILE DIGITALLY SIGNED AND SEALED UNDER RULE 61G15-23.004, F.A.C.

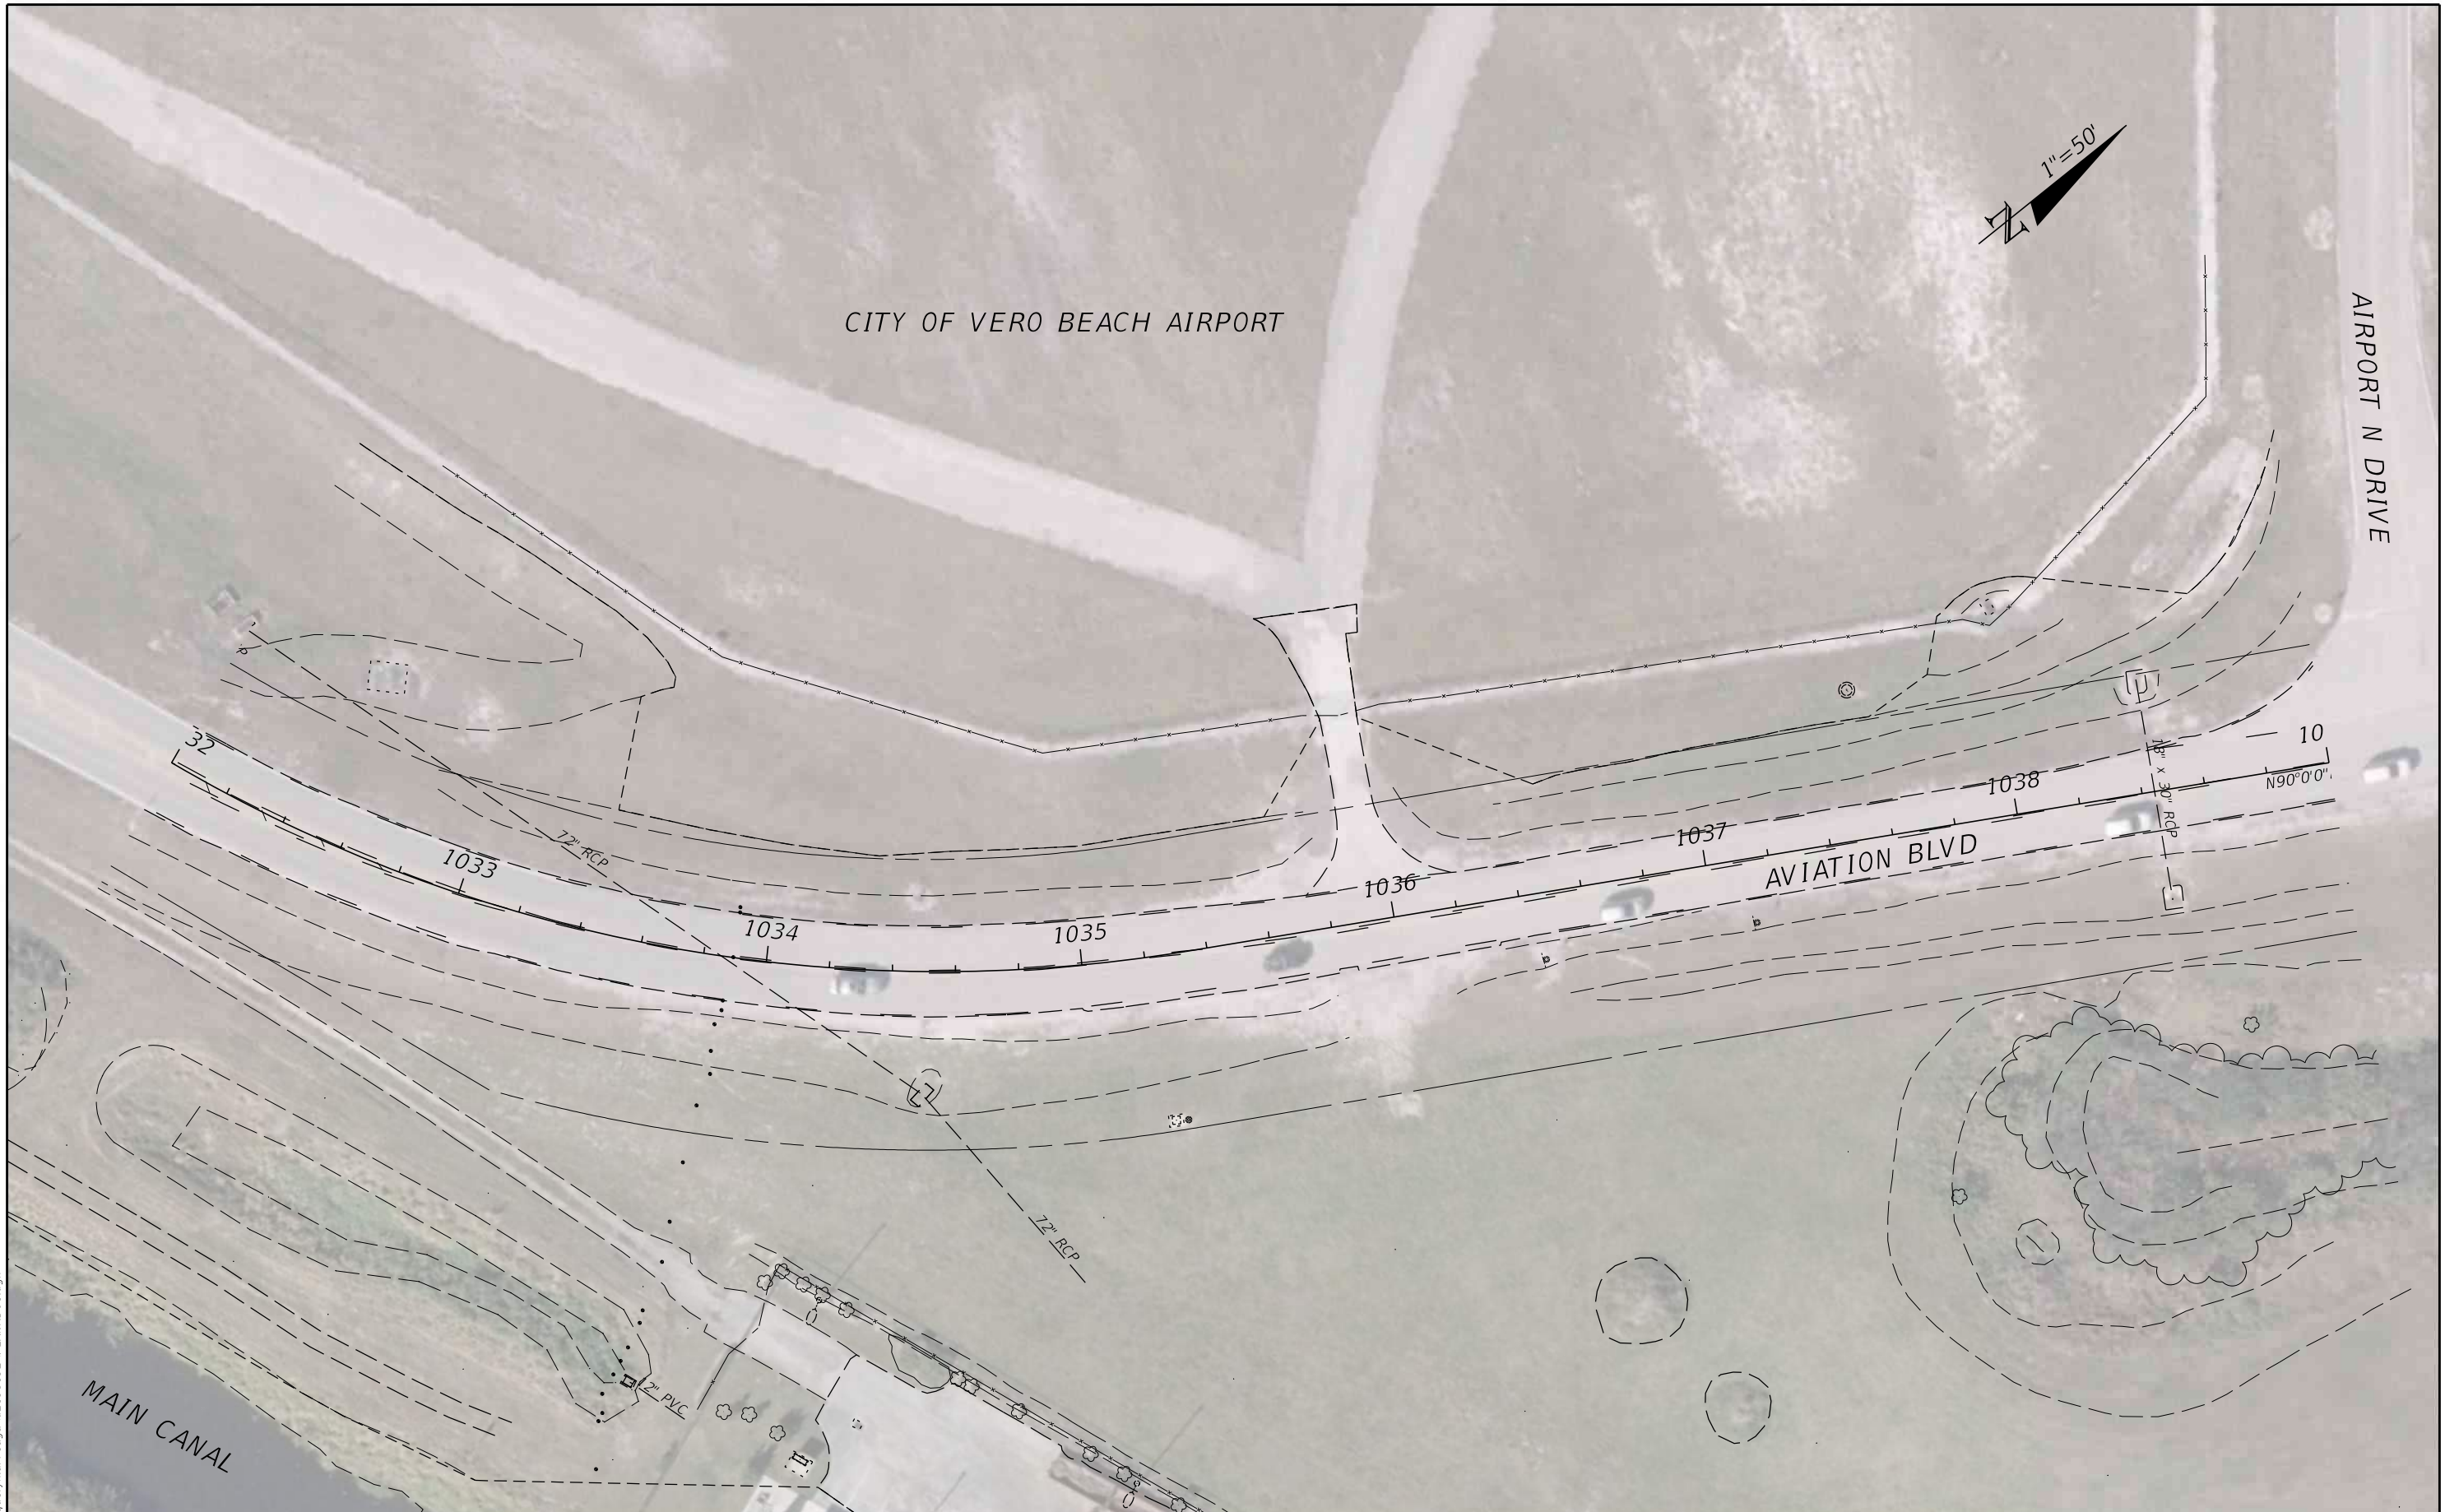

9/15/2022 11:09:30 AM Jacquelyn.Arreaga  
 c:\pwworking\wgn\jacquelyn.arreaga\d2198192\PLAN\ARD01.dgn


REVISIONS				PROFESSIONAL TYPE	STATE OF FLORIDA DEPARTMENT OF TRANSPORTATION			SHEET NO.
DATE	DESCRIPTION	DATE	DESCRIPTION		ROAD NO.	COUNTY	FINANCIAL PROJECT ID	
				WILLIAM EVANS LICENSE NUMBER: 45207 WGI, INC. 2035 VISTA PARKWAY WEST PALM BEACH, FL 33411	SR 5	INDIAN RIVER	441693-1-22-02	26

**UTILITY CONTACT PLAN (26)**

THE OFFICIAL RECORD OF THIS SHEET IS THE ELECTRONIC FILE DIGITALLY SIGNED AND SEALED UNDER RULE 61G15-23.004, F.A.C.



CITY OF VERO BEACH AIRPORT

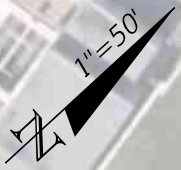

9/15/2022 11:09:43 AM Jacquelyn.Arreaga c:\pwworking\wg\N\Jacquelyn.arreaga\d2198192\PLANRD01.dgn

REVISIONS				PROFESSIONAL TYPE	STATE OF FLORIDA DEPARTMENT OF TRANSPORTATION			SHEET NO.
DATE	DESCRIPTION	DATE	DESCRIPTION		ROAD NO.	COUNTY	FINANCIAL PROJECT ID	
				WILLIAM EVANS LICENSE NUMBER: 45207 WGI, INC. 2035 VISTA PARKWAY WEST PALM BEACH, FL 33411	SR 5	INDIAN RIVER	441693-1-22-02	27

**UTILITY CONTACT PLAN (27)**

THE OFFICIAL RECORD OF THIS SHEET IS THE ELECTRONIC FILE DIGITALLY SIGNED AND SEALED UNDER RULE 61G15-23.004, F.A.C.

**Appendix D**

**Utility Agency Owner Responses**

AT&T Florida  
AT&T Transmission  
City of Vero Beach  
Comcast  
Crown Castle  
Florida City Gas/ NextEra  
FP&L Distribution  
FP&L Transmission  
Indian River County Utilities  
Lumen (CenturyLink) National  
Resurgence Infrastructure Group  
Sprint  
Verizon/ MCI

## Appendices

### Appendix D

#### AT&T Florida




# External Map Request for Wgi

Date: 6/7/2023

Index Map

## Aviation Blvd Pande Study From 27Th Ave To Us1 Markup Project

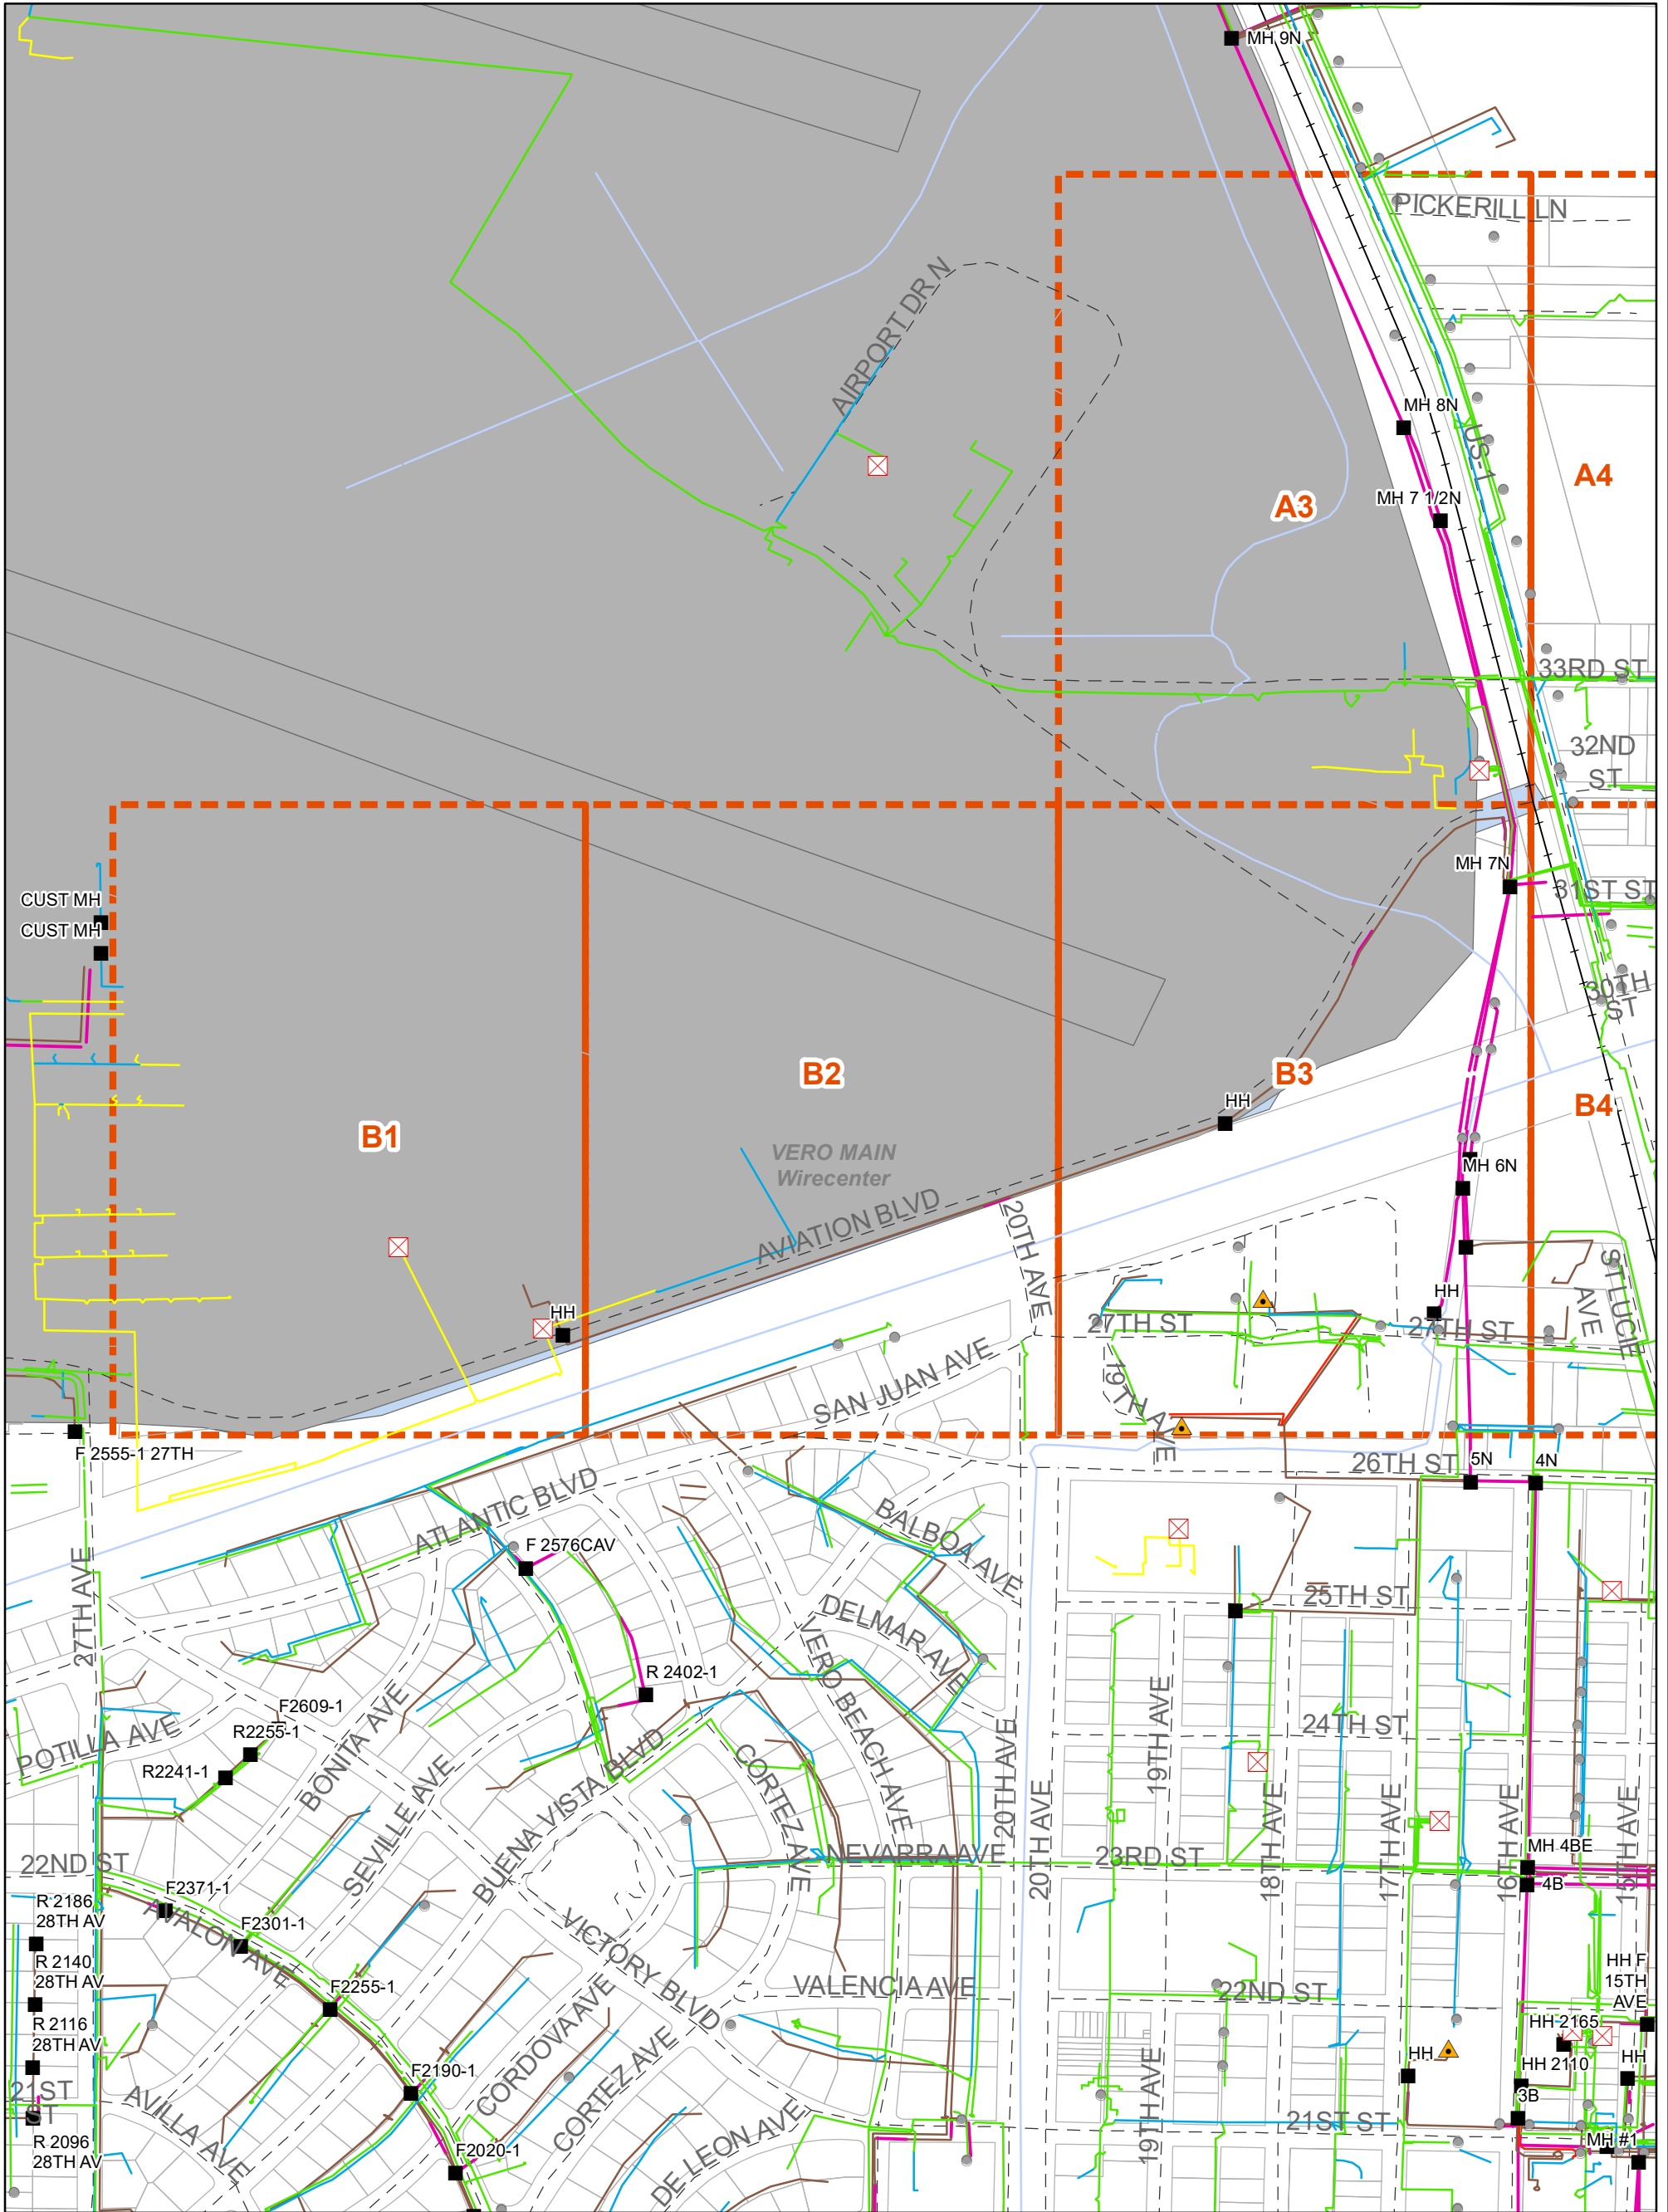

1:6,072



- Poles
- Remote Terminals
- SAls
- Manholes
- Aerial
- Building
- Buried
- Underground
- Floating
- Submarine
- Other
- Conduit
- Railroads
- Street Centerlines
- Mapping Index
- Wirecenter Boundary
- Parcels
- JobAOI




Copyright 2020 AT&T Intellectual Property. All rights reserved. AT&T and the AT&T logo are trademarks of AT&T Intellectual Property. The copying, scanning or other reproduction of this map without prior written permission of AT&T Intellectual Property is strictly prohibited. This map is provided 'as is'. Neither AT&T Intellectual Property nor any of its affiliates shall have any liability whatsoever to any person or entity for or on account of any injury, loss, or damage of any kind of nature sustained by, or any liability incurred by or imposed upon any other person or entity arising out of or in connection with or resulting from the use of this map.

Location of facilities shown herein are subject to field verification. No liability is assumed by AT&T as to the accuracy of location facilities. Please call USA at 811 two working days in advance of any grading or excavation in vicinity of our underground facilities. AT&T proprietary (internal use only). Not for use or disclosure outside the AT&T companies except under written agreement. Telco proprietary data is not to be disclosed to siloed employees.

AT&T PROPRIETARY-This information constitutes confidential trade secrets and commercial or financial information owned by AT&T and is shared for Critical Infrastructure Protection purposes only. It is exempt from disclosure under the Freedom of Information Act (5 USC 552), Exemptions (b)(3)&(4), and its disclosure is prohibited under the Trade Secrets Act (18 USC 1905), the Critical Infrastructure Information Act of 2002, 6 USC 133, and any State or local law requiring disclosure of information or records. This information must not be copied or distributed to others not agreed upon by AT&T, but in all events do not copy or distribute to such others without notification pursuant to Executive Order 12600.



## Aviation Blvd Pande Study From 27Th Ave To Us1 Markup Project

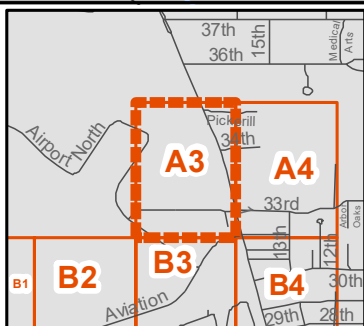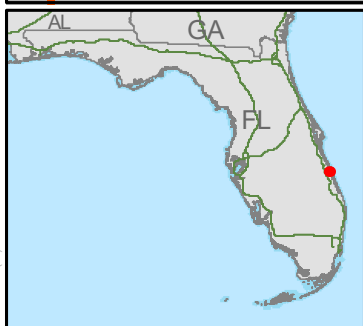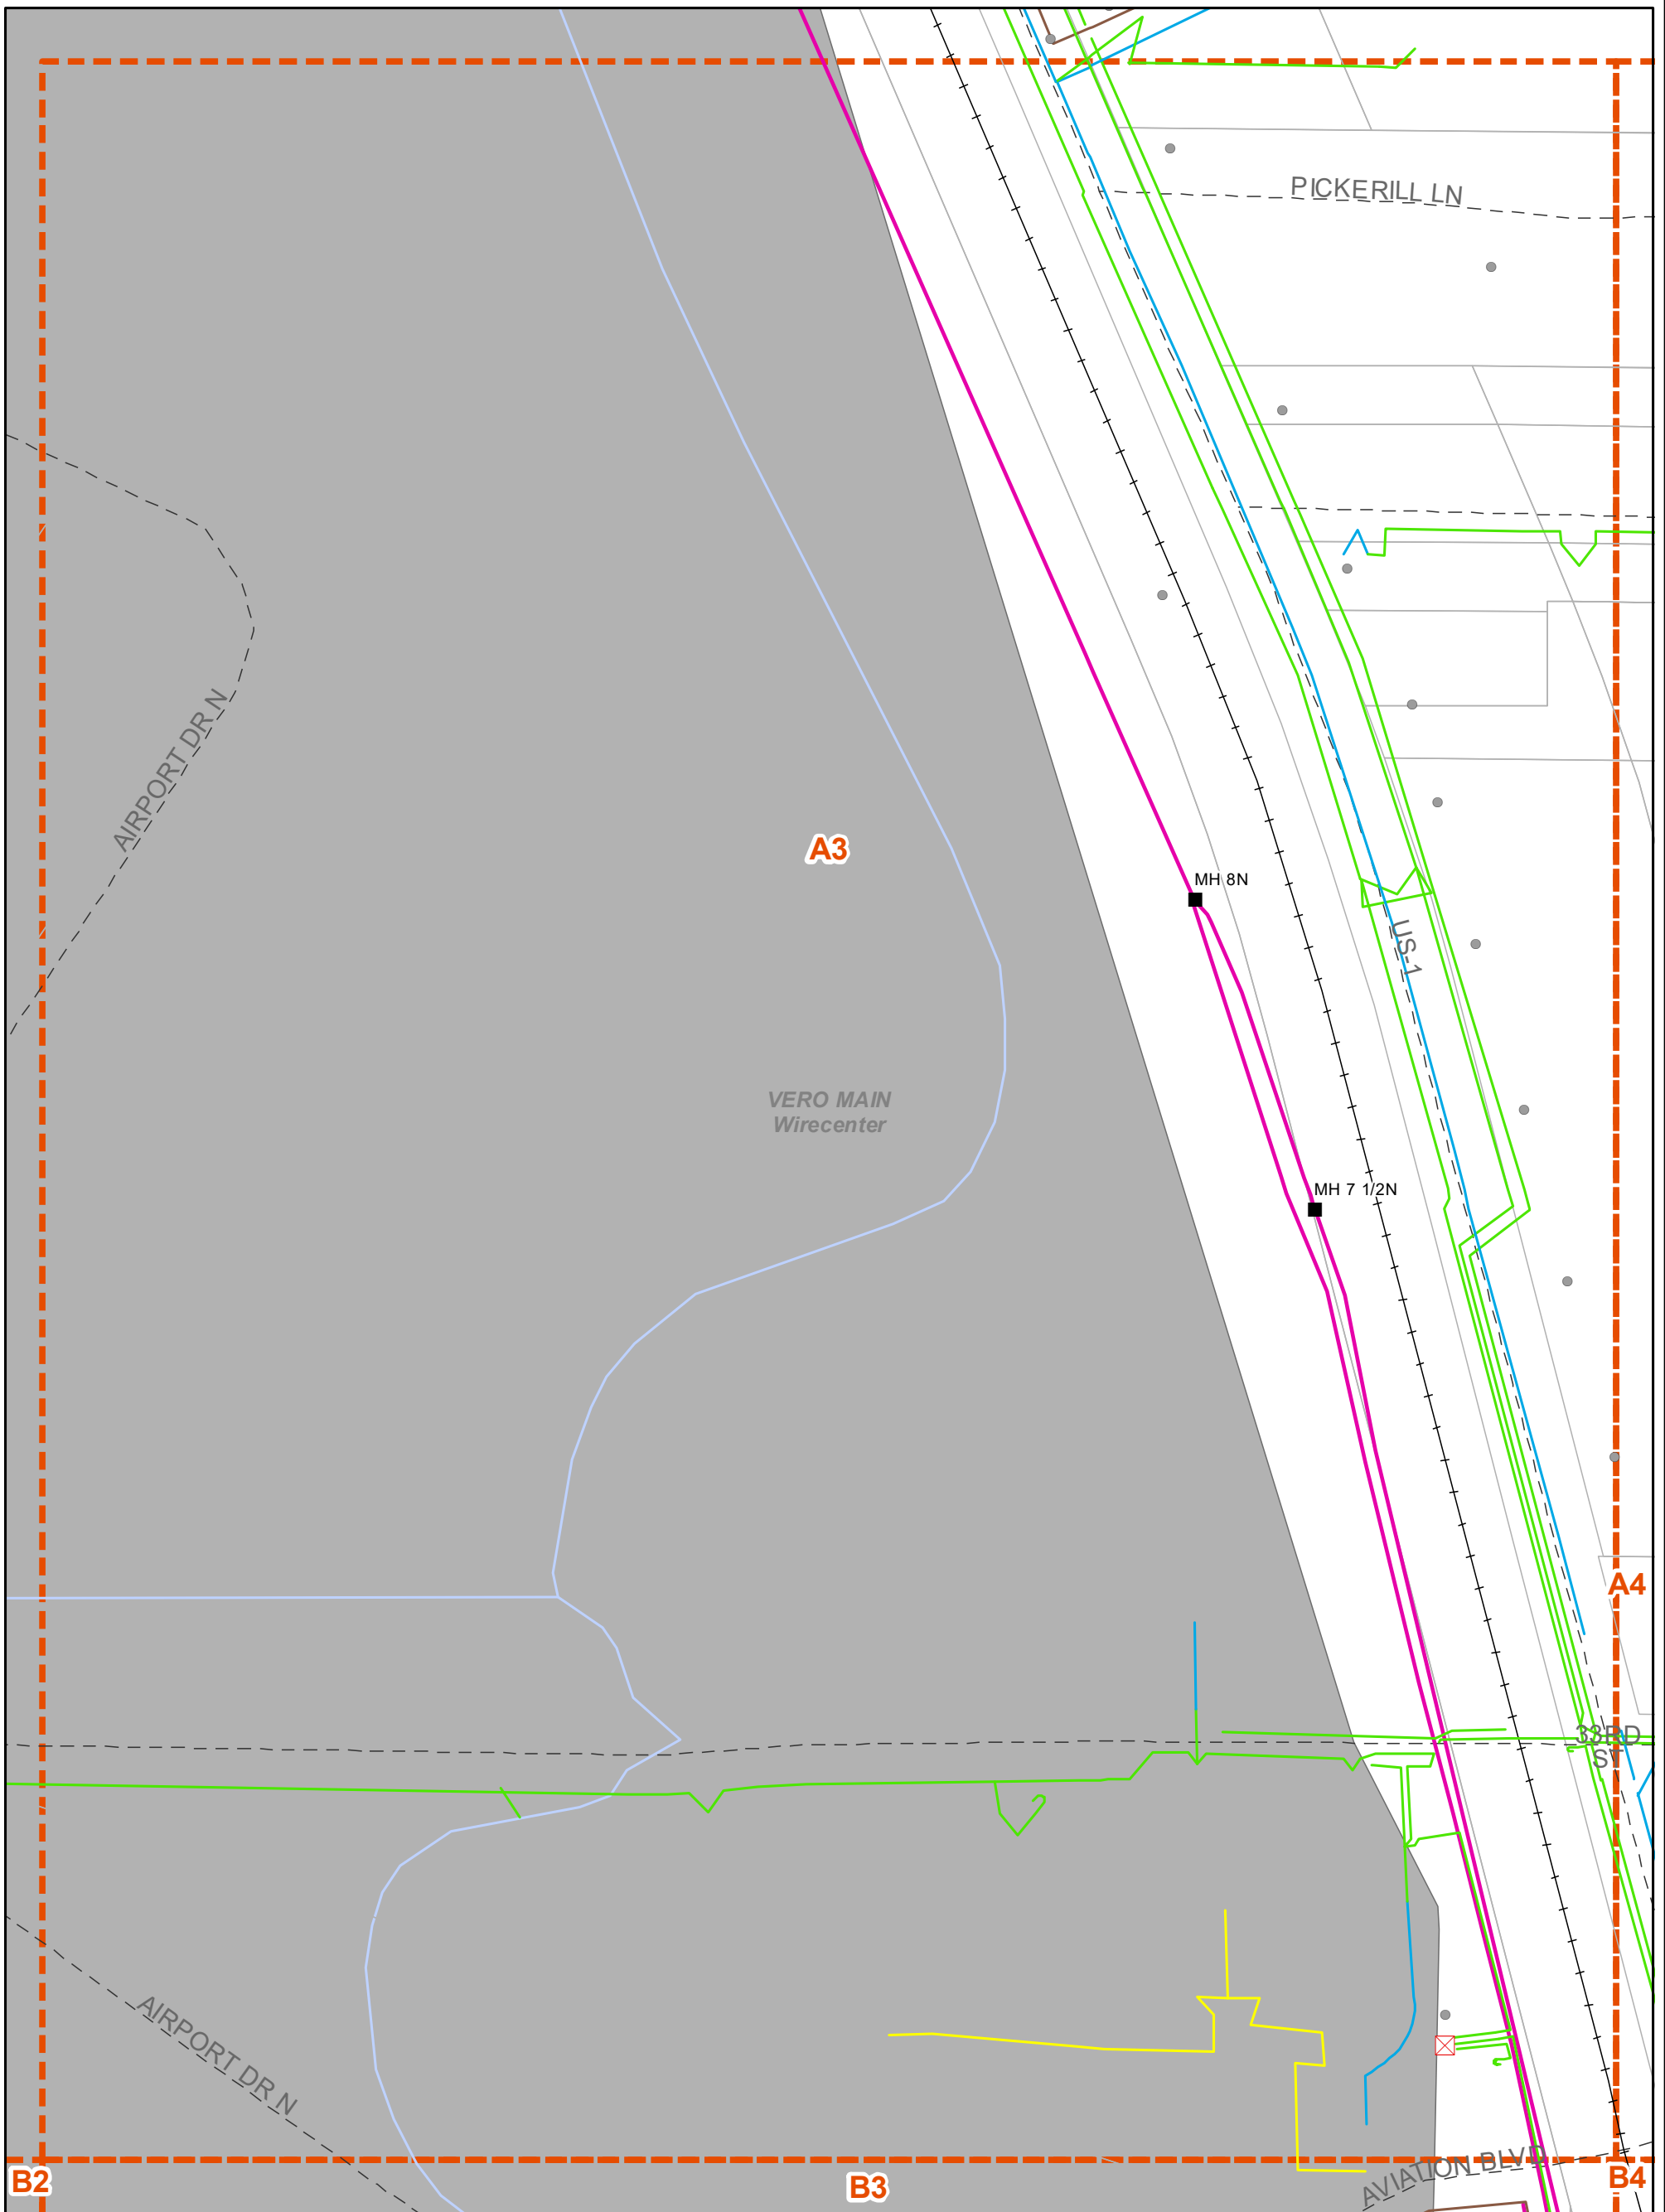

1:1,820



- Poles
- ⊠ SAls
- Manholes
- ⚡ Aerial
- 🏠 Building
- 🌿 Buried
- 🔌 Underground
- 🌊 Floating
- 📏 Submarine
- 🛤️ Other
- 📏 Conduit
- 🚂 Railroads
- 📏 Street Centerlines
- 📏 Mapping Index
- 📏 Wirecenter Boundary
- 📏 Parcels




Copyright 2020 AT&T Intellectual Property. All rights reserved. AT&T and the AT&T logo are trademarks of AT&T Intellectual Property. The copying, scanning or other reproduction of this map without prior written permission of AT&T Intellectual Property is strictly prohibited. This map is provided 'as is'. Neither AT&T Intellectual Property nor any of its affiliates shall have any liability whatsoever to any person or entity for or on account of any injury, loss, or damage of any kind of nature sustained by, or any liability incurred by or imposed upon any other person or entity arising out of or in connection with or resulting from the use of this map.

Location of facilities shown herein are subject to field verification. No liability is assumed by AT&T as to the accuracy of location facilities. Please call USA at 811 two working days in advance of any grading or excavation in vicinity of our underground facilities. AT&T proprietary (internal use only). Not for use or disclosure outside the AT&T companies except under written agreement. Telco proprietary data is not to be disclosed to sited employees.

AT&T PROPRIETARY-This information constitutes confidential trade secrets and commercial or financial information owned by AT&T and is shared for Critical Infrastructure Protection purposes only. It is exempt from disclosure under the Freedom of Information Act (5 USC 552), Exemptions (b)(3)&(4), and its disclosure is prohibited under the Trade Secrets Act (18 USC 1905), the Critical Infrastructure Information Act of 2002, 6 USC 133, and any State or local law requiring disclosure of information or records. This information must not be copied or distributed to others not agreed upon by AT&T, but in all events do not copy or distribute to such others without notification pursuant to Executive Order 12600.



## Aviation Blvd Pdande Study From 27Th Ave To Us1 Markup Project

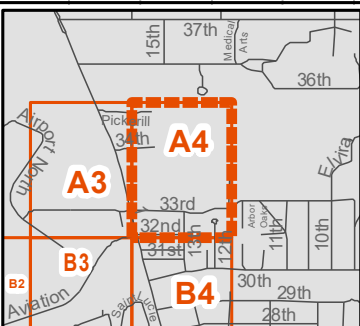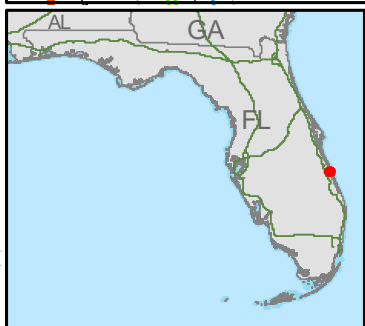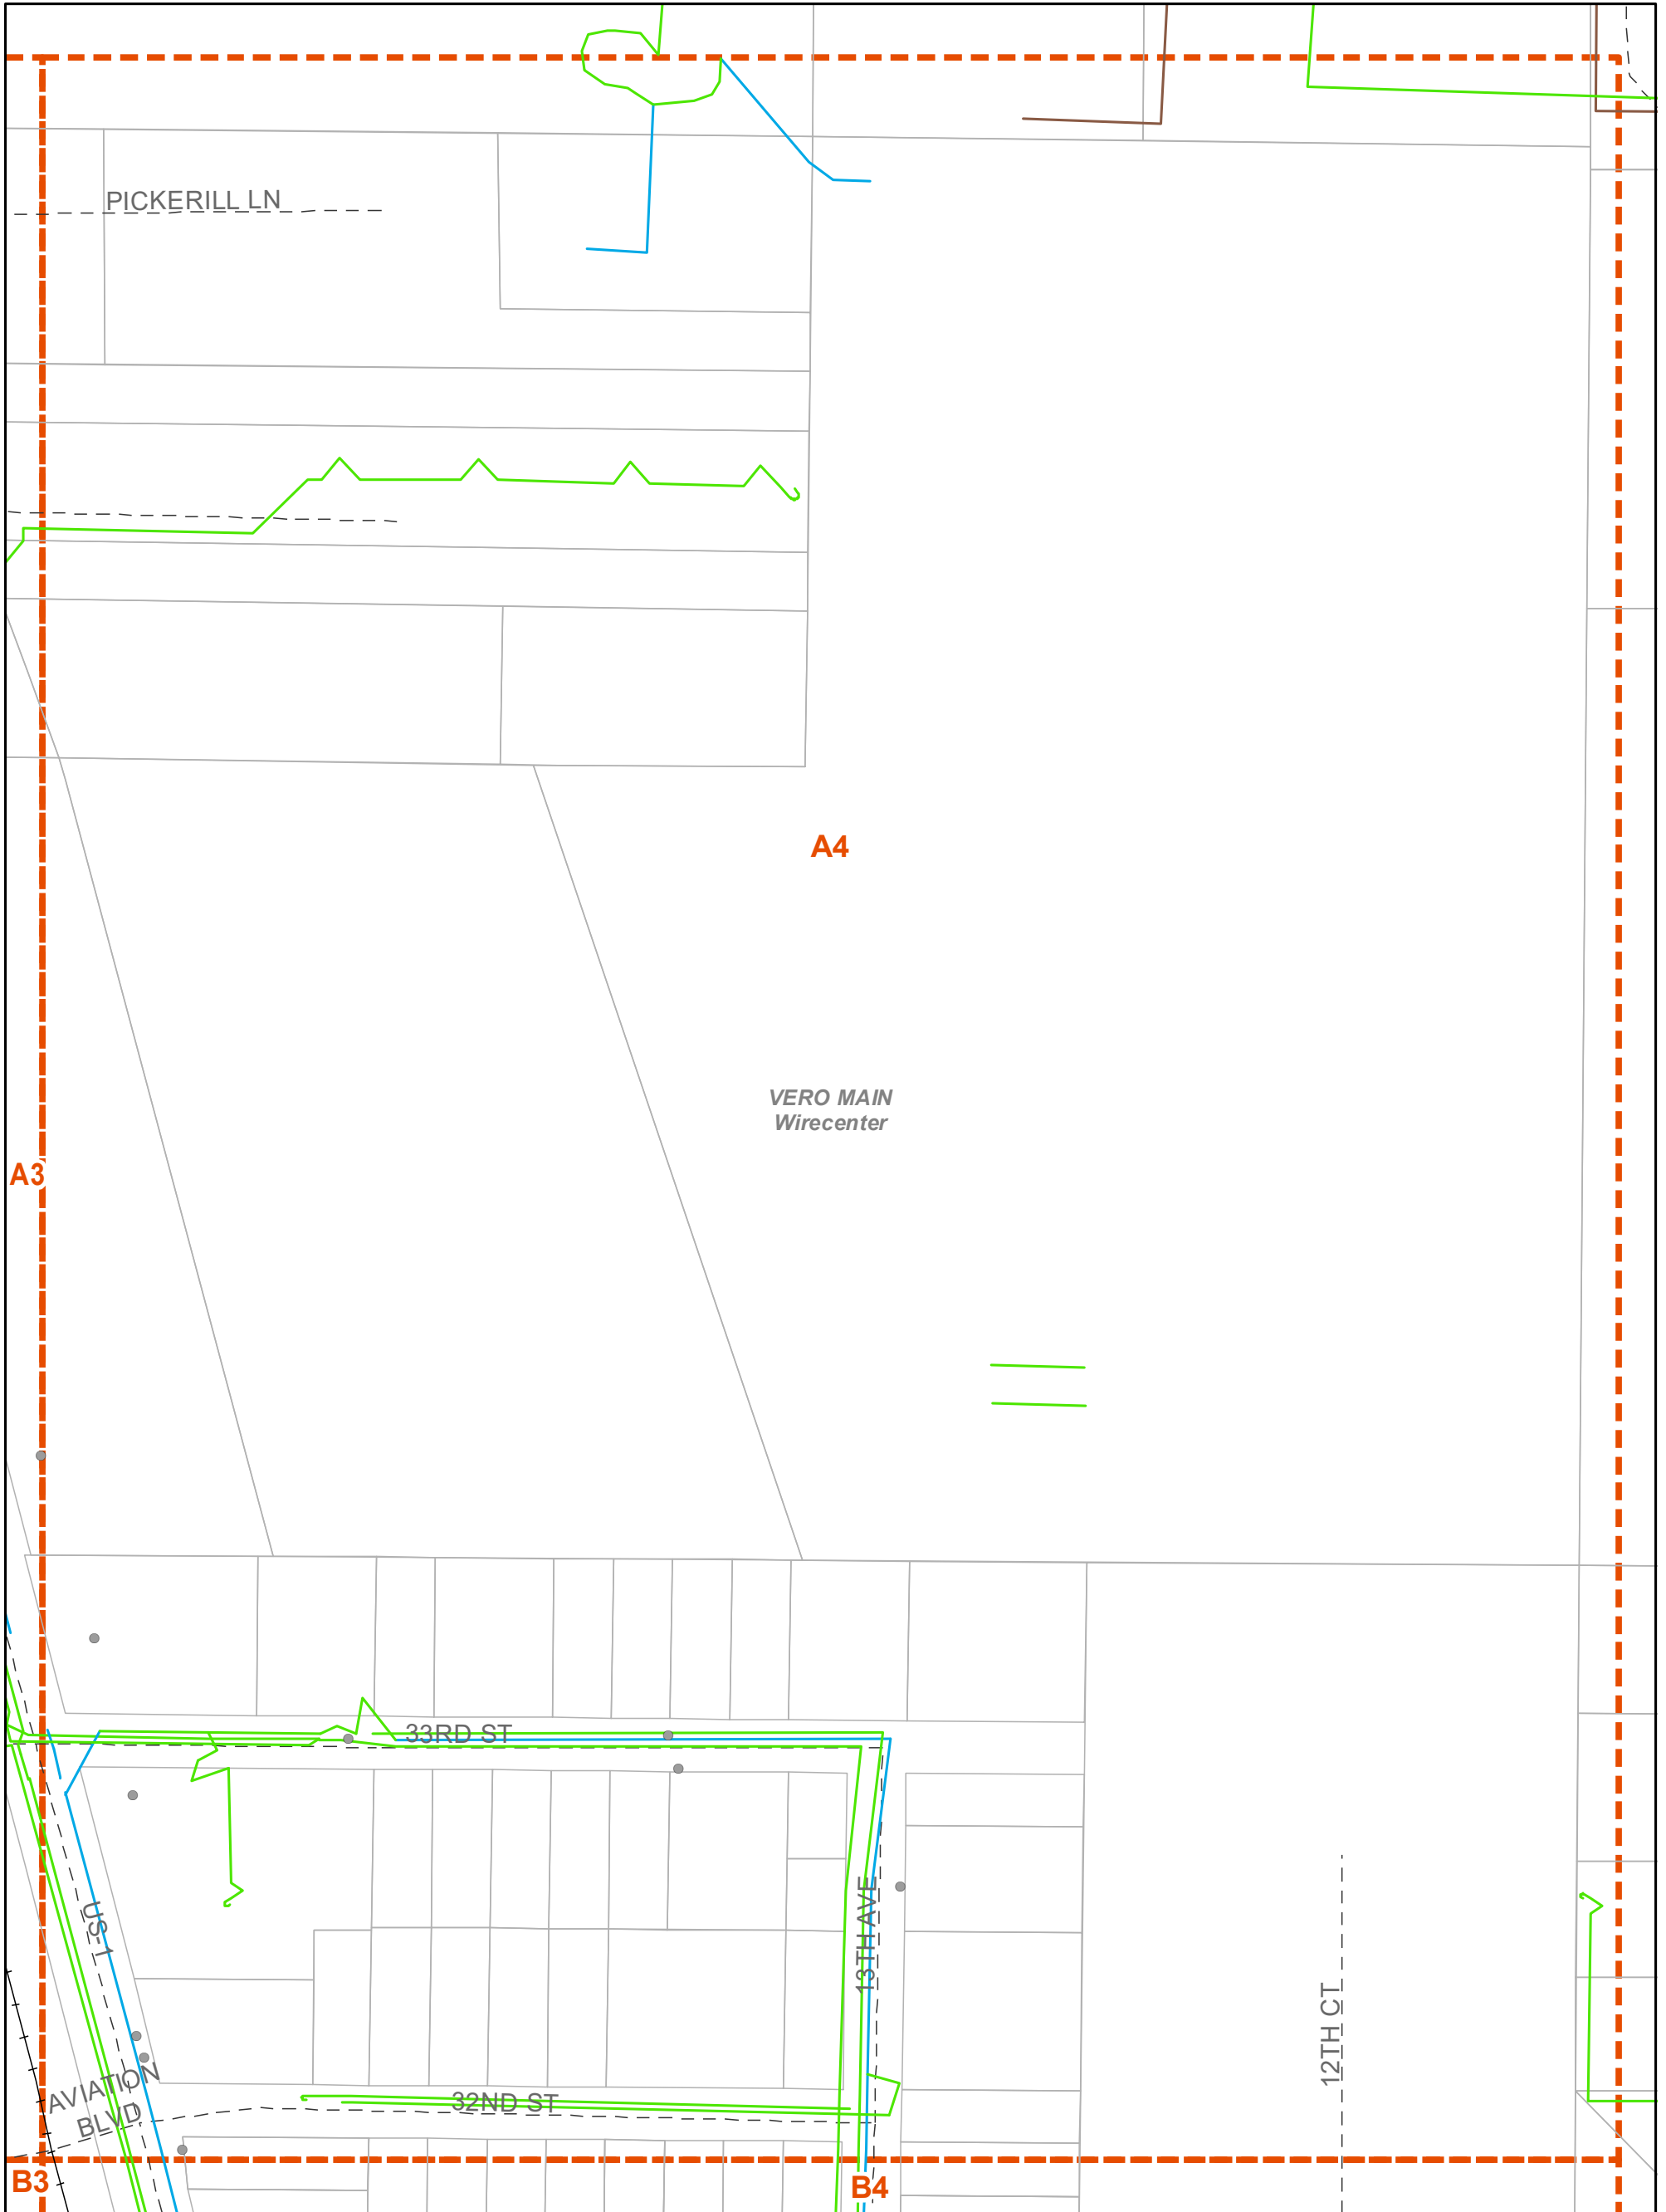

1:1,820



- Poles
- Aerial
- Building
- Buried
- Underground
- Floating
- Submarine
- Other
- Railroads
- Street Centerlines
- Mapping Index
- Wirecenter Boundary
- Parcels




Copyright 2020 AT&T Intellectual Property. All rights reserved. AT&T and the AT&T logo are trademarks of AT&T Intellectual Property. The copying, scanning or other reproduction of this map without prior written permission of AT&T Intellectual Property is strictly prohibited. This map is provided 'as is'. Neither AT&T Intellectual Property nor any of its affiliates shall have any liability whatsoever to any person or entity for or on account of any injury, loss, or damage of any kind of nature sustained by, or any liability incurred by or imposed upon any other person or entity arising out of or in connection with or resulting from the use of this map.

Location of facilities shown herein are subject to field verification. No liability is assumed by AT&T as to the accuracy of location facilities. Please call USA at 811 two working days in advance of any grading or excavation in vicinity of our underground facilities. AT&T proprietary (internal use only). Not for use or disclosure outside the AT&T companies except under written agreement. Telco proprietary data is not to be disclosed to sited employees.

AT&T PROPRIETARY-This information constitutes confidential trade secrets and commercial or financial information owned by AT&T and is shared for Critical Infrastructure Protection purposes only. It is exempt from disclosure under the Freedom of Information Act (5 USC 552), Exemptions (b)(3)&(4), and its disclosure is prohibited under the Trade Secrets Act (18 USC 1905), the Critical Infrastructure Information Act of 2002, 6 USC 133, and any State or local law requiring disclosure of information or records. This information must not be copied or distributed to others not agreed upon by AT&T, but in all events do not copy or distribute to such others without notification pursuant to Executive Order 12600.



## Aviation Blvd Pdande Study From 27Th Ave To Us1 Markup Project

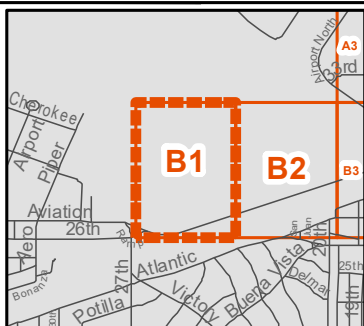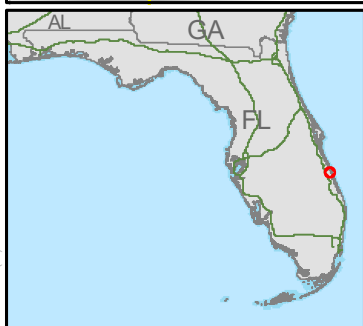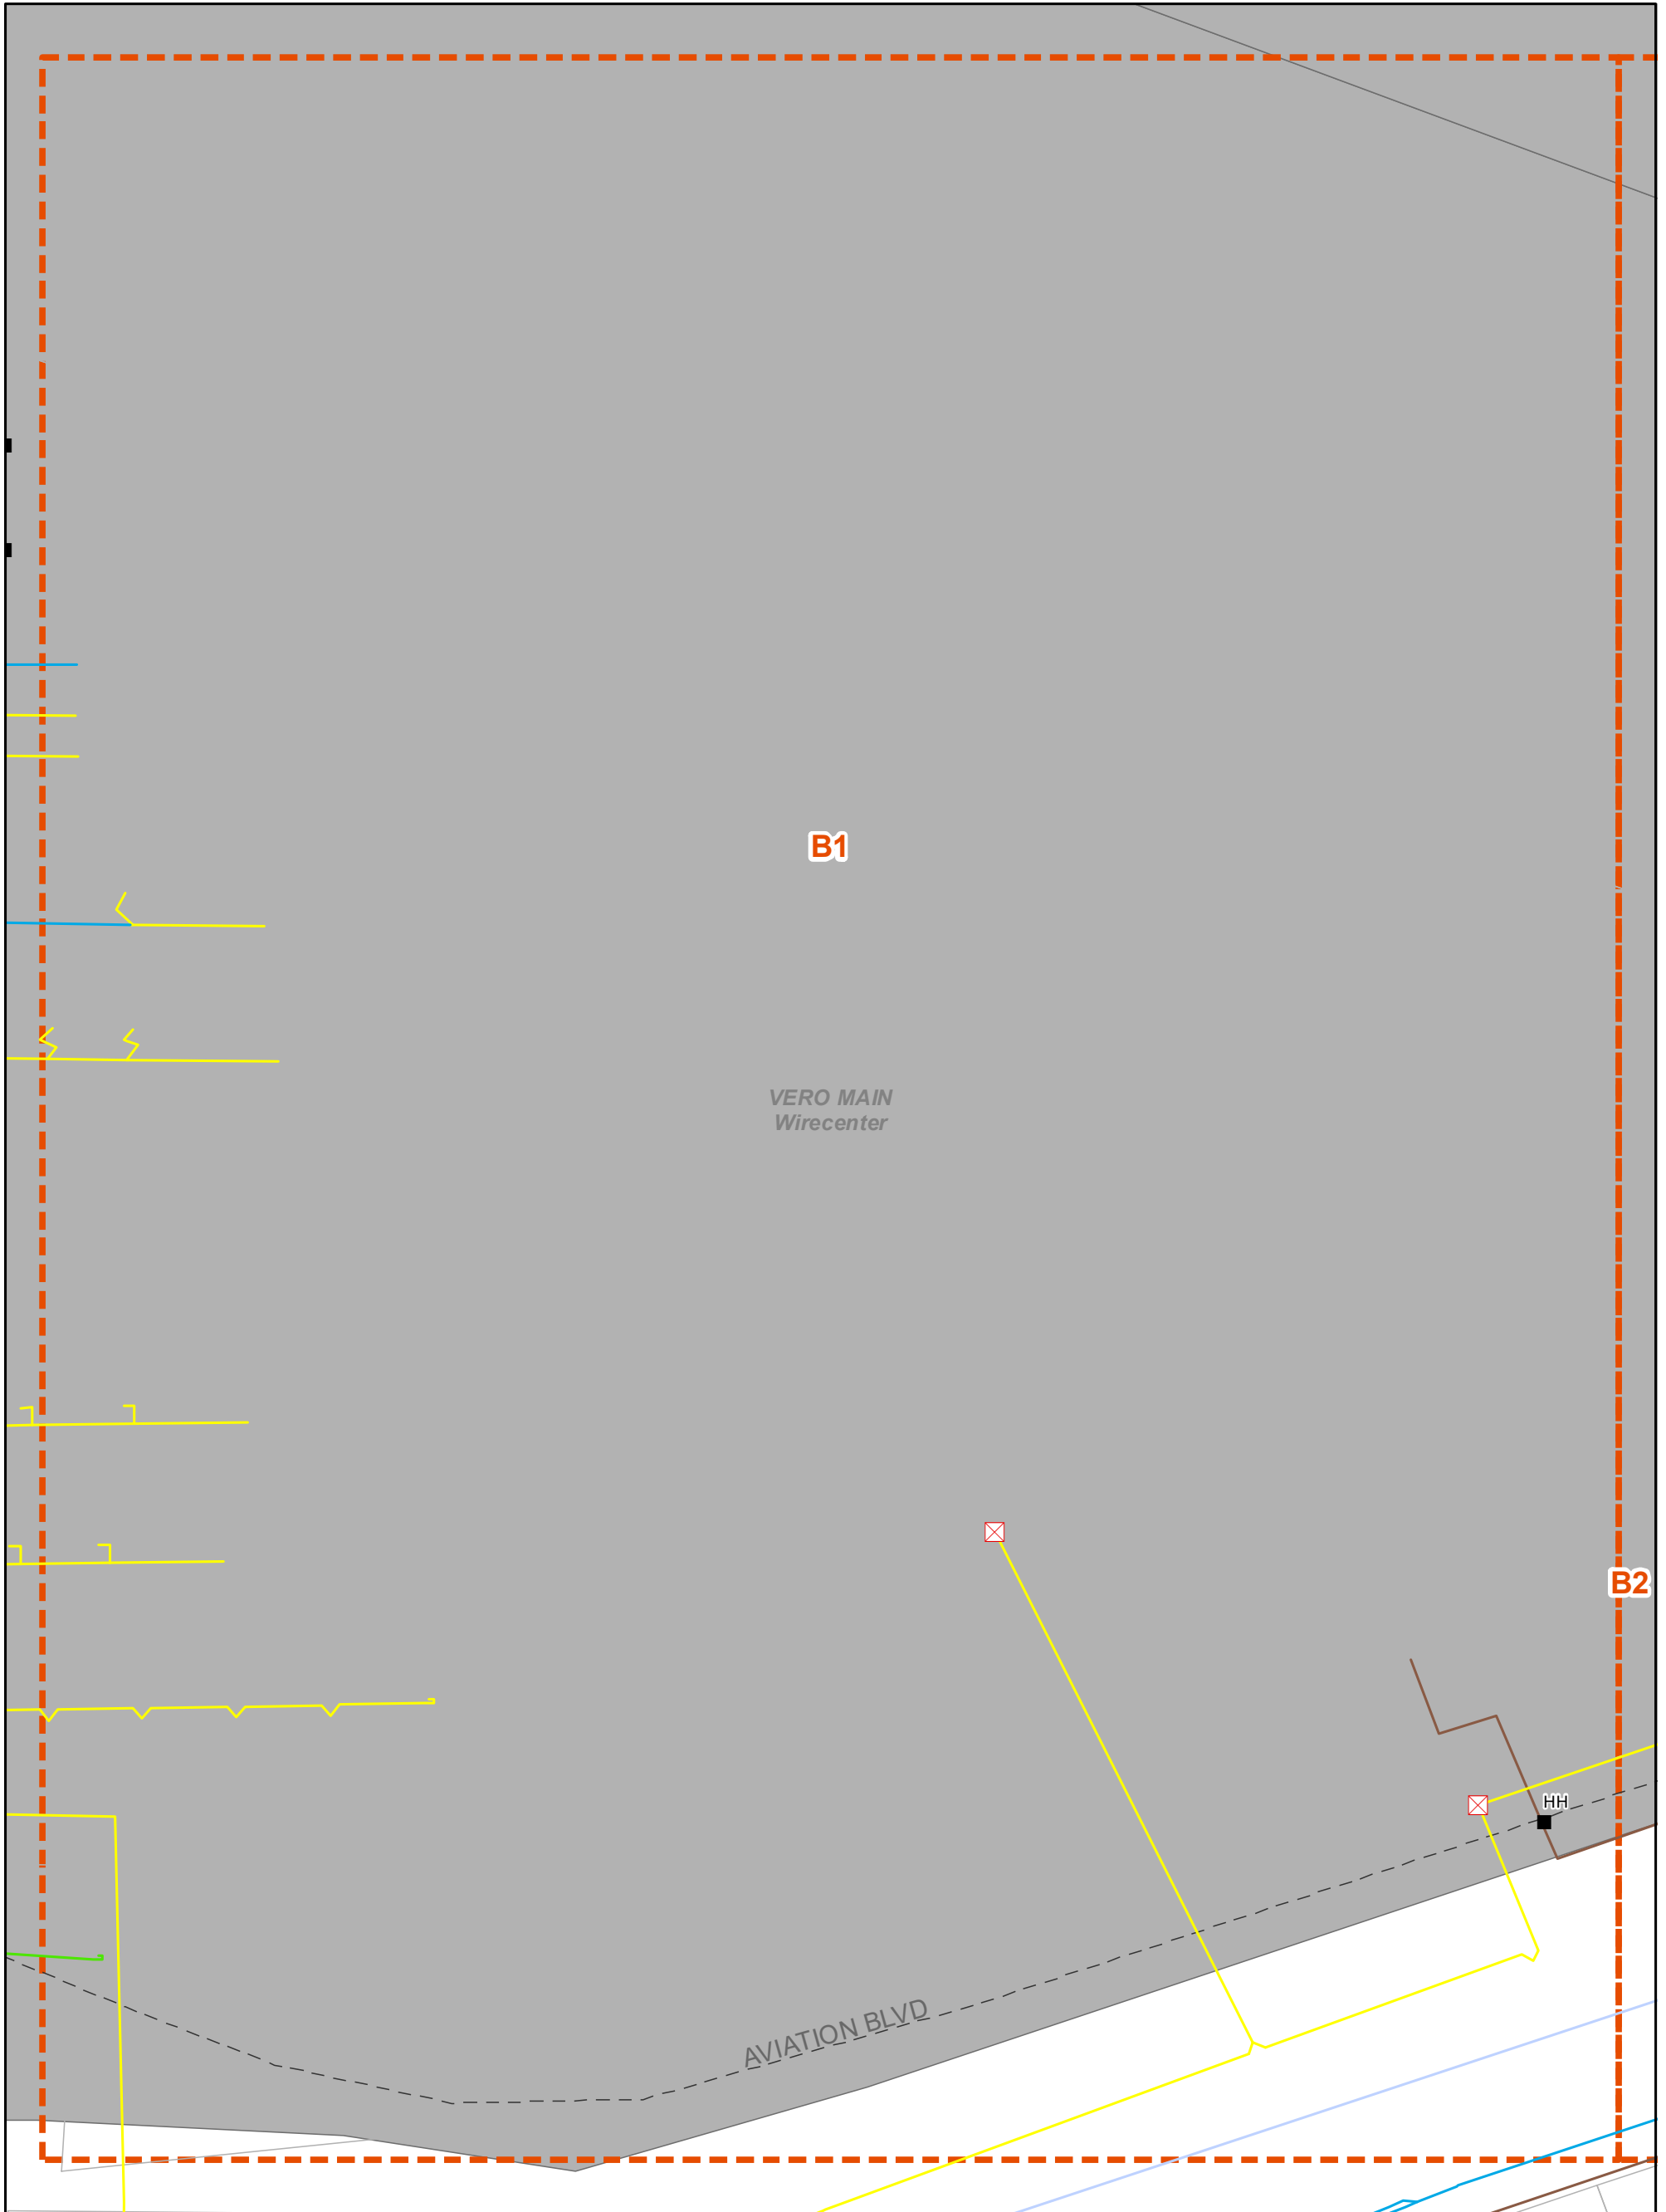

1:1,820



- SAIs
- Manholes
- Aerial
- Building
- Buried
- Underground
- Floating
- Submarine
- Other
- Street Centerlines
- Mapping Index
- Wirecenter Boundary
- Parcels




Copyright 2020 AT&T Intellectual Property. All rights reserved. AT&T and the AT&T logo are trademarks of AT&T Intellectual Property. The copying, scanning or other reproduction of this map without prior written permission of AT&T Intellectual Property is strictly prohibited. This map is provided 'as is'. Neither AT&T Intellectual Property nor any of its affiliates shall have any liability whatsoever to any person or entity for or on account of any injury, loss, or damage of any kind of nature sustained by, or any liability incurred by or imposed upon any other person or entity arising out of or in connection with or resulting from the use of this map.

Location of facilities shown herein are subject to field verification. No liability is assumed by AT&T as to the accuracy or location facilities. Please call USA at 811 two working days in advance of any grading or excavation in vicinity of our underground facilities. AT&T propriety (internal use only). Not for use or disclosure outside the AT&T companies except under written agreement. Telco proprietary data is not to be disclosed to sited employees.

AT&T PROPRIETARY-This information constitutes confidential trade secrets and commercial or financial information owned by AT&T and is shared for Critical Infrastructure Protection purposes only. It is exempt from disclosure under the Freedom of Information Act (5 USC 552), Exemptions (b)(3)&(4), and its disclosure is prohibited under the Trade Secrets Act (18 USC 1905), the Critical Infrastructure Information Act of 2002, 6 USC 133, and any State or local law requiring disclosure of information or records. This information must not be copied or distributed to others not agreed upon by AT&T, but in all events do not copy or distribute to such others without notification pursuant to Executive Order 12600.



Aviation Blvd Pdande Study From 27Th Ave To Us1 Markup Project

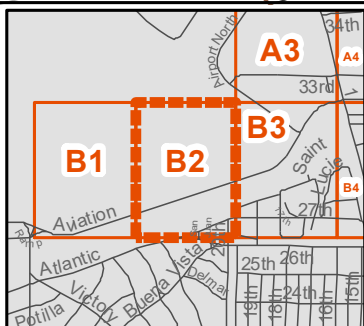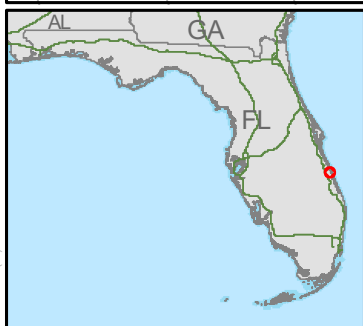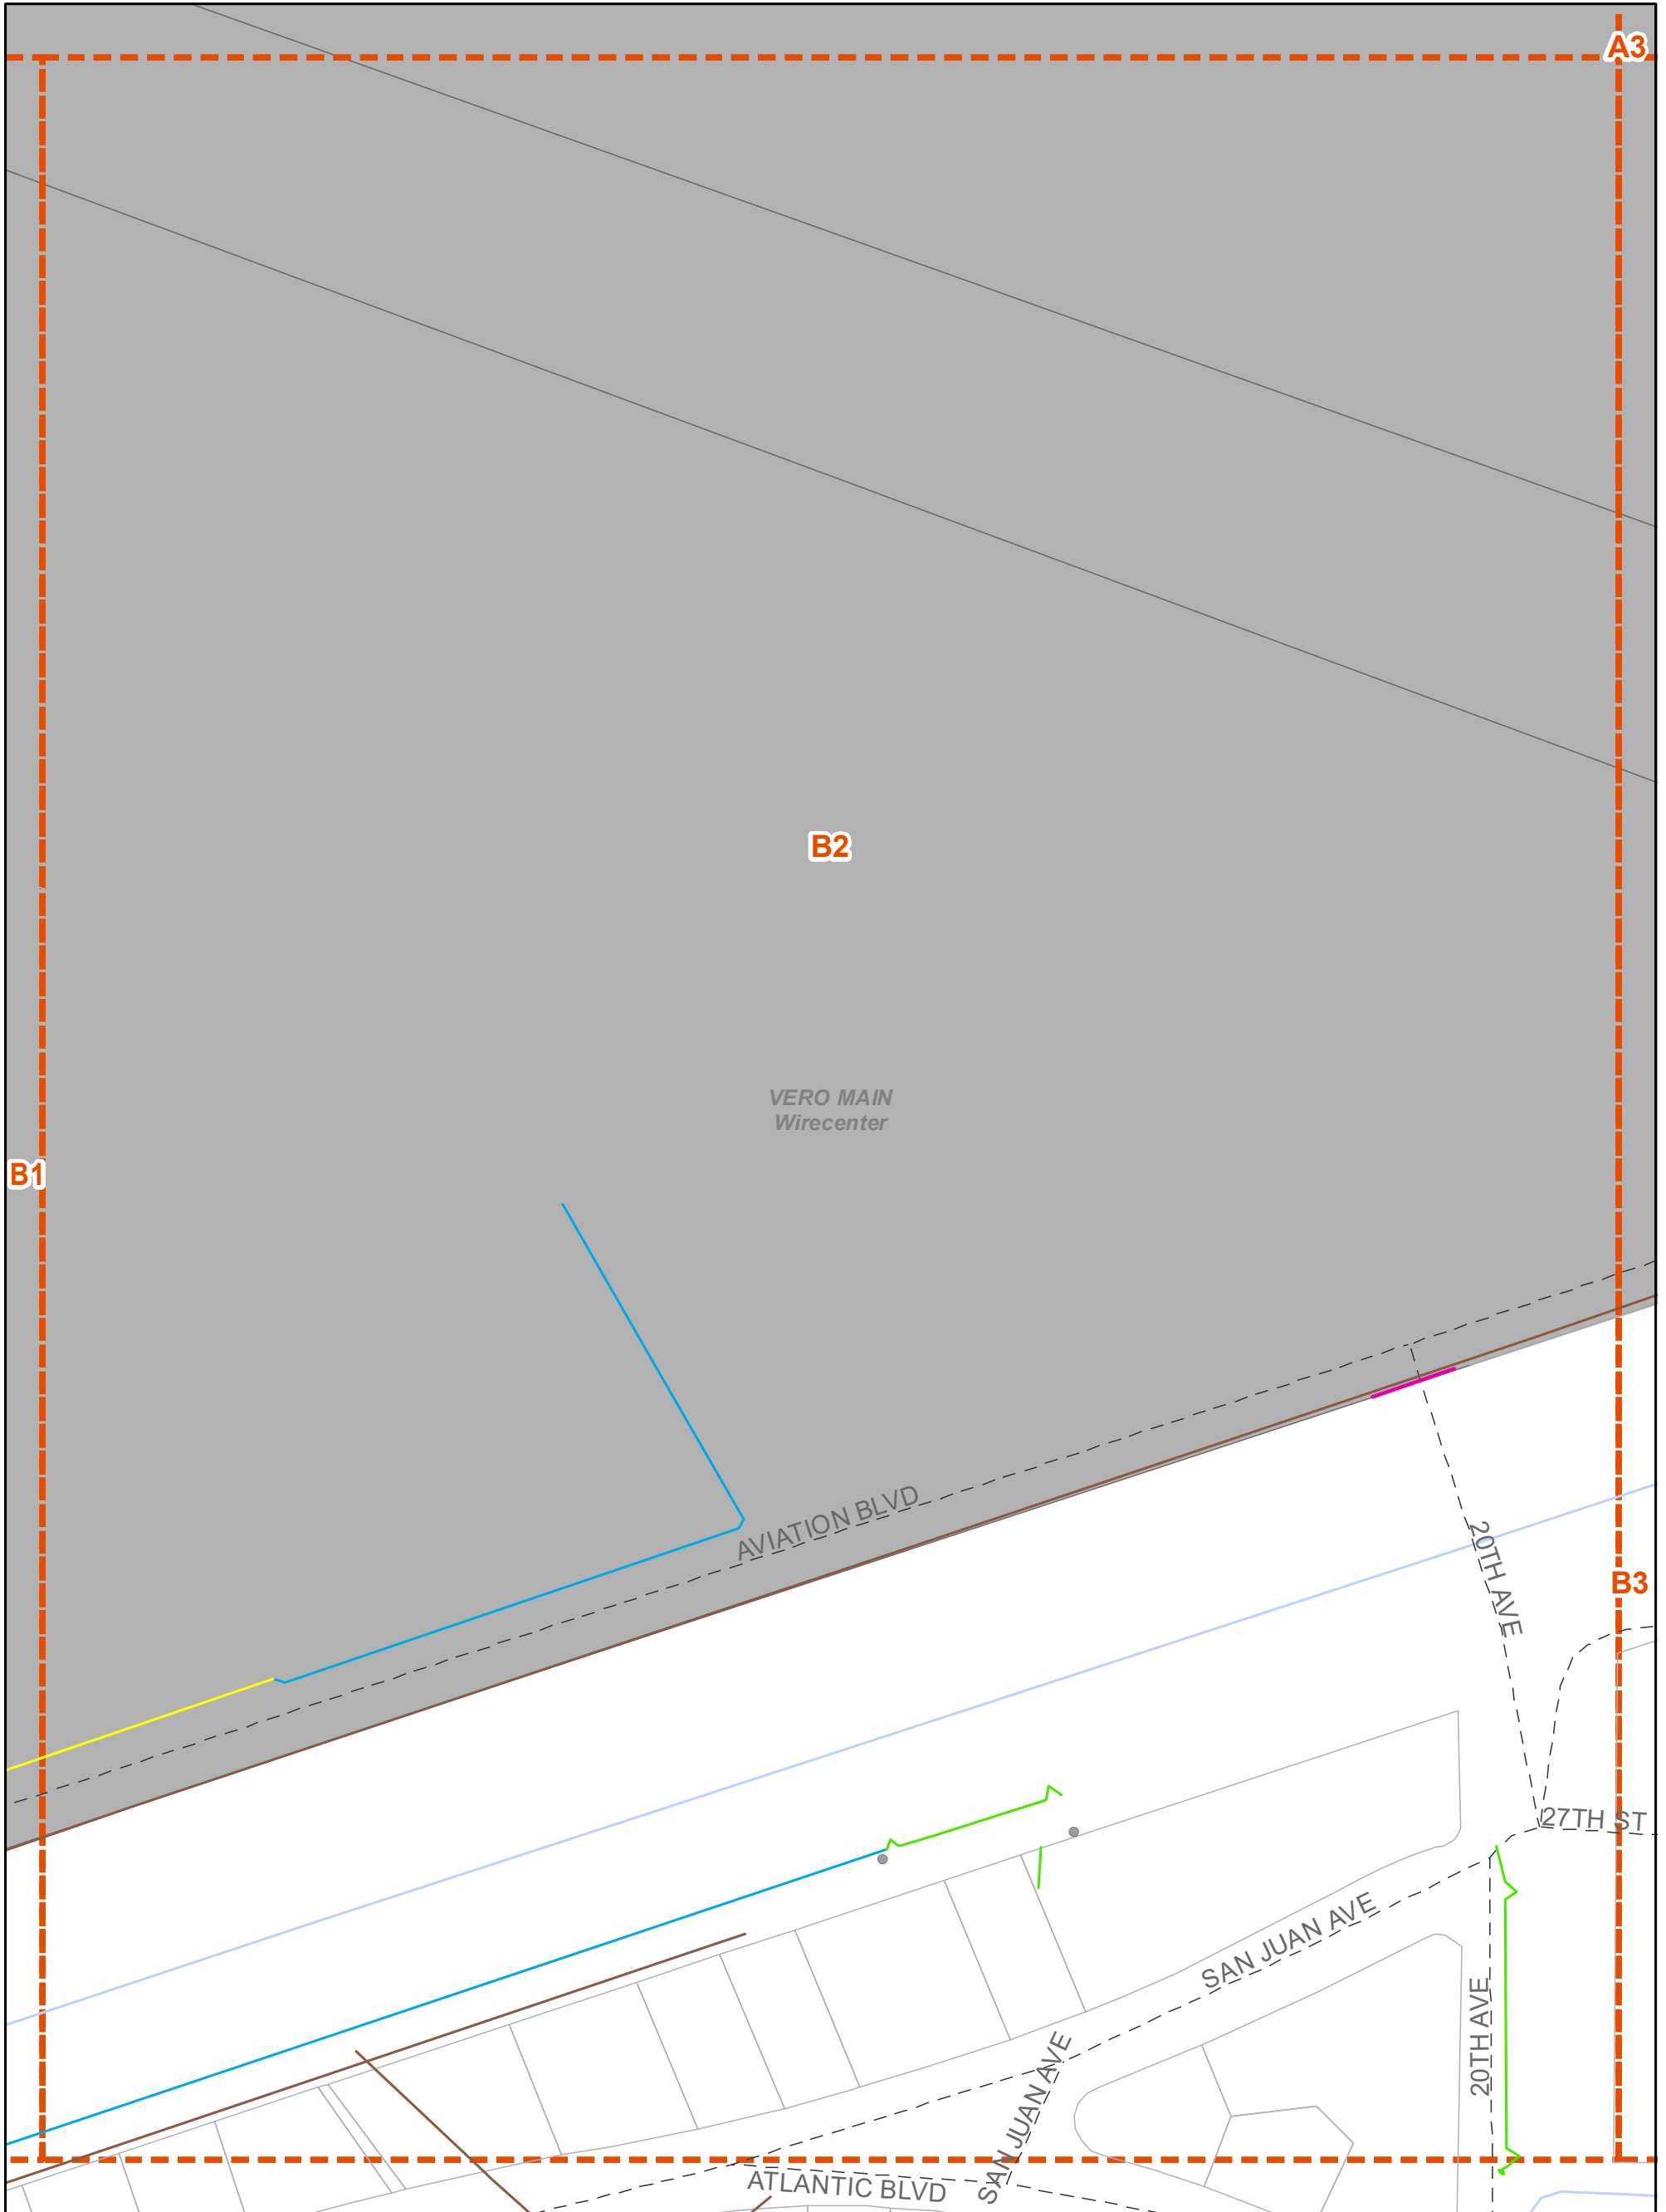

1:1,820



- Poles
- Aerial
- Building
- Buried
- Underground
- Floating
- Submarine
- Other
- Conduit
- Street Centerlines
- Mapping Index
- Wirecenter Boundary
- Parcels

Copyright 2020 AT&T Intellectual Property. All rights reserved. AT&T and the AT&T logo are trademarks of AT&T Intellectual Property. The copying, scanning or other reproduction of this map without prior written permission of AT&T Intellectual Property is strictly prohibited. This map is provided 'as is'. Neither AT&T Intellectual Property nor any of its affiliates shall have any liability whatsoever to any person or entity for or on account of any injury, loss, or damage of any kind of nature sustained by, or any liability incurred by or imposed upon any other person or entity arising out of or in connection with or resulting from the use of this map.




Location of facilities shown herein are subject to field verification. No liability is assumed by AT&T as to the accuracy of location facilities. Please call USA at 811 two working days in advance of any grading or excavation in vicinity of our underground facilities. AT&T proprietary (internal use only). Not for use or disclosure outside the AT&T companies except under written agreement. Telco proprietary data is not to be disclosed to sited employees.

AT&T PROPRIETARY-This information constitutes confidential trade secrets and commercial or financial information owned by AT&T and is shared for Critical Infrastructure Protection purposes only. It is exempt from disclosure under the Freedom of Information Act (5 USC 552), Exemptions (b)(3)&(4), and its disclosure is prohibited under the Trade Secrets Act (18 USC 1905), the Critical Infrastructure Information Act of 2002, 6 USC 133, and any State or local law requiring disclosure of information or records. This information must not be copied or distributed to others not agreed upon by AT&T, but in all events do not copy or distribute to such others without notification pursuant to Executive Order 12600.





## Aviation Blvd Pande Study From 27Th Ave To Us1 Markup Project

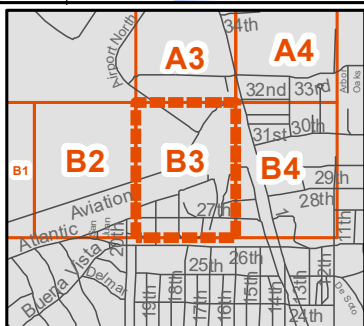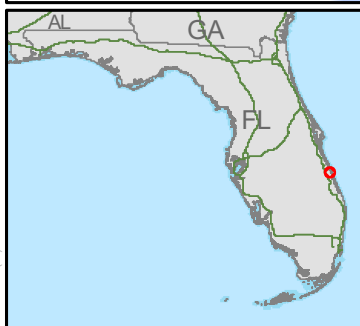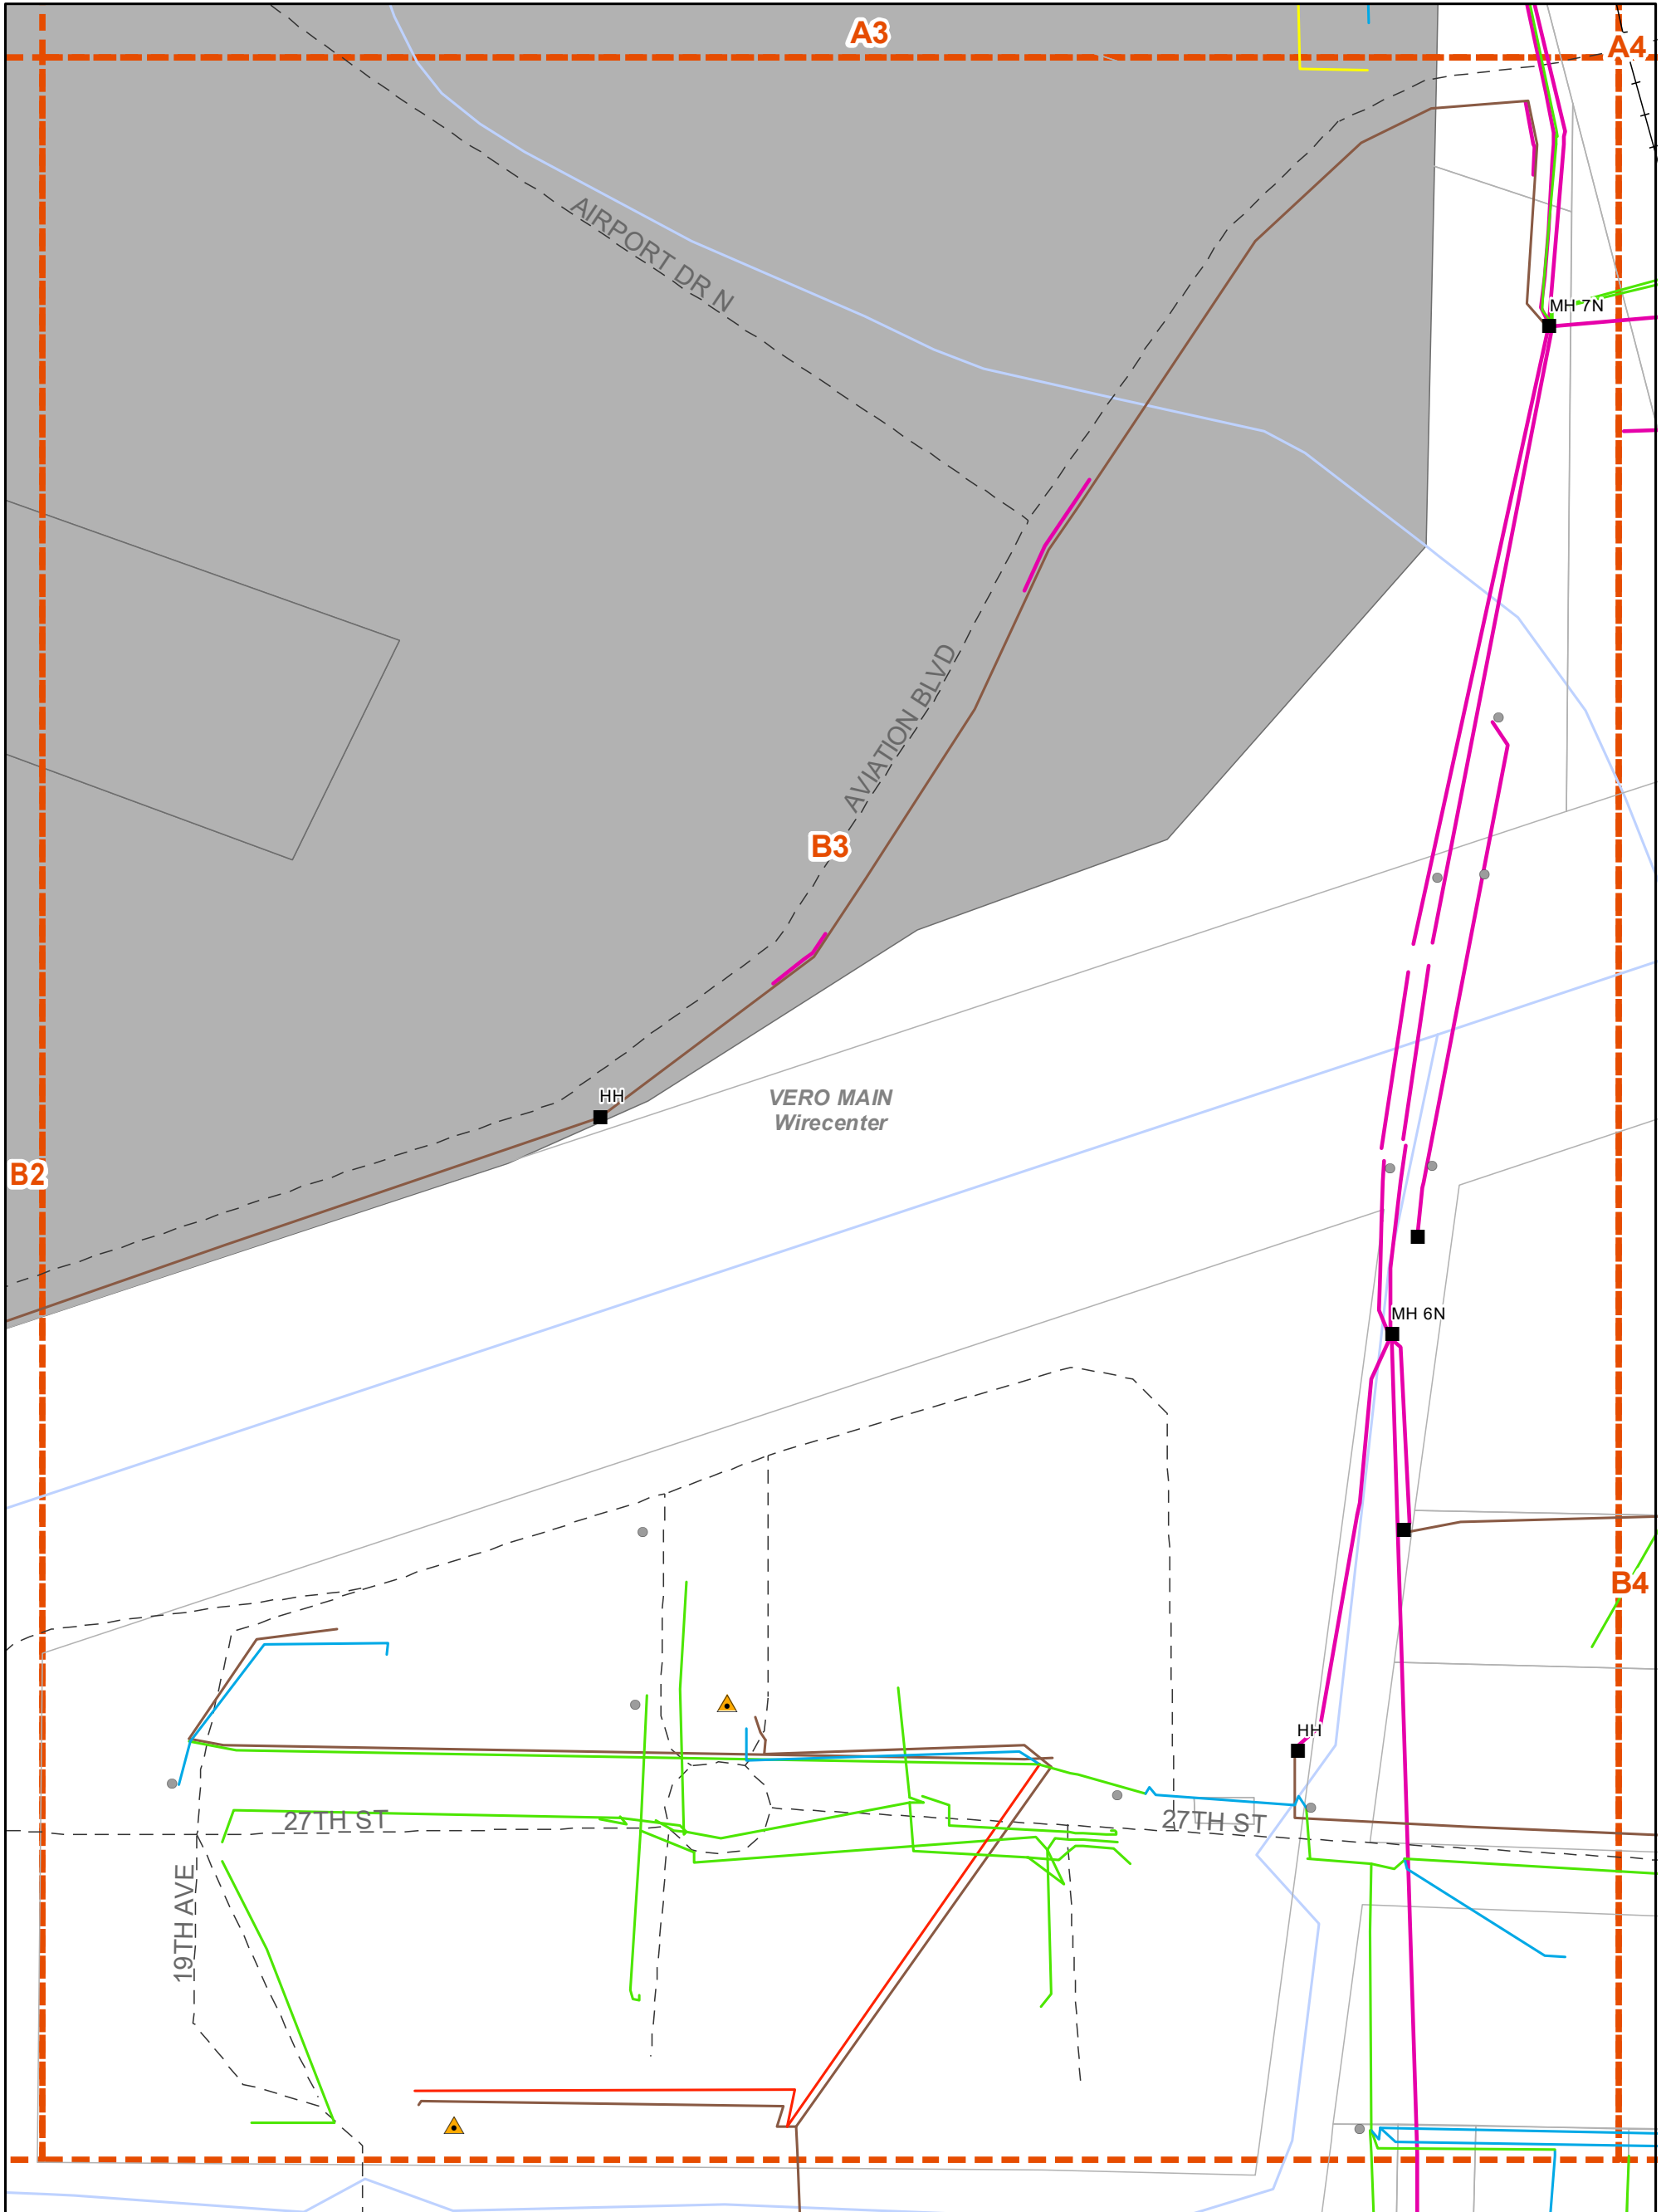

1:1,820



- Poles
- ▲ Remote Terminals
- Manholes
- Aerial
- Building
- Buried
- Underground
- Floating
- Submarine
- Other
- Conduit
- Railroads
- Street Centerlines
- Mapping Index
- Wirecenter Boundary
- Parcels




Copyright 2020 AT&T Intellectual Property. All rights reserved. AT&T and the AT&T logo are trademarks of AT&T Intellectual Property. The copying, scanning or other reproduction of this map without prior written permission of AT&T Intellectual Property is strictly prohibited. This map is provided 'as is'. Neither AT&T Intellectual Property nor any of its affiliates shall have any liability whatsoever to any person or entity for or on account of any injury, loss, or damage of any kind of nature sustained by, or any liability incurred by or imposed upon any other person or entity arising out of or in connection with or resulting from the use of this map.

Location of facilities shown herein are subject to field verification. No liability is assumed by AT&T as to the accuracy of location facilities. Please call USA at 811 two working days in advance of any grading or excavation in vicinity of our underground facilities. AT&T proprietary (internal use only). Not for use or disclosure outside the AT&T companies except under written agreement. Telco proprietary data is not to be disclosed to sited employees.

AT&T PROPRIETARY-This information constitutes confidential trade secrets and commercial or financial information owned by AT&T and is shared for Critical Infrastructure Protection purposes only. It is exempt from disclosure under the Freedom of Information Act (5 USC 552), Exemptions (b)(3)&(4), and its disclosure is prohibited under the Trade Secrets Act (18 USC 1905), the Critical Infrastructure Information Act of 2002, 6 USC 133, and any State or local law requiring disclosure of information or records. This information must not be copied or distributed to others not agreed upon by AT&T, but in all events do not copy or distribute to such others without notification pursuant to Executive Order 12600.



## Aviation Blvd Pande Study From 27Th Ave To Us1 Markup Project

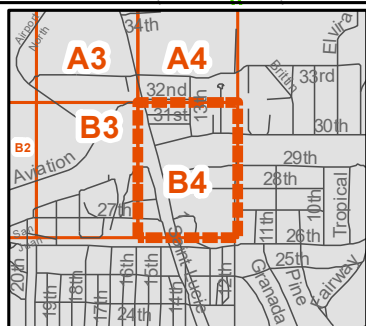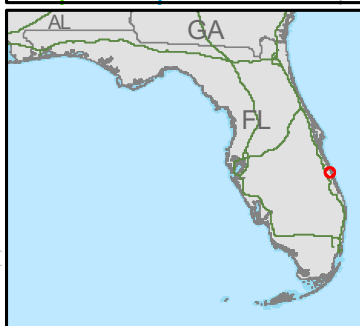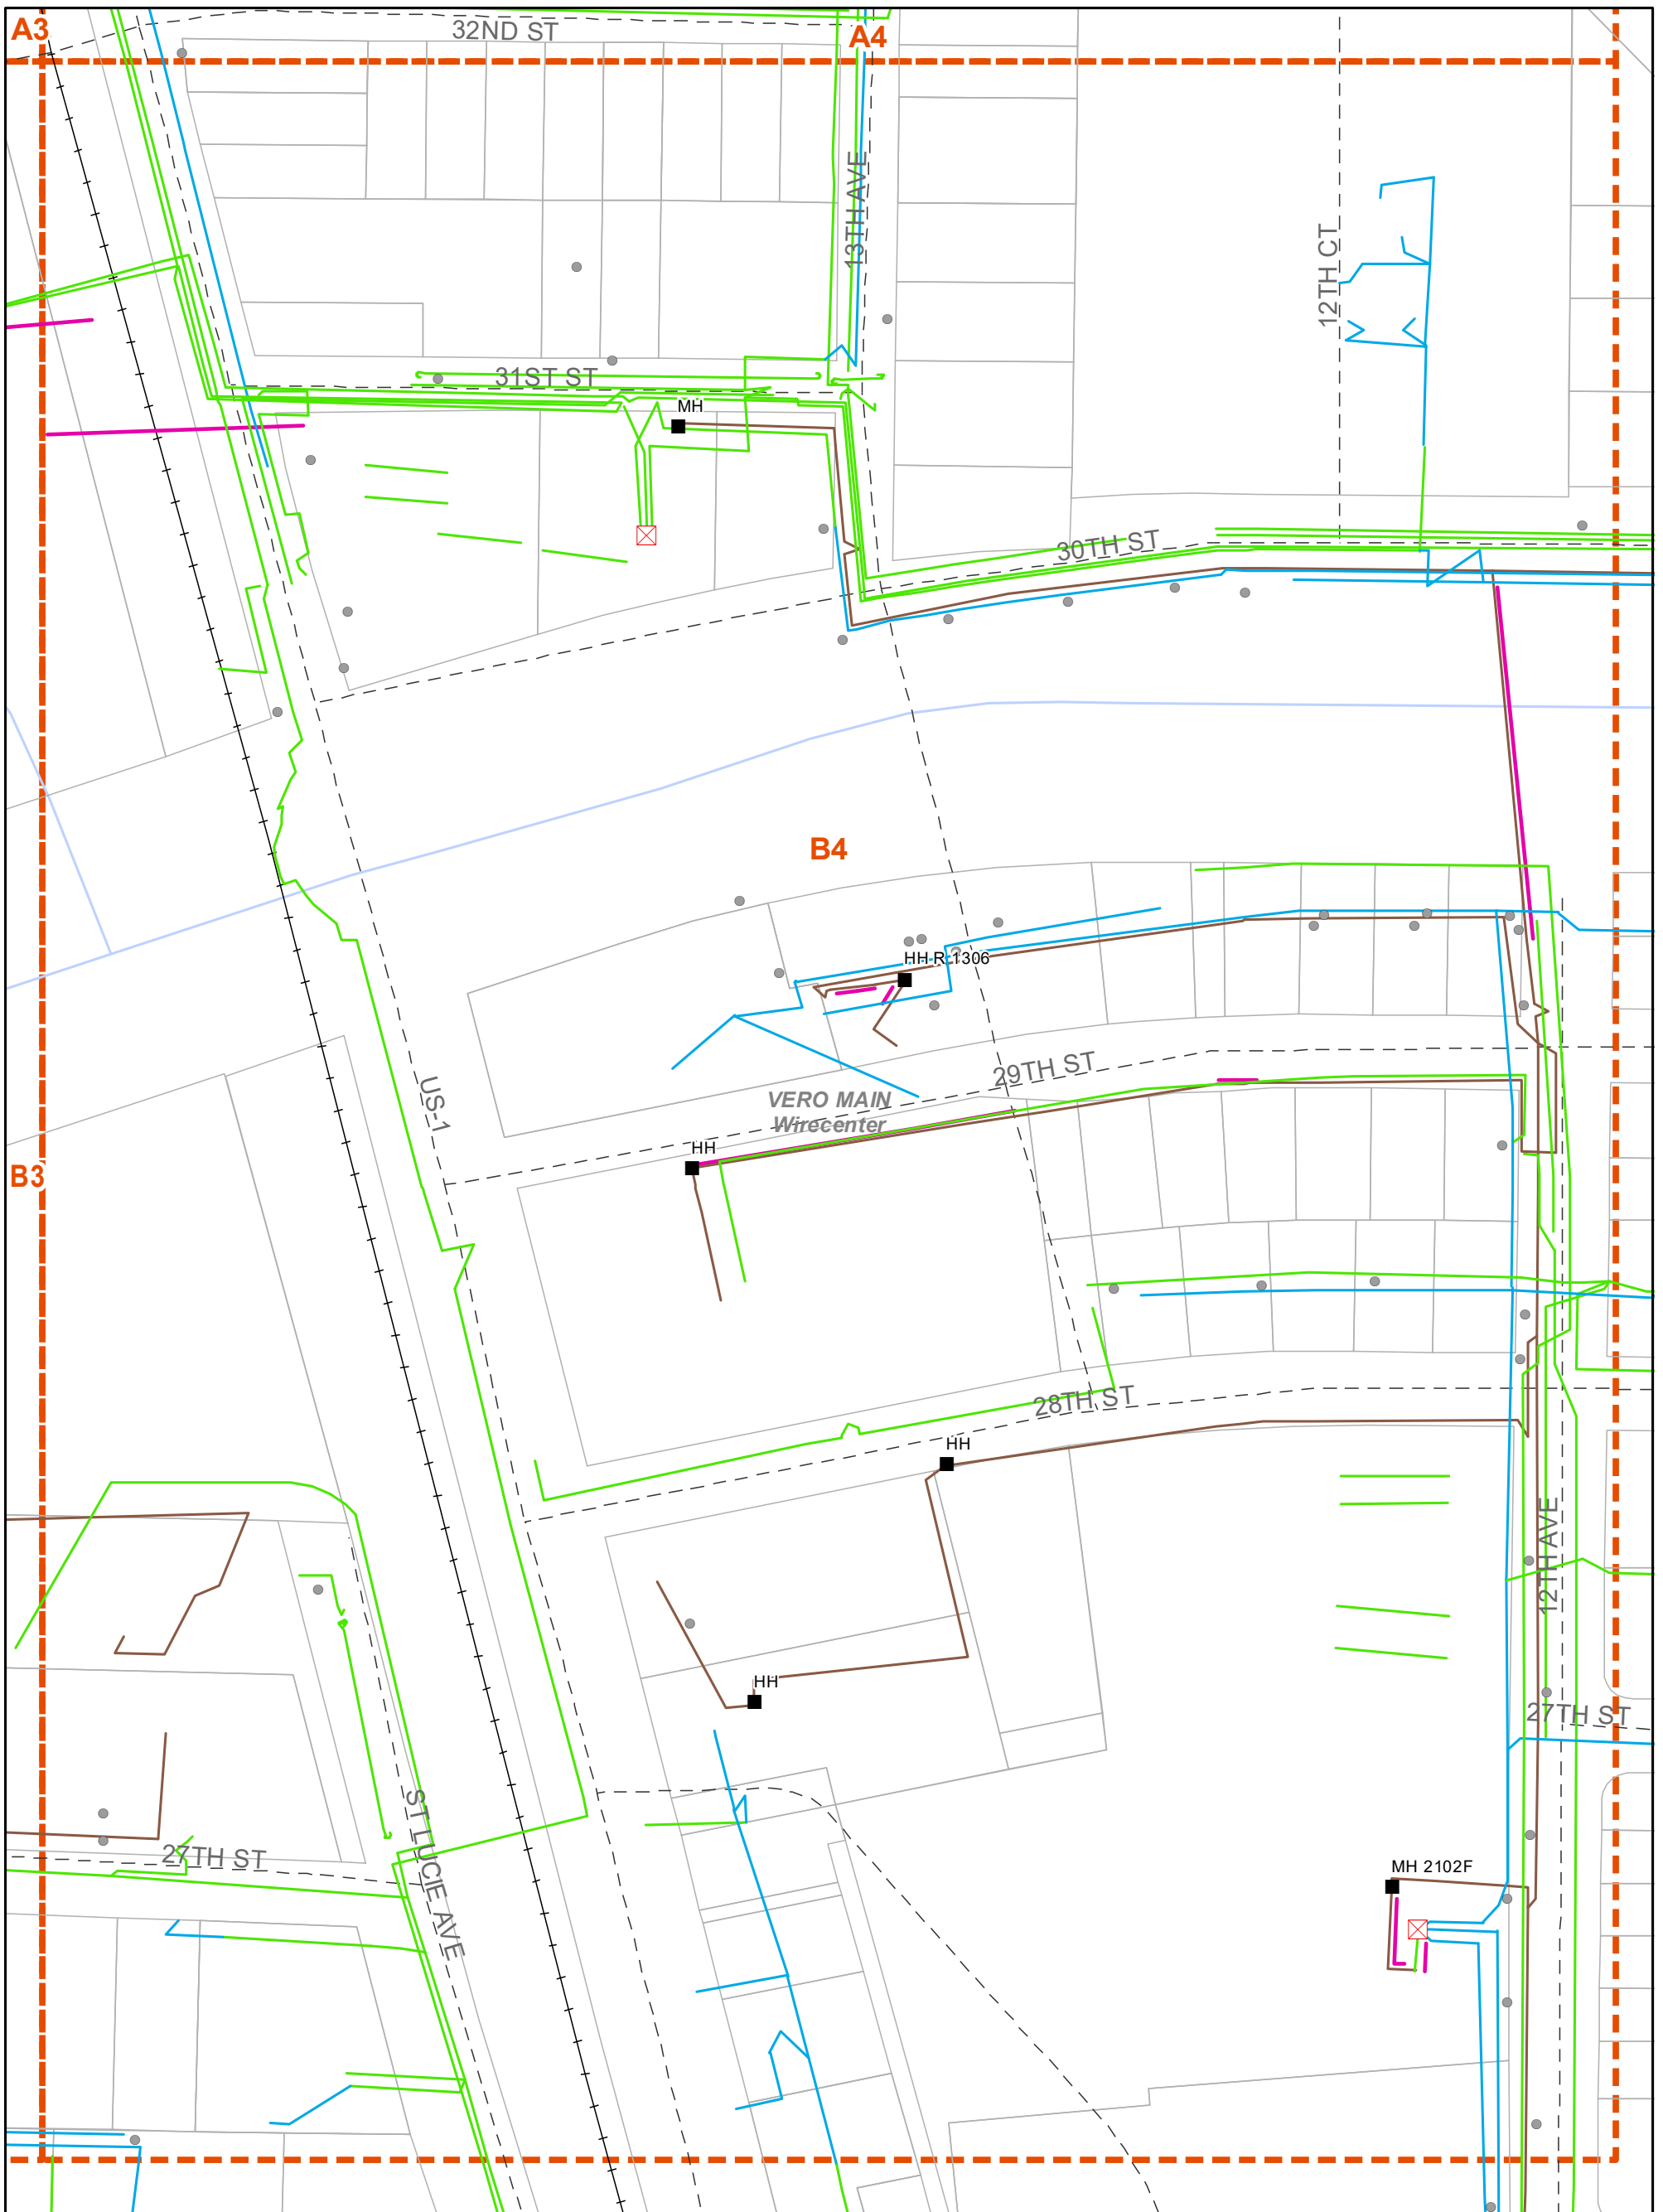

1:1,820



- Poles
- ⊠ SAls
- Manholes
- ⚡ Aerial
- 🏠 Building
- 🌿 Buried
- 📉 Underground
- 🌊 Floating
- 🌊 Submarine
- 📏 Other
- 📏 Conduit
- 🚂 Railroads
- 📏 Street Centerlines
- 📏 Mapping Index
- 📏 Wirecenter Boundary
- 📏 Parcels

Copyright 2020 AT&T Intellectual Property. All rights reserved. AT&T and the AT&T logo are trademarks of AT&T Intellectual Property. The copying, scanning or other reproduction of this map without prior written permission of AT&T Intellectual Property is strictly prohibited. This map is provided 'as is'. Neither AT&T Intellectual Property nor any of its affiliates shall have any liability whatsoever to any person or entity for or on account of any injury, loss, or damage of any kind of nature sustained by, or any liability incurred by or imposed upon any other person or entity arising out of or in connection with or resulting from the use of this map.

Location of facilities shown herein are subject to field verification. No liability is assumed by AT&T as to the accuracy of location facilities. Please call USA at 811 two working days in advance of any grading or excavation in vicinity of our underground facilities. AT&T proprietary (internal use only). Not for use or disclosure outside the AT&T companies except under written agreement. Telco proprietary data is not to be disclosed to sited employees.

AT&T PROPRIETARY-This information constitutes confidential trade secrets and commercial or financial information owned by AT&T and is shared for Critical Infrastructure Protection purposes only. It is exempt from disclosure under the Freedom of Information Act (5 USC 552), Exemptions (b)(3)&(4), and its disclosure is prohibited under the Trade Secrets Act (18 USC 1905), the Critical Infrastructure Information Act of 2002, 6 USC 133, and any State or local law requiring disclosure of information or records. This information must not be copied or distributed to others not agreed upon by AT&T, but in all events do not copy or distribute to such others without notification pursuant to Executive Order 12600.








# External Map Request for Wgi

## Us1 Pande Study Atandt Markup Project

Date: 6/7/2023

Page Name: A1

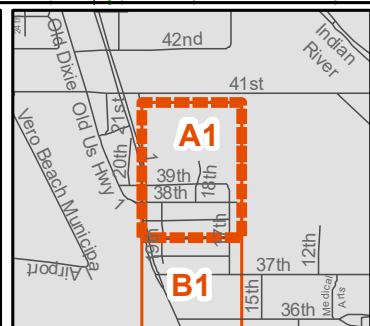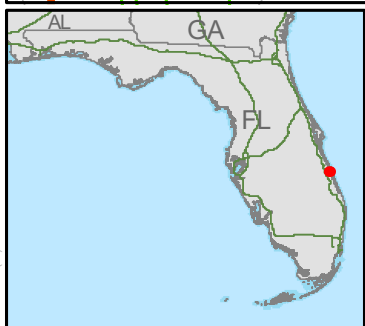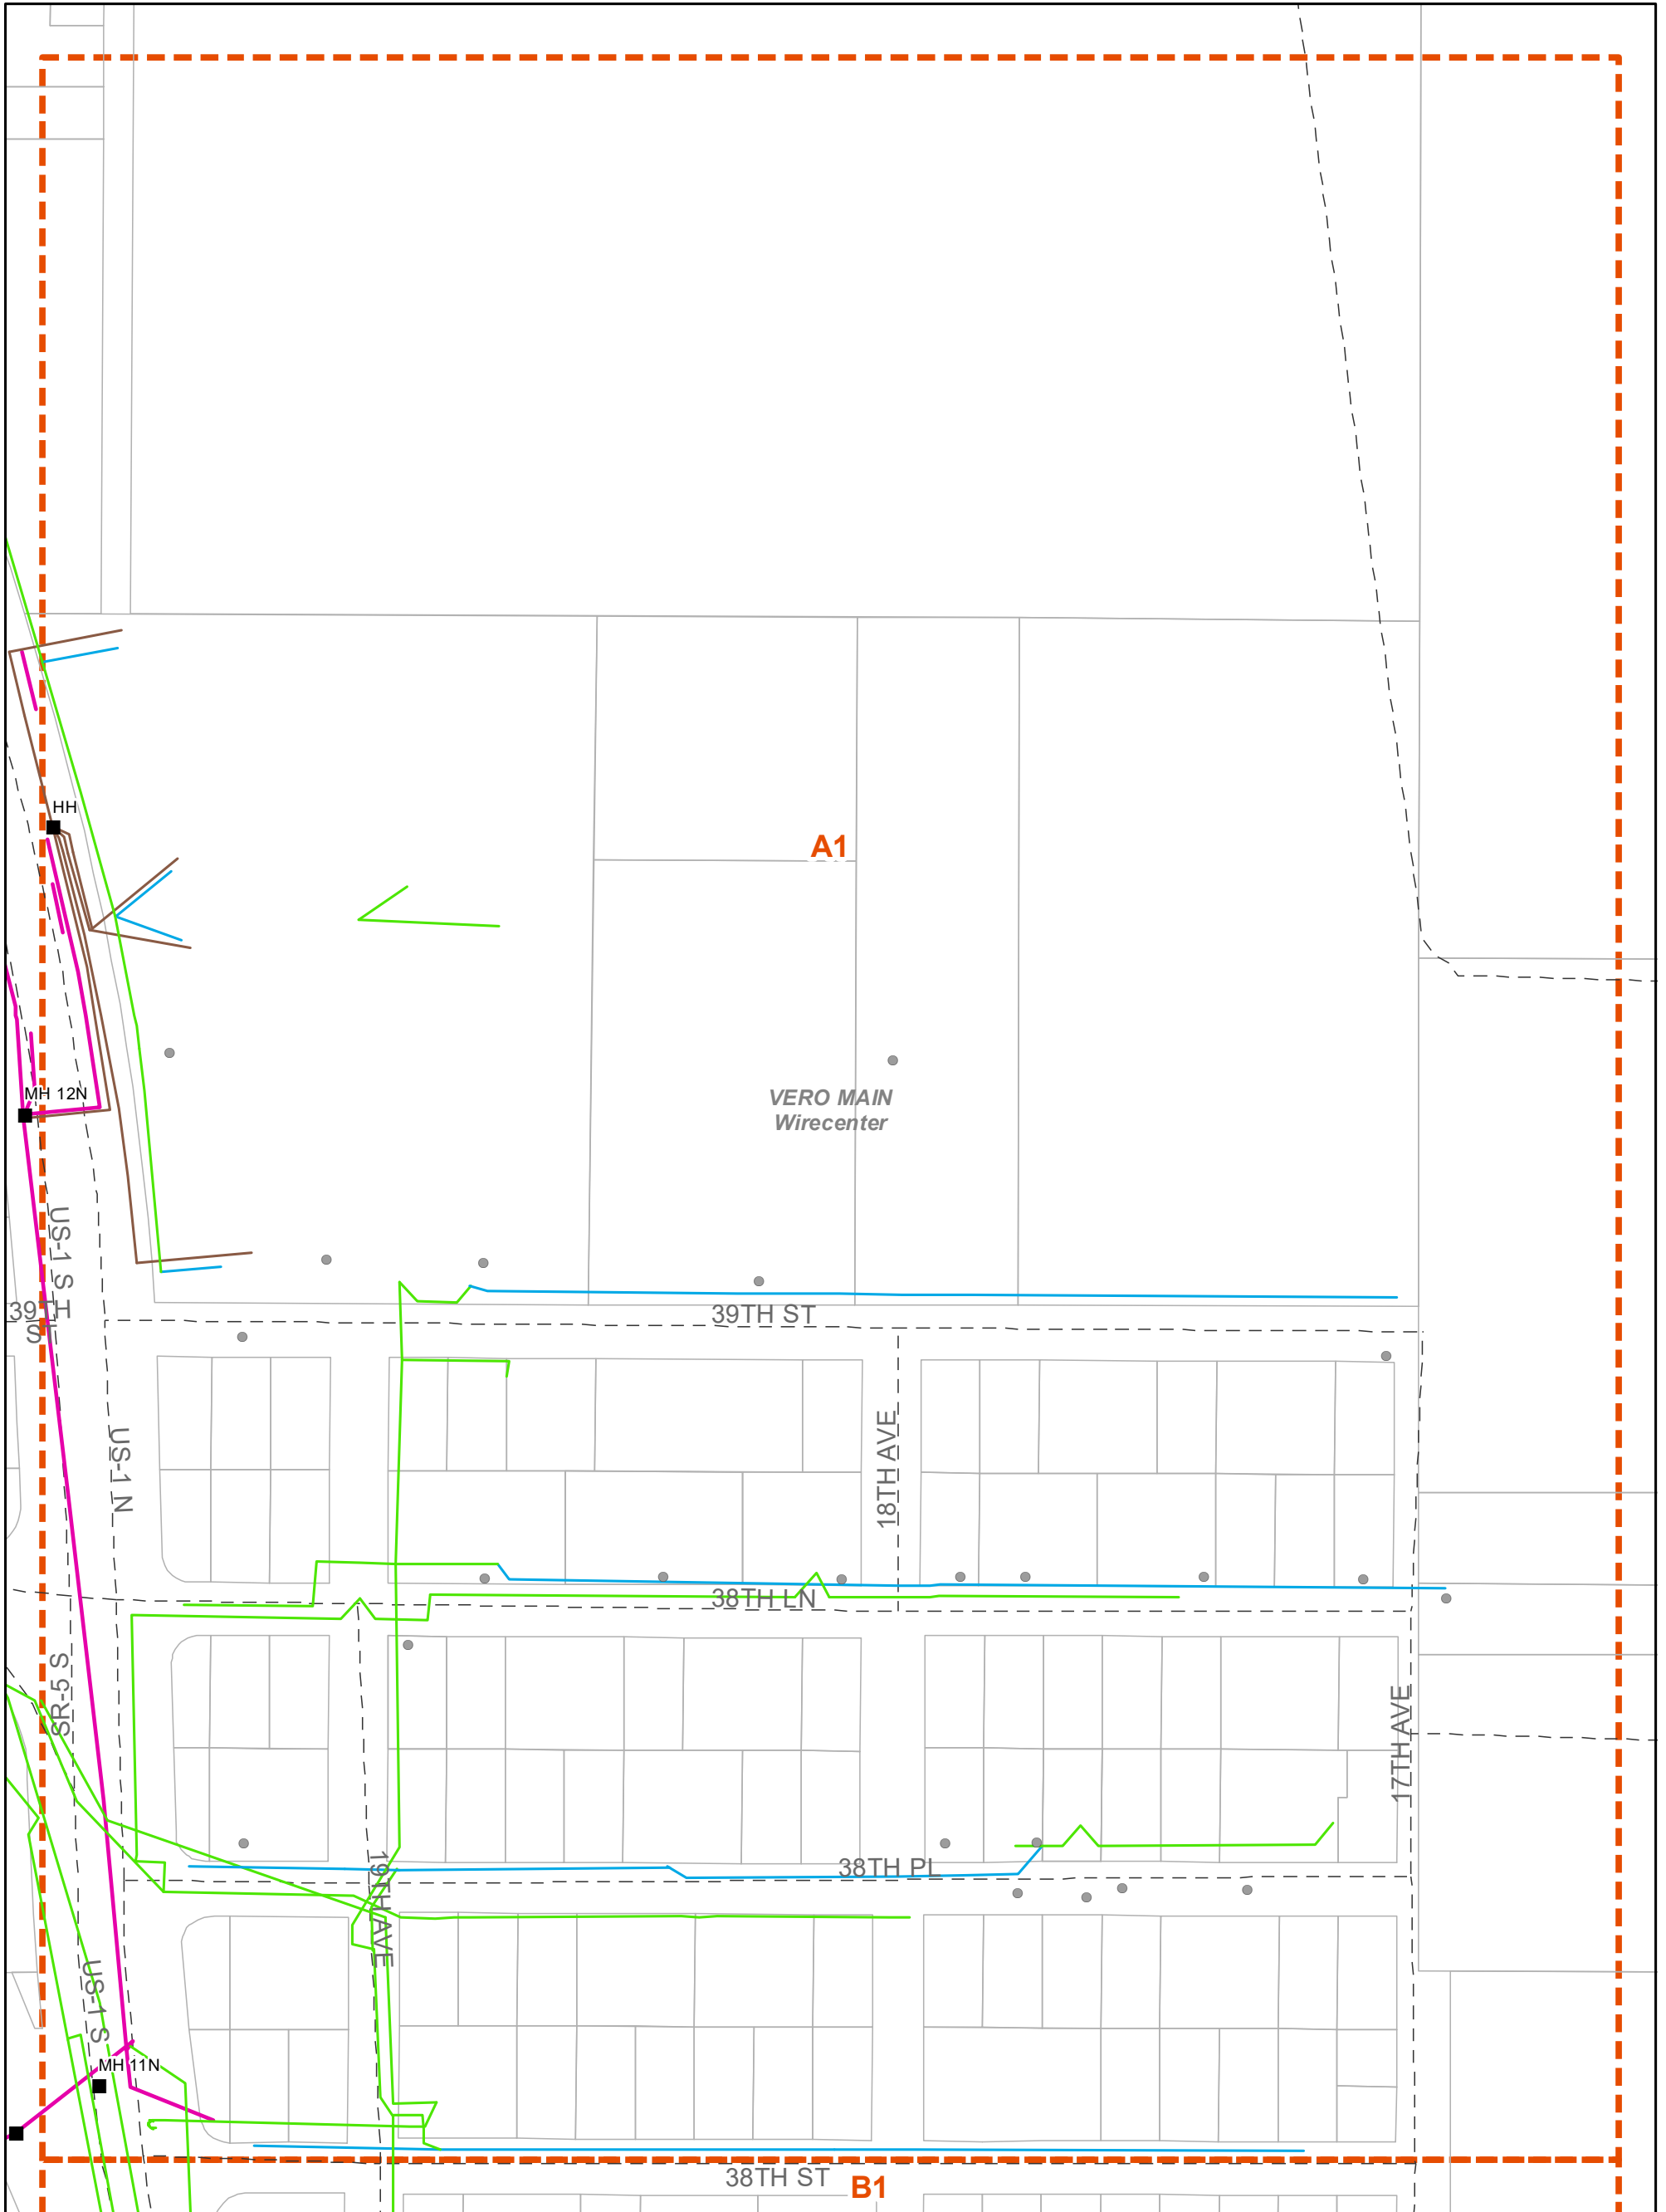

1:1,820



- Poles
- Manholes
- Aerial
- Building
- Buried
- Underground
- Floating
- Submarine
- Other
- Conduit
- Street Centerlines
- Mapping Index
- Wirecenter Boundary
- Parcels

Copyright 2020 AT&T Intellectual Property. All rights reserved. AT&T and the AT&T logo are trademarks of AT&T Intellectual Property. The copying, scanning or other reproduction of this map without prior written permission of AT&T Intellectual Property is strictly prohibited. This map is provided 'as is'. Neither AT&T Intellectual Property nor any of its affiliates shall have any liability whatsoever to any person or entity for or on account of any injury, loss, or damage of any kind of nature sustained by, or any liability incurred by or imposed upon any other person or entity arising out of or in connection with or resulting from the use of this map.

Location of facilities shown herein are subject to field verification. No liability is assumed by AT&T as to the accuracy of location facilities. Please call USA at 811 two working days in advance of any grading or excavation in vicinity of our underground facilities. AT&T propriety (internal use only). Not for use or disclosure outside the AT&T companies except under written agreement. Telco proprietary data is not to be disclosed to sited employees.

AT&T PROPRIETARY-This information constitutes confidential trade secrets and commercial or financial information owned by AT&T and is shared for Critical Infrastructure Protection purposes only. It is exempt from disclosure under the Freedom of Information Act(5 USC 552), Exemptions (b)(3)&(4), and its disclosure is prohibited under the Trade Secrets Act(18 USC 1905), the Critical Infrastructure Information Act of 2002, 6 USC 133, and any State or local law requiring disclosure of information or records. This information must not be copied or distributed to others not agreed upon by AT&T, but in all events do not copy or distribute to such others without notification pursuant to Executive Order 12600.





# External Map Request for Wgi

## Us1 Pande Study Atandt Markup Project

Date: 6/7/2023

Page Name: B1

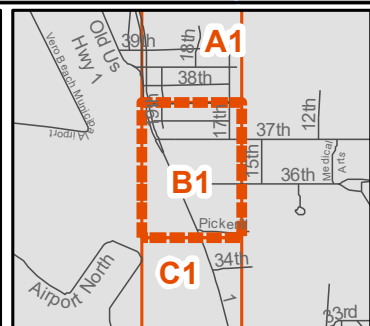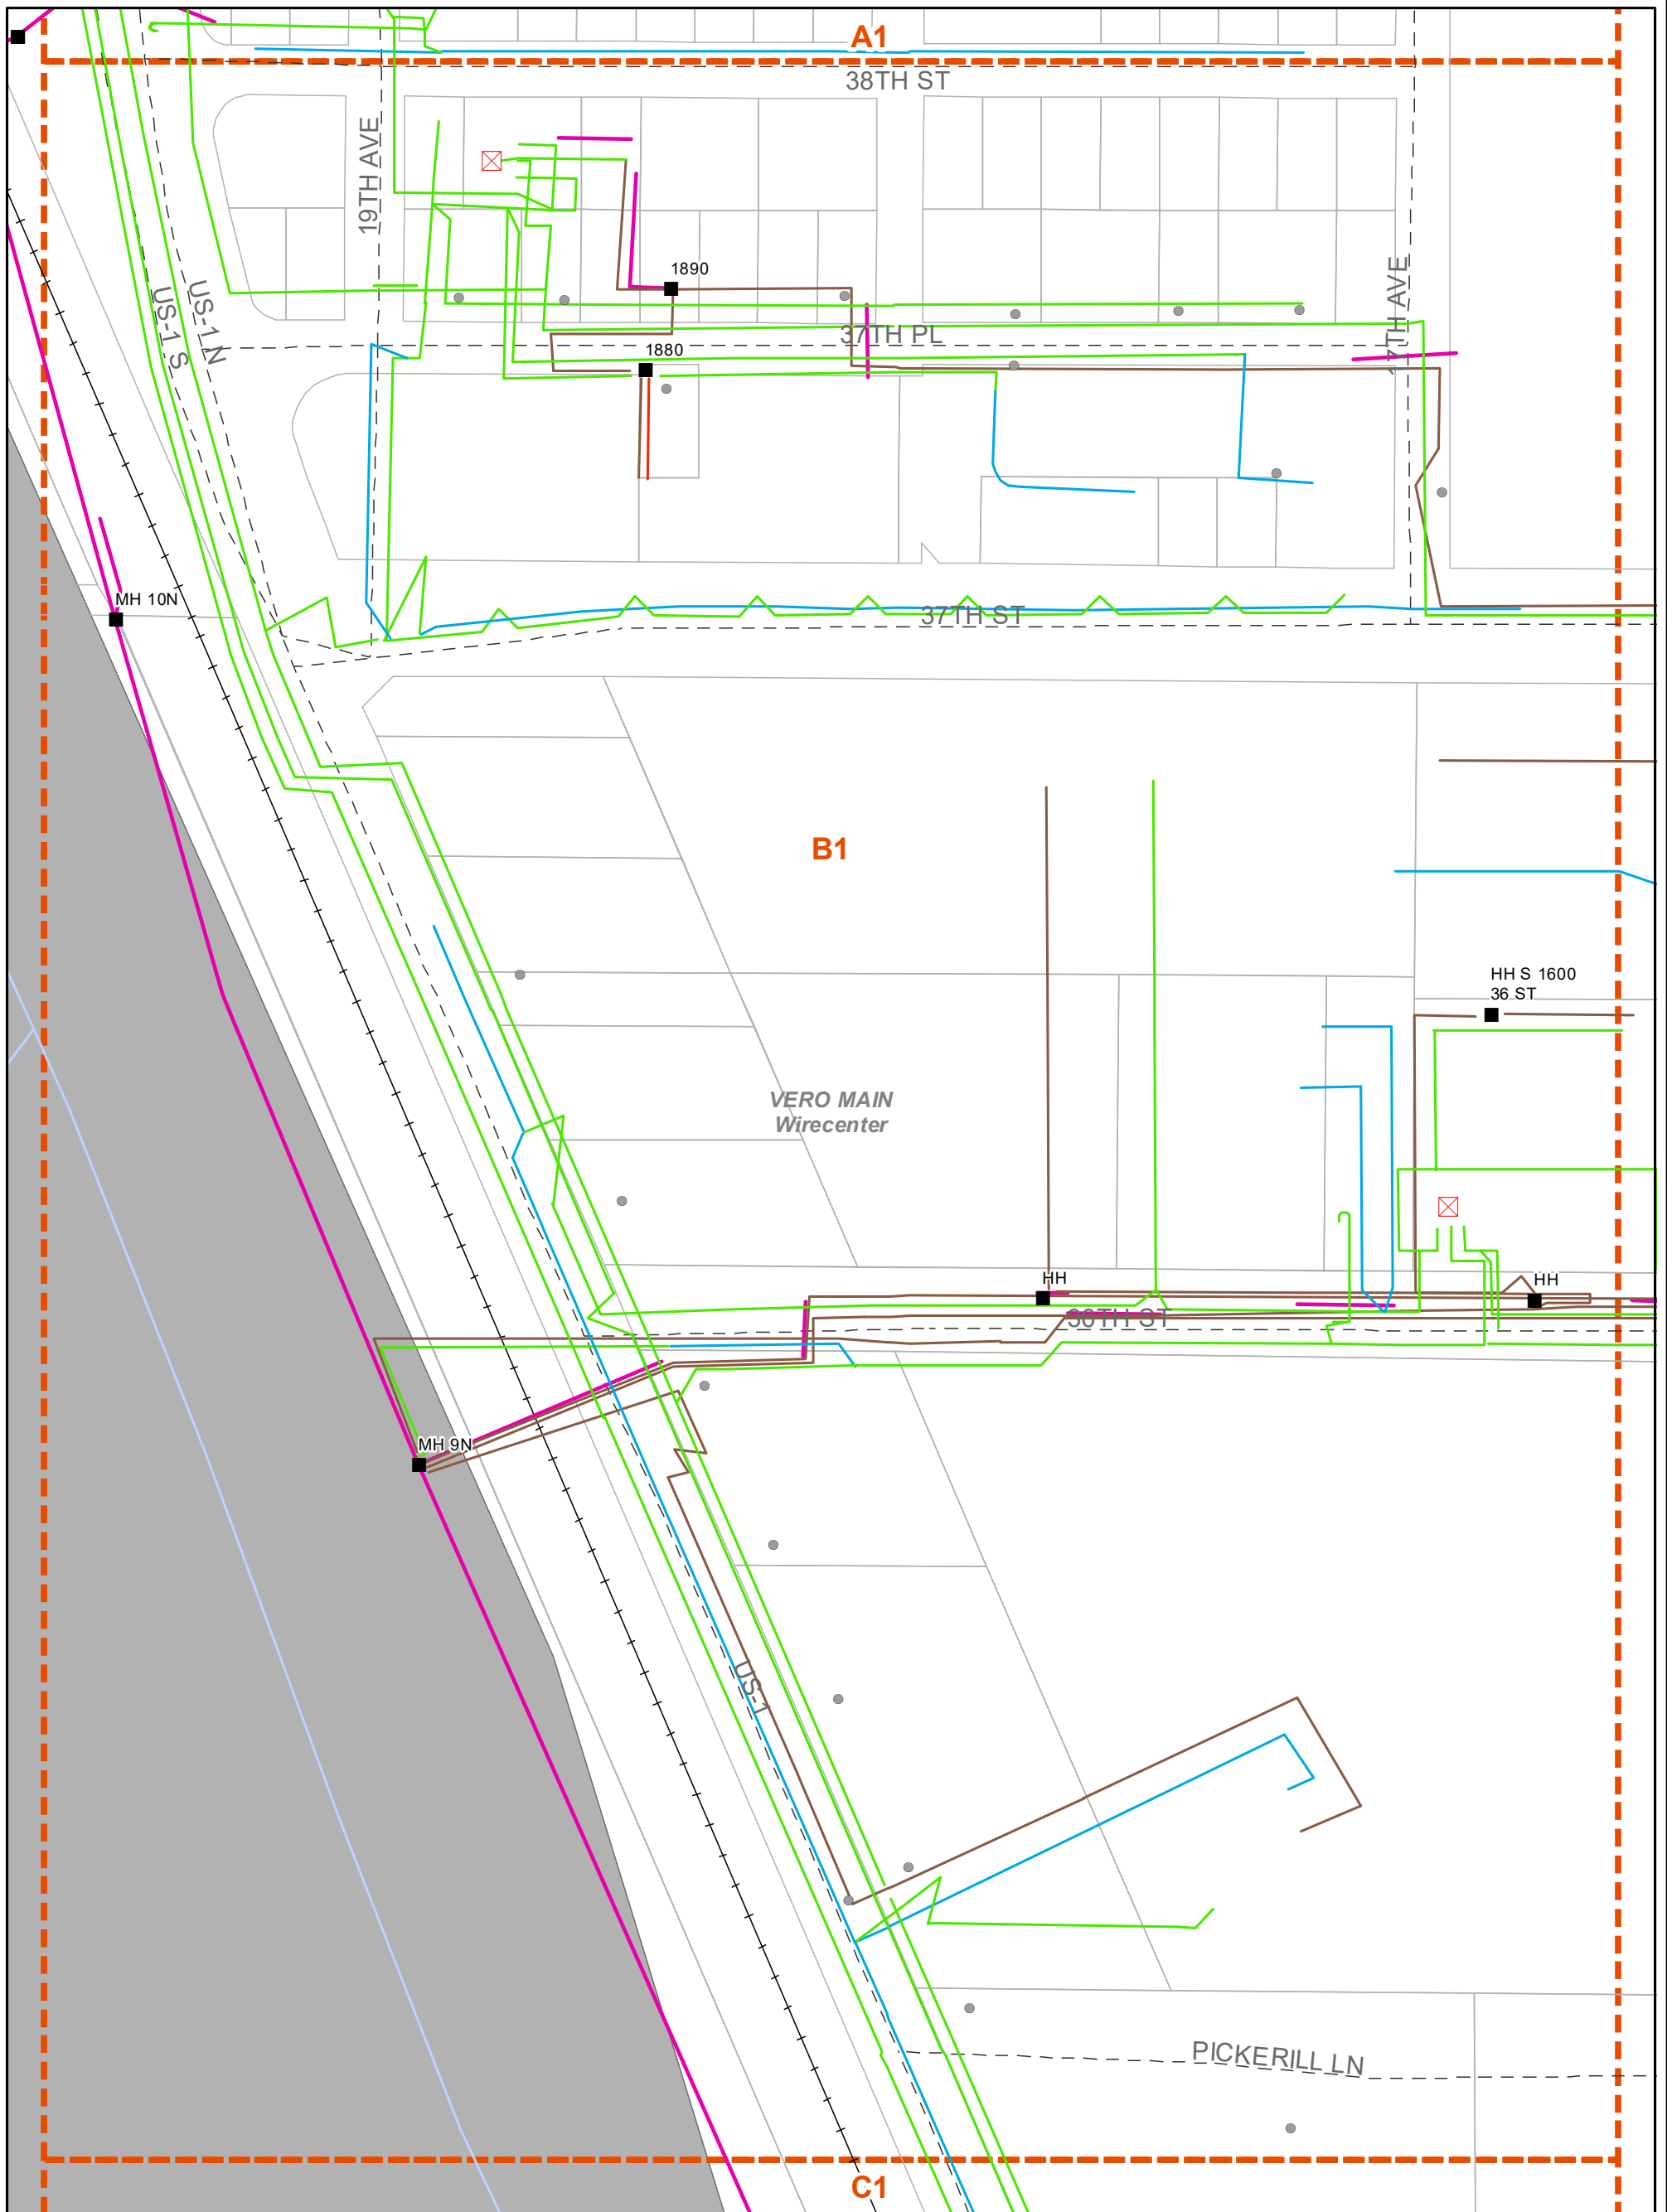

1:1,820



- Poles
- ⊠ SAIs
- Manholes
- Aerial
- Building
- Buried
- Underground
- Floating
- Submarine
- Other
- Conduit
- Railroads
- Street Centerlines
- Mapping Index
- Wirecenter Boundary
- Parcels

Copyright 2020 AT&T Intellectual Property. All rights reserved. AT&T and the AT&T logo are trademarks of AT&T Intellectual Property. The copying, scanning or other reproduction of this map without prior written permission of AT&T Intellectual Property is strictly prohibited. This map is provided 'as is'. Neither AT&T Intellectual Property nor any of its affiliates shall have any liability whatsoever to any person or entity for or on account of any injury, loss, or damage of any kind of nature sustained by, or any liability incurred by or imposed upon any other person or entity arising out of or in connection with or resulting from the use of this map.

Location of facilities shown herein are subject to field verification. No liability is assumed by AT&T as to the accuracy of location facilities. Please call USA at 811 two working days in advance of any grading or excavation in vicinity of our underground facilities. AT&T proprietary (internal use only). Not for use or disclosure outside the AT&T companies except under written agreement. Telco proprietary data is not to be disclosed to sited employees.

AT&T PROPRIETARY-This information constitutes confidential trade secrets and commercial or financial information owned by AT&T and is shared for Critical Infrastructure Protection purposes only. It is exempt from disclosure under the Freedom of Information Act (5 USC 552), Exemptions (b)(3)&(4), and its disclosure is prohibited under the Trade Secrets Act (18 USC 1905), the Critical Infrastructure Information Act of 2002, 6 USC 133, and any State or local law requiring disclosure of information or records. This information must not be copied or distributed to others not agreed upon by AT&T, but in all events do not copy or distribute to such others without notification pursuant to Executive Order 12600.





# External Map Request for Wgi

## Us1 Pande Study Atandt Markup Project

Date: 6/7/2023

Page Name: C1

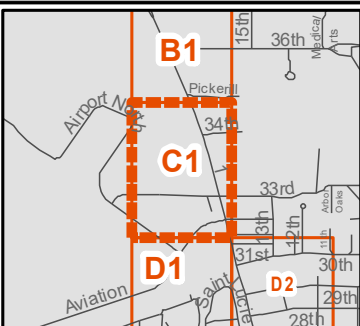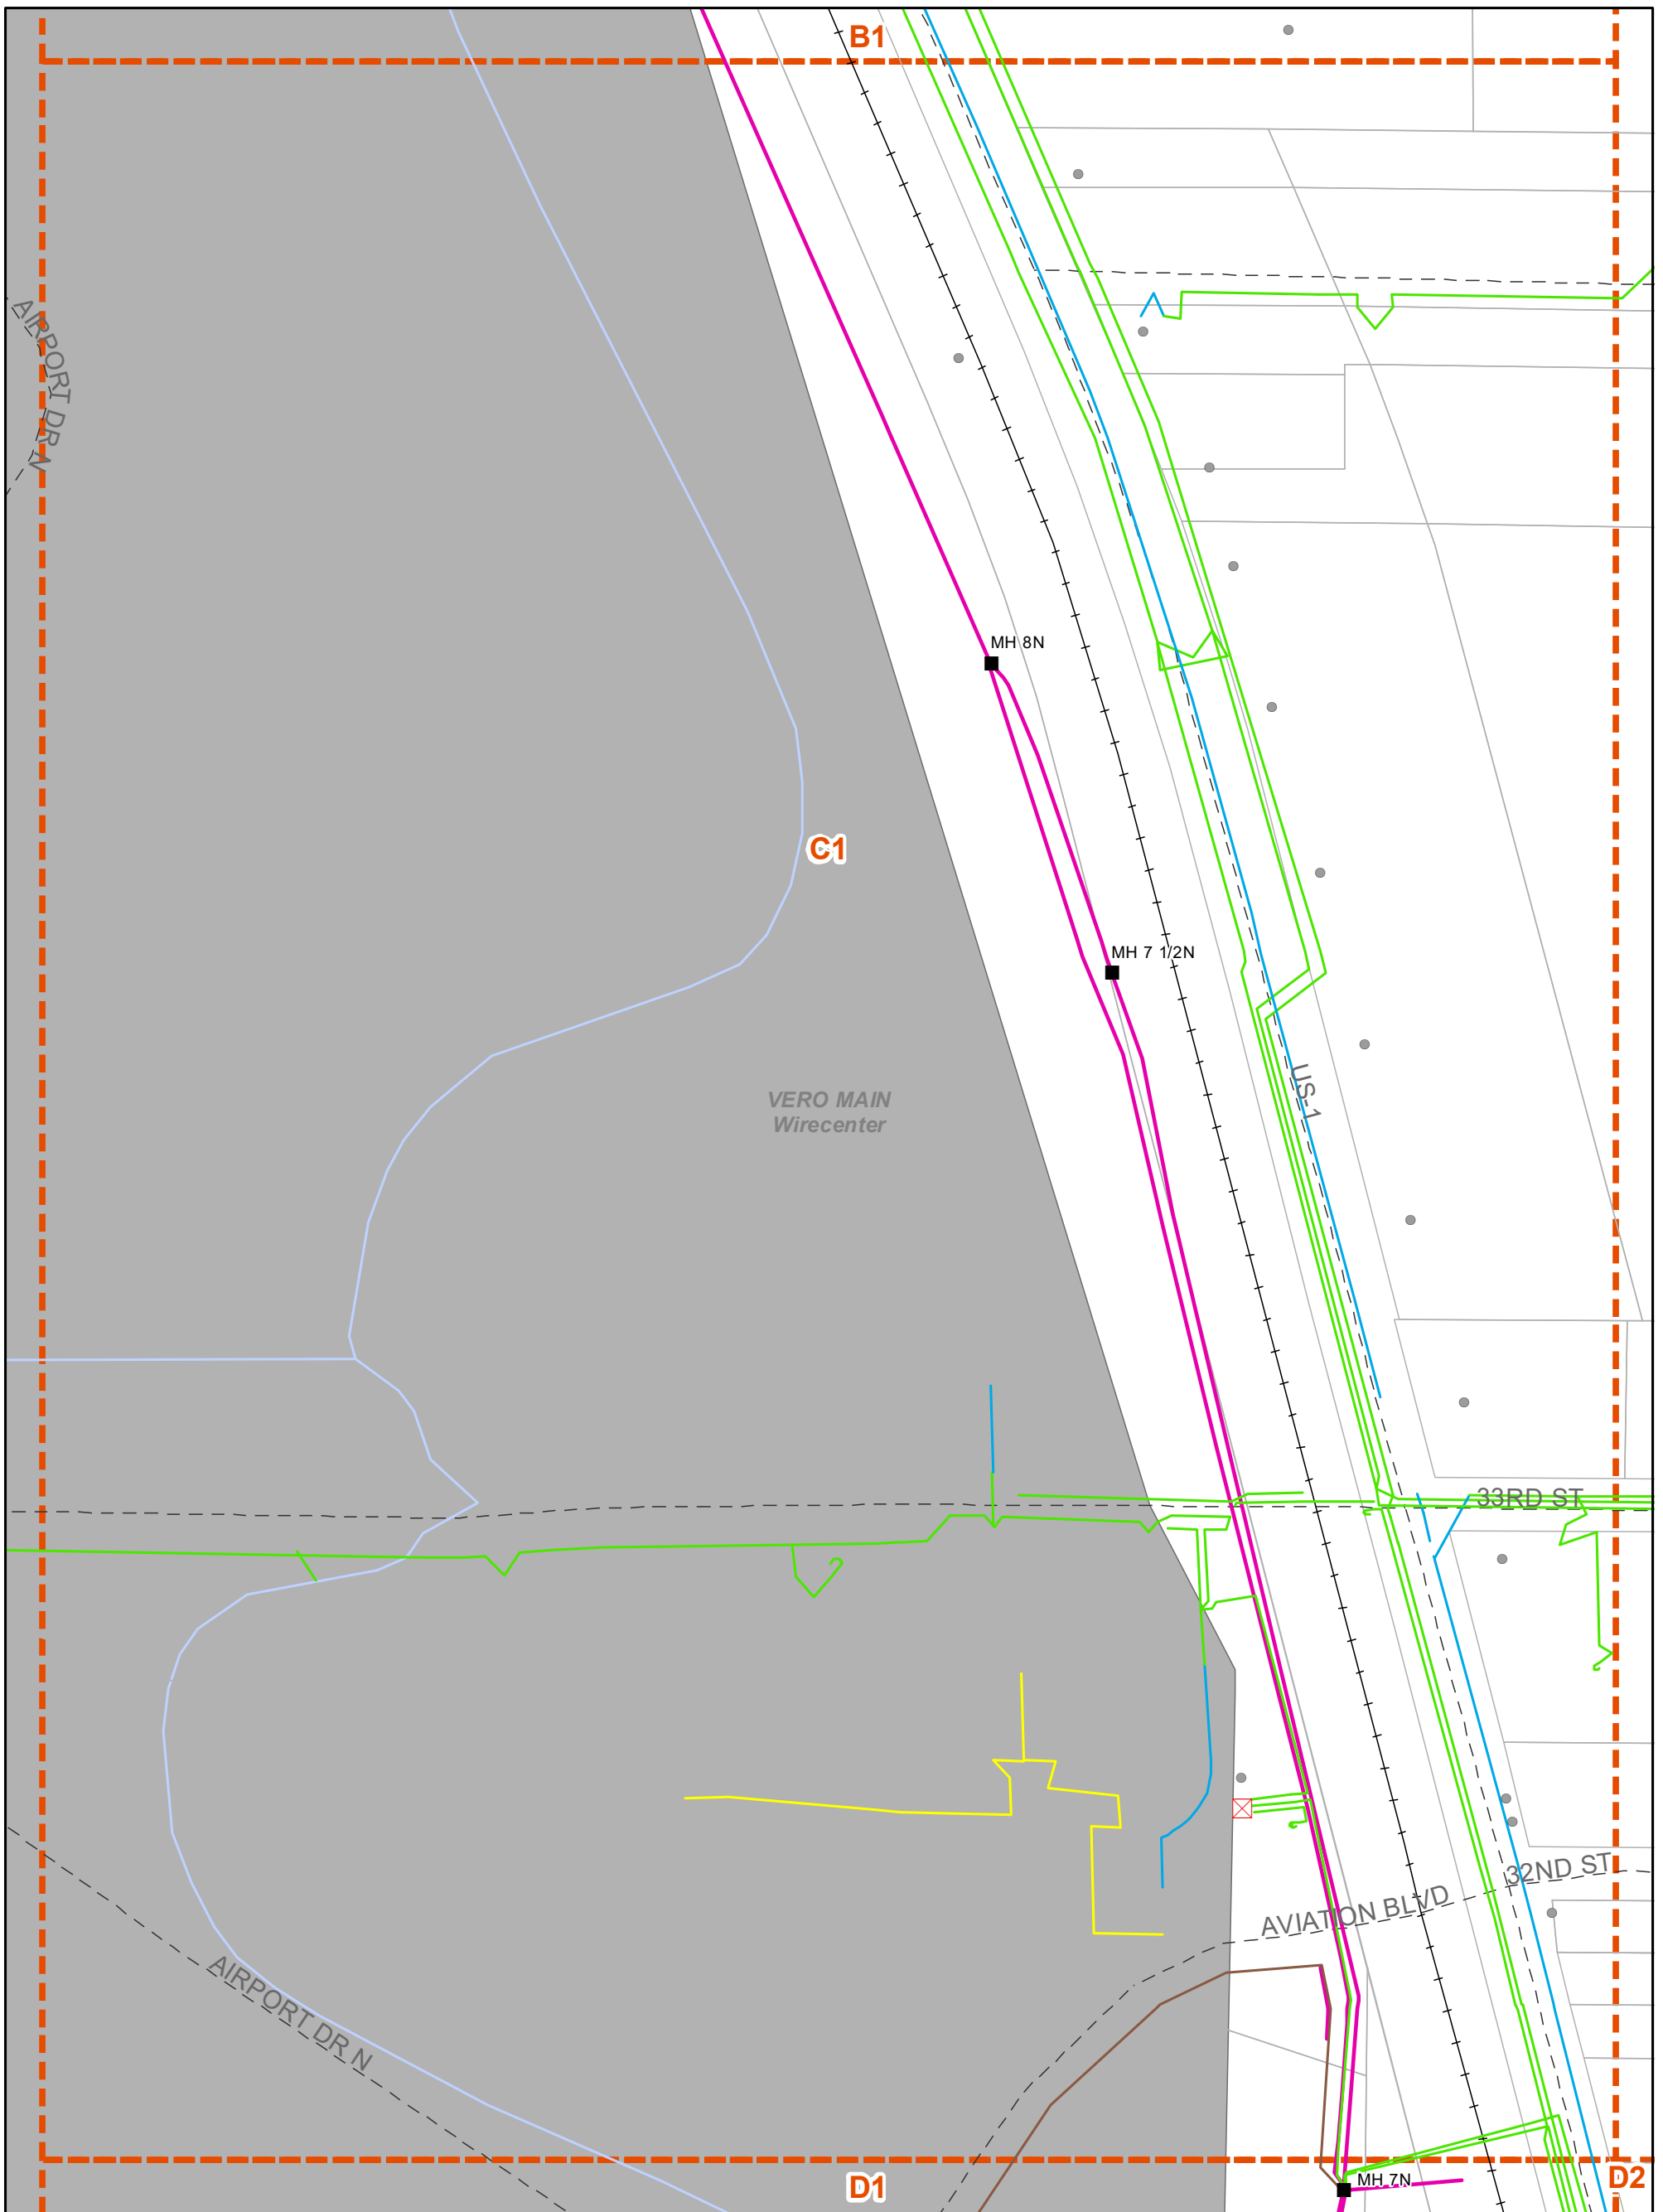

1:1,820



- Poles
- ⊠ SAls
- Manholes
- ⚡ Aerial
- 🏠 Building
- 🌿 Buried
- 📏 Underground
- 🌊 Floating
- 🌊 Submarine
- 📏 Other
- 📏 Conduit
- 🚂 Railroads
- 📏 Street Centerlines
- 📏 Mapping Index
- 📏 Wirecenter Boundary
- 📏 Parcels

Copyright 2020 AT&T Intellectual Property. All rights reserved. AT&T and the AT&T logo are trademarks of AT&T Intellectual Property. The copying, scanning or other reproduction of this map without prior written permission of AT&T Intellectual Property is strictly prohibited. This map is provided 'as is'. Neither AT&T Intellectual Property nor any of its affiliates shall have any liability whatsoever to any person or entity for or on account of any injury, loss, or damage of any kind of nature sustained by, or any liability incurred by or imposed upon any other person or entity arising out of or in connection with or resulting from the use of this map.

Location of facilities shown herein are subject to field verification. No liability is assumed by AT&T as to the accuracy of location facilities. Please call USA at 811 two working days in advance of any grading or excavation in vicinity of our underground facilities. AT&T proprietary (internal use only). Not for use or disclosure outside the AT&T companies except under written agreement. Telco proprietary data is not to be disclosed to sited employees.

AT&T PROPRIETARY-This information constitutes confidential trade secrets and commercial or financial information owned by AT&T and is shared for Critical Infrastructure Protection purposes only. It is exempt from disclosure under the Freedom of Information Act(5 USC 552), Exemptions (b)(3)&(4), and its disclosure is prohibited under the Trade Secrets Act(18 USC 1905), the Critical Infrastructure Information Act of 2002, 6 USC 133, and any State or local law requiring disclosure of information or records. This information must not be copied or distributed to others not agreed upon by AT&T, but in all events do not copy or distribute to such others without notification pursuant to Executive Order 12600.






# External Map Request for Wgi

## Us1 Pande Study Atandt Markup Project

Date: 6/7/2023

Page Name: D1

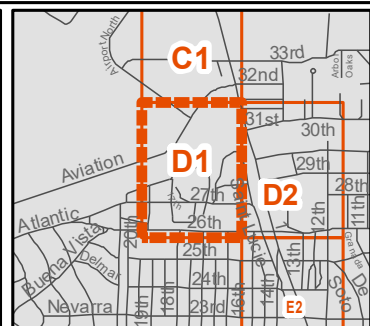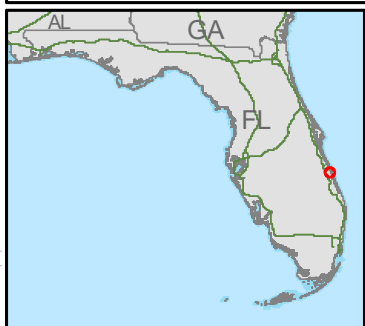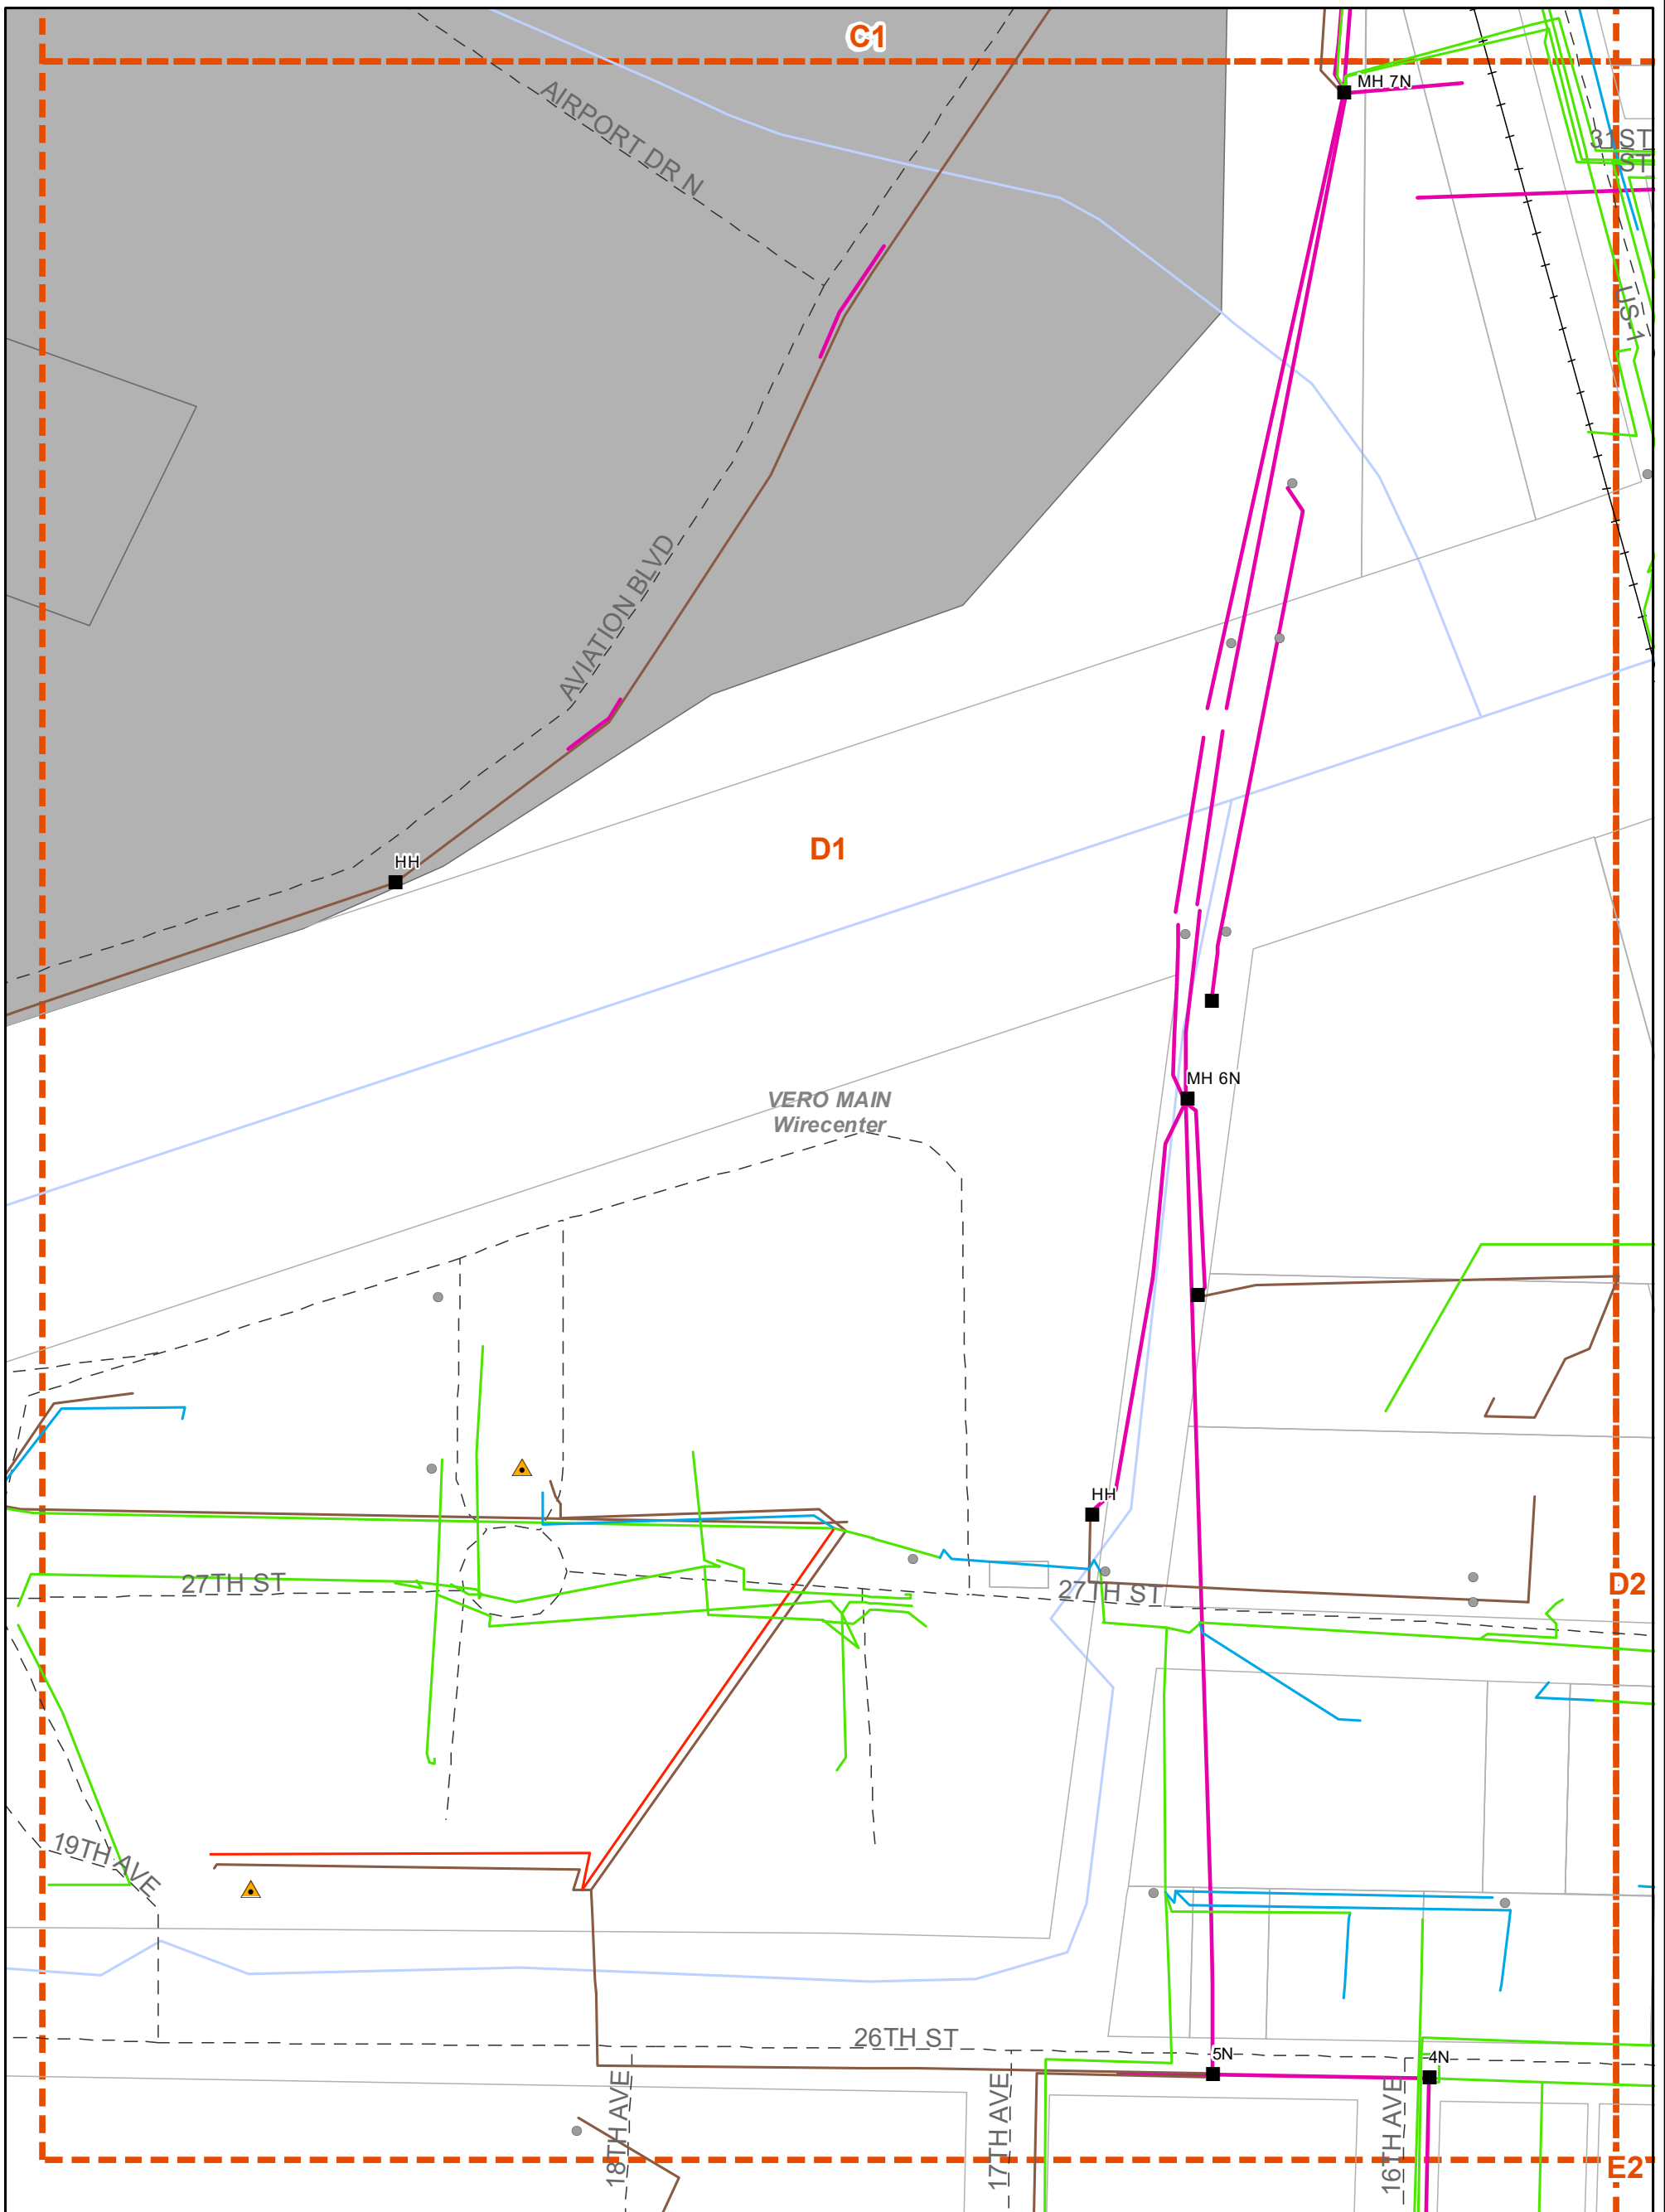

1:1,820

- Poles
- ▲ Remote Terminals
- Manholes
- Aerial
- Building
- Buried
- Underground
- Floating
- Submarine
- Other
- Conduit
- Railroads
- Street Centerlines
- Mapping Index
- Wirecenter Boundary
- Parcels

Copyright 2020 AT&T Intellectual Property. All rights reserved. AT&T and the AT&T logo are trademarks of AT&T Intellectual Property. The copying, scanning or other reproduction of this map without prior written permission of AT&T Intellectual Property is strictly prohibited. This map is provided 'as is'. Neither AT&T Intellectual Property nor any of its affiliates shall have any liability whatsoever to any person or entity for or on account of any injury, loss, or damage of any kind of nature sustained by, or any liability incurred by or imposed upon any other person or entity arising out of or in connection with or resulting from the use of this map.

Location of facilities shown herein are subject to field verification. No liability is assumed by AT&T as to the accuracy of location facilities. Please call USA at 811 two working days in advance of any grading or excavation in vicinity of our underground facilities. AT&T proprietary (internal use only). Not for use or disclosure outside the AT&T companies except under written agreement. Telco proprietary data is not to be disclosed to sited employees.

AT&T PROPRIETARY-This information constitutes confidential trade secrets and commercial or financial information owned by AT&T and is shared for Critical Infrastructure Protection purposes only. It is exempt from disclosure under the Freedom of Information Act (5 USC 552). Exemptions (b)(3)&(4), and its disclosure is prohibited under the Trade Secrets Act (18 USC 1905), the Critical Infrastructure Information Act of 2002, 6 USC 133, and any State or local law requiring disclosure of information or records. This information must not be copied or distributed to others not agreed upon by AT&T, but in all events do not copy or distribute to such others without notification pursuant to Executive Order 12600.






# External Map Request for Wgi

## Us1 Pande Study Atandt Markup Project

Date: 6/7/2023

Page Name: D2

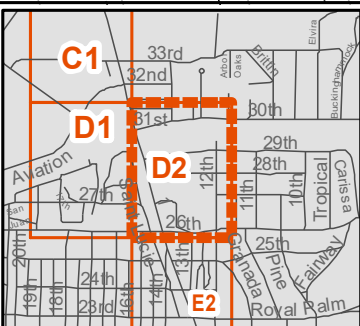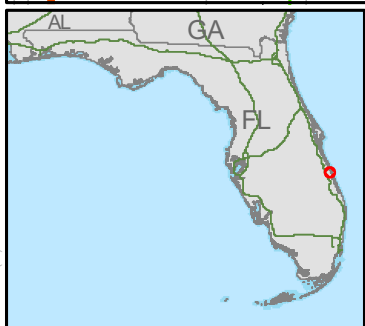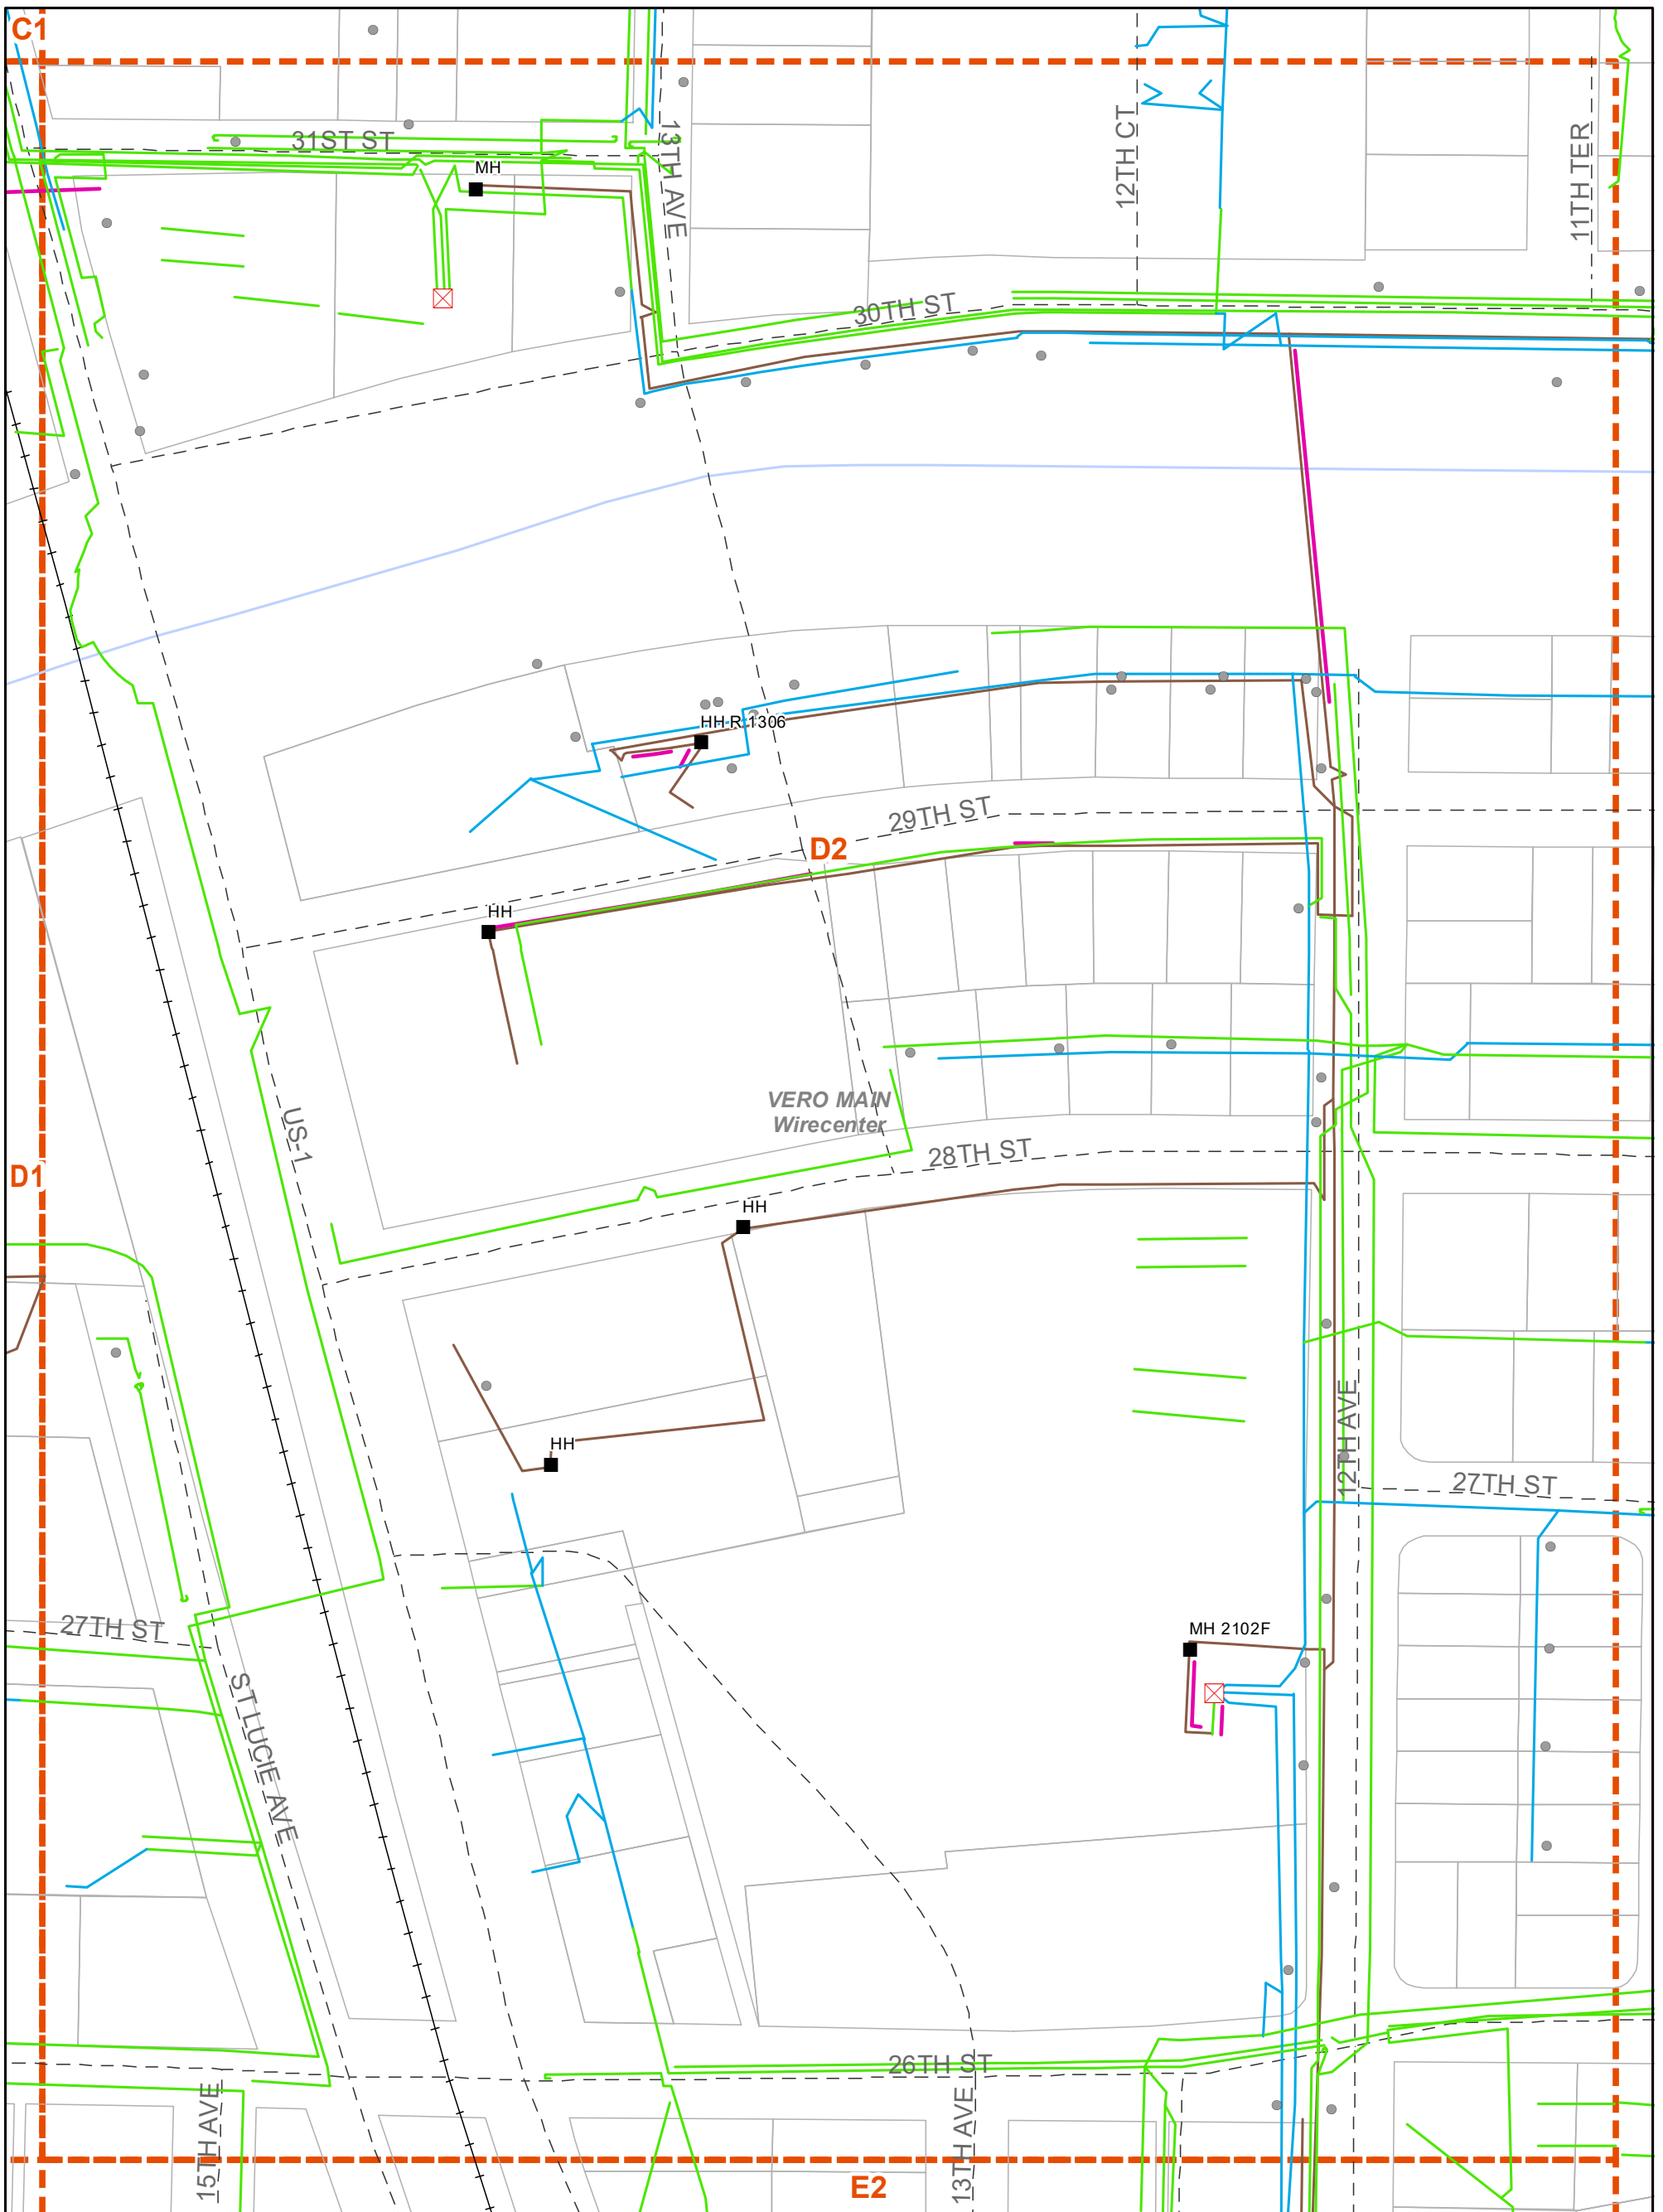

1:1,820



- Poles
- ⊠ SAls
- Manholes
- ⚡ Aerial
- 🏠 Building
- 🌿 Buried
- 📡 Underground
- 📶 Floating
- 🌊 Submarine
- 📏 Other
- 📀 Conduit
- 🚂 Railroads
- 📏 Street Centerlines
- 📏 Mapping Index
- 📏 Wirecenter Boundary
- 📏 Parcels

Copyright 2020 AT&T Intellectual Property. All rights reserved. AT&T and the AT&T logo are trademarks of AT&T Intellectual Property. The copying, scanning or other reproduction of this map without prior written permission of AT&T Intellectual Property is strictly prohibited. This map is provided 'as is'. Neither AT&T Intellectual Property nor any of its affiliates shall have any liability whatsoever to any person or entity for or on account of any injury, loss, or damage of any kind of nature sustained by, or any liability incurred by or imposed upon any other person or entity arising out of or in connection with or resulting from the use of this map.

Location of facilities shown herein are subject to field verification. No liability is assumed by AT&T as to the accuracy of location facilities. Please call USA at 811 two working days in advance of any grading or excavation in vicinity of our underground facilities. AT&T proprietary (internal use only). Not for use or disclosure outside the AT&T companies except under written agreement. Telco proprietary data is not to be disclosed to sited employees.

AT&T PROPRIETARY-This information constitutes confidential trade secrets and commercial or financial information owned by AT&T and is shared for Critical Infrastructure Protection purposes only. It is exempt from disclosure under the Freedom of Information Act(5 USC 552), Exemptions (b)(3)&(4), and its disclosure is prohibited under the Trade Secrets Act(18 USC 1905), the Critical Infrastructure Information Act of 2002, 6 USC 133, and any State or local law requiring disclosure of information or records. This information must not be copied or distributed to others not agreed upon by AT&T, but in all events do not copy or distribute to such others without notification pursuant to Executive Order 12600.








# External Map Request for Wgi

## Us1 Pande Study Atandt Markup Project

Date: 6/7/2023

Page Name: E2

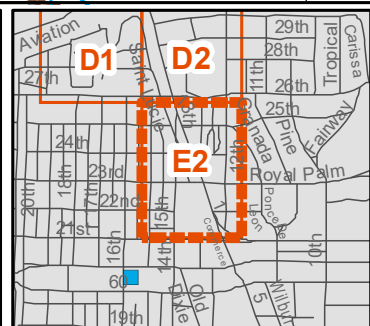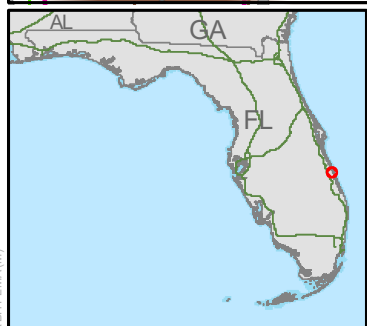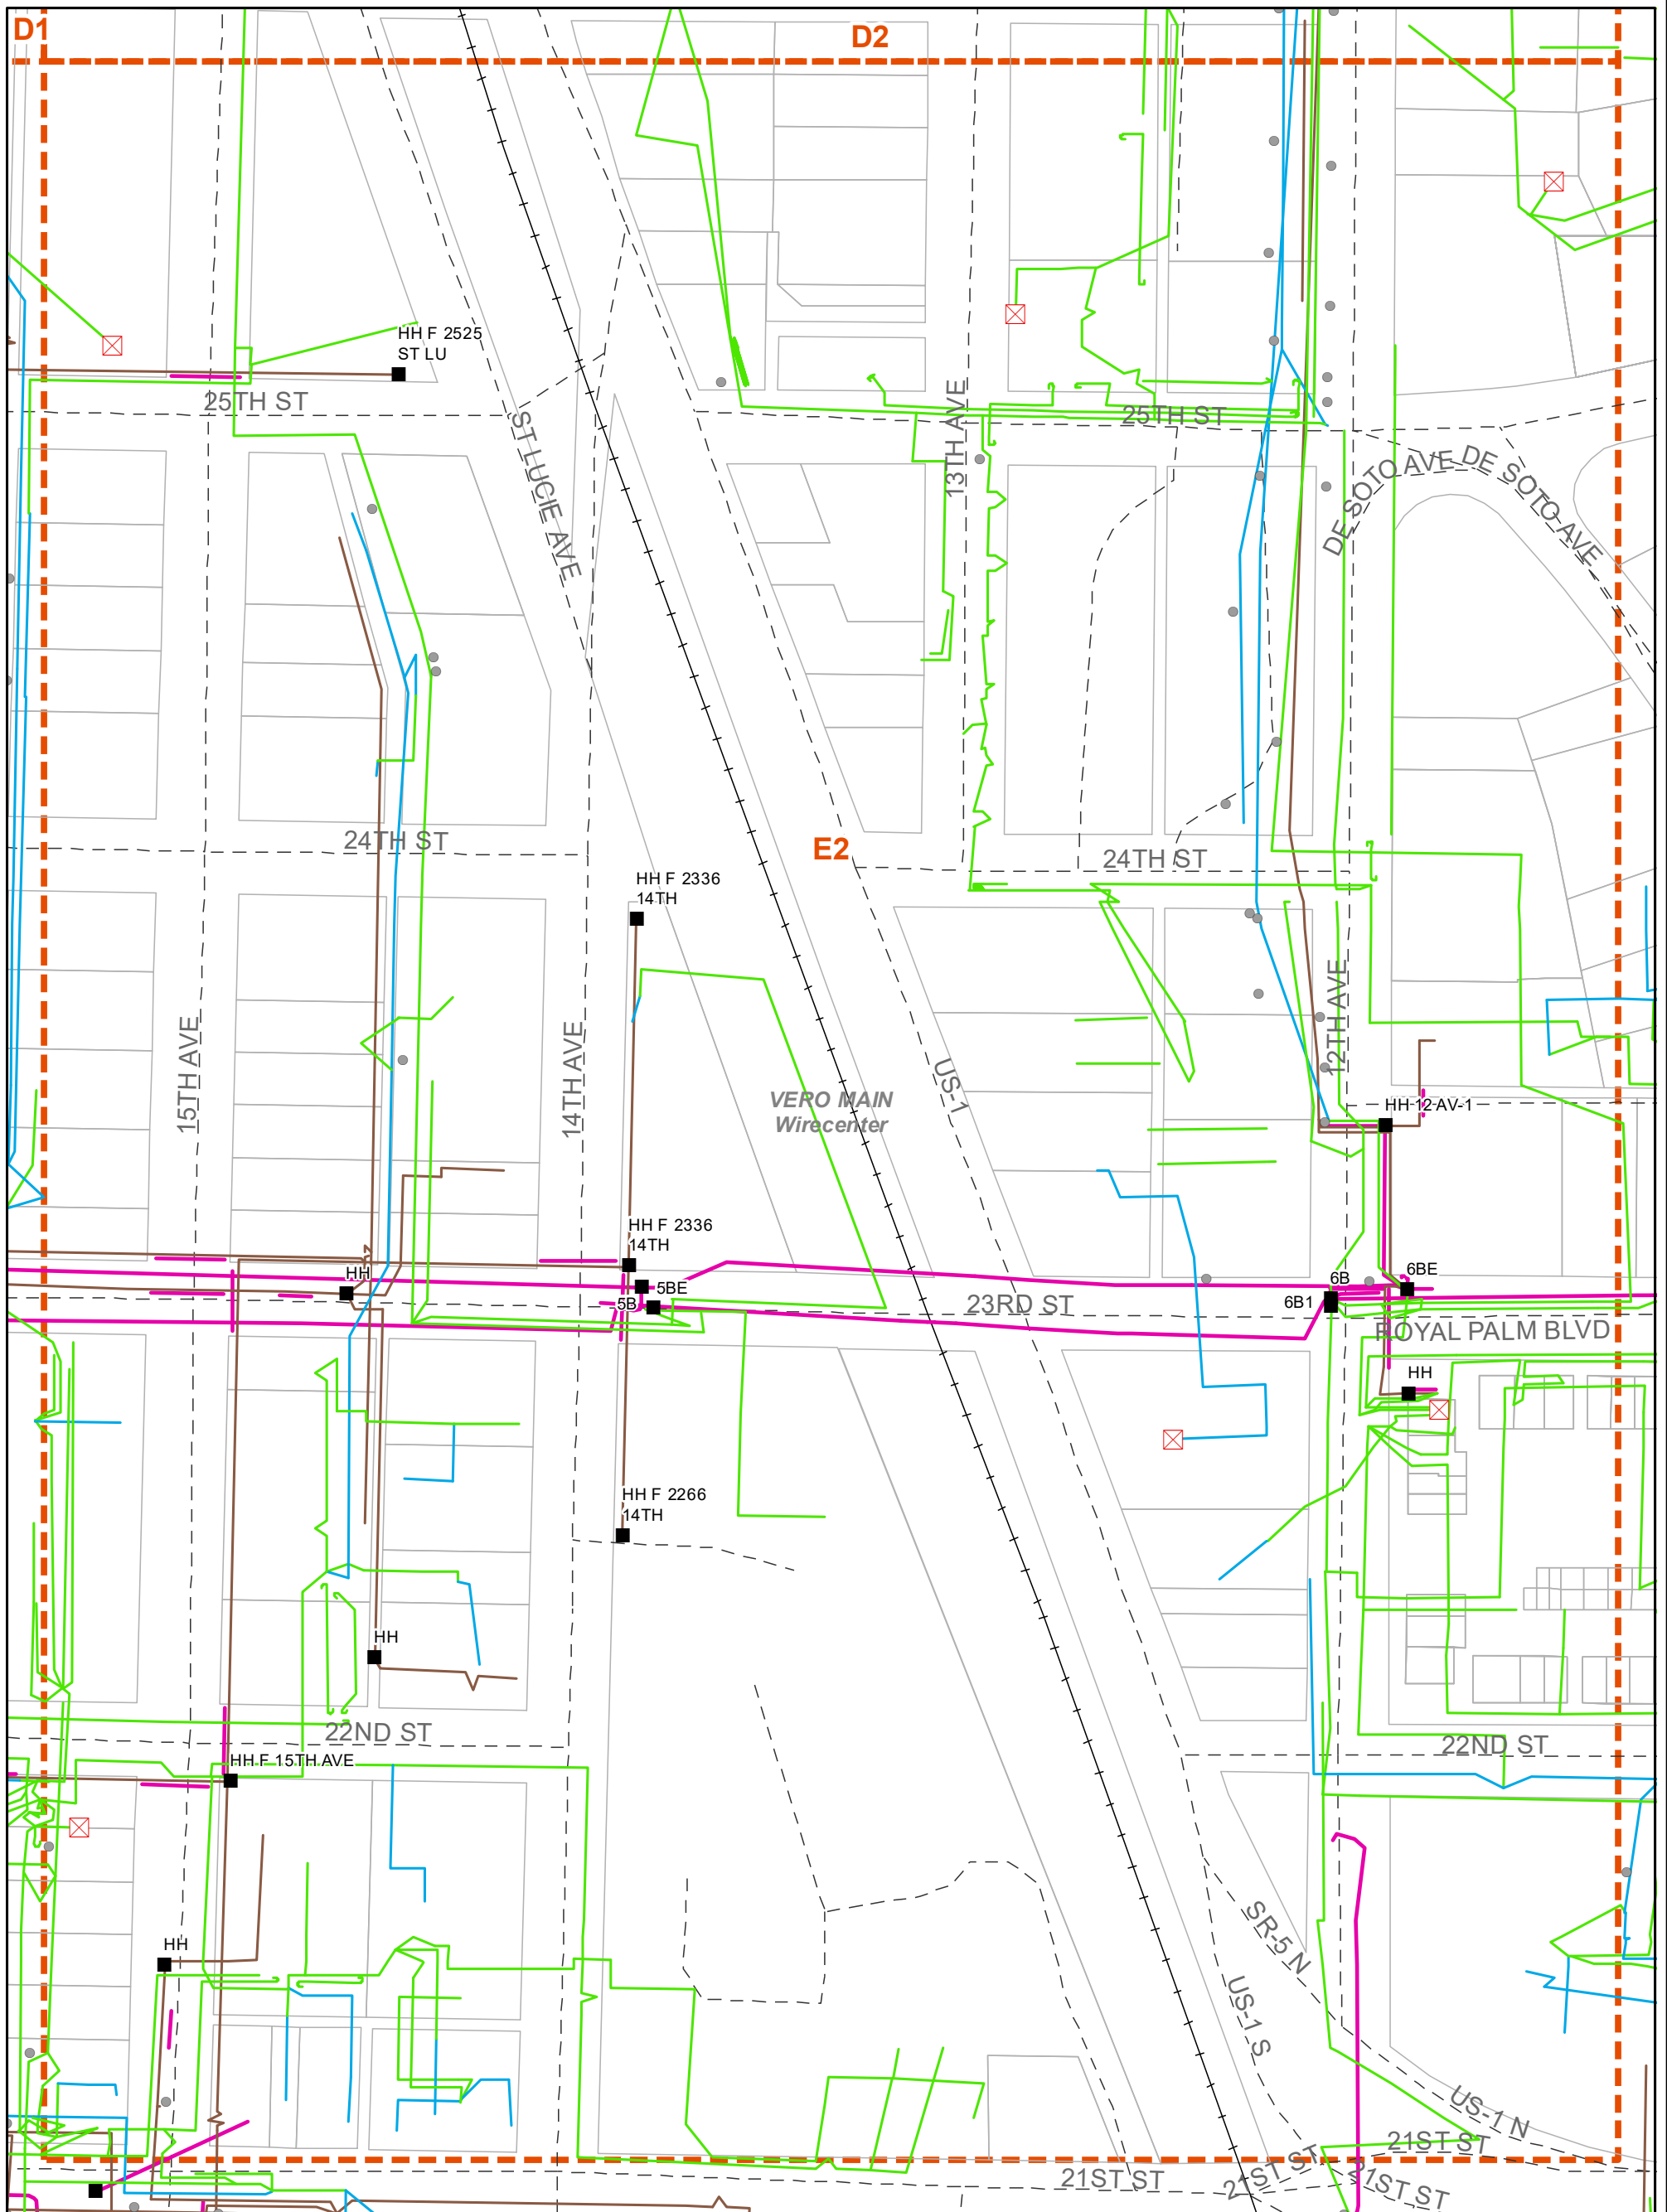

1:1,820



- Poles
- ⊠ SAls
- Manholes
- ⚡ Aerial
- 🏠 Building
- 🌿 Buried
- 📡 Underground
- 🌊 Floating
- 📏 Submarine
- 🛤 Other
- 📏 Conduit
- 🚂 Railroads
- 📏 Street Centerlines
- 📏 Mapping Index
- 📏 Wirecenter Boundary
- 📏 Parcels

Copyright 2020 AT&T Intellectual Property. All rights reserved. AT&T and the AT&T logo are trademarks of AT&T Intellectual Property. The copying, scanning or other reproduction of this map without prior written permission of AT&T Intellectual Property is strictly prohibited. This map is provided 'as is'. Neither AT&T Intellectual Property nor any of its affiliates shall have any liability whatsoever to any person or entity for or on account of any injury, loss, or damage of any kind of nature sustained by, or any liability incurred by or imposed upon any other person or entity arising out of or in connection with or resulting from the use of this map.

Location of facilities shown herein are subject to field verification. No liability is assumed by AT&T as to the accuracy of location facilities. Please call USA at 811 two working days in advance of any grading or excavation in vicinity of our underground facilities. AT&T propriety (internal use only). Not for use or disclosure outside the AT&T companies except under written agreement. Telco proprietary data is not to be disclosed to sited employees.

AT&T PROPRIETARY-This information constitutes confidential trade secrets and commercial or financial information owned by AT&T and is shared for Critical Infrastructure Protection purposes only. It is exempt from disclosure under the Freedom of Information Act (5 USC 552), Exemptions (b)(3)&(4), and its disclosure is prohibited under the Trade Secrets Act (18 USC 1905), the Critical Infrastructure Information Act of 2002, 6 USC 133, and any State or local law requiring disclosure of information or records. This information must not be copied or distributed to others not agreed upon by AT&T, but in all events do not copy or distribute to such others without notification pursuant to Executive Order 12600.

**Appendix D**

**AT&T Transmission**



Engineering Office – Orlando

6000 Metro West Blvd.  
Suite 201  
Orlando, FL 32835-7631  
Phone: (407) 578-8000  
Fax: (407) 578-7300  
Email: [swagner@pea-inc.net](mailto:swagner@pea-inc.net)

November 2, 2022


WGI, Inc.  
Attn: Matthew Phillips  
2035 Vista Parkway  
West Palm Beach, FL 33411  
(561) 687-2220

**RE: FIN: 441693-1-22-01  
Aviation Blvd PD&E Study  
Indian River County**

**AT&T Corp Long Lines (Transmission)** maintains a high-capacity fiber optic cable within the above project limits. Based on Plans received on 10/28/2022 detailed plans will be necessary to determine any or no conflict with proposed construction at this time. Please send updated plans to this office as they become available. If you have any questions, please call this office at (407) 578-8000.

• All correspondence and coordination herein are with regards to att Corp. (Transmission) which is not responsible for facilities owned and managed by Trans Connectivity Group (TCG), LLC d/b/a TCA. Any questions, inquiries, and/or clarifications with regards to TCA facilities should be addressed to [FL-RELOCATIONS@treccgroup.com](mailto:FL-RELOCATIONS@treccgroup.com).

Sincerely,



Kenneth S. Wagner  
Assistant Engineer  
Representing AT&T, Inc.

KSW

Cc: G. Jacobson (AT&T)  
File: 22-01-001

Attention: The information contained in this E-mail message is privileged and confidential information intended only for the use of the individual(s) named above. If the reader of this message is not the intended recipient, you are hereby notified that any dissemination, distribution or copy of this communication is strictly prohibited. If you have received this communication in error, please contact the sender by reply E-mail and destroy all copies of the original message. Thank you.

Orlando, FL

**Kenneth Wagner**

**From:** Matthew Phillips <Matthew.Phillips@wginc.com>  
**Sent:** Friday, October 28, 2022 11:51 AM  
**To:** Reid, Ezekiel; tyong@covb.org; Harrison Youngblood; Kenneth Wagner; Puglisi, Andrew; jon.baker@t-mobile.com; Carr, Donovan Ralph; Tiburcio, Daniel; whoward@covb.org; Rob Morris; FOLKERTS, LUKE; Haskett, Danny; Rene, Jude; Laura Glass  
**Subject:** FM: 441693-1-22-02 Aviation Blvd PD&E Study from 27th Ave to US1/SR5 and SR5 from 21st St. to 37th St.  
**Attachments:** Mimecast Large File Send Instructions

I'm using Mimecast to share large files with you. Please see the attached instructions.

**RE: ADJUSTMENT OF UTILITIES – STATE STATUTES CHAPTER 337.403**  
**Project:** SR-5(US-1) at Aviation Boulevard PD&E Study  
**Description:** Aviation Blvd PD&E Study from 27<sup>th</sup> Ave to US1/SR5 and SR5 from 21<sup>st</sup> St. to 37<sup>th</sup> St.  
**County:** Indian River County  
**FPID:** 441693-1-22-02

**Project Development & Environmental (PD&E) Utility Assessment Report**

The Florida Department of Transportation (FDOT), is conducting a Project Development and Environment (PD&E) Study for the improvements to the above roadway(s). The PD&E study limits begin at Aviation Blvd. & 27<sup>th</sup> Ave and go east to US1/SR5, then continue along US from 21<sup>st</sup> St., north to 37<sup>th</sup> St. (See Attached Project Location map). In order to determine the best alternative for this project, we need to determine the location and anticipated impacts for all existing, proposed and out-of-service utility facilities within the project study limits, both underground and overhead.

For this purpose we are requesting your office mark on the attached plans (plans dated September 15, 2022), all your existing, proposed and out-of-service utility facilities, both inside and along the project study right-of-way lines, and/or within the limits as shown. We are further asking you return the marked plans and requested information (hard copy or electronic) to this office before **November 22, 2022.**

Please provide with your response the following information:

- Updated contact information for your Agency/Owner, providing name, phone, email and address.
- Attached plans marked to indicate the location, type and size of your existing, proposed and out-of-service facilities within the study limits, and indicate whether underground or aerial. Along with the marked plans, provide any atlas maps, GIS or other additional plans or information that might help to describe and define your facilities.
- Marked plans to show the limits of any easements, subordinations, or other property interests you may have along or within the study limits, and any existing or proposed encroachments onto those properties.
- A lump sum order-of-magnitude relocation cost estimate that approximates the cost to adjust or relocate all of your utilities within the project study limits. This estimate will not influence any detailed estimates furnished later; it is for the purpose of addressing any major impacts.
- An estimate of the time frames to relocate all of your utilities within the project limits. This estimate will not influence any detailed time frames furnished later.
- Whether you agency would be interested in entering a Utility Work by Highway Contractor Agreement, including whether this would include affected facilities or proposed installations.
- If you do not have any utility facilities within the study limits, please provide a No Facilities Letter.

Thank you for your attention and cooperation to this matter.



October 25, 2022

RE: **ADJUSTMENT OF UTILITIES – STATE STATUTES CHAPTER 337.403**  
Project: SR-5(US-1) at Aviation Boulevard PD&E Study  
Description: Aviation Blvd PD&E Study from 27<sup>th</sup> Ave to US1/SR5 and SR5 from 21<sup>st</sup> St. to 37<sup>th</sup> St.  
County: Indian River County  
FPID: 441693-1-22-02

**Project Development & Environmental (PD&E) Utility Assessment Report**

The Florida Department of Transportation (FDOT), is conducting a Project Development and Environment (PD&E) Study for the improvements to the above roadway(s). The PD&E study limits begin at Aviation Blvd. & 27<sup>th</sup> Ave and go east to US1/SR5, then continue along US from 21<sup>st</sup> St., north to 37<sup>th</sup> St. (See Attached Project Location map). In order to determine the best alternative for this project, we need to determine the location and anticipated impacts for all existing, proposed and out-of-service utility facilities within the project study limits, both underground and overhead.

For this purpose we are requesting your office mark on the attached plans (plans dated September 15, 2022), all your existing, proposed and out-of-service utility facilities, both inside and along the project study right-of-way lines, and/or within the limits as shown. We are further asking you return the marked plans and requested information (hard copy or electronic) to this office before **November 22, 2022.**


Please provide with your response the following information:


- Updated contact information for your Agency/Owner, providing name, phone, email and address.
- Attached plans marked to indicate the location, type and size of your existing, proposed and out-of-service facilities within the study limits, and indicate whether underground or aerial. Along with the marked plans, provide any atlas maps, GIS or other additional plans or information that might help to describe and define your facilities.
- Marked plans to show the limits of any easements, subordinations, or other property interests you may have along or within the study limits, and any existing or proposed encroachments onto those properties.
- A lump sum order-of-magnitude relocation cost estimate that approximates the cost to adjust or relocate all of your utilities within the project study limits. This estimate will not influence any detailed estimates furnished later; it is for the purpose of addressing any major impacts.
- An estimate of the time frames to relocate all of your utilities within the project limits. This estimate will not influence any detailed time frames furnished later.
- Whether you agency would be interested in entering a Utility Work by Highway Contractor Agreement, including whether this would include affected facilities or proposed installations.
- If you do not have any utility facilities within the study limits, please provide a No Facilities Letter.

Thank you for your attention and cooperation to this matter. Your input and continued cooperation on this project is essential. Should you have any questions do not hesitate to contact me directly at 561-713-1683, or send email to [matthew.phillips@wginc.com](mailto:matthew.phillips@wginc.com).


WGI, INC.

  
Matthew Phillips  
Sr. Utility Coordinator

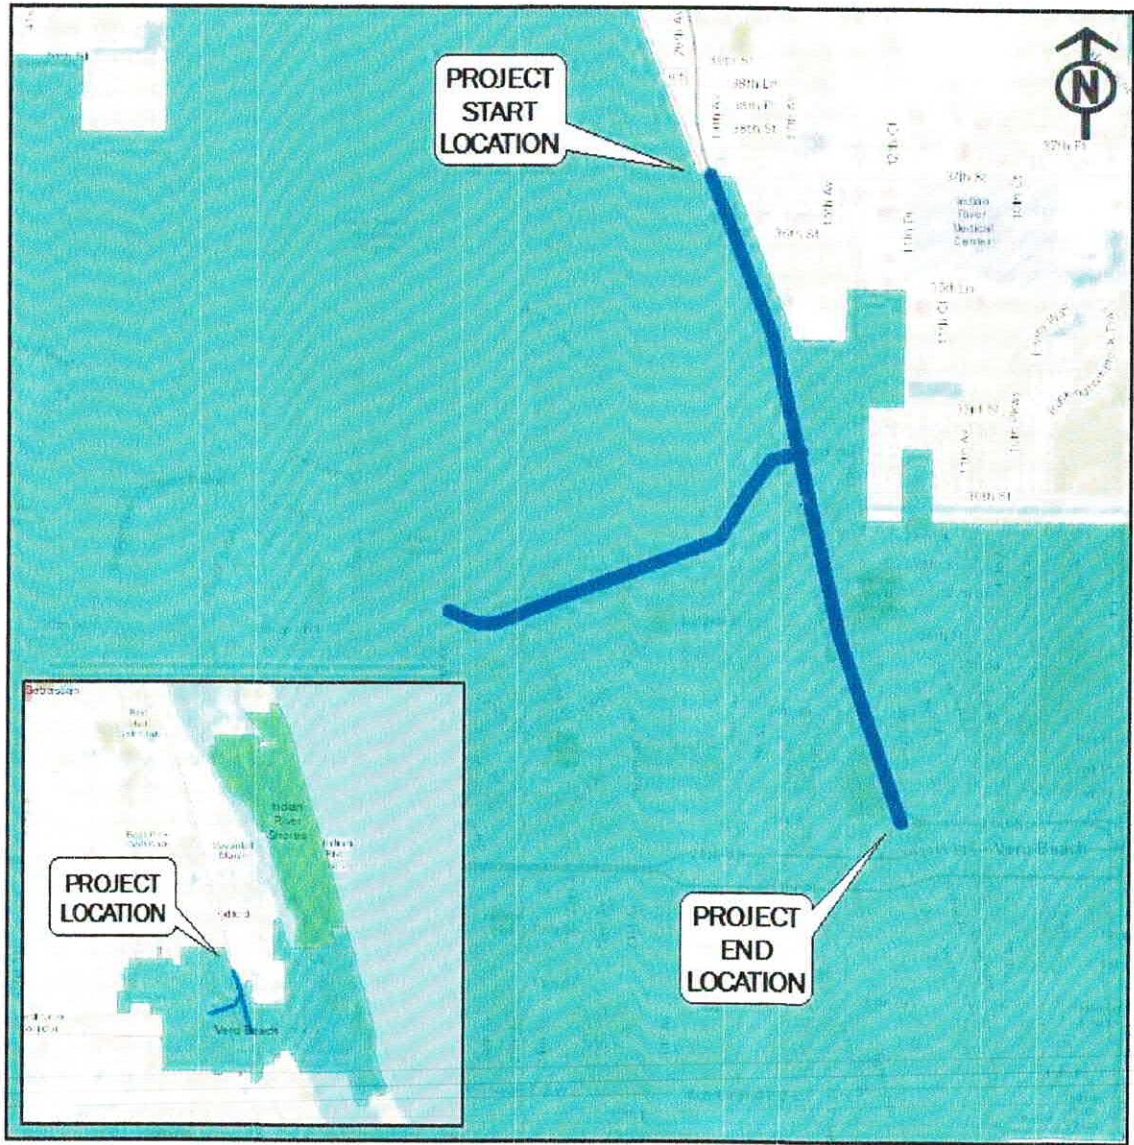

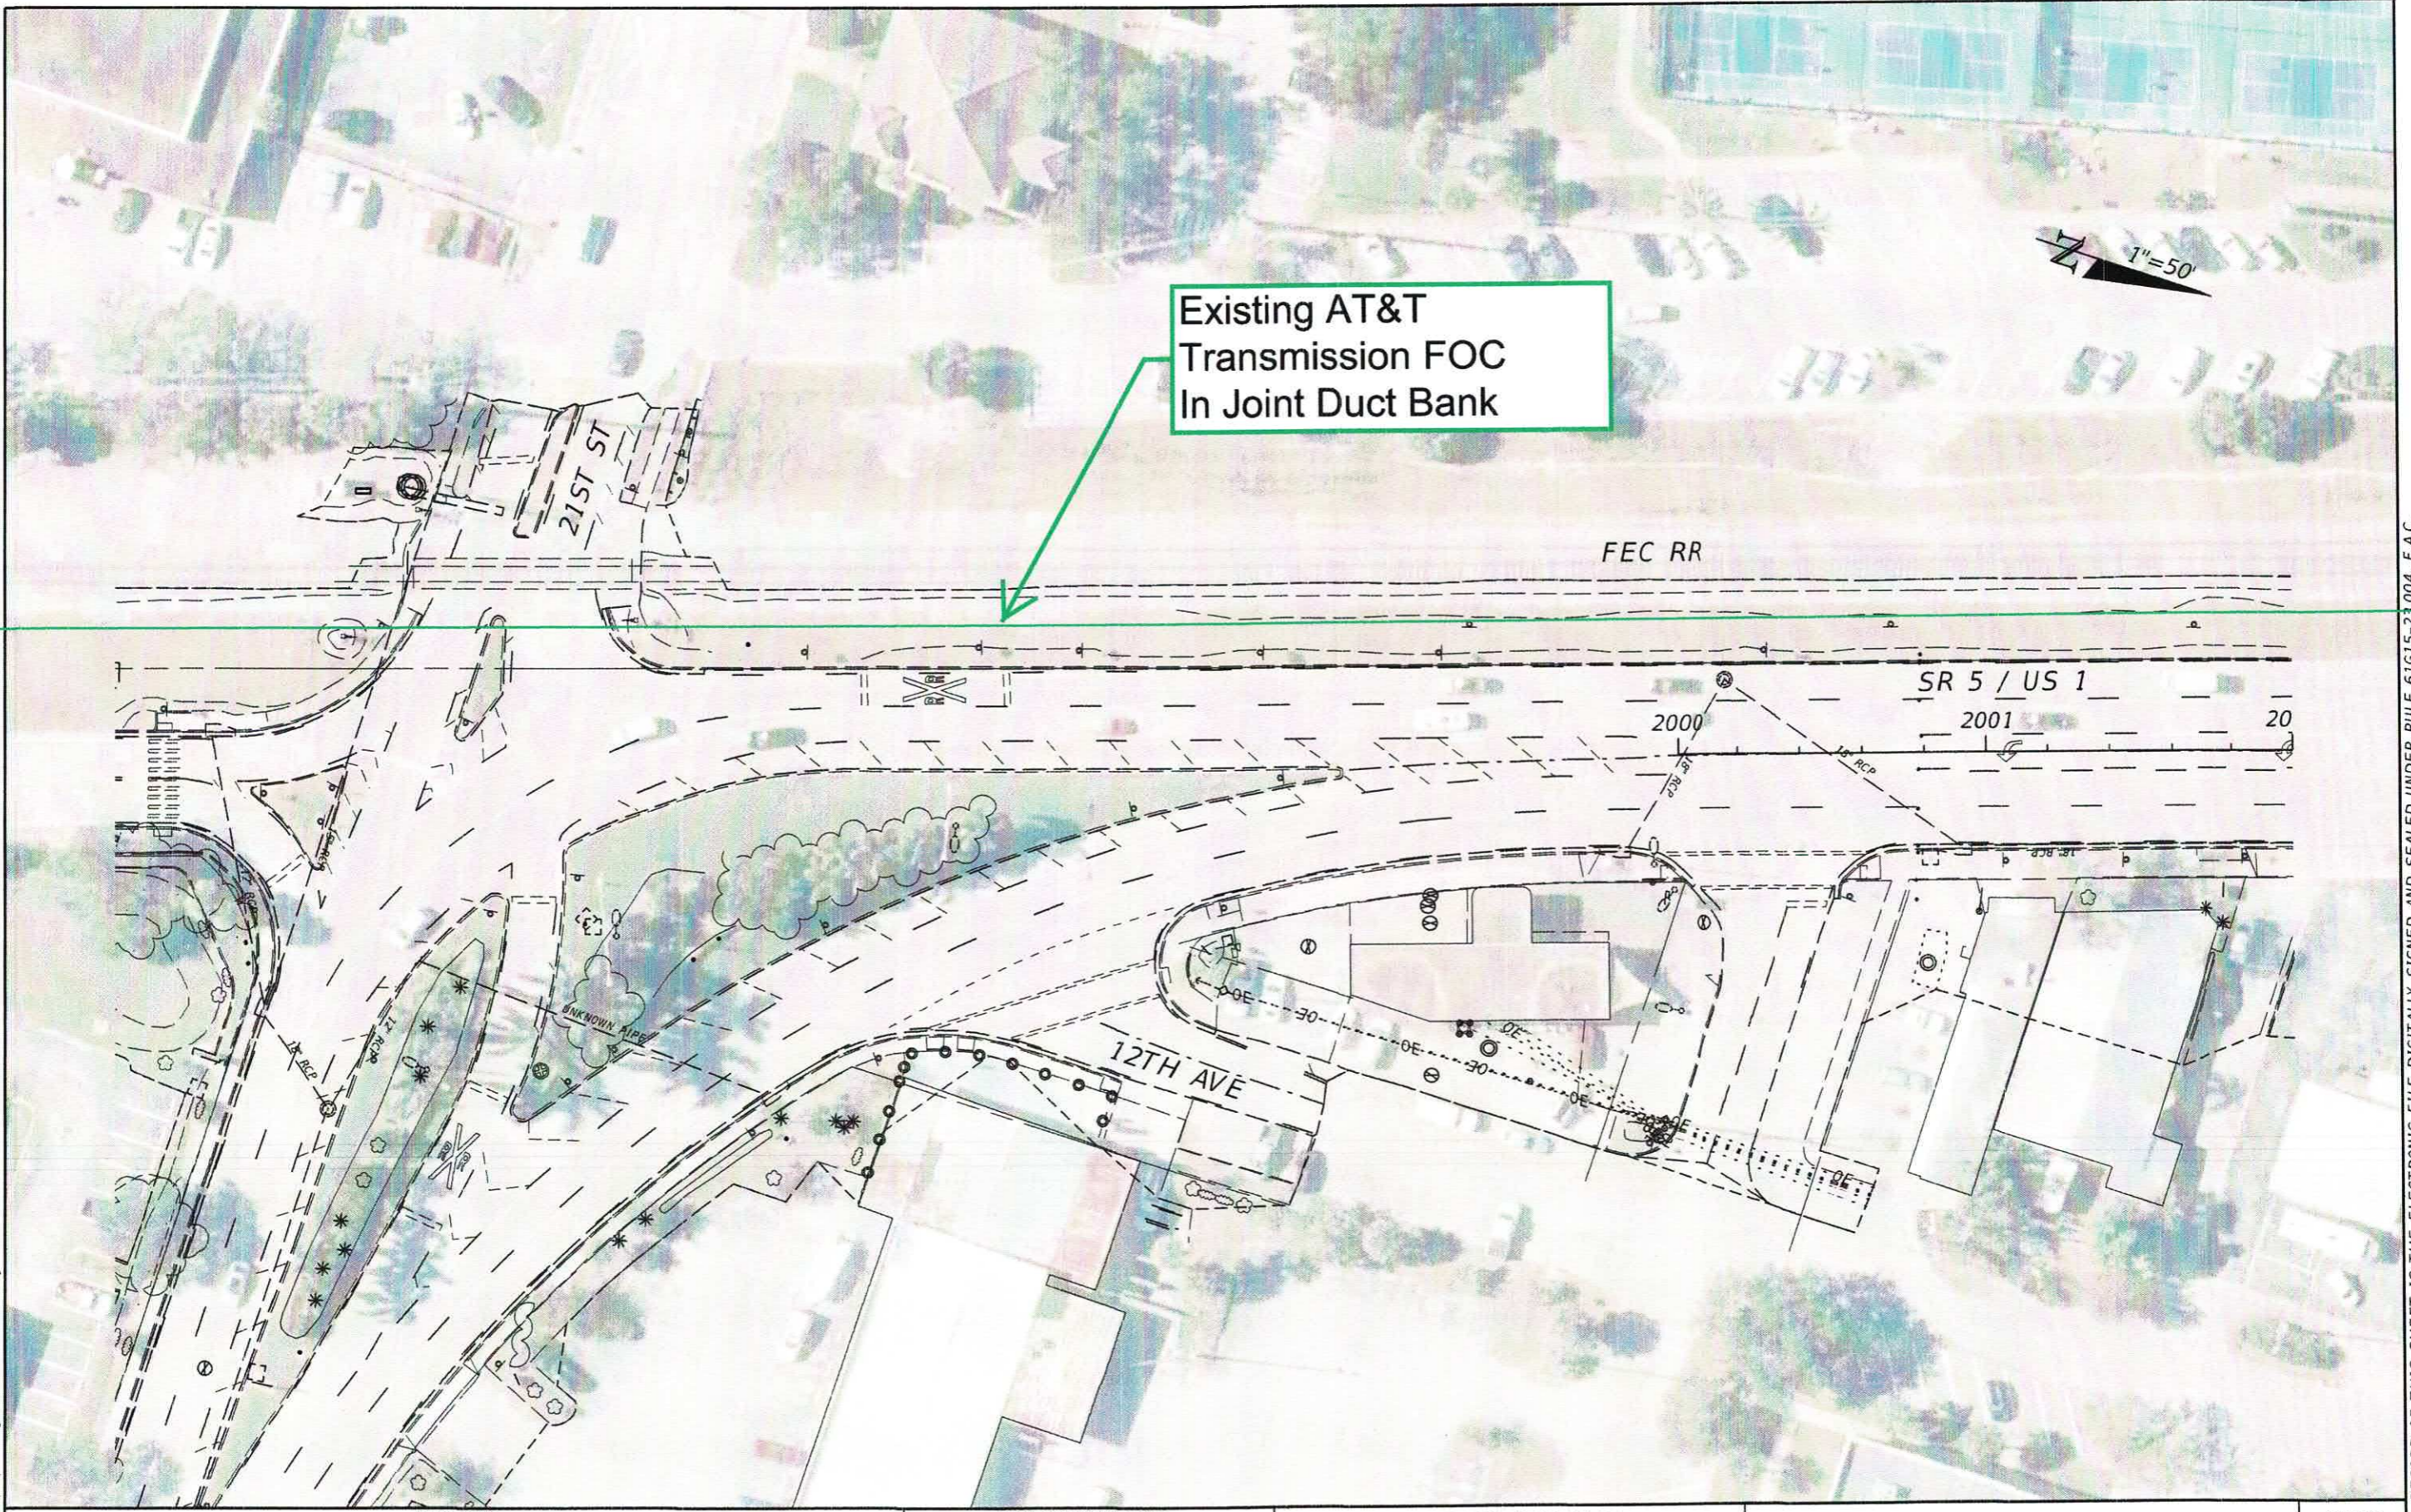

Existing AT&T  
Transmission FOC  
In Joint Duct Bank

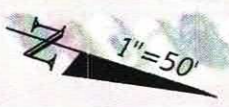


9/15/2022 10:58:52 AM Jacquelyn.Arreola  
C:\pwworking\wg\jacquelyn.arreola\2198192\PLMRD01.dgn

THE OFFICIAL RECORD OF THIS SHEET IS THE ELECTRONIC FILE DIGITALLY SIGNED AND SEALED UNDER RULE 61G15-23.004, F.A.C.

REVISIONS		PROFESSIONAL TYPE		STATE OF FLORIDA DEPARTMENT OF TRANSPORTATION			UTILITY CONTACT PLAN (1)	SHEET NO.
DATE	DESCRIPTION	DATE	DESCRIPTION	ROAD NO.	COUNTY	FINANCIAL PROJECT ID		
				SR 5	INDIAN RIVER	441693-1-22-02		1

WILLIAM EVANS  
LICENSE NUMBER: 45207  
WGI, INC.  
2035 VISTA PARKWAY  
WEST PALM BEACH, FL 33411

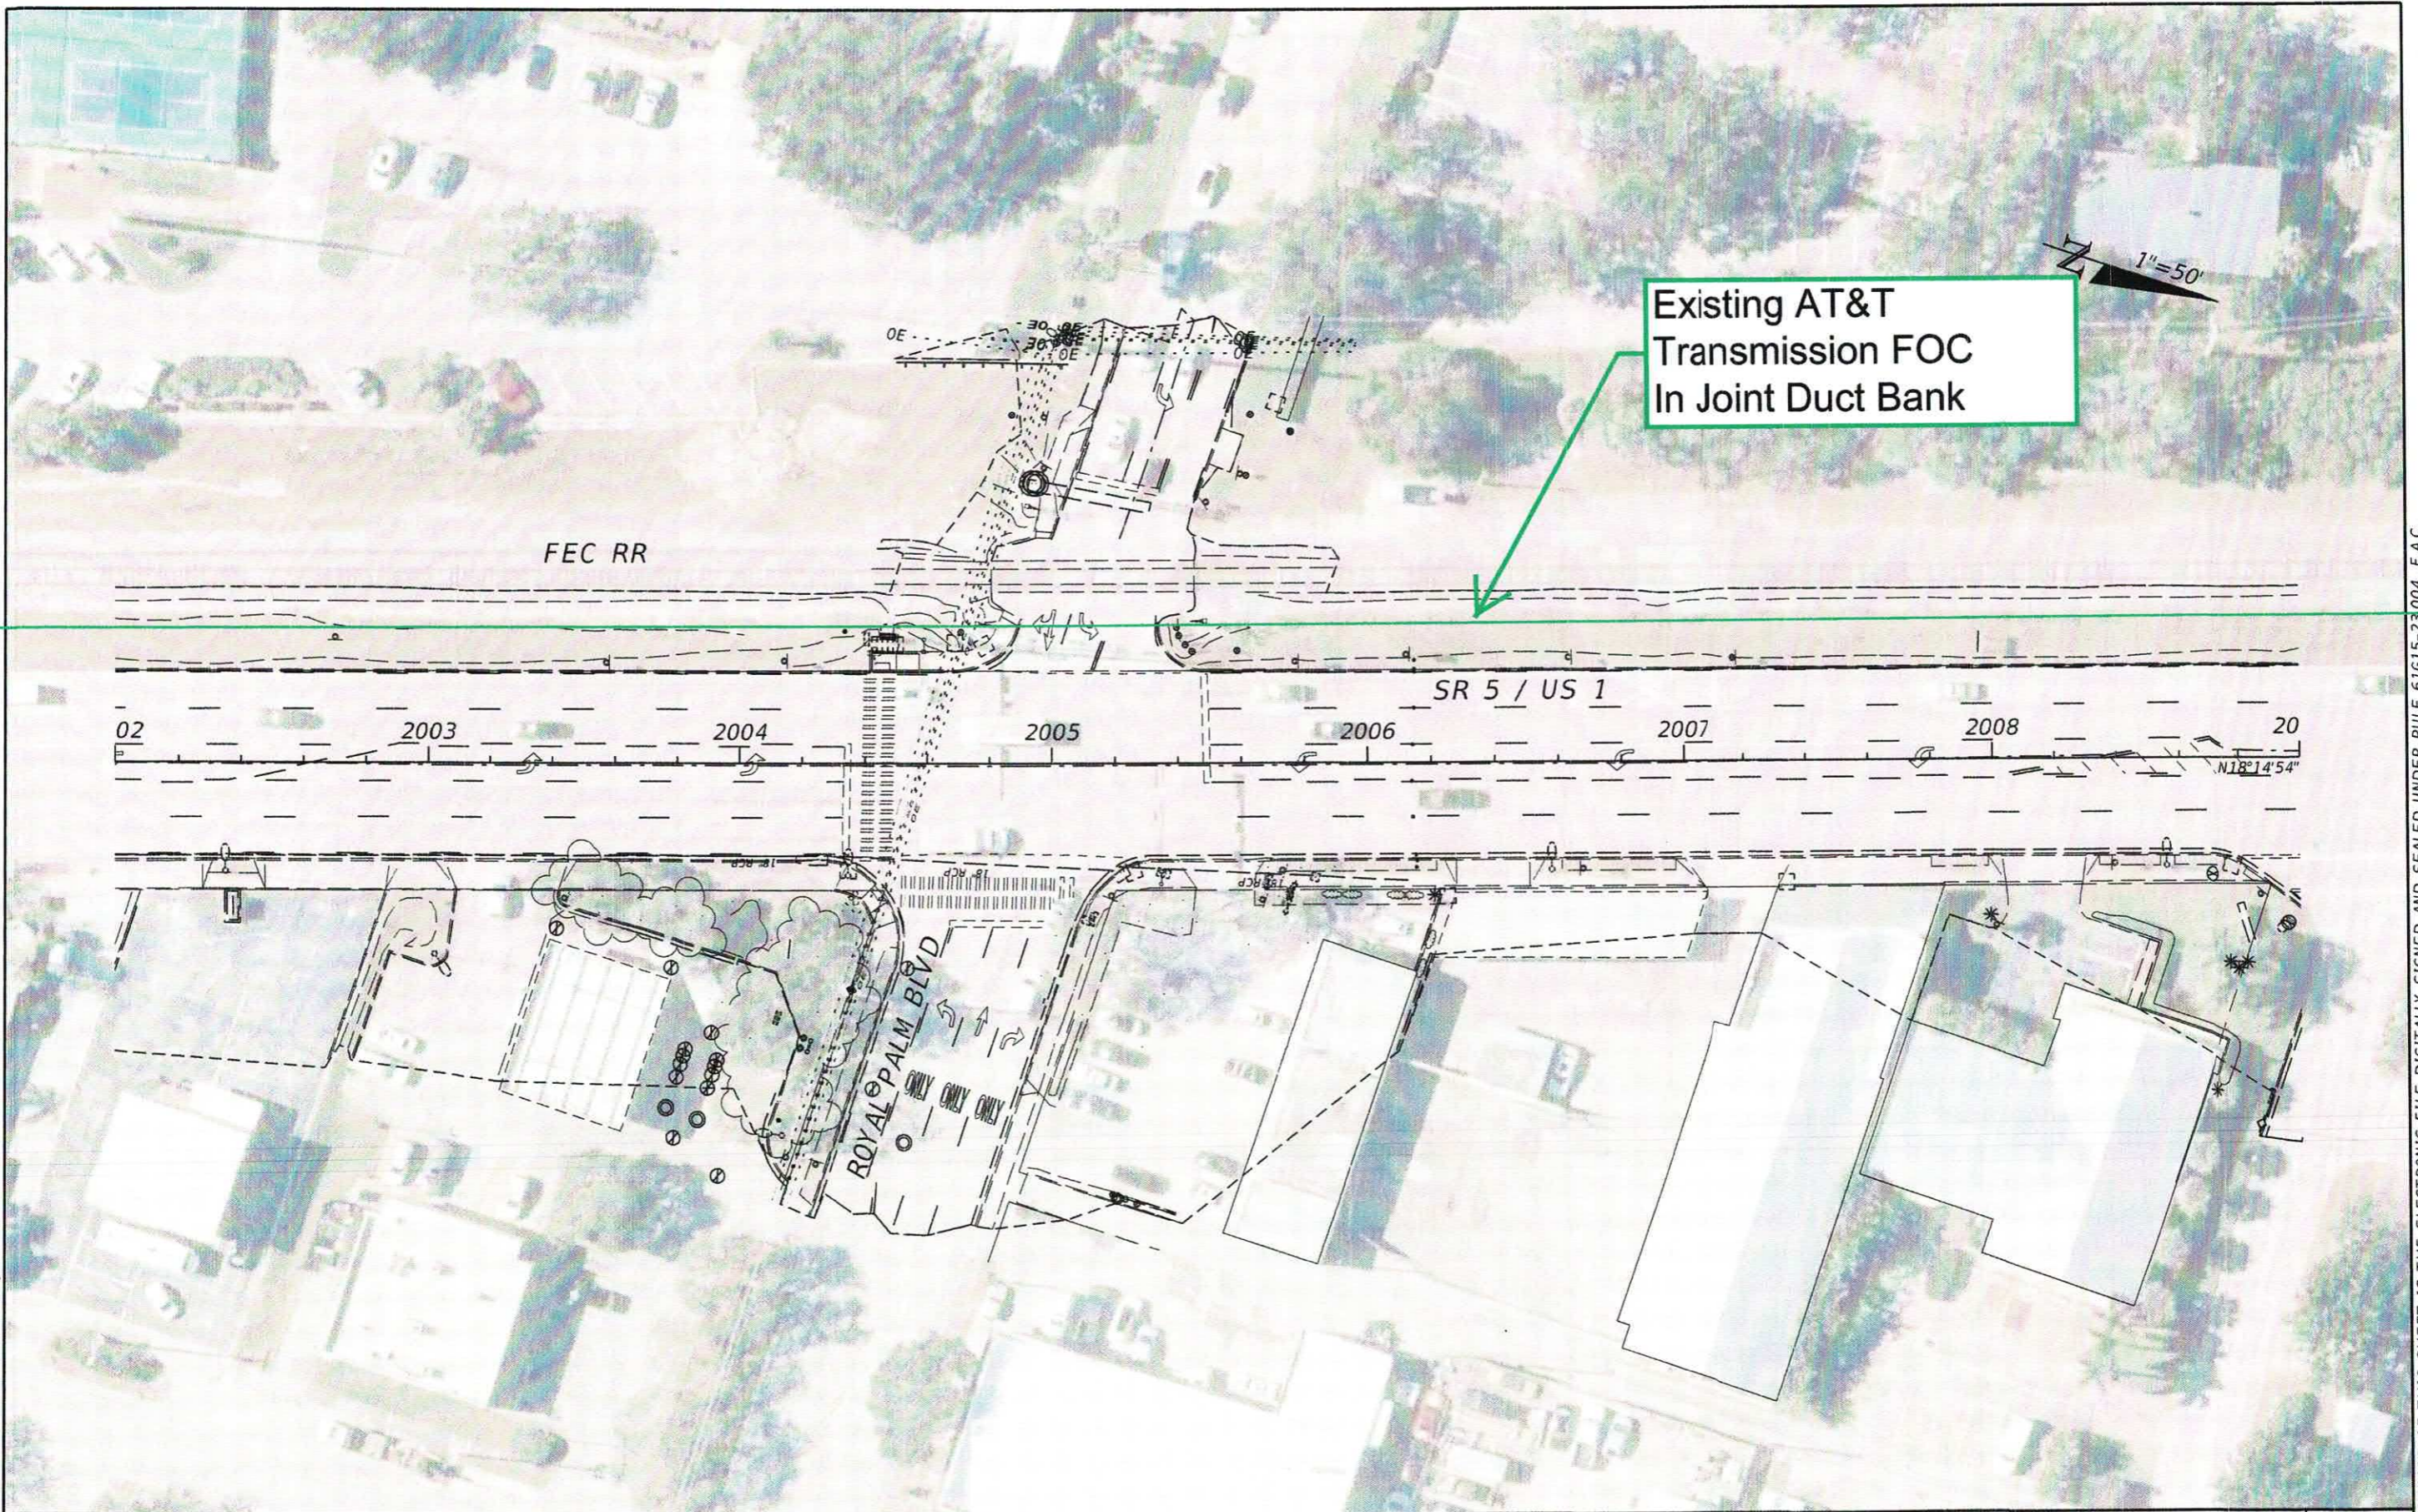


9/15/2022 10:59:58 AM Jacquelyn.Arreola  
 C:\pwworking\wgi\jacquelyn.arreola\2198192\PLANNING\01.dgn

REVISIONS				PROFESSIONAL TYPE		STATE OF FLORIDA DEPARTMENT OF TRANSPORTATION			UTILITY CONTACT PLAN (2)	SHEET NO.  2
DATE	DESCRIPTION	DATE	DESCRIPTION	WILLIAM EVANS LICENSE NUMBER: 45207 WGI, INC. 2035 VISTA PARKWAY WEST PALM BEACH, FL 33411		ROAD NO.	COUNTY	FINANCIAL PROJECT ID		
						SR 5	INDIAN RIVER	441693-1-22-02		

THE OFFICIAL RECORD OF THIS SHEET IS THE ELECTRONIC FILE DIGITALLY SIGNED AND SEALED UNDER RULE 61G15-23.004, F.A.C.



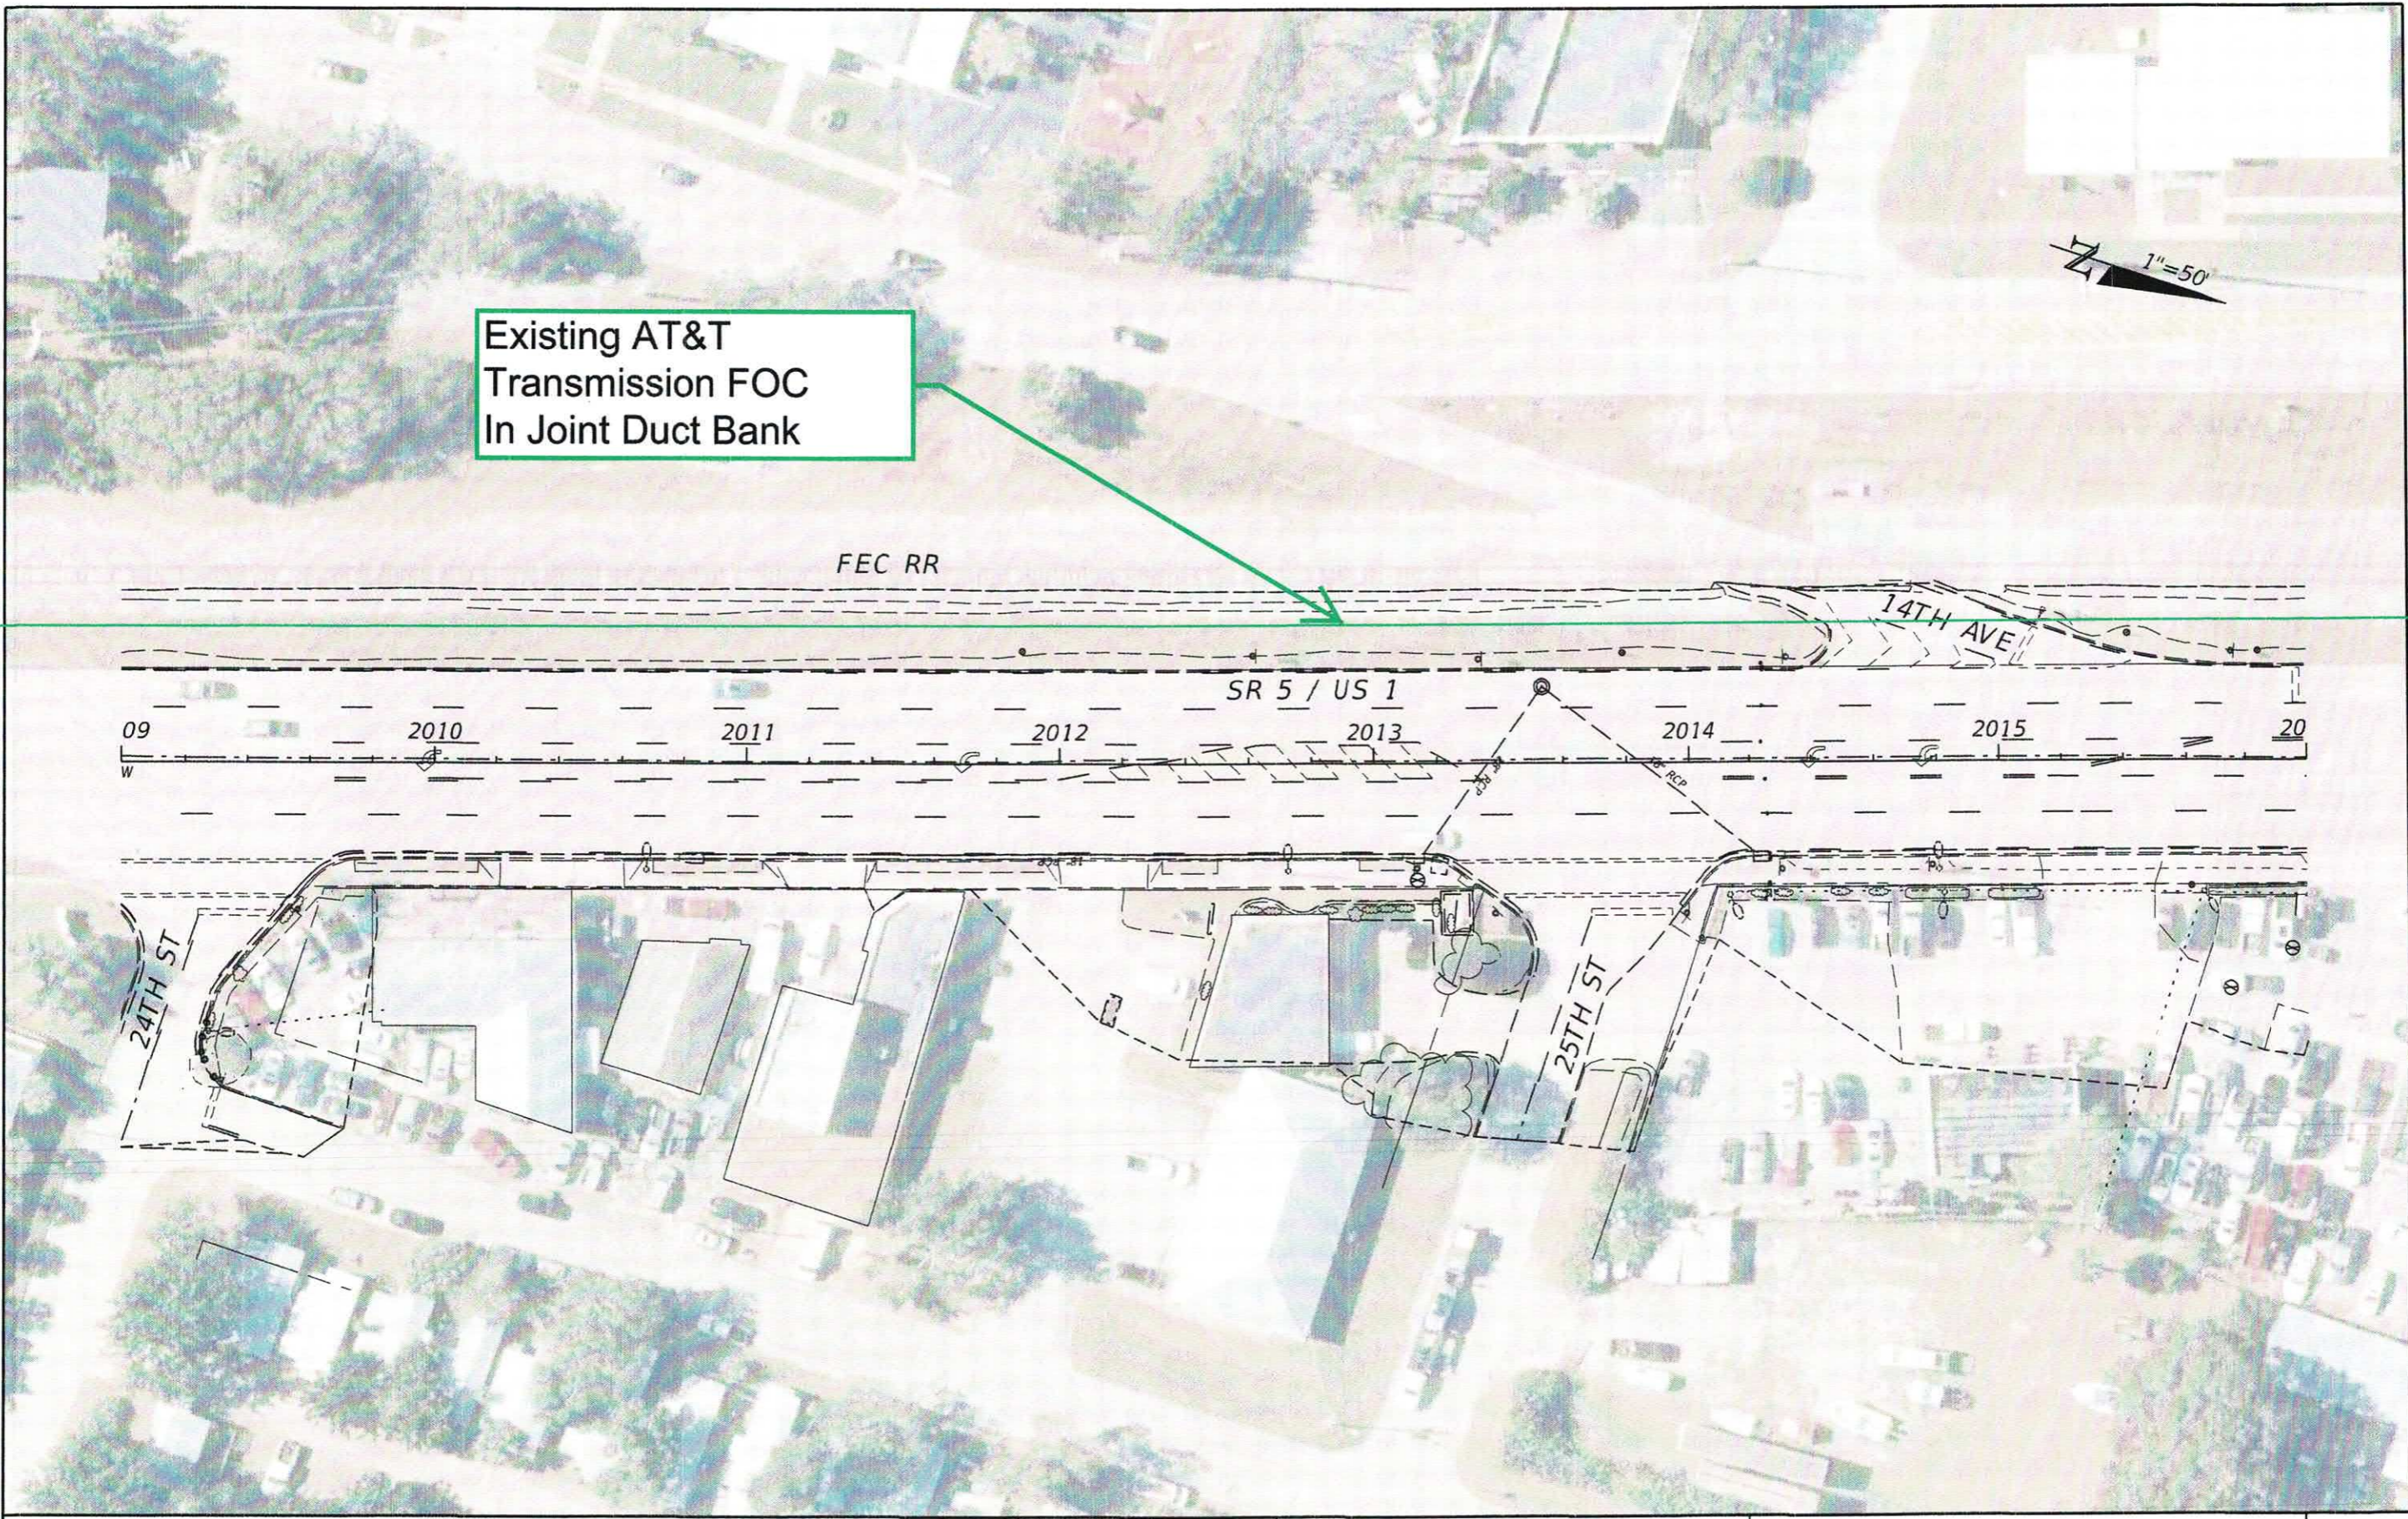


9/15/2022 11:00:13 AM jacquelin.ayres@wgi.com  
 C:\pwworking\wgi\jacquelin.ayres\2198192\PLANR001.dgn

REVISIONS				PROFESSIONAL TYPE	STATE OF FLORIDA DEPARTMENT OF TRANSPORTATION			SHEET NO.
DATE	DESCRIPTION	DATE	DESCRIPTION		ROAD NO.	COUNTY	FINANCIAL PROJECT ID	
				WILLIAM EVANS LICENSE NUMBER: 45207 WGI, INC. 2035 VISTA PARKWAY WEST PALM BEACH, FL 33411	SR 5	INDIAN RIVER	441693-1-22-02	3

**UTILITY CONTACT PLAN (3)**

THE OFFICIAL RECORD OF THIS SHEET IS THE ELECTRONIC FILE DIGITALLY SIGNED AND SEALED UNDER RULE 61G15-23.004, F.A.C.

Existing AT&T  
Transmission FOC  
In Joint Duct Bank

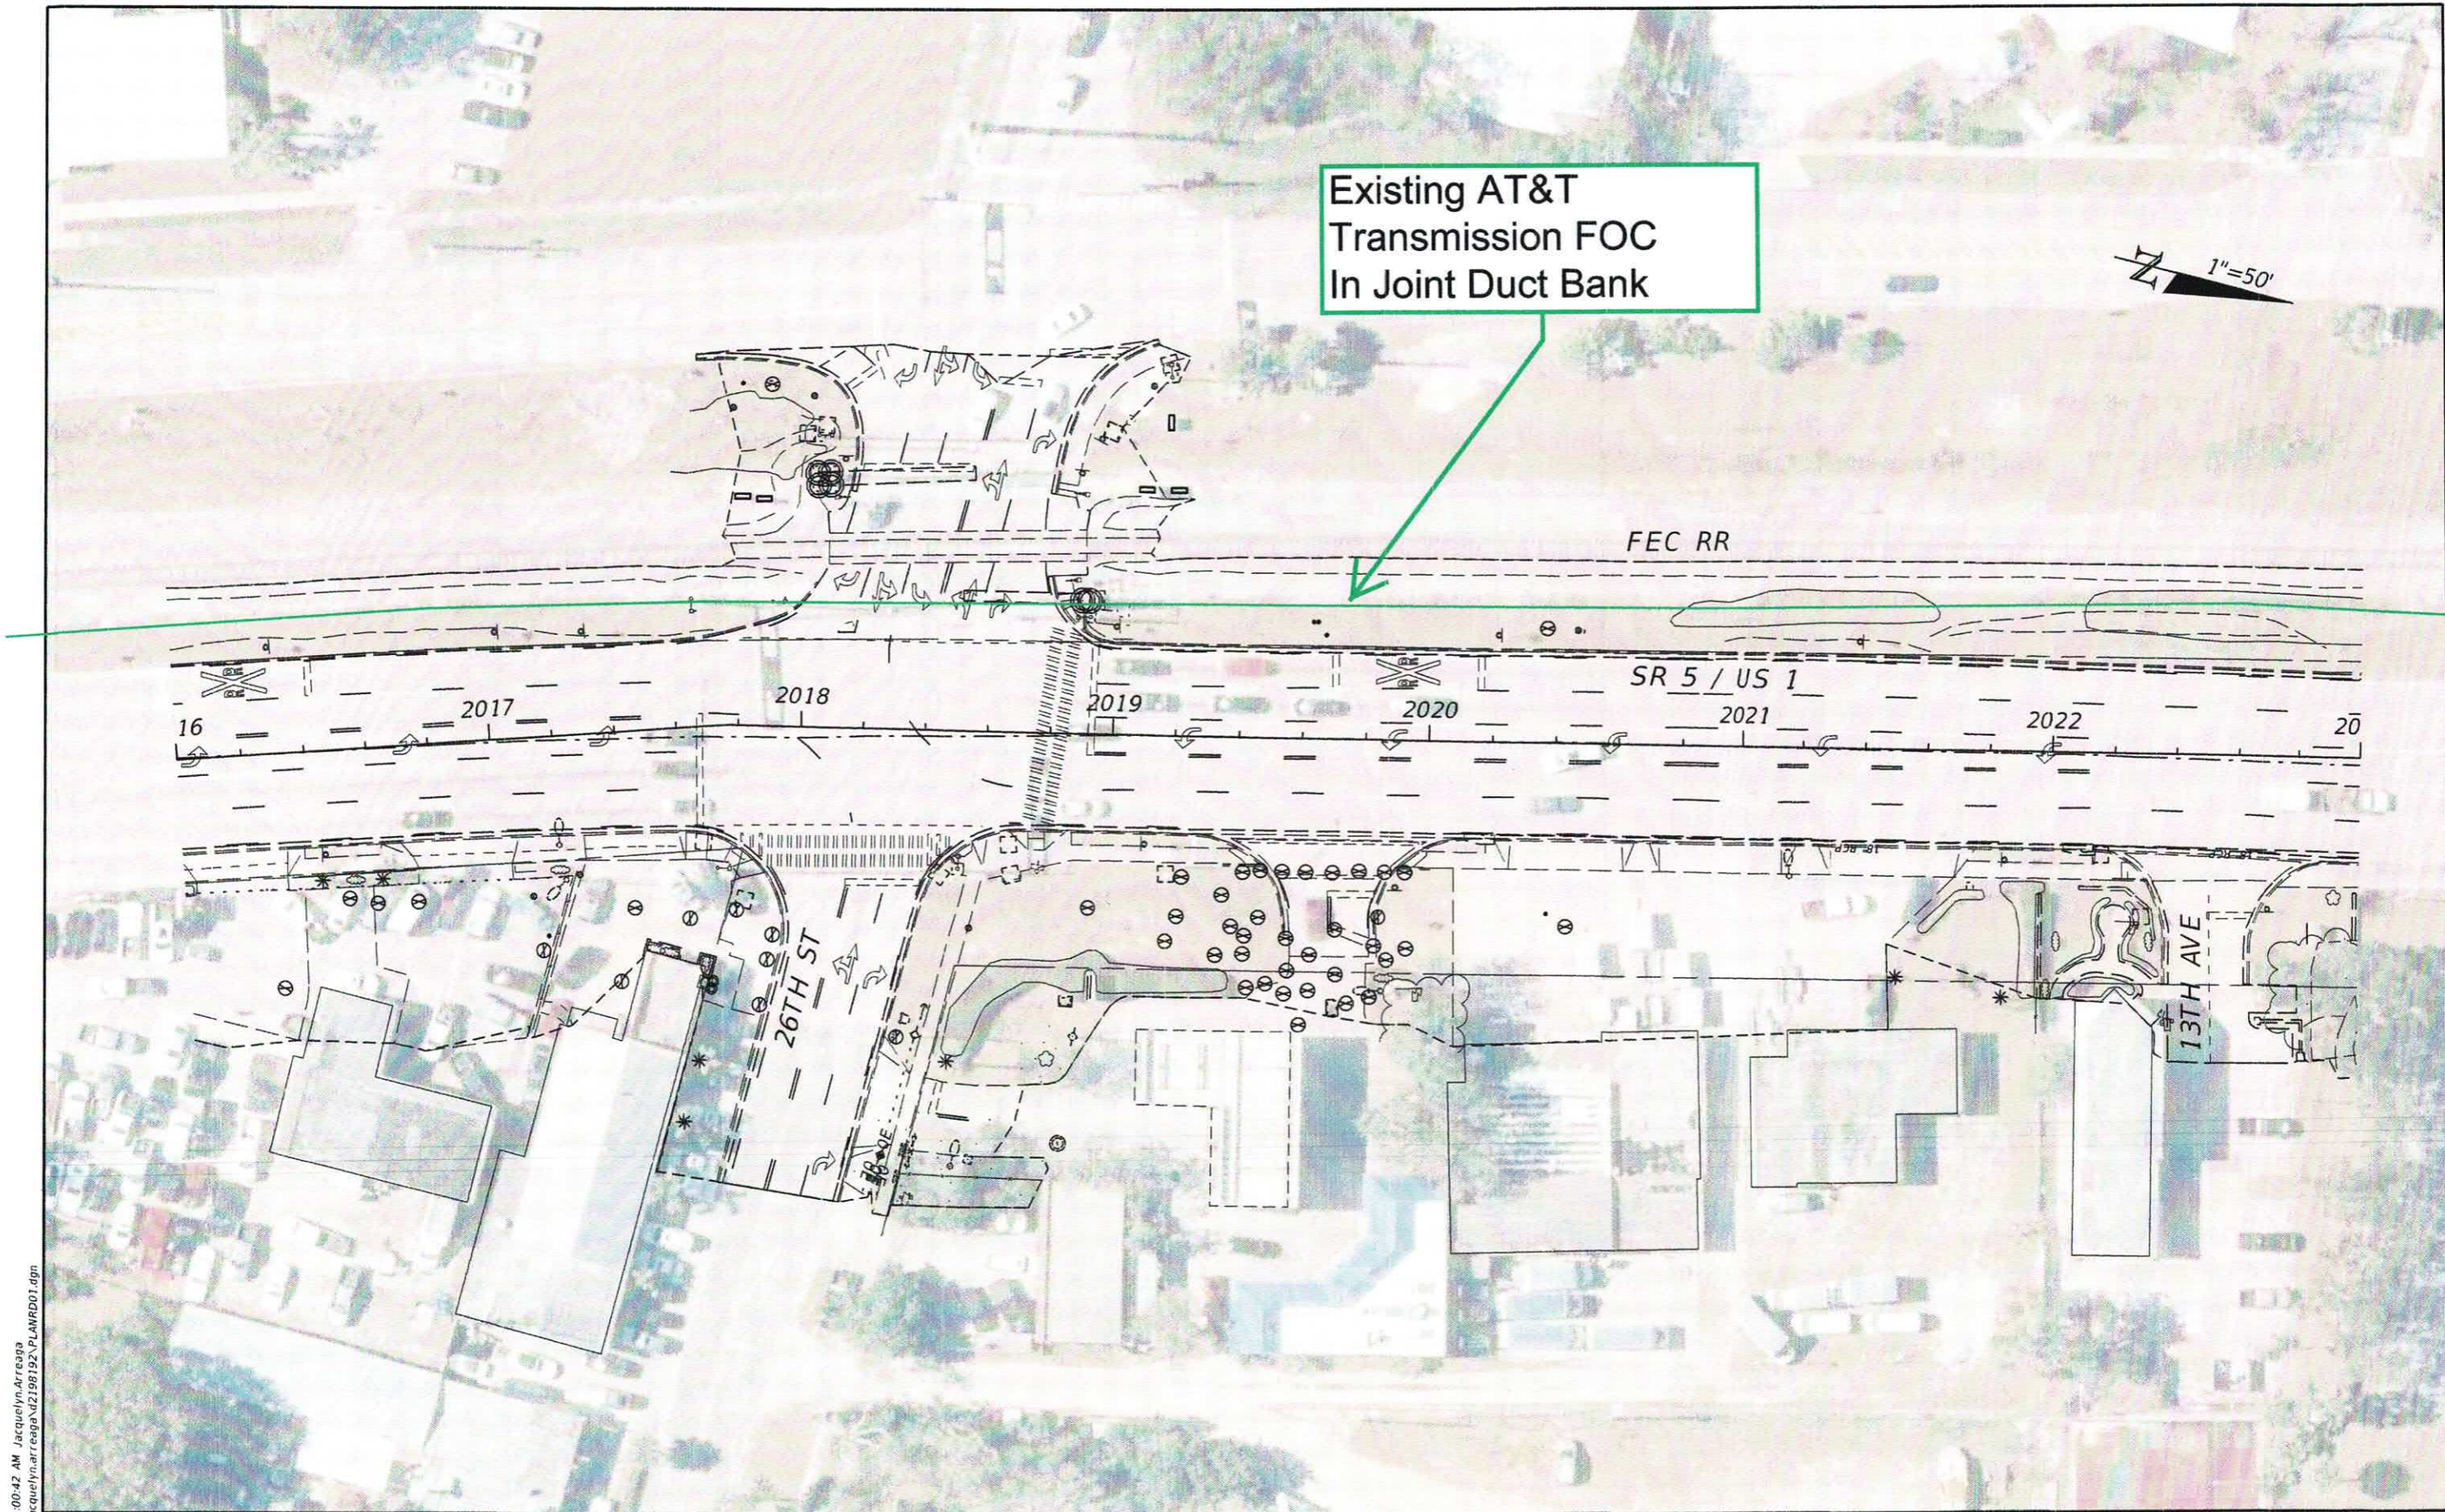

9/15/2022 11:00:42 AM jacquelyn.arraes@wgi.com  
 c:\pwworking\wgi\jacquelyn.arraes\42198192\PLANR001.dgn

REVISIONS				PROFESSIONAL TYPE		STATE OF FLORIDA DEPARTMENT OF TRANSPORTATION			UTILITY CONTACT PLAN (4)	SHEET NO.  4
DATE	DESCRIPTION	DATE	DESCRIPTION	WILLIAM EVANS LICENSE NUMBER: 45207 WGI, INC. 2035 VISTA PARKWAY WEST PALM BEACH, FL 33411		ROAD NO.	COUNTY	FINANCIAL PROJECT ID		
						SR 5	INDIAN RIVER	441693-1-22-02		

THE OFFICIAL RECORD OF THIS SHEET IS THE ELECTRONIC FILE DIGITALLY SIGNED AND SEALED UNDER RULE 61G15-23.004, F.A.C.

Existing AT&T  
Transmission FOC  
In Joint Duct Bank



FEC RR

SR 5 / US 1

23      2024      2025      2026      2027      2028      2029      20

N 13° 4' 59" W

28TH ST

29TH ST

9/15/2022 11:00:51 AM Jacquelyn.Arraeza C:\pwworking\wgi\jacquelyn.araeza\2198192\PL\ARDD01.dgn

REVISIONS			
DATE	DESCRIPTION	DATE	DESCRIPTION

PROFESSIONAL TYPE  
WILLIAM EVANS  
LICENSE NUMBER: 45207  
WGI, INC.  
2035 VISTA PARKWAY  
WEST PALM BEACH, FL 33411

STATE OF FLORIDA DEPARTMENT OF TRANSPORTATION		
ROAD NO.	COUNTY	FINANCIAL PROJECT ID
SR 5	INDIAN RIVER	441693-1-22-02

**UTILITY CONTACT PLAN (5)**

SHEET NO.  
5

THE OFFICIAL RECORD OF THIS SHEET IS THE ELECTRONIC FILE DIGITALLY SIGNED AND SEALED UNDER RULE 61G15-23.004, F.A.C.

Existing AT&T  
Transmission FOC  
In Joint Duct Bank

CITY OF VERO BEACH AIRPORT

1"=50'

FEC RR

30 2031 2032 2033 2034 2035 2036 20

MAIN CANAL

30TH ST

31ST ST

9/15/2022 11:01:04 AM Jacquelyn.Arraras  
C:\pwworking\wgi\jacquelyn.arraras\2198182\PLANRD01.dgn

REVISIONS			
DATE	DESCRIPTION	DATE	DESCRIPTION

PROFESSIONAL TYPE  
WILLIAM EVANS  
LICENSE NUMBER: 45207  
WGI, INC.  
2035 VISTA PARKWAY  
WEST PALM BEACH, FL 33411

STATE OF FLORIDA DEPARTMENT OF TRANSPORTATION		
ROAD NO.	COUNTY	FINANCIAL PROJECT ID
SR 5	INDIAN RIVER	441693-1-22-02

UTILITY CONTACT PLAN (6)

SHEET NO.  
6

THE OFFICIAL RECORD OF THIS SHEET IS THE ELECTRONIC FILE DIGITALLY SIGNED AND SEALED UNDER RULE 61G15-23.004, F.A.C.

Existing AT&T  
Transmission FOC  
In Joint Duct Bank

CITY OF VERO BEACH AIRPORT

CITY OF VERO BEACH  
WATER TREATMENT FACILITY

AVIATION BLVD



FEC RR

SR 5 / US 1

32ND ST

33RD ST

9/15/2022 11:01:42 AM Jacquelyn.Arreaga c:\pwworking\wgn\jacquelyn.arreaga\2198192\PLANR001.dgn

THE OFFICIAL RECORD OF THIS SHEET IS THE ELECTRONIC FILE DIGITALLY SIGNED AND SEALED UNDER RULE 61G15-23.004, F.A.C.


REVISIONS		PROFESSIONAL TYPE		STATE OF FLORIDA DEPARTMENT OF TRANSPORTATION			UTILITY CONTACT PLAN (7)	SHEET NO.
DATE	DESCRIPTION	DATE	DESCRIPTION	ROAD NO.	COUNTY	FINANCIAL PROJECT ID		
				SR 5	INDIAN RIVER	441693-1-22-02		7

WILLIAM EVANS  
LICENSE NUMBER: 45207  
WGI, INC.  
2035 VISTA PARKWAY  
WEST PALM BEACH, FL 33411

CITY OF VERO BEACH AIRPORT



Existing AT&T  
Transmission FOC  
In Joint Duct Bank

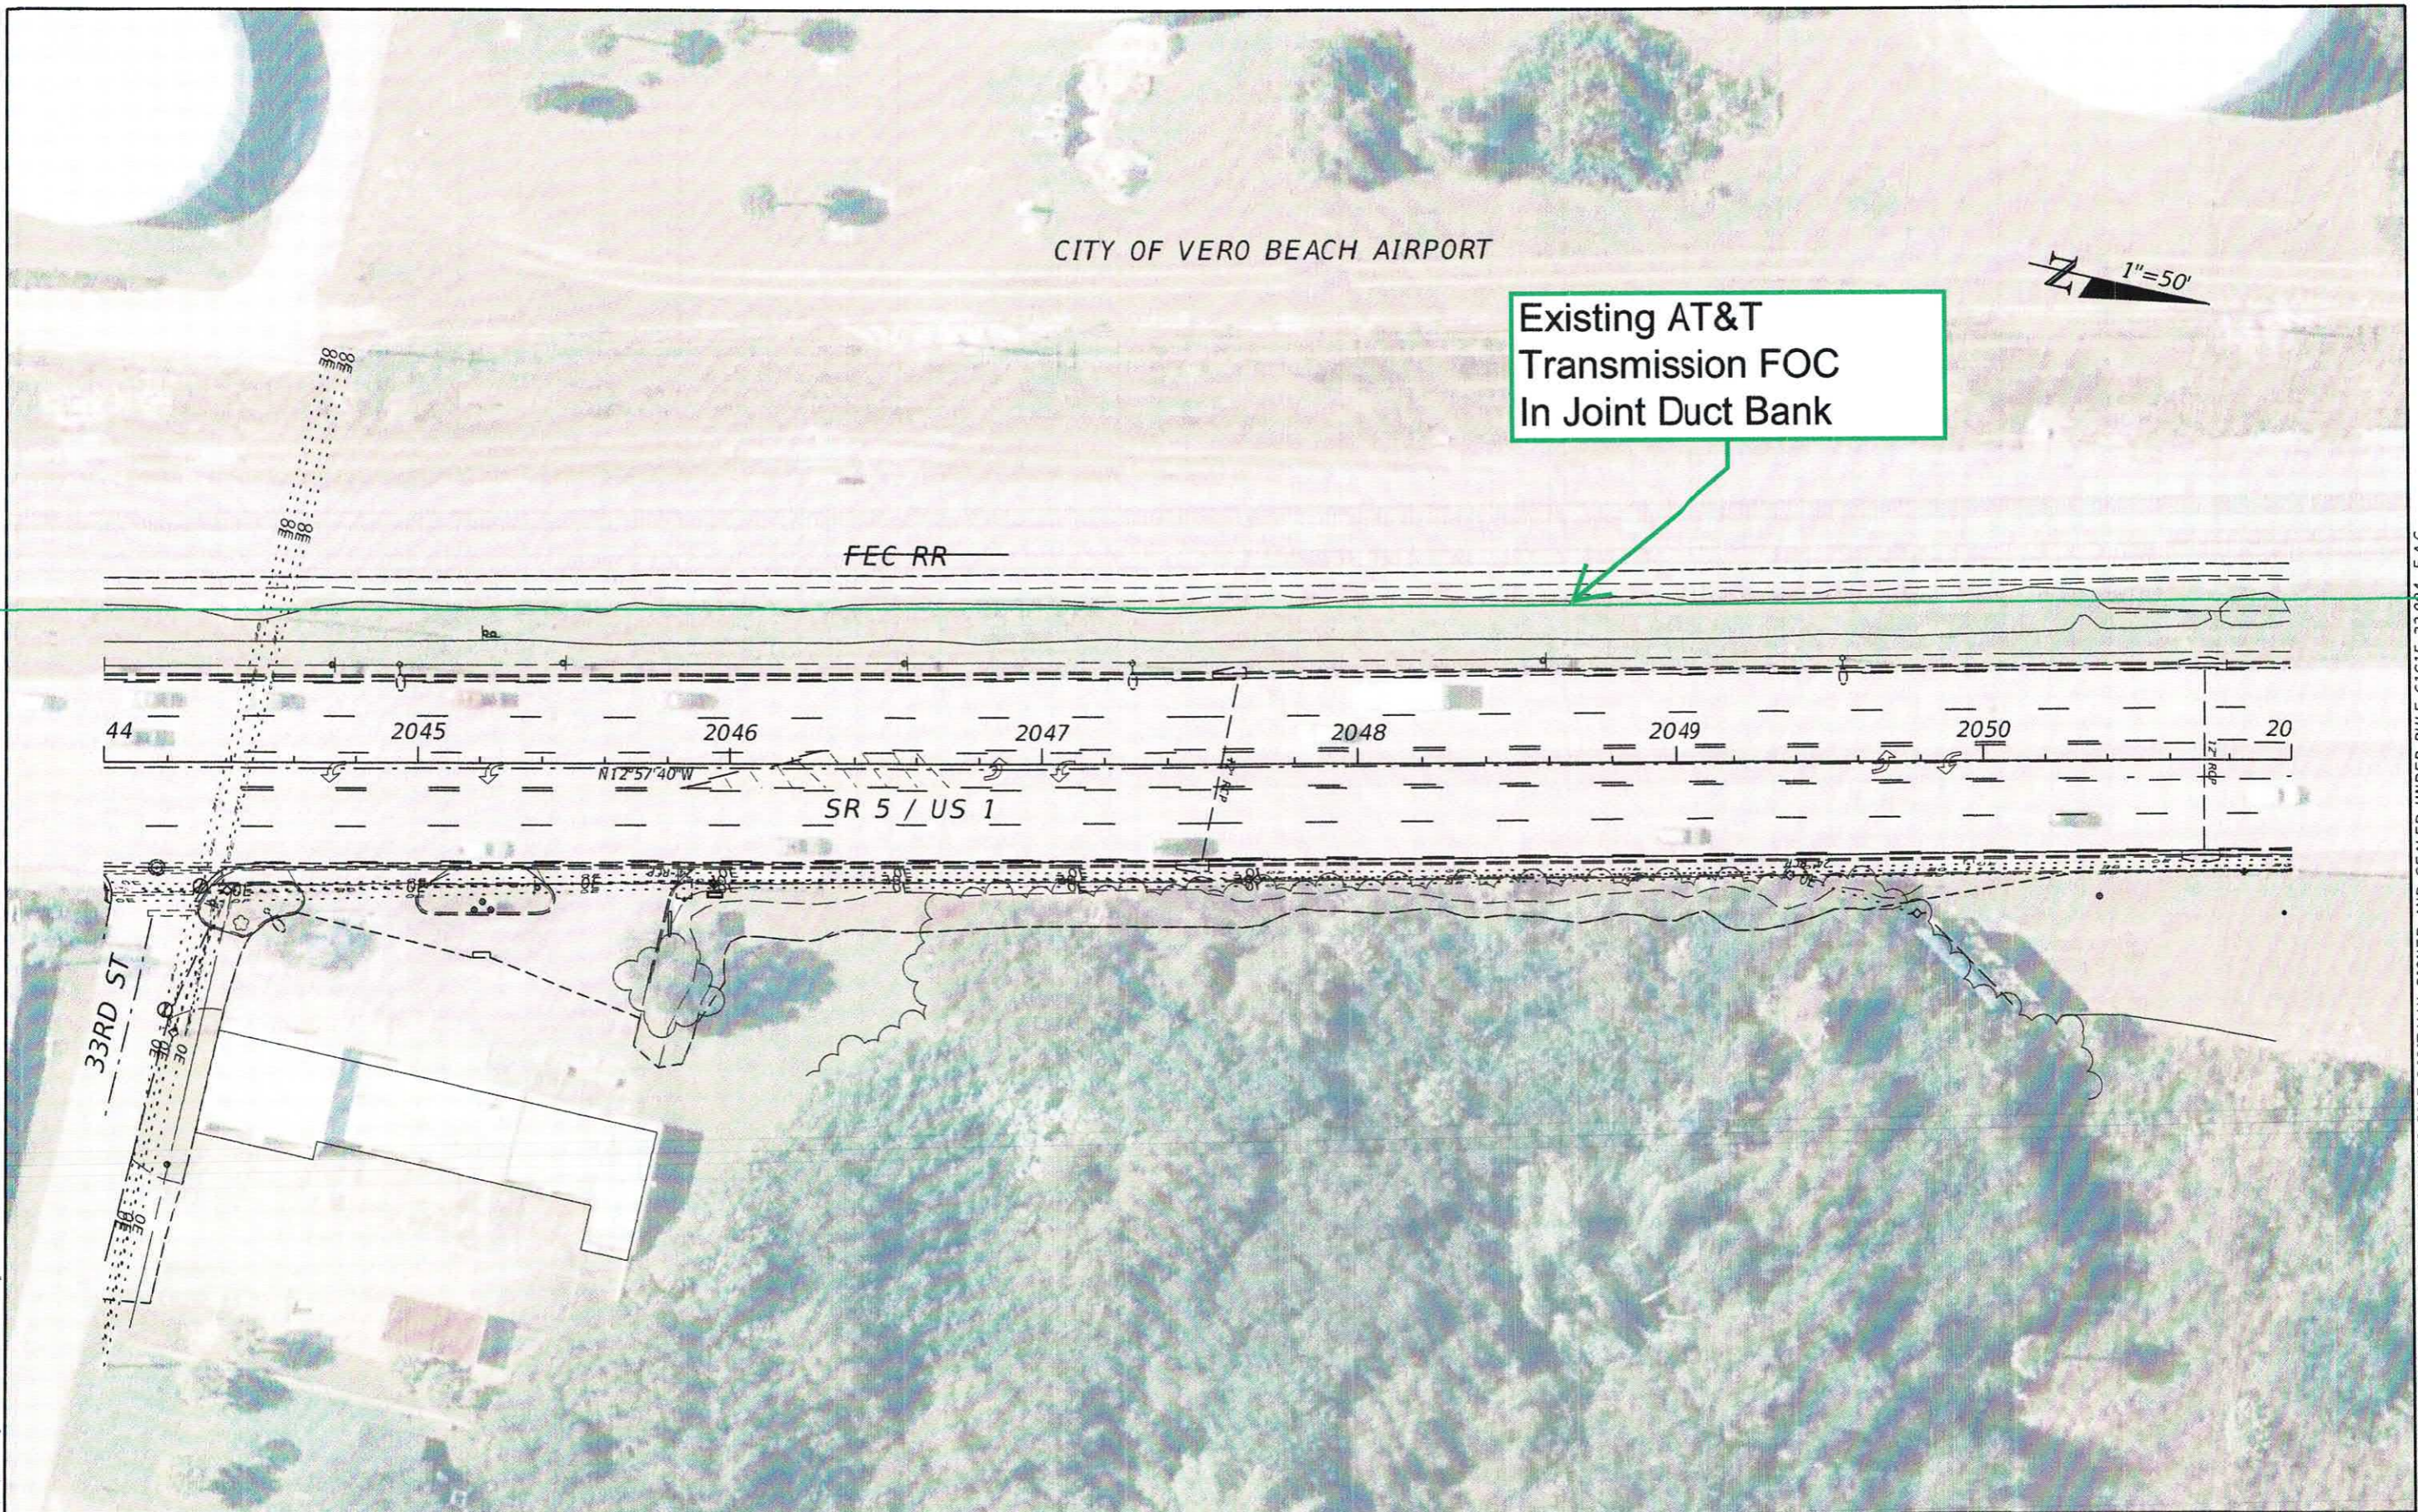

9/15/2022 11:02:24 AM Jacquelyn.Arreola  
C:\pwworking\wgi\jacquelyn.arreola\2198192\PLANRD01.dgn

REVISIONS				PROFESSIONAL TYPE	STATE OF FLORIDA DEPARTMENT OF TRANSPORTATION			UTILITY CONTACT PLAN (8)	SHEET NO. 8
DATE	DESCRIPTION	DATE	DESCRIPTION		ROAD NO.	COUNTY	FINANCIAL PROJECT ID		
				WILLIAM EVANS LICENSE NUMBER: 45207 WGI, INC. 2035 VISTA PARKWAY WEST PALM BEACH, FL 33411	SR 5	INDIAN RIVER	441693-1-22-02		


THE OFFICIAL RECORD OF THIS SHEET IS THE ELECTRONIC FILE DIGITALLY SIGNED AND SEALED UNDER RULE 61G15-23.004, F.A.C.

CITY OF VERO BEACH AIRPORT

Existing AT&T  
Transmission FOC  
In Joint Duct Bank



FEC RR

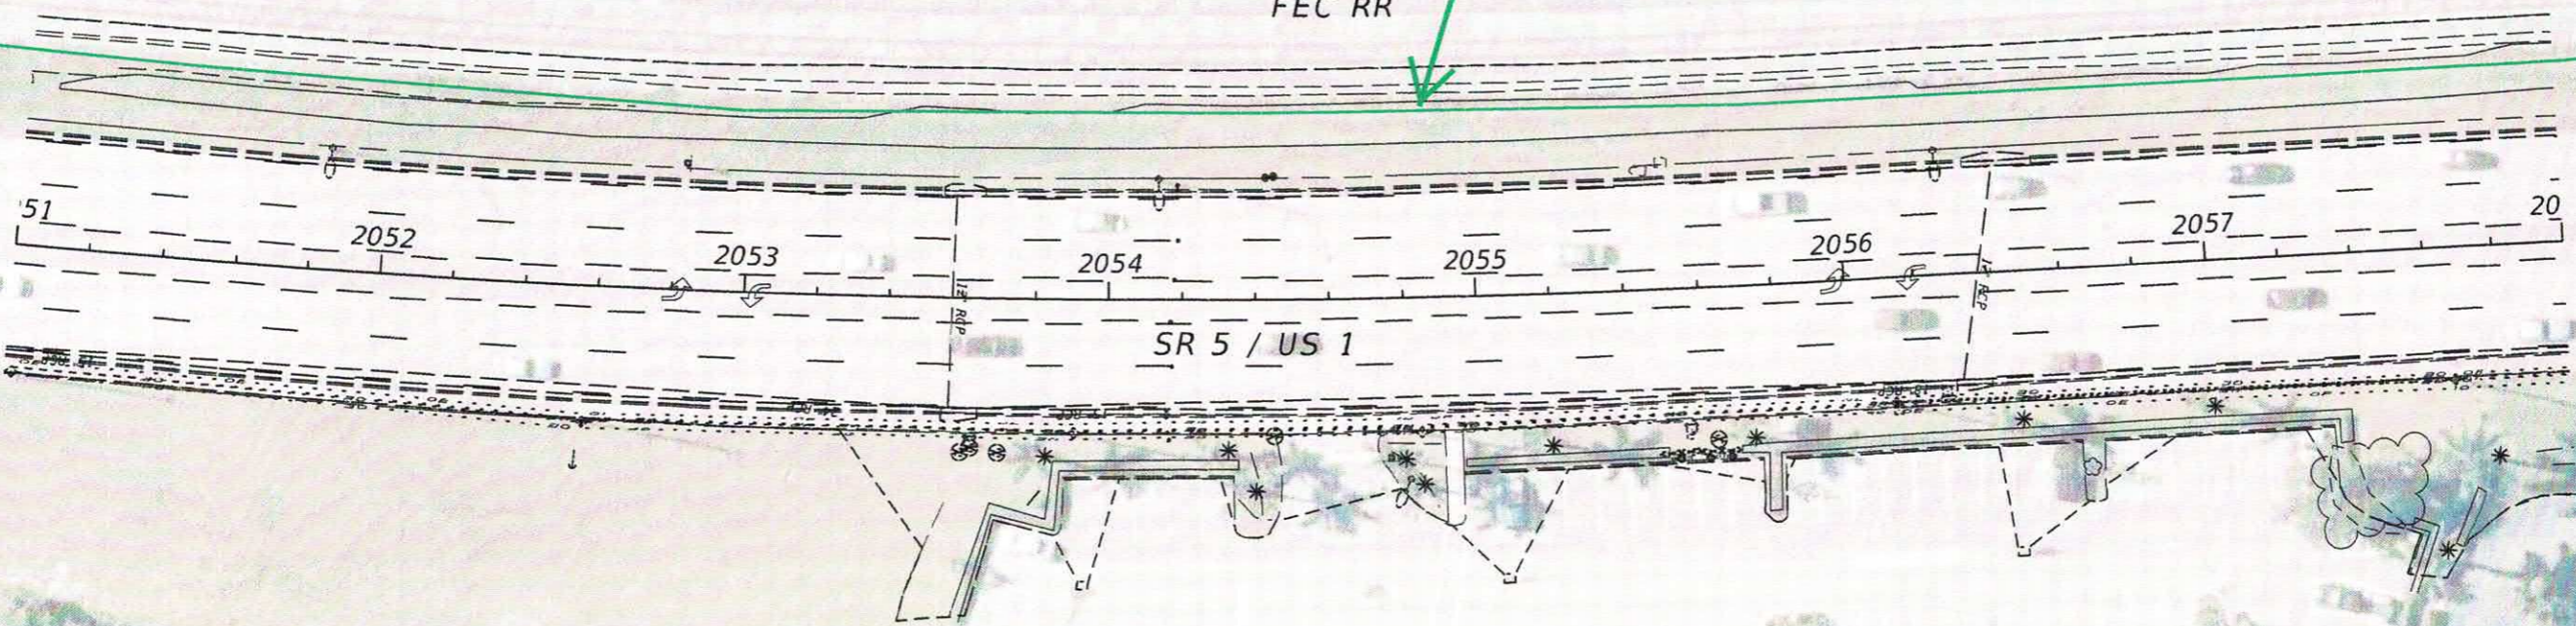

SR 5 / US 1

9/15/2022 11:02:50 AM Jacquelyn.Arreola  
C:\pwworking\wgi\jacquelyn.arreola\2198192\PLANR001.dgn

REVISIONS			
DATE	DESCRIPTION	DATE	DESCRIPTION

PROFESSIONAL TYPE  
WILLIAM EVANS  
LICENSE NUMBER: 45207  
WGI, INC.  
2035 VISTA PARKWAY  
WEST PALM BEACH, FL 33411

STATE OF FLORIDA DEPARTMENT OF TRANSPORTATION		
ROAD NO.	COUNTY	FINANCIAL PROJECT ID
SR 5	INDIAN RIVER	441693-1-22-02

**UTILITY CONTACT PLAN (9)**

SHEET NO.  
9

THE OFFICIAL RECORD OF THIS SHEET IS THE ELECTRONIC FILE DIGITALLY SIGNED AND SEALED UNDER RULE 61G15-23.004, F.A.C.

CITY OF VERO BEACH AIRPORT

Existing AT&T  
Transmission FOC  
In Joint Duct Bank



FEC RR

58 2059 2060 2061 2062 2063 2064 20

SR 5 / US 1

PICKERILL LN


9/15/2022 11:03:08 AM jacquelyn.arres@tpa.com C:\pwworking\wgijac\wgijac-arres\20210915\20210915-PLAND01.dgn

THE OFFICIAL RECORD OF THIS SHEET IS THE ELECTRONIC FILE DIGITALLY SIGNED AND SEALED UNDER RULE 61G15-23.004, F.A.C.

REVISIONS				PROFESSIONAL TYPE		STATE OF FLORIDA DEPARTMENT OF TRANSPORTATION			UTILITY CONTACT PLAN (10)	SHEET NO.  10
DATE	DESCRIPTION	DATE	DESCRIPTION	WILLIAM EVANS LICENSE NUMBER: 45207 WGI, INC. 2035 VISTA PARKWAY WEST PALM BEACH, FL 33411		ROAD NO.	COUNTY	FINANCIAL PROJECT ID		
				SR 5	INDIAN RIVER	441693-1-22-02				



CITY OF VERO BEACH AIRPORT

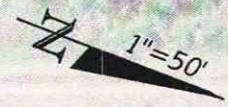

Existing AT&T  
Transmission FOC  
In Joint Duct Bank

FEC RR

65 2066 2067 2068 2069 2070 2071 20  
N21°06'27\"/>

SR 5 / US 1

36TH ST

9/15/2022 11:03:42 AM jacquelyn.arreaga  
C:\pwworking\wgi\jacquelyn.arreaga\22198192\PLANRD01.dgn

REVISIONS		PROFESSIONAL TYPE	
DATE	DESCRIPTION	DATE	DESCRIPTION

WILLIAM EVANS  
LICENSE NUMBER: 45207  
WGI, INC.  
2035 VISTA PARKWAY  
WEST PALM BEACH, FL 33411

STATE OF FLORIDA DEPARTMENT OF TRANSPORTATION		
ROAD NO.	COUNTY	FINANCIAL PROJECT ID
SR 5	INDIAN RIVER	441693-1-22-02

**UTILITY CONTACT PLAN (11)**

SHEET NO.  
11

THE OFFICIAL RECORD OF THIS SHEET IS THE ELECTRONIC FILE DIGITALLY SIGNED AND SEALED UNDER RULE 61G15-23.004, F.A.C.

CITY OF VERO BEACH AIRPORT

Existing AT&T  
Transmission FOC  
In Joint Duct Bank



FEC RR

SR 5 / US 1

72 2073 2074 2075 2076 2077 2078 20

N20°11'43"W


37TH PL

37TH ST

9/15/2022 11:04:09 AM Jacquelyn.Arrcupsa c:\pwworking\wgi\jacquelyn.arrcupsa\d2198192\PLANRD01.dgn

THE OFFICIAL RECORD OF THIS SHEET IS THE ELECTRONIC FILE DIGITALLY SIGNED AND SEALED UNDER RULE 61G15-23.004, F.A.C.

REVISIONS				PROFESSIONAL TYPE		STATE OF FLORIDA DEPARTMENT OF TRANSPORTATION			UTILITY CONTACT PLAN (12)	SHEET NO.
DATE	DESCRIPTION	DATE	DESCRIPTION	WILLIAM EVANS LICENSE NUMBER: 45207 WGI, INC. 2035 VISTA PARKWAY WEST PALM BEACH, FL 33411		ROAD NO.	COUNTY	FINANCIAL PROJECT ID		
						SR 5	INDIAN RIVER	441693-1-22-02		12

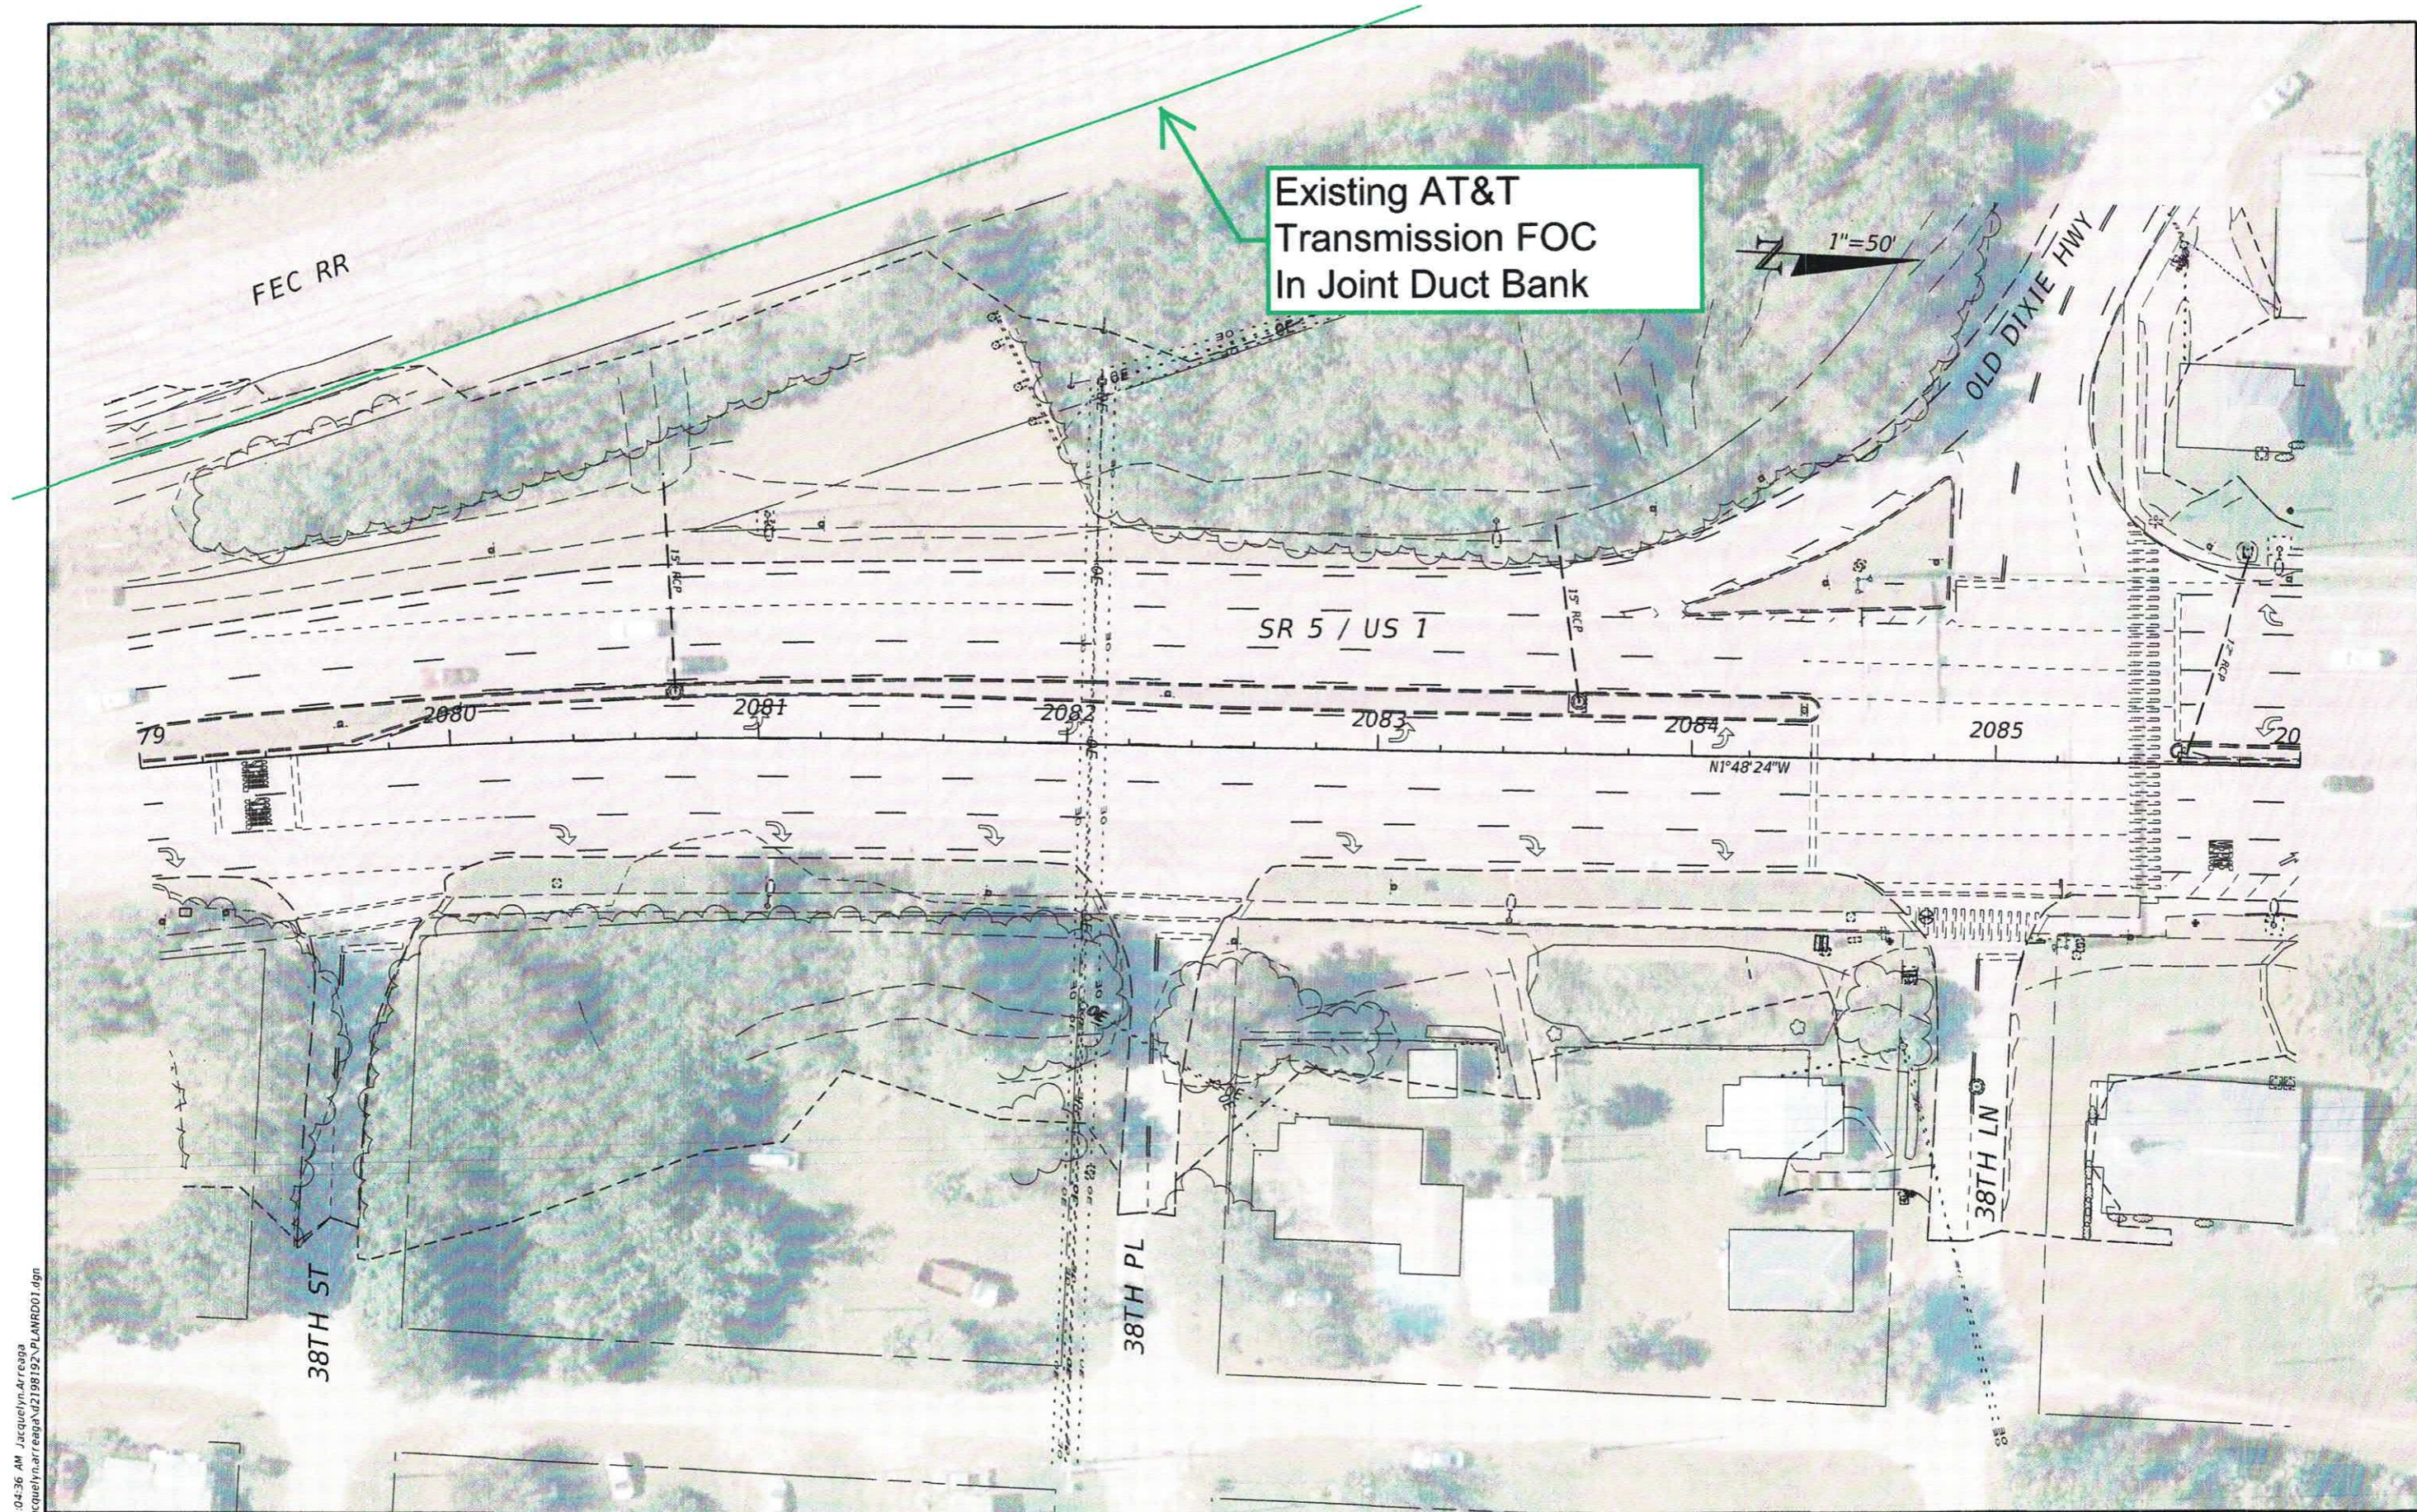

Existing AT&T  
Transmission FOC  
In Joint Duct Bank

9/15/2022 11:04:36 AM Jacquelyn.Arreaga  
c:\pwworking\wgi\jacquelyn.arreaga\27198192\PLANRD01.dgn

REVISIONS		PROFESSIONAL TYPE	
DATE	DESCRIPTION	DATE	DESCRIPTION

WILLIAM EVANS  
LICENSE NUMBER: 45207  
WGI, INC.  
2035 VISTA PARKWAY  
WEST PALM BEACH, FL 33411


STATE OF FLORIDA DEPARTMENT OF TRANSPORTATION		
ROAD NO.	COUNTY	FINANCIAL PROJECT ID
SR 5	INDIAN RIVER	441693-1-22-02

**UTILITY CONTACT PLAN (13)**

SHEET NO.  
13

THE OFFICIAL RECORD OF THIS SHEET IS THE ELECTRONIC FILE DIGITALLY SIGNED AND SEALED UNDER RULE 61G15-23.004, F.A.C.

CITY OF VERO BEACH AIRPORT

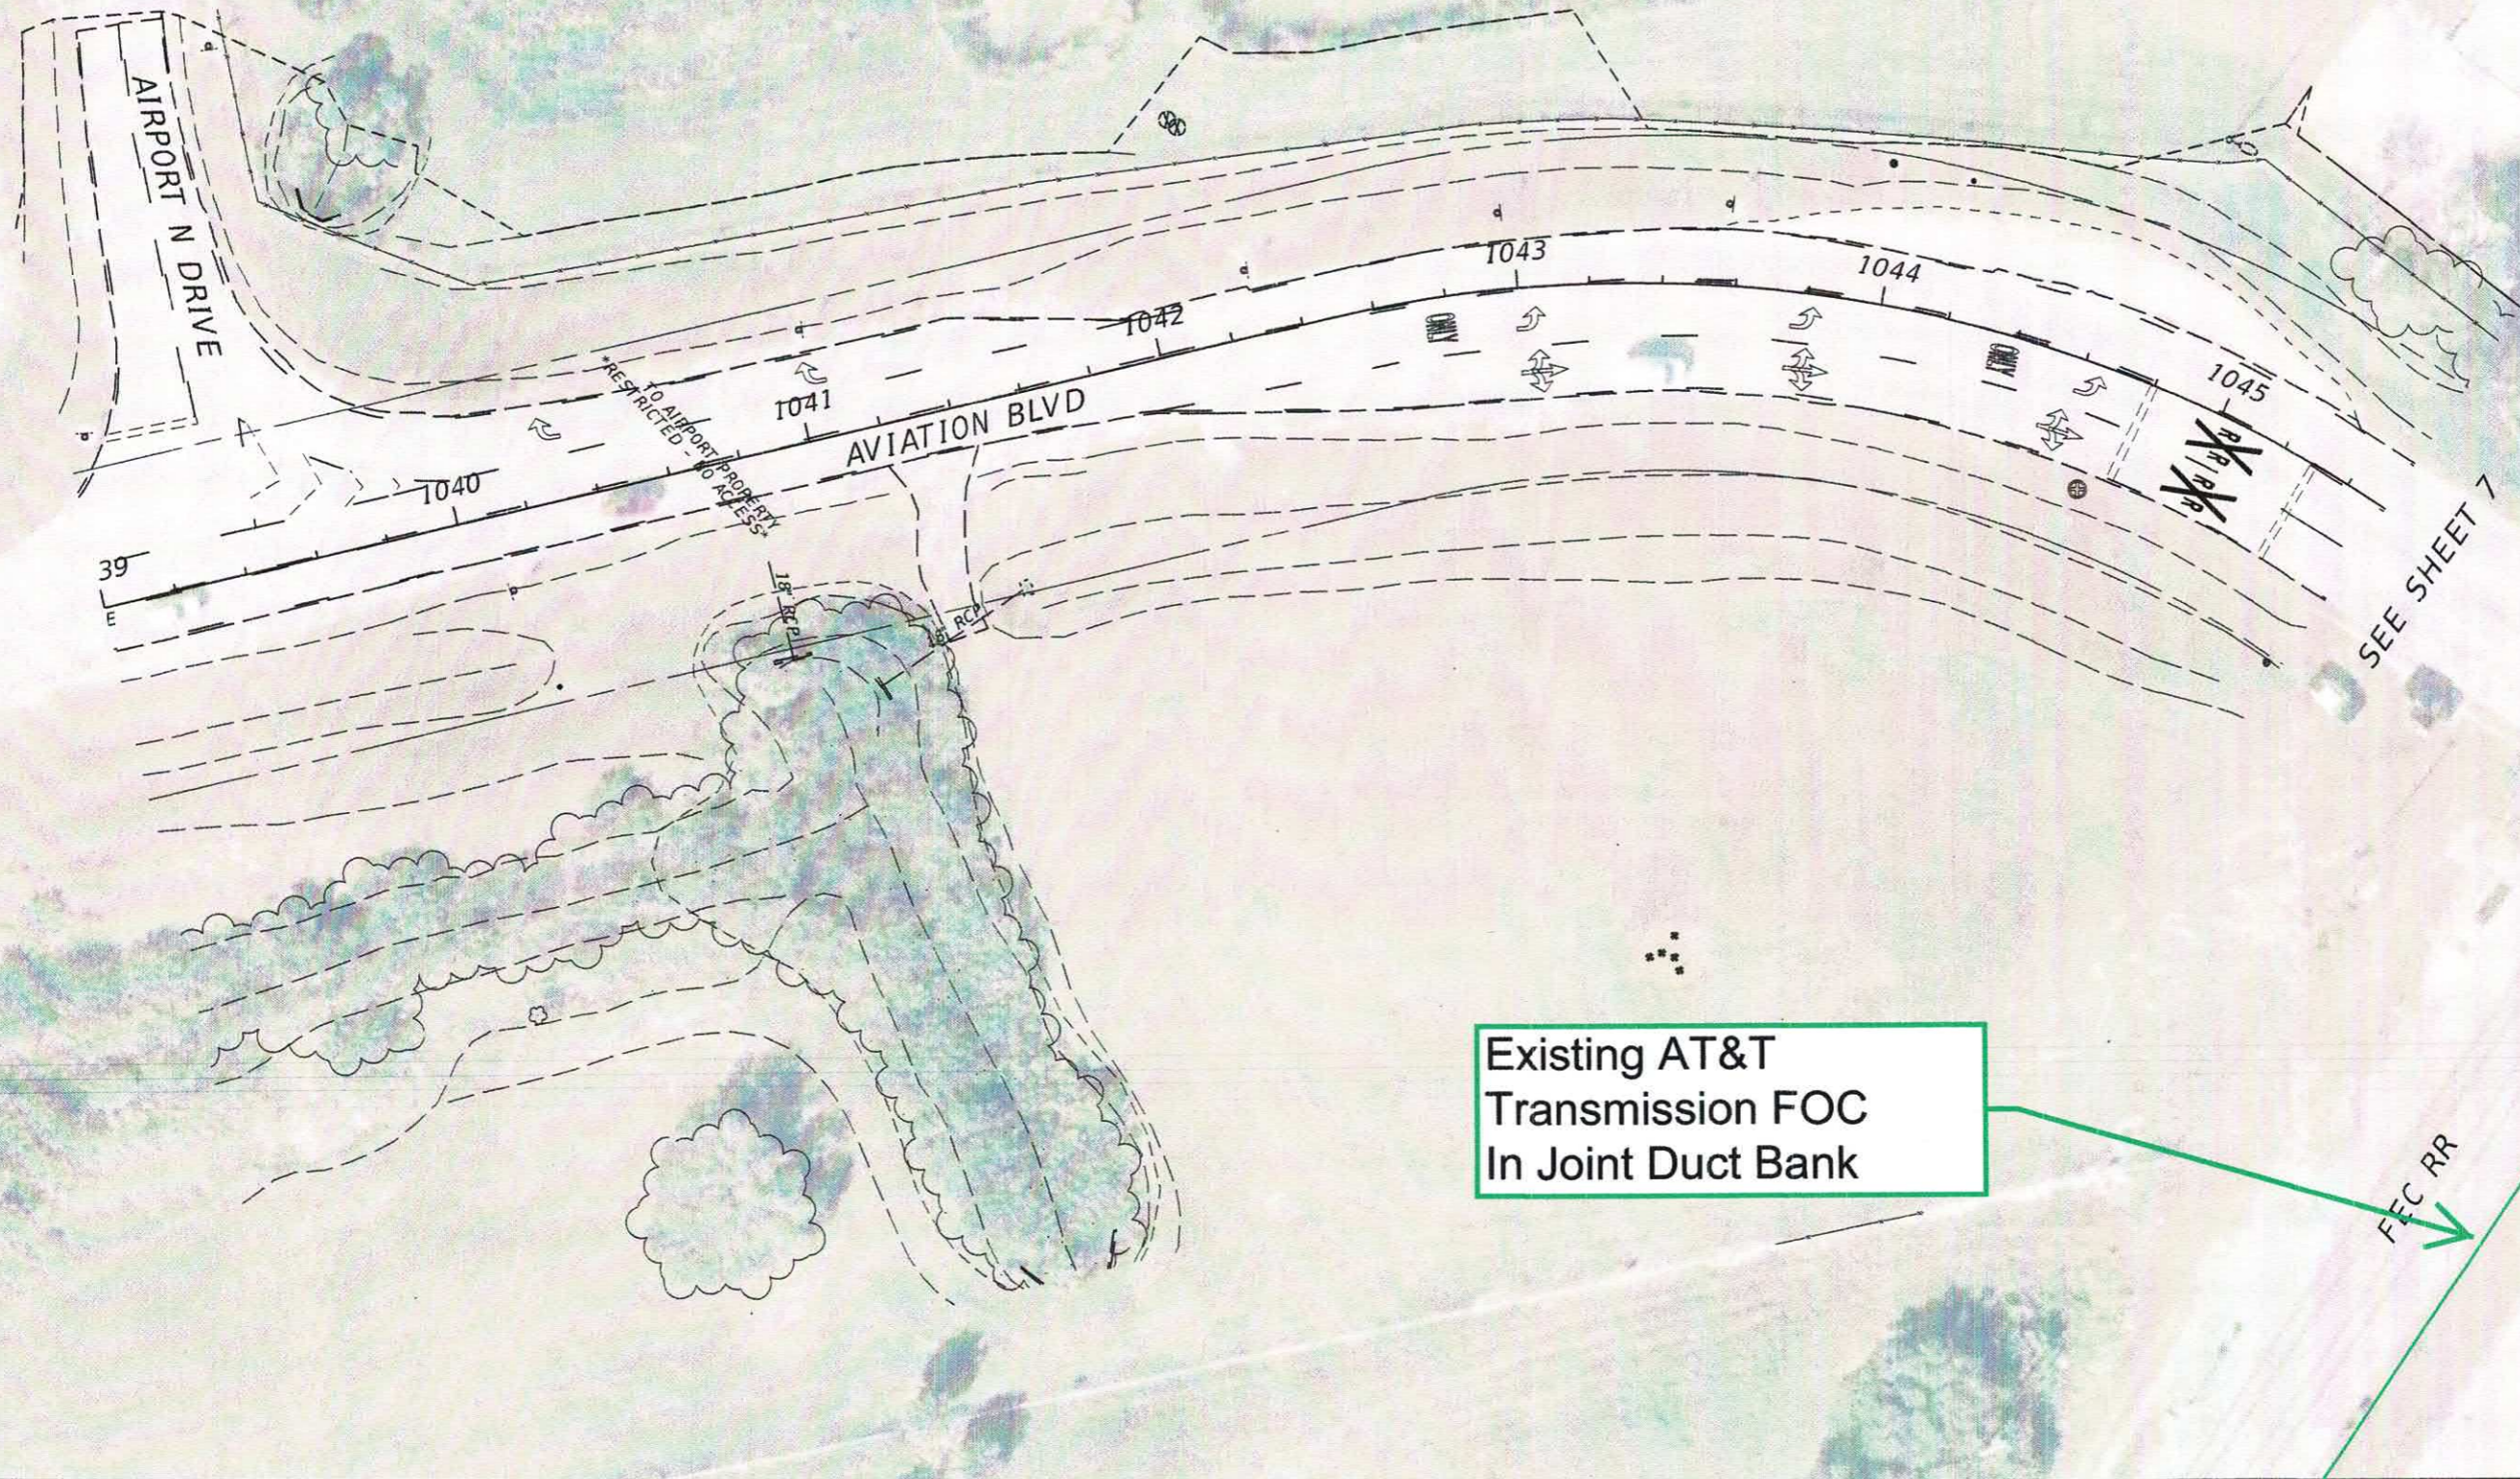

Existing AT&T  
Transmission FOC  
In Joint Duct Bank

FEC RR

SR 5 / US 1

9/15/2022 11:09:43 AM Jacquelyn.Arreaga  
C:\pwworking\wgj\jacquelyn.arreaga\2738192\PLANRD01.dgn


REVISIONS				PROFESSIONAL TYPE	STATE OF FLORIDA DEPARTMENT OF TRANSPORTATION			SHEET NO.
DATE	DESCRIPTION	DATE	DESCRIPTION		ROAD NO.	COUNTY	FINANCIAL PROJECT ID	
				WILLIAM EVANS LICENSE NUMBER: 45207 WGI, INC. 2035 VISTA PARKWAY WEST PALM BEACH, FL 33411	SR 5	INDIAN RIVER	441693-1-22-02	27

**UTILITY CONTACT PLAN (27)**

THE OFFICIAL RECORD OF THIS SHEET IS THE ELECTRONIC FILE DIGITALLY SIGNED AND SEALED UNDER RULE 61G15-23.004, F.A.C.

**Appendix D**

**City of Vero Beach**

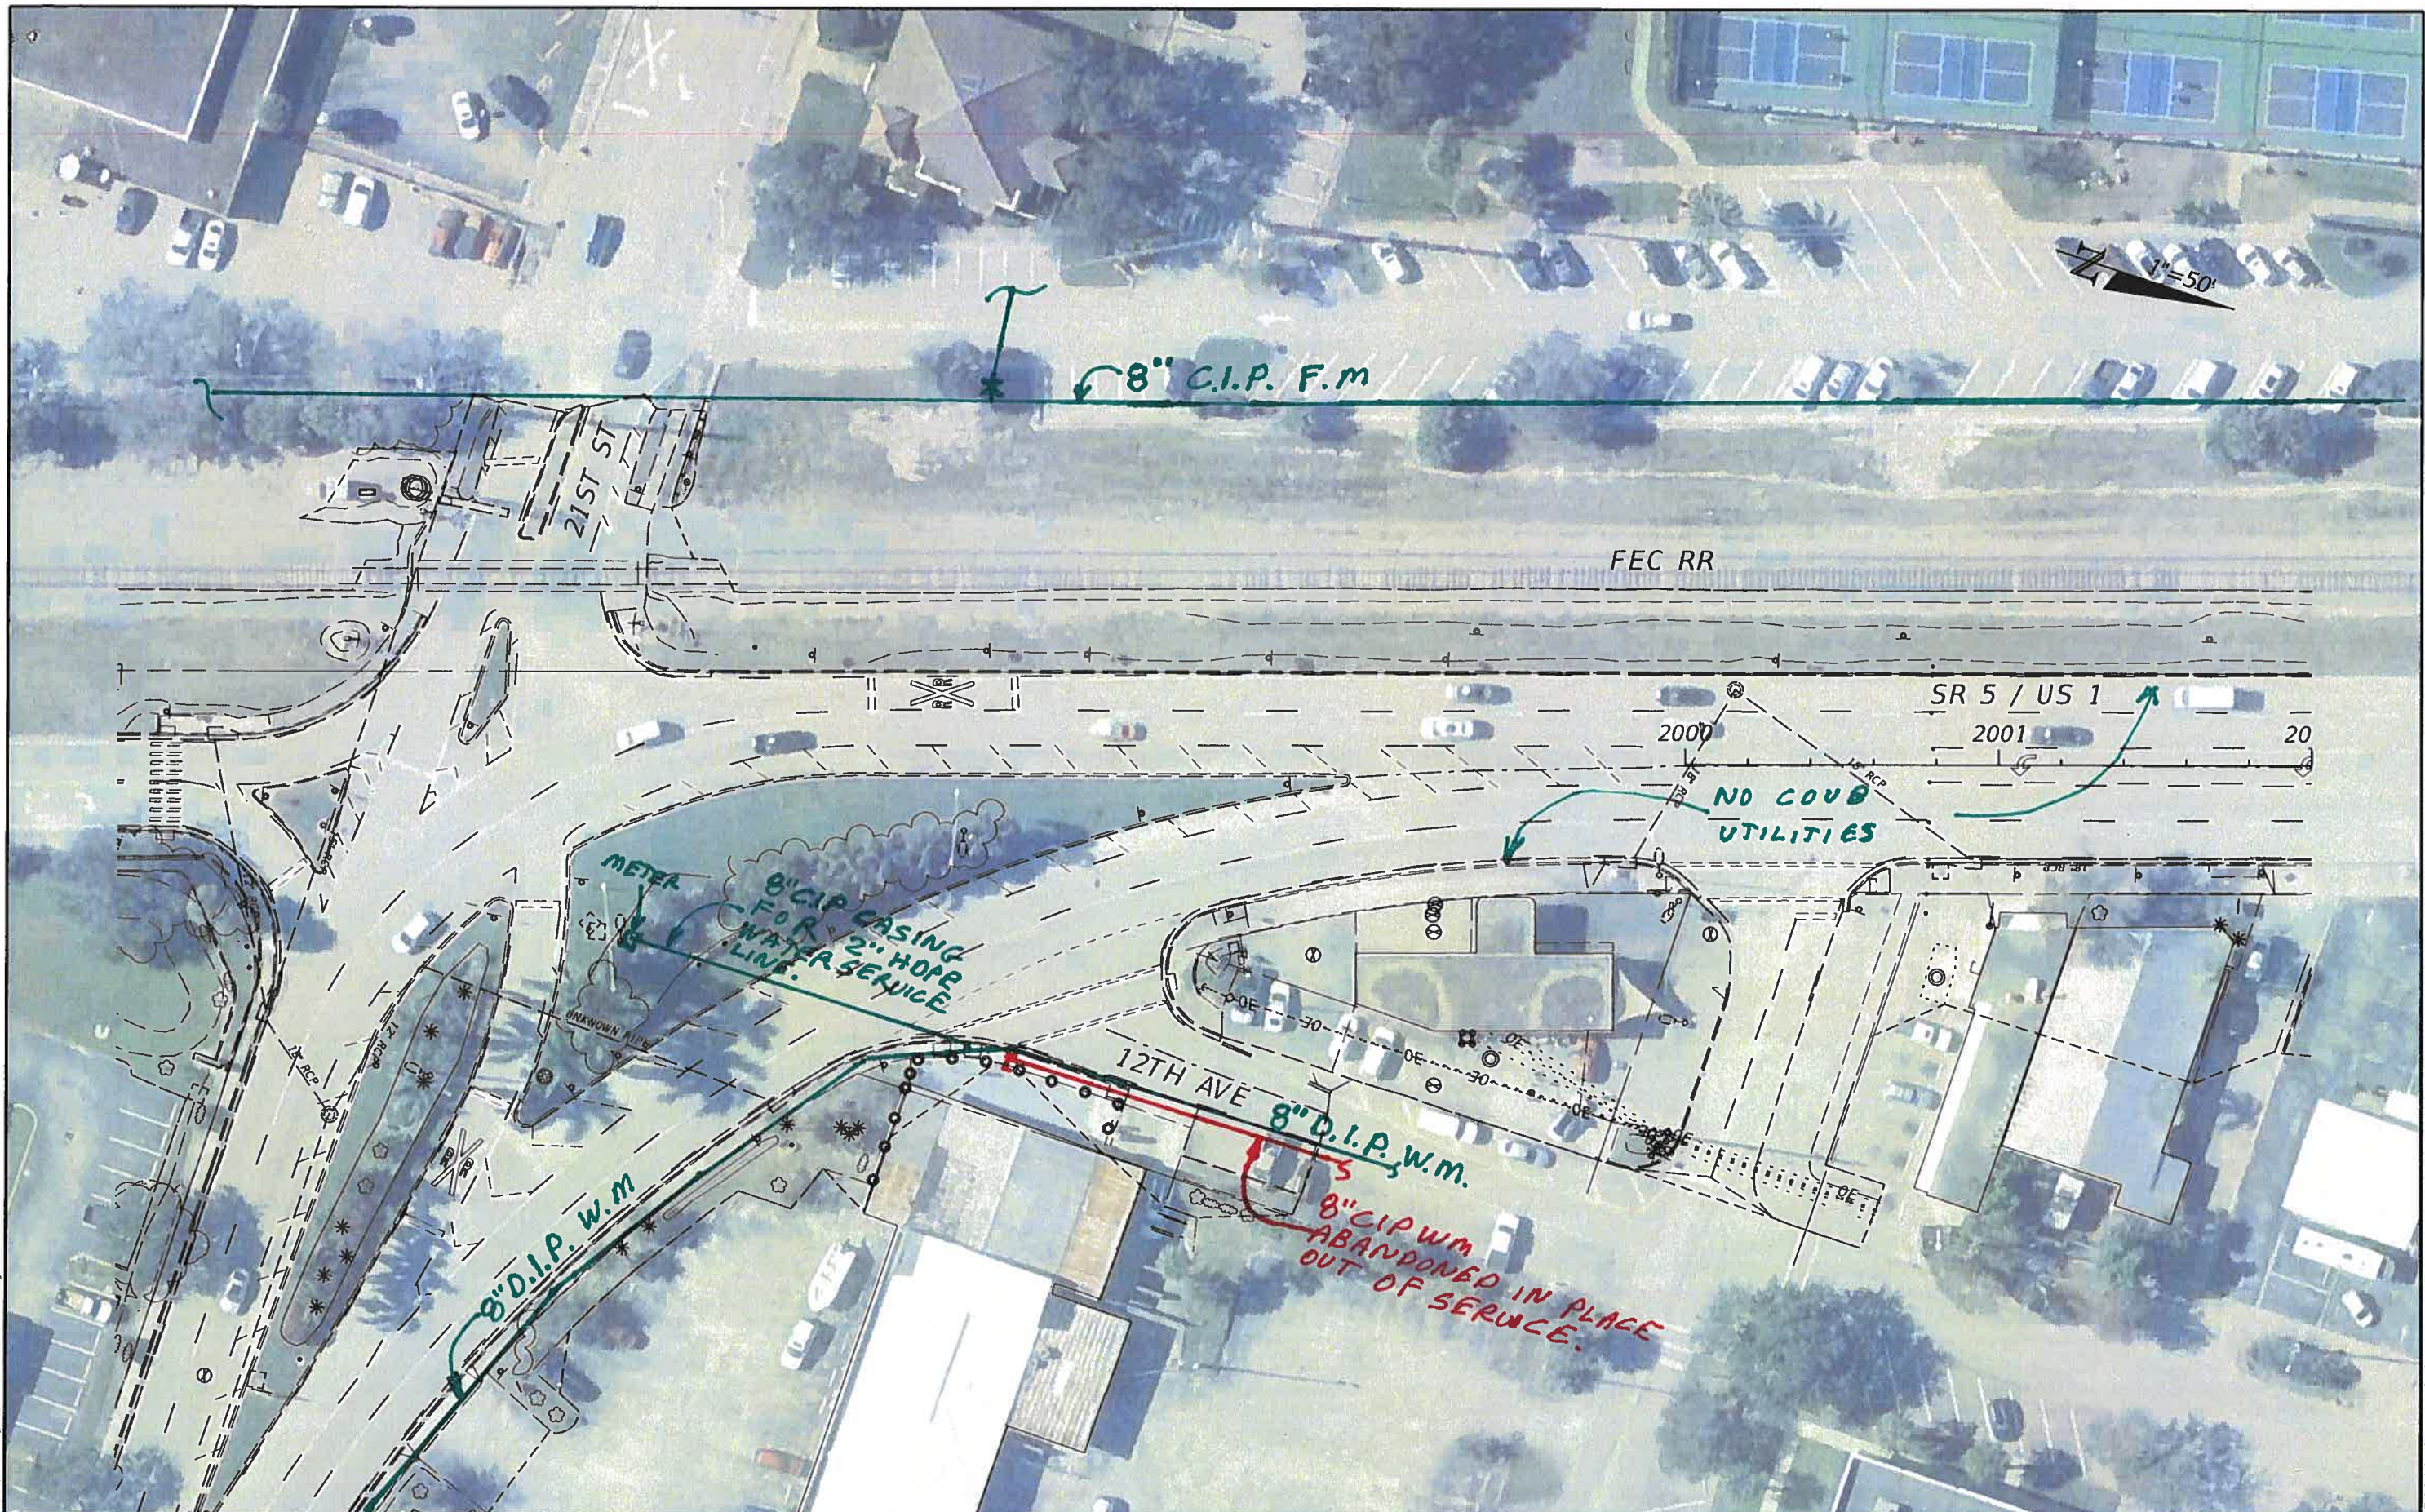


9/15/2022 10:58:52 AM jacquelyn.arrcaga  
 C:\pwworking\wg\jacquelyn.arrcaga\2198192\PLANR001.dgn

REVISIONS		PROFESSIONAL TYPE		STATE OF FLORIDA DEPARTMENT OF TRANSPORTATION			UTILITY CONTACT PLAN (1)	SHEET NO. 1
DATE	DESCRIPTION	DATE	DESCRIPTION	ROAD NO.	COUNTY	FINANCIAL PROJECT ID		
				SR 5	INDIAN RIVER	441693-1-22-02		

WILLIAM EVANS  
 LICENSE NUMBER: 45207  
 WGI, INC.  
 2035 VISTA PARKWAY  
 WEST PALM BEACH, FL 33411

THE OFFICIAL RECORD OF THIS SHEET IS THE ELECTRONIC FILE DIGITALLY SIGNED AND SEALED UNDER RULE 61G15-23.004, F.A.C.

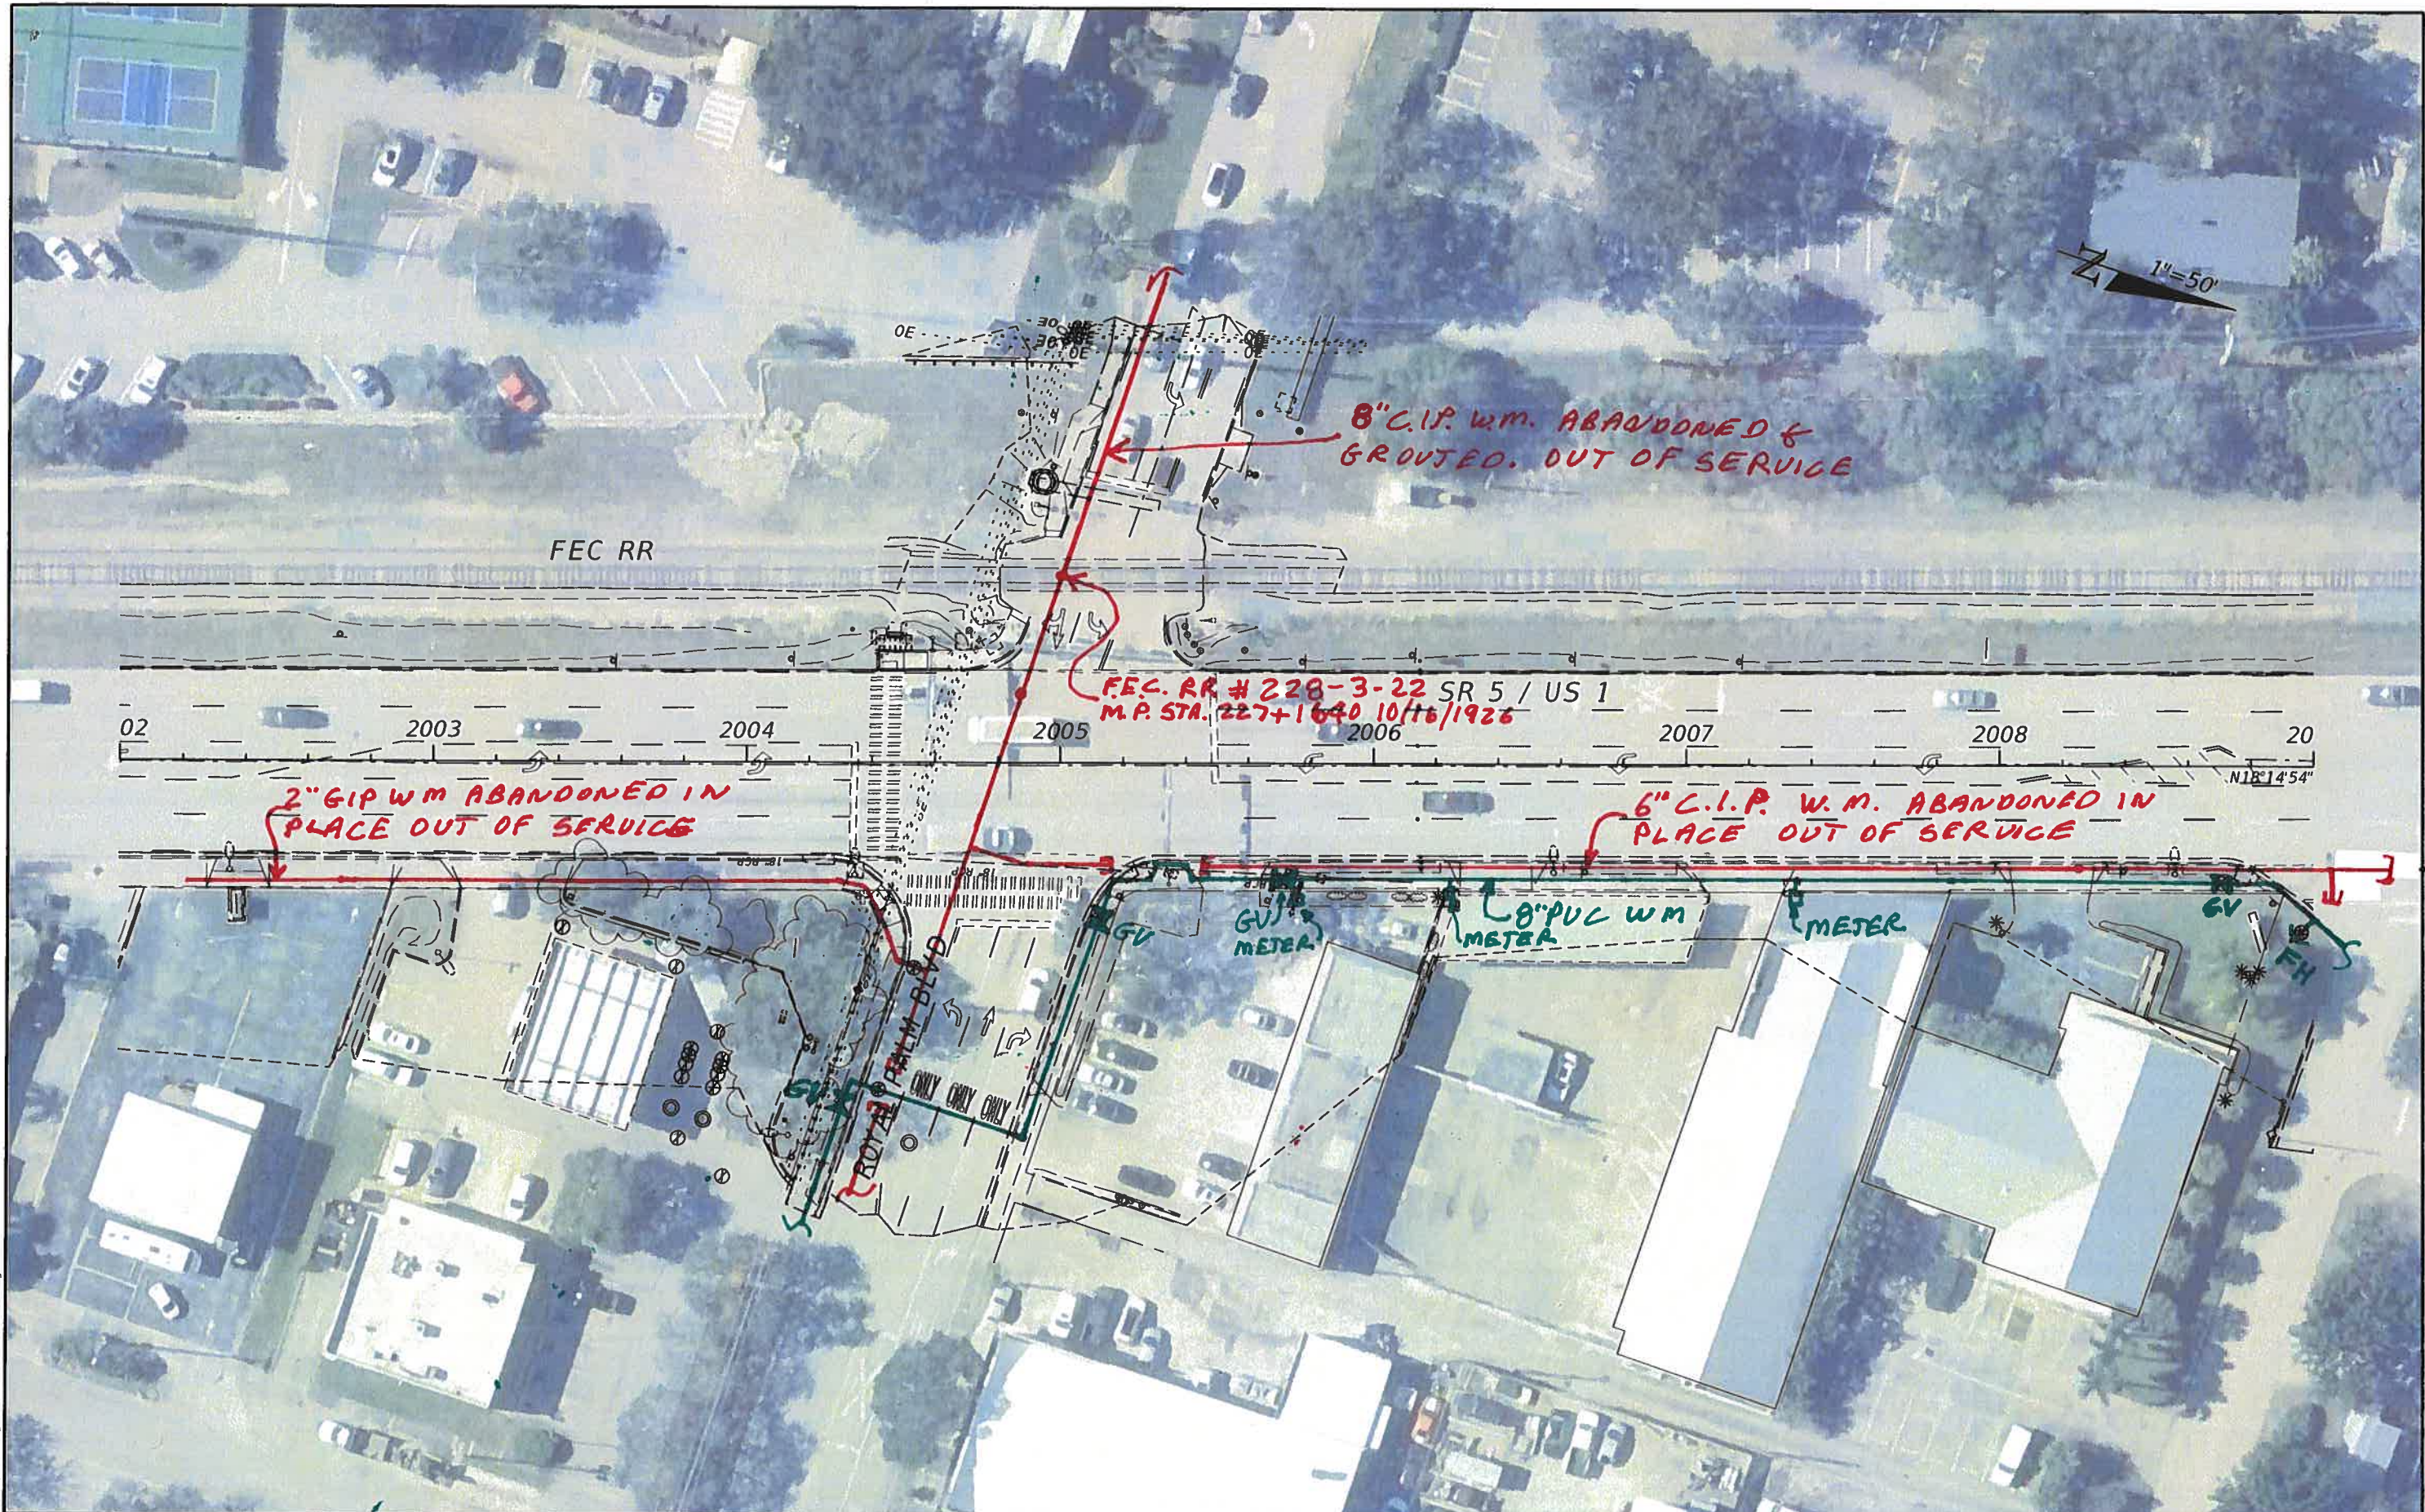


02 2003 2004 2005 2006 2007 2008 20  
 N18°14'54"

REVISIONS		PROFESSIONAL TYPE		STATE OF FLORIDA DEPARTMENT OF TRANSPORTATION			UTILITY CONTACT PLAN (2)	SHEET NO.
DATE	DESCRIPTION	DATE	DESCRIPTION	ROAD NO.	COUNTY	FINANCIAL PROJECT ID		
				SR 5	INDIAN RIVER	441693-1-22-02		2

9/15/2022 10:59:58 AM Jacquelyn.Arrasca  
 c:\pwworking\wgi\jacquelyn.arraasca\2198192\PLANRD01.dgn

THE OFFICIAL RECORD OF THIS SHEET IS THE ELECTRONIC FILE DIGITALLY SIGNED AND SEALED UNDER RULE 61G15-23.004, F.A.C.

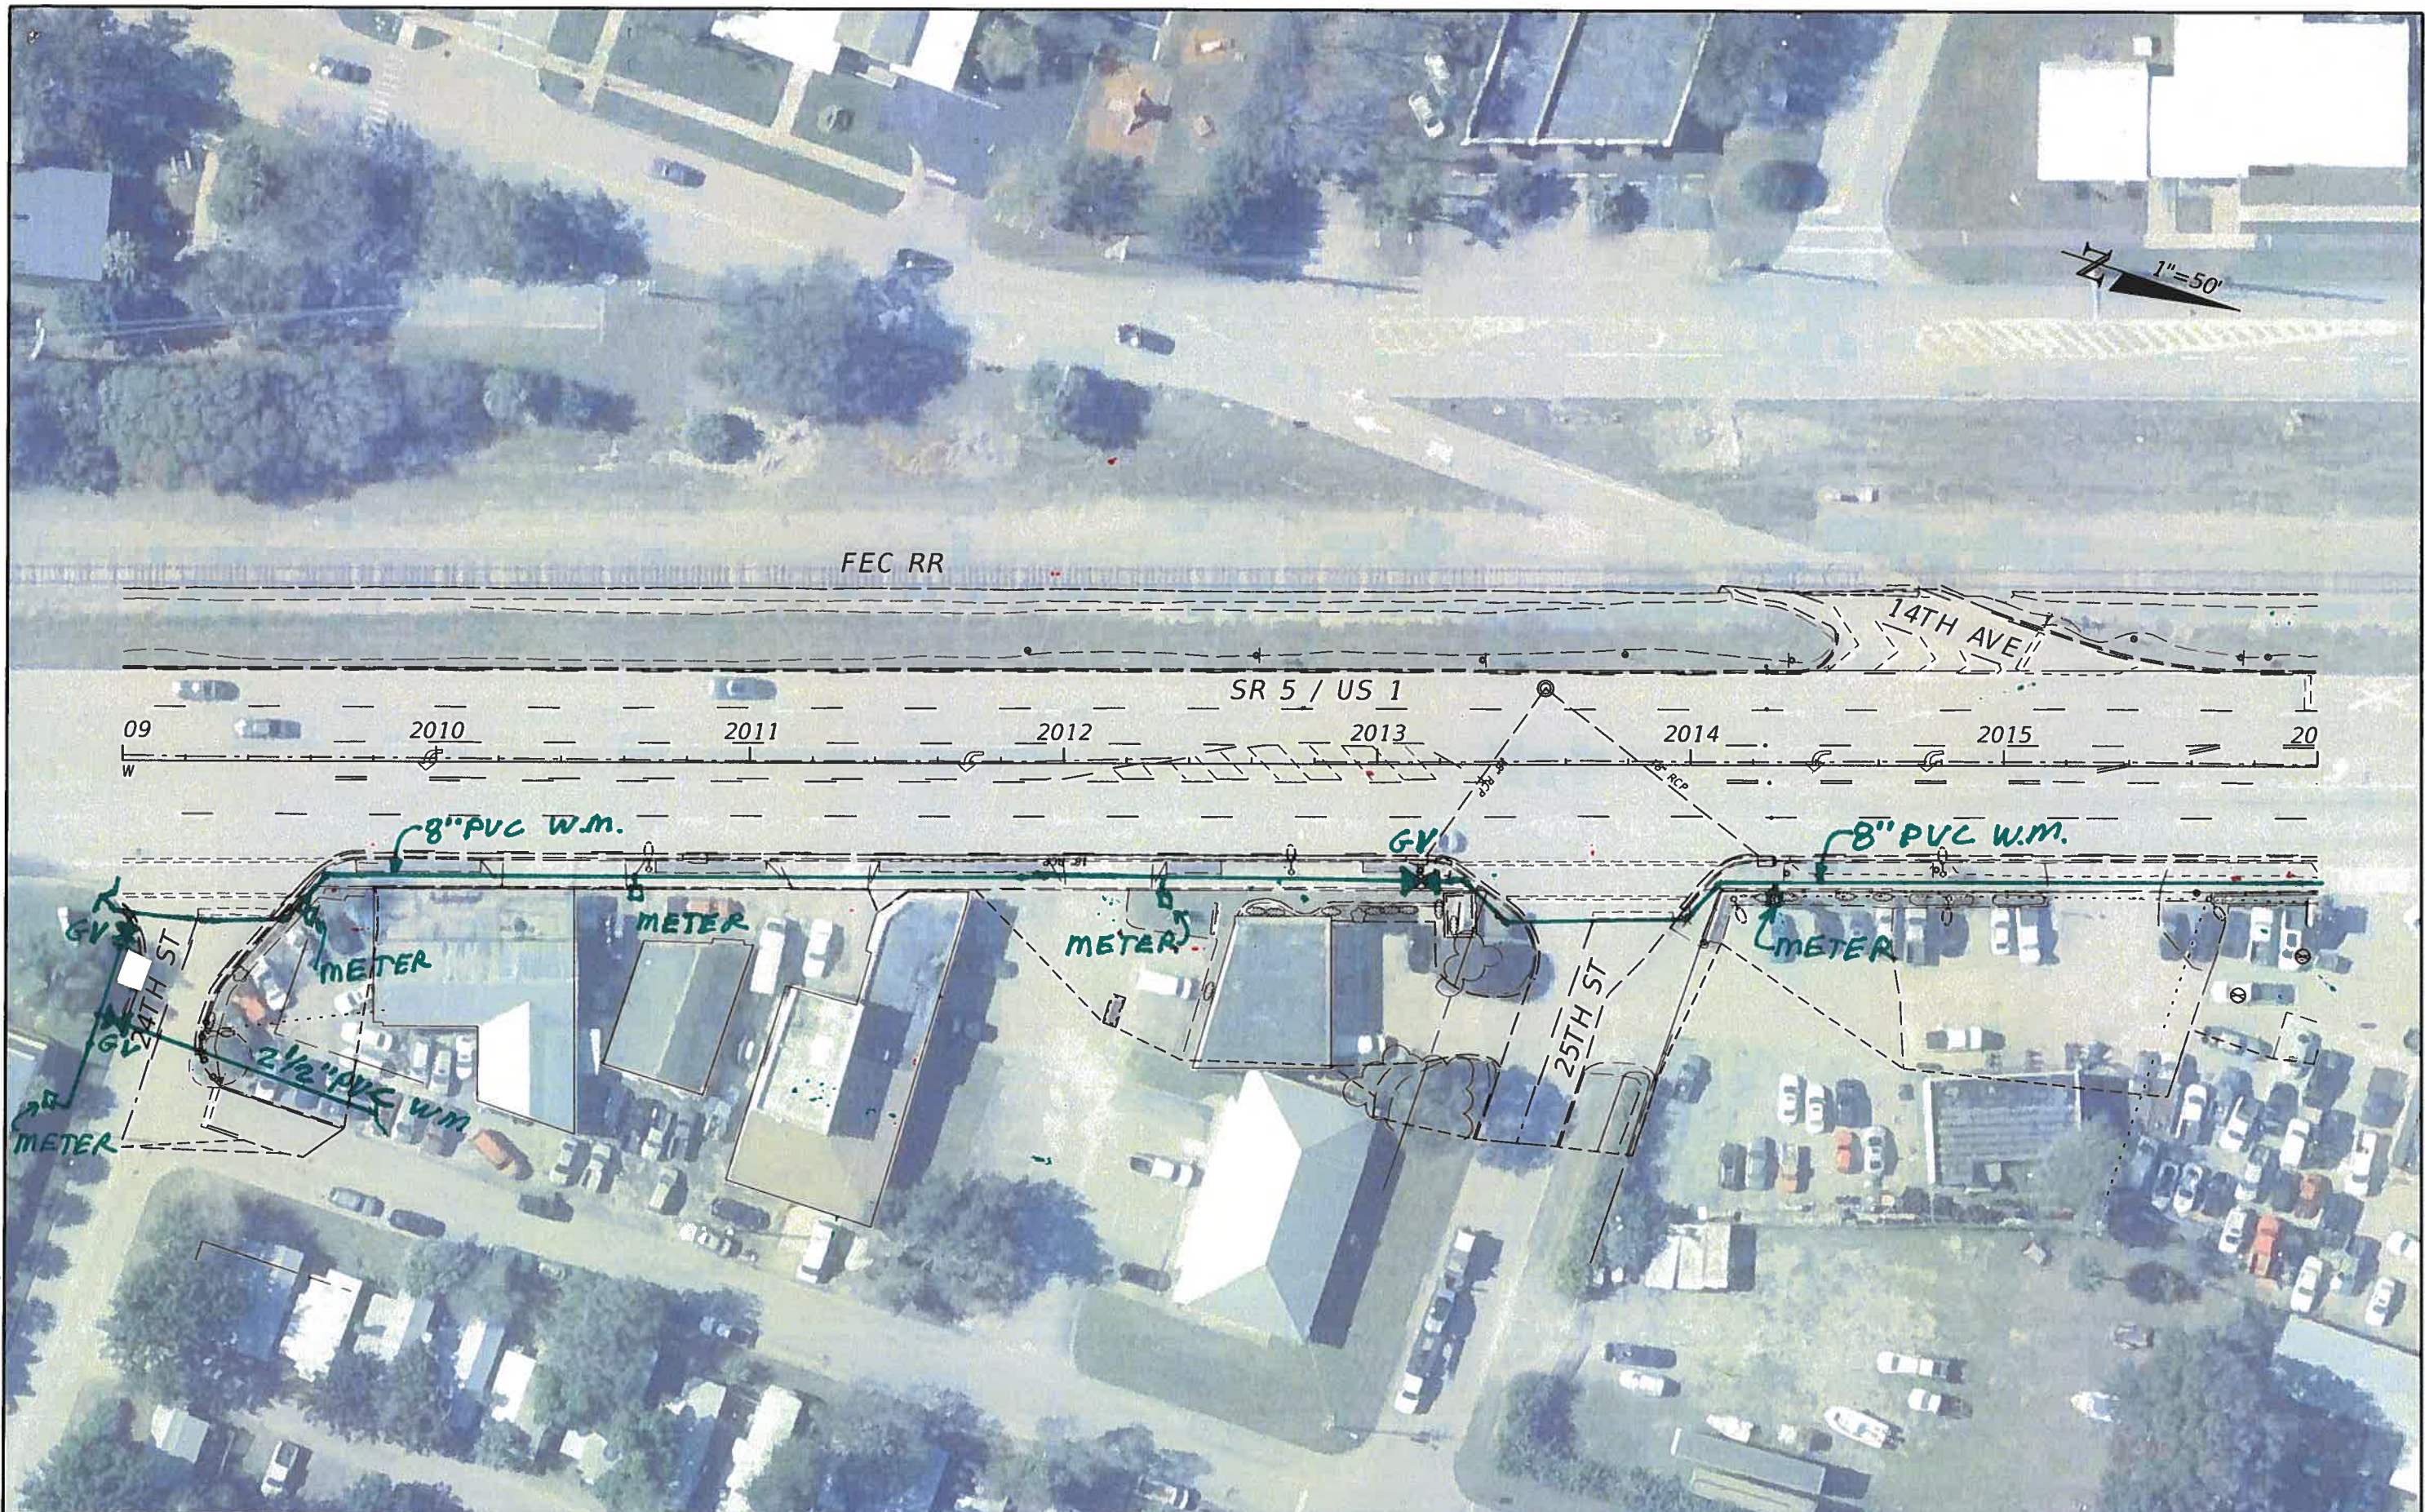

09 2010 2011 2012 2013 2014 2015 20



9/15/2022 11:00:13 AM Jacquelyn Arrcaga c:\pwworking\wgi\jacquelyn\arrcaga\02198192\PLANR001.dgn

THE OFFICIAL RECORD OF THIS SHEET IS THE ELECTRONIC FILE DIGITALLY SIGNED AND SEALED UNDER RULE 61G15-23.004, F.A.C.

REVISIONS		PROFESSIONAL TYPE		STATE OF FLORIDA DEPARTMENT OF TRANSPORTATION			UTILITY CONTACT PLAN (3)	SHEET NO.
DATE	DESCRIPTION	DATE	DESCRIPTION	ROAD NO.	COUNTY	FINANCIAL PROJECT ID		
				SR 5	INDIAN RIVER	441693-1-22-02		3

WILLIAM EVANS  
 LICENSE NUMBER: 45207  
 WGI, INC.  
 2035 VISTA PARKWAY  
 WEST PALM BEACH, FL 33411





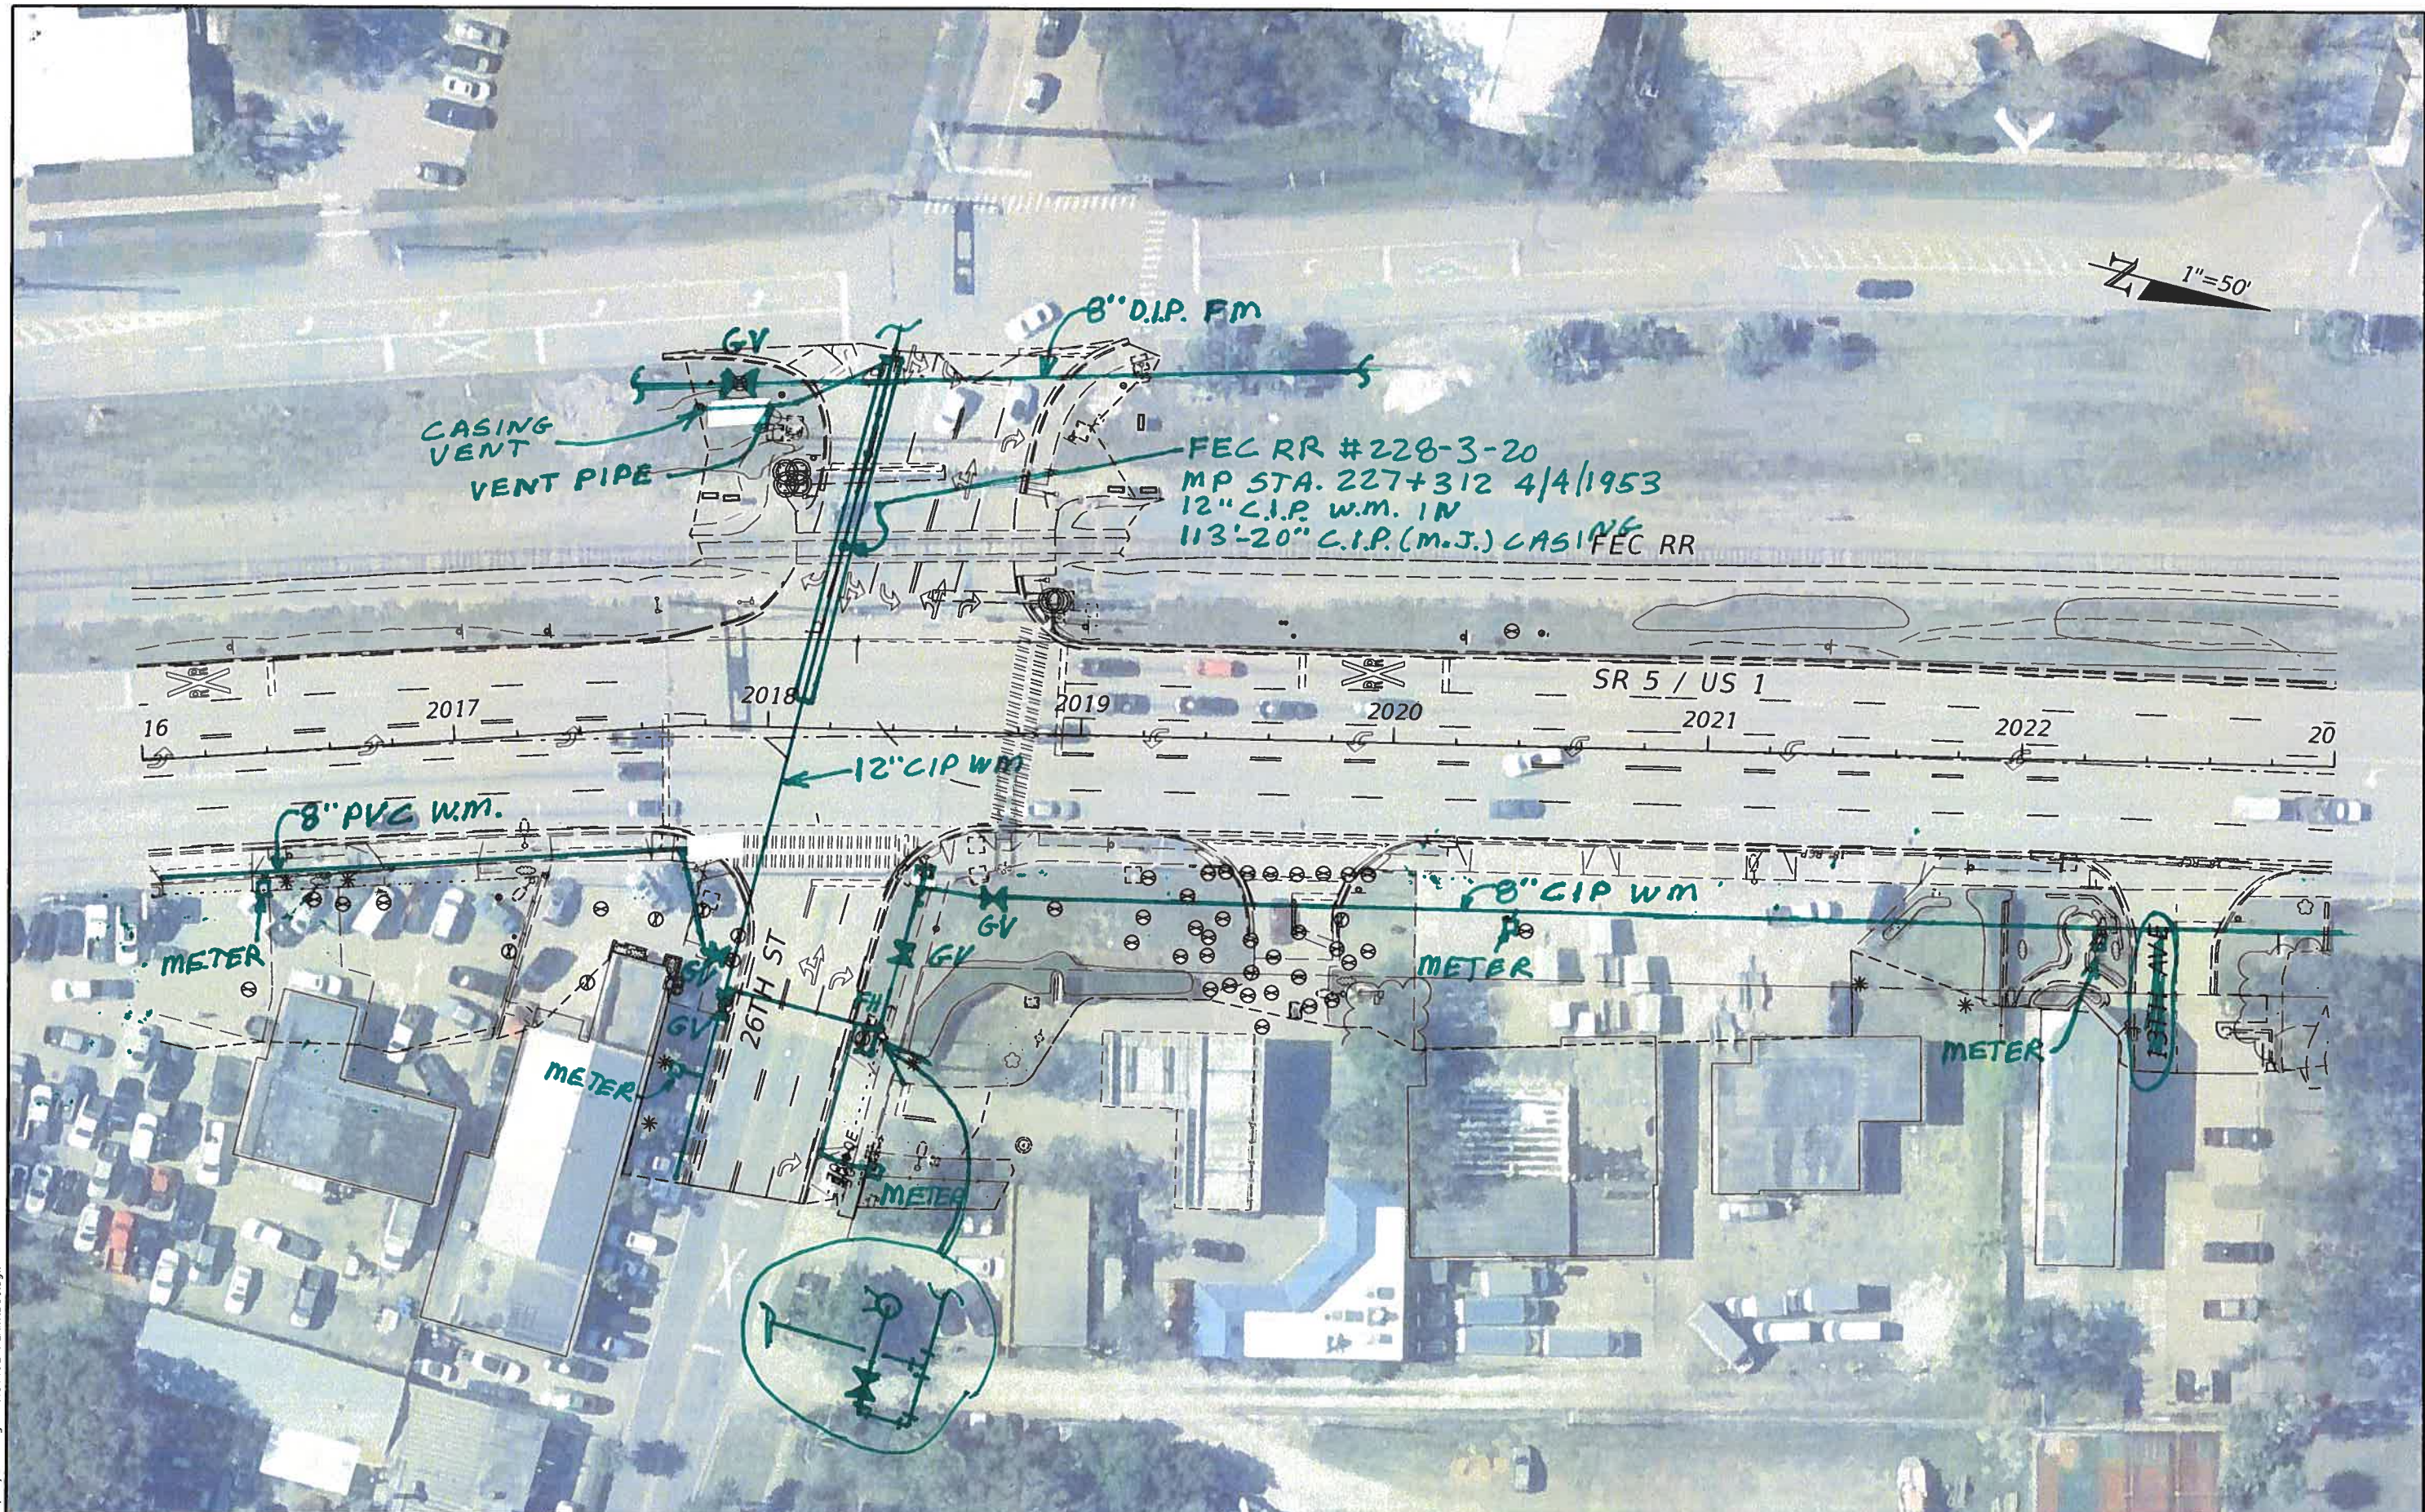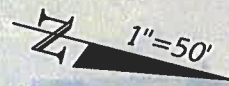

9/15/2022 11:00:42 AM Jacquelyn.Arrcaga c:\pwworking\wg\jacquelyn.arreaga\d2198192\PLMRD01.dgn

THE OFFICIAL RECORD OF THIS SHEET IS THE ELECTRONIC FILE DIGITALLY SIGNED AND SEALED UNDER RULE 61G15-23.004, F.A.C.

REVISIONS		PROFESSIONAL TYPE		STATE OF FLORIDA DEPARTMENT OF TRANSPORTATION			SHEET NO.
DATE	DESCRIPTION	DATE	DESCRIPTION	ROAD NO.	COUNTY	FINANCIAL PROJECT ID	
				SR 5	INDIAN RIVER	441693-1-22-02	4
				<b>UTILITY CONTACT PLAN (4)</b>			

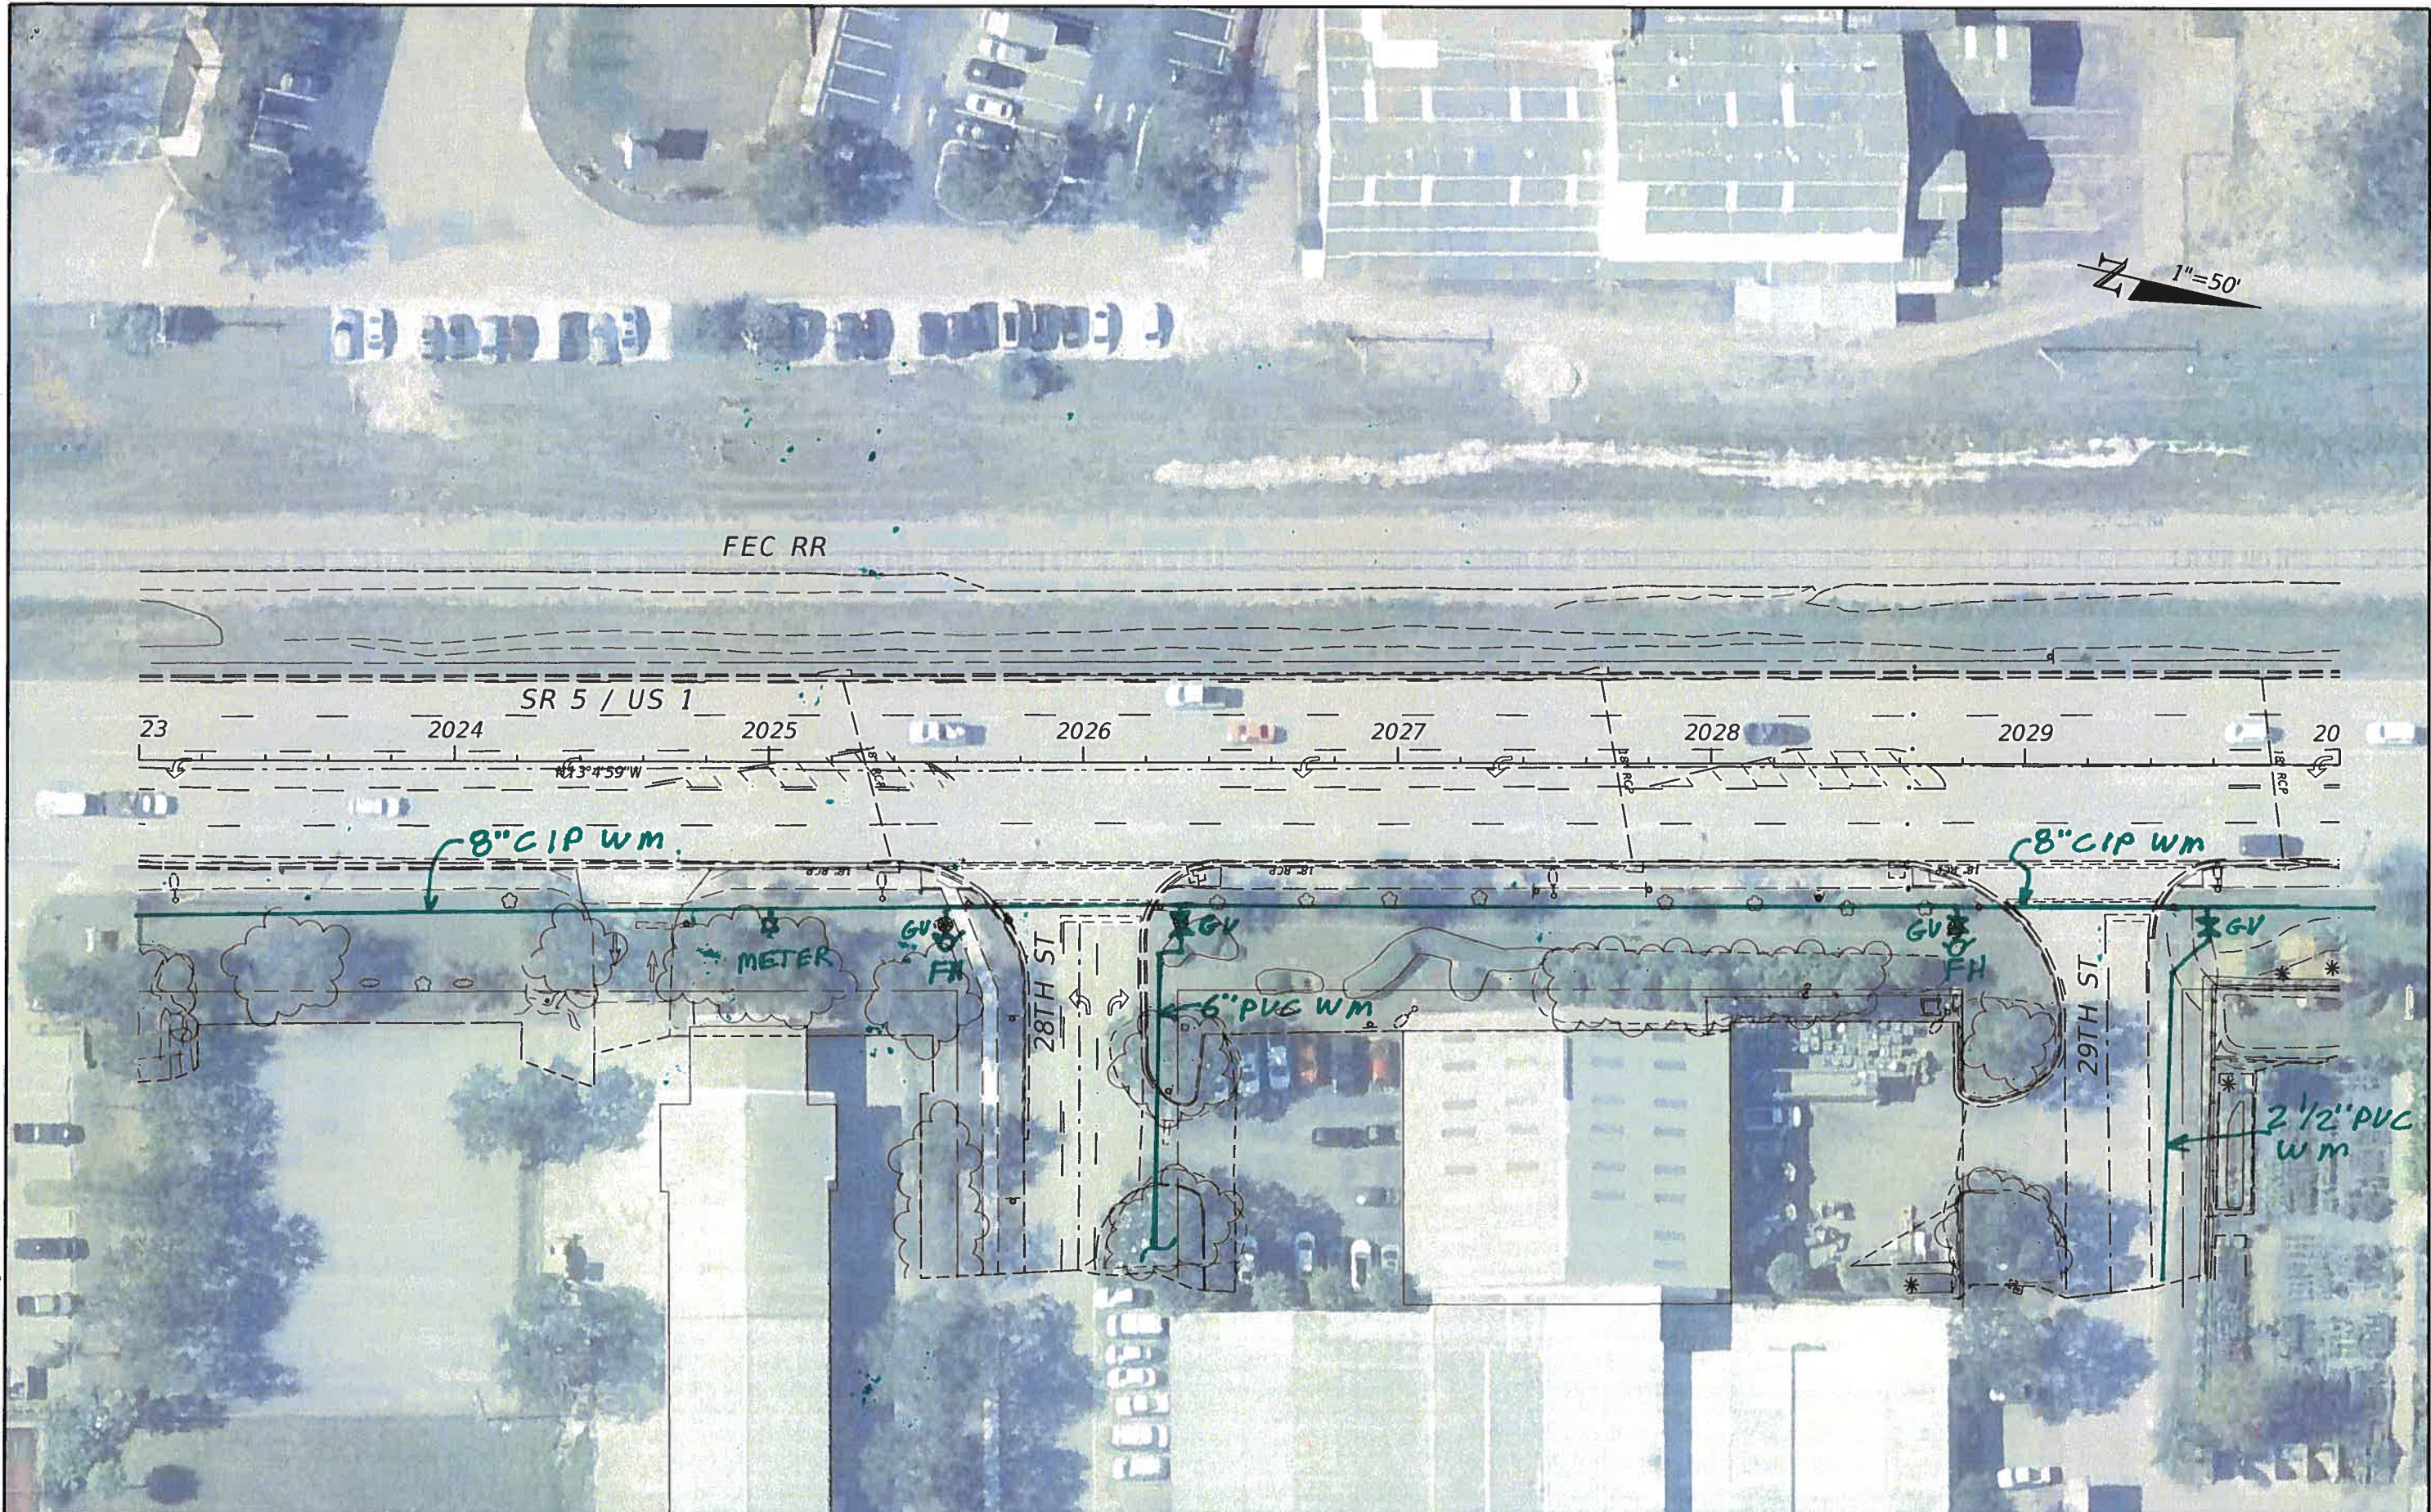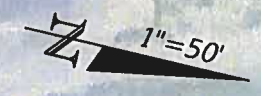


9/15/2022 11:00:51 AM Jacquelyn.Arrcaga  
 C:\pwworking\wgi\jacquelyn.rrcaga\2198192\PLANR001.dgn

REVISIONS		PROFESSIONAL TYPE		STATE OF FLORIDA DEPARTMENT OF TRANSPORTATION			SHEET NO.
DATE	DESCRIPTION	DATE	DESCRIPTION	ROAD NO.	COUNTY	FINANCIAL PROJECT ID	
				SR 5	INDIAN RIVER	441693-1-22-02	5

**UTILITY CONTACT PLAN (5)**

THE OFFICIAL RECORD OF THIS SHEET IS THE ELECTRONIC FILE DIGITALLY SIGNED AND SEALED UNDER RULE 61G15-23.004, F.A.C.

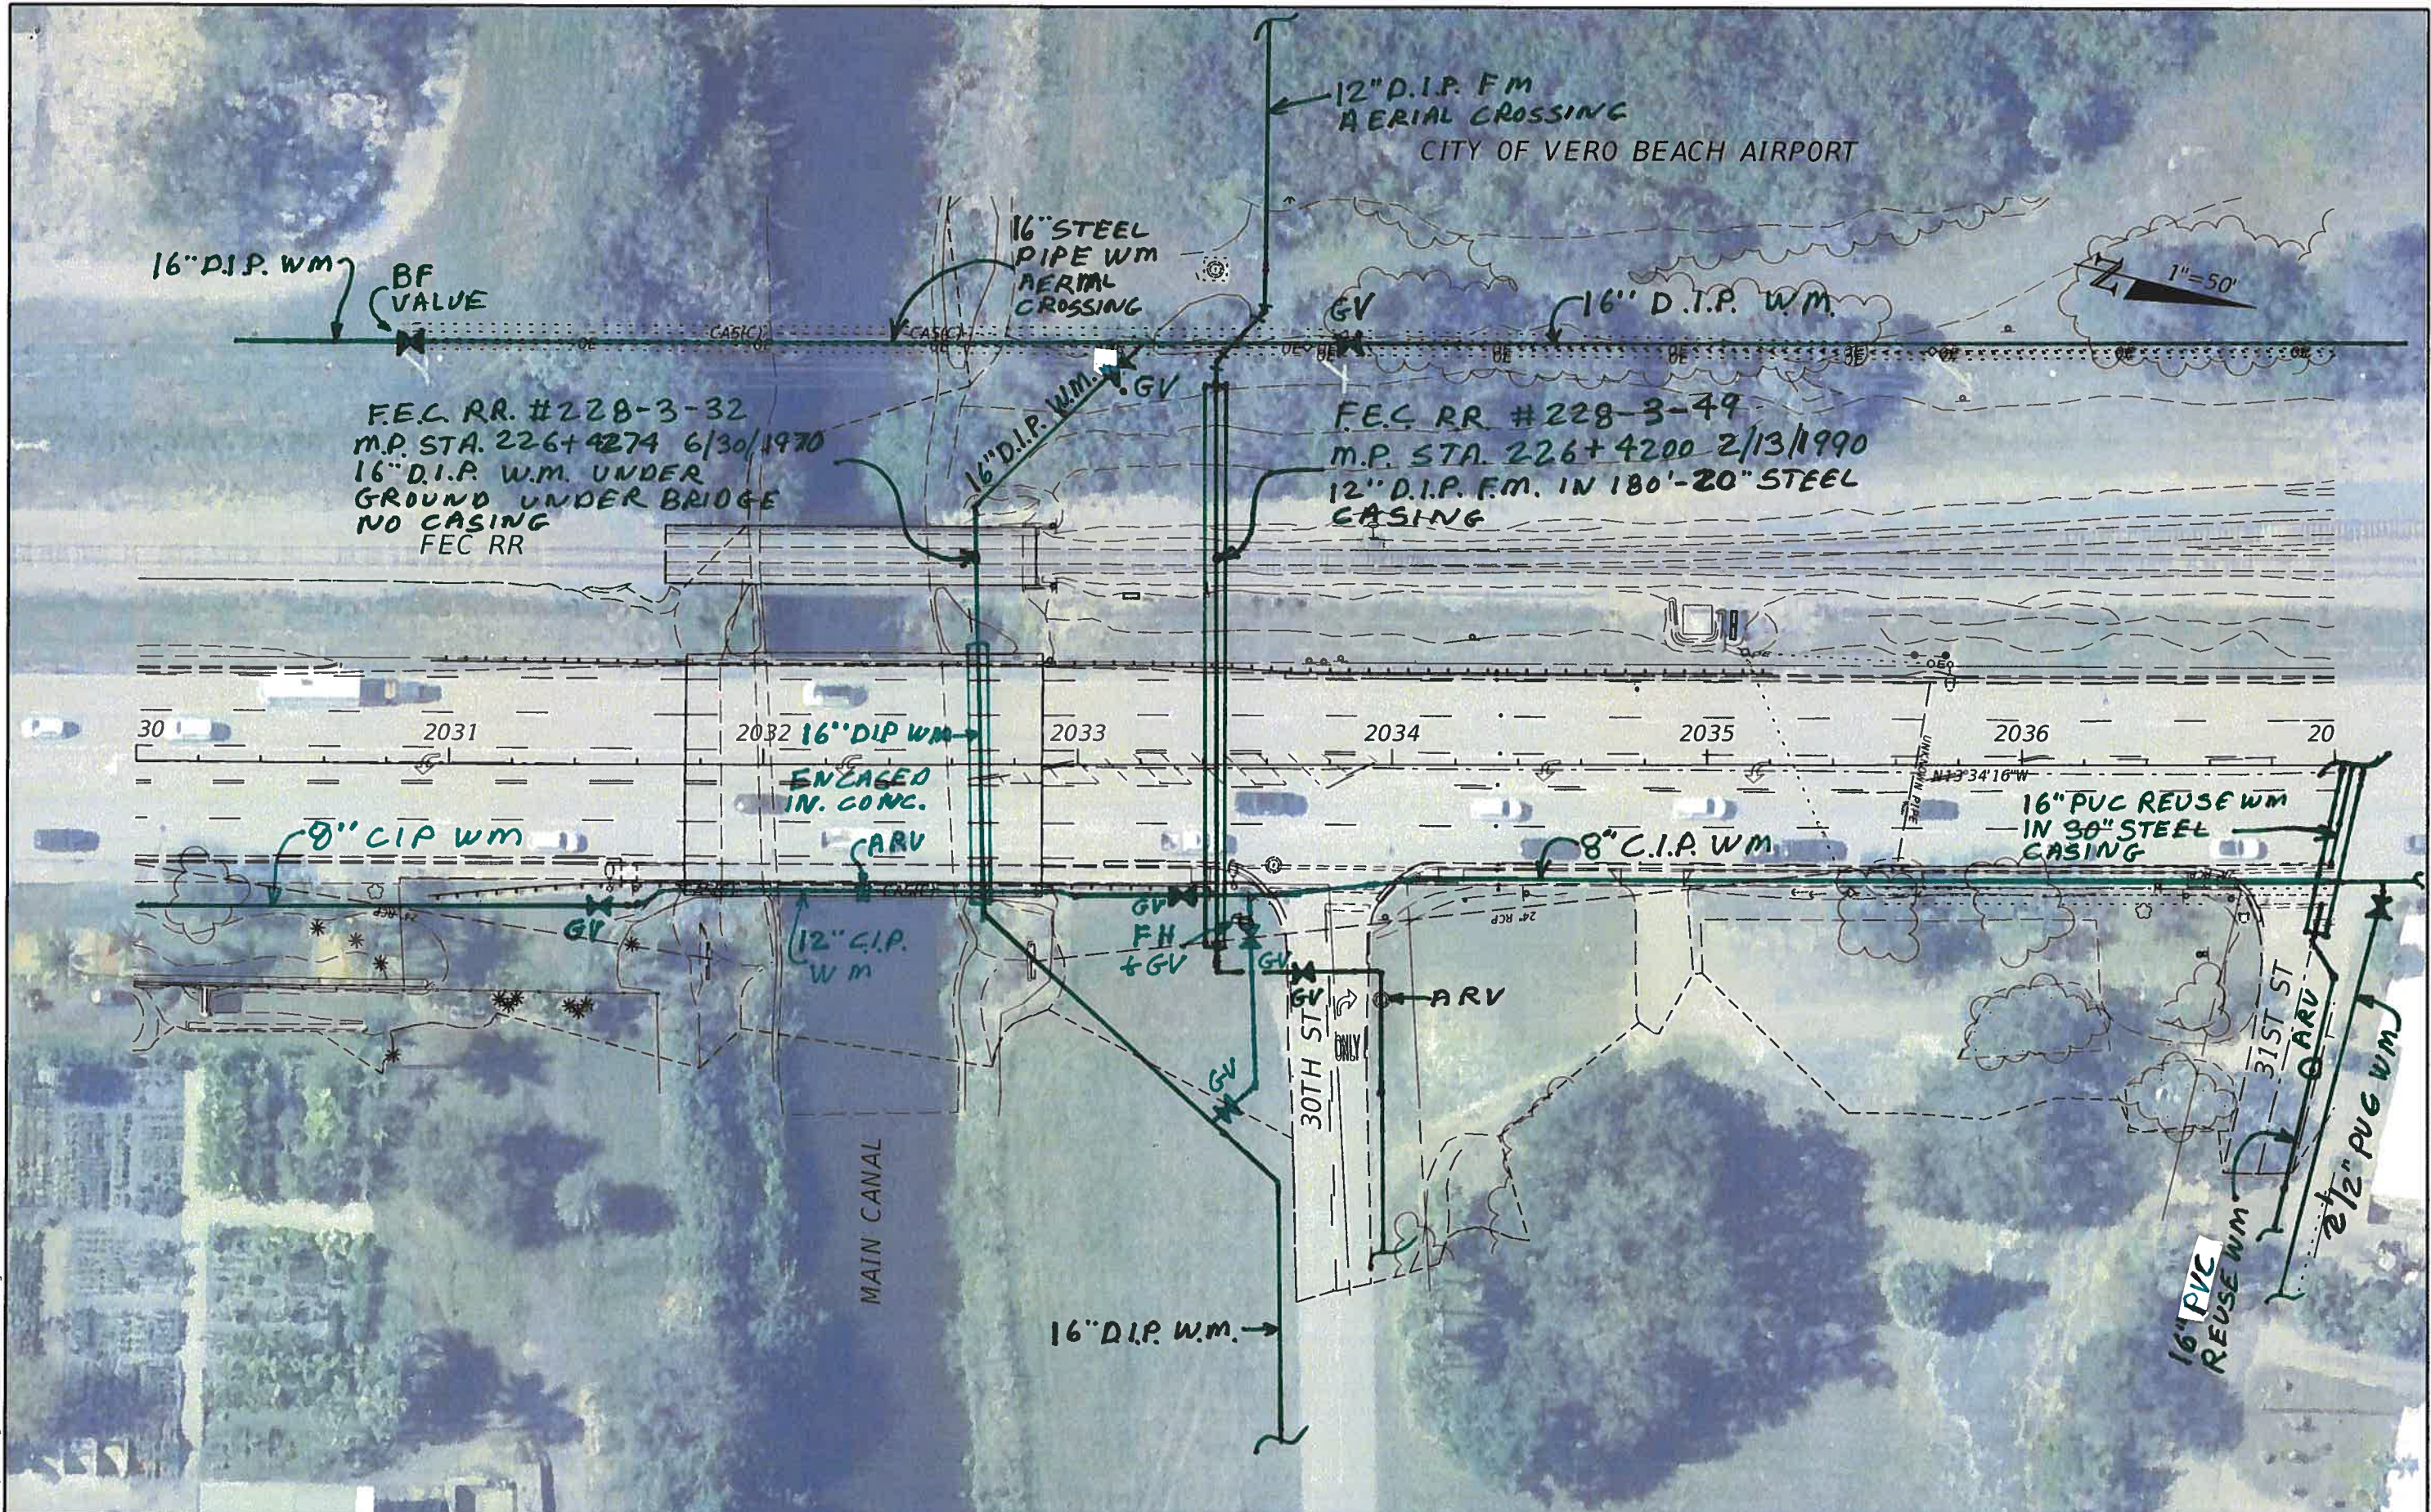


9/15/2022 11:01:04 AM Jacquelyn.Arrcaga  
 c:\pwworking\wgi\jacquelyn.rrcaga\d2198192\PLANR001.dgn

REVISIONS		PROFESSIONAL TYPE		STATE OF FLORIDA DEPARTMENT OF TRANSPORTATION			SHEET NO.
DATE	DESCRIPTION	DATE	DESCRIPTION	ROAD NO.	COUNTY	FINANCIAL PROJECT ID	
				SR 5	INDIAN RIVER	441693-1-22-02	6

**UTILITY CONTACT PLAN (6)**

THE OFFICIAL RECORD OF THIS SHEET IS THE ELECTRONIC FILE DIGITALLY SIGNED AND SEALED UNDER RULE 61G15-23.004, F.A.C.

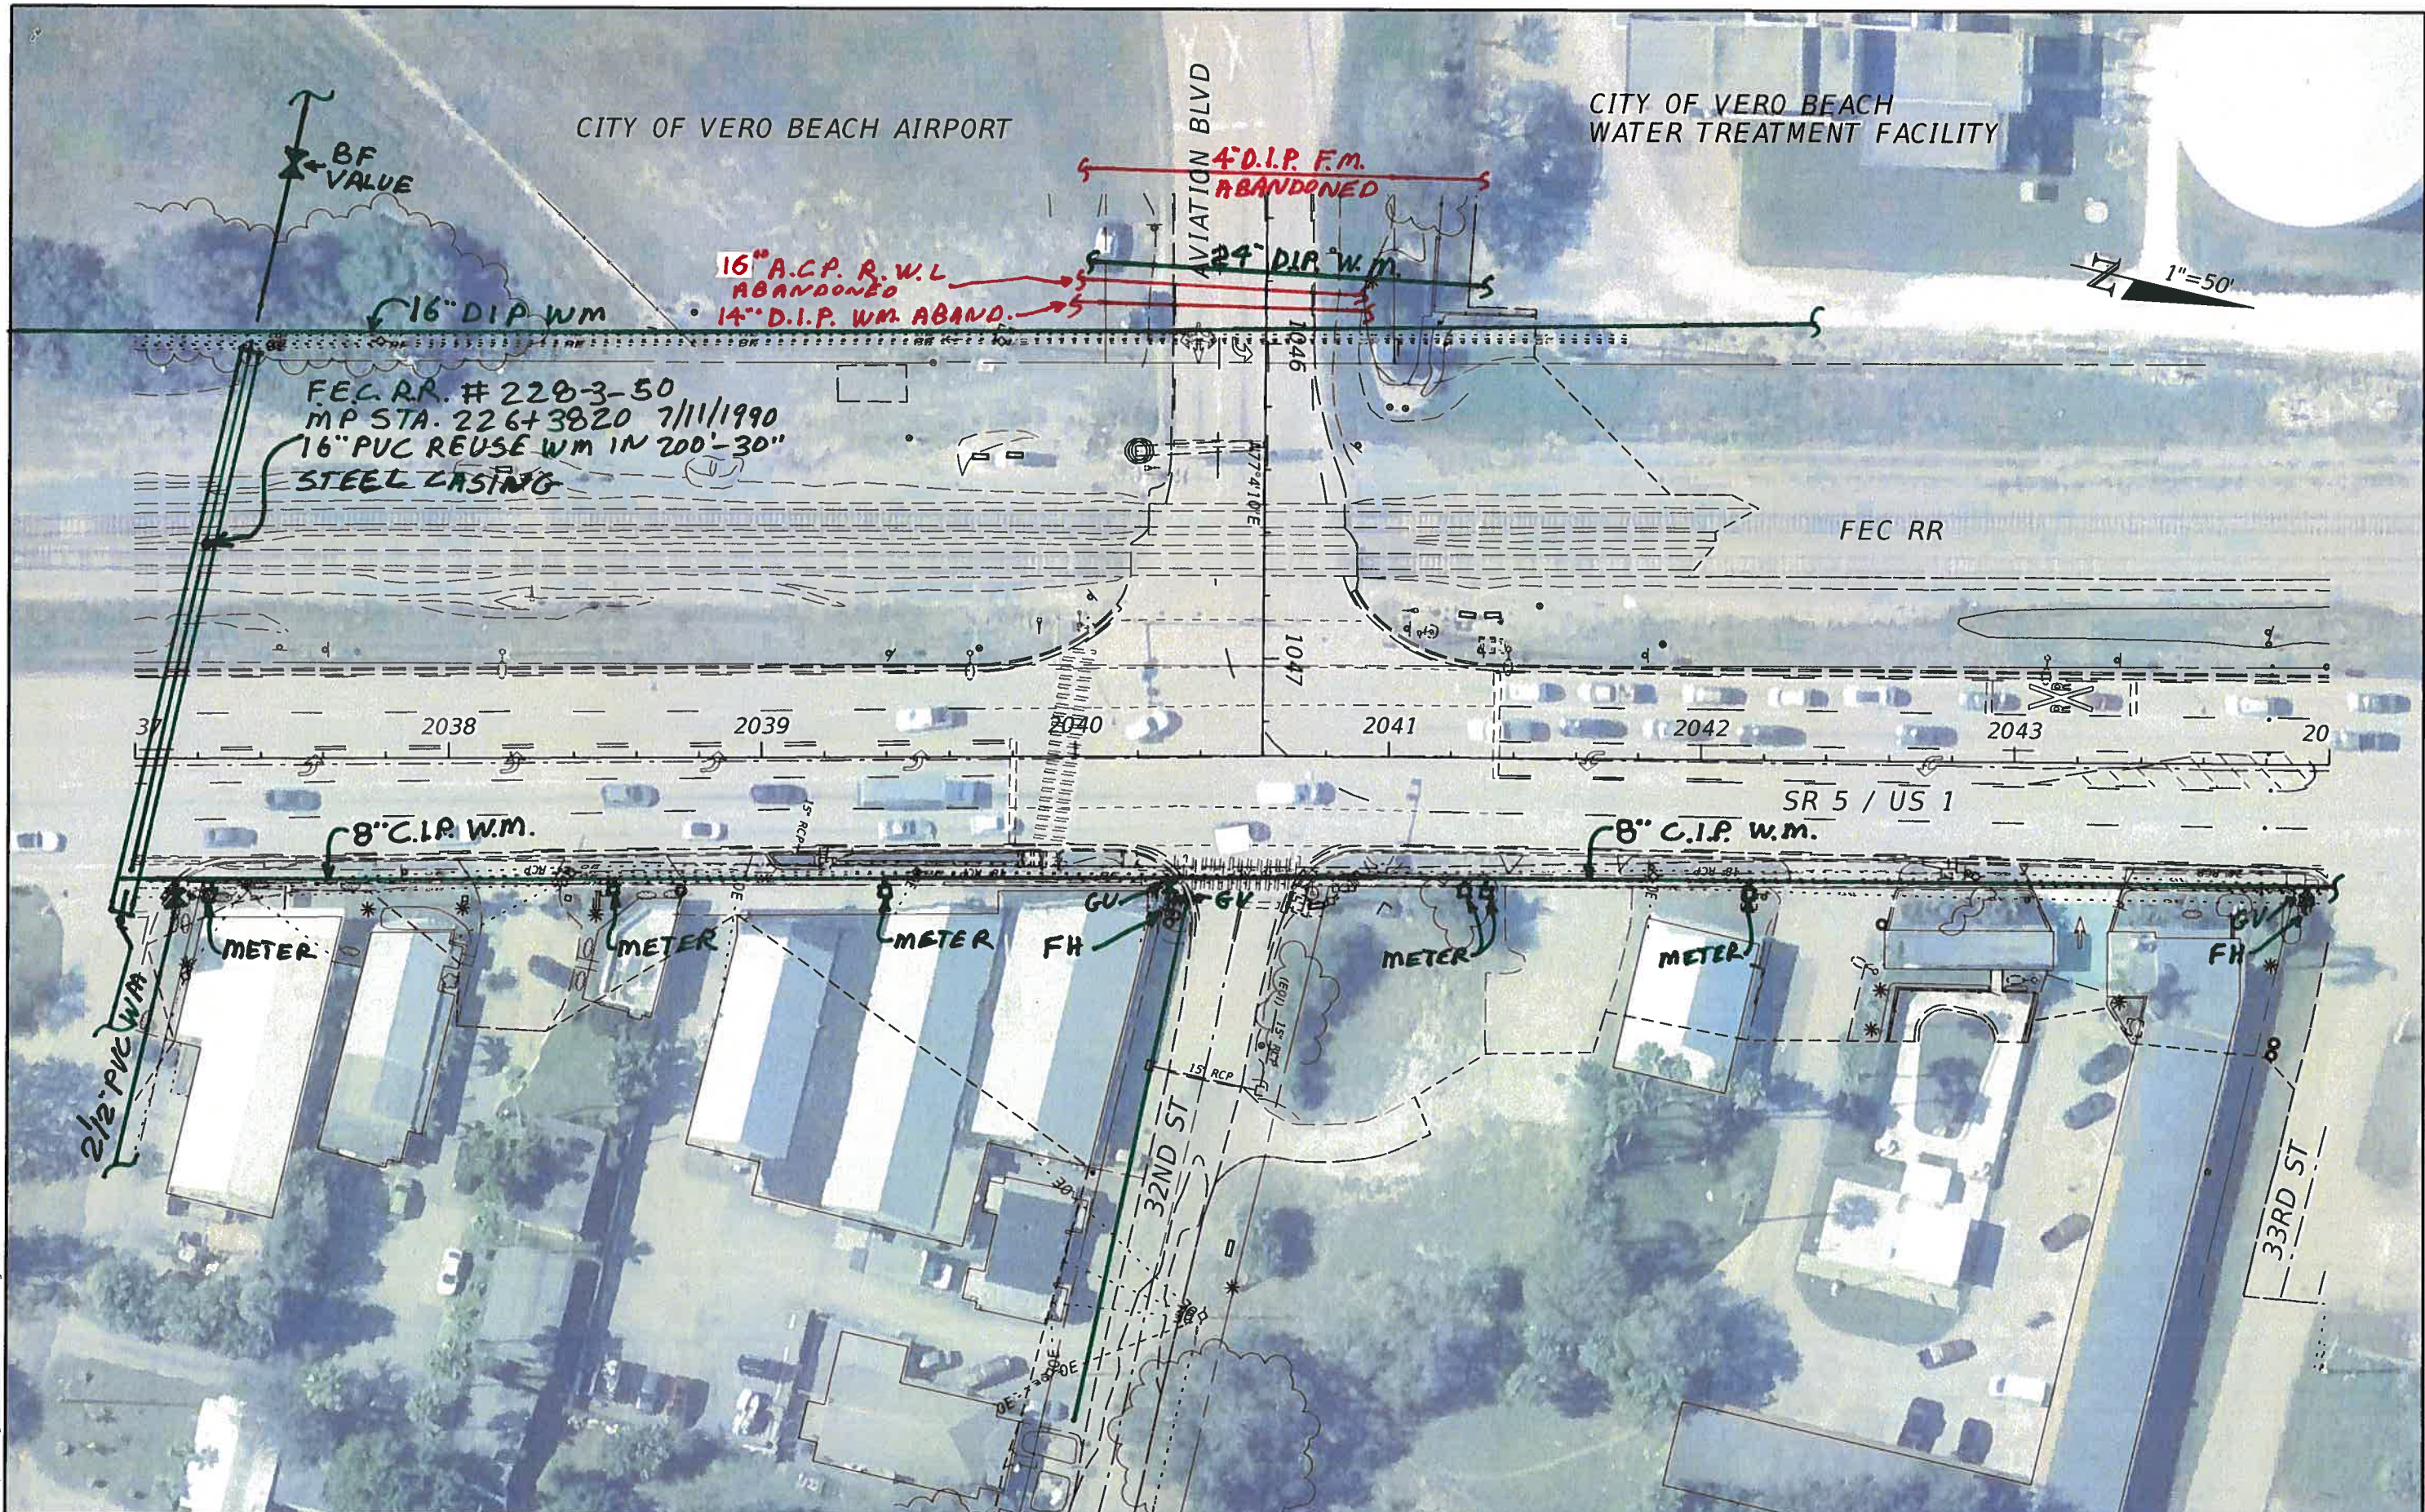

9/15/2022 11:01:42 AM jacquelyn.arreaga  
 c:\pwworking\wgi\jacquelyn.arreaga\d2198192\PLANRD01.dgn

THE OFFICIAL RECORD OF THIS SHEET IS THE ELECTRONIC FILE DIGITALLY SIGNED AND SEALED UNDER RULE 61G15-23.004, F.A.C.

REVISIONS		PROFESSIONAL TYPE		STATE OF FLORIDA DEPARTMENT OF TRANSPORTATION			SHEET NO.  7
DATE	DESCRIPTION	DATE	DESCRIPTION	ROAD NO.	COUNTY	FINANCIAL PROJECT ID	
			WILLIAM EVANS LICENSE NUMBER: 45207 WGI, INC. 2035 VISTA PARKWAY WEST PALM BEACH, FL 33411	SR 5	INDIAN RIVER	441693-1-22-02	

**UTILITY CONTACT PLAN (7)**

CITY OF VERO BEACH AIRPORT



FEC RR. #228-3-52  
 MP. STA. 226+3100 3/28/2008  
 24" PVC W.W.T.P. EFFLUENT TRANSMISSION MAIN  
 IN 240'-42" STEEL CASING

FEC RR

44 2045 2046 2047 2048 2049 2050 20

N12°57'40"W

SR 5 / US 1

8" C.I.P. W.M.

METER

CASING VENT LINE

CASING VENT

ARV ON  
 CONE P.P.

33RD ST

24" PVC E.T.M.  
 6" PVC W.M.

9/15/2022 11:02:24 AM Jacquelyn.Arrcaga  
 c:\pwworking\wgi\jacquelyn.rrcaga\d2198192\PLANR001.dgn

THE OFFICIAL RECORD OF THIS SHEET IS THE ELECTRONIC FILE DIGITALLY SIGNED AND SEALED UNDER RULE 61G15-23.004, F.A.C.

REVISIONS		PROFESSIONAL TYPE		STATE OF FLORIDA DEPARTMENT OF TRANSPORTATION			SHEET NO.
DATE	DESCRIPTION	DATE	DESCRIPTION	ROAD NO.	COUNTY	FINANCIAL PROJECT ID	
			WILLIAM EVANS LICENSE NUMBER: 45207 WGI, INC. 2035 VISTA PARKWAY WEST PALM BEACH, FL 33411	SR 5	INDIAN RIVER	441693-1-22-02	8

UTILITY CONTACT PLAN (8)

CITY OF VERO BEACH AIRPORT



FEC RR

51 2052 2053 2054 2055 2056 2057 20


SR 5 / US 1

8" CIP W.M.

8" CIP W.M. ABANDONED & GROUTED. OUT OF SERVICE

METER 6" FIRE SERVICE

8" PVC W.M. IN 8' UTILITY EASEMENT

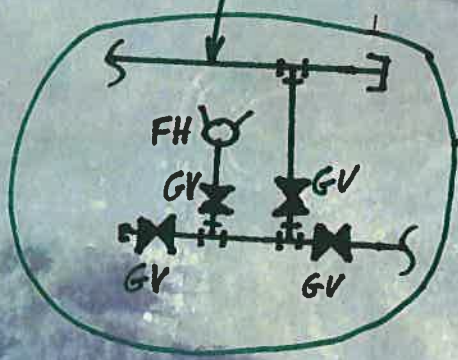

9/15/2022 11:02:50 AM jacquelyn.arreaga c:\pwworking\wgi\jacquelyn.arreaga\d2198192\PLANR001.dgn

REVISIONS		PROFESSIONAL TYPE		STATE OF FLORIDA DEPARTMENT OF TRANSPORTATION			SHEET NO.
DATE	DESCRIPTION	DATE	DESCRIPTION	ROAD NO.	COUNTY	FINANCIAL PROJECT ID	
				SR 5	INDIAN RIVER	441693-1-22-02	9

UTILITY CONTACT PLAN (9)

THE OFFICIAL RECORD OF THIS SHEET IS THE ELECTRONIC FILE DIGITALLY SIGNED AND SEALED UNDER RULE 61G15-23.004, F.A.C.

CITY OF VERO BEACH AIRPORT



FEC RR

58 2059 2060 2061 2062 2063 2064 20

8" C.I.P. W.M. ABANDONED & GROUTED. OUT OF SERVICE

SR 5 / US 1

8" C.I.P. W.M.

8" PVC W.M. IN 8' UTILITY EASEMENT

4" FIRE SERVICE METER

PICKERILL LN

GV

9/15/2022 11:03:08 AM Jacquelyn.Arrcaga C:\pwworking\wgijacquelyn\arrega\2198192\PLANR001.dgn

REVISIONS		PROFESSIONAL TYPE		STATE OF FLORIDA DEPARTMENT OF TRANSPORTATION			SHEET NO.
DATE	DESCRIPTION	DATE	DESCRIPTION	ROAD NO.	COUNTY	FINANCIAL PROJECT ID	
				SR 5	INDIAN RIVER	441693-1-22-02	10

WILLIAM EVANS  
 LICENSE NUMBER: 45207  
 WGI, INC.  
 2035 VISTA PARKWAY  
 WEST PALM BEACH, FL 33411

UTILITY CONTACT PLAN (10)

THE OFFICIAL RECORD OF THIS SHEET IS THE ELECTRONIC FILE DIGITALLY SIGNED AND SEALED UNDER RULE 61G15-23.004, F.A.C.

CITY OF VERO BEACH AIRPORT



16" D.I.P. W.M.

F.E.C. RR. # 228-3-36  
 M.P. STA. 226+0852 4/2/1975  
 16" D.I.P. W.M. IN 166'-30"  
 STEEL CASING

FEC RR

65 2066 2067 2068 2069 2070 2071 20

N21°46'7"W

8" C.I.P. W.M.

FH + GV

SR 5 / US 1

8" C.I.P. W.M.

METER METER

METER

36TH ST

16" D.I.P. W.M.


9/15/2022 11:03:42 AM Jacquelyn.Arrcaga  
 c:\pwworking\wgi\jacquelyn.arrcaga\d2198192\PLANR001.dgn

REVISIONS		PROFESSIONAL TYPE		STATE OF FLORIDA DEPARTMENT OF TRANSPORTATION			UTILITY CONTACT PLAN (11)	SHEET NO.  11
DATE	DESCRIPTION	DATE	DESCRIPTION	ROAD NO.	COUNTY	FINANCIAL PROJECT ID		
				SR 5	INDIAN RIVER	441693-1-22-02		

THE OFFICIAL RECORD OF THIS SHEET IS THE ELECTRONIC FILE DIGITALLY SIGNED AND SEALED UNDER RULE 61G15-23.004, F.A.C.



CITY OF VERO BEACH AIRPORT

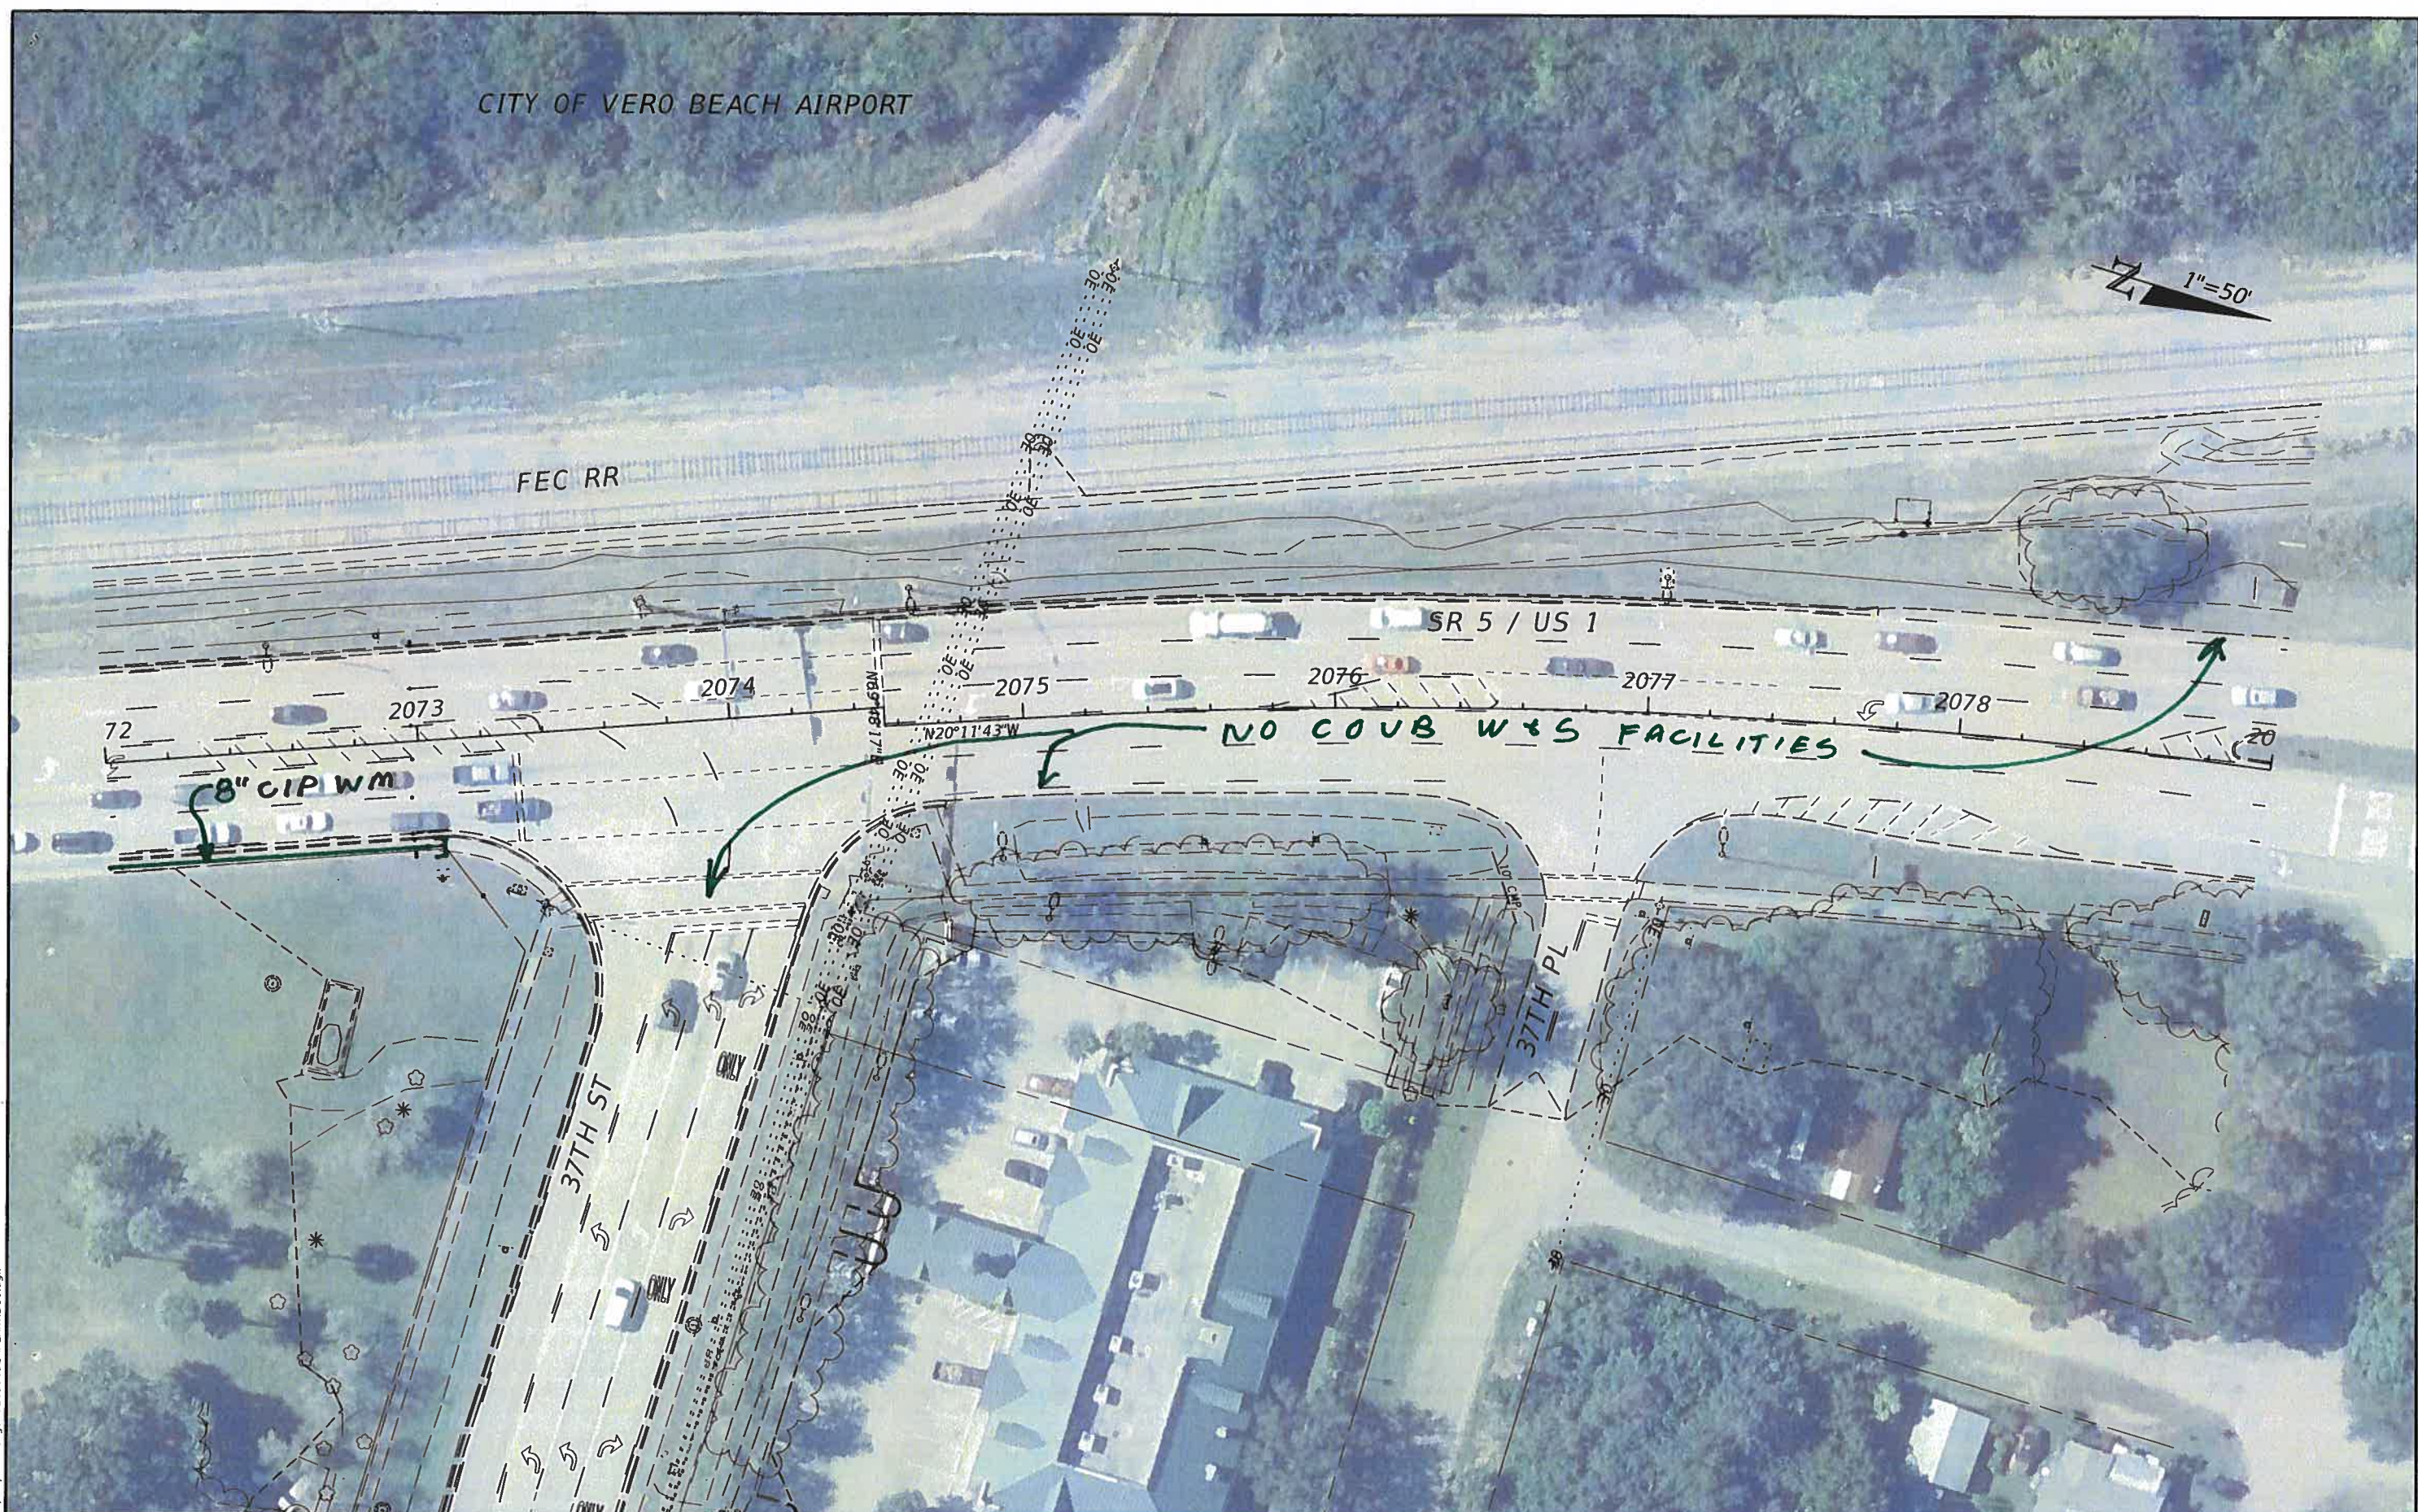


9/15/2022 11:04:09 AM jacquelyn.arreaga c:\pwworking\wg\jacquelyn.arreaga\d2198192\PLANRD01.dgn

REVISIONS		PROFESSIONAL TYPE		STATE OF FLORIDA DEPARTMENT OF TRANSPORTATION			UTILITY CONTACT PLAN (12)	SHEET NO.  12
DATE	DESCRIPTION	DATE	DESCRIPTION	ROAD NO.	COUNTY	FINANCIAL PROJECT ID		
				SR 5	INDIAN RIVER	441693-1-22-02		


THE OFFICIAL RECORD OF THIS SHEET IS THE ELECTRONIC FILE DIGITALLY SIGNED AND SEALED UNDER RULE 61G15-23.004, F.A.C.

9/15/2022 11:04:36 AM Jacquelyn.Arrcaga  
 C:\pwworking\wgi\jacquelyn.rrcaga\d2198192\PLANRD01.dgn

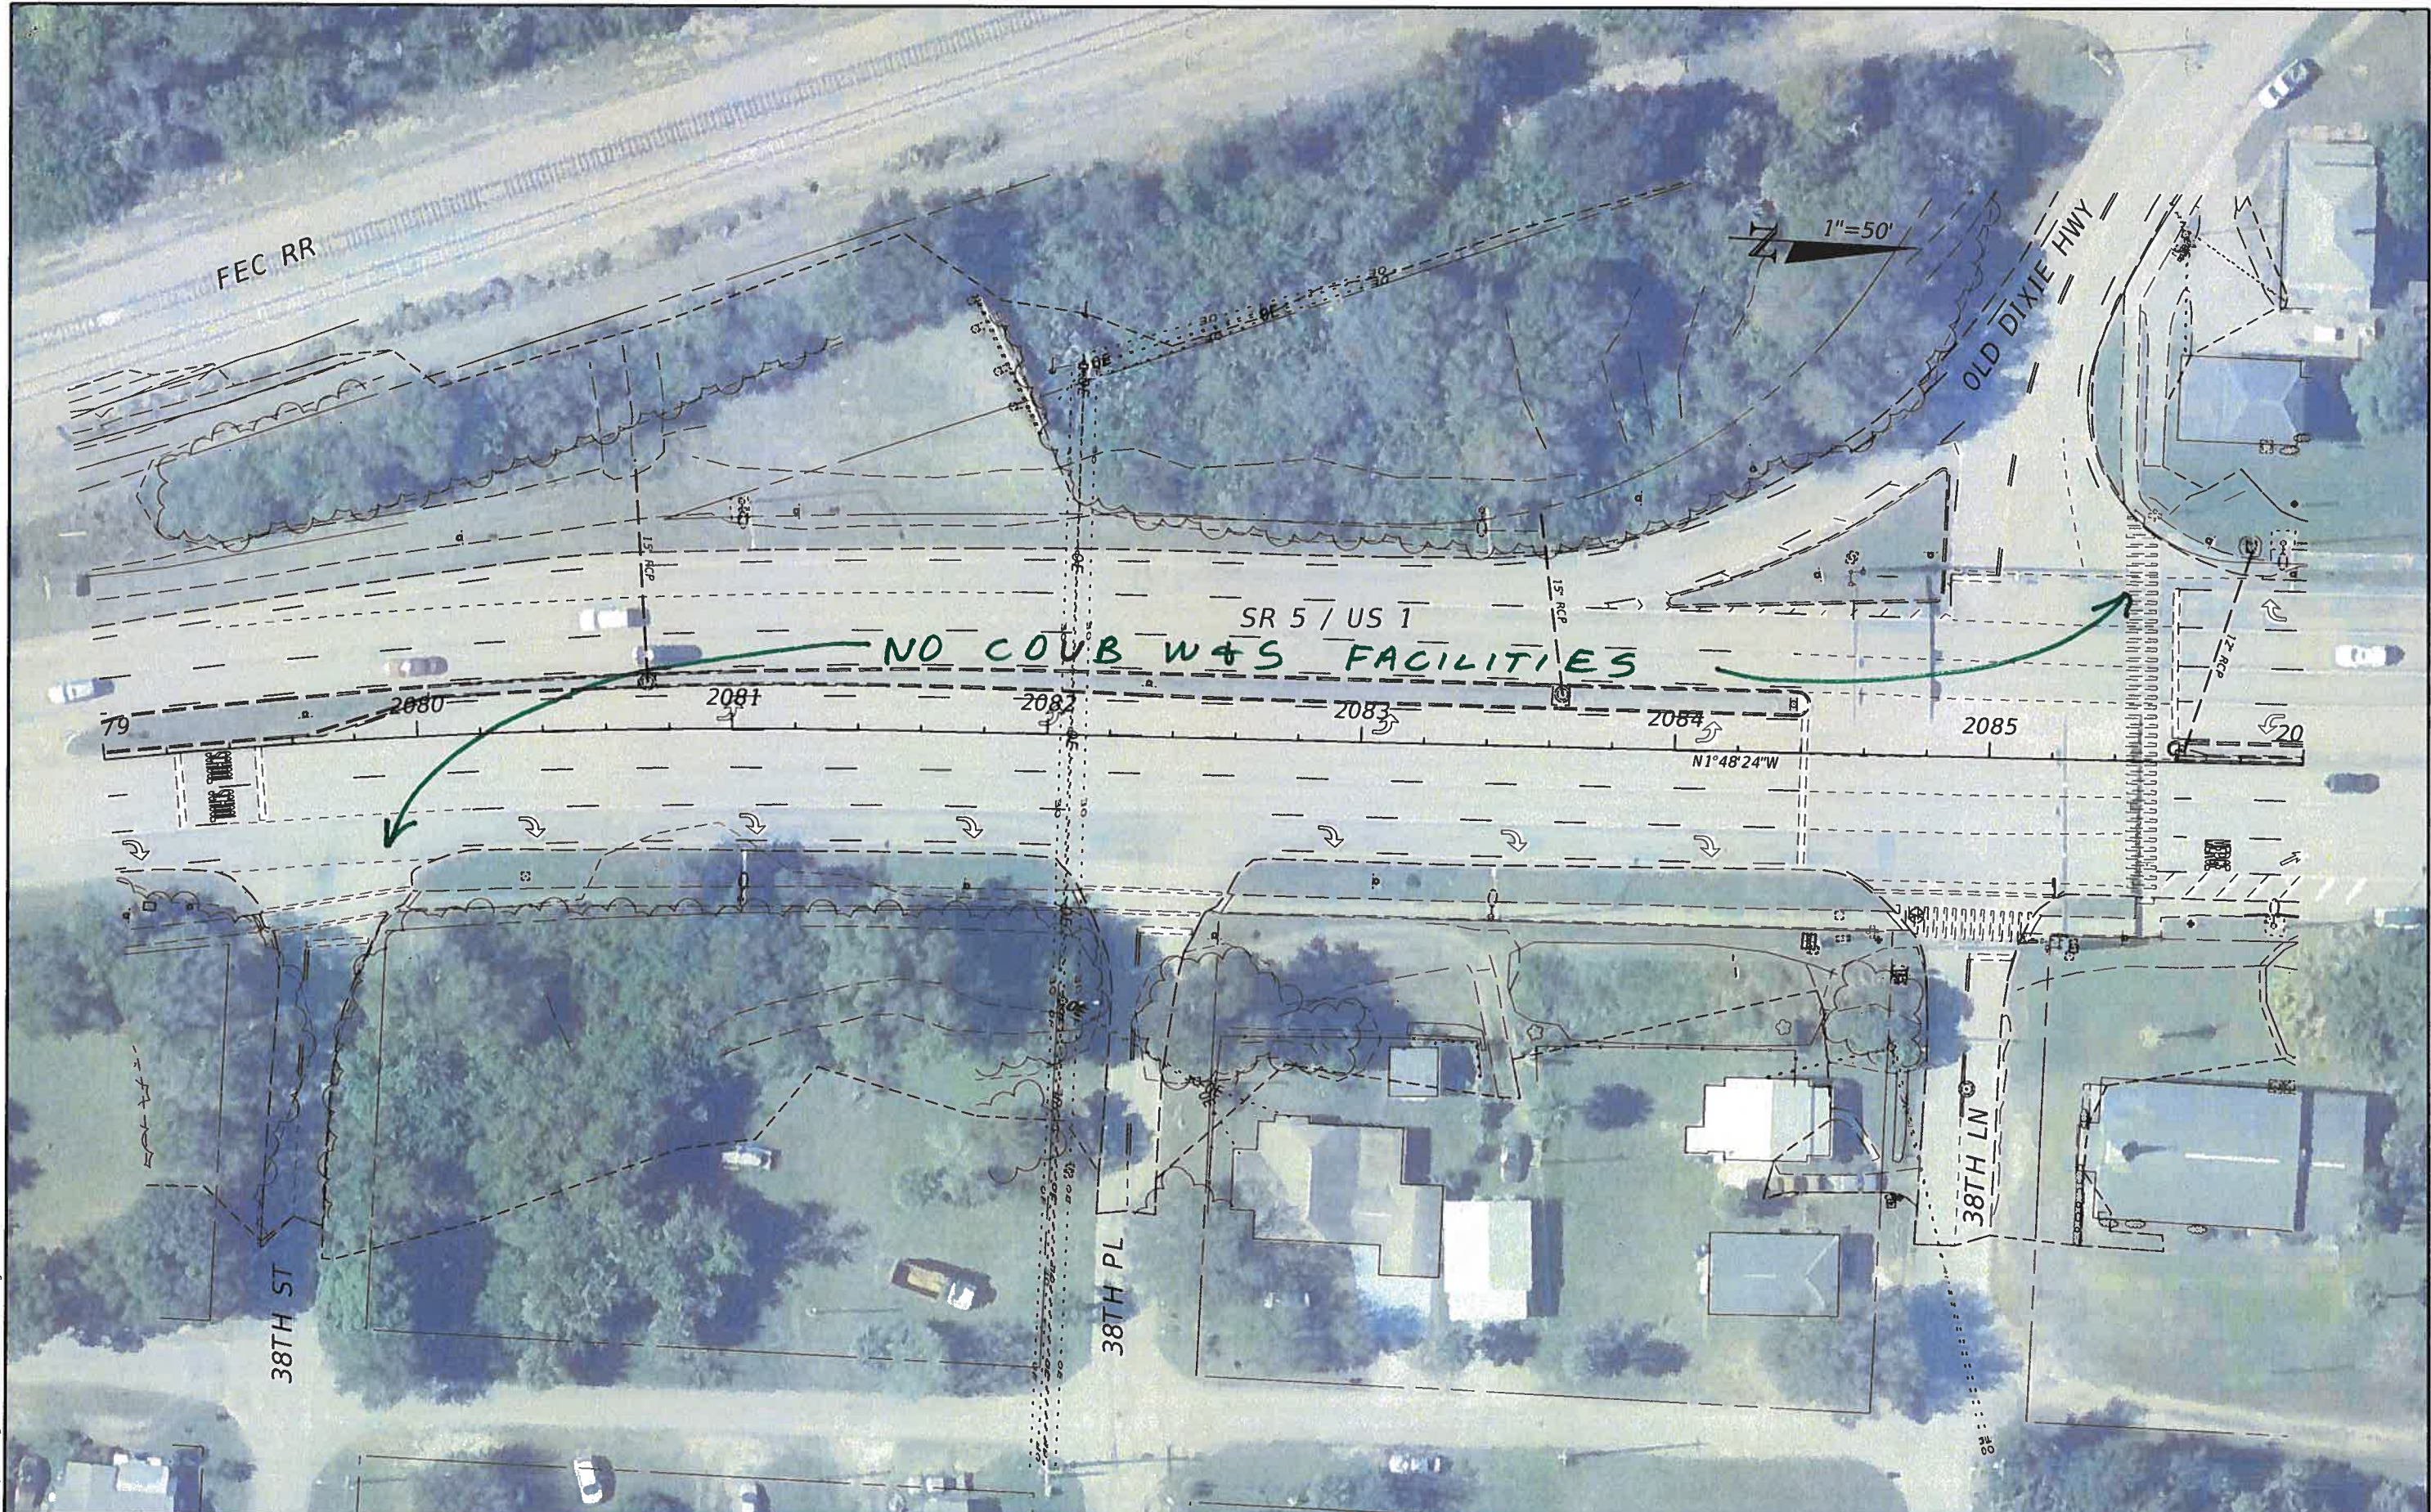

DATE		REVISIONS		PROFESSIONAL TYPE		STATE OF FLORIDA DEPARTMENT OF TRANSPORTATION			SHEET NO.
DATE	DESCRIPTION	DATE	DESCRIPTION	WILLIAM EVANS LICENSE NUMBER: 45207 WGI, INC. 2035 VISTA PARKWAY WEST PALM BEACH, FL 33411	ROAD NO.	COUNTY	FINANCIAL PROJECT ID		
					SR 5	INDIAN RIVER	441693-1-22-02	<b>UTILITY CONTACT PLAN (13)</b>	13

THE OFFICIAL RECORD OF THIS SHEET IS THE ELECTRONIC FILE DIGITALLY SIGNED AND SEALED UNDER RULE 61G15-23.004, F.A.C.

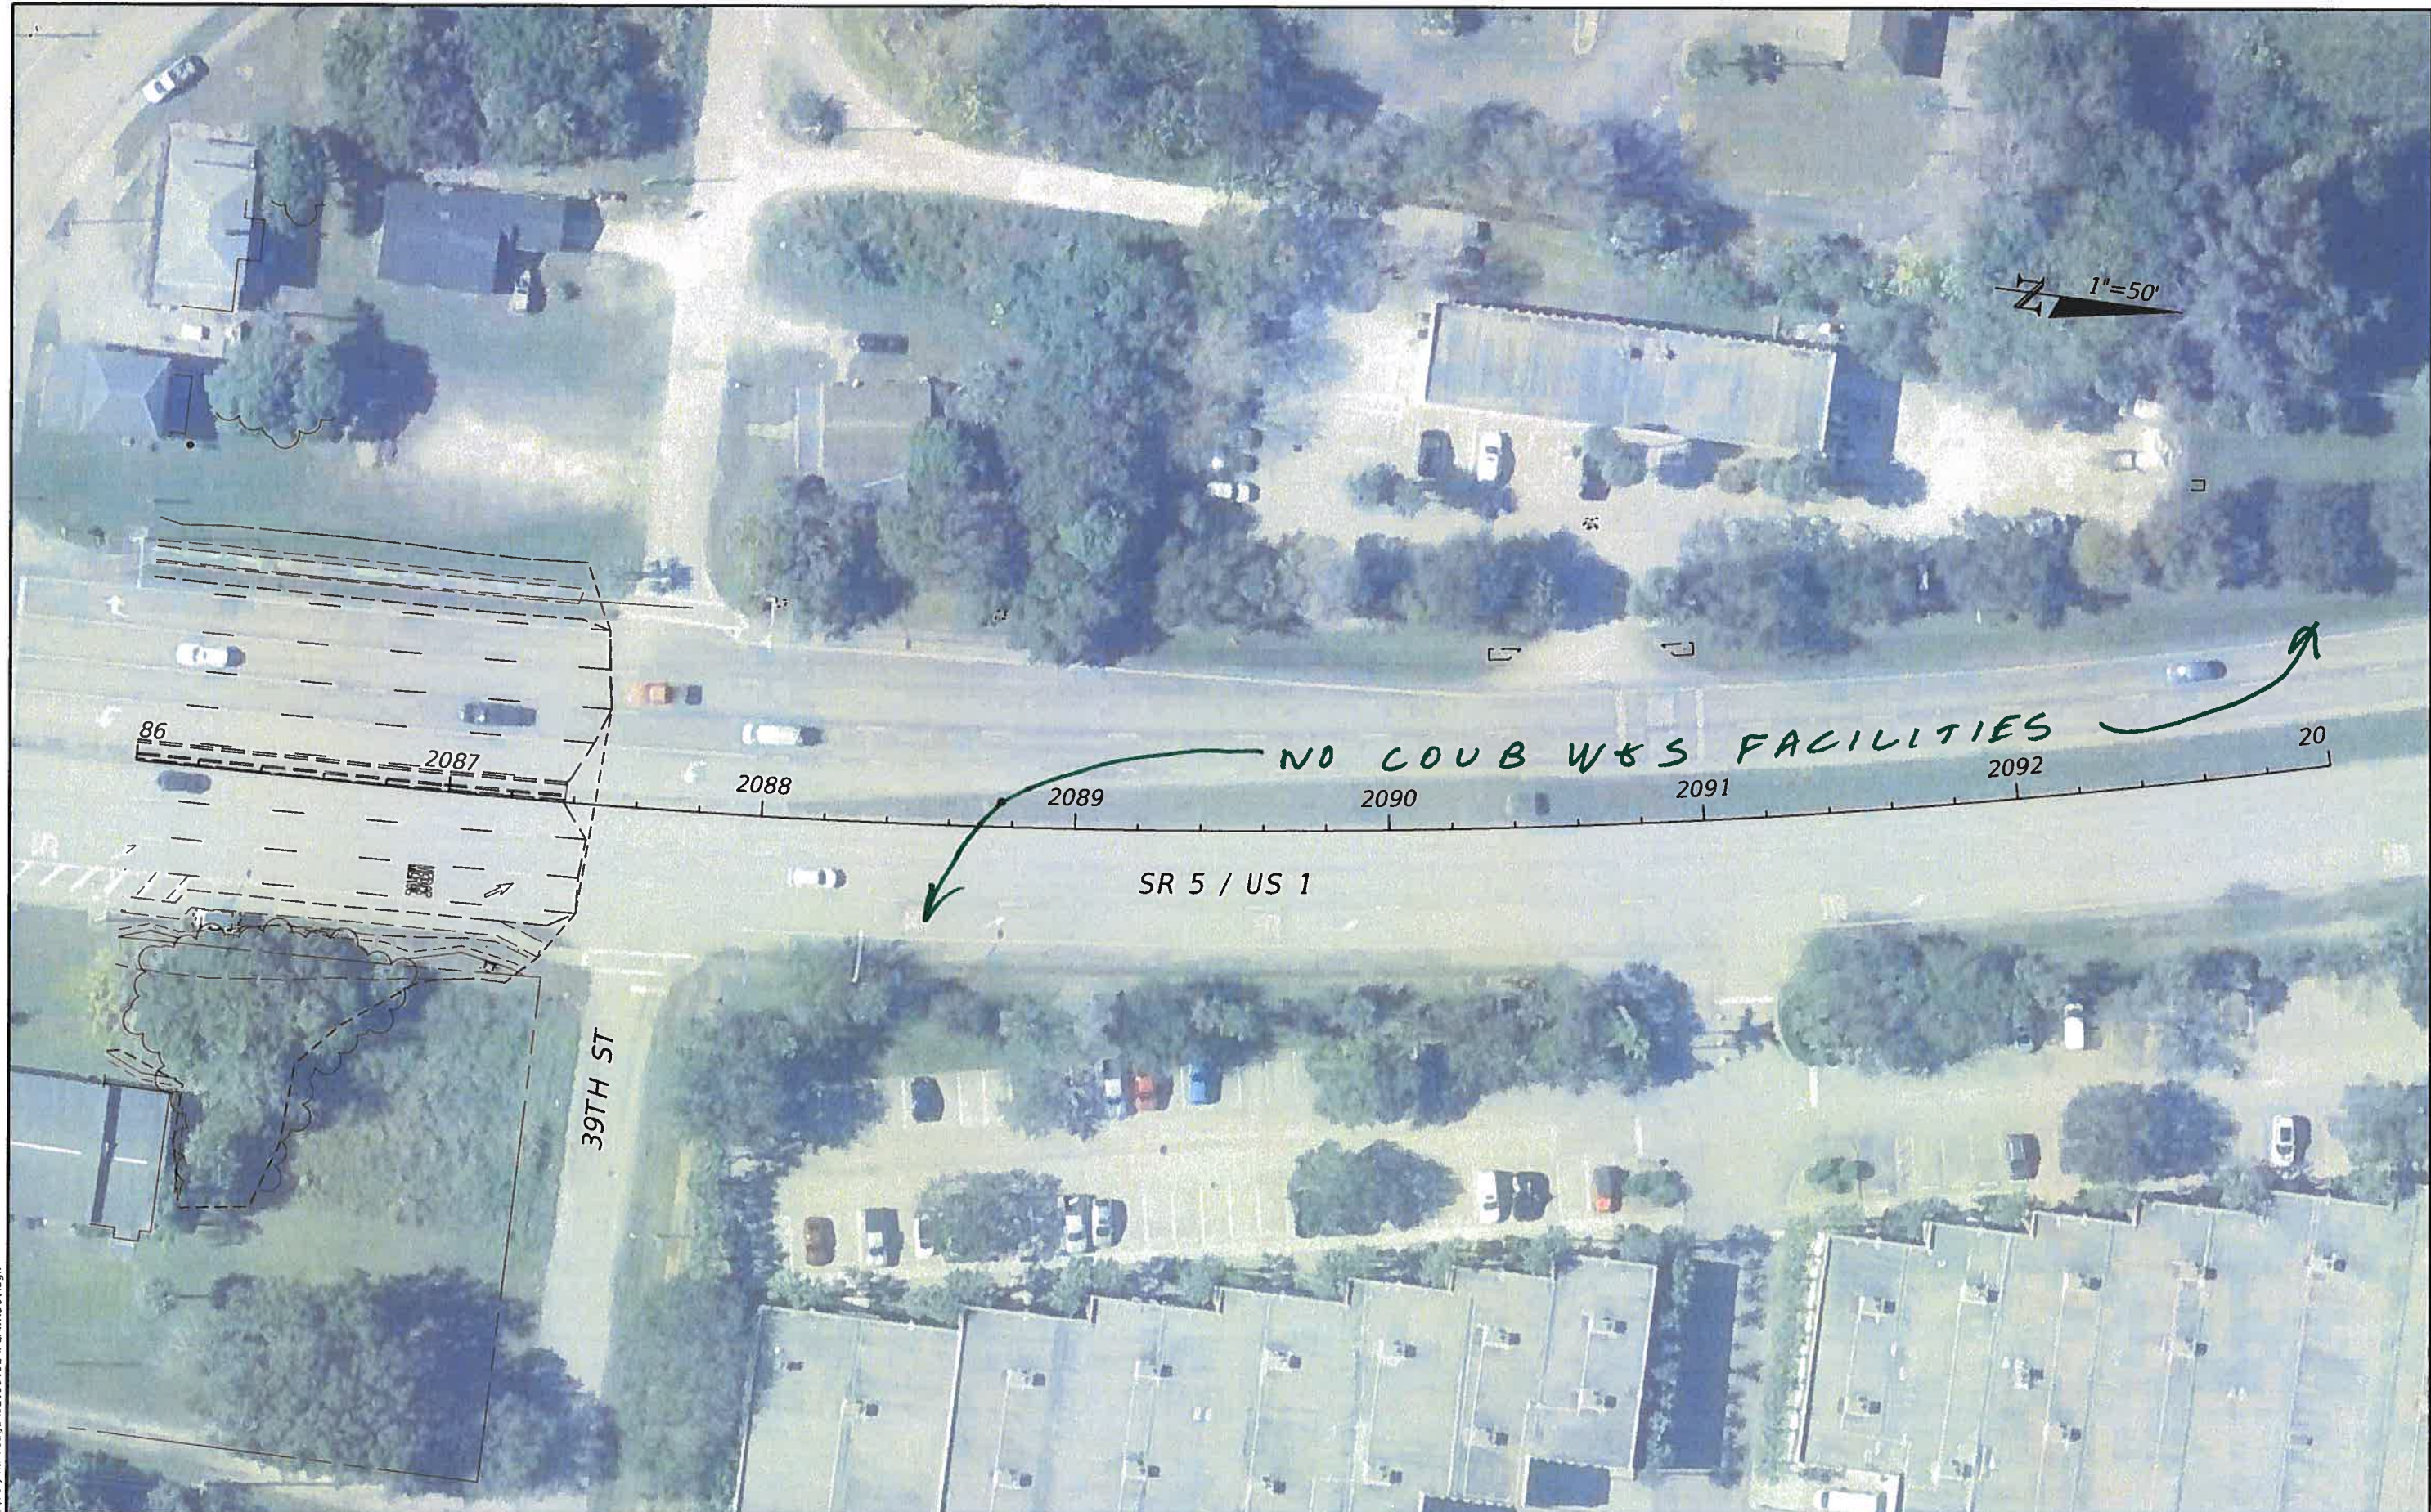

9/15/2022 11:05:04 AM Jacquelyn.Arrcaga c:\pwworking\wgi\jacquelyn.rrcaga\d2198192\PLANRD01.dgn

THE OFFICIAL RECORD OF THIS SHEET IS THE ELECTRONIC FILE DIGITALLY SIGNED AND SEALED UNDER RULE 61G15-23.004, F.A.C.

DATE		REVISIONS		PROFESSIONAL TYPE		STATE OF FLORIDA DEPARTMENT OF TRANSPORTATION			SHEET NO.
DATE	DESCRIPTION	DATE	DESCRIPTION	WILLIAM EVANS LICENSE NUMBER: 45207 WGI, INC. 2035 VISTA PARKWAY WEST PALM BEACH, FL 33411	ROAD NO.	COUNTY	FINANCIAL PROJECT ID	14	
					SR 5	INDIAN RIVER	441693-1-22-02		<b>UTILITY CONTACT PLAN (14)</b>




9/15/2022 11:05:51 AM Jacquelyn.Arcaga  
 C:\pwworking\wgi\jacquelyn.arcaaga\d2198192\PLANR001.dgn

THE OFFICIAL RECORD OF THIS SHEET IS THE ELECTRONIC FILE DIGITALLY SIGNED AND SEALED UNDER RULE 61G15-23.004, F.A.C.

REVISIONS		PROFESSIONAL TYPE		STATE OF FLORIDA DEPARTMENT OF TRANSPORTATION			UTILITY CONTACT PLAN (15)	SHEET NO.
DATE	DESCRIPTION	DATE	DESCRIPTION	ROAD NO.	COUNTY	FINANCIAL PROJECT ID		
				SR 5	INDIAN RIVER	441693-1-22-02		15

WILLIAM EVANS  
 LICENSE NUMBER: 45207  
 WGI, INC.  
 2035 VISTA PARKWAY  
 WEST PALM BEACH, FL 33411

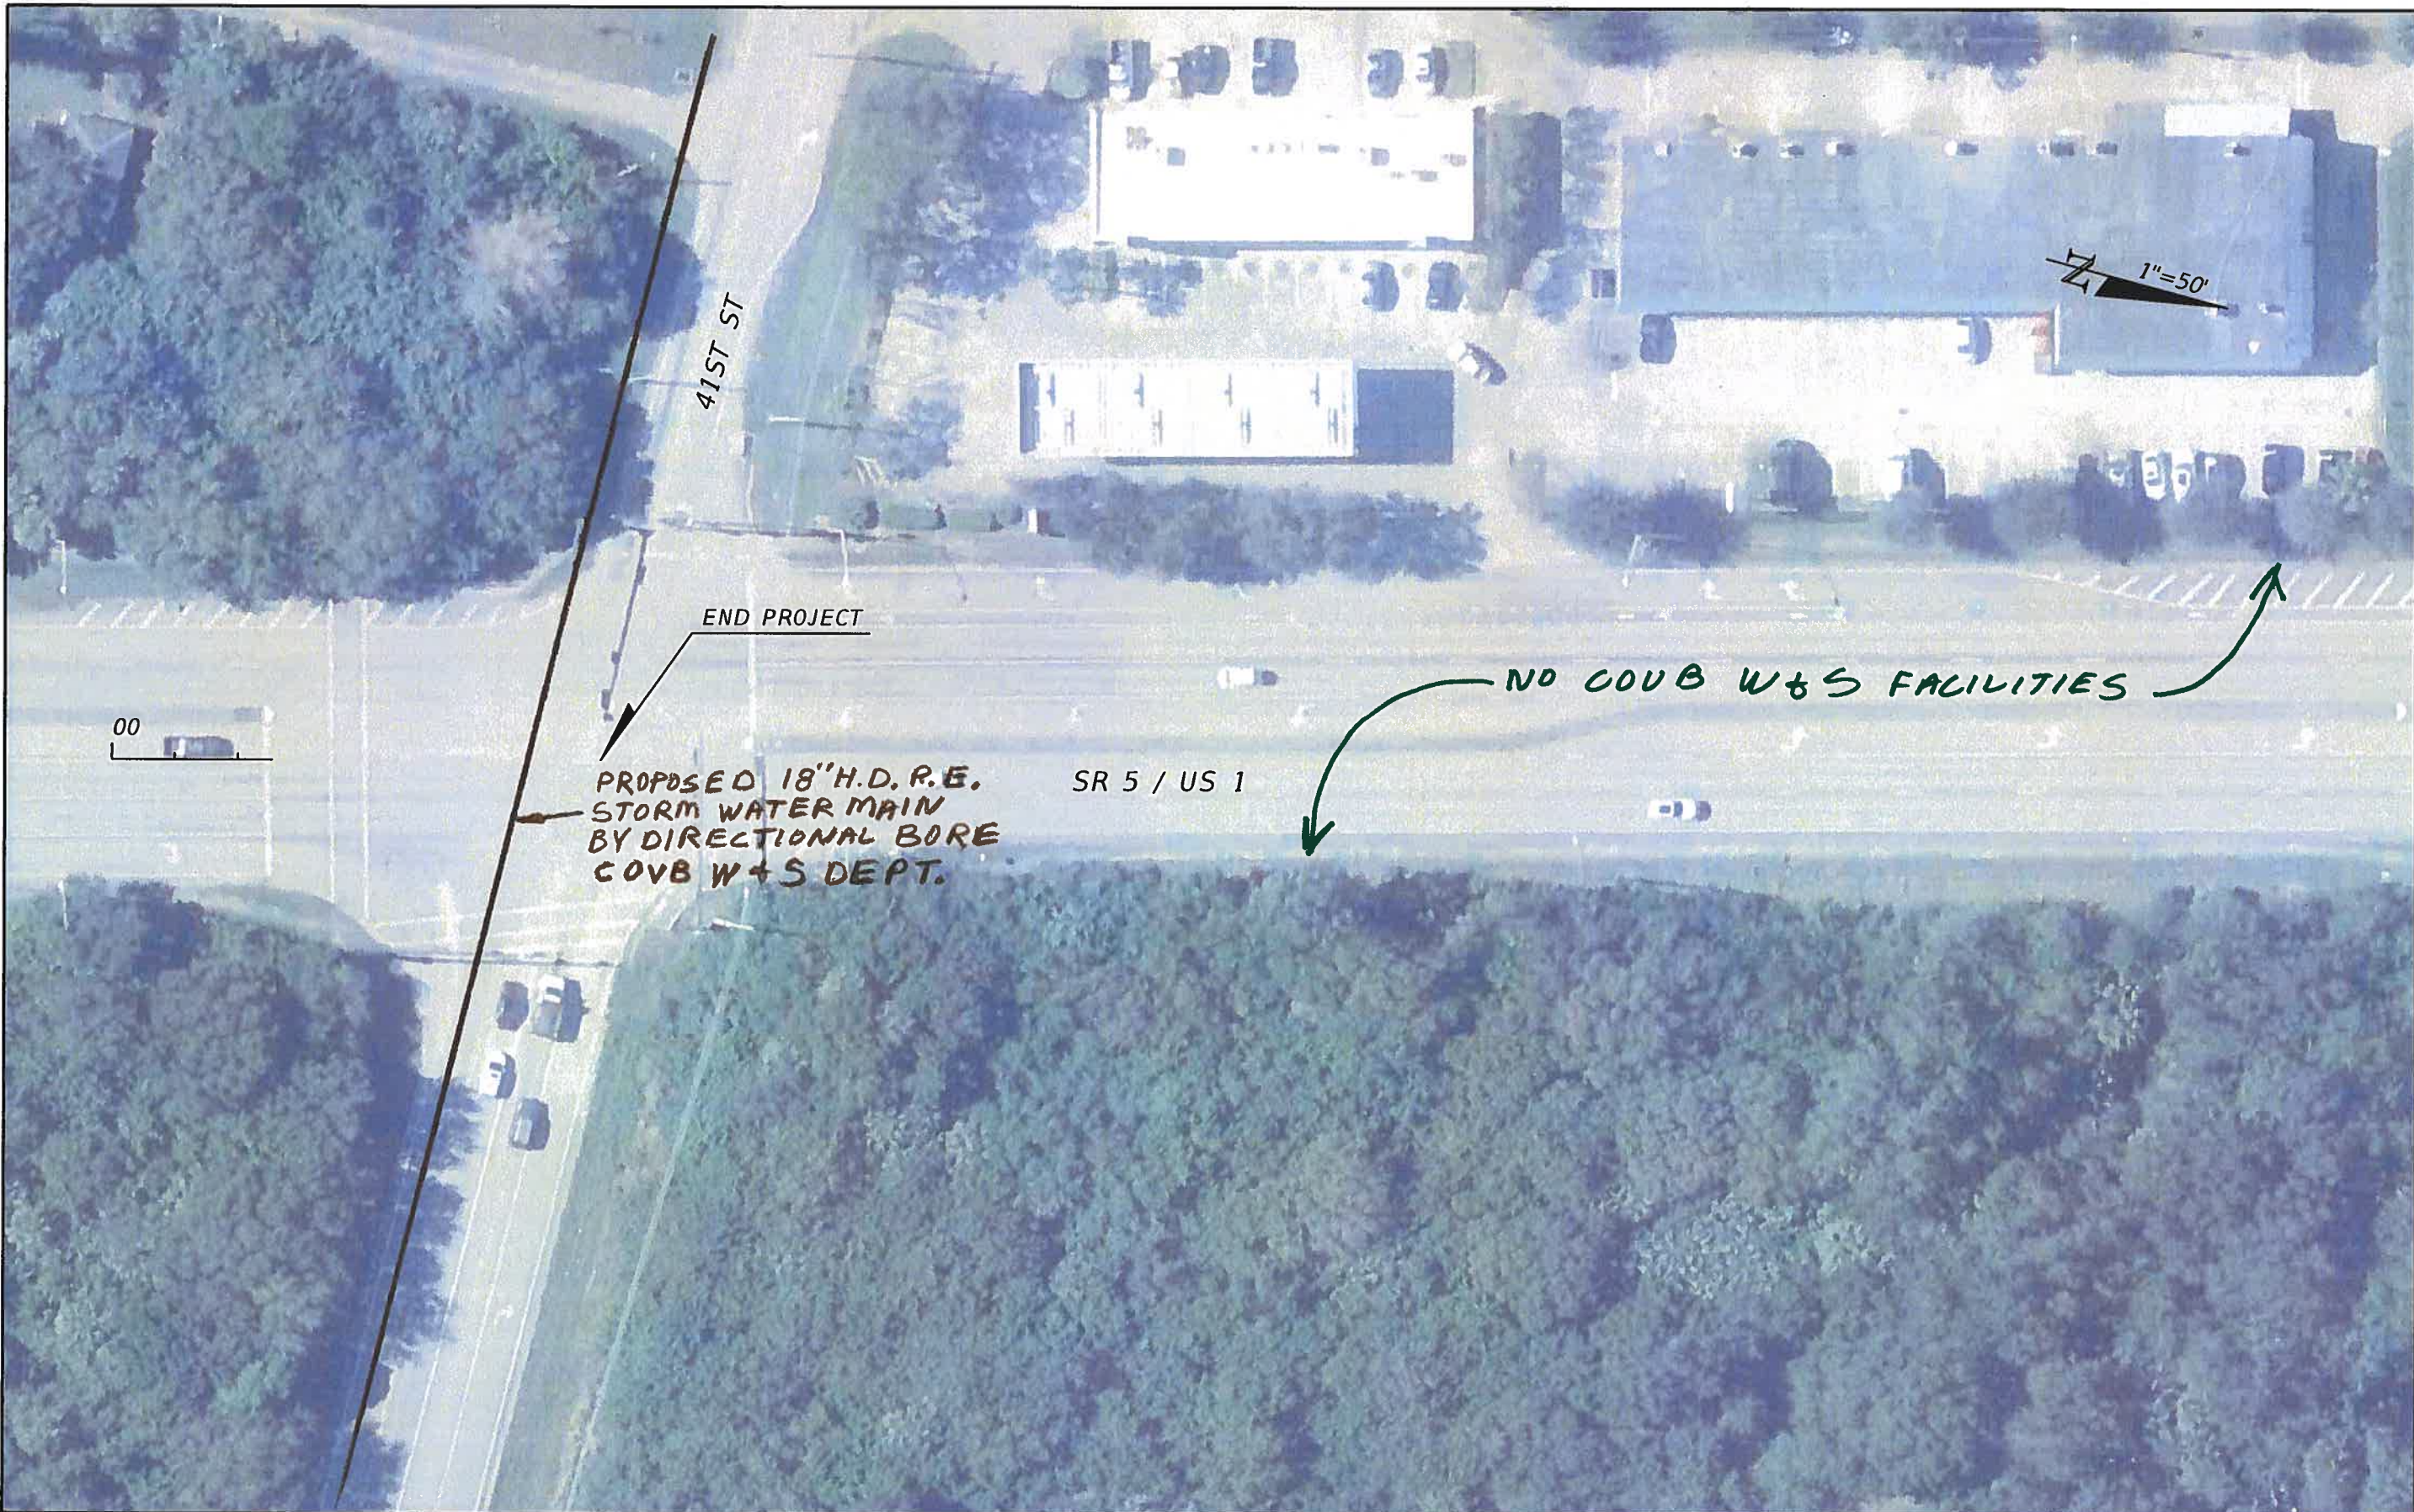

9/15/2022 11:06:09 AM Jacquelyn Arreaga  
 c:\pwworking\wgi\jacquel\proj\resg\2198192\PLMRD01.dgn


REVISIONS		PROFESSIONAL TYPE		STATE OF FLORIDA DEPARTMENT OF TRANSPORTATION			UTILITY CONTACT PLAN (16)	SHEET NO.  16
DATE	DESCRIPTION	DATE	DESCRIPTION	ROAD NO.	COUNTY	FINANCIAL PROJECT ID		
				SR 5	INDIAN RIVER	441693-1-22-02		

WILLIAM EVANS  
 LICENSE NUMBER: 45207  
 WGI, INC.  
 2035 VISTA PARKWAY  
 WEST PALM BEACH, FL 33411

THE OFFICIAL RECORD OF THIS SHEET IS THE ELECTRONIC FILE DIGITALLY SIGNED AND SEALED UNDER RULE 61G15-23.004, F.A.C.

SEE SHEET 6

1"=50'

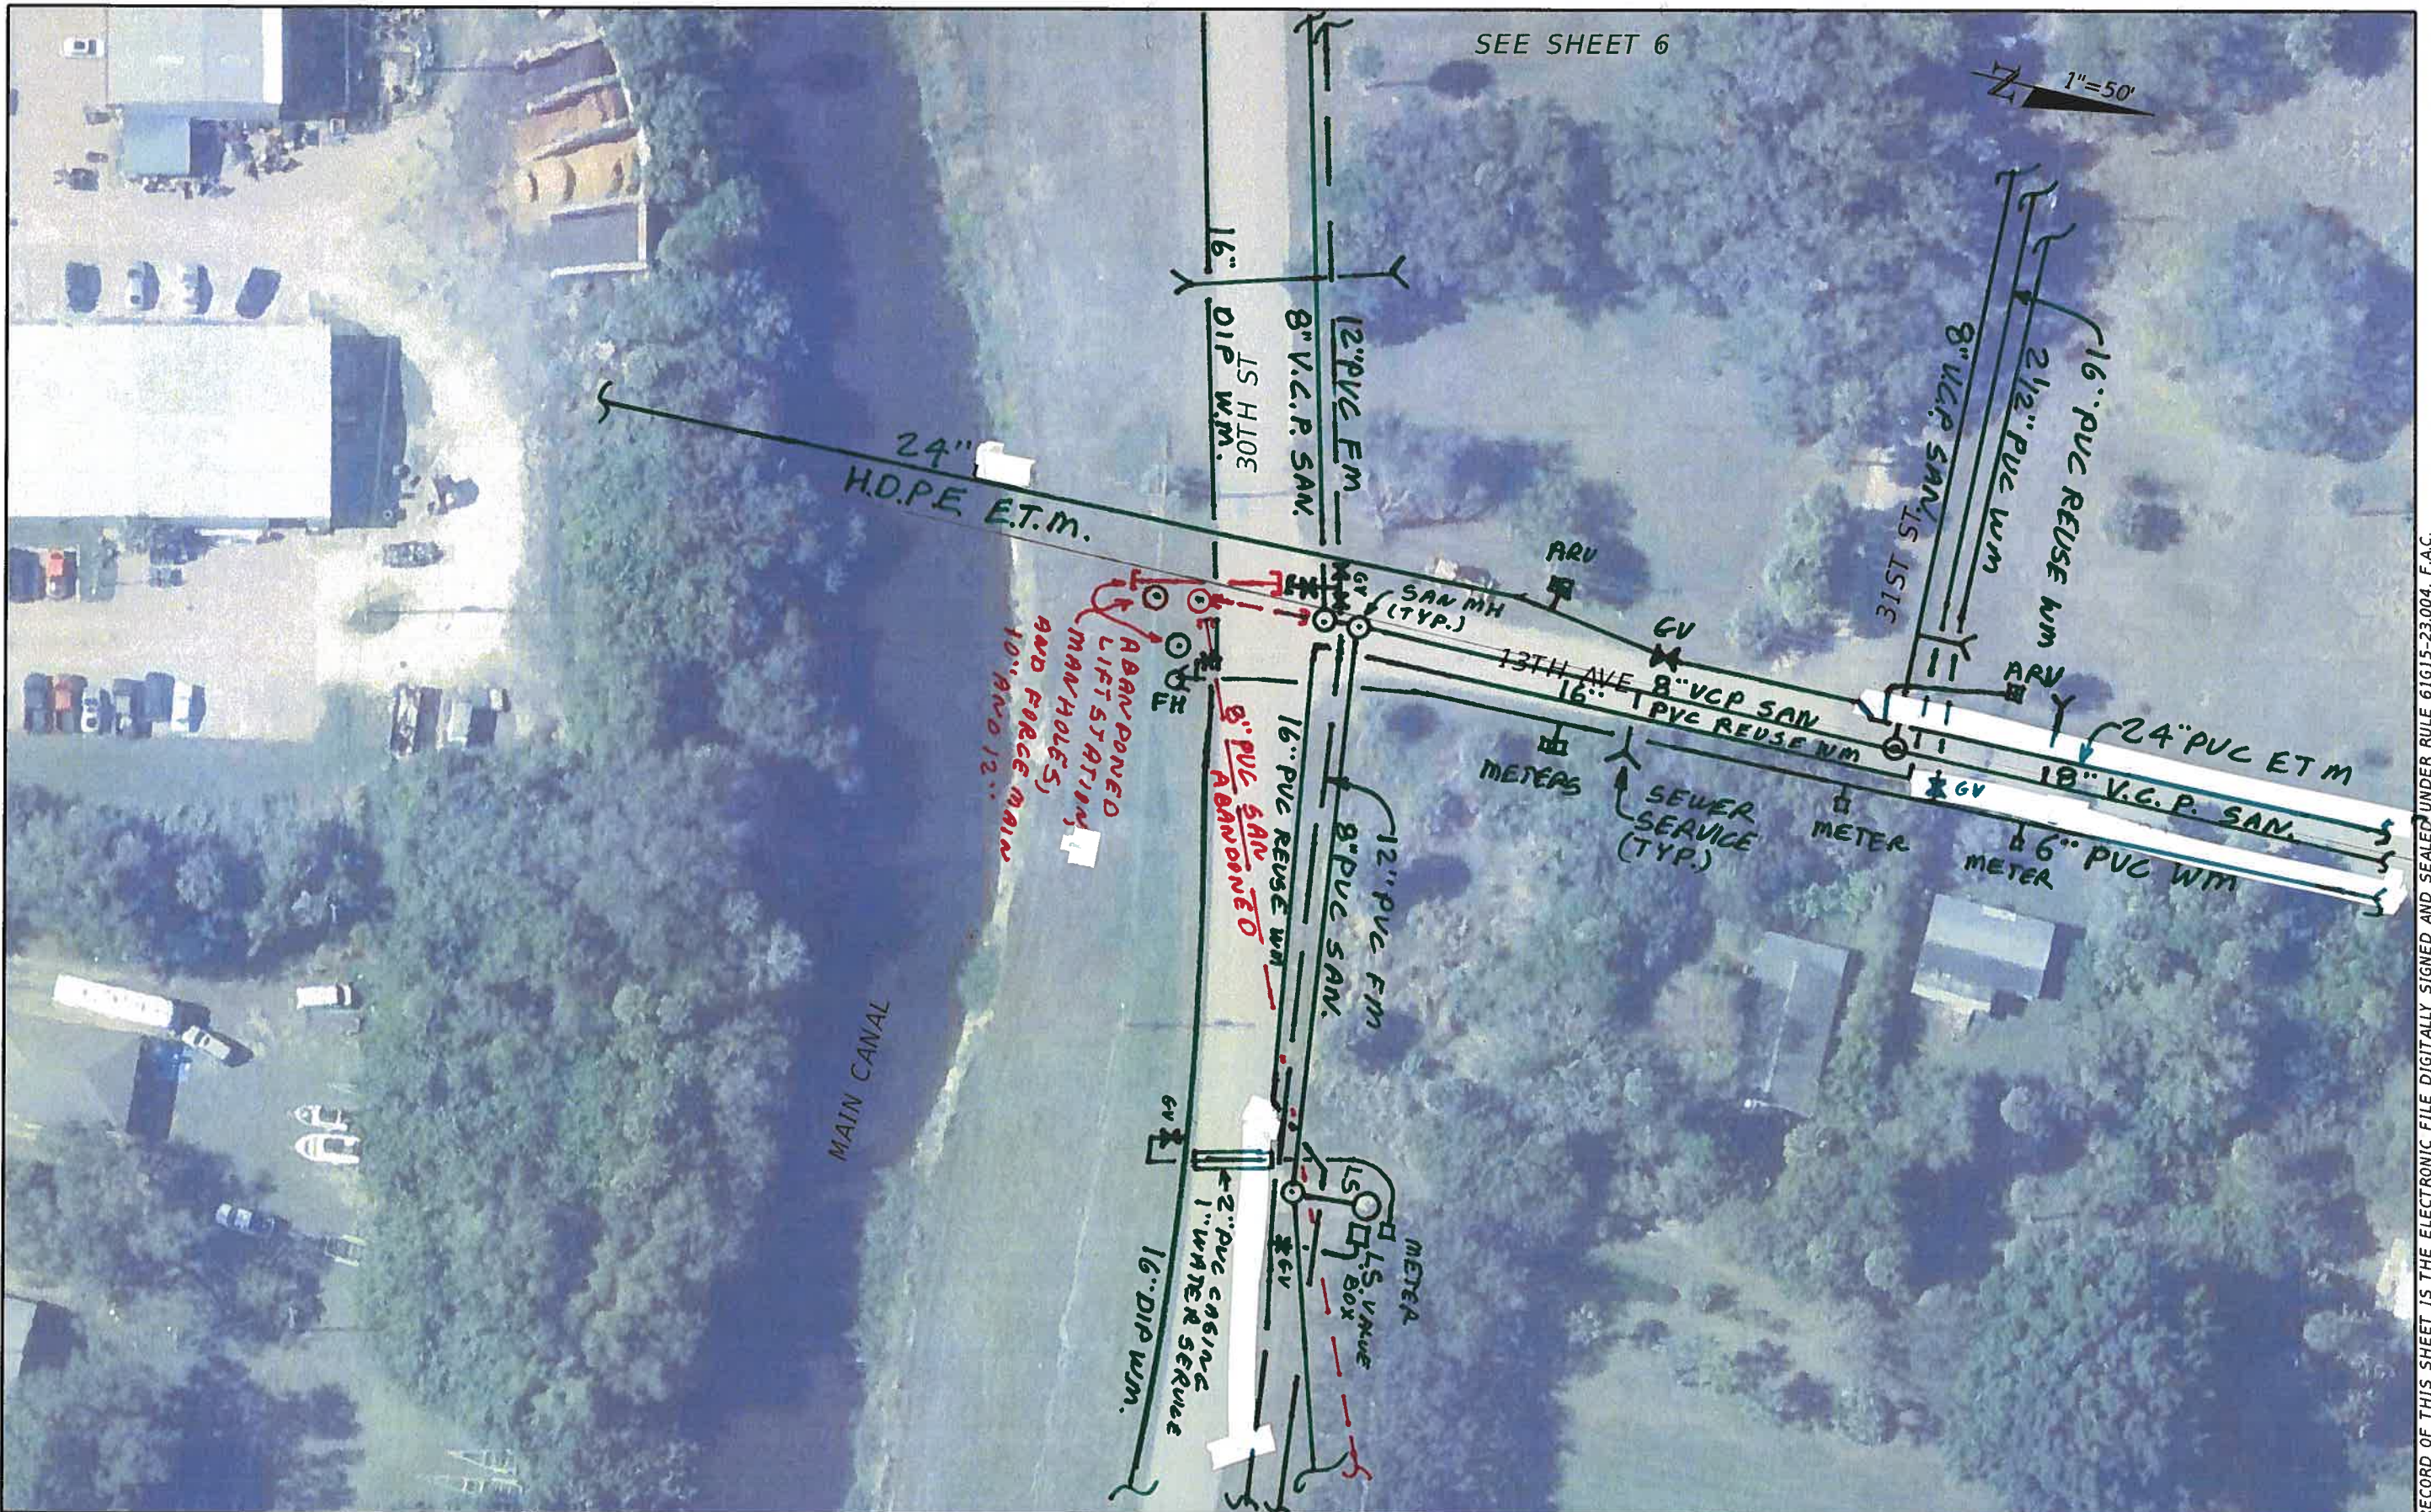

ABANDONED  
LIFT STATION  
AND FORCE MAIN  
10\"/>

9/15/2022 11:00:48 AM J:\jacquelin\ar\resop  
c:\pwworking\wg\jacquelin\ar\resop\2198192\PLANR001.dgn

REVISIONS		PROFESSIONAL TYPE		STATE OF FLORIDA DEPARTMENT OF TRANSPORTATION			SHEET NO.
DATE	DESCRIPTION	DATE	DESCRIPTION	ROAD NO.	COUNTY	FINANCIAL PROJECT ID	
				SR 5	INDIAN RIVER	441693-1-22-02	17

UTILITY CONTACT PLAN (17)

THE OFFICIAL RECORD OF THIS SHEET IS THE ELECTRONIC FILE DIGITALLY SIGNED AND SEALED UNDER RULE 61G15-23.004, F.A.C.

SEE SHEET 7

SEE SHEET 17

SEE SHEET 19



9/15/2022 11:07:02 AM jacquelyn.arreaga  
 c:\pwworking\wgi\jacquelyn.arreaga\d2198192\PLANR001.dgn

REVISIONS		PROFESSIONAL TYPE		STATE OF FLORIDA DEPARTMENT OF TRANSPORTATION			UTILITY CONTACT PLAN (18)	SHEET NO.  6
DATE	DESCRIPTION	DATE	DESCRIPTION	ROAD NO.	COUNTY	FINANCIAL PROJECT ID		
				SR 5	INDIAN RIVER	441693-1-22-02		

WILLIAM EVANS  
 LICENSE NUMBER: 45207  
 WGI, INC.  
 2035 VISTA PARKWAY  
 WEST PALM BEACH, FL 33411

THE OFFICIAL RECORD OF THIS SHEET IS THE ELECTRONIC FILE DIGITALLY SIGNED AND SEALED UNDER RULE 61G15-23.004, F.A.C.

SEE SHEET 8



SEE SHEET 18

SEE SHEET 20

?

9/15/2022 11:17:13 AM Jacquelyn.Arrcaga  
c:\pwworking\wgi\jacquelyn.arreaga\d2198192\PLANRD01.dgn

DATE		REVISIONS		PROFESSIONAL TYPE		STATE OF FLORIDA DEPARTMENT OF TRANSPORTATION			SHEET NO.
DATE	DESCRIPTION	DATE	DESCRIPTION	WILLIAM EVANS LICENSE NUMBER: 45207 WGI, INC. 2035 VISTA PARKWAY WEST PALM BEACH, FL 33411	ROAD NO.	COUNTY	FINANCIAL PROJECT ID	19	
					SR 5	INDIAN RIVER	441693-1-22-02		

**UTILITY CONTACT PLAN (19)**

THE OFFICIAL RECORD OF THIS SHEET IS THE ELECTRONIC FILE DIGITALLY SIGNED AND SEALED UNDER RULE 61G15-23.004, F.A.C.



SEE SHEET 9

SEE SHEET 19



1"=50'

8" PVC SAN.

91'-6" PVC SAN.

325'-8" PVC SAN.  
WITH 15' UTILITY EASEMENT

SAN. MW


GAERGE TRAP

9/15/2022 11:17:26 AM jacquelyn.arreaga  
c:\pwworking\wgi\jacquelyn.arreaga\2198192\PLANRD01.dgn

REVISIONS		PROFESSIONAL TYPE		STATE OF FLORIDA DEPARTMENT OF TRANSPORTATION			SHEET NO.
DATE	DESCRIPTION	DATE	DESCRIPTION	ROAD NO.	COUNTY	FINANCIAL PROJECT ID	
			WILLIAM EVANS LICENSE NUMBER: 45207 WGI, INC. 2035 VISTA PARKWAY WEST PALM BEACH, FL 33411	SR 5	INDIAN RIVER	441693-1-22-02	20

UTILITY CONTACT PLAN (20)

THE OFFICIAL RECORD OF THIS SHEET IS THE ELECTRONIC FILE DIGITALLY SIGNED AND SEALED UNDER RULE 61G15-23.004, F.A.C.

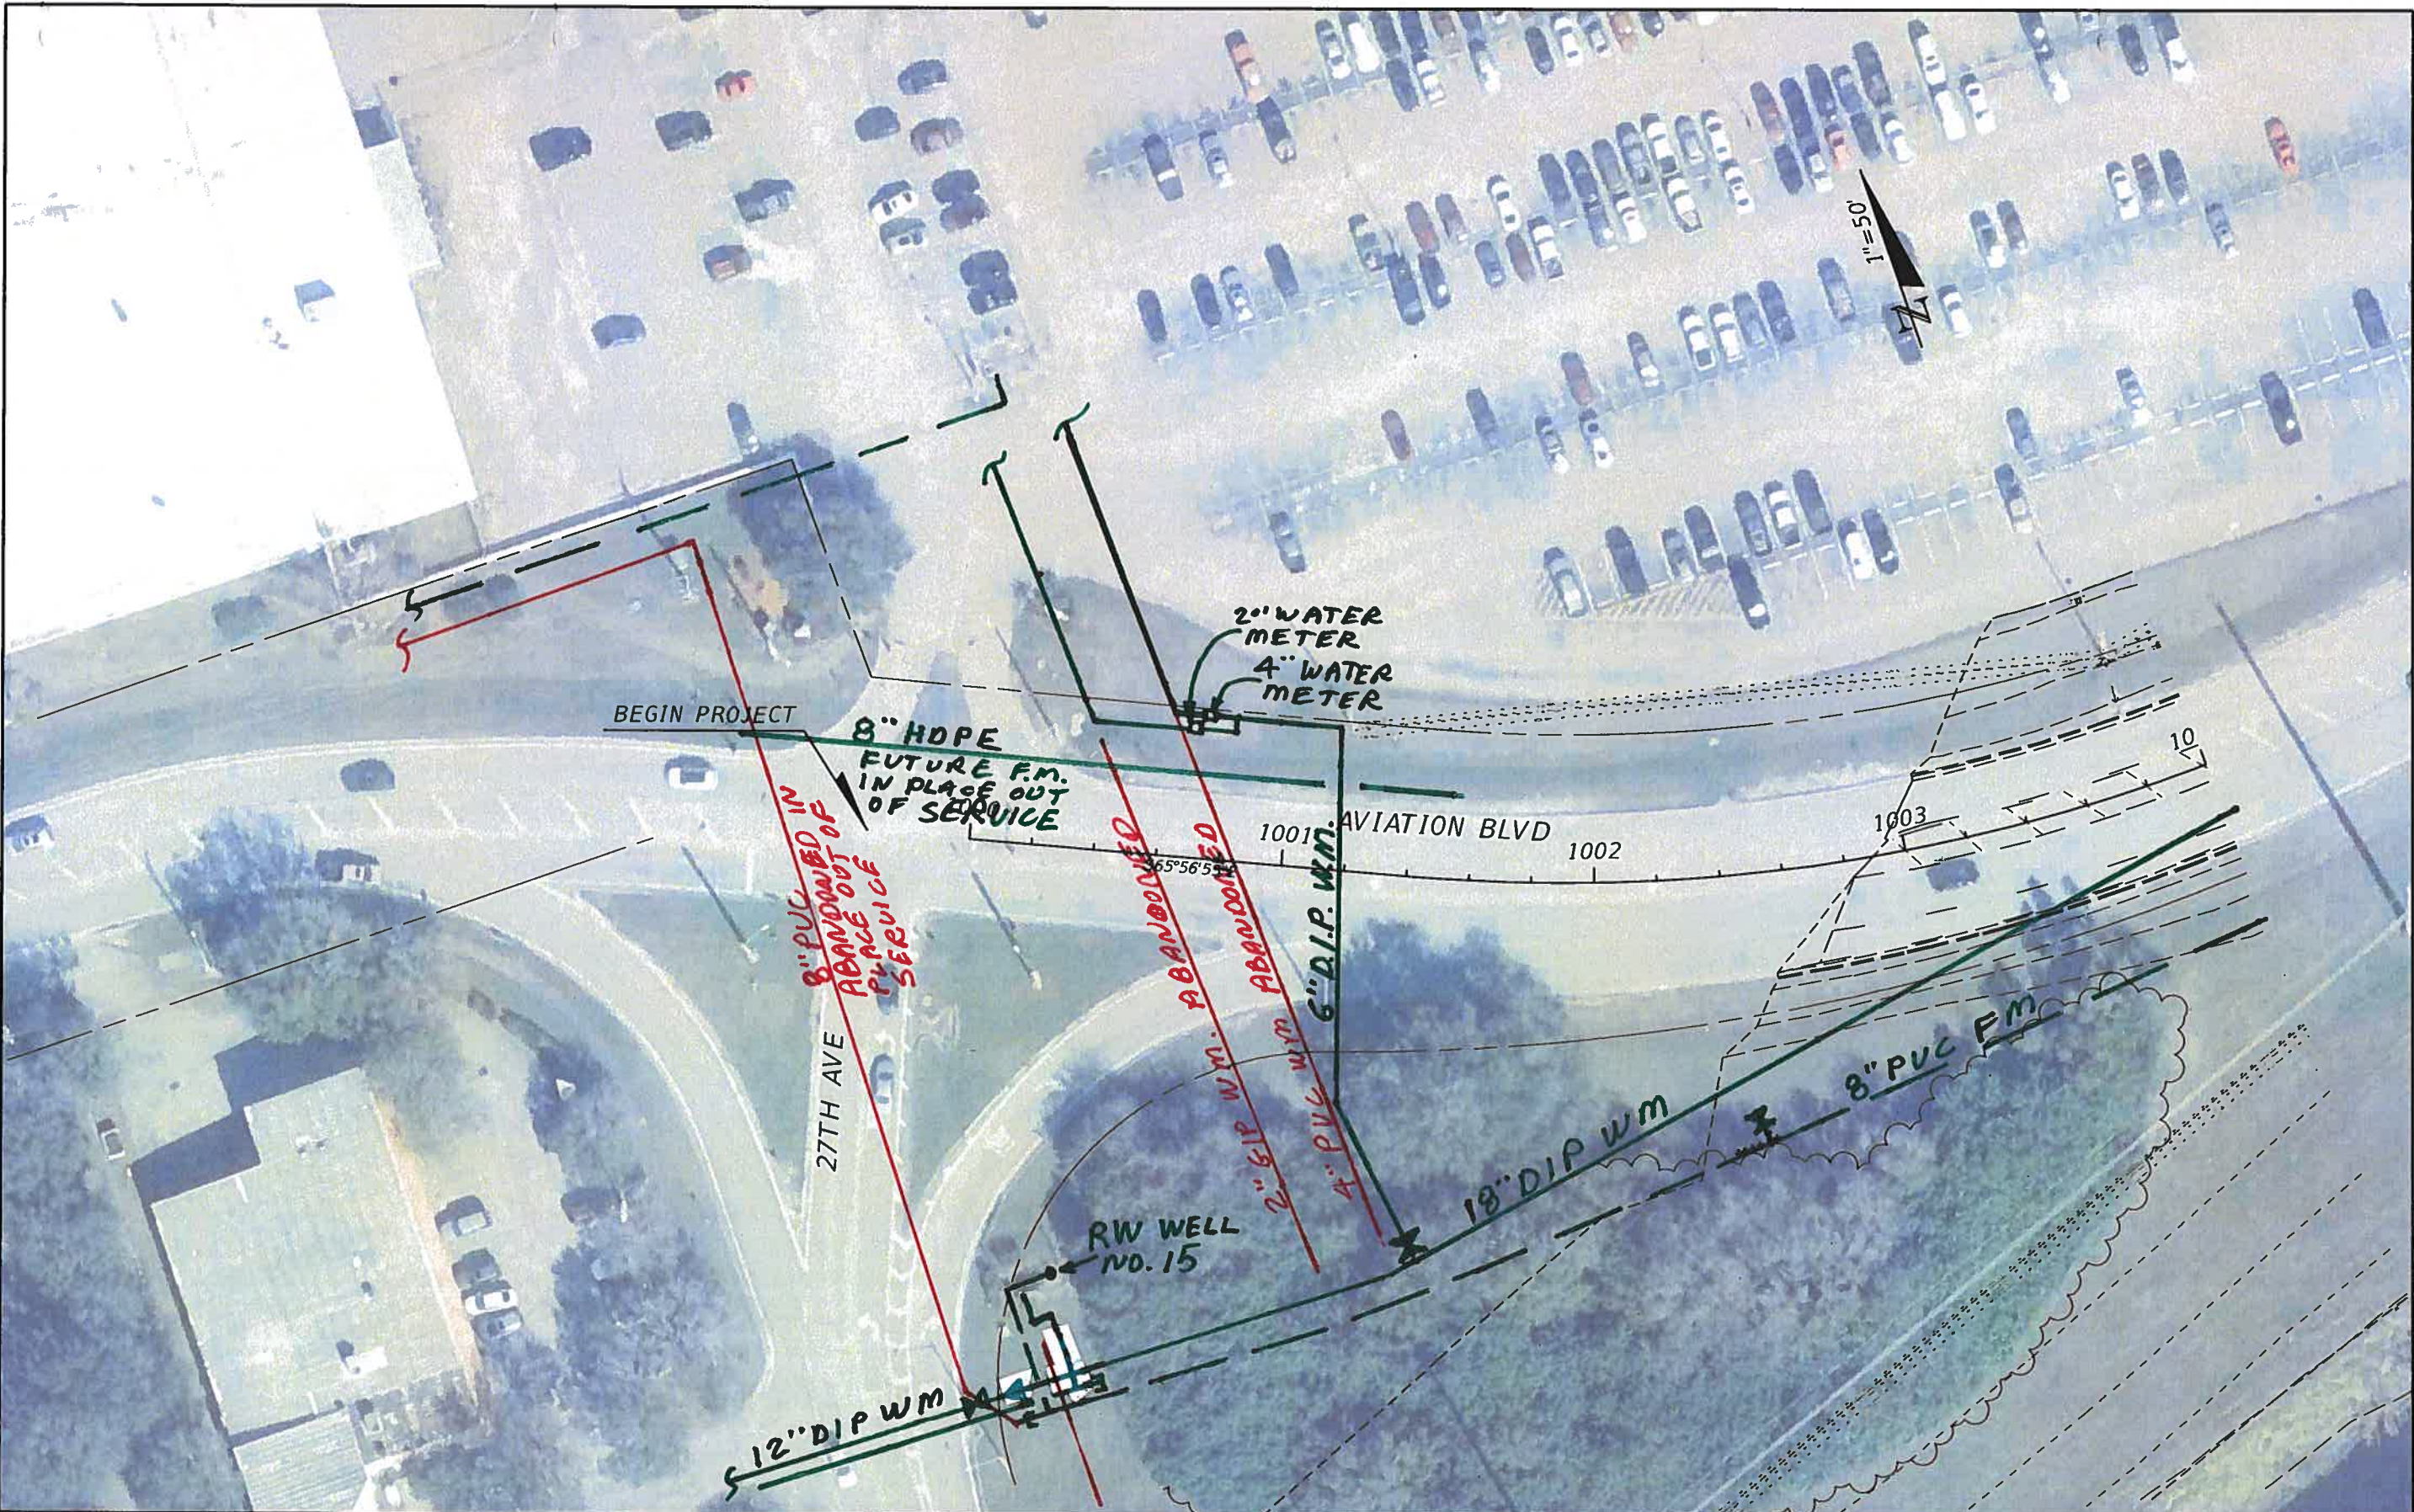

9/15/2022 11:07:58 AM Jacquelyn.Arrisp  
 C:\pwworking\wg\jacquelin\proj\61615-23\192\PLANR001.dgn


REVISIONS	
DATE	DESCRIPTION

PROFESSIONAL TYPE  
 WILLIAM EVANS  
 LICENSE NUMBER: 45207  
 WGI, INC.  
 2035 VISTA PARKWAY  
 WEST PALM BEACH, FL 33411

STATE OF FLORIDA DEPARTMENT OF TRANSPORTATION		
ROAD NO.	COUNTY	FINANCIAL PROJECT ID
SR 5	INDIAN RIVER	441693-1-22-02

**UTILITY CONTACT PLAN (21)**  
 SHEET NO.  
 21

THE OFFICIAL RECORD OF THIS SHEET IS THE ELECTRONIC FILE DIGITALLY SIGNED AND SEALED UNDER RULE 61G15-23.004, F.A.C.

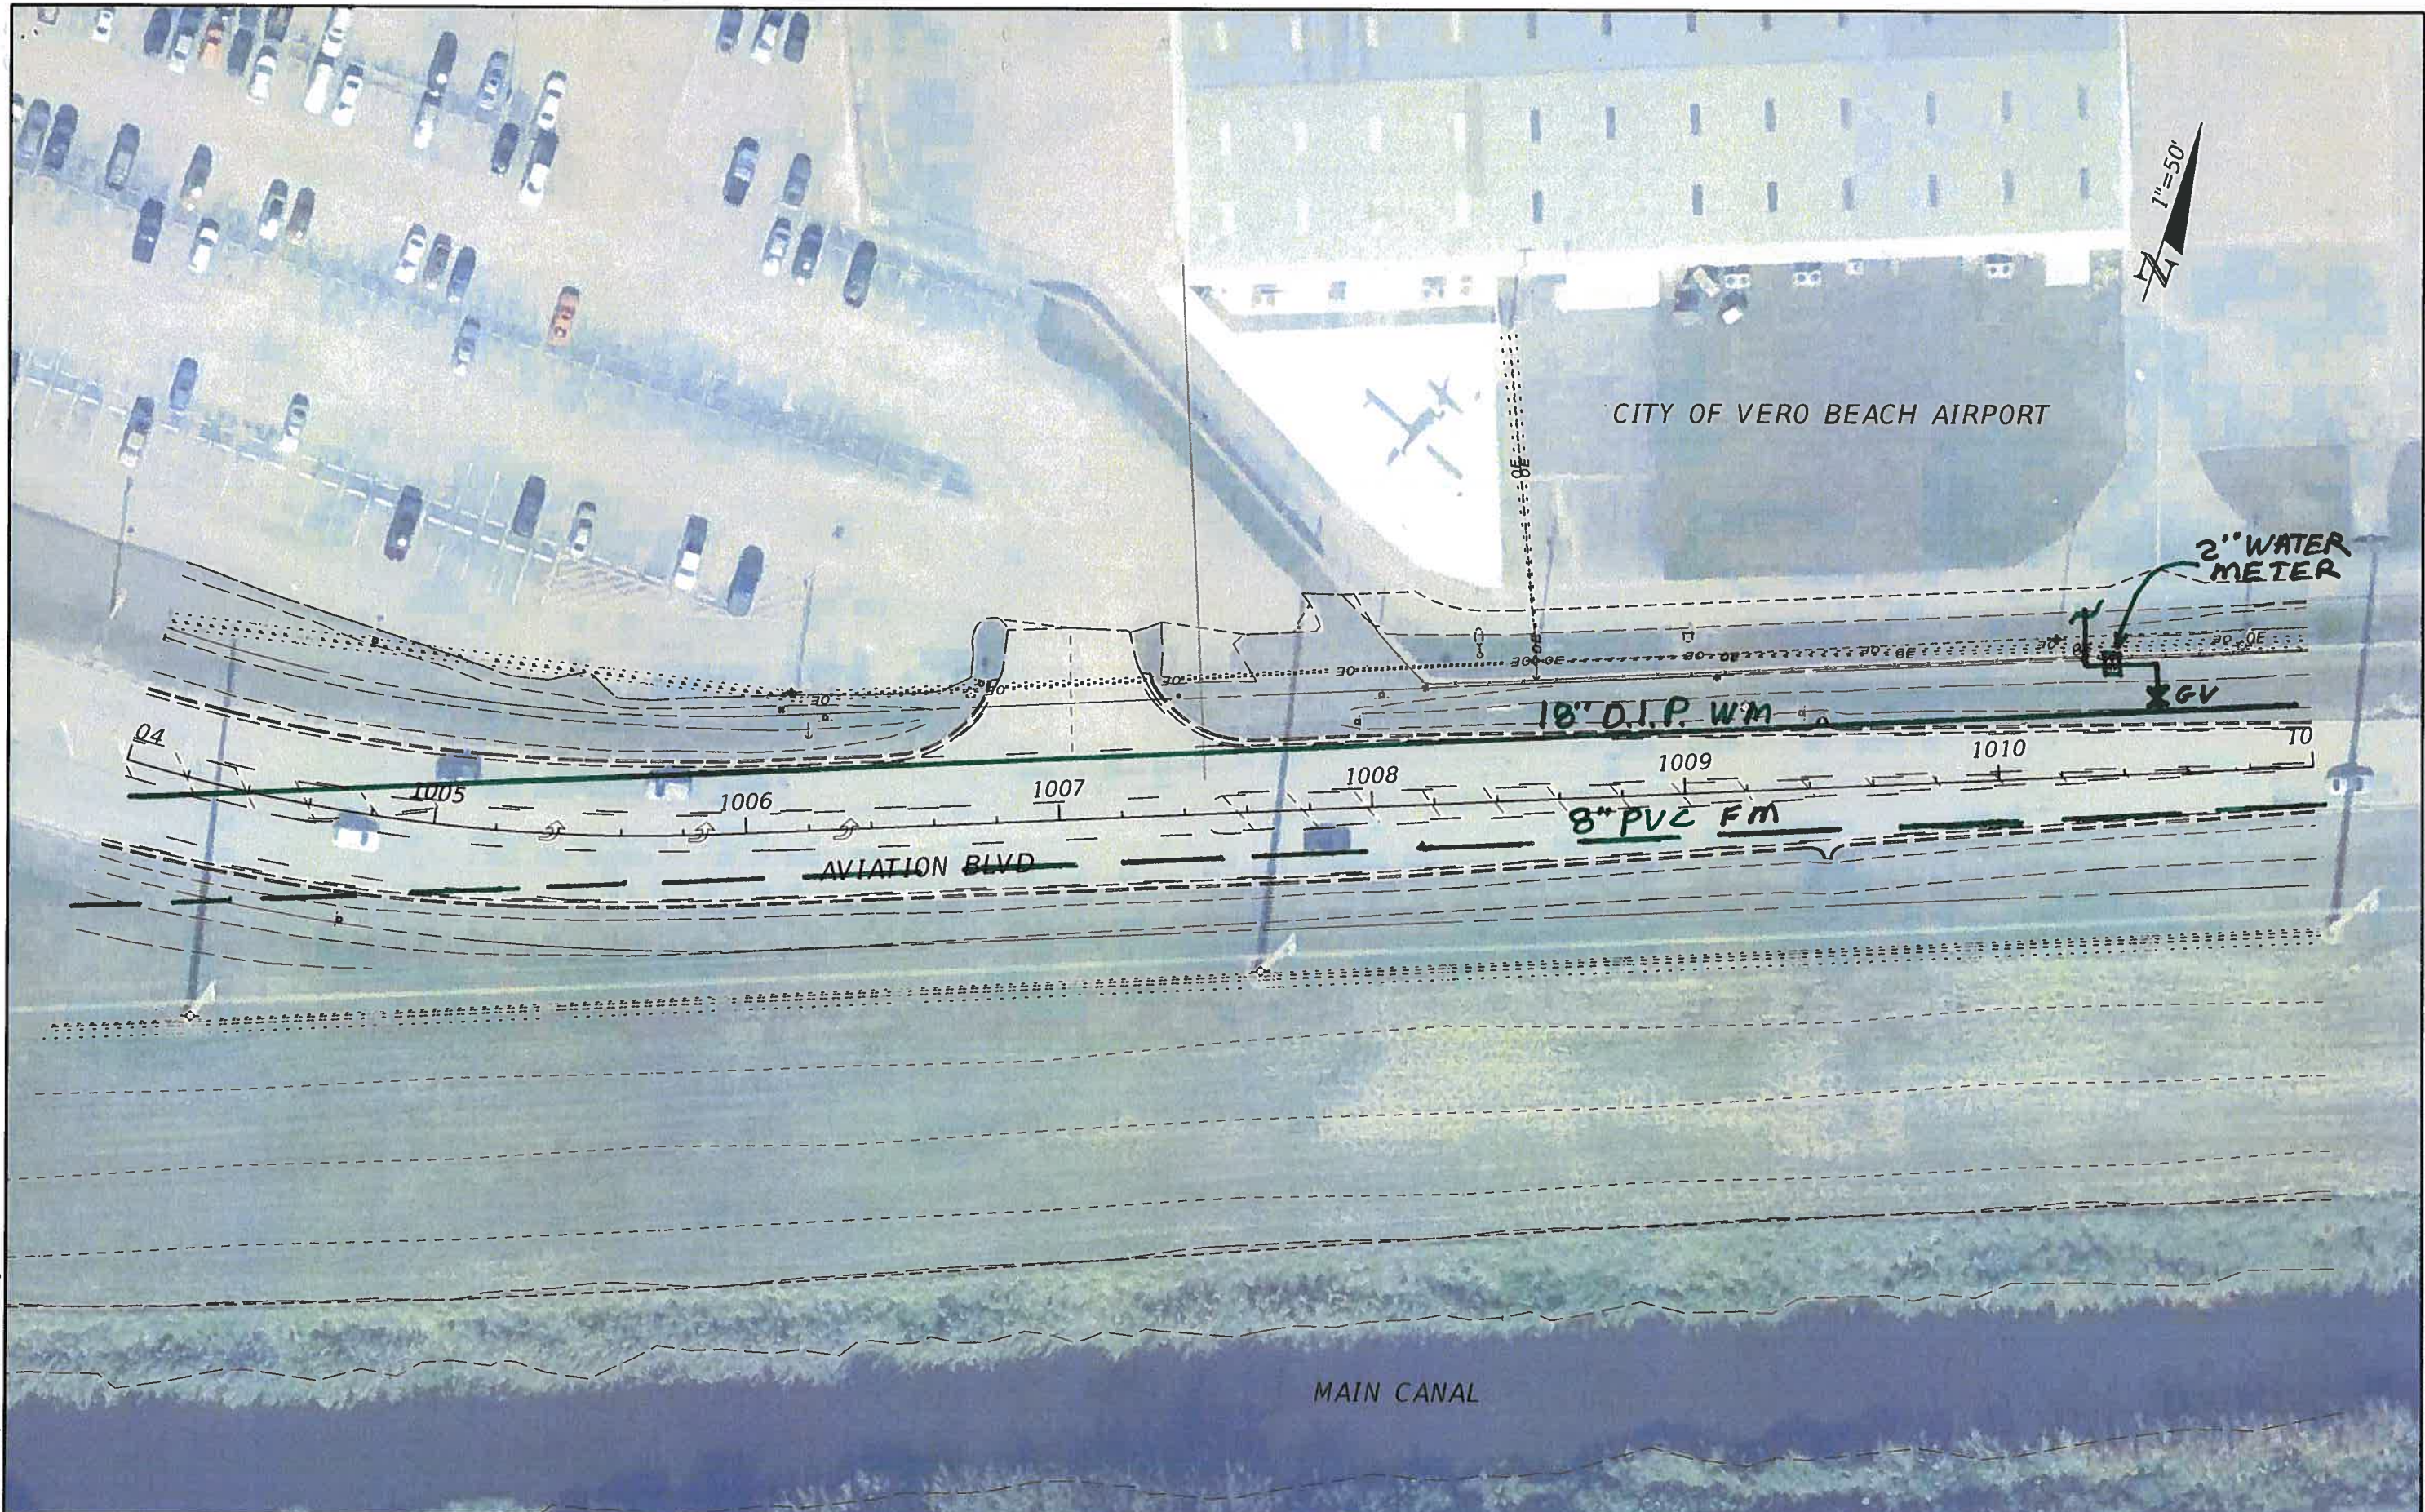

CITY OF VERO BEACH AIRPORT

2" WATER METER

18" D.I.P. WM

8" PVC FM

AVIATION BLVD

MAIN CANAL


9/15/2022 11:08:27 AM Jacquelyn.Arreaga c:\pwworking\wgi\jacquelyn.arreaga\d2198192\PLANR001.dgn

THE OFFICIAL RECORD OF THIS SHEET IS THE ELECTRONIC FILE DIGITALLY SIGNED AND SEALED UNDER RULE 61G15-23.004, F.A.C.

REVISIONS		PROFESSIONAL TYPE		STATE OF FLORIDA DEPARTMENT OF TRANSPORTATION			UTILITY CONTACT PLAN (22)	SHEET NO.
DATE	DESCRIPTION	DATE	DESCRIPTION	ROAD NO.	COUNTY	FINANCIAL PROJECT ID		
				SR 5	INDIAN RIVER	441693-1-22-02		22

WILLIAM EVANS  
LICENSE NUMBER: 45207  
WGI, INC.  
2035 VISTA PARKWAY  
WEST PALM BEACH, FL 33411

CITY OF VERO BEACH AIRPORT

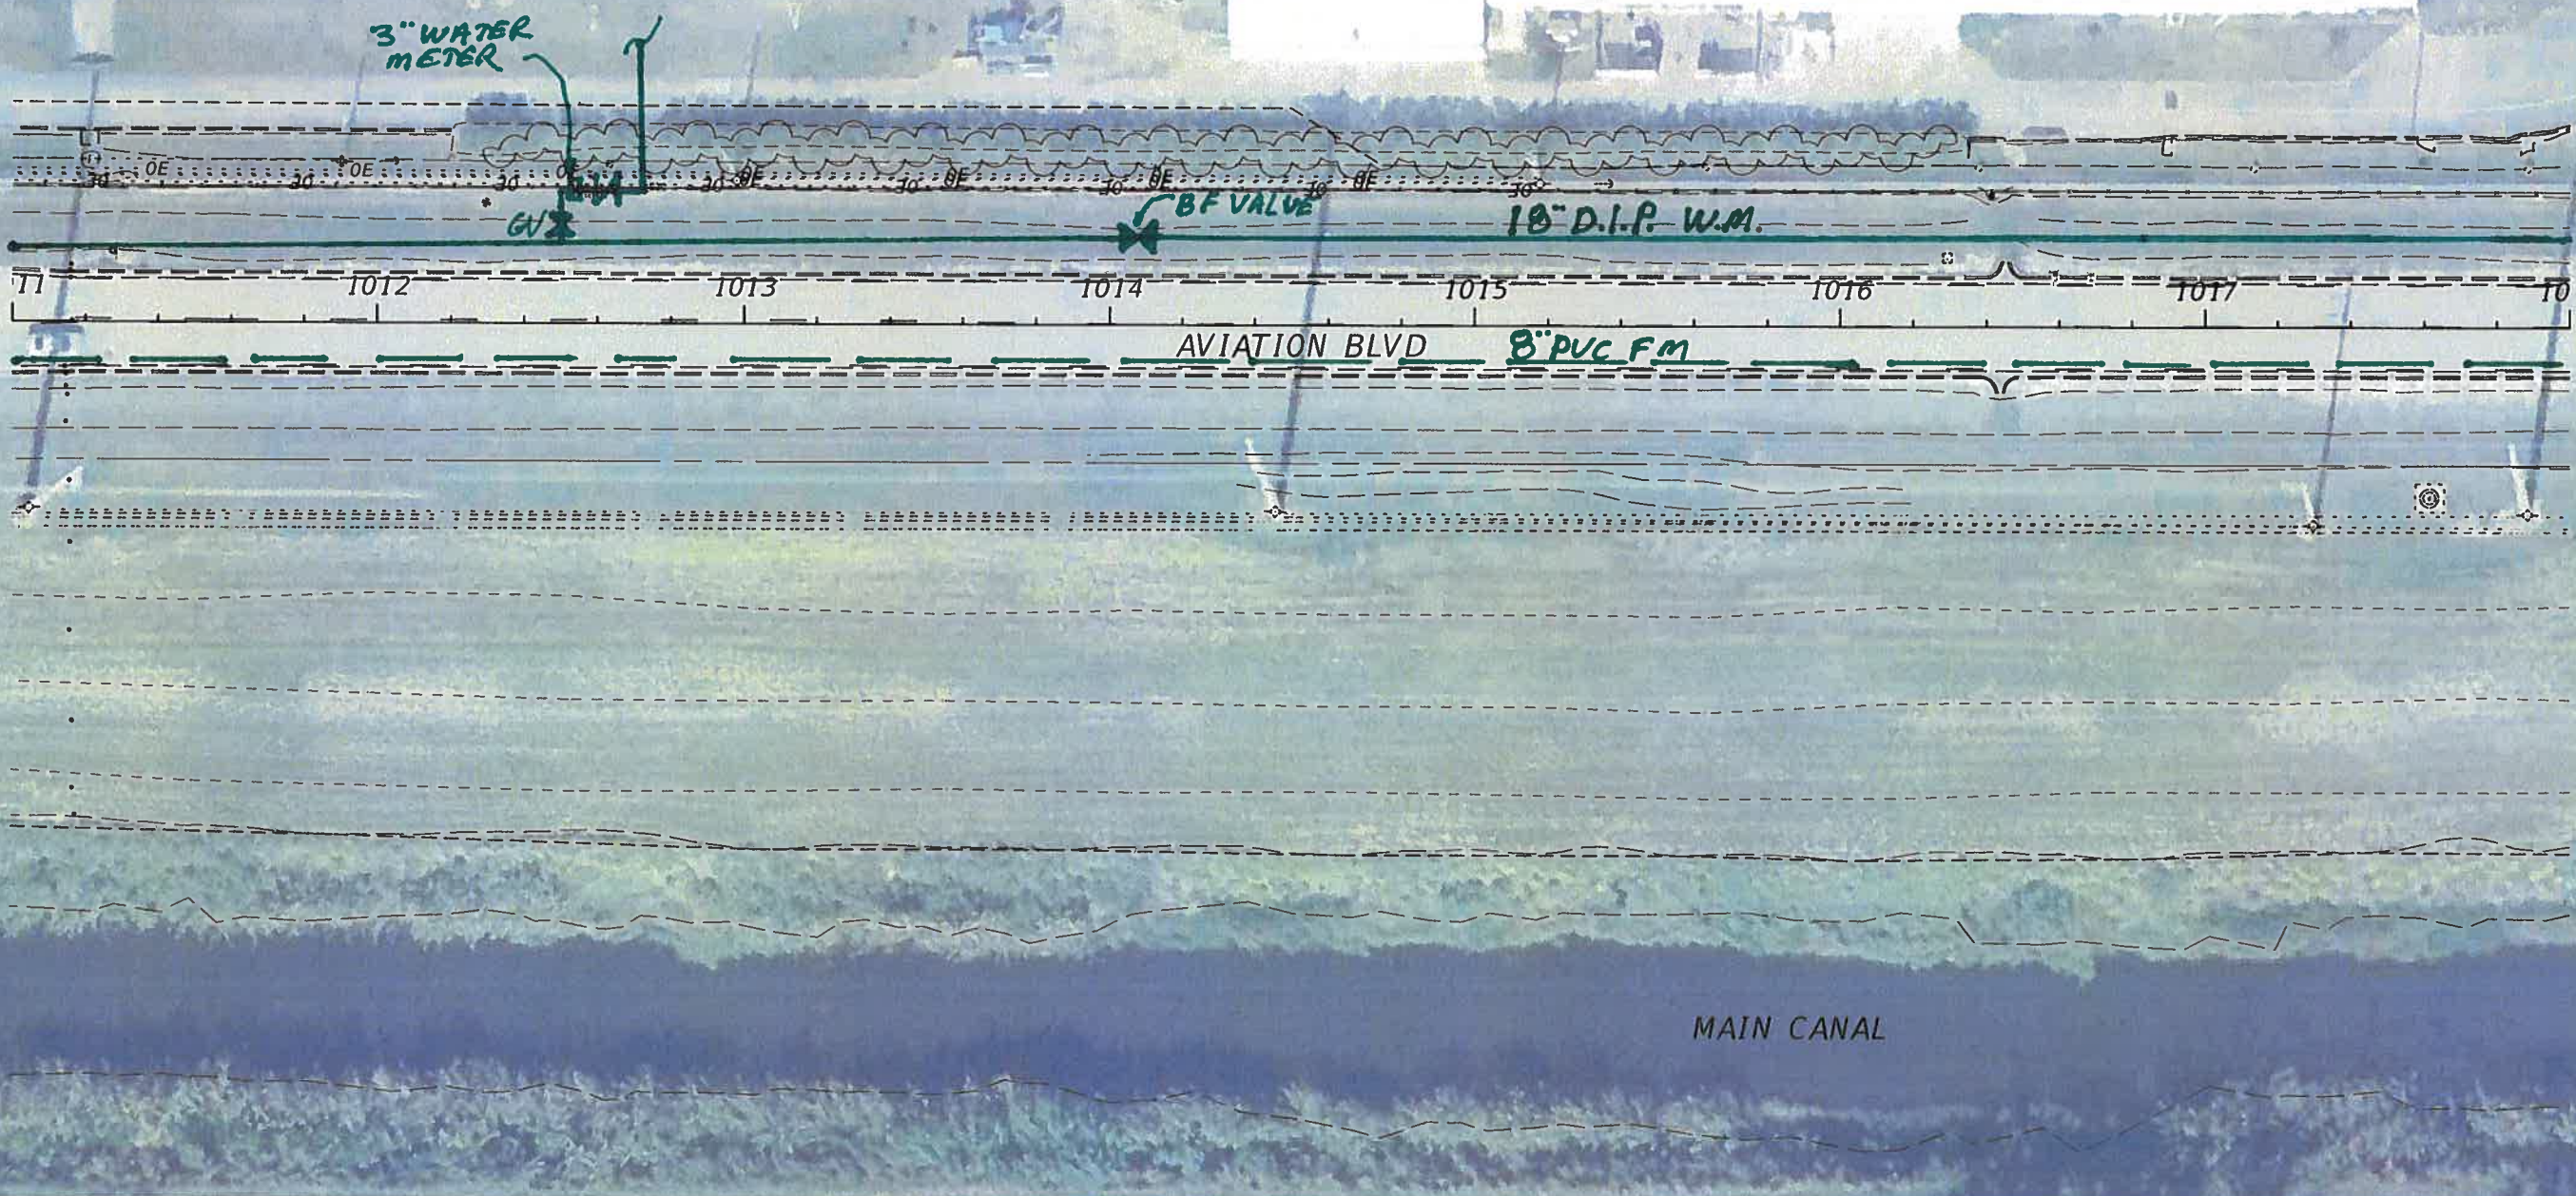

9/15/2022 11:08:39 AM Jacquelyn Arrcaga c:\pwworking\wgi\jacquelyn.rrcaga\2198192\PLANR001.dgn


THE OFFICIAL RECORD OF THIS SHEET IS THE ELECTRONIC FILE DIGITALLY SIGNED AND SEALED UNDER RULE 61G15-23.004, F.A.C.

REVISIONS		PROFESSIONAL TYPE		STATE OF FLORIDA DEPARTMENT OF TRANSPORTATION			UTILITY CONTACT PLAN (23)	SHEET NO.  23
DATE	DESCRIPTION	DATE	DESCRIPTION	ROAD NO.	COUNTY	FINANCIAL PROJECT ID		
				SR 5	INDIAN RIVER	441693-1-22-02		

WILLIAM EVANS  
LICENSE NUMBER: 45207  
WGI, INC.  
2035 VISTA PARKWAY  
WEST PALM BEACH, FL 33411



CITY OF VERO BEACH AIRPORT

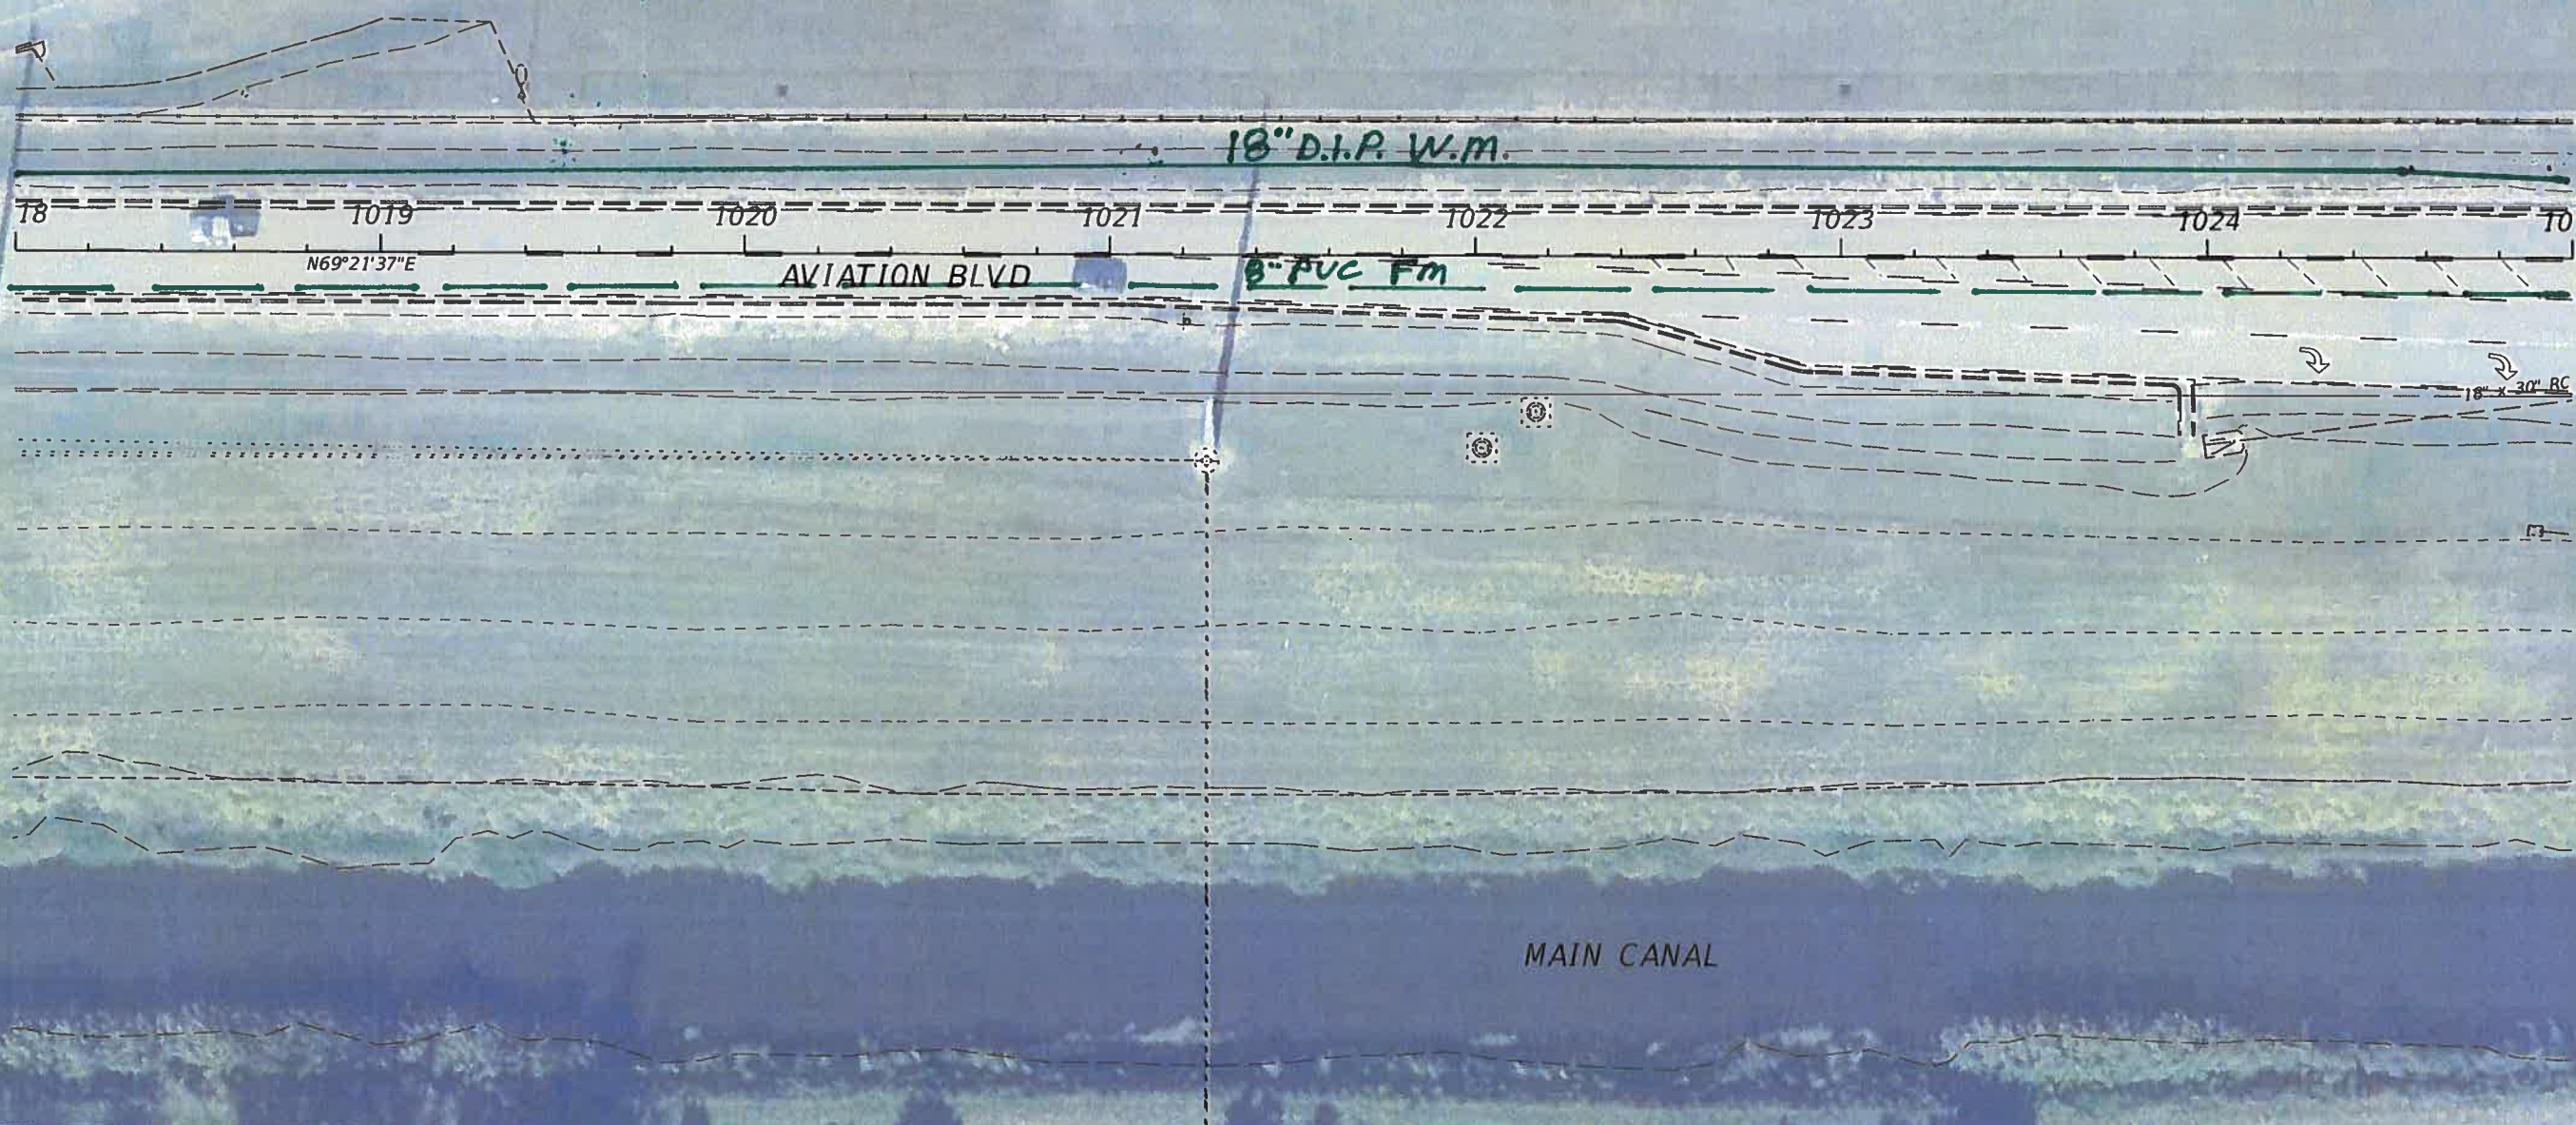


9/15/2022 11:08:55 AM Jacquelyn.Arrcaga c:\pwworking\wgi\jacquelyn.arrcaga\d2198192\PLANRD01.dgn

THE OFFICIAL RECORD OF THIS SHEET IS THE ELECTRONIC FILE DIGITALLY SIGNED AND SEALED UNDER RULE 61G15-23.004, F.A.C.

DATE		REVISIONS		PROFESSIONAL TYPE		STATE OF FLORIDA DEPARTMENT OF TRANSPORTATION			SHEET NO.
DATE	DESCRIPTION	DATE	DESCRIPTION	WILLIAM EVANS LICENSE NUMBER: 45207 WGI, INC. 2035 VISTA PARKWAY WEST PALM BEACH, FL 33411	ROAD NO.	COUNTY	FINANCIAL PROJECT ID	24	
					SR 5	INDIAN RIVER	441693-1-22-02		<b>UTILITY CONTACT PLAN (24)</b>

CITY OF VERO BEACH AIRPORT

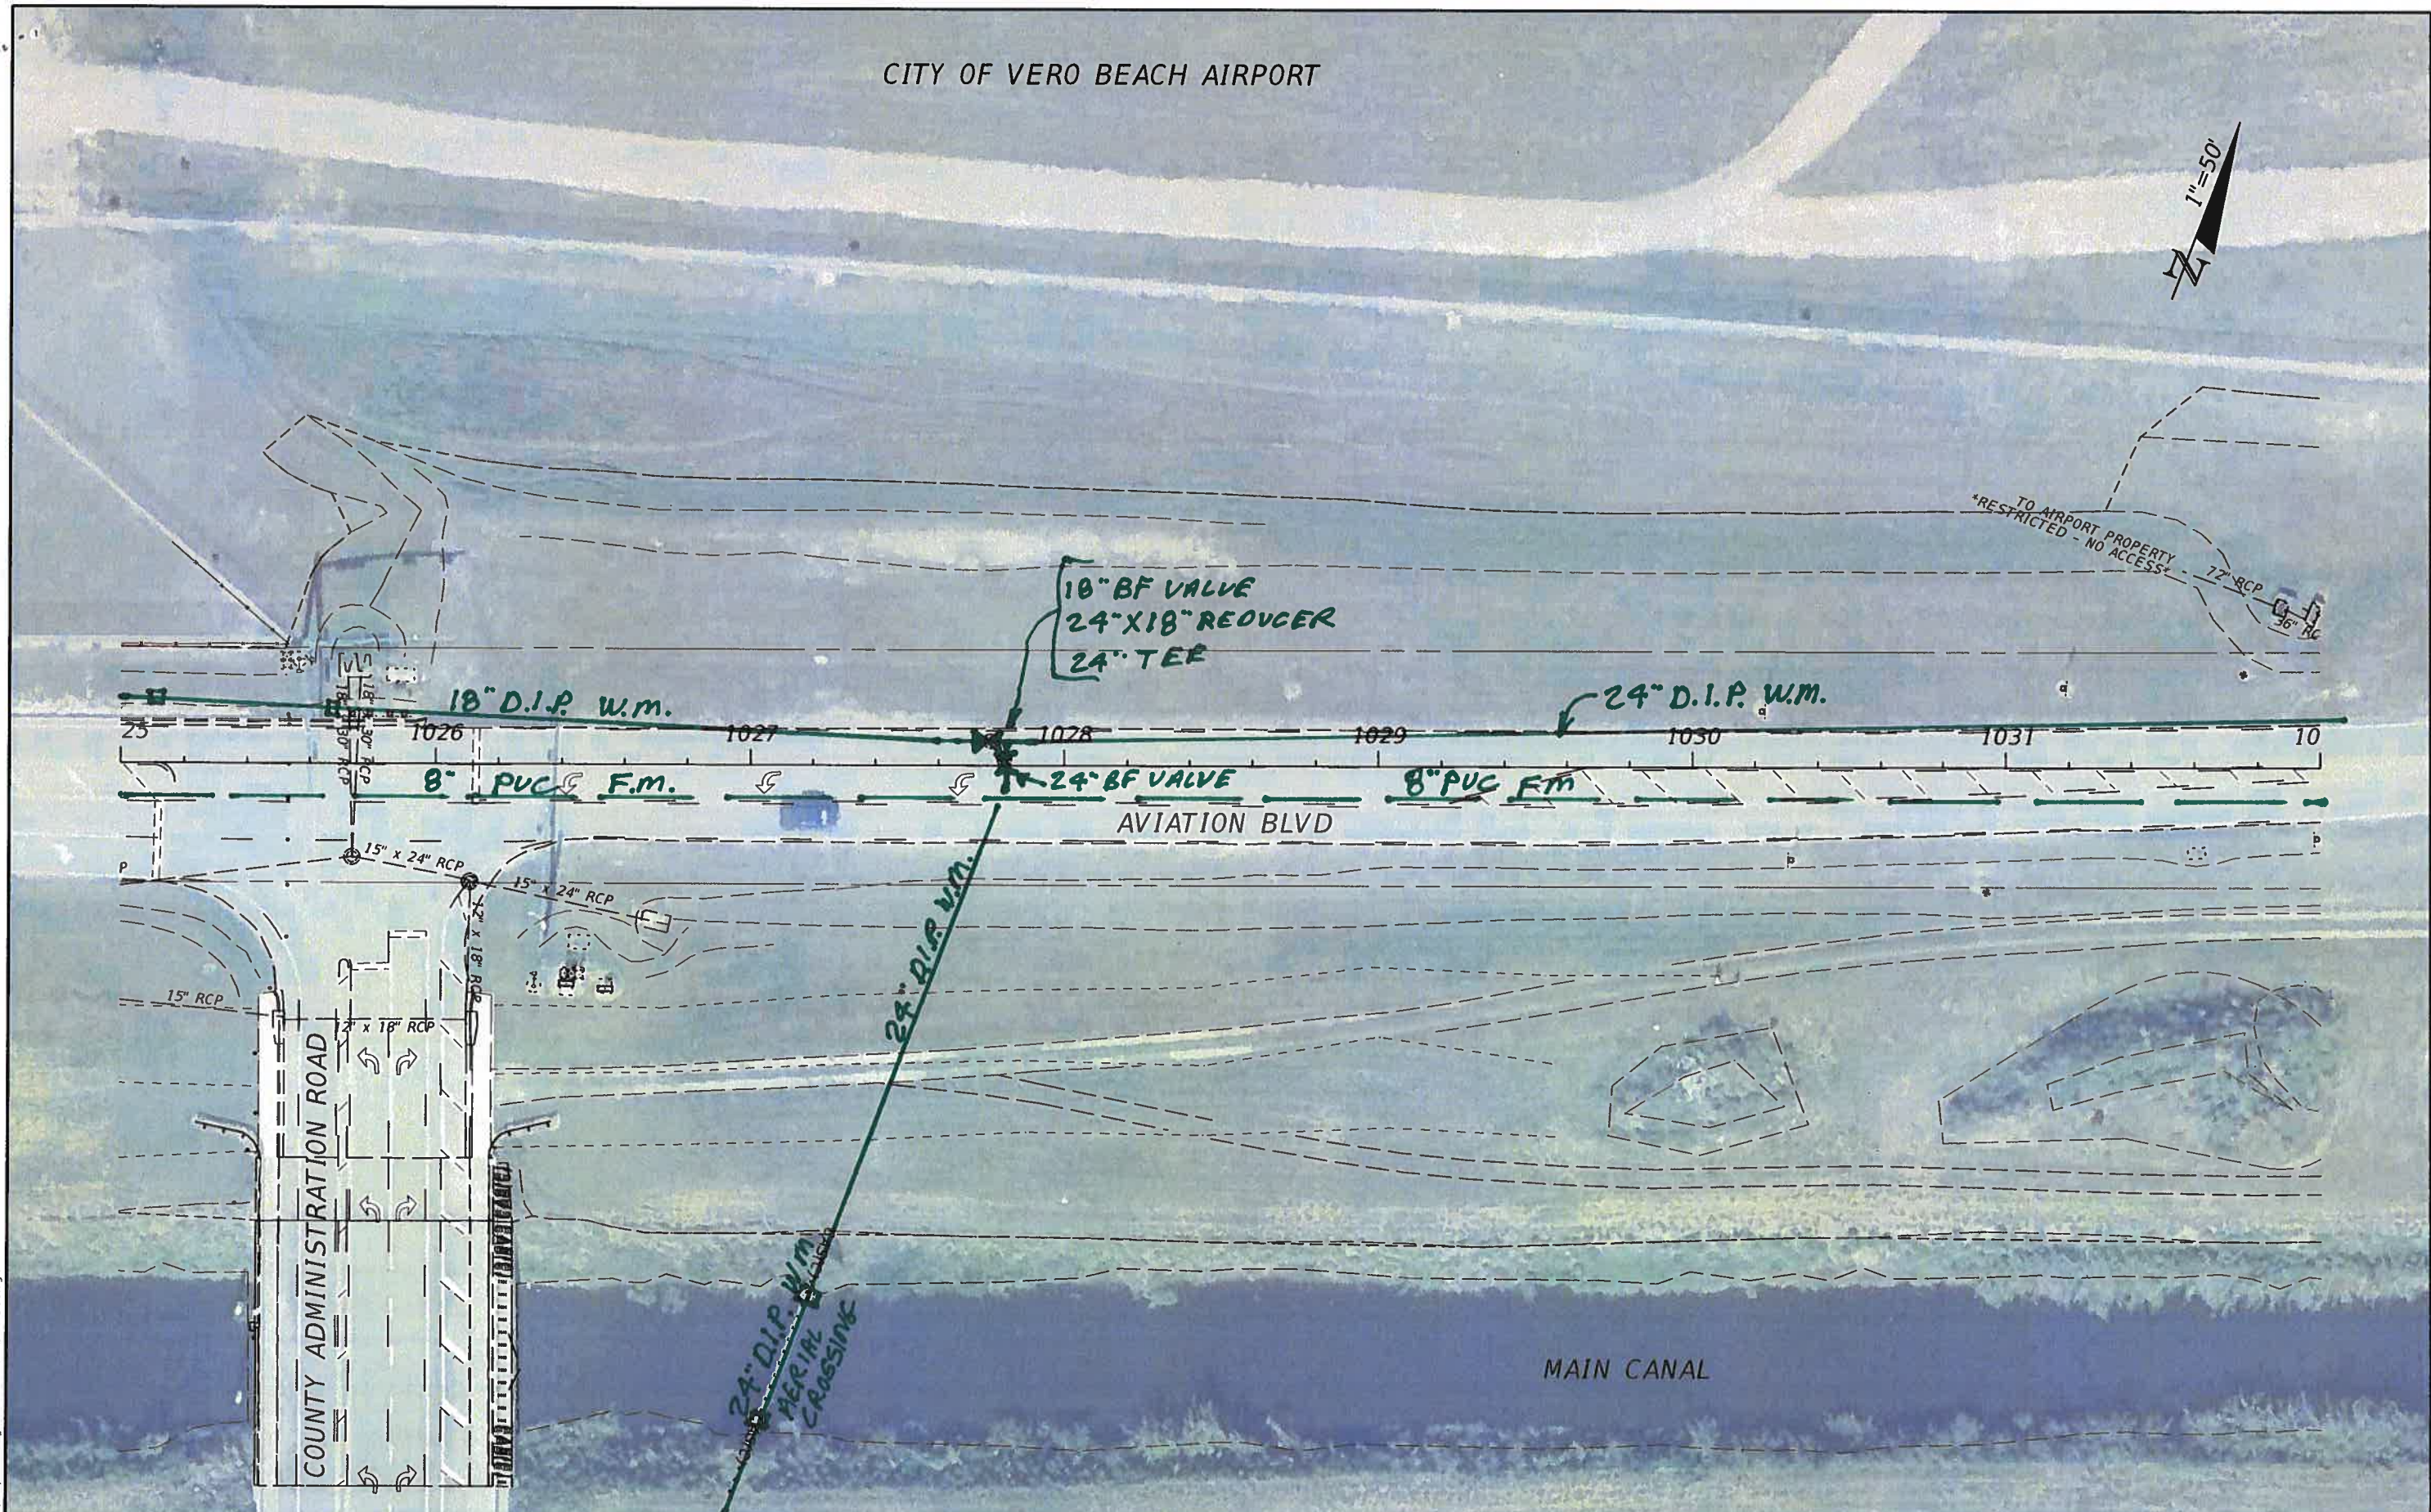

9/15/2022 11:09:17 AM jacquelyn.arcoaga  
c:\pwworking\wgi\jacquelyn.arcoaga\d2198192\PLANR001.dgn


THE OFFICIAL RECORD OF THIS SHEET IS THE ELECTRONIC FILE DIGITALLY SIGNED AND SEALED UNDER RULE 61G15-23.004, F.A.C.

REVISIONS		PROFESSIONAL TYPE		STATE OF FLORIDA DEPARTMENT OF TRANSPORTATION			SHEET NO.
DATE	DESCRIPTION	DATE	DESCRIPTION	ROAD NO.	COUNTY	FINANCIAL PROJECT ID	
				SR 5	INDIAN RIVER	441693-1-22-02	25

**UTILITY CONTACT PLAN (25)**

WILLIAM EVANS  
LICENSE NUMBER: 45207  
WGI, INC.  
2035 VISTA PARKWAY  
WEST PALM BEACH, FL 33411

CITY OF VERO BEACH AIRPORT

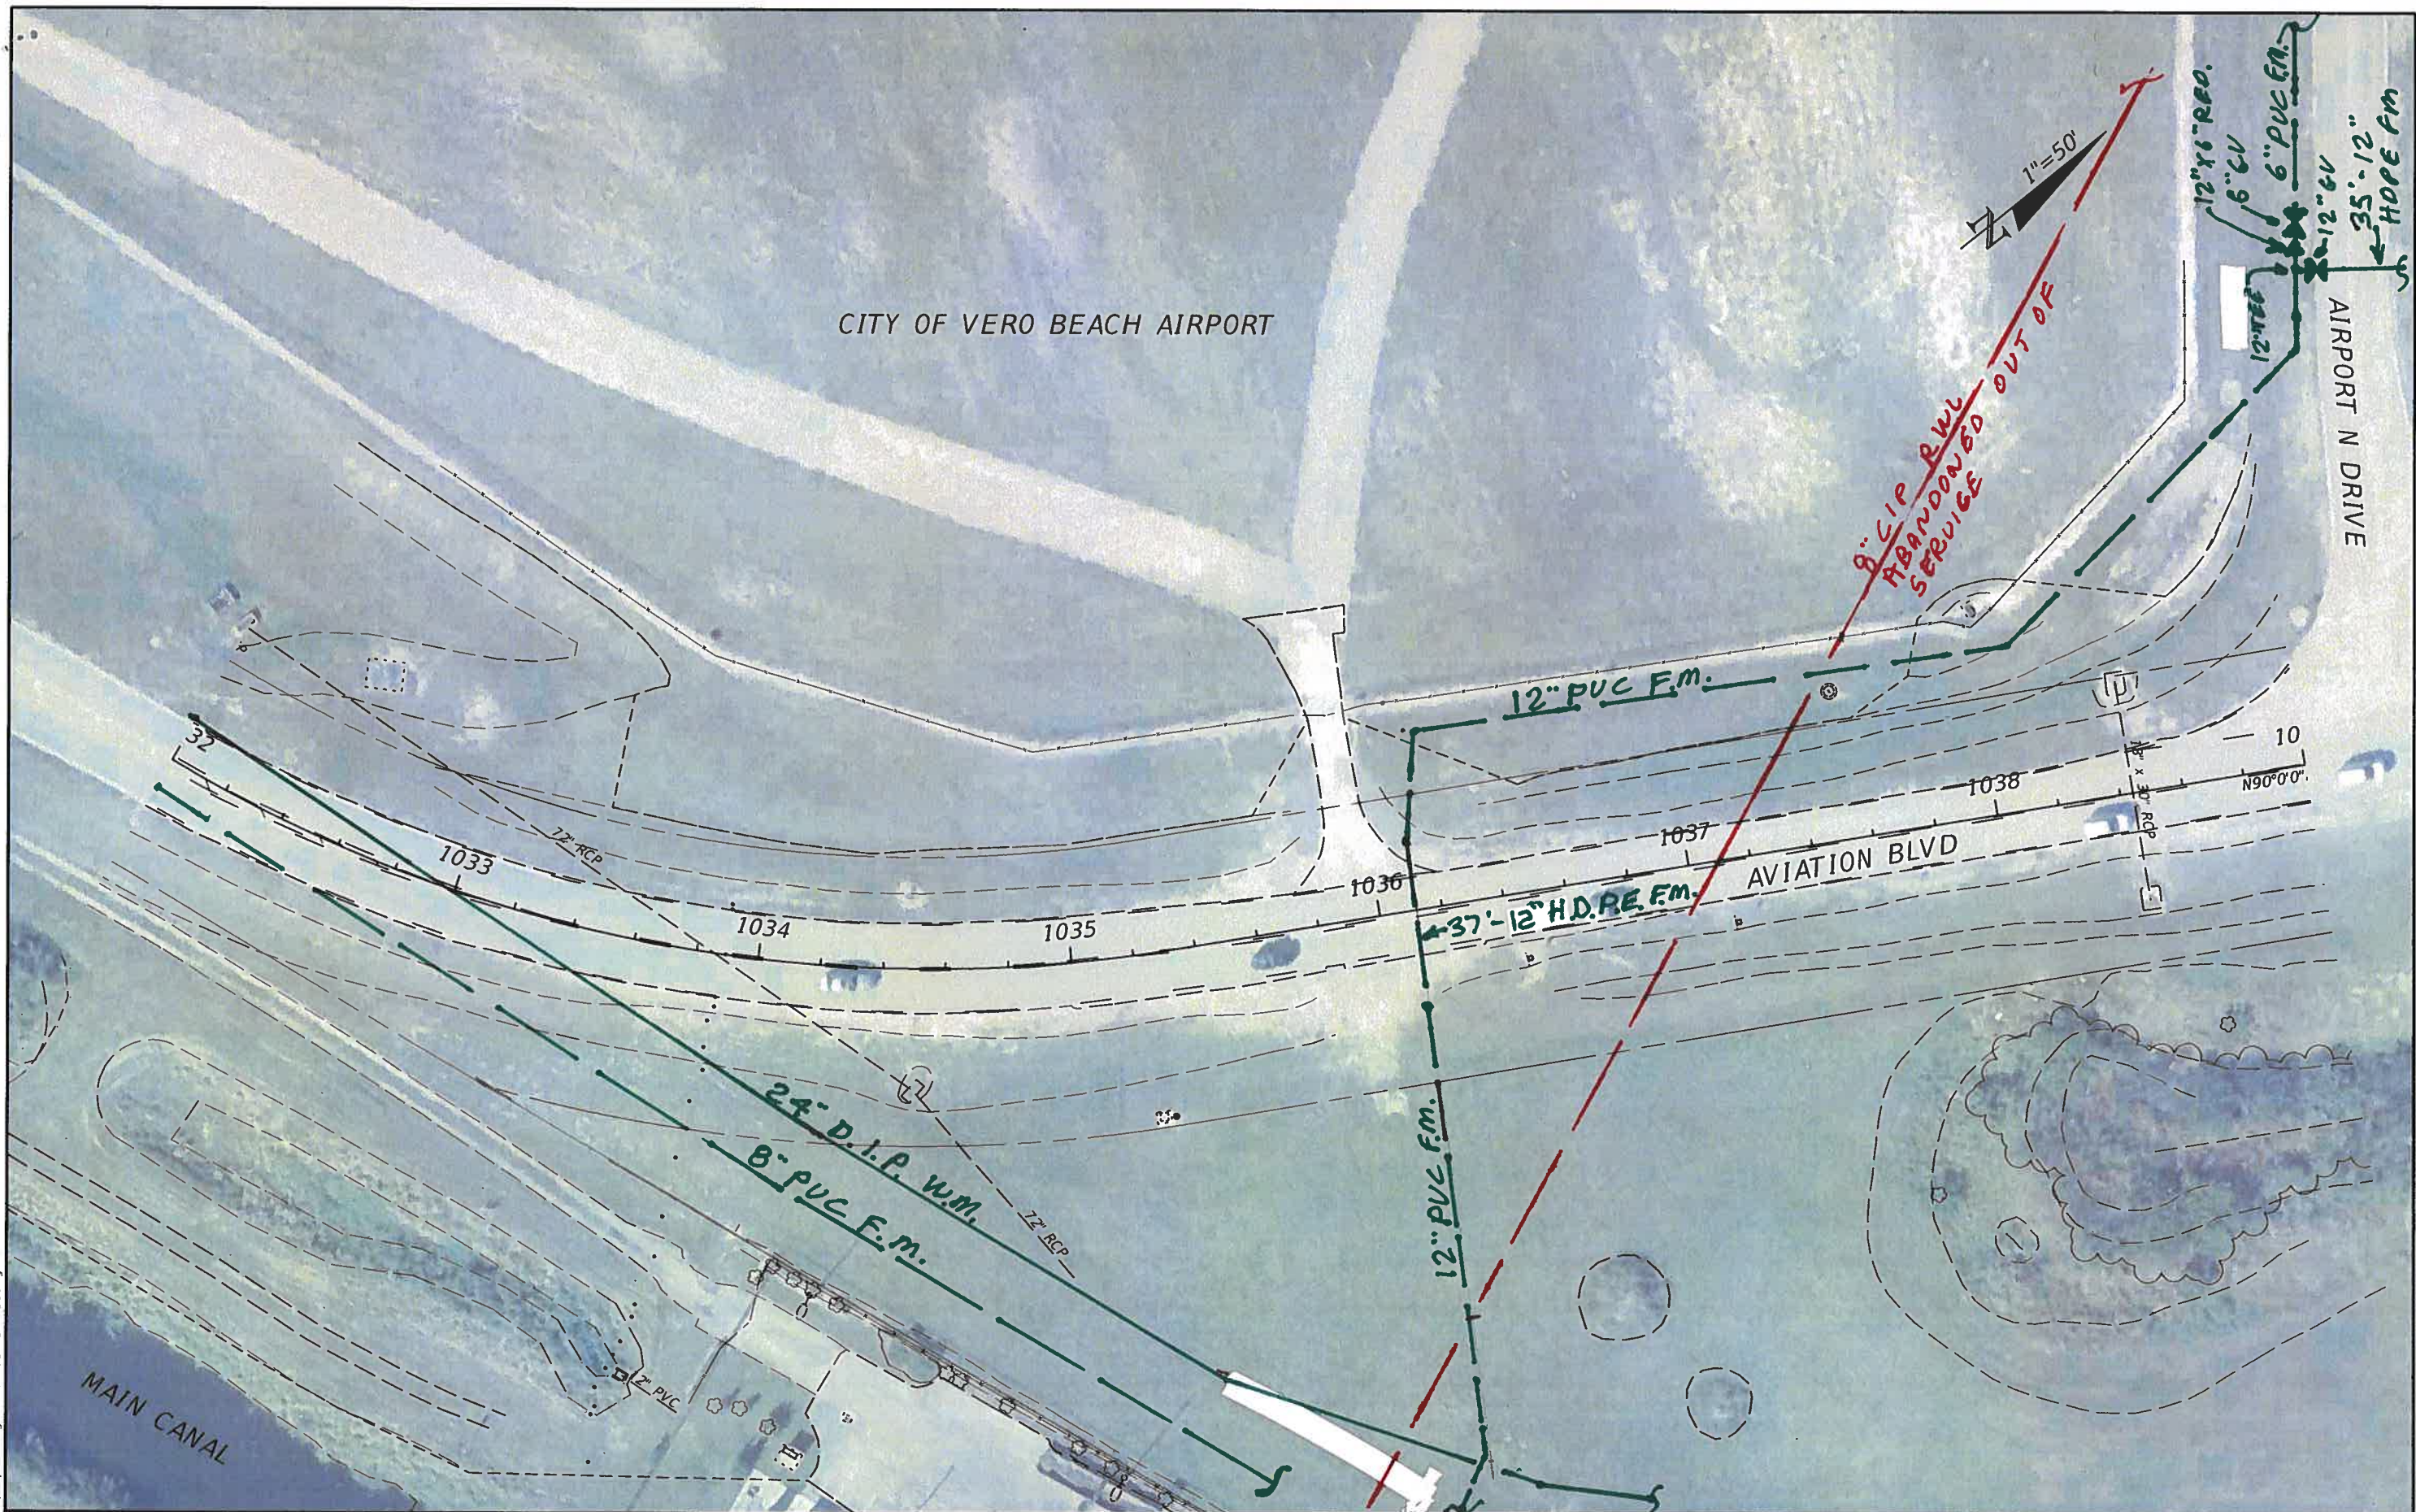

8\"/>



12\"/>

AIRPORT N DRIVE

AVIATION BLVD

MAIN CANAL


9/15/2022 11:09:30 AM Jacquelyn.Arrcaga  
 C:\pwworking\wgn\jacquelyn.arrcaga\d2198192\PLANRDO1.dgn

REVISIONS		PROFESSIONAL TYPE		STATE OF FLORIDA DEPARTMENT OF TRANSPORTATION			UTILITY CONTACT PLAN (26)	SHEET NO.  26
DATE	DESCRIPTION	DATE	DESCRIPTION	ROAD NO.	COUNTY	FINANCIAL PROJECT ID		
				SR 5	INDIAN RIVER	441693-1-22-02		

WILLIAM EVANS  
 LICENSE NUMBER: 45207  
 WGI, INC.  
 2035 VISTA PARKWAY  
 WEST PALM BEACH, FL 33411

THE OFFICIAL RECORD OF THIS SHEET IS THE ELECTRONIC FILE DIGITALLY SIGNED AND SEALED UNDER RULE 61G15-23.004, F.A.C.

CITY OF VERO BEACH AIRPORT

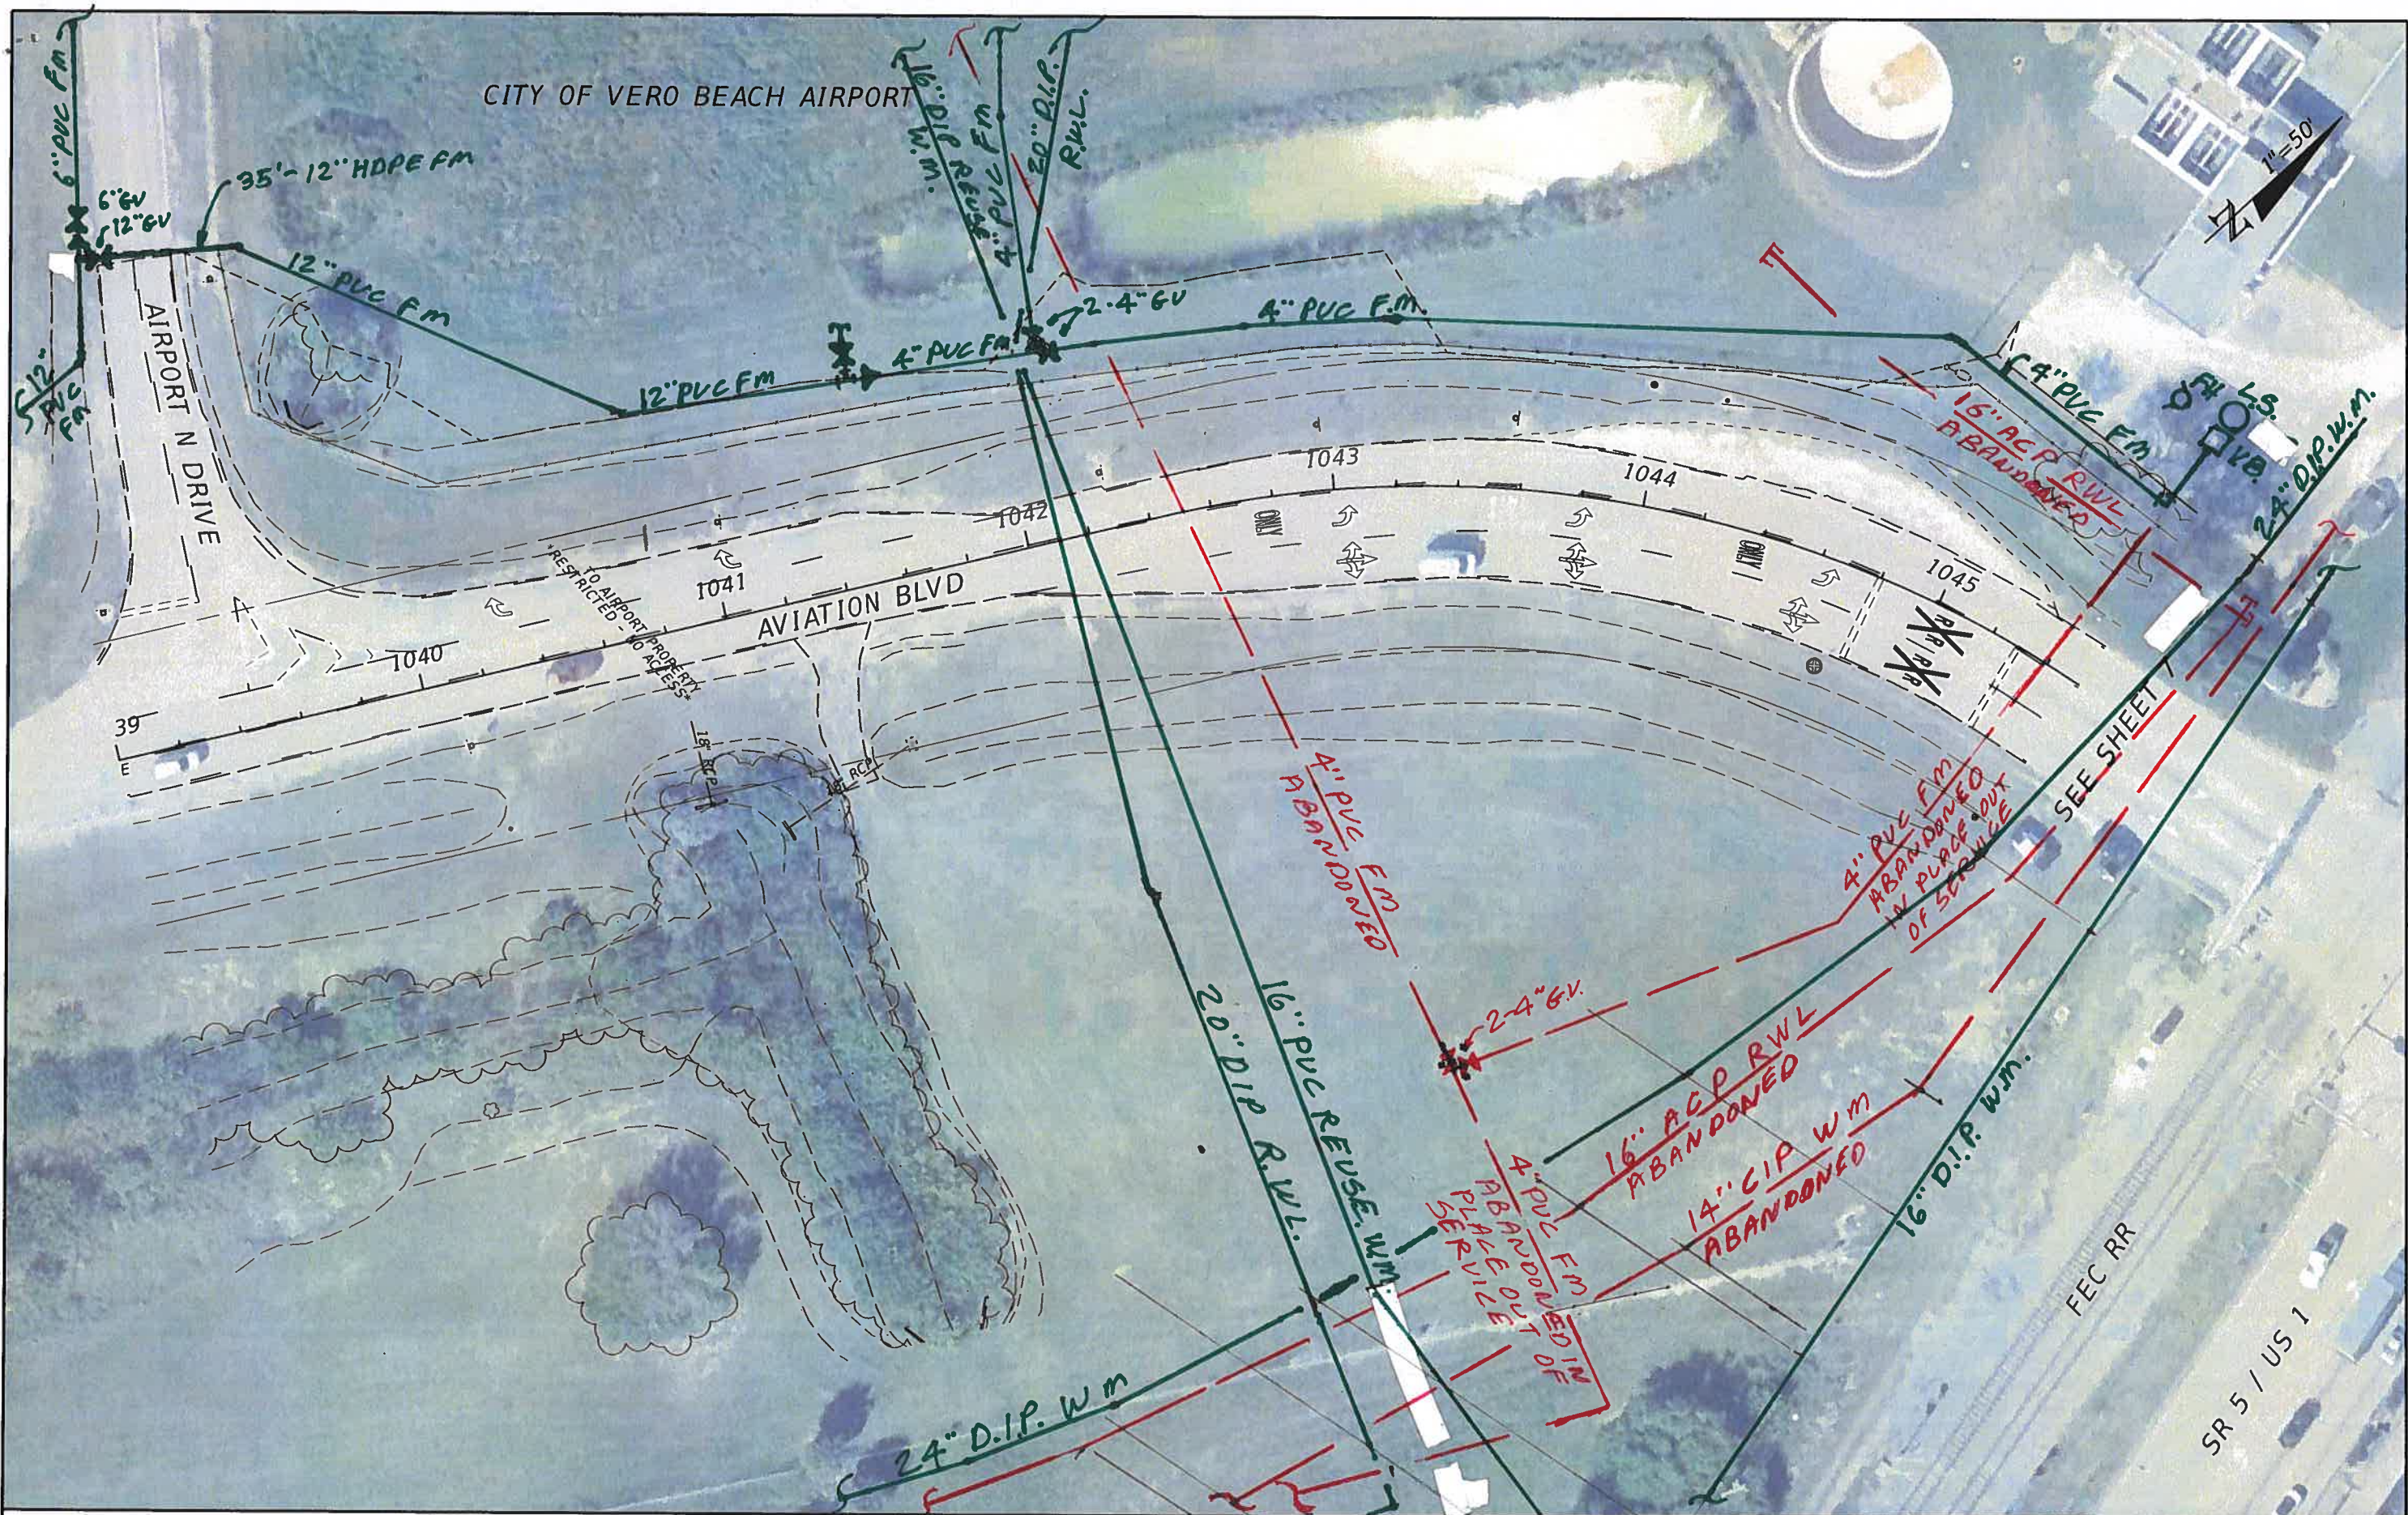

9/15/2022 11:09:43 AM jacquelyn.arraaga c:\pwworking\wg\jacquelyn.arraaga\2198192\PLANR001.dgn

REVISIONS		PROFESSIONAL TYPE		STATE OF FLORIDA DEPARTMENT OF TRANSPORTATION			SHEET NO.
DATE	DESCRIPTION	DATE	DESCRIPTION	ROAD NO.	COUNTY	FINANCIAL PROJECT ID	
				SR 5	INDIAN RIVER	441603-1-22-02	27

**UTILITY CONTACT PLAN (27)**


THE OFFICIAL RECORD OF THIS SHEET IS THE ELECTRONIC FILE DIGITALLY SIGNED AND SEALED UNDER RULE 61G15-23.004, F.A.C.



**Appendices**

**Appendix D**

**Comcast**

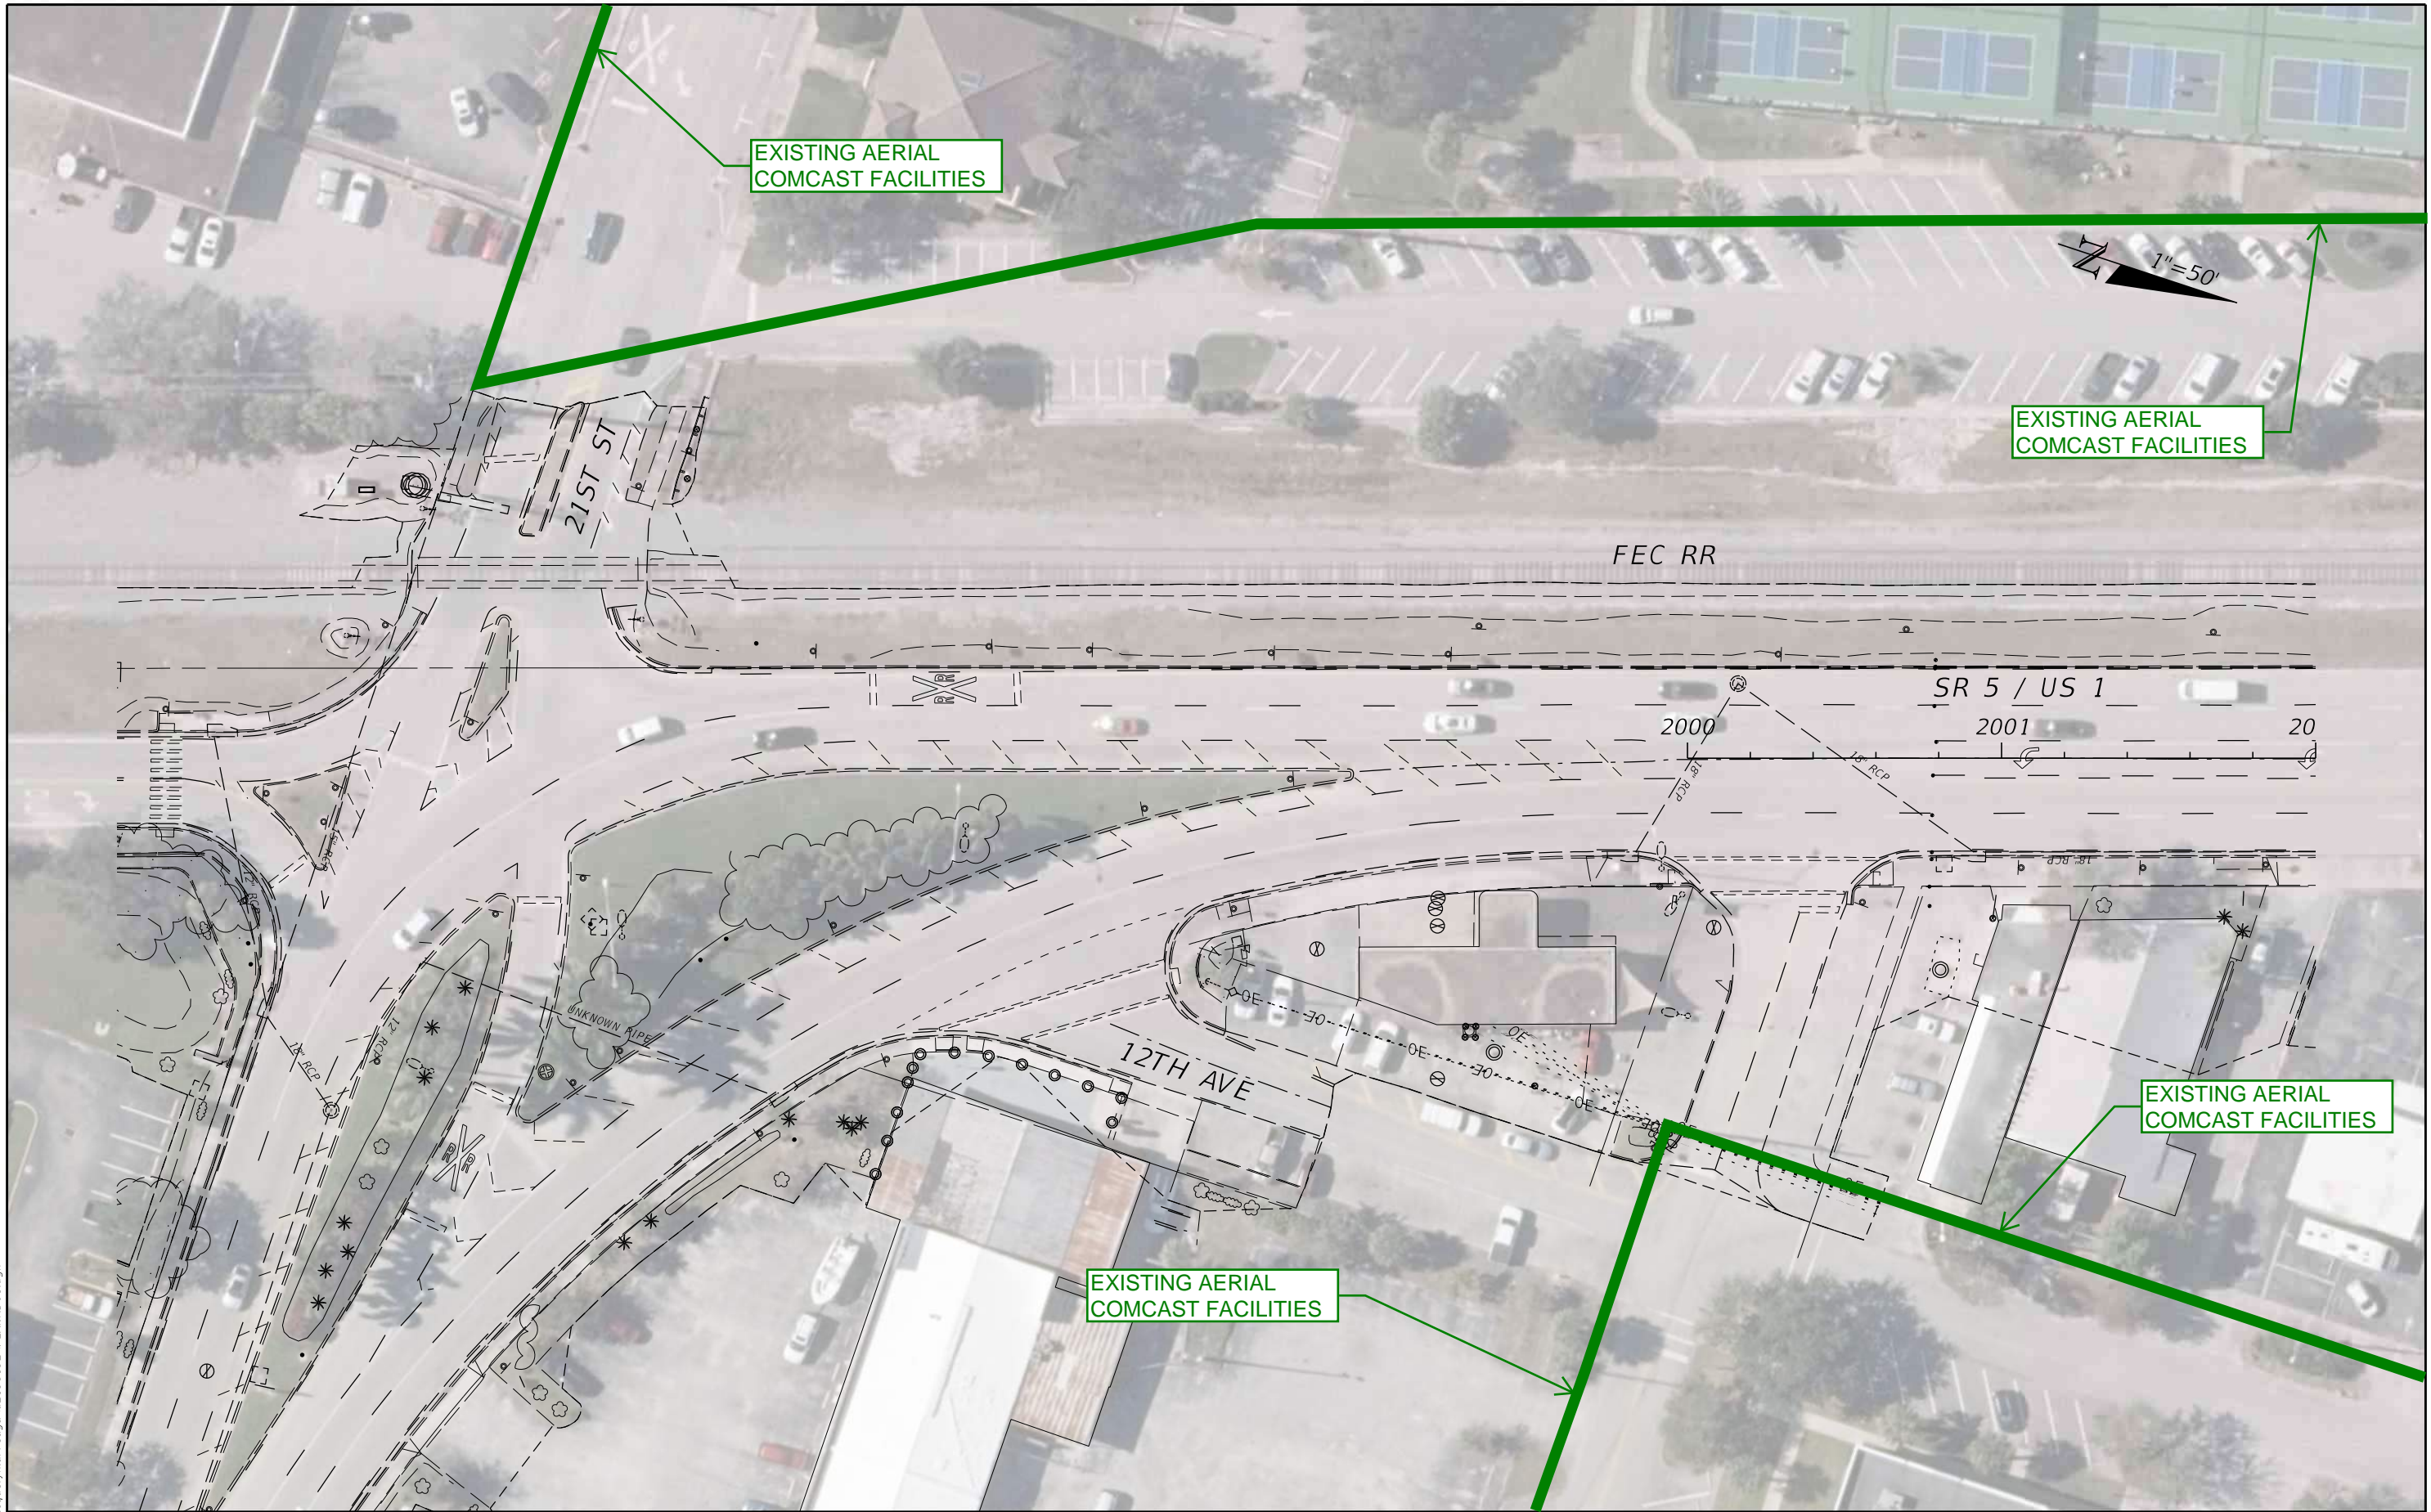

9/15/2022 10:58:52 AM Jacquelyn.Arreaga  
 c:\pwworking\wgn\jacquelyn.arreaga\d2198192\PLAN\RD01.dgn

REVISIONS	
DATE	DESCRIPTION


**PROFESSIONAL TYPE**  
 WILLIAM EVANS  
 LICENSE NUMBER: 45207  
 WGI, INC.  
 2035 VISTA PARKWAY  
 WEST PALM BEACH, FL 33411

STATE OF FLORIDA DEPARTMENT OF TRANSPORTATION		
ROAD NO.	COUNTY	FINANCIAL PROJECT ID
SR 5	INDIAN RIVER	441693-1-22-02

**UTILITY CONTACT PLAN (1)**

**SHEET NO.**  
 1


THE OFFICIAL RECORD OF THIS SHEET IS THE ELECTRONIC FILE DIGITALLY SIGNED AND SEALED UNDER RULE 61G15-23.004, F.A.C.

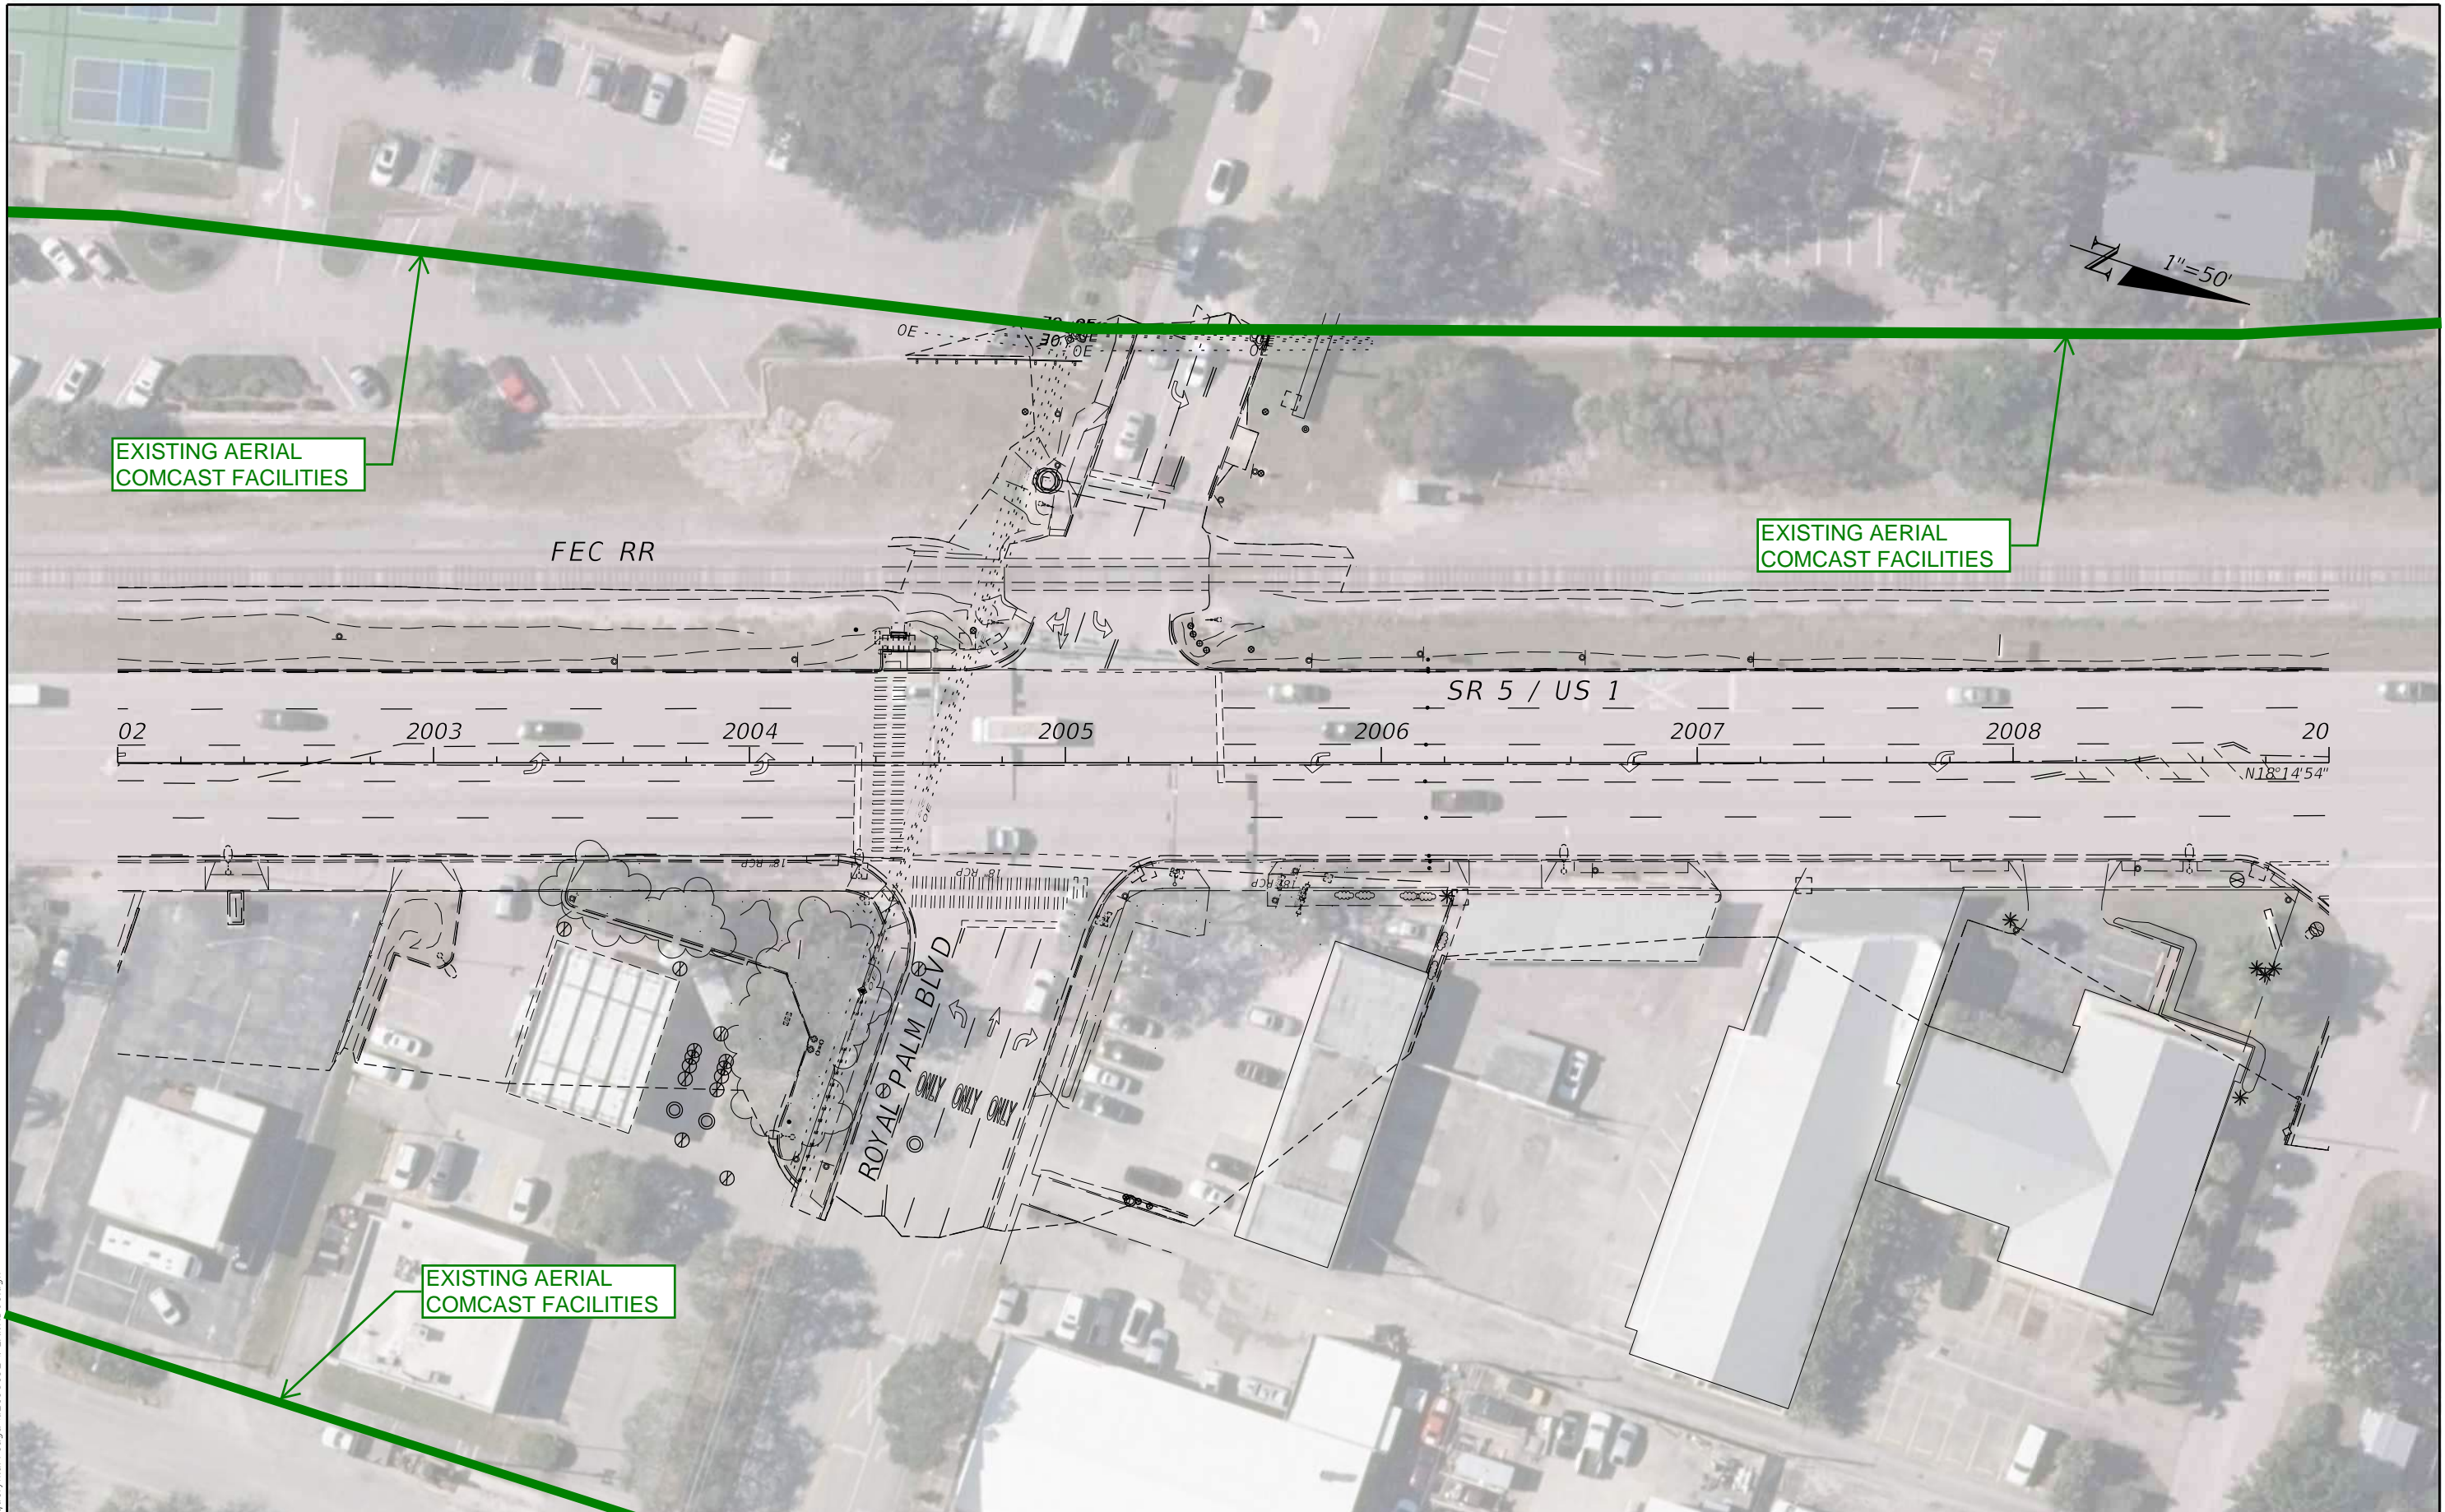

EXISTING AERIAL  
COMCAST FACILITIES

EXISTING AERIAL  
COMCAST FACILITIES

EXISTING AERIAL  
COMCAST FACILITIES

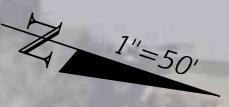


9/15/2022 10:59:58 AM Jacquelyn.Arreaga c:\pwworking\wgn\jacquelyn.arreaga\d2198192\PLANRD01.dgn

REVISIONS				PROFESSIONAL TYPE	STATE OF FLORIDA DEPARTMENT OF TRANSPORTATION			SHEET NO.
DATE	DESCRIPTION	DATE	DESCRIPTION		ROAD NO.	COUNTY	FINANCIAL PROJECT ID	
				WILLIAM EVANS LICENSE NUMBER: 45207 WGI, INC. 2035 VISTA PARKWAY WEST PALM BEACH, FL 33411	SR 5	INDIAN RIVER	441693-1-22-02	2

**UTILITY CONTACT PLAN (2)**

THE OFFICIAL RECORD OF THIS SHEET IS THE ELECTRONIC FILE DIGITALLY SIGNED AND SEALED UNDER RULE 61G15-23.004, F.A.C.

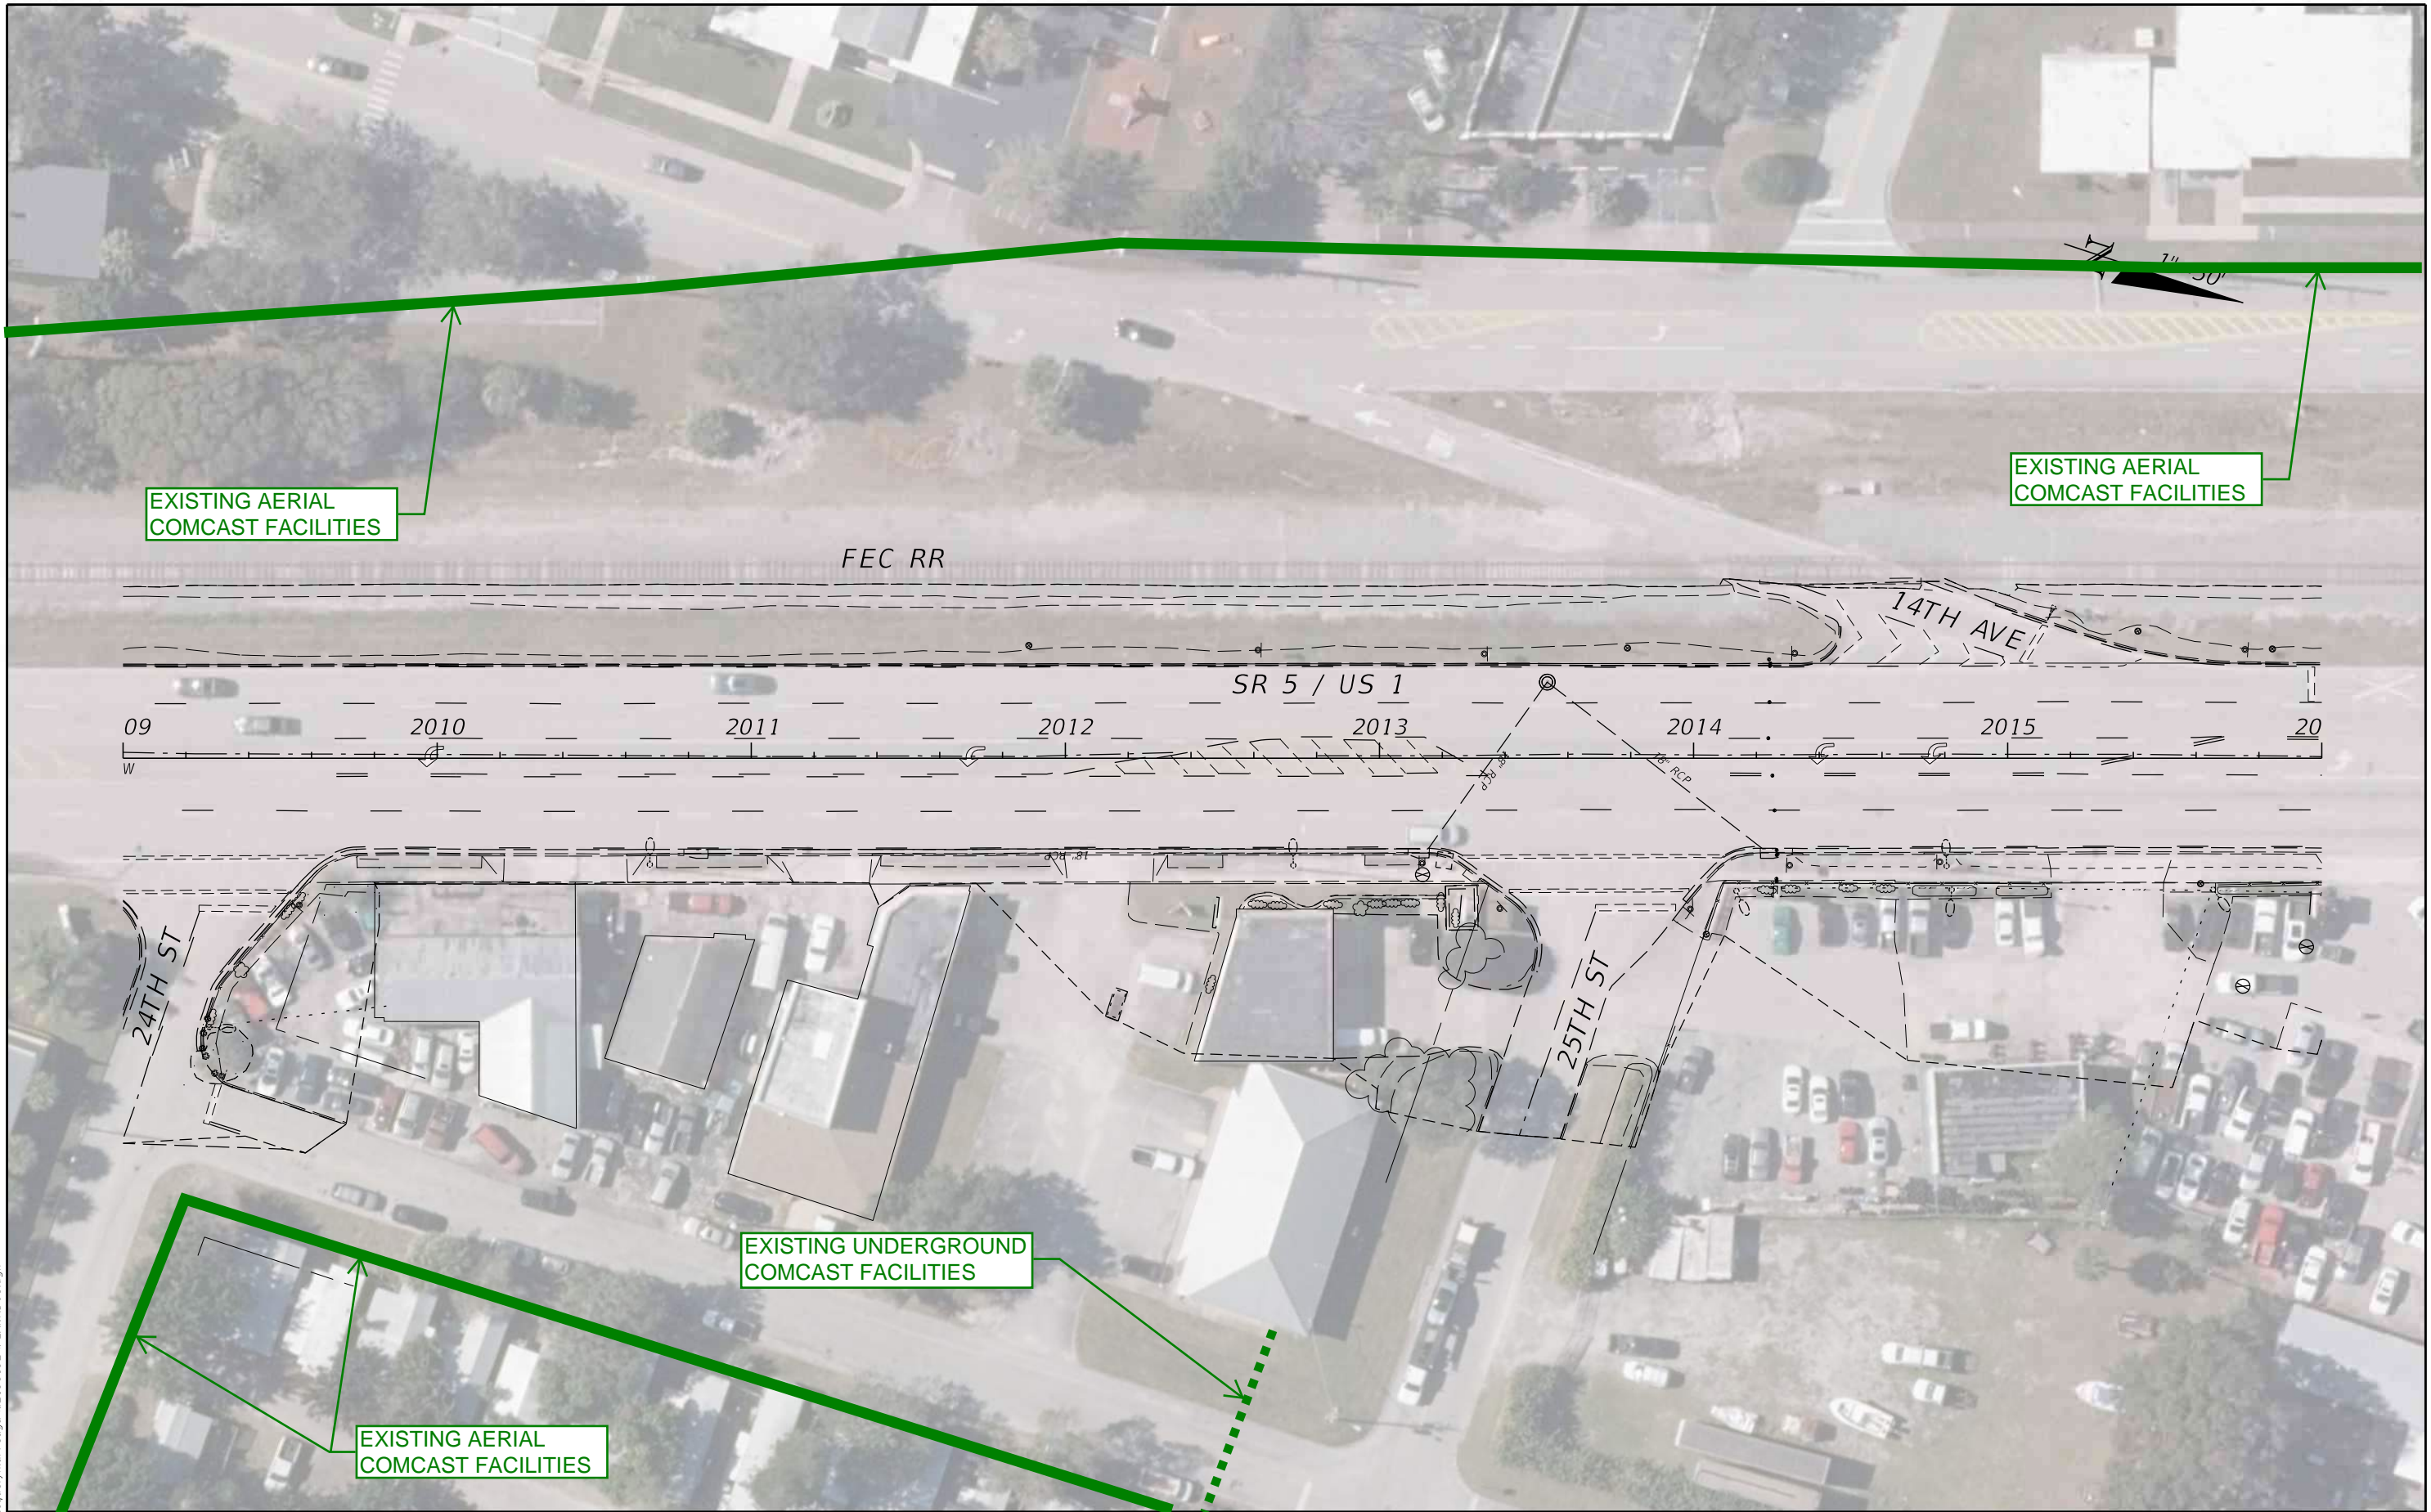


9/15/2022 11:00:13 AM Jacquelyn.Arreaga c:\pwworking\wg\N\Jacquelyn.arreaga\d2198192\PLAN\RD01.dgn

THE OFFICIAL RECORD OF THIS SHEET IS THE ELECTRONIC FILE DIGITALLY SIGNED AND SEALED UNDER RULE 61G15-23.004, F.A.C.

DATE		REVISIONS		PROFESSIONAL TYPE		STATE OF FLORIDA DEPARTMENT OF TRANSPORTATION			SHEET NO.
DATE	DESCRIPTION	DATE	DESCRIPTION			ROAD NO.	COUNTY	FINANCIAL PROJECT ID	
				WILLIAM EVANS LICENSE NUMBER: 45207 WGI, INC. 2035 VISTA PARKWAY WEST PALM BEACH, FL 33411		SR 5	INDIAN RIVER	441693-1-22-02	3


**UTILITY CONTACT PLAN (3)**

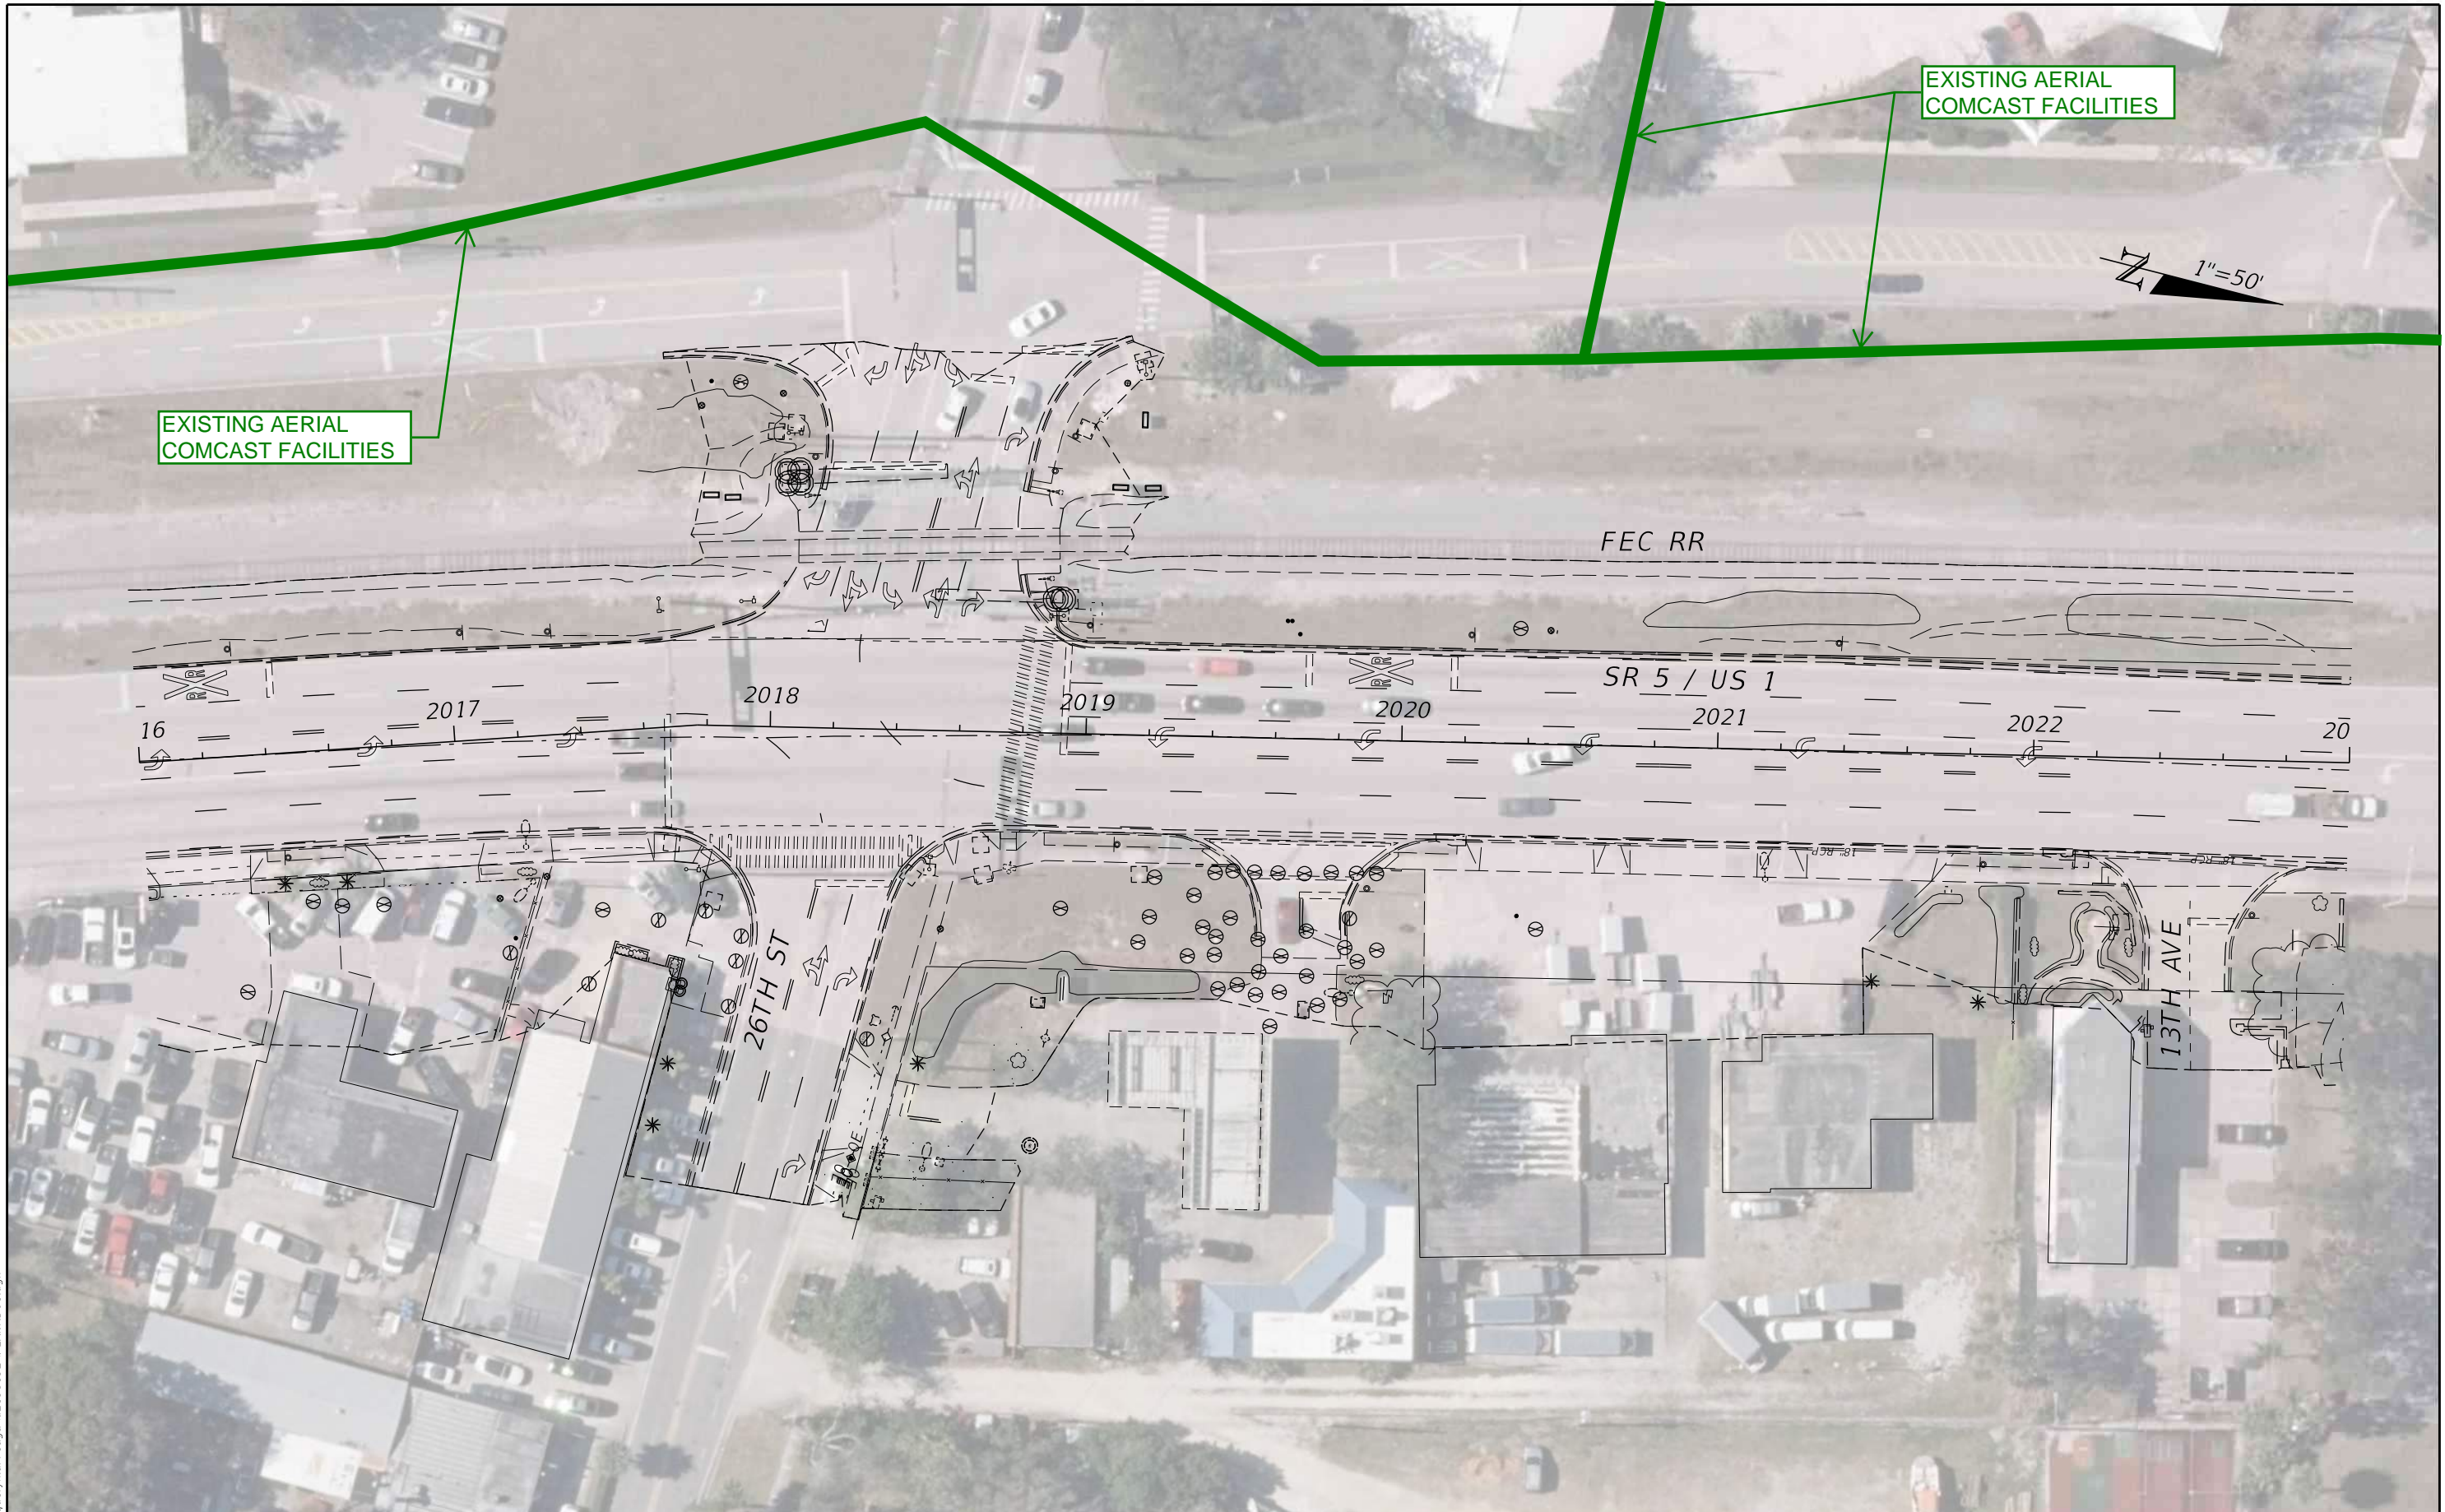

9/15/2022 11:00:42 AM Jacquelyn.Arreaga  
 c:\pwworking\wgn\jacquelyn.arreaga\d2198192\PLANRD01.dgn

REVISIONS		PROFESSIONAL TYPE		STATE OF FLORIDA DEPARTMENT OF TRANSPORTATION			SHEET NO.
DATE	DESCRIPTION	DATE	DESCRIPTION	ROAD NO.	COUNTY	FINANCIAL PROJECT ID	
				SR 5	INDIAN RIVER	441693-1-22-02	4
				<b>UTILITY CONTACT PLAN (4)</b>			

THE OFFICIAL RECORD OF THIS SHEET IS THE ELECTRONIC FILE DIGITALLY SIGNED AND SEALED UNDER RULE 61G15-23.004, F.A.C.

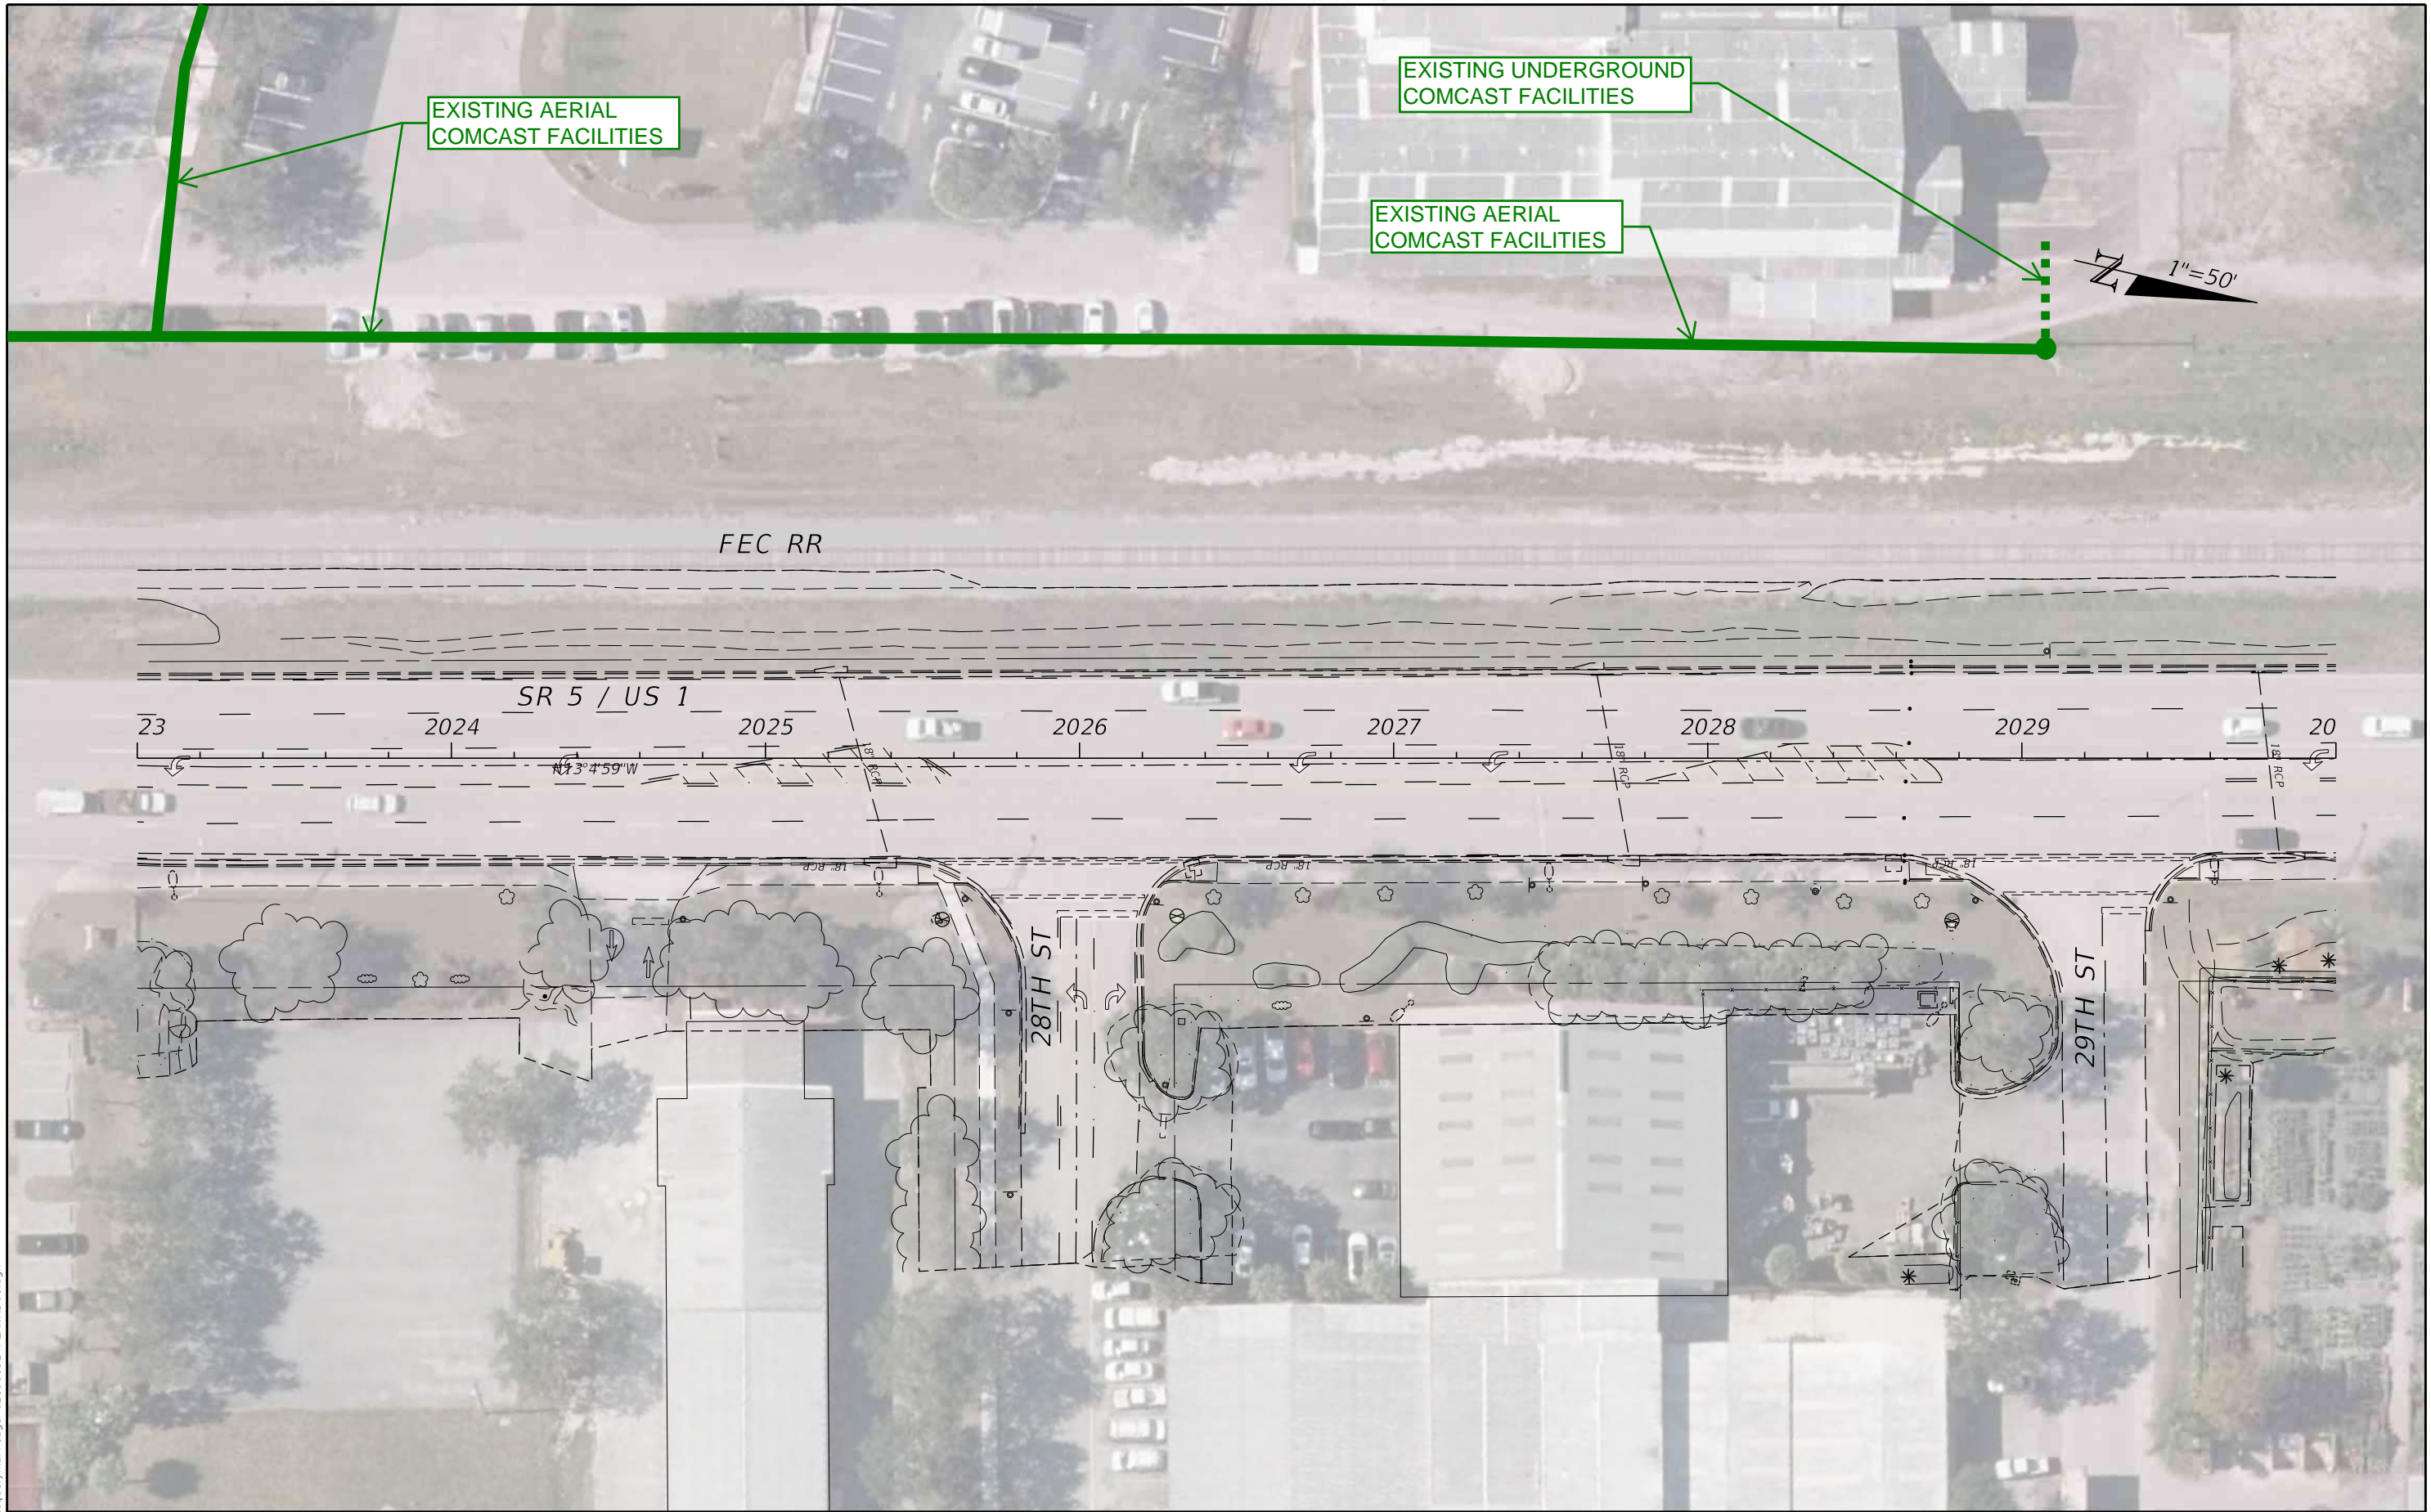


9/15/2022 11:00:51 AM Jacquelyn.Arreaga  
 c:\pwworking\wgn\jacquelyn.arreaga\d2198192\PLANRD01.dgn

REVISIONS				PROFESSIONAL TYPE	STATE OF FLORIDA DEPARTMENT OF TRANSPORTATION			SHEET NO.
DATE	DESCRIPTION	DATE	DESCRIPTION		ROAD NO.	COUNTY	FINANCIAL PROJECT ID	
				WILLIAM EVANS LICENSE NUMBER: 45207 WGI, INC. 2035 VISTA PARKWAY WEST PALM BEACH, FL 33411	SR 5	INDIAN RIVER	441693-1-22-02	5

**UTILITY CONTACT PLAN (5)**


THE OFFICIAL RECORD OF THIS SHEET IS THE ELECTRONIC FILE DIGITALLY SIGNED AND SEALED UNDER RULE 61G15-23.004, F.A.C.

CITY OF VERO BEACH AIRPORT

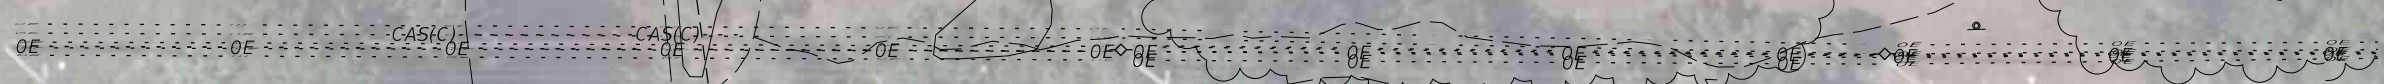

FEC RR

NO COMCAST FACILITIES

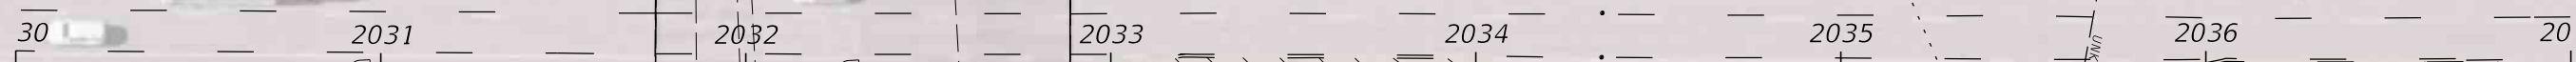

NO COMCAST FACILITIES

MAIN CANAL

30TH ST ONLY

31ST ST


EXISTING AERIAL COMCAST FACILITIES

9/15/2022 11:01:04 AM Jacquelyn.Arreaga c:\pwworking\wgn\jacquelyn.arreaga\d2198192\PLANRD01.dgn

REVISIONS		PROFESSIONAL TYPE		STATE OF FLORIDA DEPARTMENT OF TRANSPORTATION			UTILITY CONTACT PLAN (6)	SHEET NO. 6
DATE	DESCRIPTION	DATE	DESCRIPTION	ROAD NO.	COUNTY	FINANCIAL PROJECT ID		
				SR 5	INDIAN RIVER	441693-1-22-02		

WILLIAM EVANS  
LICENSE NUMBER: 45207  
WGI, INC.  
2035 VISTA PARKWAY  
WEST PALM BEACH, FL 33411

THE OFFICIAL RECORD OF THIS SHEET IS THE ELECTRONIC FILE DIGITALLY SIGNED AND SEALED UNDER RULE 61G15-23.004, F.A.C.

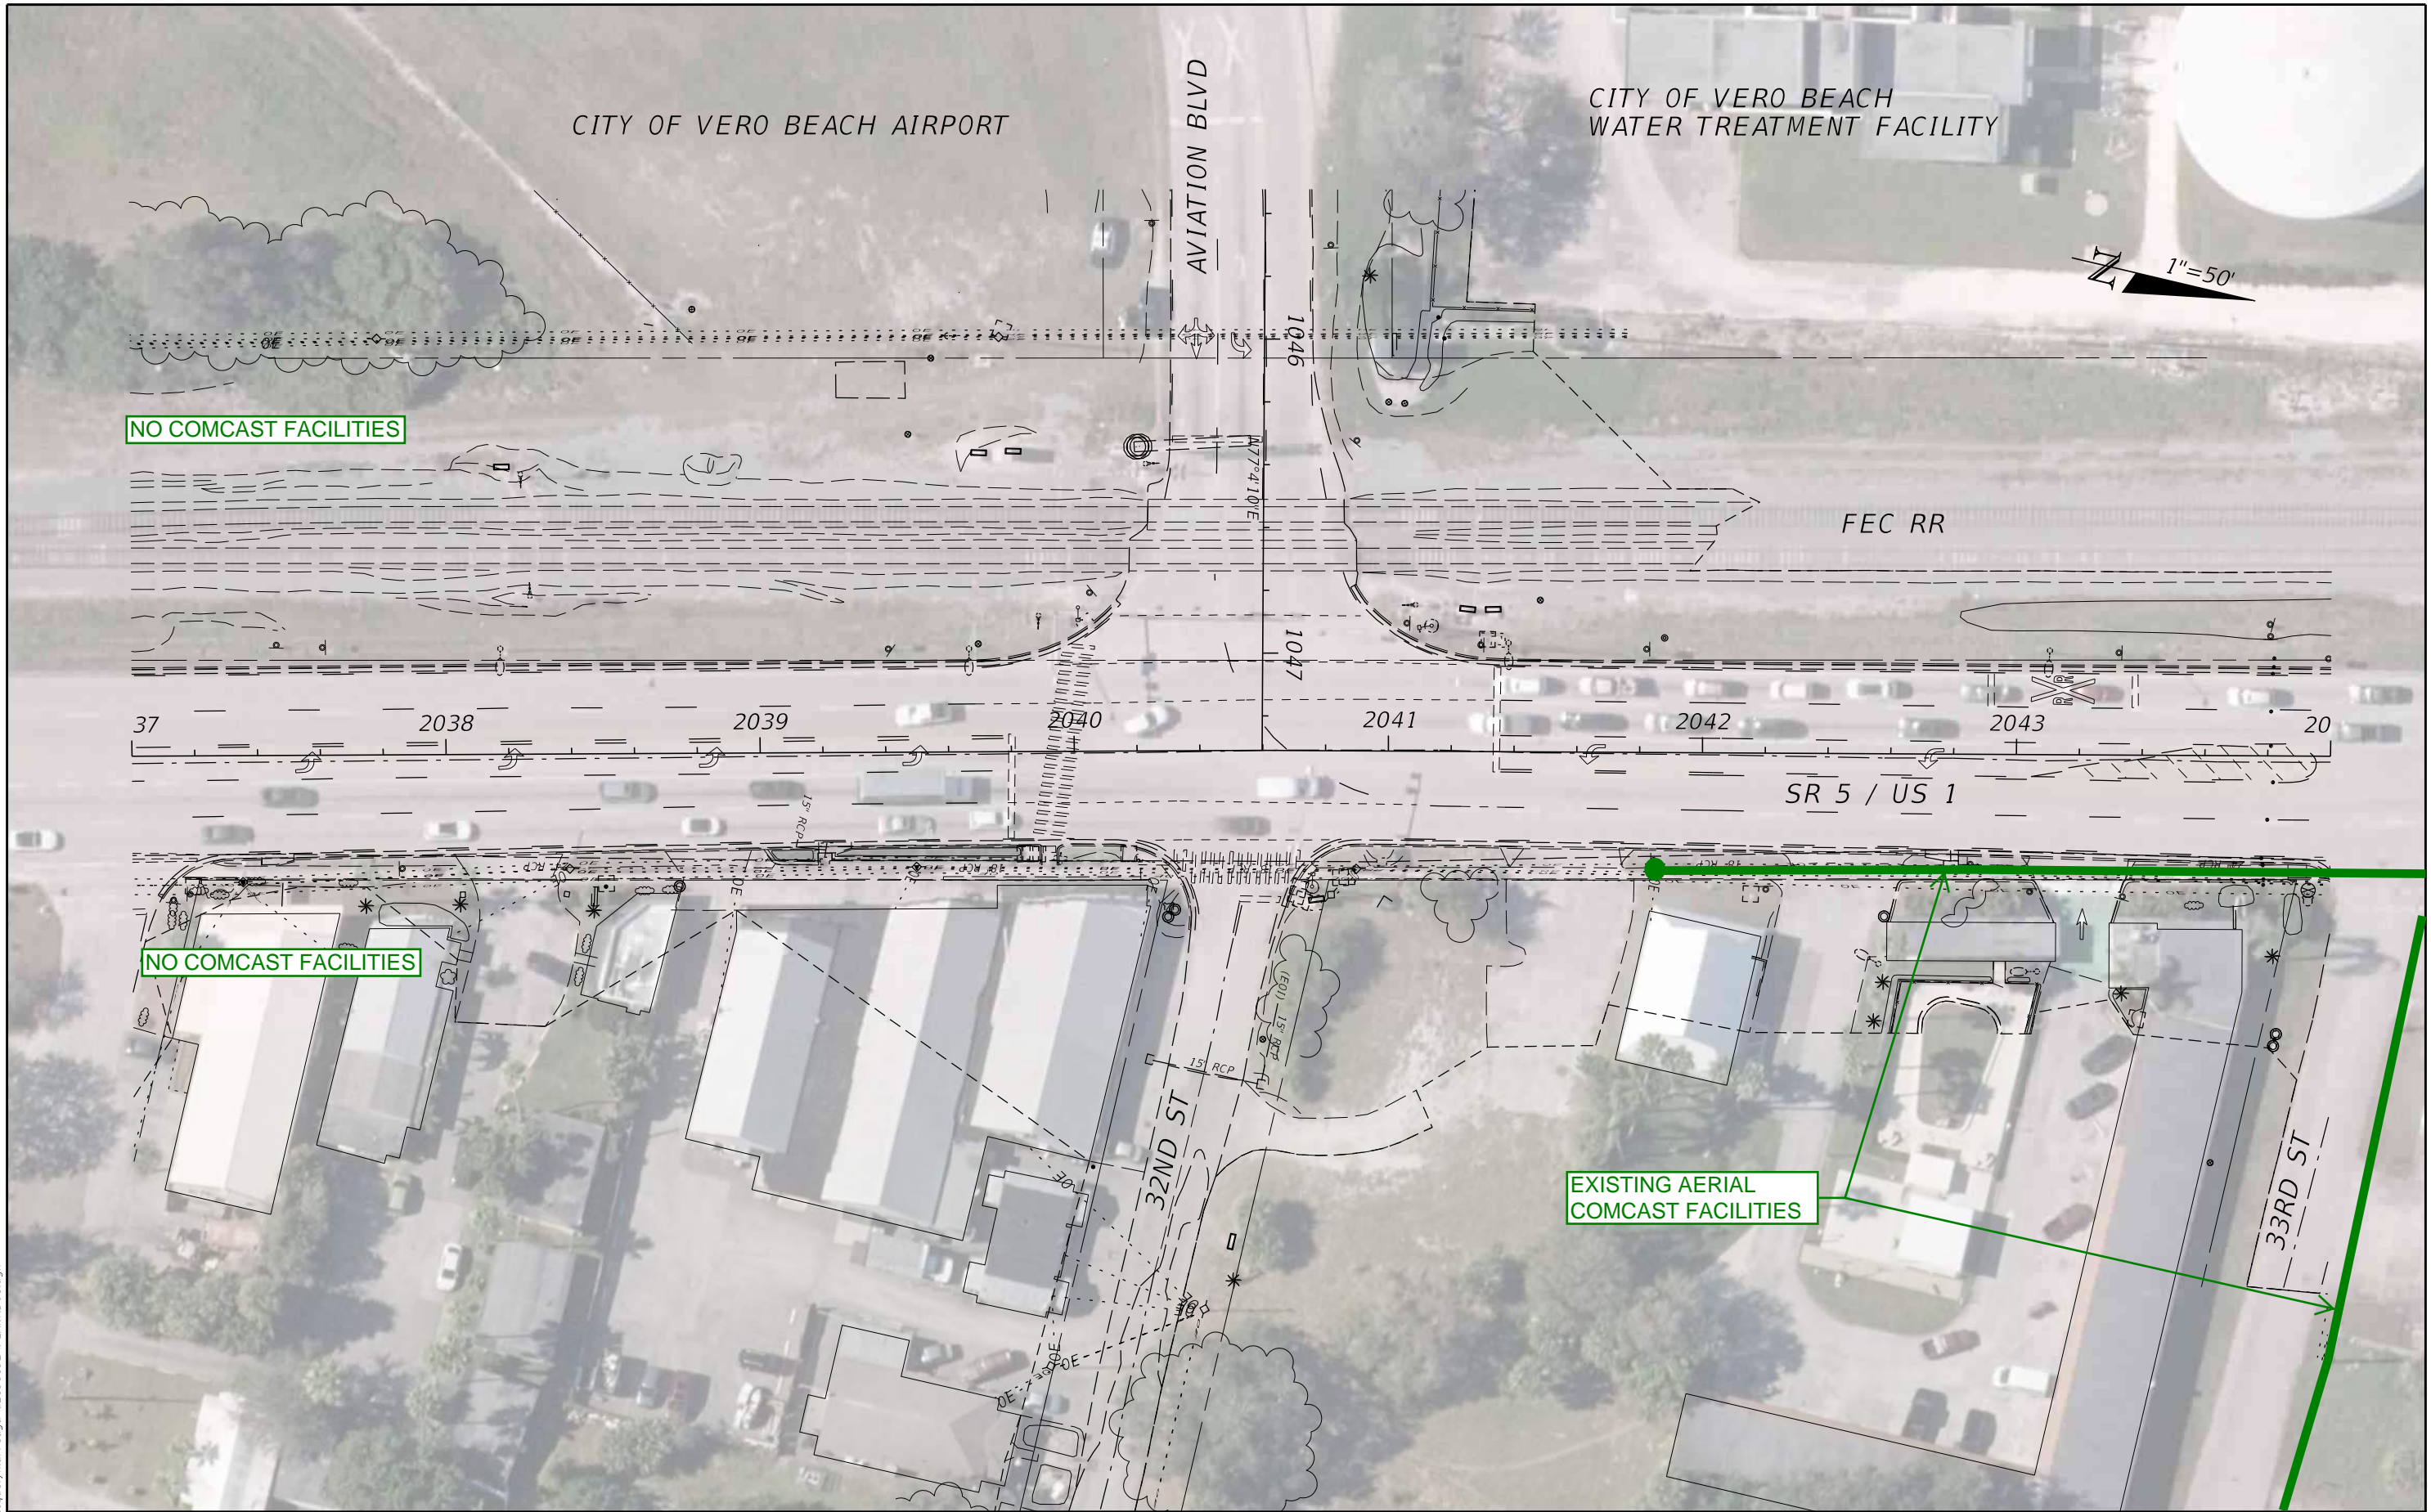

NO COMCAST FACILITIES

NO COMCAST FACILITIES

EXISTING AERIAL COMCAST FACILITIES

9/15/2022 11:01:42 AM Jacquelyn.Arreaga c:\pwworking\wg\Jacquelyn.arreaga\d2198192\PLANRD01.dgn

REVISIONS		PROFESSIONAL TYPE		STATE OF FLORIDA DEPARTMENT OF TRANSPORTATION			UTILITY CONTACT PLAN (7)	SHEET NO. 7
DATE	DESCRIPTION	DATE	DESCRIPTION	ROAD NO.	COUNTY	FINANCIAL PROJECT ID		
				SR 5	INDIAN RIVER	441693-1-22-02		

WILLIAM EVANS  
LICENSE NUMBER: 45207  
WGI, INC.  
2035 VISTA PARKWAY  
WEST PALM BEACH, FL 33411

THE OFFICIAL RECORD OF THIS SHEET IS THE ELECTRONIC FILE DIGITALLY SIGNED AND SEALED UNDER RULE 61G15-23.004, F.A.C.



CITY OF VERO BEACH AIRPORT



9/15/2022 11:02:24 AM Jacquelyn.Arreaga c:\pwworking\wgn\jacquelyn.arreaga\d2198192\PLANRD01.dgn

REVISIONS		REVISIONS	
DATE	DESCRIPTION	DATE	DESCRIPTION

PROFESSIONAL TYPE  
 WILLIAM EVANS  
 LICENSE NUMBER: 45207  
 WGI, INC.  
 2035 VISTA PARKWAY  
 WEST PALM BEACH, FL 33411

STATE OF FLORIDA DEPARTMENT OF TRANSPORTATION		
ROAD NO.	COUNTY	FINANCIAL PROJECT ID
SR 5	INDIAN RIVER	441693-1-22-02

**UTILITY CONTACT PLAN (8)**

SHEET NO.  
8


THE OFFICIAL RECORD OF THIS SHEET IS THE ELECTRONIC FILE DIGITALLY SIGNED AND SEALED UNDER RULE 61G15-23.004, F.A.C.

CITY OF VERO BEACH AIRPORT



FEC RR

SR 5 / US 1

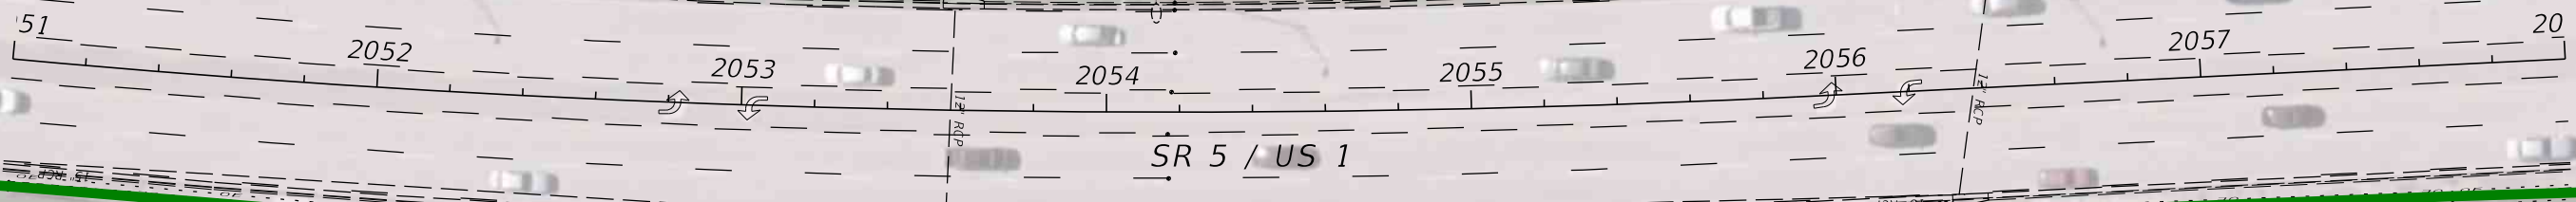

EXISTING AERIAL COMCAST FACILITIES

EXISTING AERIAL COMCAST FACILITIES

EXISTING UNDERGROUND COMCAST FACILITIES

9/15/2022 11:02:50 AM Jacquelyn.Arreaga c:\pwworking\wg\Jacquelyn.arreaga\d2198192\PLANRD01.dgn

DATE		REVISIONS		PROFESSIONAL TYPE	STATE OF FLORIDA DEPARTMENT OF TRANSPORTATION			SHEET NO.
DATE	DESCRIPTION	DATE	DESCRIPTION		ROAD NO.	COUNTY	FINANCIAL PROJECT ID	
				WILLIAM EVANS LICENSE NUMBER: 45207 WGI, INC. 2035 VISTA PARKWAY WEST PALM BEACH, FL 33411	SR 5	INDIAN RIVER	441693-1-22-02	9

UTILITY CONTACT PLAN (9)

THE OFFICIAL RECORD OF THIS SHEET IS THE ELECTRONIC FILE DIGITALLY SIGNED AND SEALED UNDER RULE 61G15-23.004, F.A.C.

CITY OF VERO BEACH AIRPORT



FEC RR

58 2059 2060 2061 2062 2063 2064 20

SR 5 / US 1

EXISTING AERIAL COMCAST FACILITIES

EXISTING AERIAL COMCAST FACILITIES

EXISTING UNDERGROUND COMCAST FACILITIES


PICKERILL LN

9/15/2022 11:03:08 AM Jacquelyn.Arreaga c:\pwworking\wgn\jacquelyn.arreaga\d2198192\PLANRD01.dgn

REVISIONS				PROFESSIONAL TYPE	STATE OF FLORIDA DEPARTMENT OF TRANSPORTATION			UTILITY CONTACT PLAN (10)	SHEET NO. 10
DATE	DESCRIPTION	DATE	DESCRIPTION		ROAD NO.	COUNTY	FINANCIAL PROJECT ID		
				WILLIAM EVANS LICENSE NUMBER: 45207 WGI, INC. 2035 VISTA PARKWAY WEST PALM BEACH, FL 33411	SR 5	INDIAN RIVER	441693-1-22-02		

THE OFFICIAL RECORD OF THIS SHEET IS THE ELECTRONIC FILE DIGITALLY SIGNED AND SEALED UNDER RULE 61G15-23.004, F.A.C.

CITY OF VERO BEACH AIRPORT

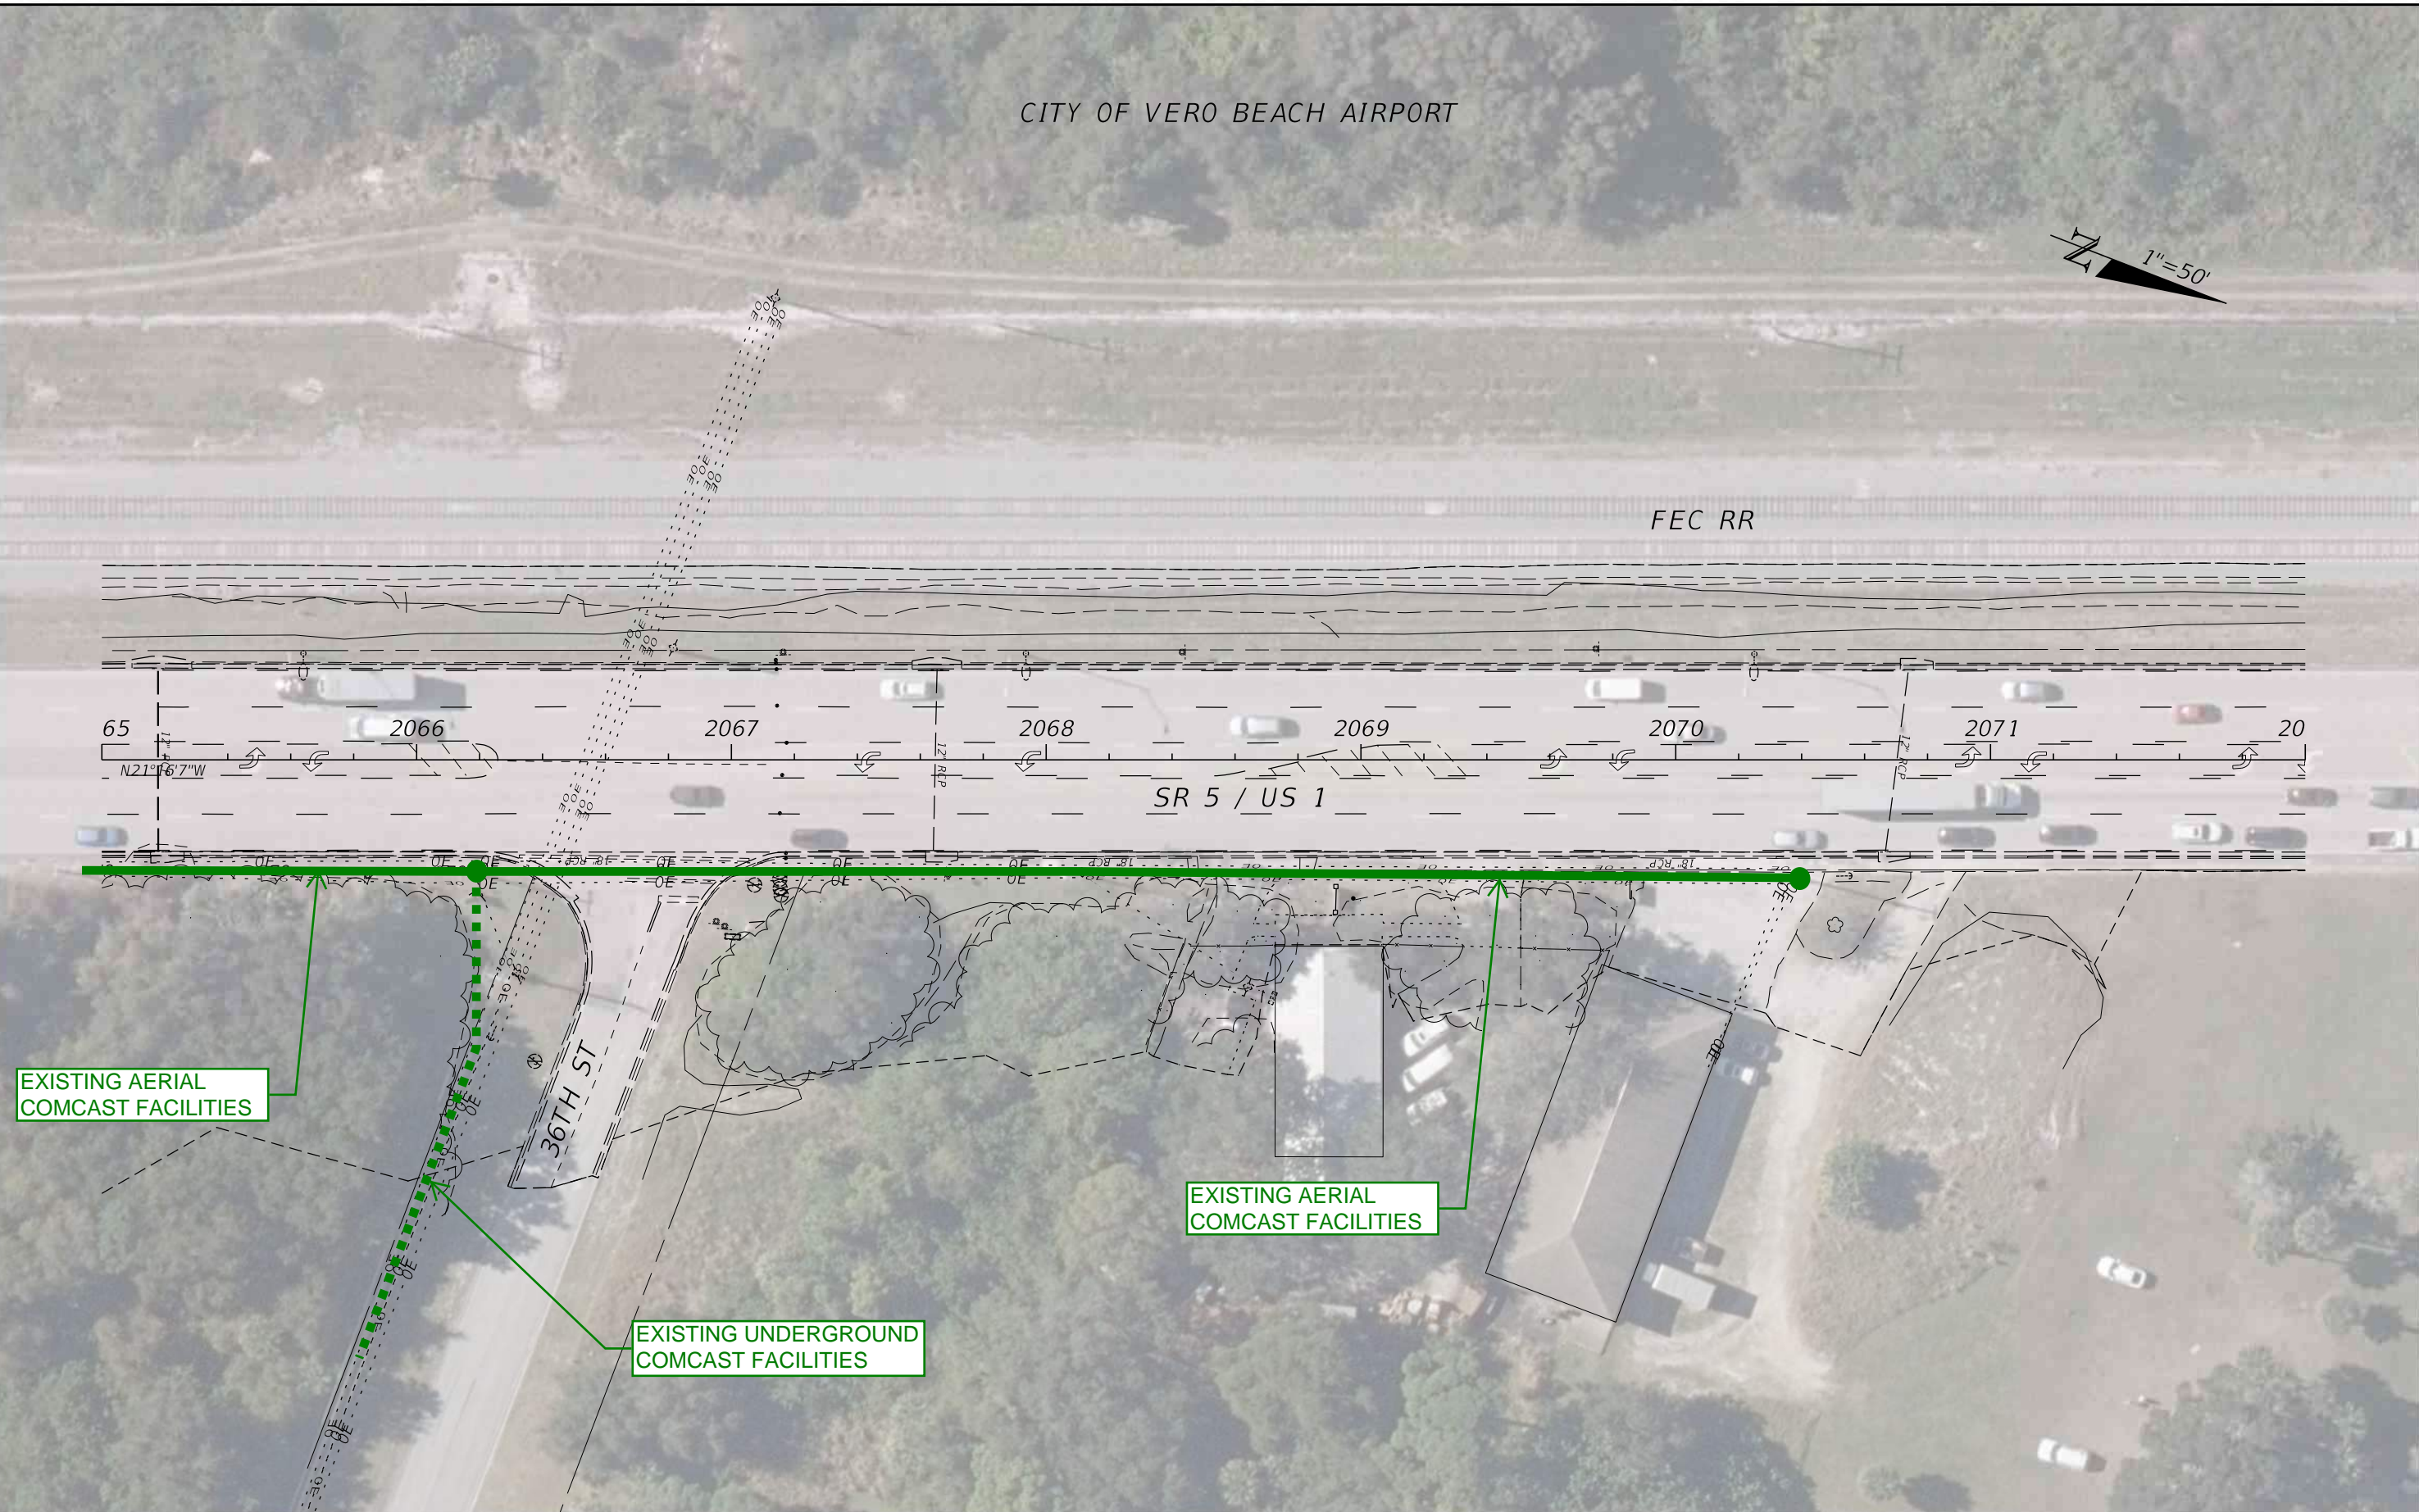

9/15/2022 11:03:42 AM Jacquelyn.Arreaga c:\pwworking\wg\N\Jacquelyn.arreaga\d2198192\PLANRD01.dgn

DATE		DESCRIPTION		REVISIONS		PROFESSIONAL TYPE		STATE OF FLORIDA DEPARTMENT OF TRANSPORTATION			SHEET NO.
DATE	DESCRIPTION	DATE	DESCRIPTION	DATE	DESCRIPTION	WILLIAM EVANS LICENSE NUMBER: 45207 WGI, INC. 2035 VISTA PARKWAY WEST PALM BEACH, FL 33411	ROAD NO.	COUNTY	FINANCIAL PROJECT ID	11	
							SR 5	INDIAN RIVER	441693-1-22-02		<b>UTILITY CONTACT PLAN (11)</b>

THE OFFICIAL RECORD OF THIS SHEET IS THE ELECTRONIC FILE DIGITALLY SIGNED AND SEALED UNDER RULE 61G15-23.004, F.A.C.

CITY OF VERO BEACH AIRPORT



NO COMCAST FACILITIES

FEC RR

NO COMCAST FACILITIES

SR 5 / US 1

EXISTING UNDERGROUND COMCAST FACILITIES

NO COMCAST FACILITIES

NO COMCAST FACILITIES

EXISTING UNDERGROUND COMCAST FACILITIES

EXISTING AERIAL COMCAST FACILITIES

EXISTING AERIAL COMCAST FACILITIES

9/15/2022 11:04:09 AM Jacquelyn.Arreaga c:\pwworking\wg\N\Jacquelyn.arreaga\d2198192\PLANRD01.dgn

REVISIONS				PROFESSIONAL TYPE	STATE OF FLORIDA DEPARTMENT OF TRANSPORTATION			UTILITY CONTACT PLAN (12)	SHEET NO. 12
DATE	DESCRIPTION	DATE	DESCRIPTION		ROAD NO.	COUNTY	FINANCIAL PROJECT ID		
				WILLIAM EVANS LICENSE NUMBER: 45207 WGI, INC. 2035 VISTA PARKWAY WEST PALM BEACH, FL 33411	SR 5	INDIAN RIVER	441693-1-22-02		

THE OFFICIAL RECORD OF THIS SHEET IS THE ELECTRONIC FILE DIGITALLY SIGNED AND SEALED UNDER RULE 61G15-23.004, F.A.C.

9/15/2022 11:04:36 AM Jacquelyn.Arreaga  
 c:\pwworking\wgn\jacquelyn.arreaga\d2198192\PLANRD01.dgn



REVISIONS		PROFESSIONAL TYPE		STATE OF FLORIDA DEPARTMENT OF TRANSPORTATION			UTILITY CONTACT PLAN (13)	SHEET NO. 13
DATE	DESCRIPTION	DATE	DESCRIPTION	ROAD NO.	COUNTY	FINANCIAL PROJECT ID		
				SR 5	INDIAN RIVER	441693-1-22-02		

THE OFFICIAL RECORD OF THIS SHEET IS THE ELECTRONIC FILE DIGITALLY SIGNED AND SEALED UNDER RULE 61G15-23.004, F.A.C.



9/15/2022 11:05:04 AM Jacquelyn.Arreaga  
c:\pwworking\wgn\jacquelyn.arreaga\d2198192\PLAN\RD01.dgn

REVISIONS				PROFESSIONAL TYPE	STATE OF FLORIDA DEPARTMENT OF TRANSPORTATION			UTILITY CONTACT PLAN (14)	SHEET NO. 14
DATE	DESCRIPTION	DATE	DESCRIPTION		ROAD NO.	COUNTY	FINANCIAL PROJECT ID		
				WILLIAM EVANS LICENSE NUMBER: 45207 WGI, INC. 2035 VISTA PARKWAY WEST PALM BEACH, FL 33411	SR 5	INDIAN RIVER	441693-1-22-02		

THE OFFICIAL RECORD OF THIS SHEET IS THE ELECTRONIC FILE DIGITALLY SIGNED AND SEALED UNDER RULE 61G15-23.004, F.A.C.



NO COMCAST FACILITIES

NO COMCAST FACILITIES

SR 5 / US 1

93      2094      2095      2096      2097      2098      2099      21


N15°6'28"W

9/15/2022 11:05:51 AM Jacquelyn.Arreaga c:\pwworking\wg\N\jacquelyn.arreaga\2198192\PLANRD01.dgn

REVISIONS				PROFESSIONAL TYPE	STATE OF FLORIDA DEPARTMENT OF TRANSPORTATION			UTILITY CONTACT PLAN (15)	SHEET NO. 15
DATE	DESCRIPTION	DATE	DESCRIPTION		ROAD NO.	COUNTY	FINANCIAL PROJECT ID		
				WILLIAM EVANS LICENSE NUMBER: 45207 WGI, INC. 2035 VISTA PARKWAY WEST PALM BEACH, FL 33411	SR 5	INDIAN RIVER	441693-1-22-02		

THE OFFICIAL RECORD OF THIS SHEET IS THE ELECTRONIC FILE DIGITALLY SIGNED AND SEALED UNDER RULE 61G15-23.004, F.A.C.




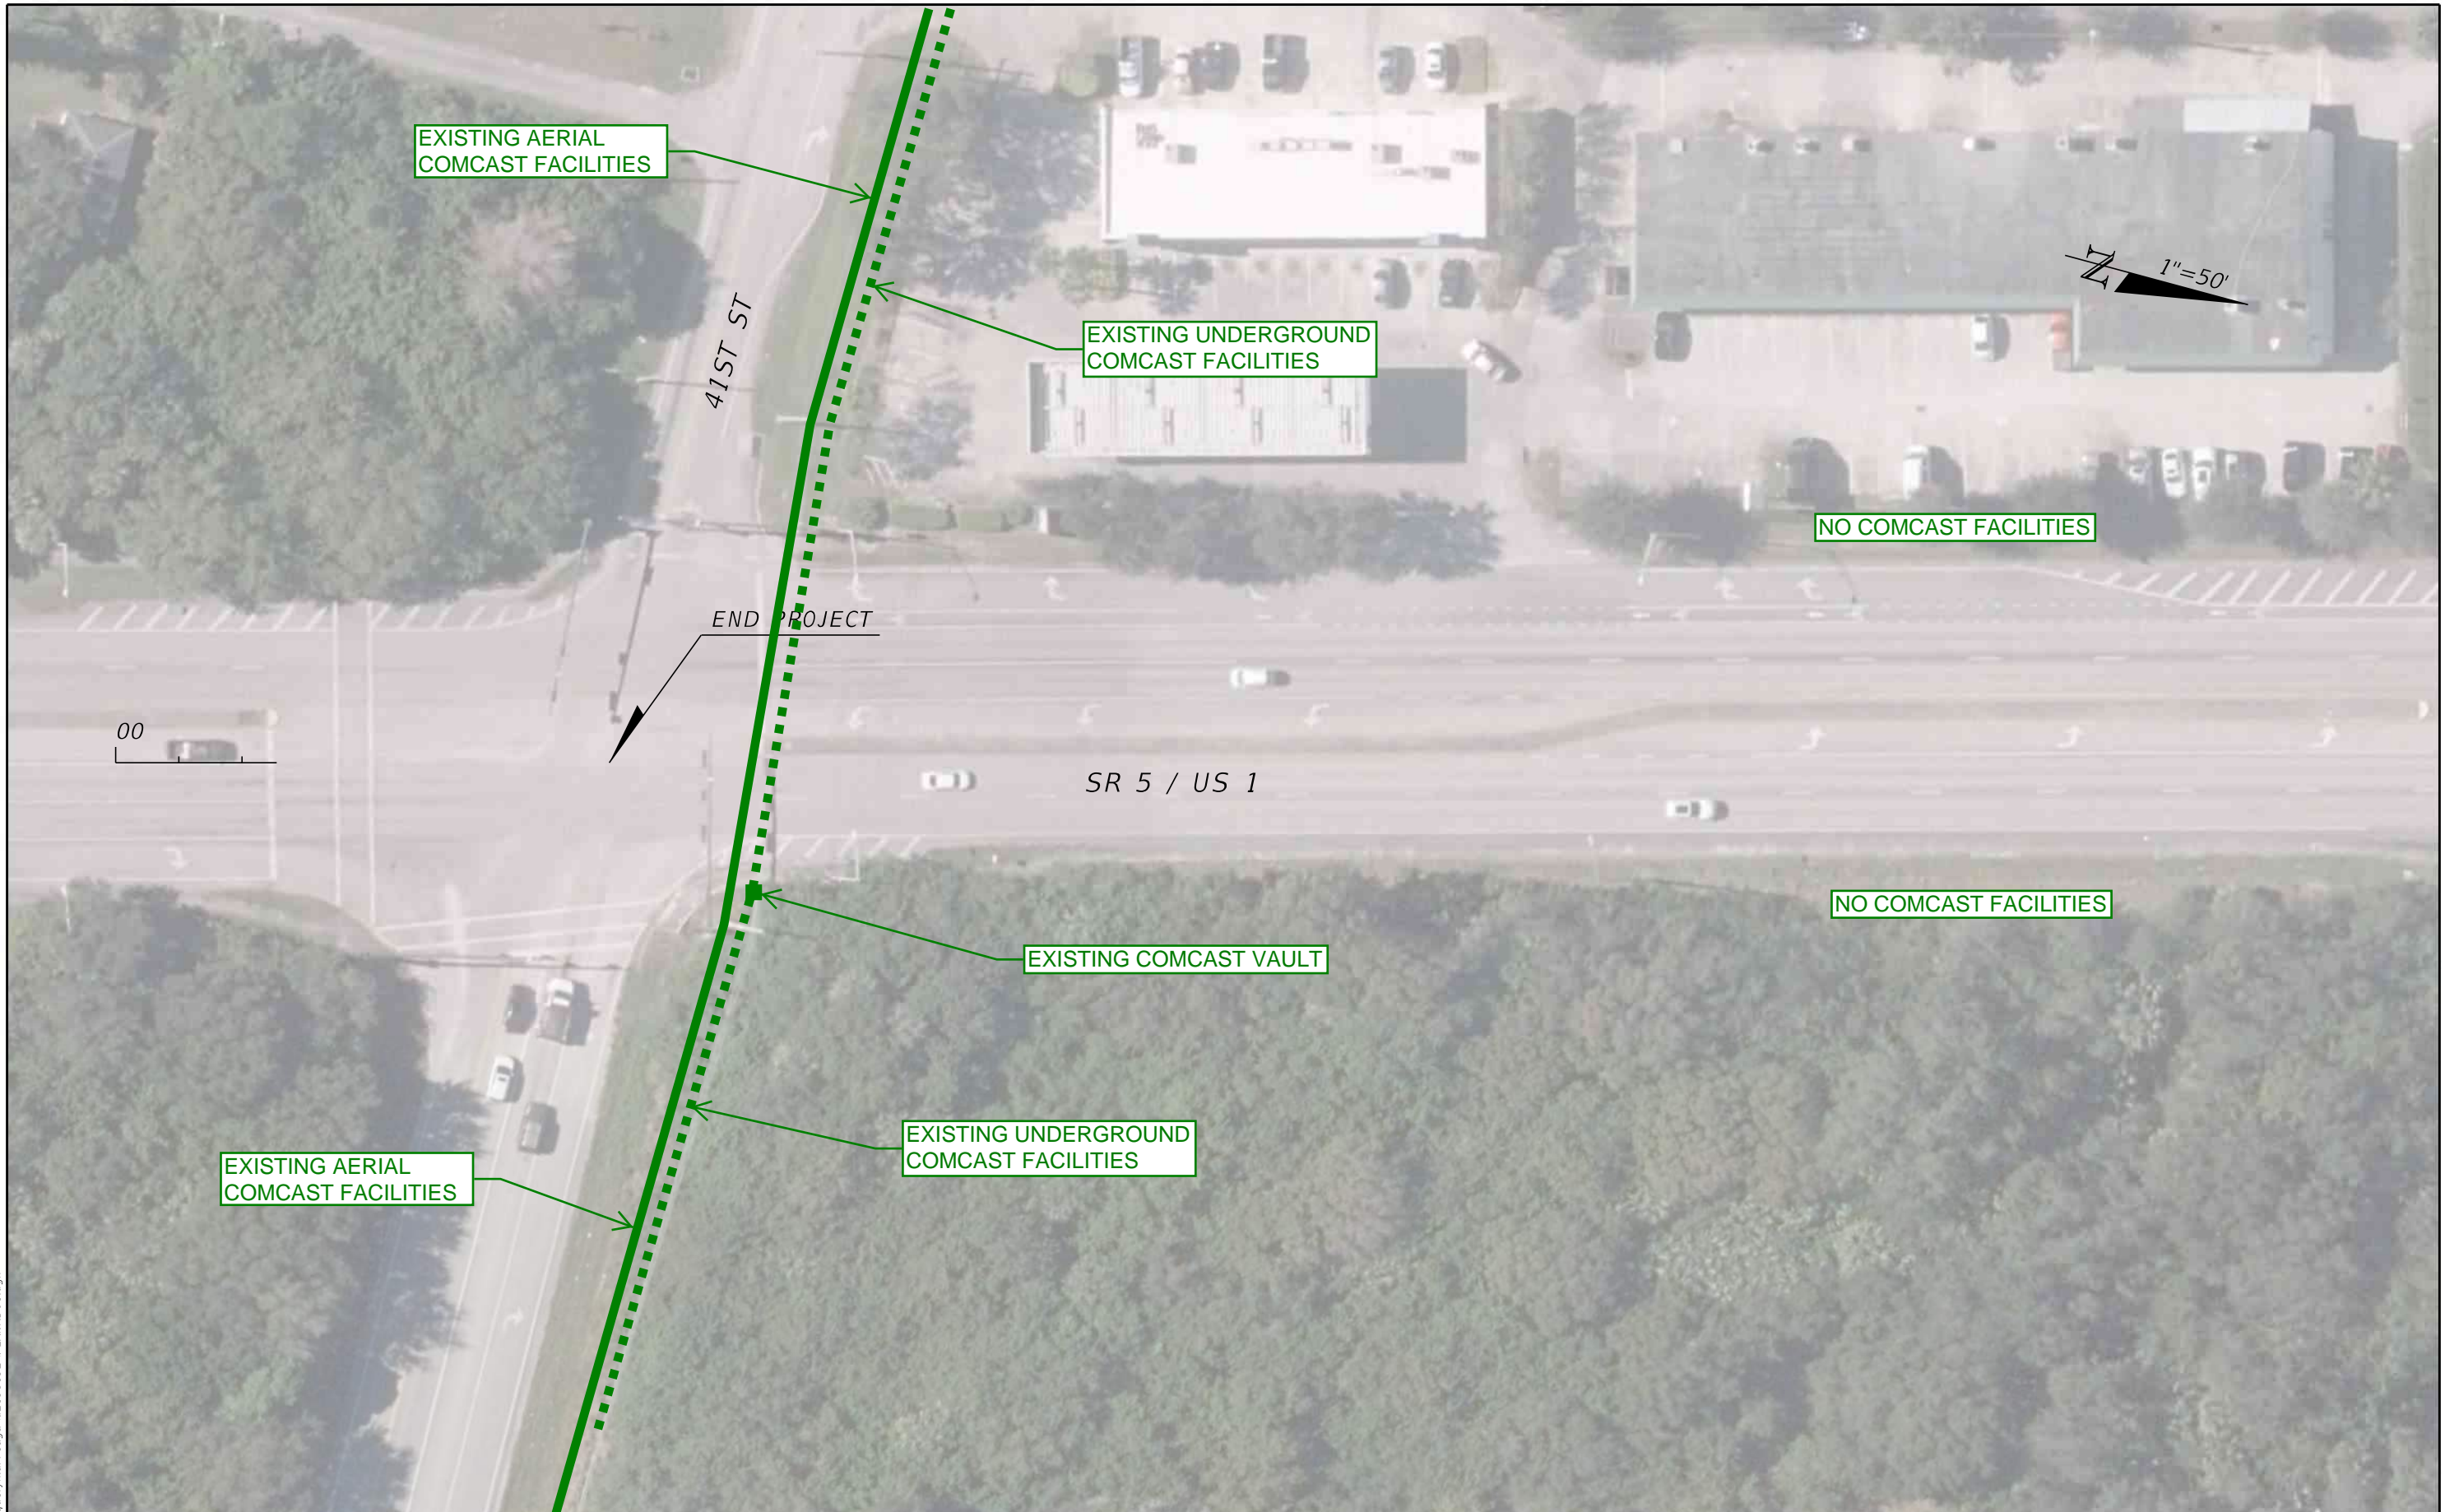


9/15/2022 11:06:09 AM Jacquelyn.Arreaga  
 c:\pwworking\wgn\jacquelyn.arreaga\d2198192\PLAN\RD01.dgn

REVISIONS				PROFESSIONAL TYPE	STATE OF FLORIDA DEPARTMENT OF TRANSPORTATION			UTILITY CONTACT PLAN (16)	SHEET NO. 16
DATE	DESCRIPTION	DATE	DESCRIPTION		ROAD NO.	COUNTY	FINANCIAL PROJECT ID		
				WILLIAM EVANS LICENSE NUMBER: 45207 WGI, INC. 2035 VISTA PARKWAY WEST PALM BEACH, FL 33411	SR 5	INDIAN RIVER	441693-1-22-02		

THE OFFICIAL RECORD OF THIS SHEET IS THE ELECTRONIC FILE DIGITALLY SIGNED AND SEALED UNDER RULE 61G15-23.004, F.A.C.

SEE SHEET 6

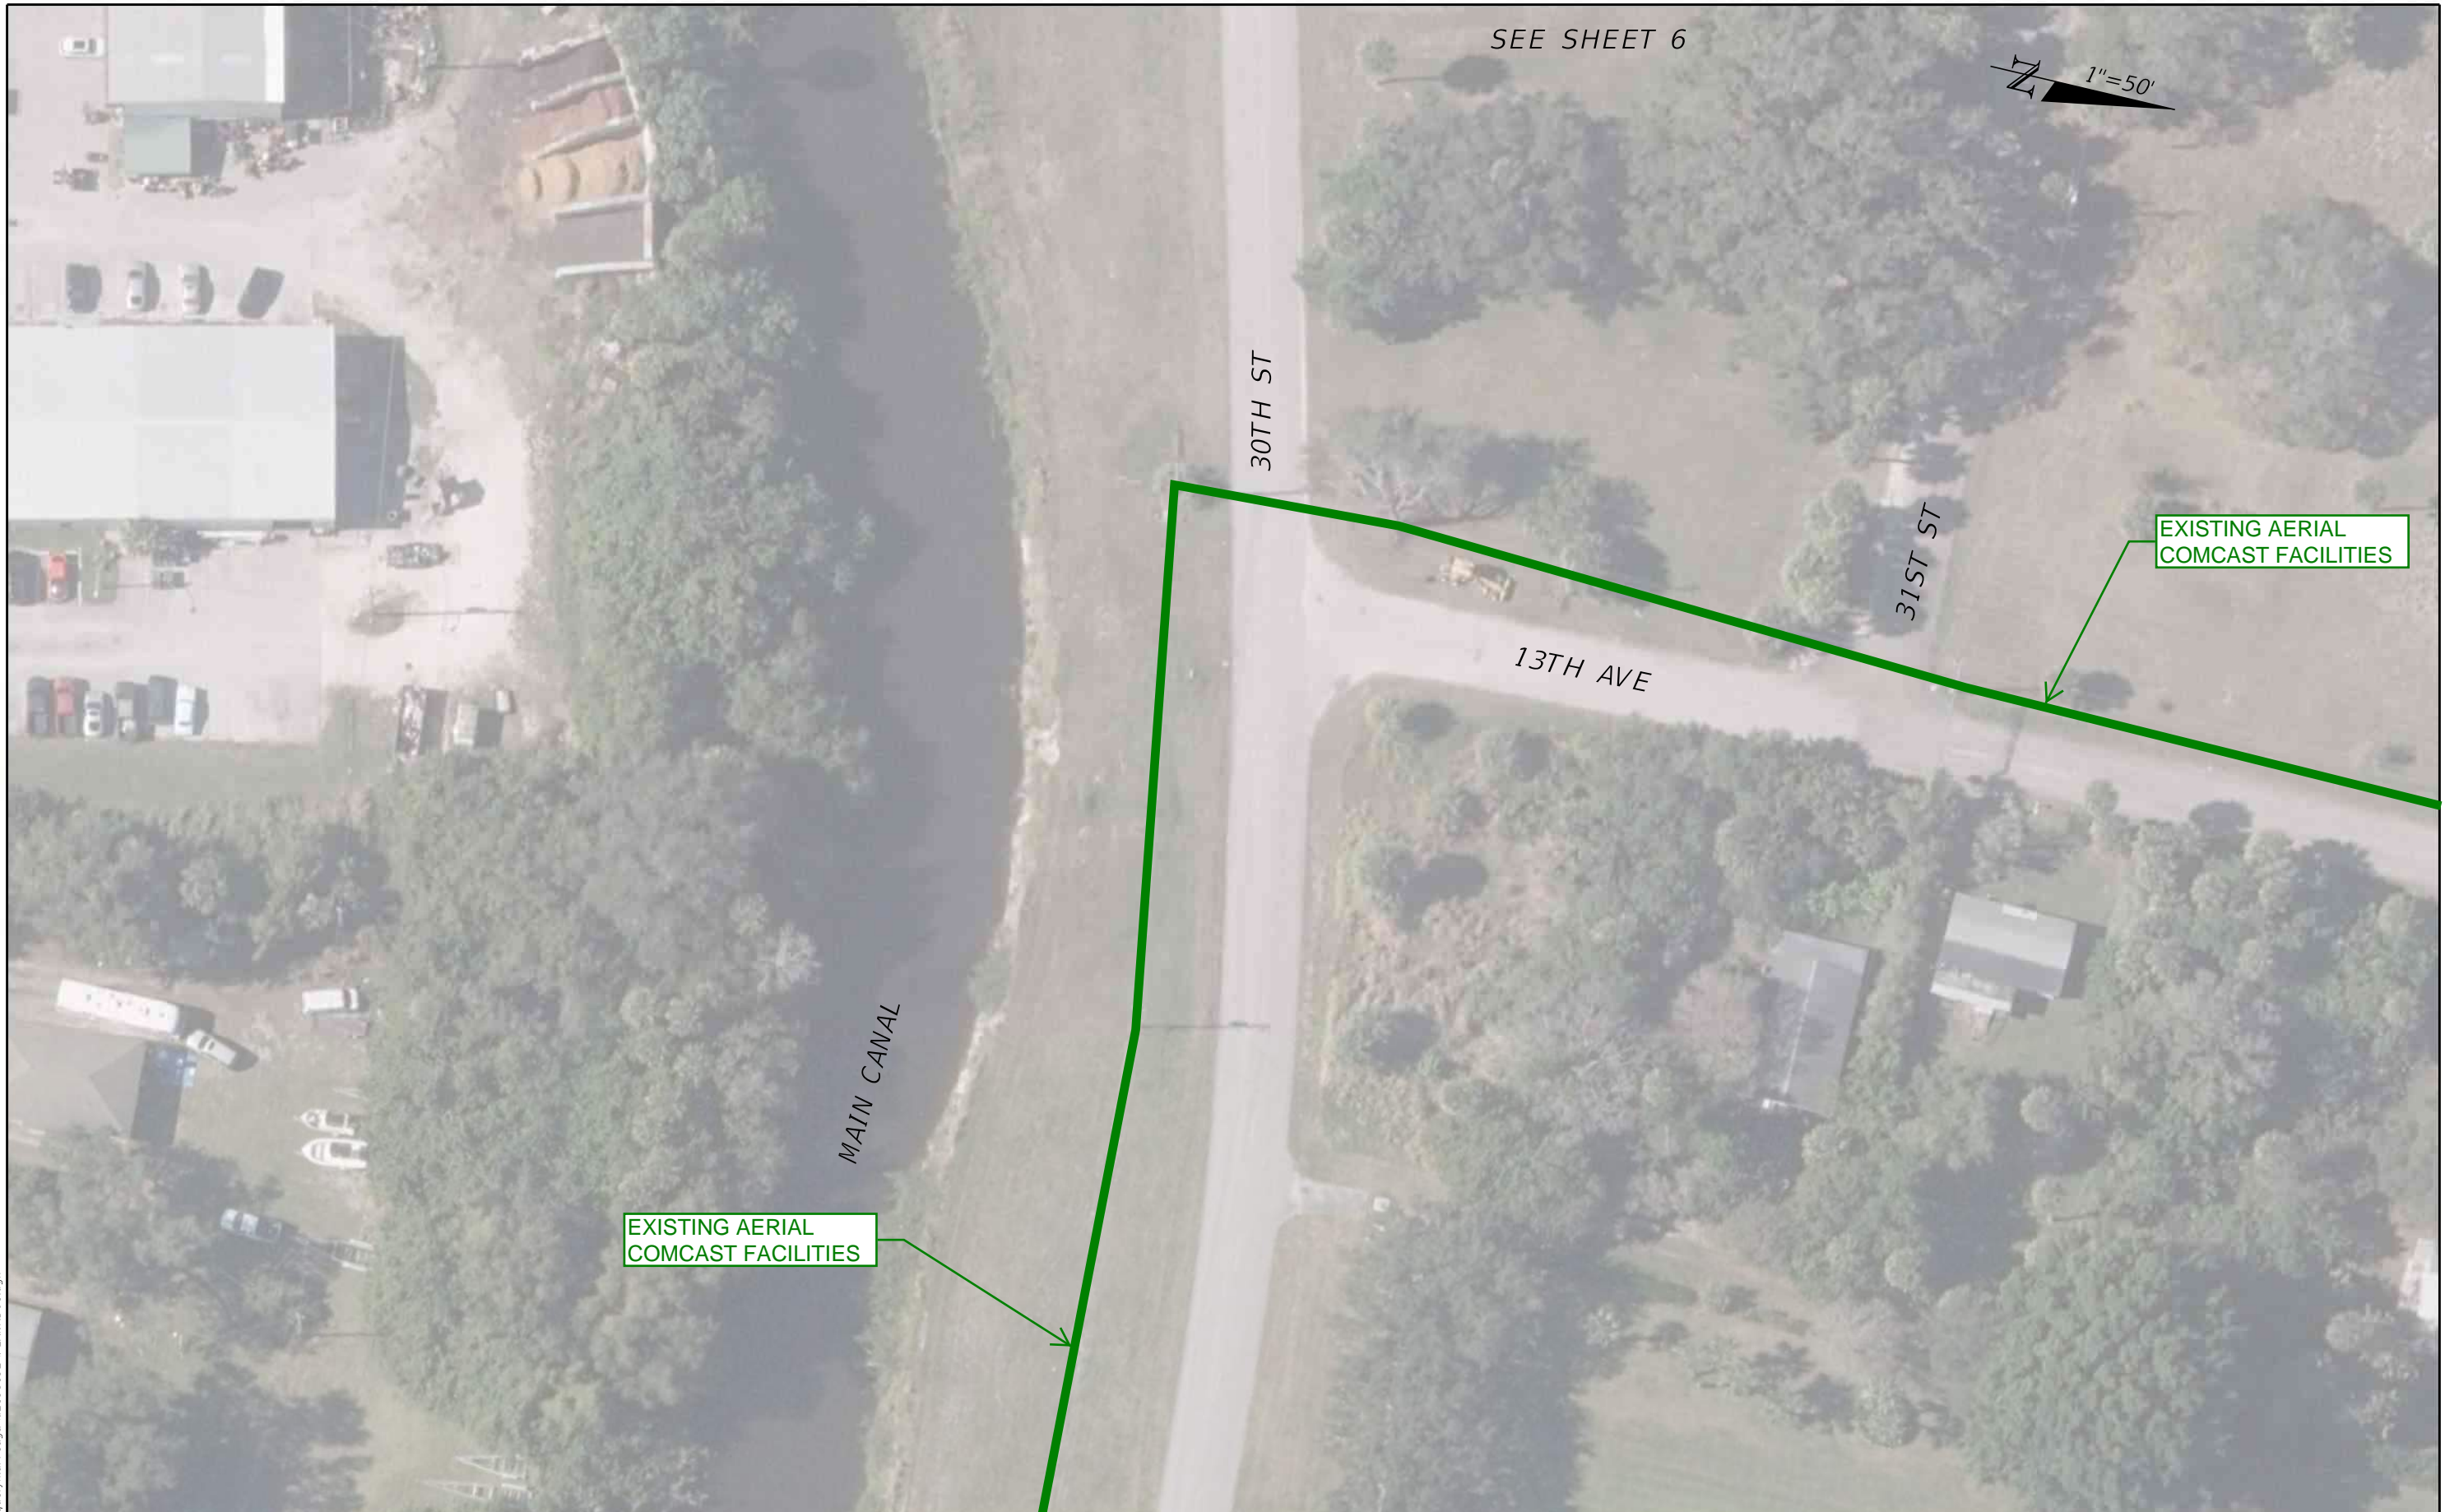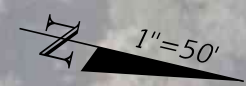

9/15/2022 11:06:48 AM Jacquelyn.Arreaga c:\pwworking\wgn\jacquelyn.arreaga\d2198192\PLANRD01.dgn

REVISIONS		PROFESSIONAL TYPE		STATE OF FLORIDA DEPARTMENT OF TRANSPORTATION			UTILITY CONTACT PLAN (17)	SHEET NO. 17
DATE	DESCRIPTION	DATE	DESCRIPTION	ROAD NO.	COUNTY	FINANCIAL PROJECT ID		
				SR 5	INDIAN RIVER	441693-1-22-02		

WILLIAM EVANS  
LICENSE NUMBER: 45207  
WGI, INC.  
2035 VISTA PARKWAY  
WEST PALM BEACH, FL 33411

THE OFFICIAL RECORD OF THIS SHEET IS THE ELECTRONIC FILE DIGITALLY SIGNED AND SEALED UNDER RULE 61G15-23.004, F.A.C.




9/15/2022 11:07:02 AM Jacquelyn.Arreaga  
 c:\pwworking\wgn\jacquelyn.arreaga\d2198192\PLANRD01.dgn

REVISIONS		PROFESSIONAL TYPE		STATE OF FLORIDA DEPARTMENT OF TRANSPORTATION			UTILITY CONTACT PLAN (18)	SHEET NO. 6
DATE	DESCRIPTION	DATE	DESCRIPTION	ROAD NO.	COUNTY	FINANCIAL PROJECT ID		
				SR 5	INDIAN RIVER	441693-1-22-02		

WILLIAM EVANS  
 LICENSE NUMBER: 45207  
 WGI, INC.  
 2035 VISTA PARKWAY  
 WEST PALM BEACH, FL 33411

THE OFFICIAL RECORD OF THIS SHEET IS THE ELECTRONIC FILE DIGITALLY SIGNED AND SEALED UNDER RULE 61G15-23.004, F.A.C.

SEE SHEET 8

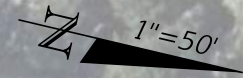

SEE SHEET 18

SEE SHEET 20

NO COMCAST FACILITIES

9/15/2022 11:17:13 AM Jacquelyn.Arreaga  
c:\pwworking\wgn\jacquelyn.arreaga\d2198192\PLANRD01.dgn

REVISIONS				PROFESSIONAL TYPE	STATE OF FLORIDA DEPARTMENT OF TRANSPORTATION			UTILITY CONTACT PLAN (19)	SHEET NO.
DATE	DESCRIPTION	DATE	DESCRIPTION	WILLIAM EVANS LICENSE NUMBER: 45207 WGI, INC. 2035 VISTA PARKWAY WEST PALM BEACH, FL 33411	ROAD NO.	COUNTY	FINANCIAL PROJECT ID		19
					SR 5	INDIAN RIVER	441693-1-22-02		


THE OFFICIAL RECORD OF THIS SHEET IS THE ELECTRONIC FILE DIGITALLY SIGNED AND SEALED UNDER RULE 61G15-23.004, F.A.C.

9/15/2022 11:17:26 AM Jacquelyn.Arreaga  
 c:\pwworking\wgn\jacquelyn.arreaga\d2198192\PLANRD01.dgn



REVISIONS				PROFESSIONAL TYPE	STATE OF FLORIDA DEPARTMENT OF TRANSPORTATION			UTILITY CONTACT PLAN (20)	SHEET NO.
DATE	DESCRIPTION	DATE	DESCRIPTION	WILLIAM EVANS LICENSE NUMBER: 45207 WGI, INC. 2035 VISTA PARKWAY WEST PALM BEACH, FL 33411	ROAD NO.	COUNTY	FINANCIAL PROJECT ID		20
						SR 5	INDIAN RIVER		441693-1-22-02

THE OFFICIAL RECORD OF THIS SHEET IS THE ELECTRONIC FILE DIGITALLY SIGNED AND SEALED UNDER RULE 61G15-23.004, F.A.C.

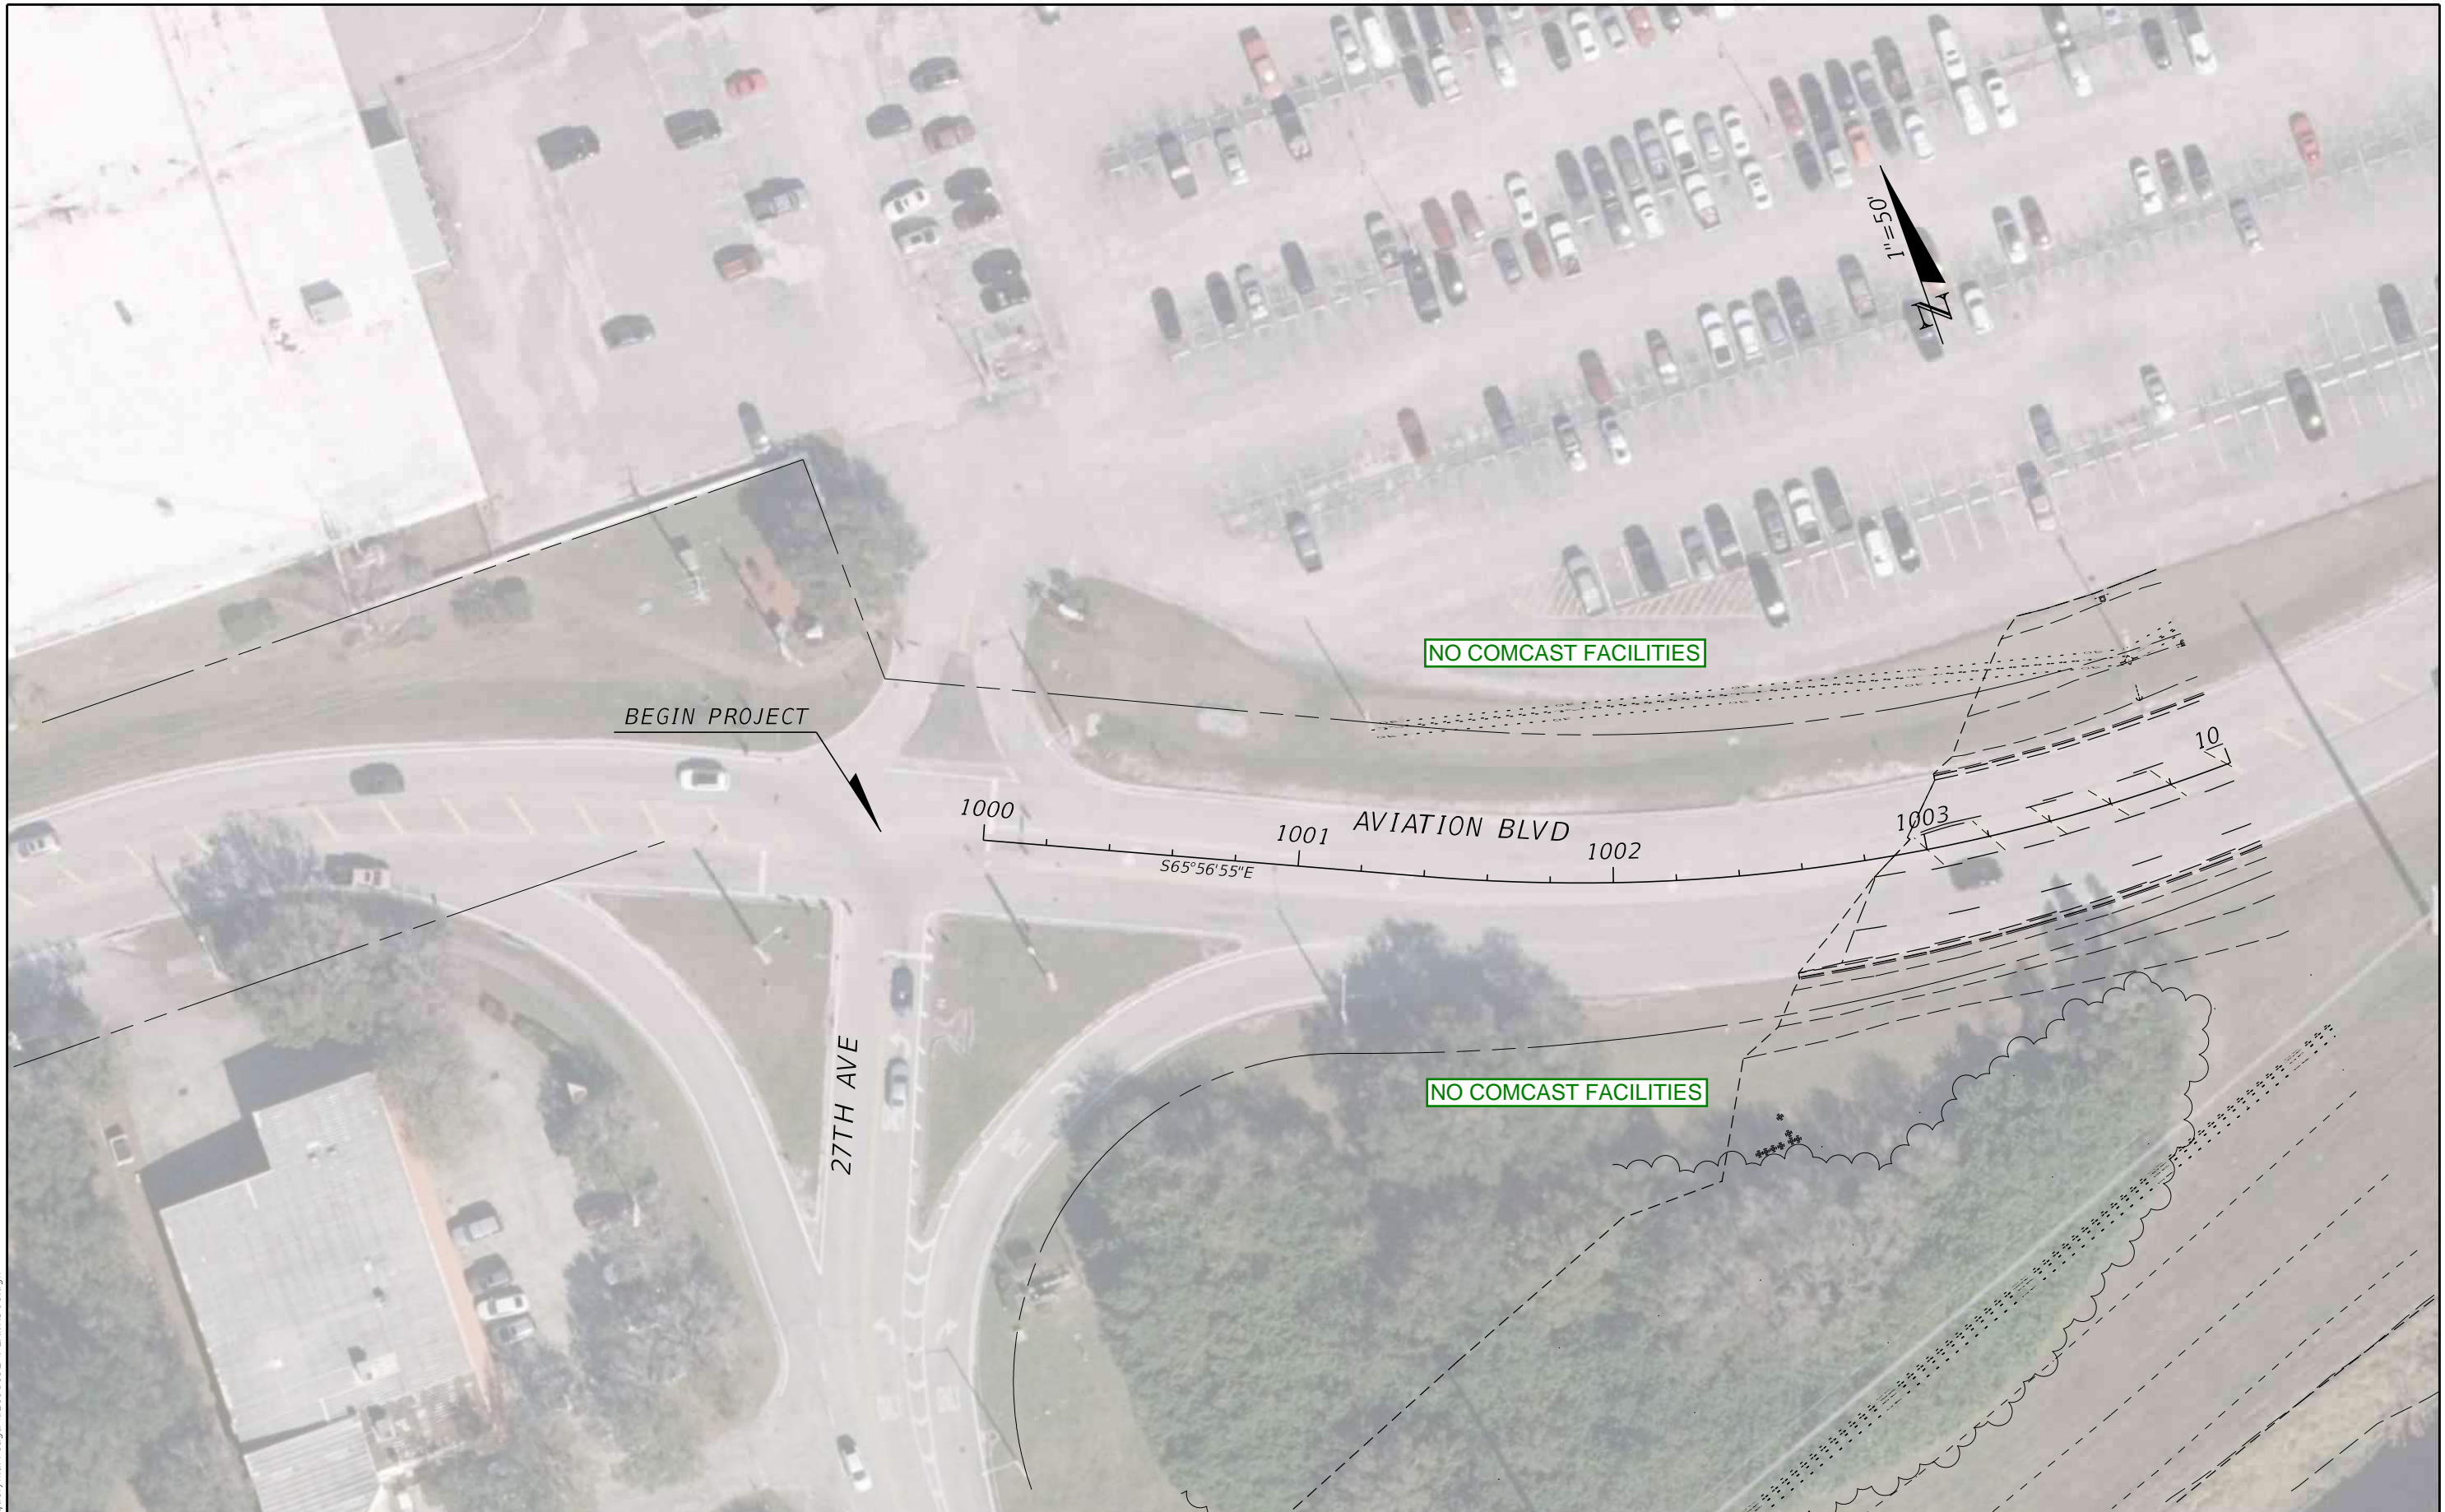


9/15/2022 11:07:58 AM Jacquelyn.Arreaga c:\pwworking\wgi\jacquelyn.arreaga\d2198192\PLAN\ARD01.dgn

REVISIONS		PROFESSIONAL TYPE		STATE OF FLORIDA DEPARTMENT OF TRANSPORTATION			UTILITY CONTACT PLAN (21)	SHEET NO. 21
DATE	DESCRIPTION	DATE	DESCRIPTION	ROAD NO.	COUNTY	FINANCIAL PROJECT ID		
				SR 5	INDIAN RIVER	441693-1-22-02		

WILLIAM EVANS  
 LICENSE NUMBER: 45207  
 WGI, INC.  
 2035 VISTA PARKWAY  
 WEST PALM BEACH, FL 33411

THE OFFICIAL RECORD OF THIS SHEET IS THE ELECTRONIC FILE DIGITALLY SIGNED AND SEALED UNDER RULE 61G15-23.004, F.A.C.

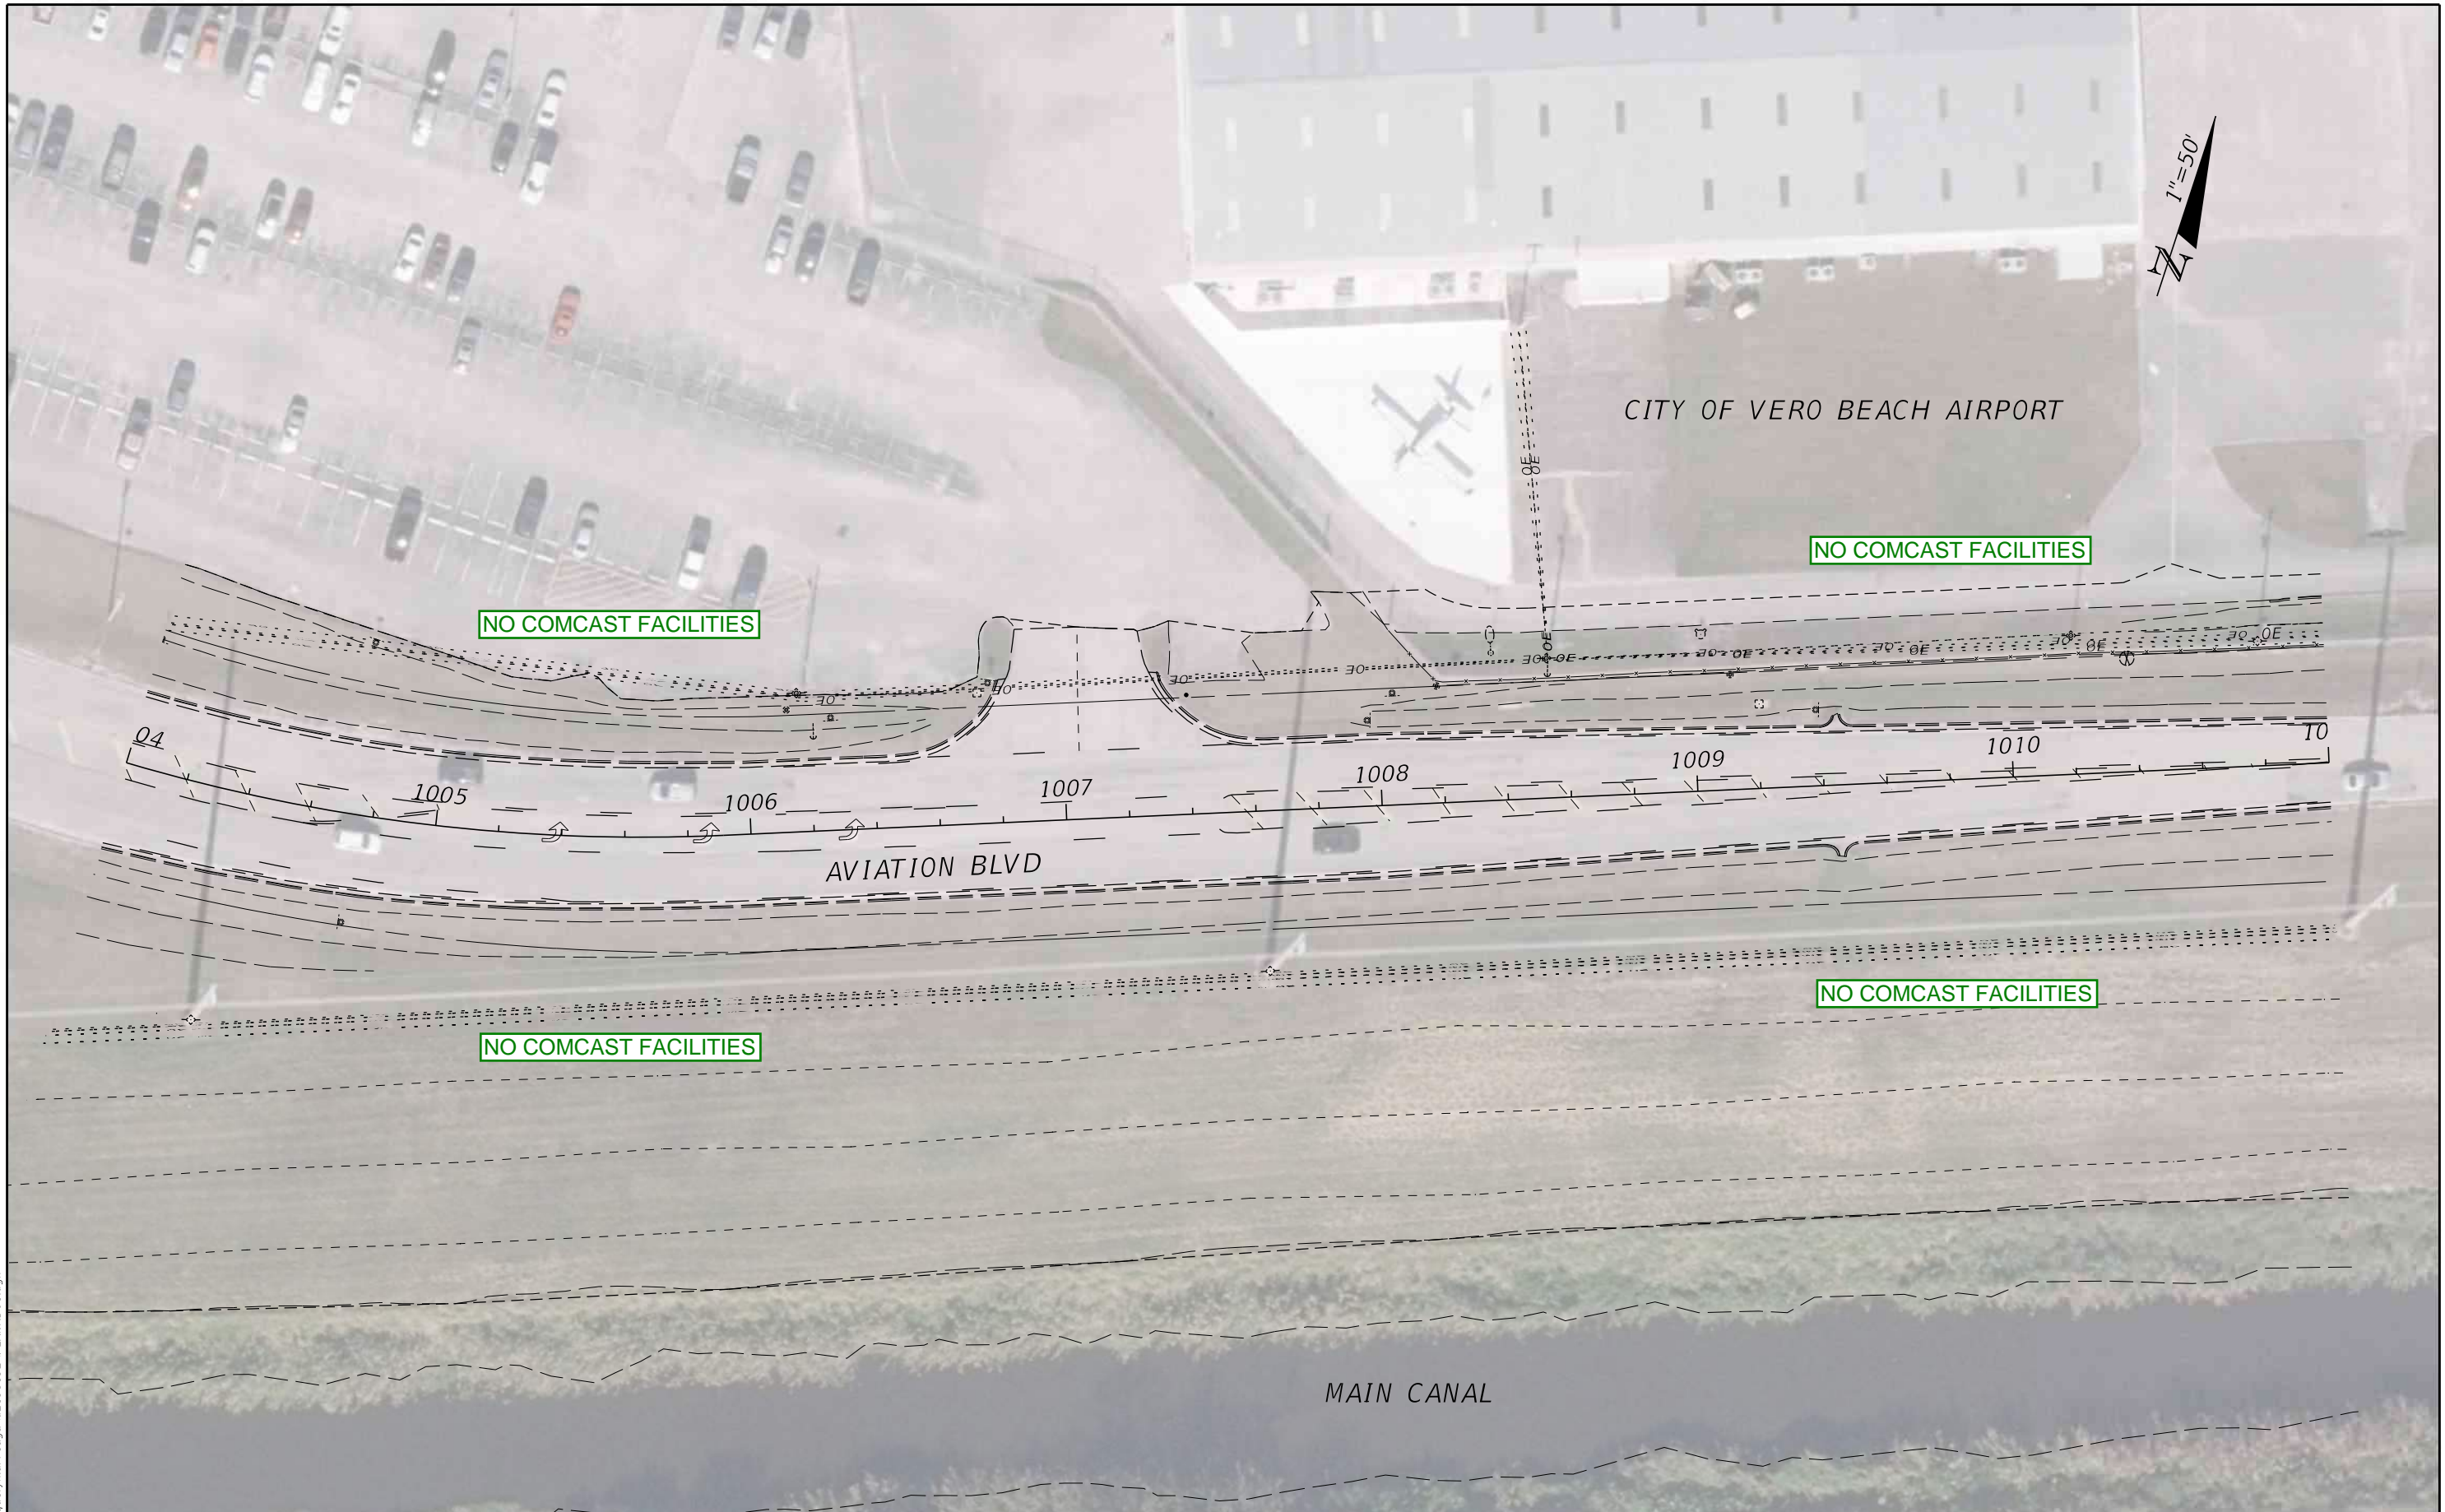

9/15/2022 11:08:27 AM Jacquelyn.Arreaga  
 c:\pwworking\wgn\jacquelyn.arreaga\d2198192\PLANRD01.dgn


THE OFFICIAL RECORD OF THIS SHEET IS THE ELECTRONIC FILE DIGITALLY SIGNED AND SEALED UNDER RULE 61G15-23.004, F.A.C.

REVISIONS		PROFESSIONAL TYPE		STATE OF FLORIDA DEPARTMENT OF TRANSPORTATION			UTILITY CONTACT PLAN (22)	SHEET NO. 22
DATE	DESCRIPTION	DATE	DESCRIPTION	ROAD NO.	COUNTY	FINANCIAL PROJECT ID		
			WILLIAM EVANS LICENSE NUMBER: 45207 WGI, INC. 2035 VISTA PARKWAY WEST PALM BEACH, FL 33411	SR 5	INDIAN RIVER	441693-1-22-02		



CITY OF VERO BEACH AIRPORT

NO COMCAST FACILITIES

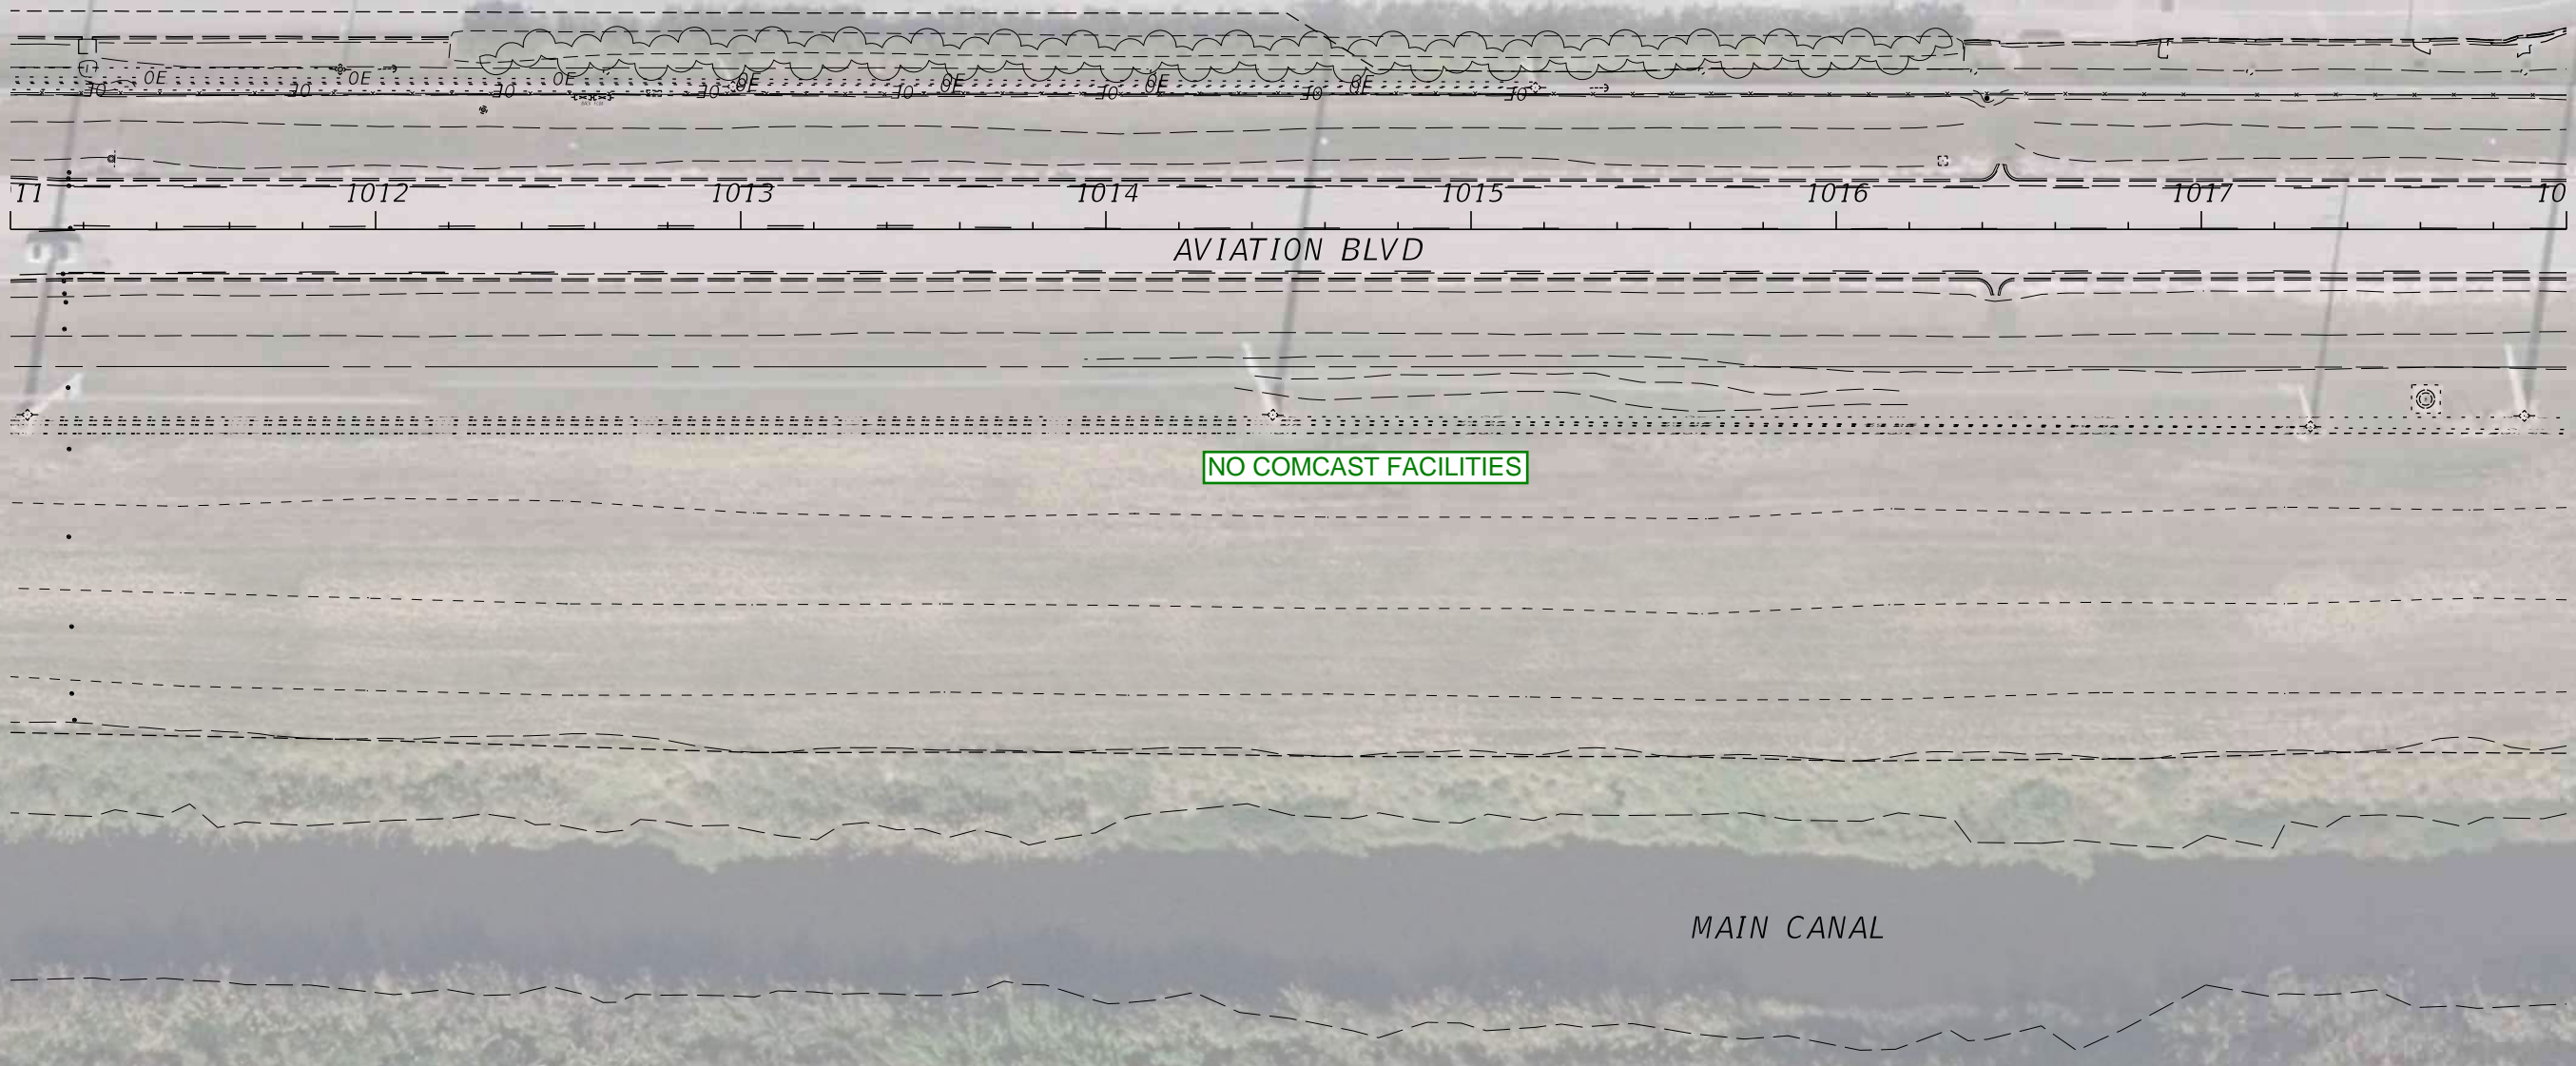

AVIATION BLVD

NO COMCAST FACILITIES

MAIN CANAL

9/15/2022 11:08:39 AM Jacquelyn.Arreaga c:\pwworking\wg\N\Jacquelyn.arreaga\d2198192\PLANRD01.dgn

REVISIONS				PROFESSIONAL TYPE	STATE OF FLORIDA DEPARTMENT OF TRANSPORTATION			UTILITY CONTACT PLAN (23)	SHEET NO. 23
DATE	DESCRIPTION	DATE	DESCRIPTION		ROAD NO.	COUNTY	FINANCIAL PROJECT ID		
				WILLIAM EVANS LICENSE NUMBER: 45207 WGI, INC. 2035 VISTA PARKWAY WEST PALM BEACH, FL 33411	SR 5	INDIAN RIVER	441693-1-22-02		


THE OFFICIAL RECORD OF THIS SHEET IS THE ELECTRONIC FILE DIGITALLY SIGNED AND SEALED UNDER RULE 61G15-23.004, F.A.C.





CITY OF VERO BEACH AIRPORT

NO COMCAST FACILITIES

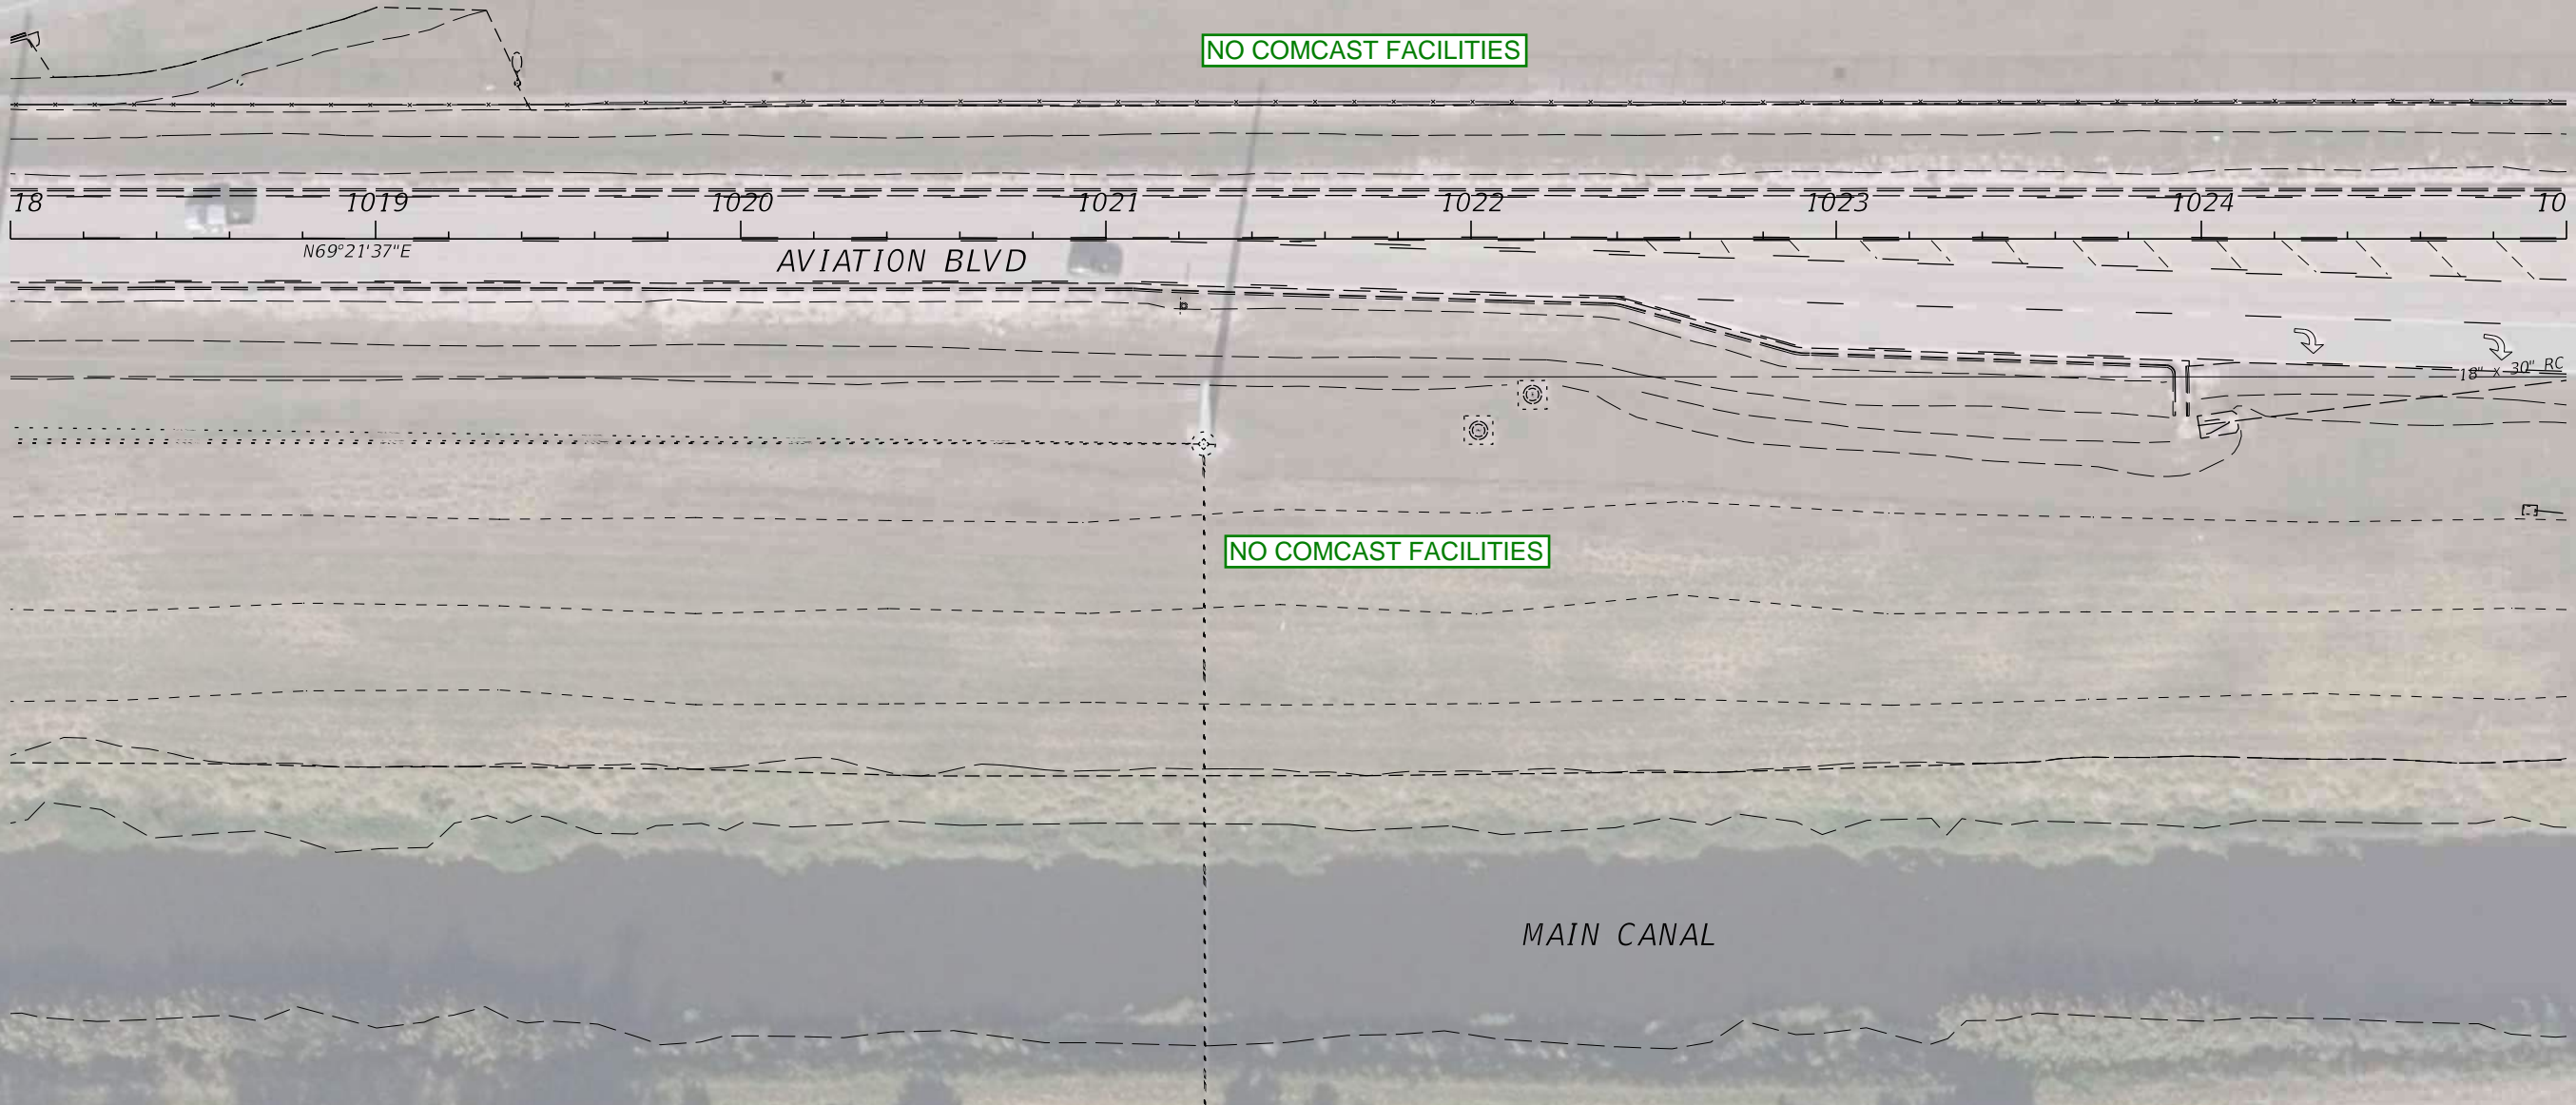


9/15/2022 11:08:55 AM Jacquelyn.Arreaga c:\pwworking\wgn\jacquelyn.arreaga\d2198192\PLANRD01.dgn

REVISIONS				PROFESSIONAL TYPE	STATE OF FLORIDA DEPARTMENT OF TRANSPORTATION			UTILITY CONTACT PLAN (24)	SHEET NO. 24
DATE	DESCRIPTION	DATE	DESCRIPTION		ROAD NO.	COUNTY	FINANCIAL PROJECT ID		
				WILLIAM EVANS LICENSE NUMBER: 45207 WGI, INC. 2035 VISTA PARKWAY WEST PALM BEACH, FL 33411	SR 5	INDIAN RIVER	441693-1-22-02		

THE OFFICIAL RECORD OF THIS SHEET IS THE ELECTRONIC FILE DIGITALLY SIGNED AND SEALED UNDER RULE 61G15-23.004, F.A.C.

CITY OF VERO BEACH AIRPORT

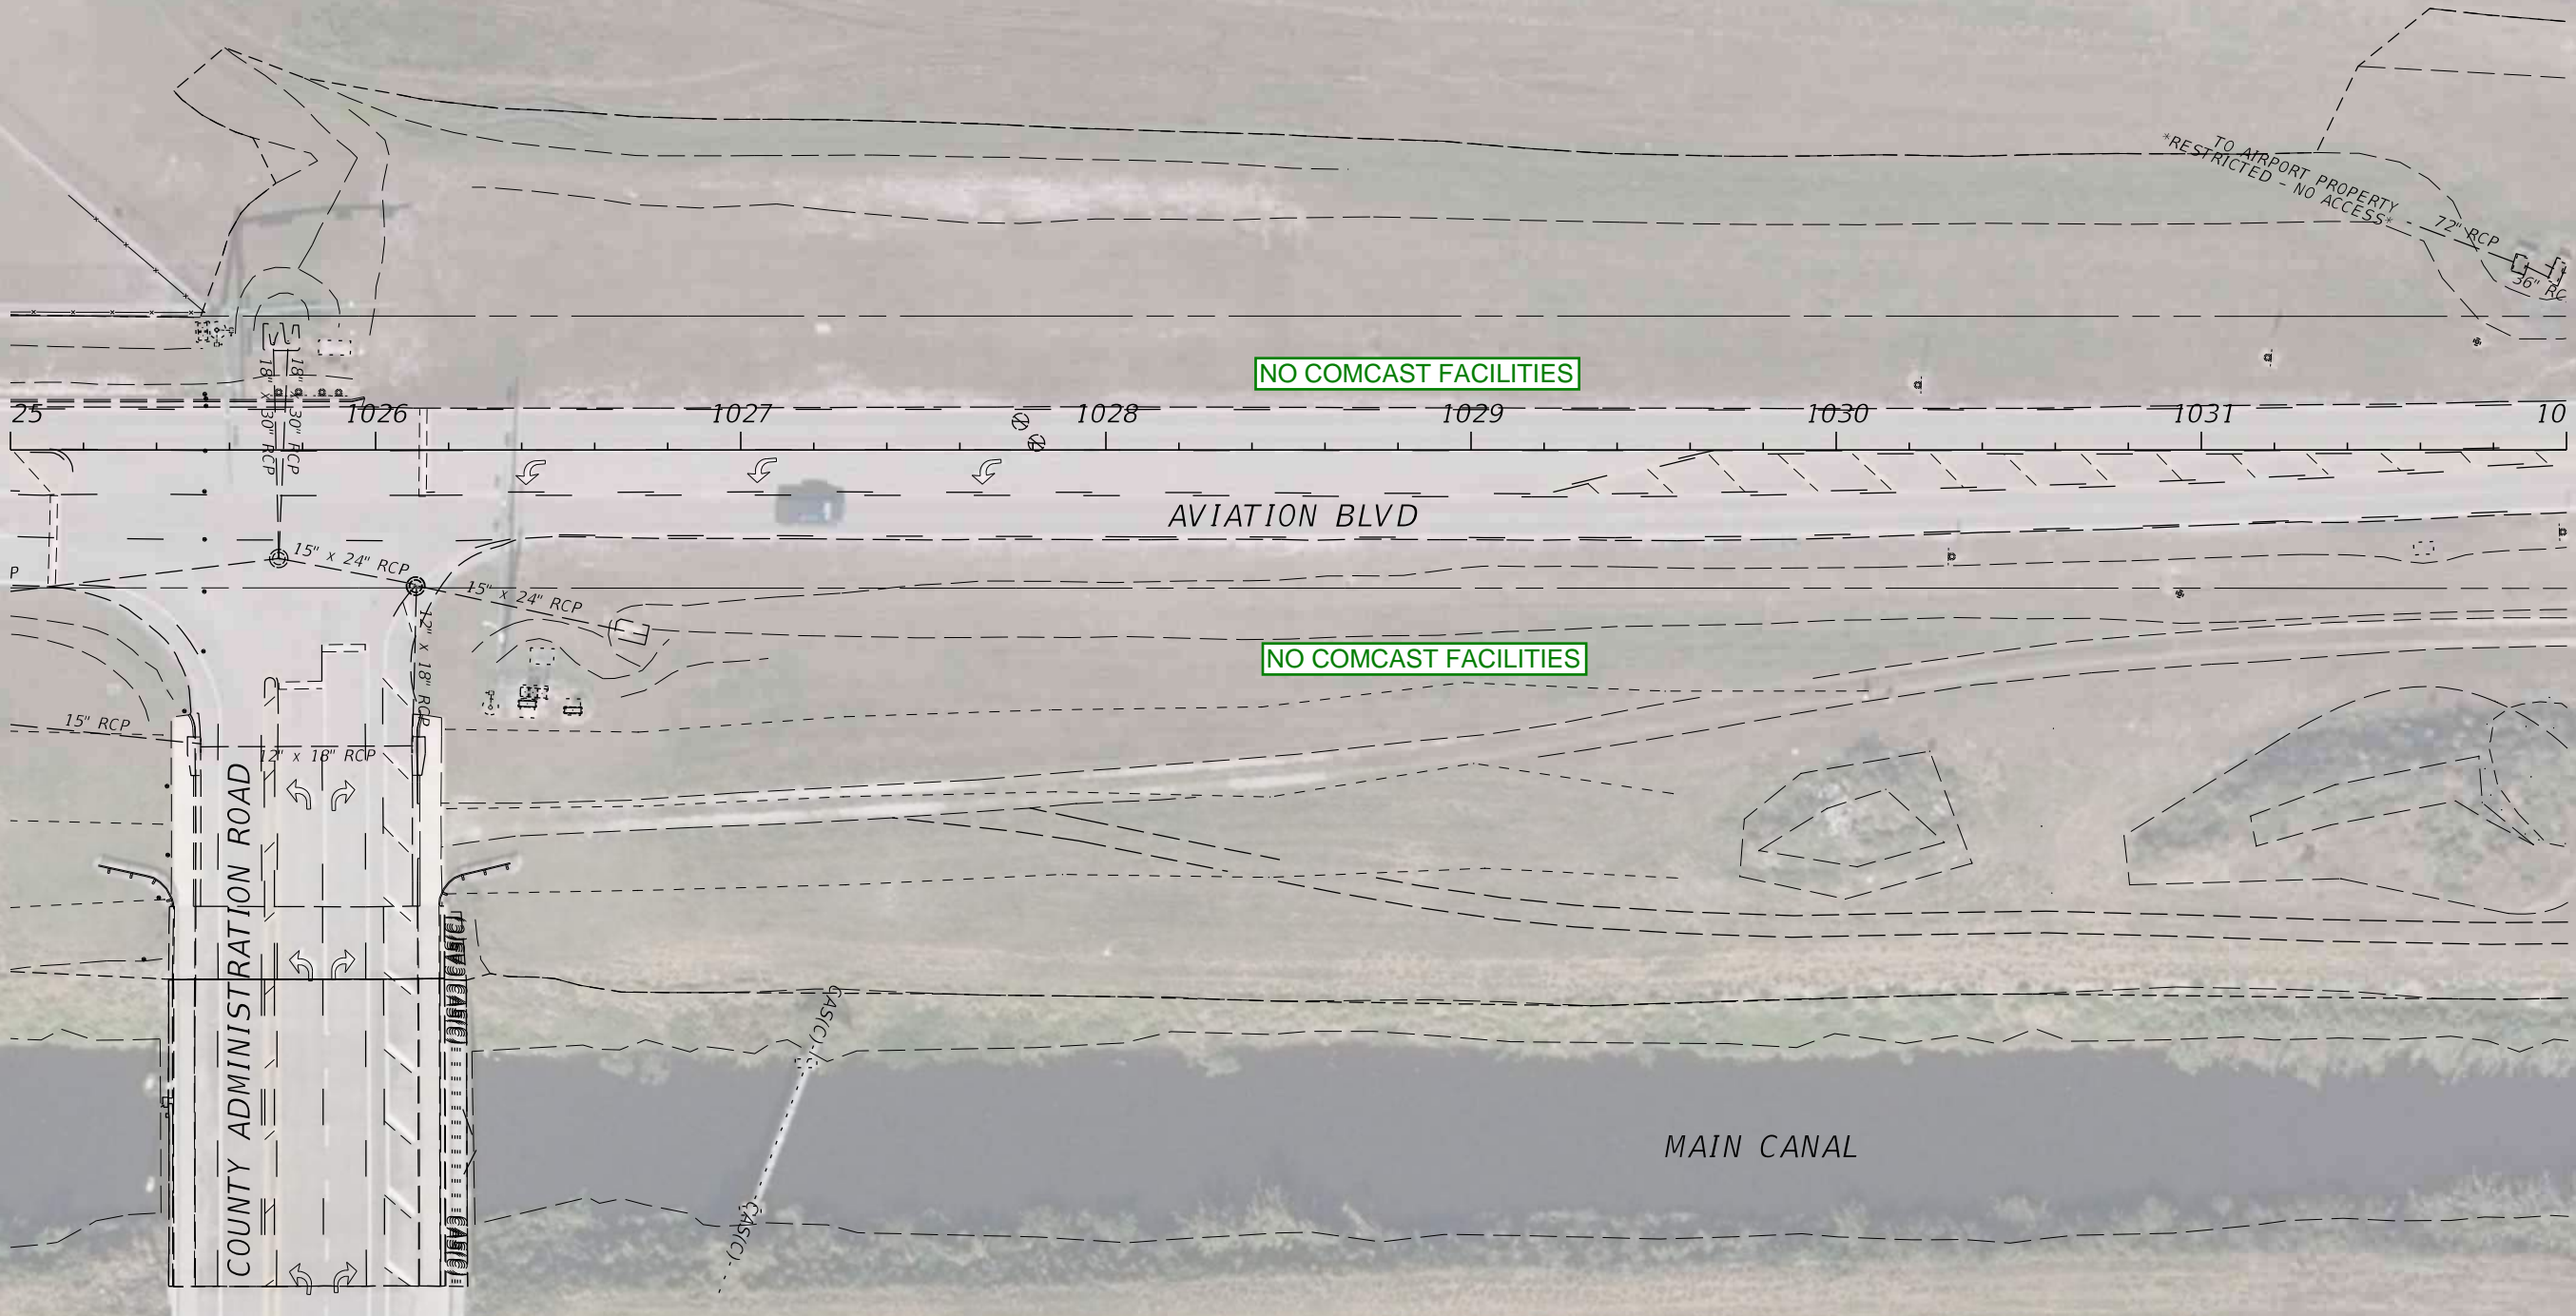

NO COMCAST FACILITIES

NO COMCAST FACILITIES

TO AIRPORT PROPERTY  
RESTRICTED - NO ACCESS

72" RCP  
56" RC

AVIATION BLVD

MAIN CANAL



COUNTY ADMINISTRATION ROAD

9/15/2022 11:09:17 AM Jacquelyn.Arreaga  
c:\pwworking\wgn\jacquelyn.arreaga\d2198192\PLAN\ARD01.dgn

REVISIONS		PROFESSIONAL TYPE		STATE OF FLORIDA DEPARTMENT OF TRANSPORTATION			UTILITY CONTACT PLAN (25)	SHEET NO. 25
DATE	DESCRIPTION	DATE	DESCRIPTION	ROAD NO.	COUNTY	FINANCIAL PROJECT ID		
				SR 5	INDIAN RIVER	441693-1-22-02		

WILLIAM EVANS  
LICENSE NUMBER: 45207  
WGI, INC.  
2035 VISTA PARKWAY  
WEST PALM BEACH, FL 33411

THE OFFICIAL RECORD OF THIS SHEET IS THE ELECTRONIC FILE DIGITALLY SIGNED AND SEALED UNDER RULE 61G15-23.004, F.A.C.

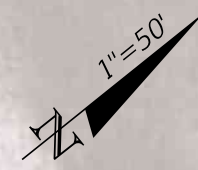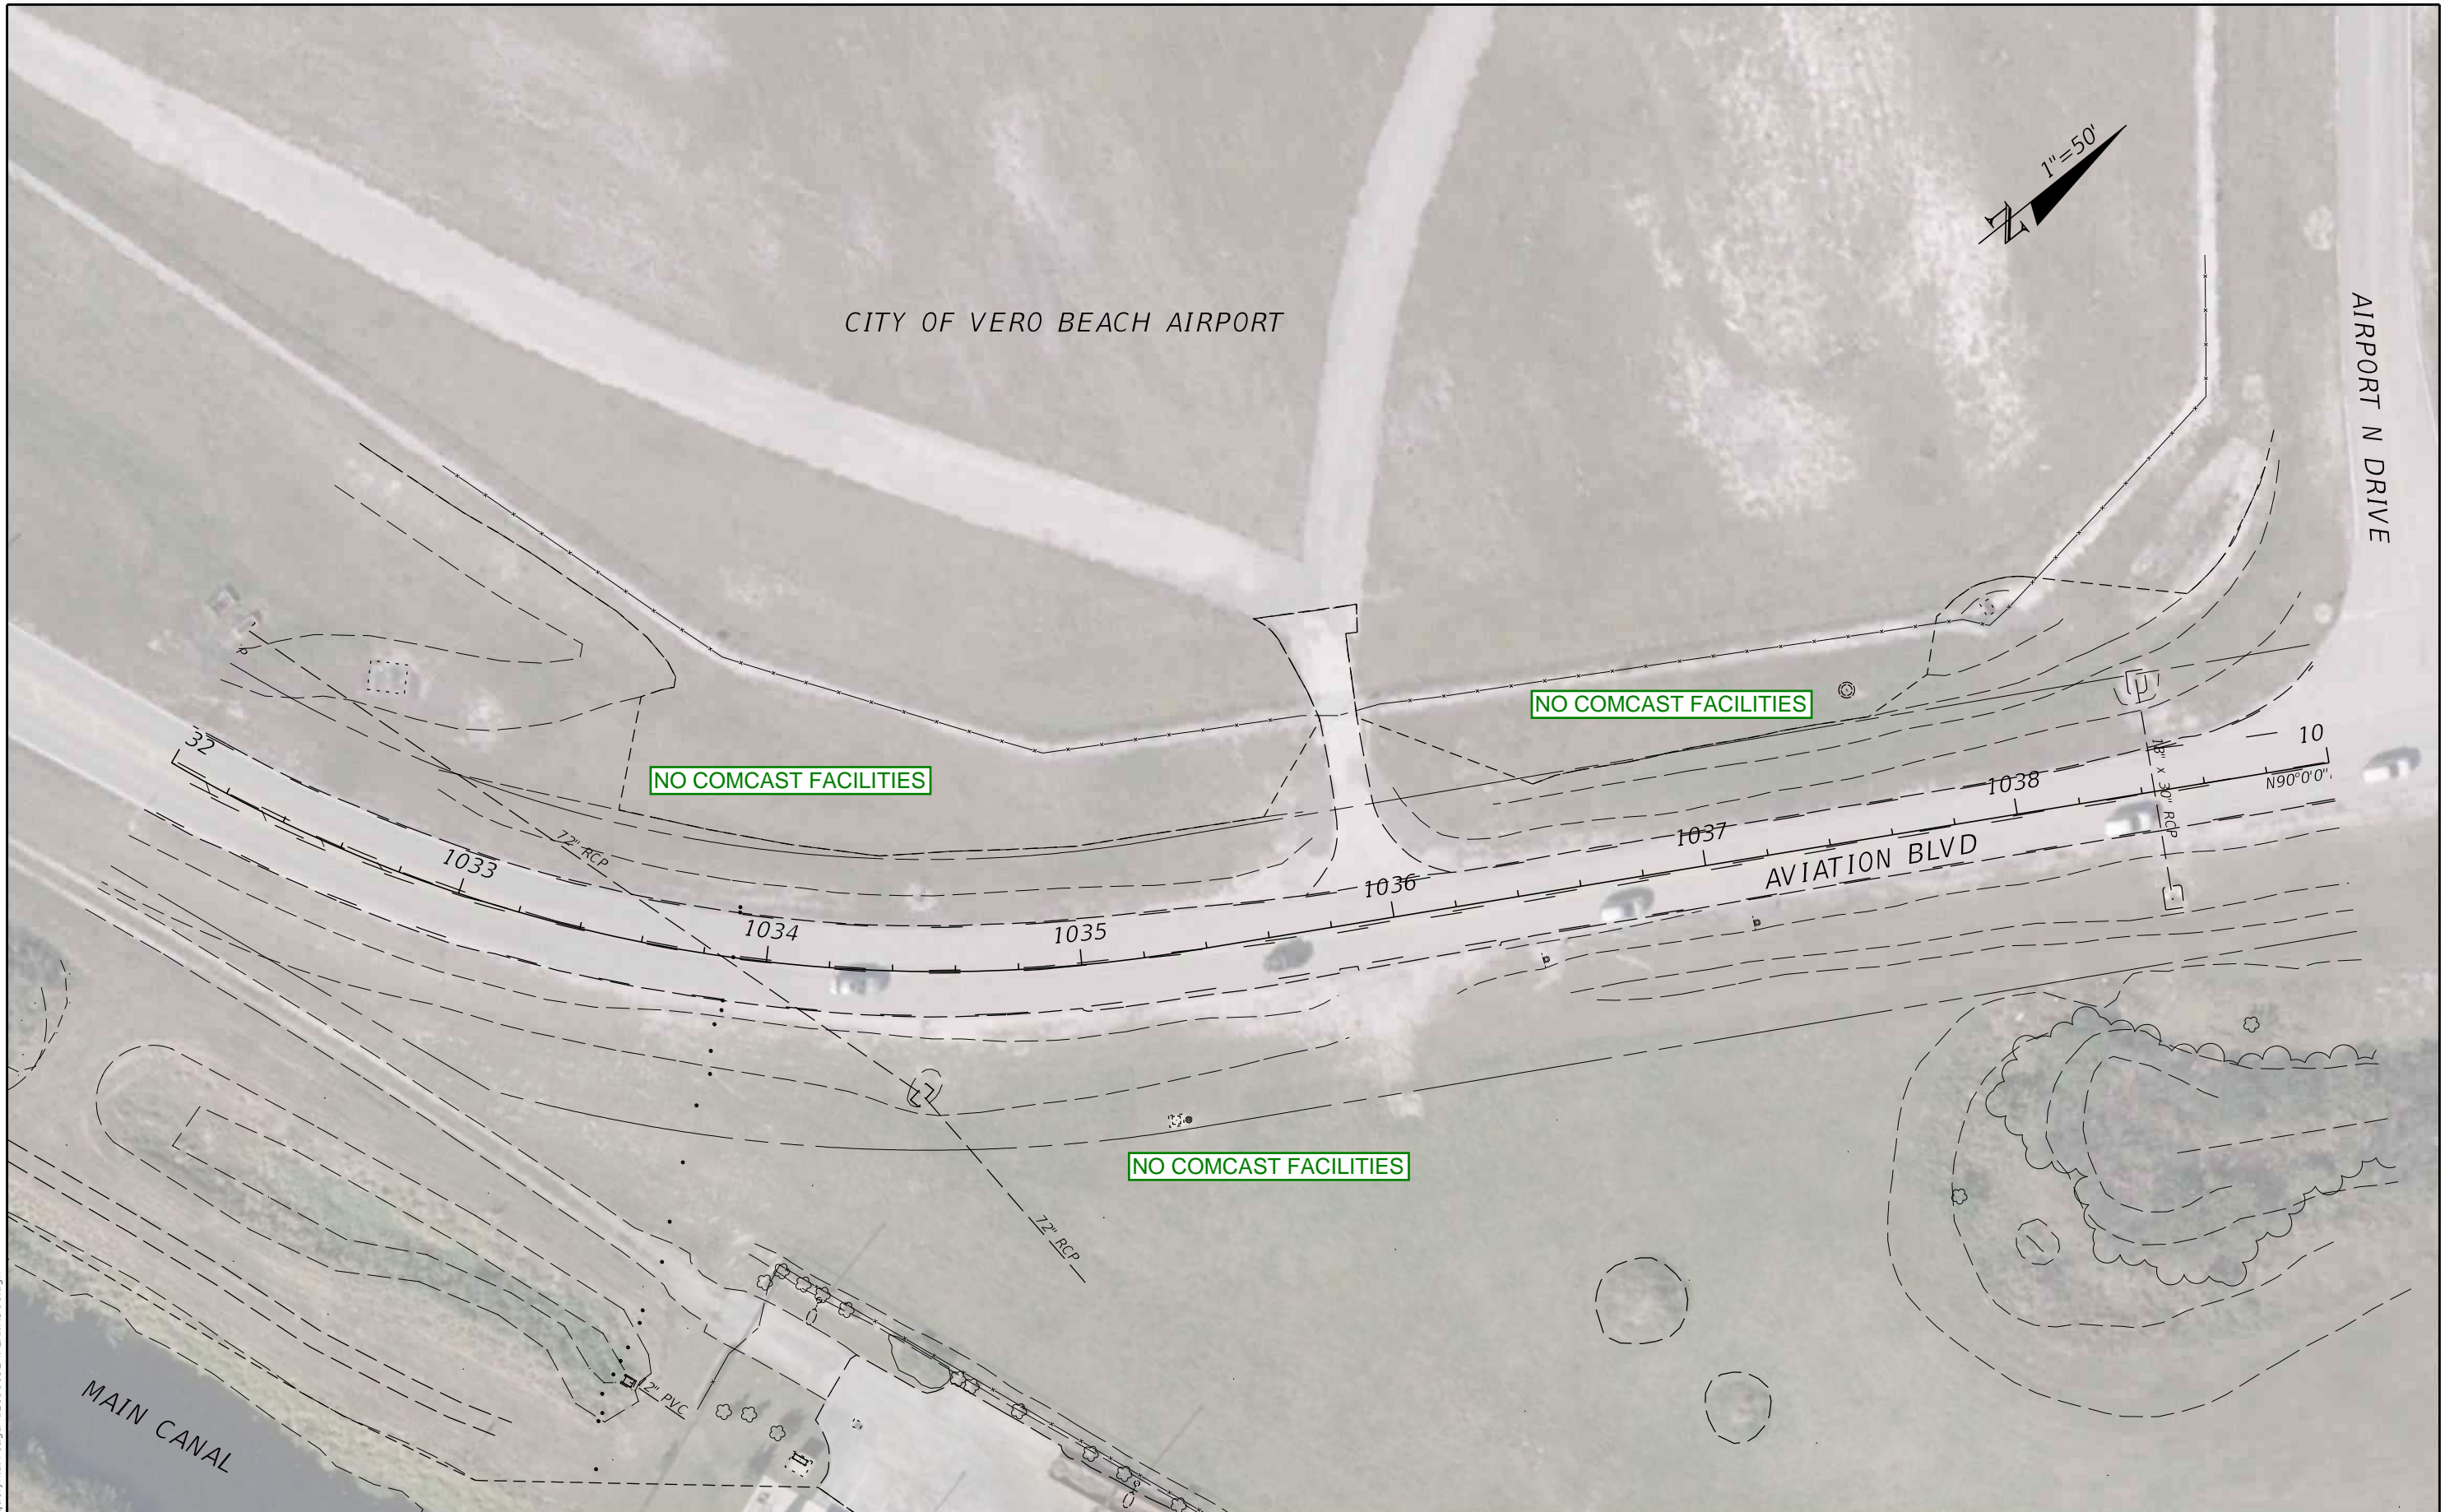

CITY OF VERO BEACH AIRPORT

AIRPORT N DRIVE

NO COMCAST FACILITIES

NO COMCAST FACILITIES

NO COMCAST FACILITIES

AVIATION BLVD


MAIN CANAL

9/15/2022 11:09:30 AM Jacquelyn.Arreaga c:\pwworking\wg\N\Jacquelyn.arreaga\d2198192\PLAN\ARD01.dgn

THE OFFICIAL RECORD OF THIS SHEET IS THE ELECTRONIC FILE DIGITALLY SIGNED AND SEALED UNDER RULE 61G15-23.004, F.A.C.

REVISIONS				PROFESSIONAL TYPE	STATE OF FLORIDA DEPARTMENT OF TRANSPORTATION			UTILITY CONTACT PLAN (26)	SHEET NO. 26
DATE	DESCRIPTION	DATE	DESCRIPTION		ROAD NO.	COUNTY	FINANCIAL PROJECT ID		
				WILLIAM EVANS LICENSE NUMBER: 45207 WGI, INC. 2035 VISTA PARKWAY WEST PALM BEACH, FL 33411	SR 5	INDIAN RIVER	441693-1-22-02		

CITY OF VERO BEACH AIRPORT

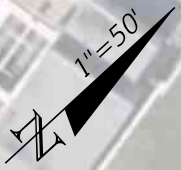

NO COMCAST FACILITIES

NO COMCAST FACILITIES



9/15/2022 11:09:43 AM Jacquelyn.Arreaga c:\pwworking\wgn\jacquelyn.arreaga\d2198192\PLAN\RD01.dgn

REVISIONS				PROFESSIONAL TYPE	STATE OF FLORIDA DEPARTMENT OF TRANSPORTATION			SHEET NO.
DATE	DESCRIPTION	DATE	DESCRIPTION		ROAD NO.	COUNTY	FINANCIAL PROJECT ID	
				WILLIAM EVANS LICENSE NUMBER: 45207 WGI, INC. 2035 VISTA PARKWAY WEST PALM BEACH, FL 33411	SR 5	INDIAN RIVER	441693-1-22-02	27

UTILITY CONTACT PLAN (27)

THE OFFICIAL RECORD OF THIS SHEET IS THE ELECTRONIC FILE DIGITALLY SIGNED AND SEALED UNDER RULE 61G15-23.004, F.A.C.

## Appendices

### Appendix D

#### Crown Castle

**Owen Smith**

---


**From:** South Florida Plans Review <SouthFloridaPlansReview@crowncastle.com>  
**Sent:** Friday, July 7, 2023 1:20 PM  
**To:** Owen Smith  
**Subject:** [EXTERNAL] RE: FPID 441693-1-22-02: Aviation Blvd PD&E Study from 27th Ave to US1/SR5 and SR5 from 21st St. to 37th St - Utility Greenline Markup Request  
**Attachments:** 441693-1-22-02-UtilityContactPlanSet\_2022-0915.pdf


Owen,

Attached are the maps showing the CCF facilities within the limits of project 441693-1-52-01 in Indian River County. We have no facilities on sheets 17 through 26.

Let me know if you need anything more.

Regards, Danny

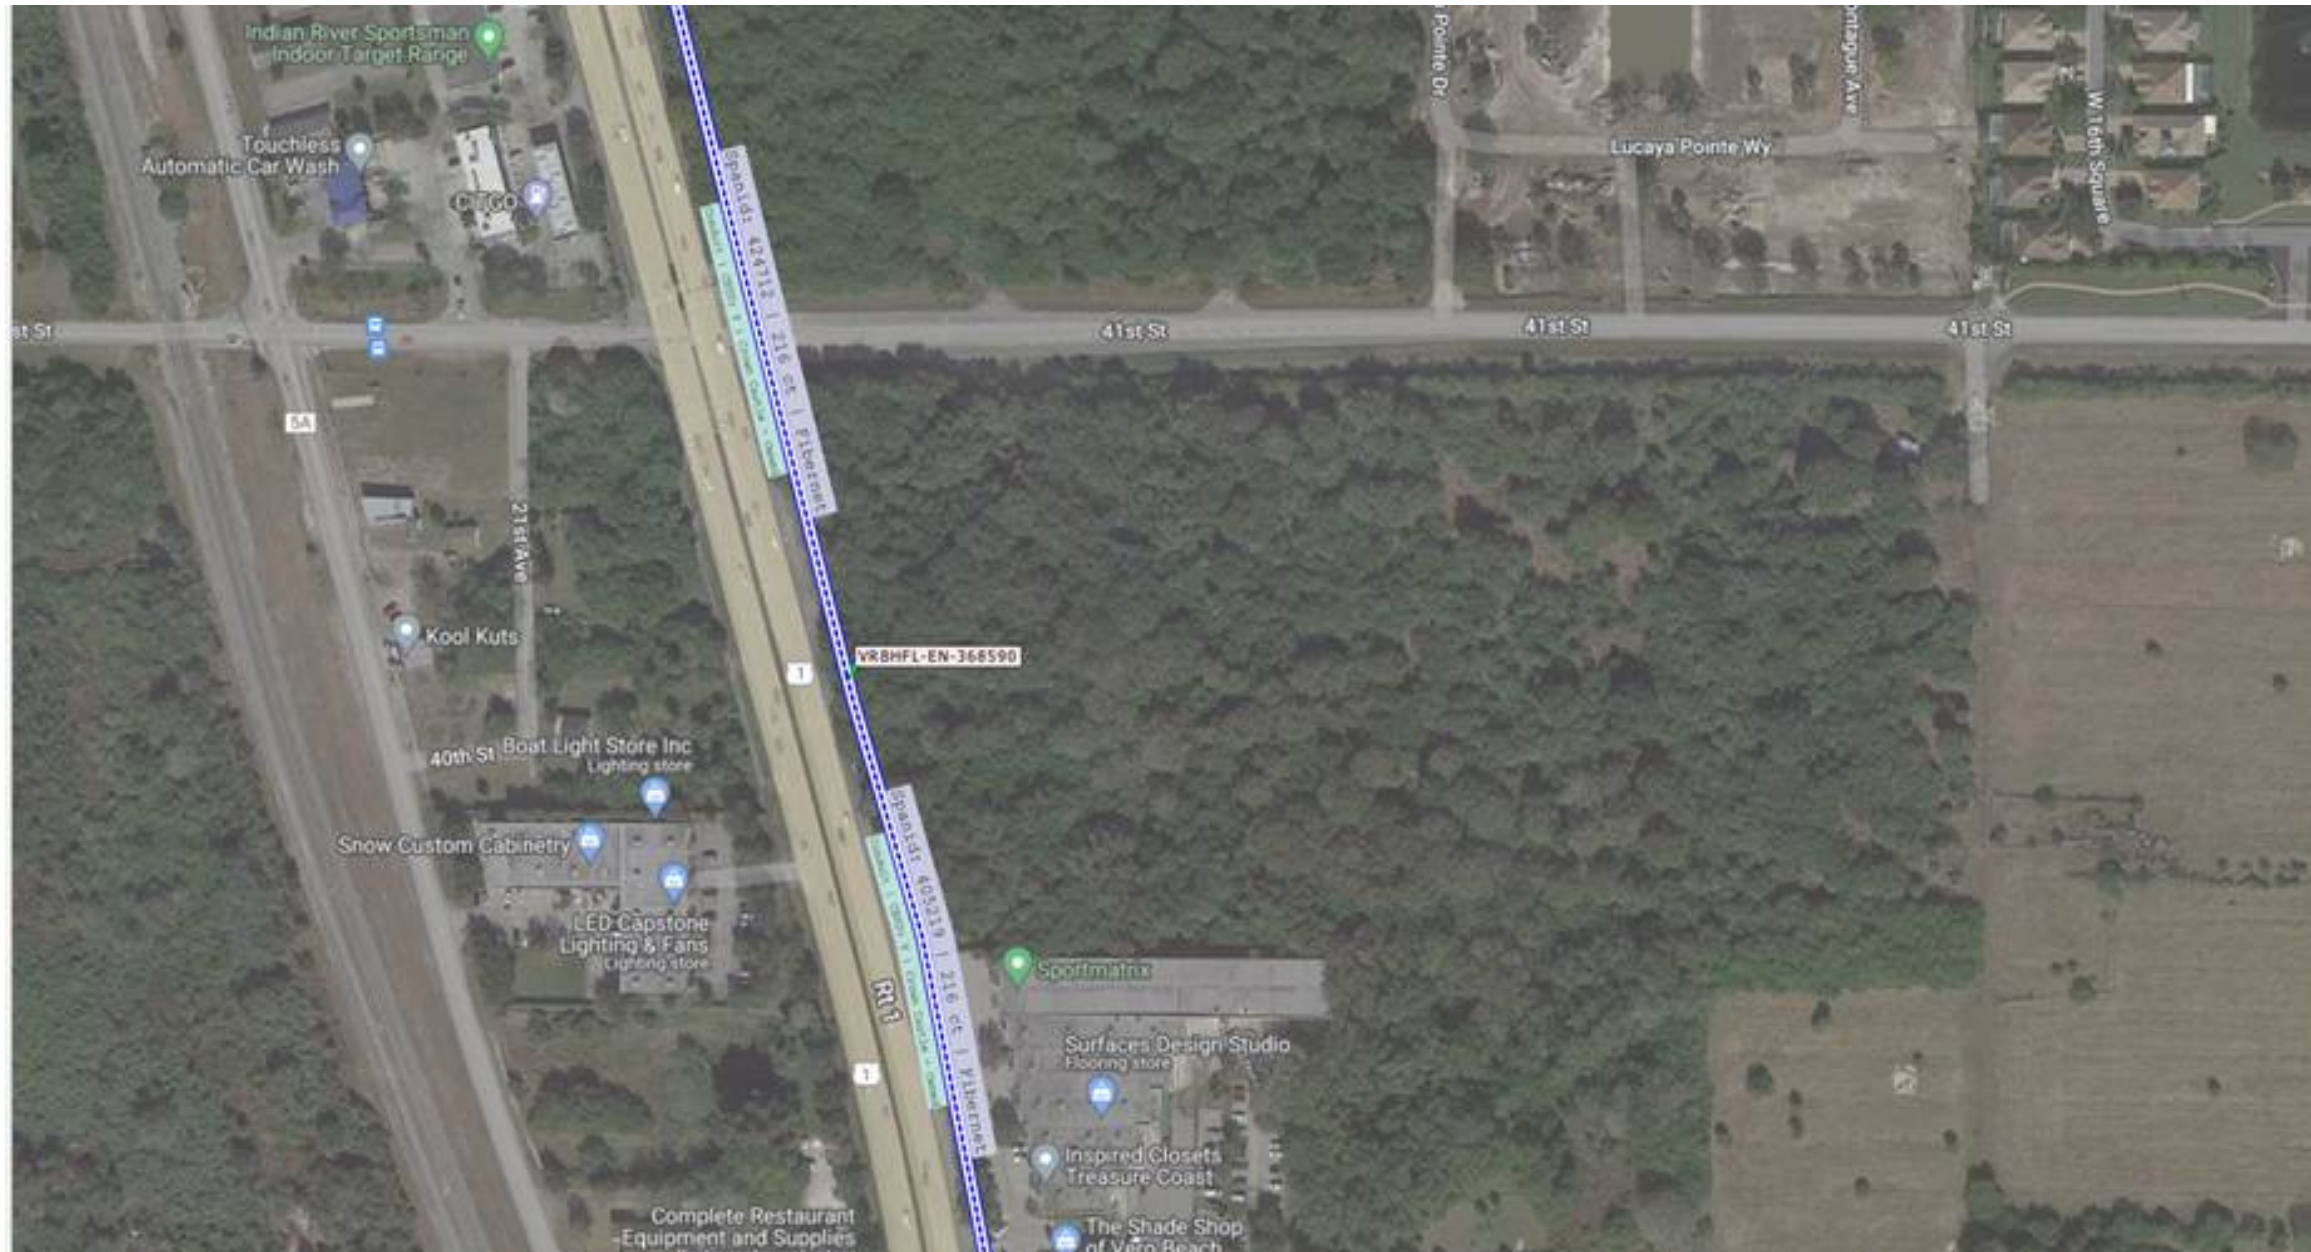

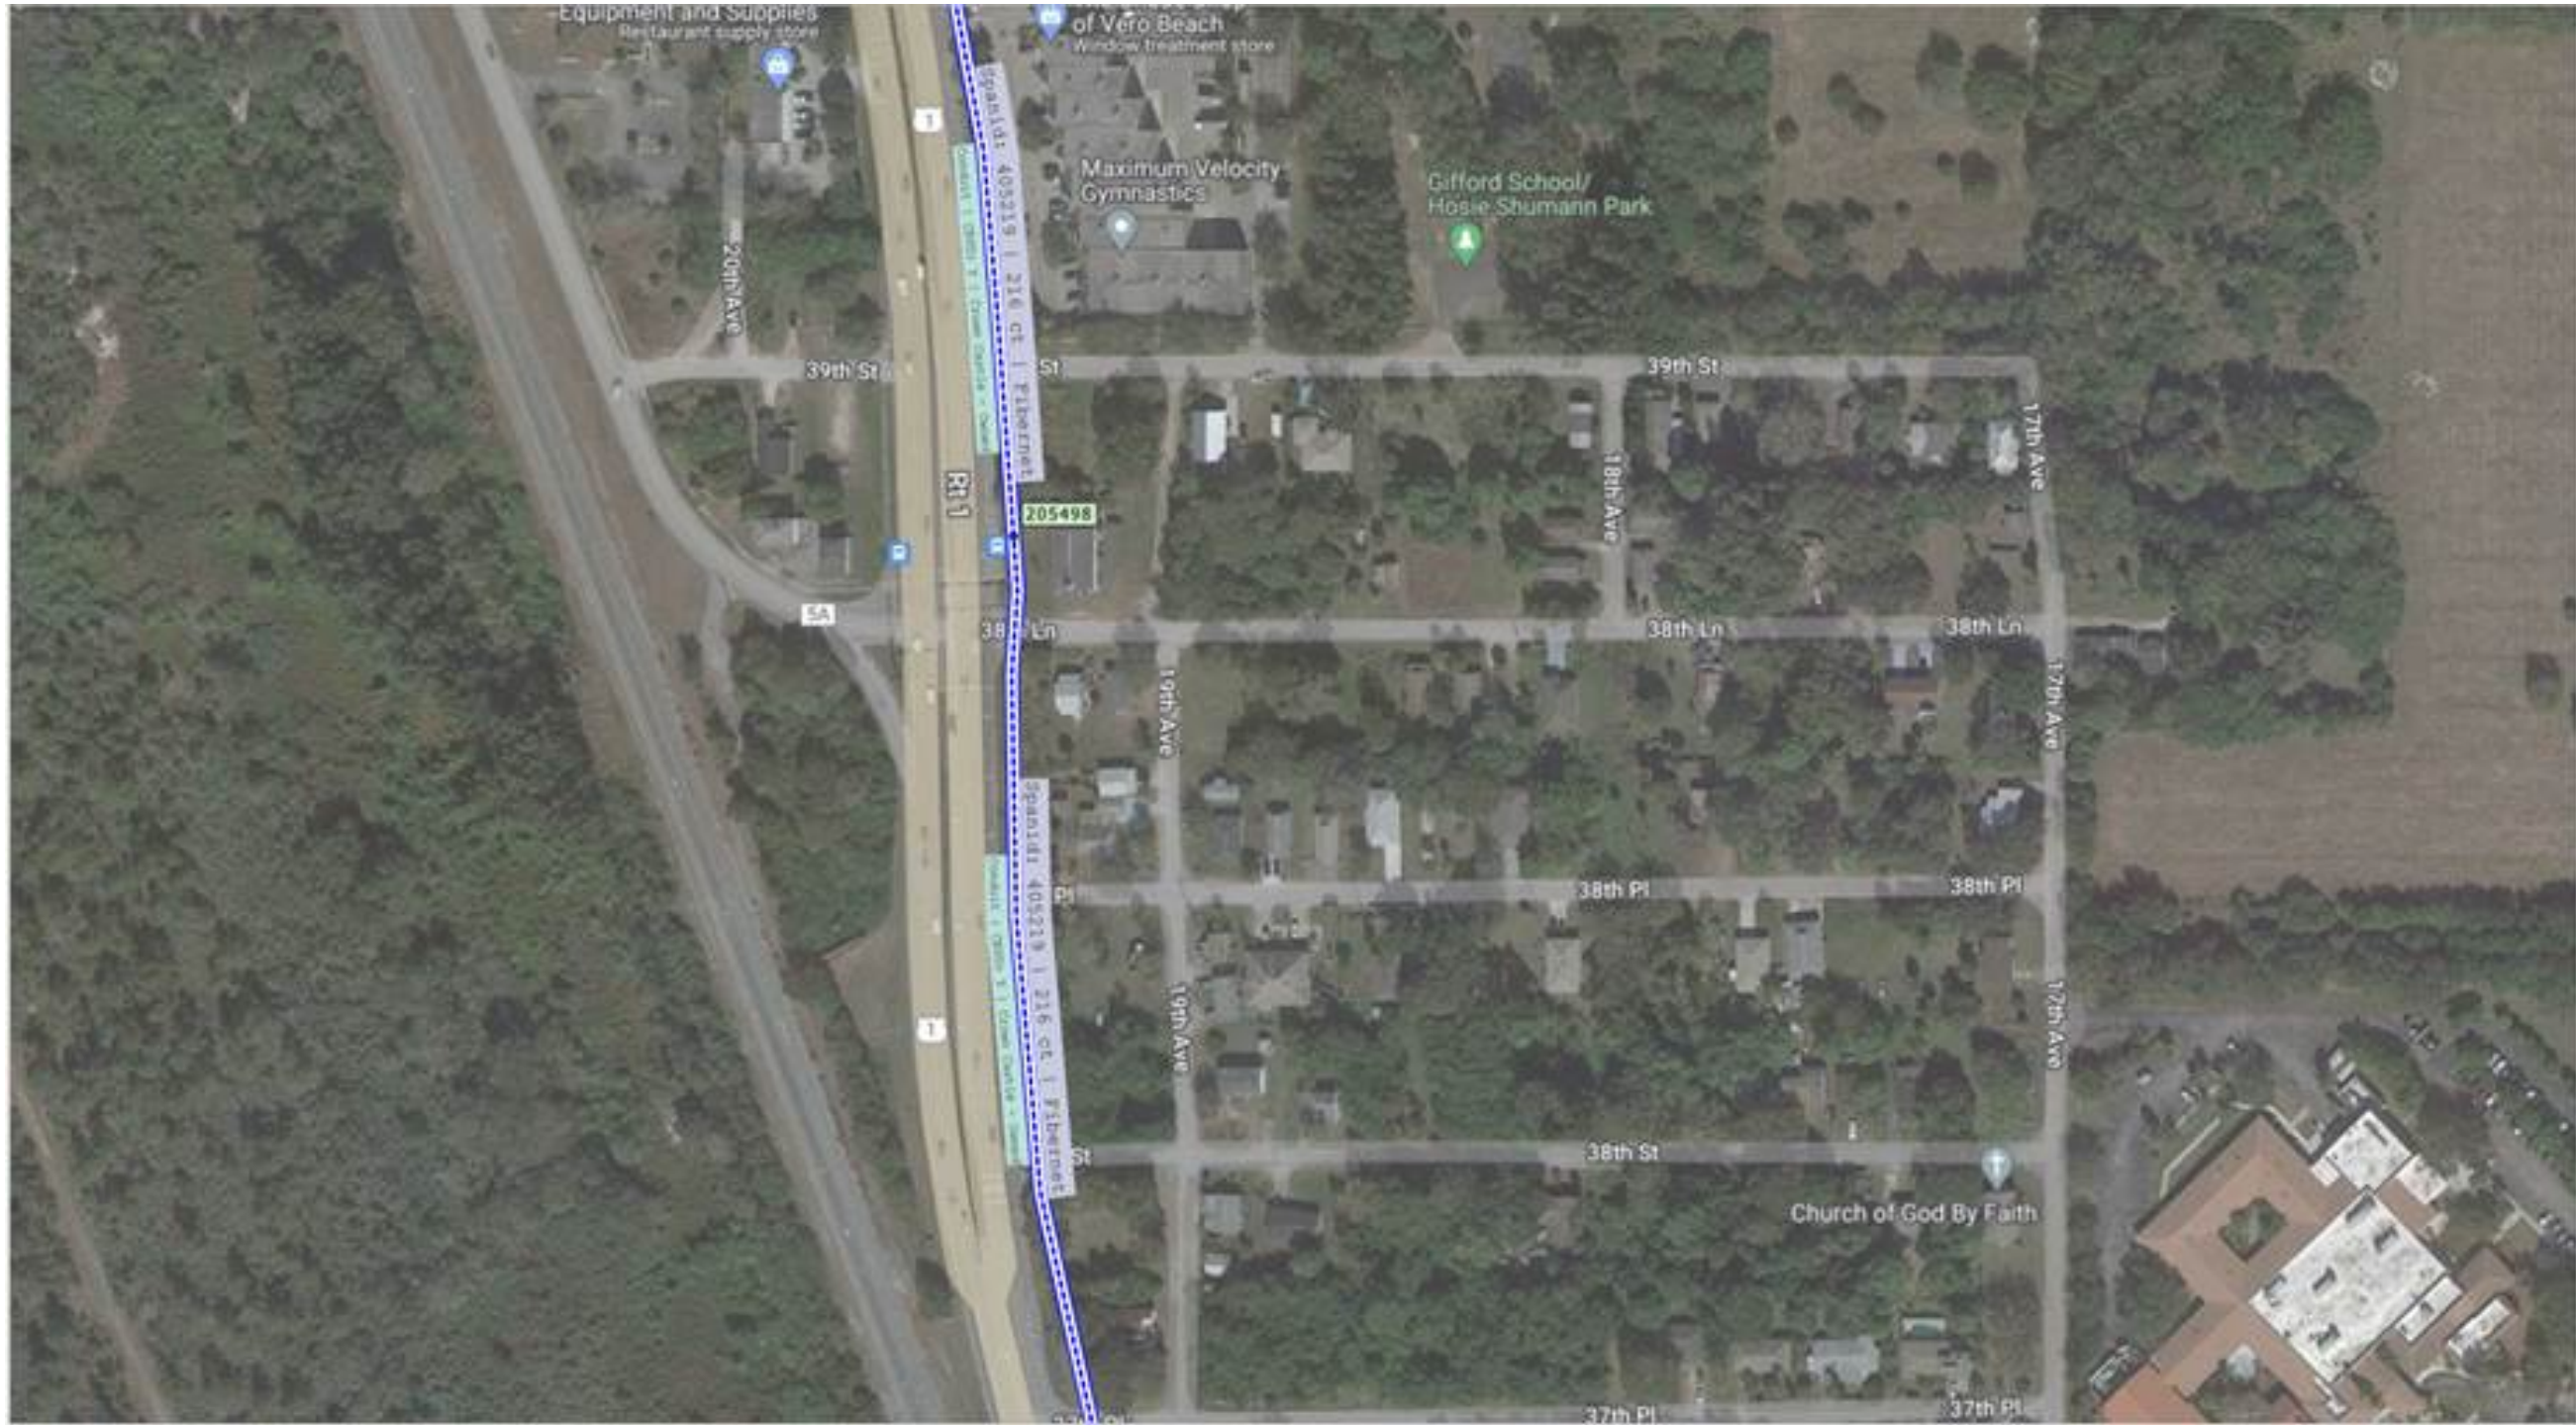











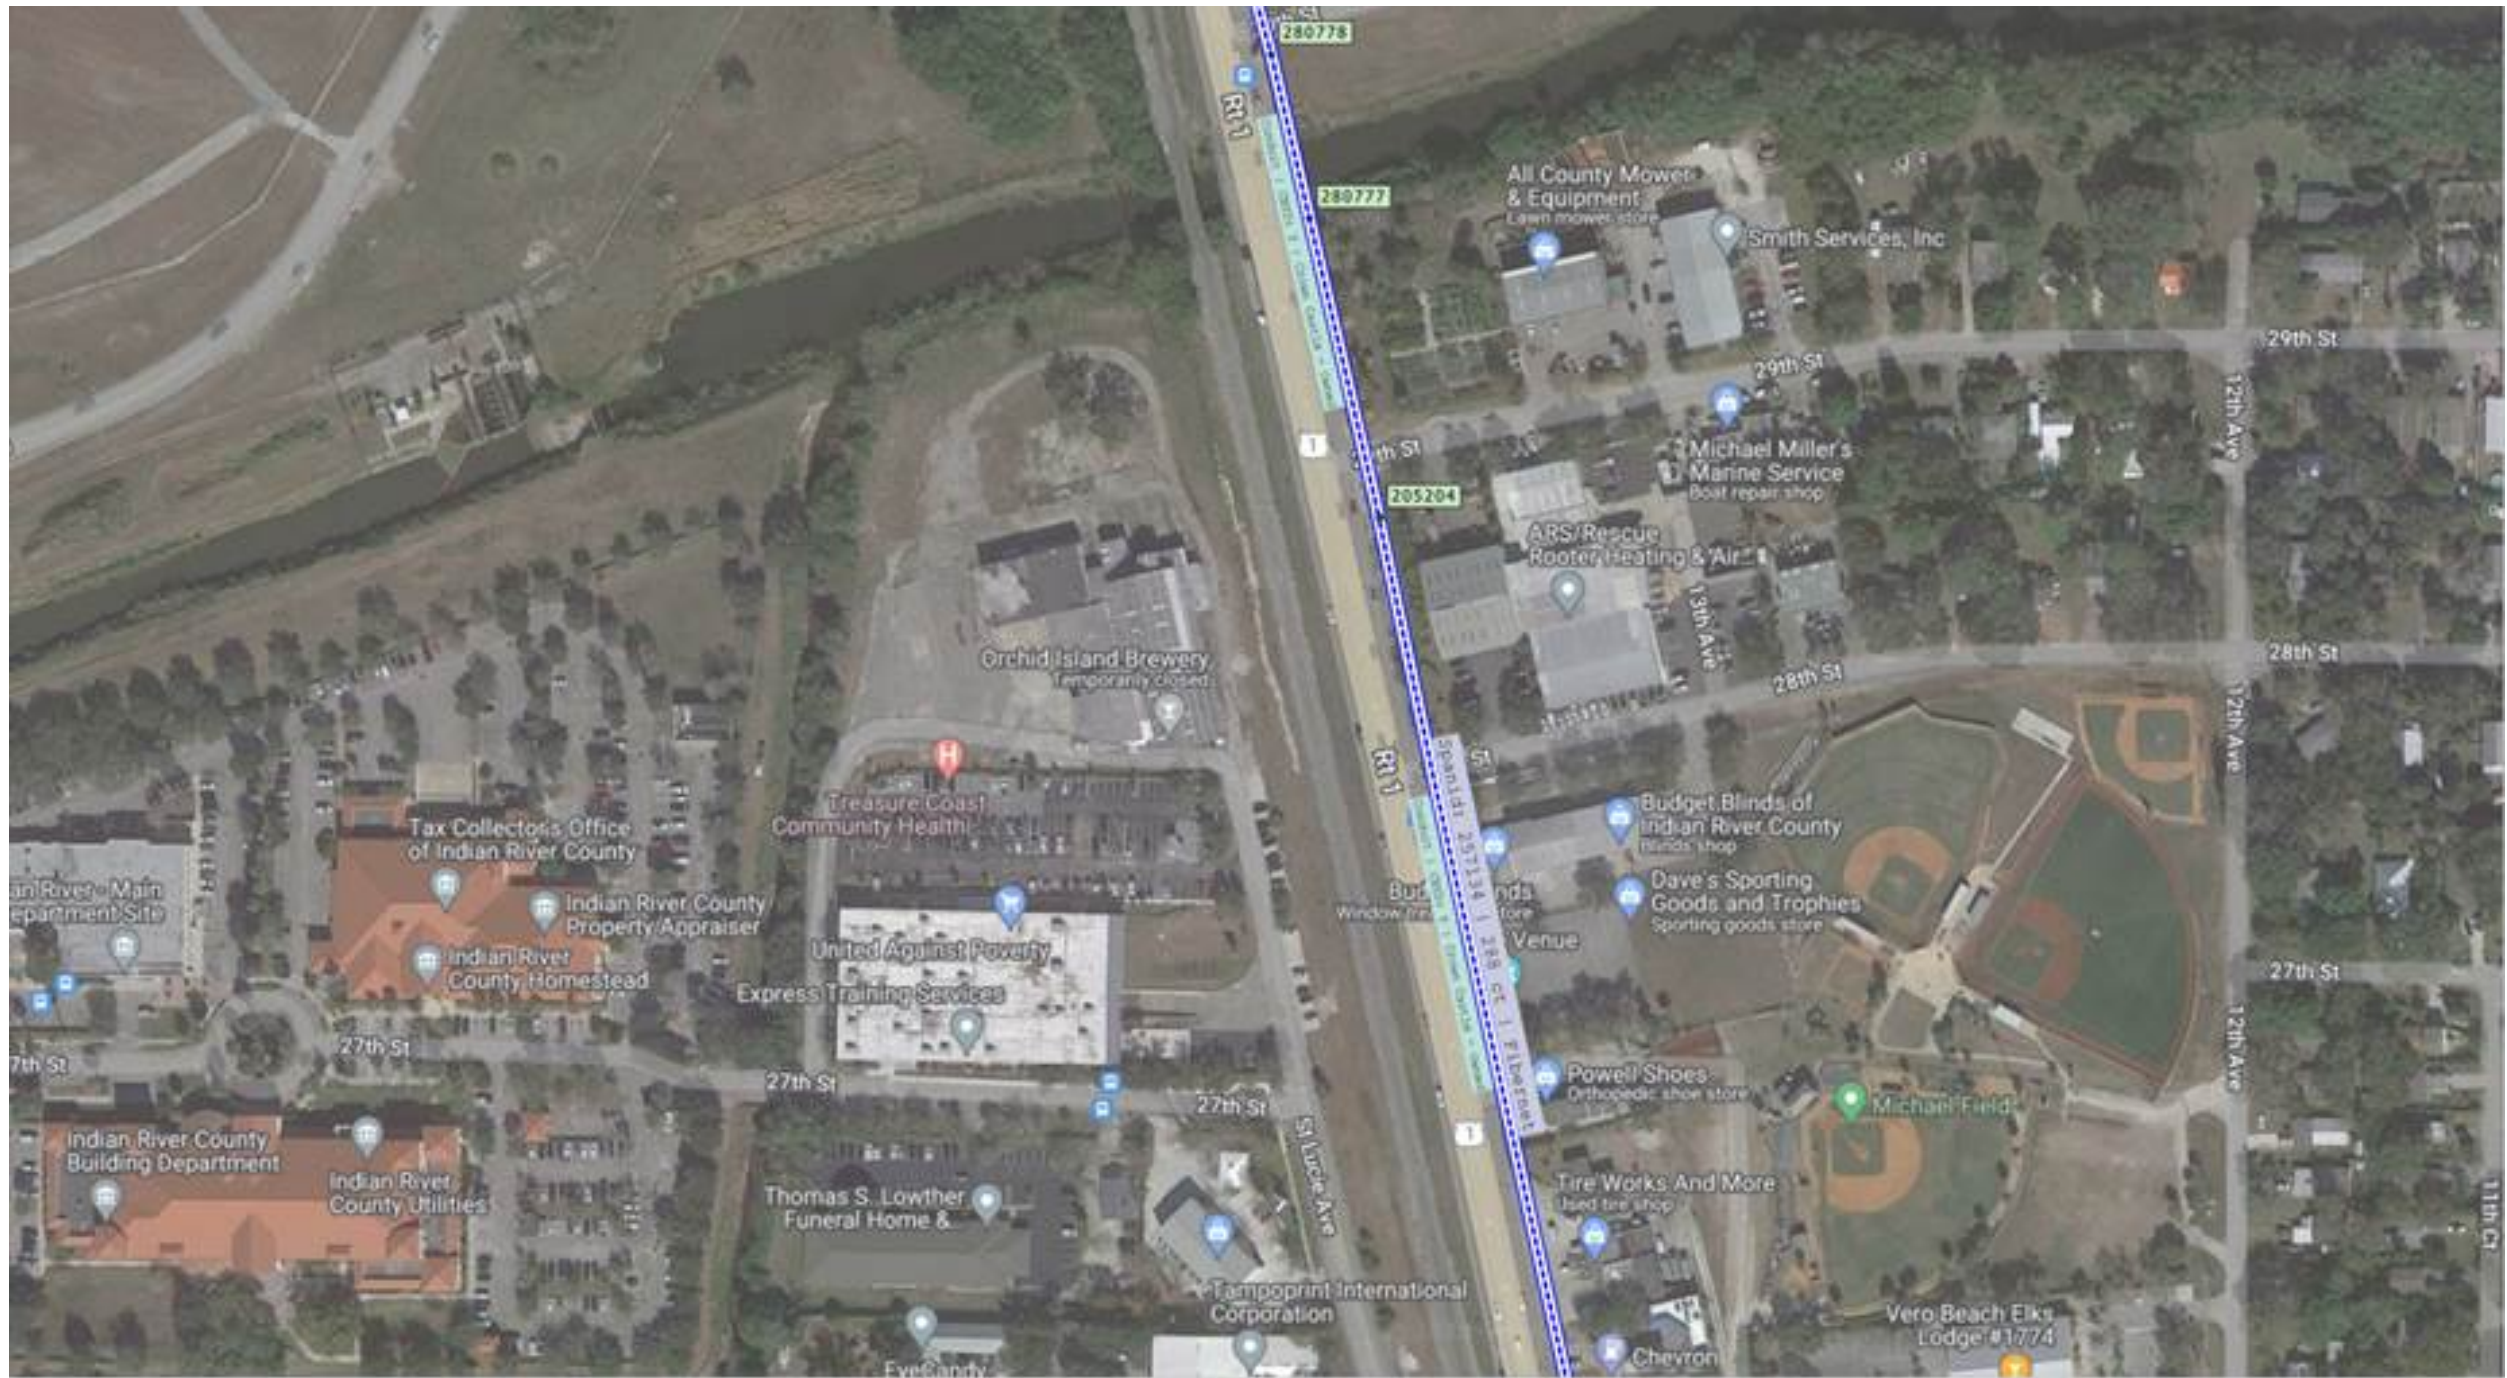

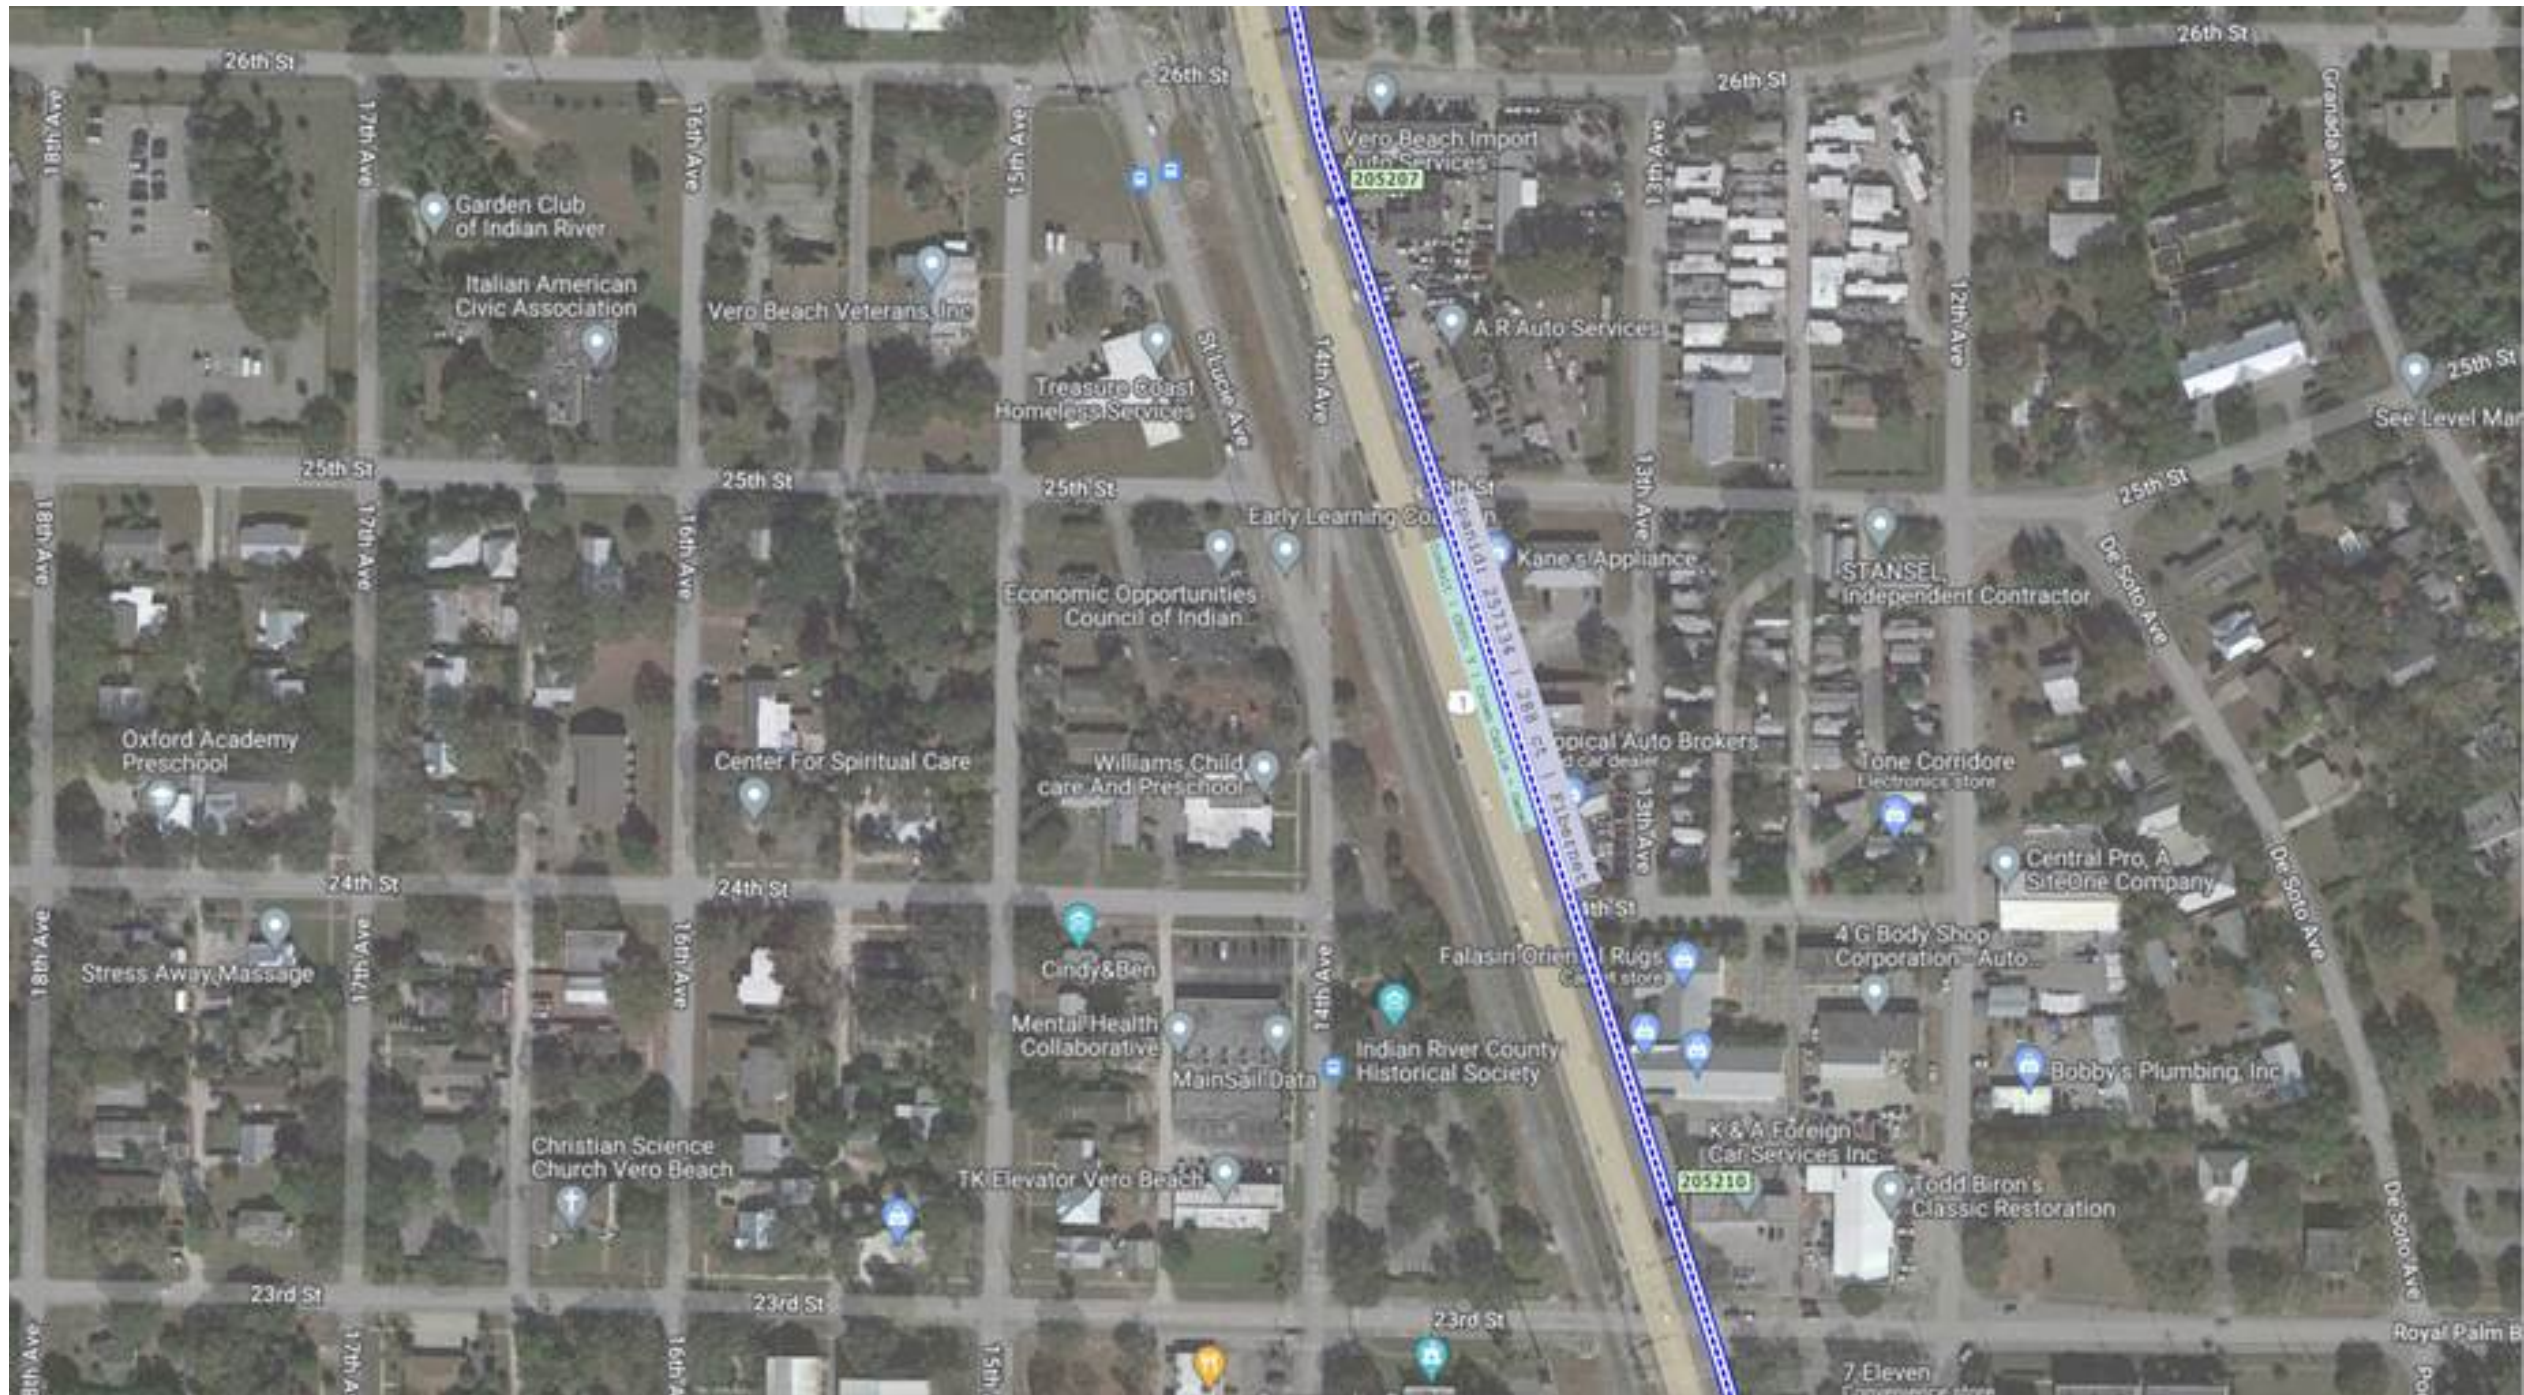





Regards, Danny

**DANNY HASKETT**

Operations Manager

T: 786-610-7073 | M: 786-246-7827


**CROWN CASTLE FIBER**

9250 W Flagler Street, Miami, FL 33174

[Fiber.CrownCastle.com](http://Fiber.CrownCastle.com)

**Appendix D**

**Florida City Gas/ NextEra**

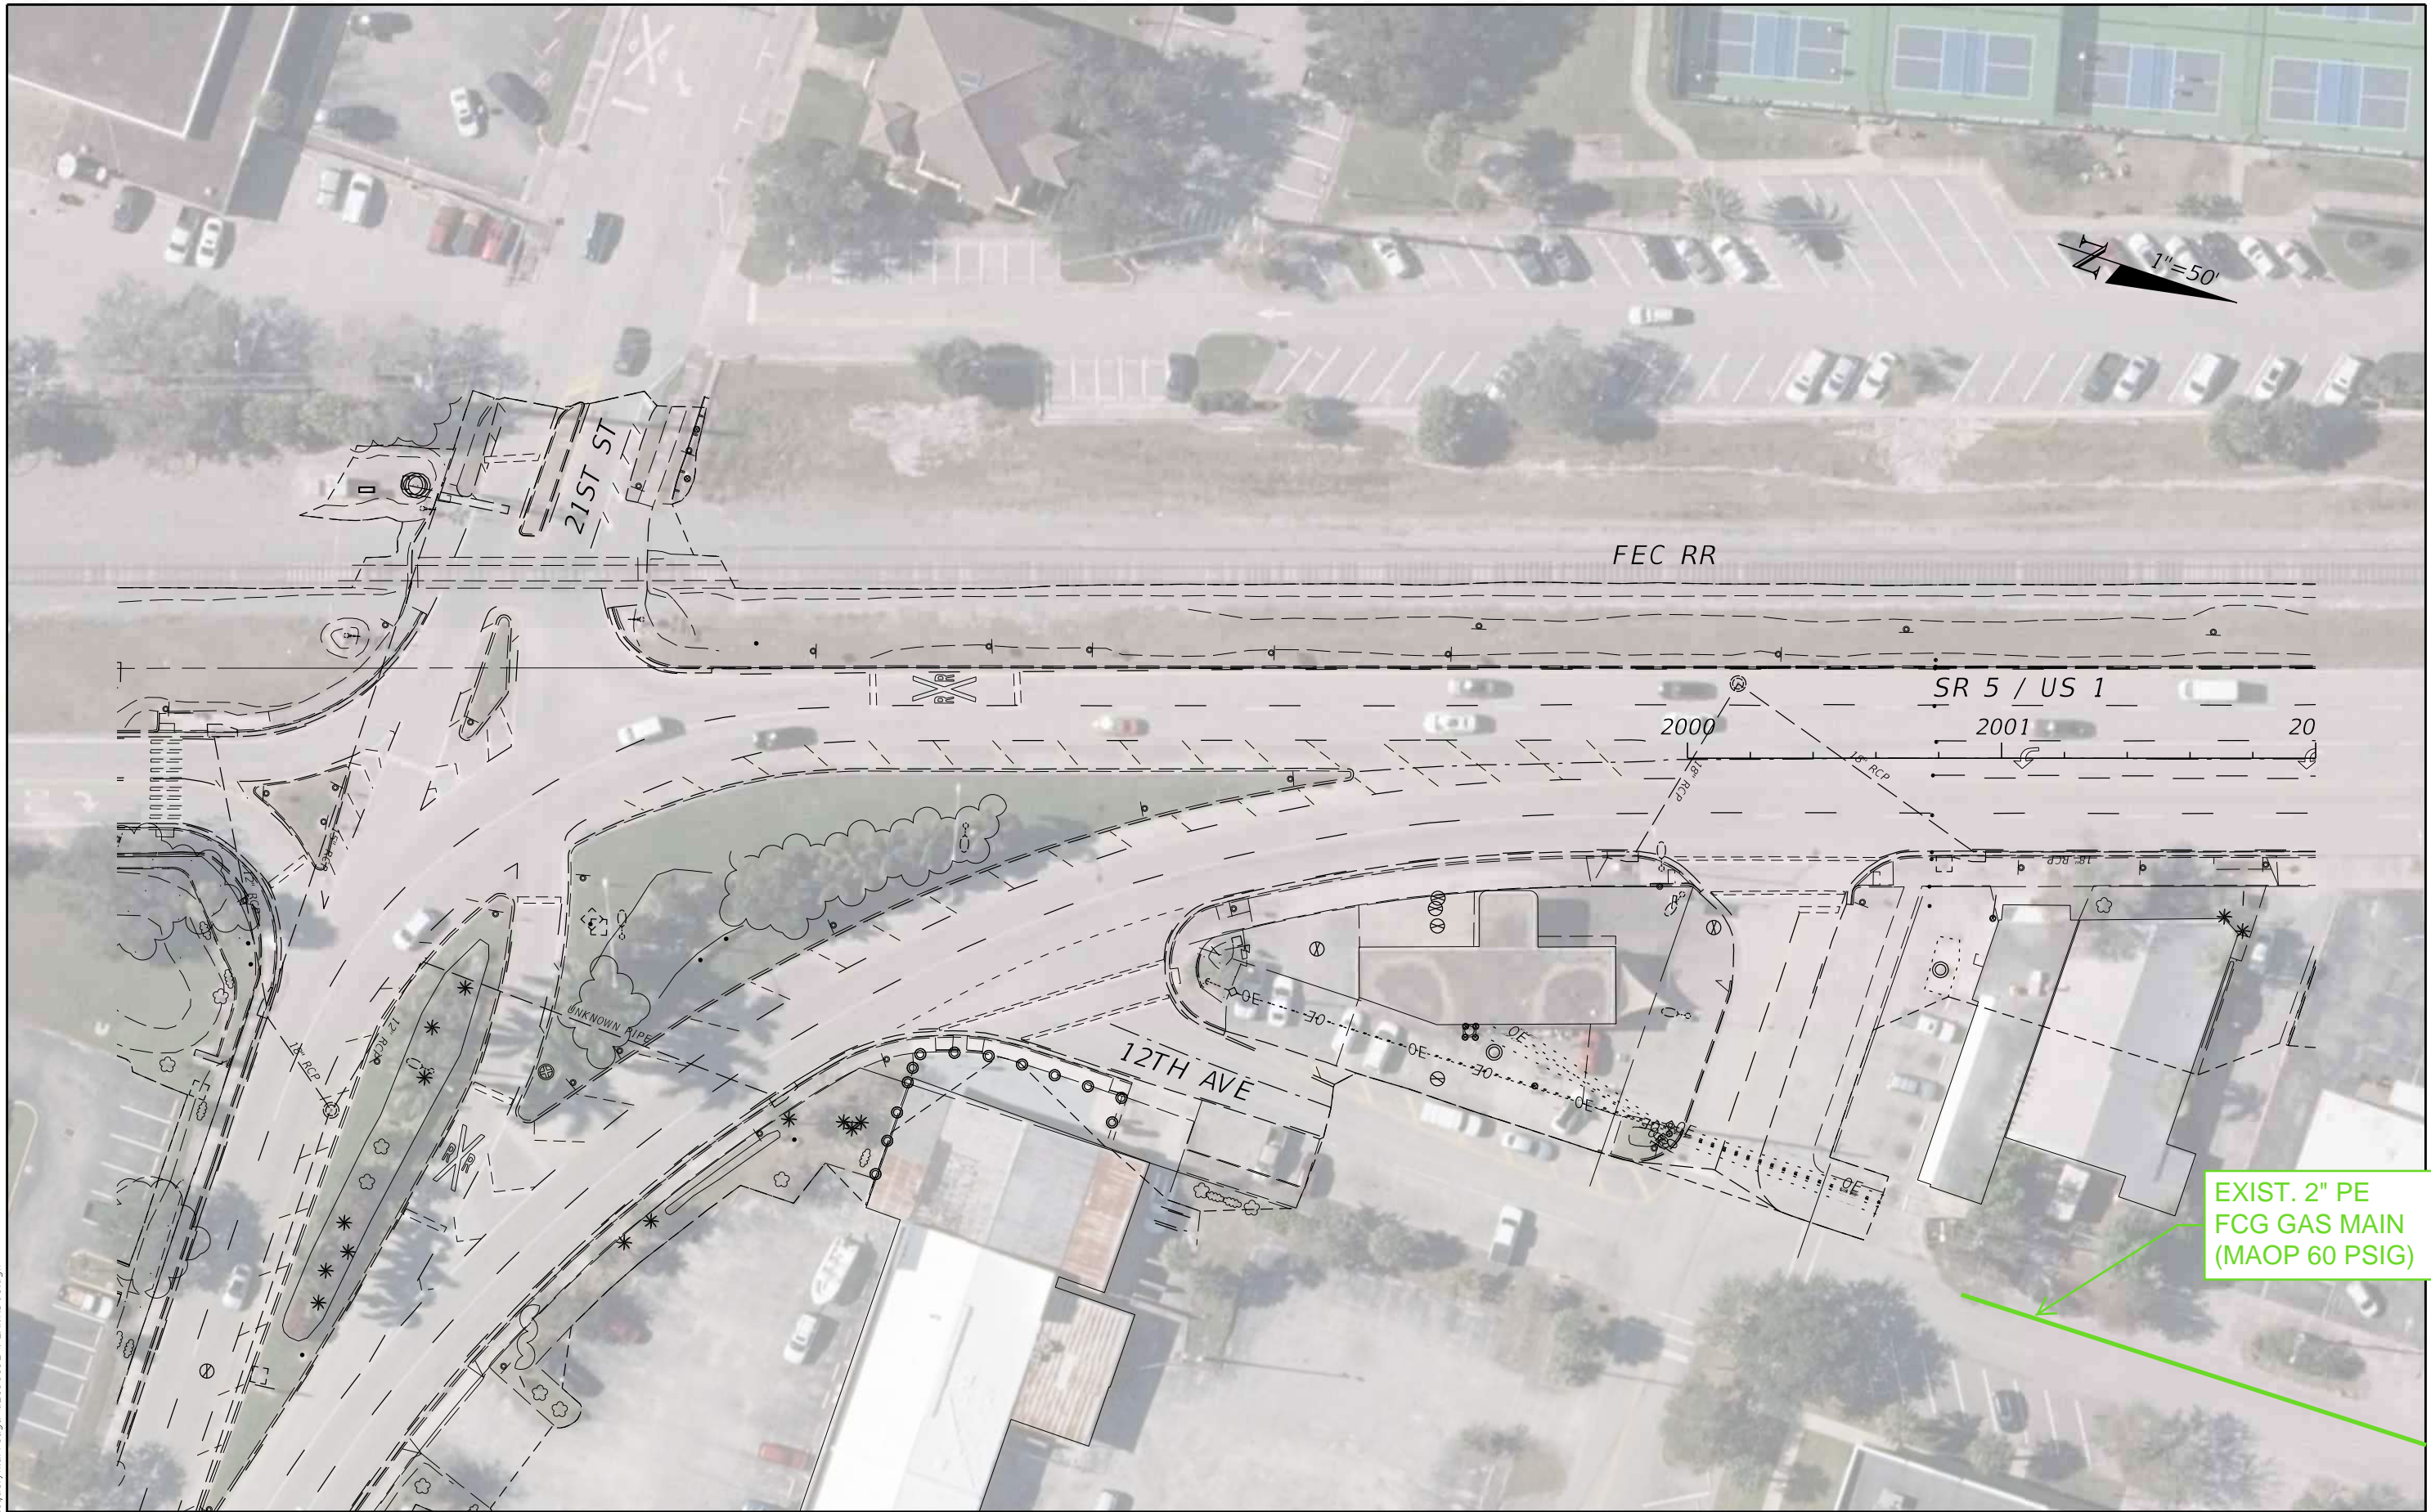

9/15/2022 10:58:52 AM Jacquelyn.Arreaga  
 c:\pwworking\wgi\jacquelyn.arreaga\d2198192\PLANRD01.dgn

REVISIONS	
DATE	DESCRIPTION

**PROFESSIONAL TYPE**  
 WILLIAM EVANS  
 LICENSE NUMBER: 45207  
 WGI, INC.  
 2035 VISTA PARKWAY  
 WEST PALM BEACH, FL 33411


STATE OF FLORIDA DEPARTMENT OF TRANSPORTATION		
ROAD NO.	COUNTY	FINANCIAL PROJECT ID
SR 5	INDIAN RIVER	441693-1-22-02

**UTILITY CONTACT PLAN (1)**

**SHEET NO.**  
 1

THE OFFICIAL RECORD OF THIS SHEET IS THE ELECTRONIC FILE DIGITALLY SIGNED AND SEALED UNDER RULE 61G15-23.004, F.A.C.



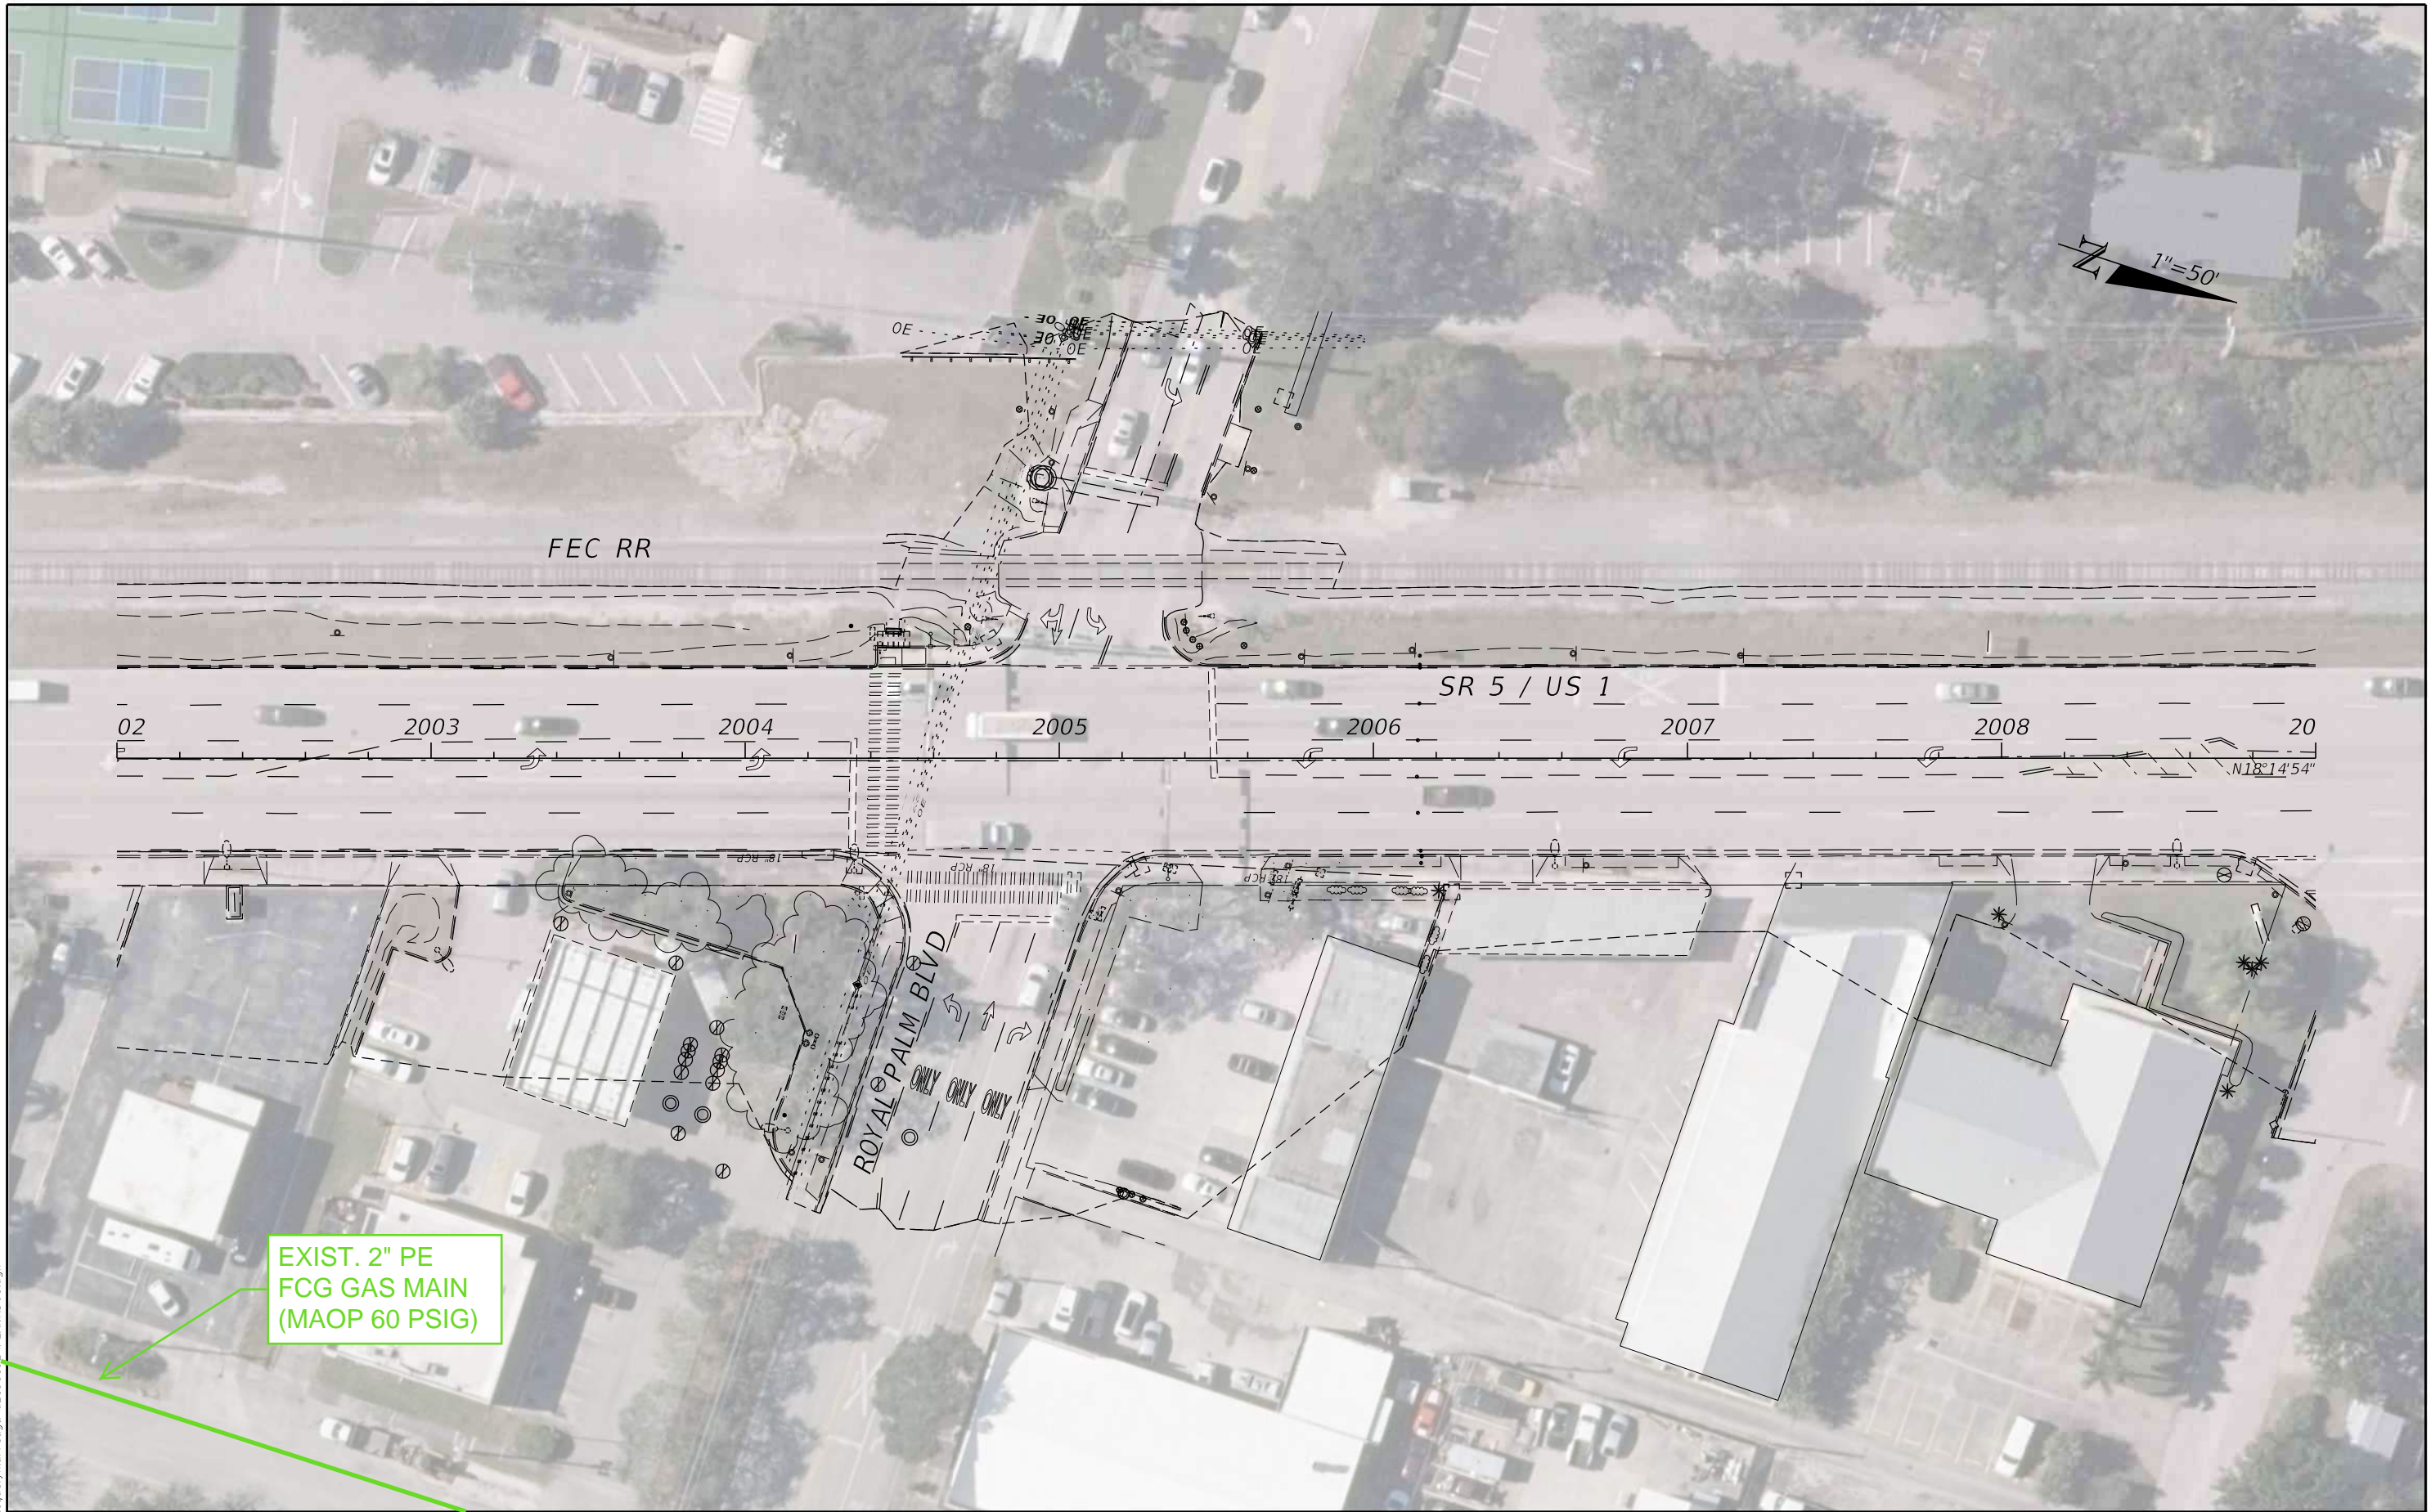


EXIST. 2" PE  
FCG GAS MAIN  
(MAOP 60 PSIG)

9/15/2022 10:59:58 AM Jacquelyn.Arreaga  
c:\pwworking\wgn\jacquelyn.arreaga\d2198192\PLANRD01.dgn

REVISIONS		PROFESSIONAL TYPE		STATE OF FLORIDA DEPARTMENT OF TRANSPORTATION			SHEET NO.
DATE	DESCRIPTION	DATE	DESCRIPTION	ROAD NO.	COUNTY	FINANCIAL PROJECT ID	
				SR 5	INDIAN RIVER	441693-1-22-02	2

**UTILITY CONTACT PLAN (2)**

THE OFFICIAL RECORD OF THIS SHEET IS THE ELECTRONIC FILE DIGITALLY SIGNED AND SEALED UNDER RULE 61G15-23.004, F.A.C.

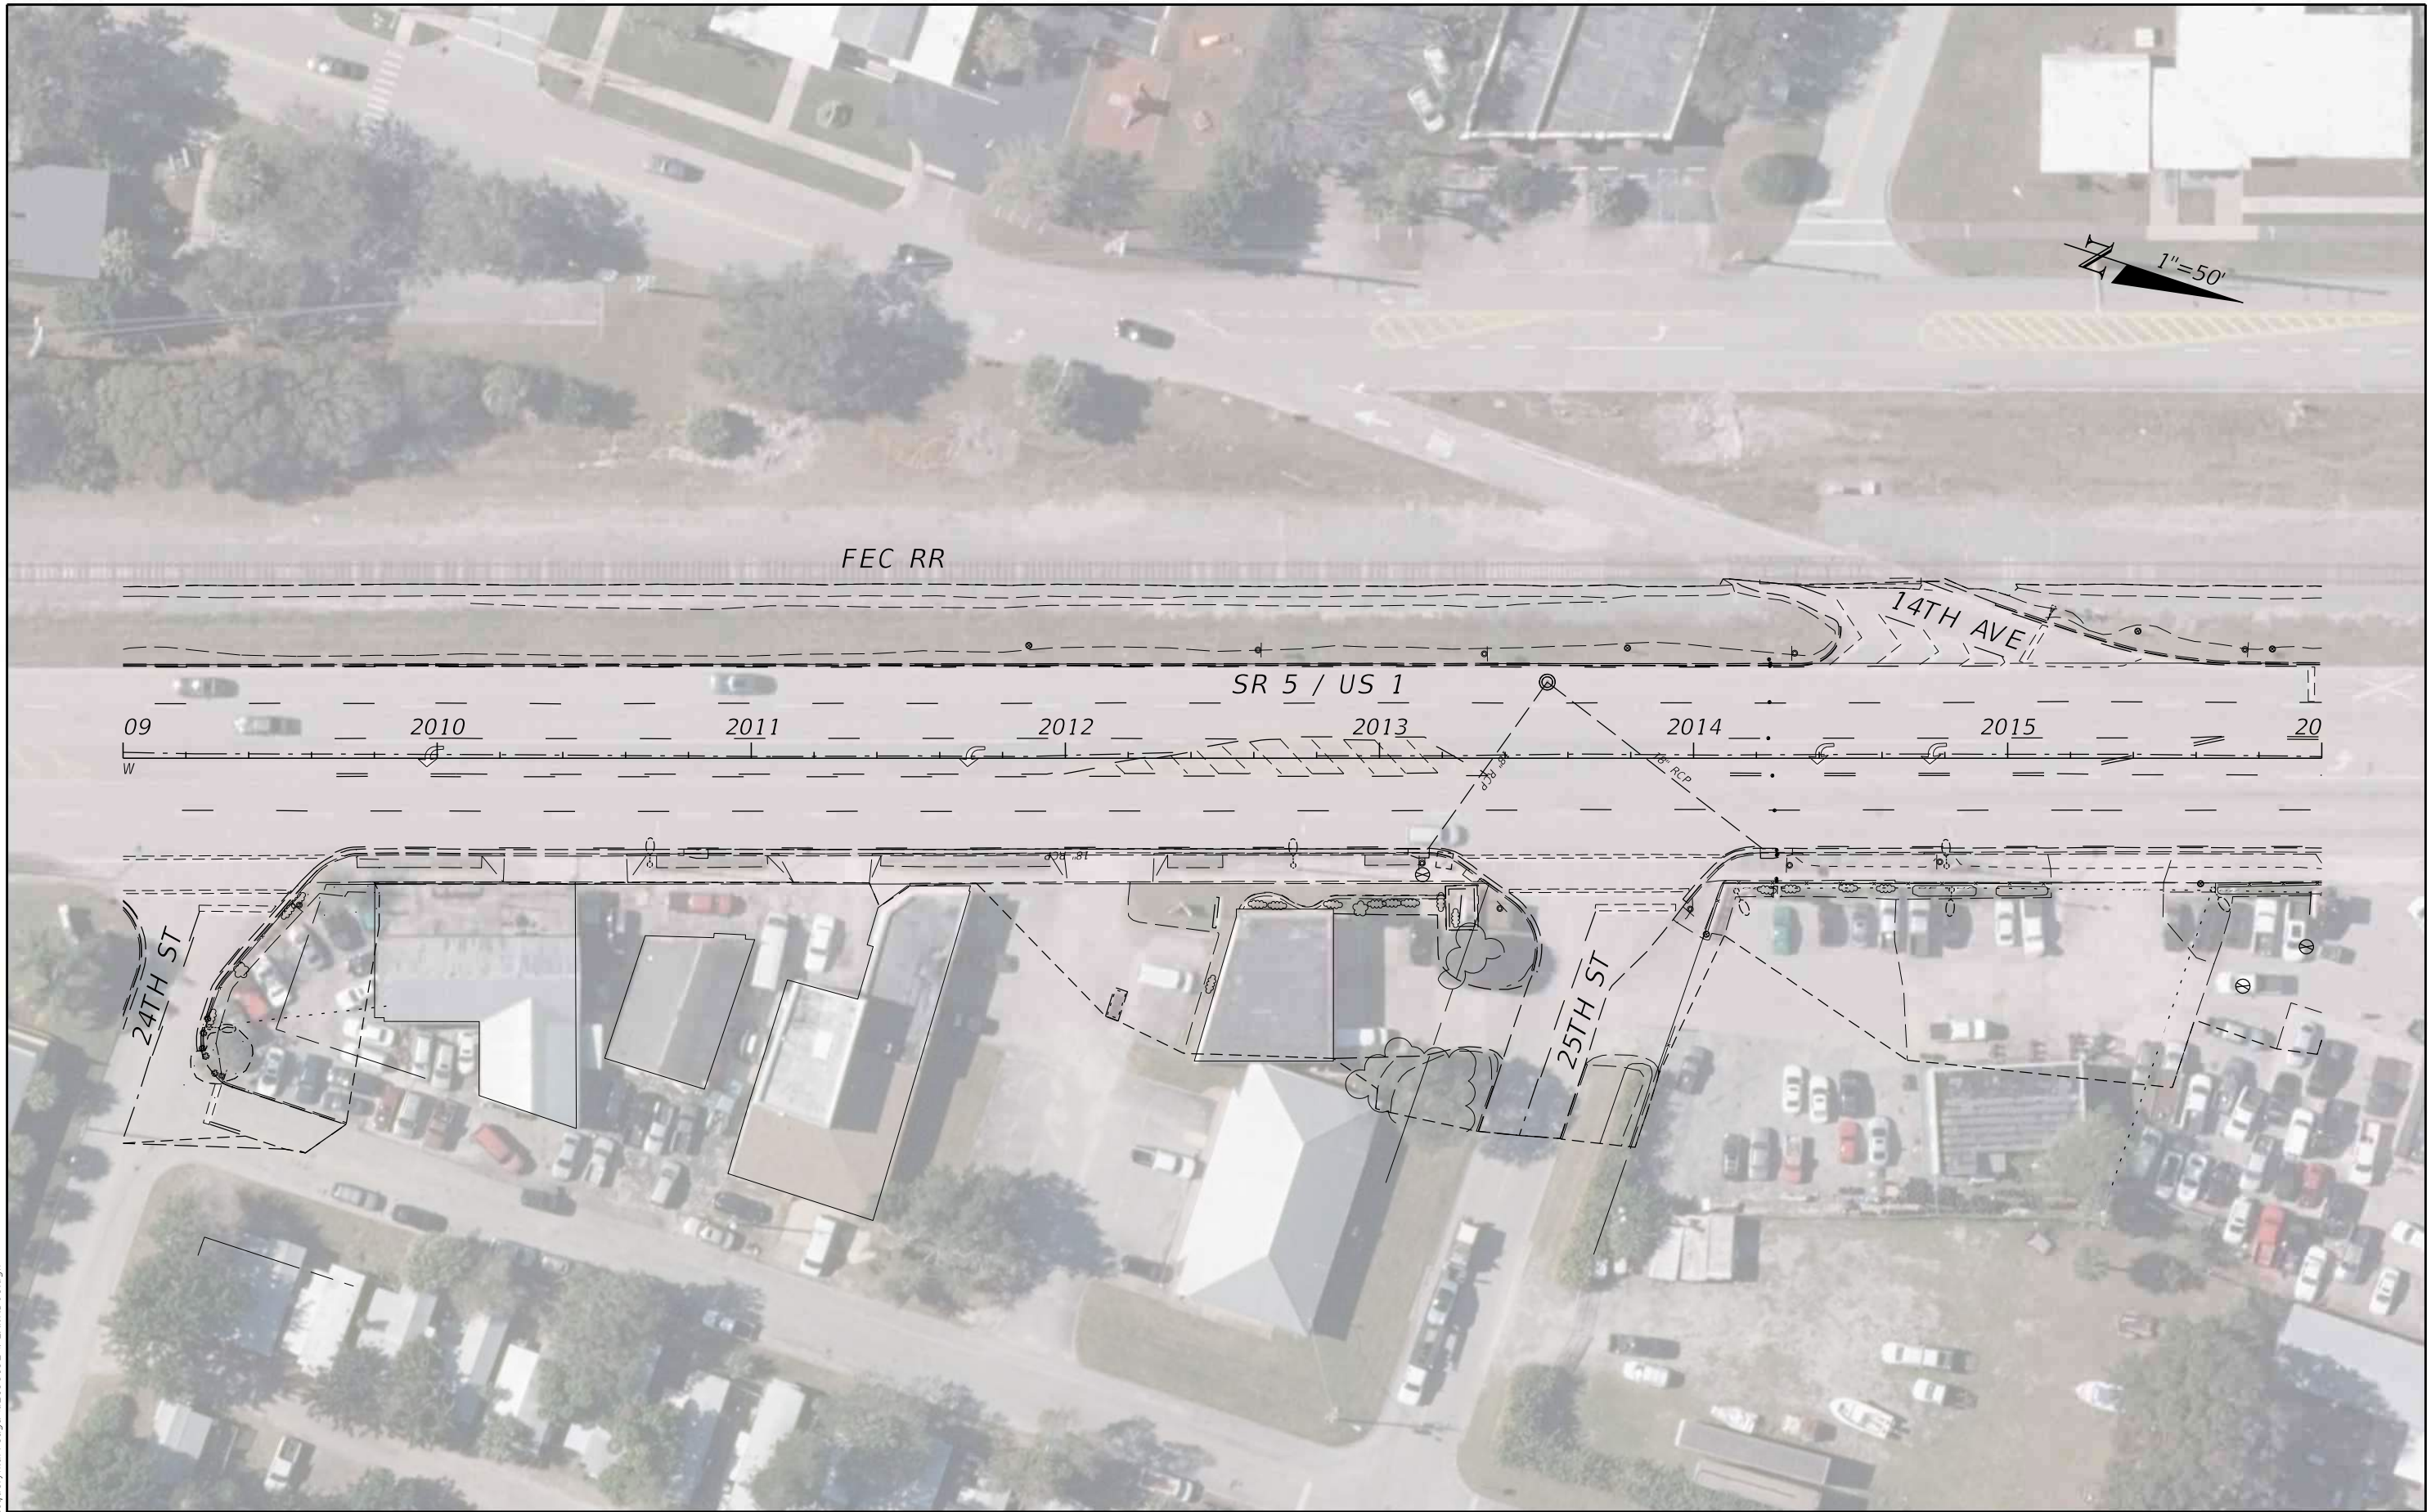

1"=50'

FEC RR

SR 5 / US 1

14TH AVE

09 2010 2011 2012 2013 2014 2015 20

24TH ST


25TH ST

9/15/2022 11:00:13 AM Jacquelyn.Arreaga c:\pwworking\wgn\jacquelyn.arreaga\d2198192\PLANRD01.dgn

REVISIONS		PROFESSIONAL TYPE		STATE OF FLORIDA DEPARTMENT OF TRANSPORTATION			UTILITY CONTACT PLAN (3)	SHEET NO. 3
DATE	DESCRIPTION	DATE	DESCRIPTION	ROAD NO.	COUNTY	FINANCIAL PROJECT ID		
				SR 5	INDIAN RIVER	441693-1-22-02		

WILLIAM EVANS  
LICENSE NUMBER: 45207  
WGI, INC.  
2035 VISTA PARKWAY  
WEST PALM BEACH, FL 33411

THE OFFICIAL RECORD OF THIS SHEET IS THE ELECTRONIC FILE DIGITALLY SIGNED AND SEALED UNDER RULE 61G15-23.004, F.A.C.

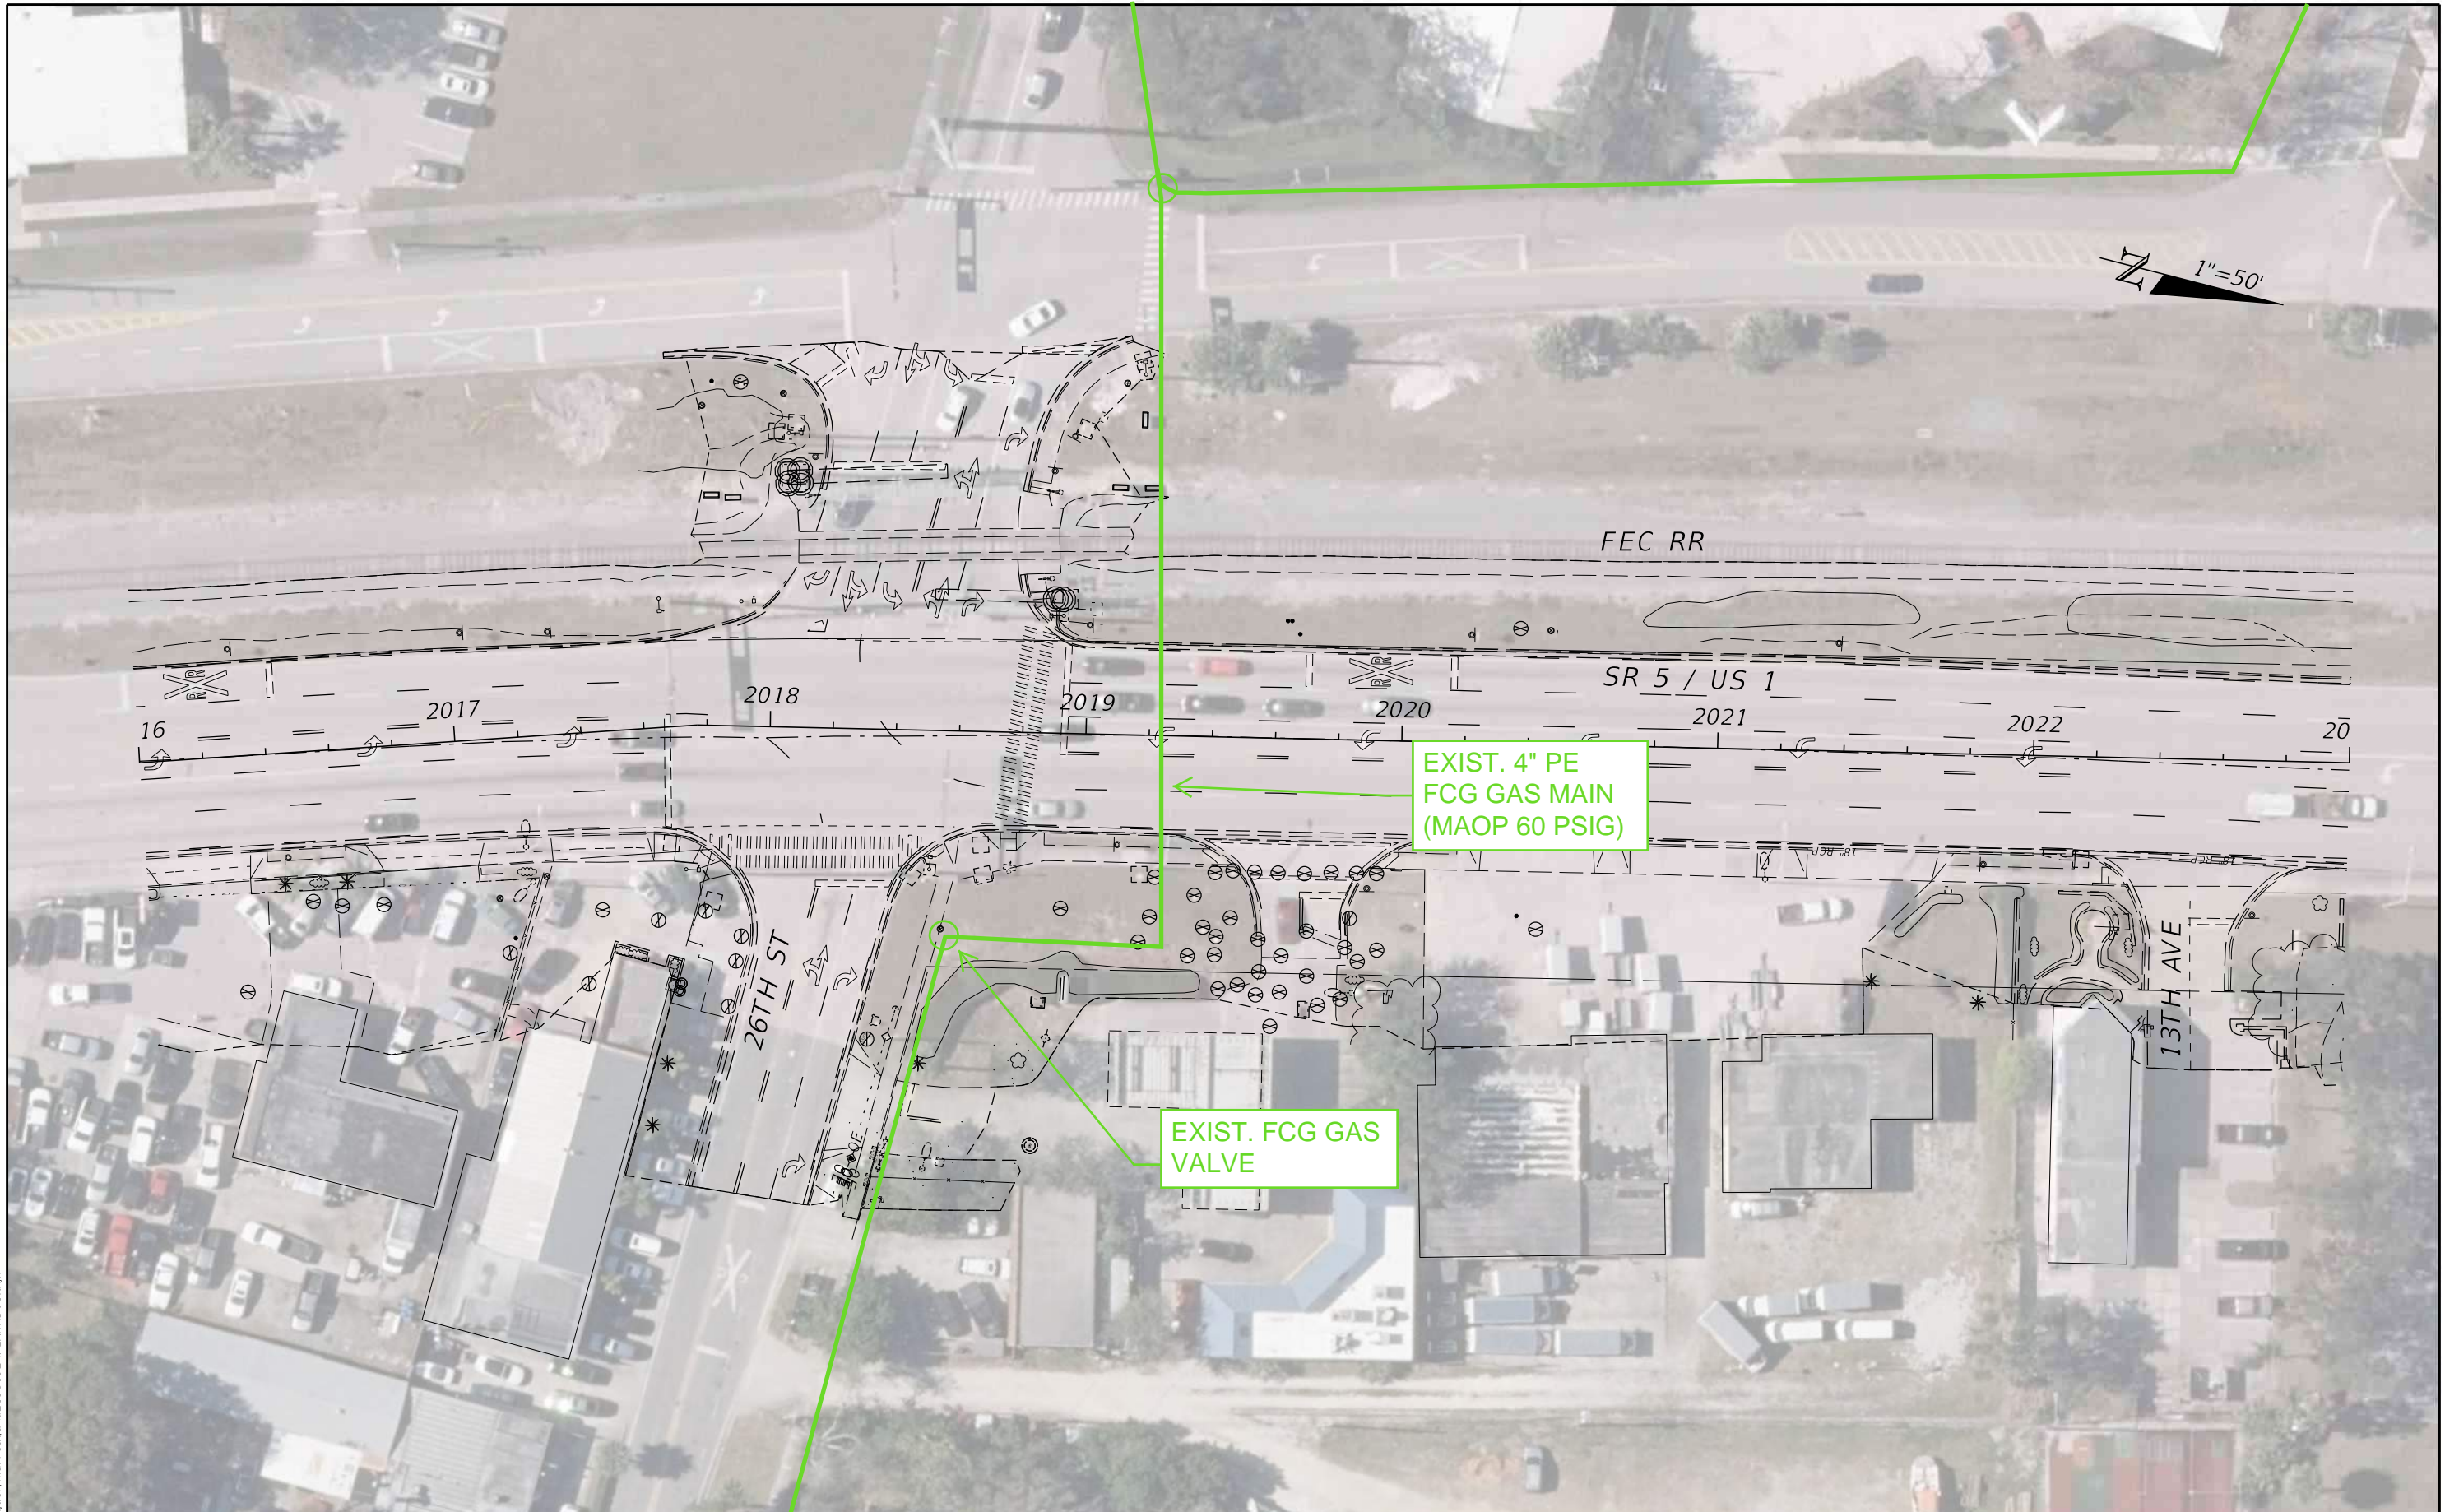

9/15/2022 11:00:42 AM Jacquelyn.Arreaga  
 c:\pwworking\wgn\jacquelyn.arreaga\d2198192\PLANRD01.dgn

REVISIONS		PROFESSIONAL TYPE		STATE OF FLORIDA DEPARTMENT OF TRANSPORTATION			SHEET NO.
DATE	DESCRIPTION	DATE	DESCRIPTION	ROAD NO.	COUNTY	FINANCIAL PROJECT ID	
				SR 5	INDIAN RIVER	441693-1-22-02	4

WILLIAM EVANS  
 LICENSE NUMBER: 45207  
 WGI, INC.  
 2035 VISTA PARKWAY  
 WEST PALM BEACH, FL 33411

**UTILITY CONTACT PLAN (4)**

THE OFFICIAL RECORD OF THIS SHEET IS THE ELECTRONIC FILE DIGITALLY SIGNED AND SEALED UNDER RULE 61G15-23.004, F.A.C.




9/15/2022 11:00:51 AM Jacquelyn.Arreaga  
 c:\pwworking\wgn\jacquelyn.arreaga\d2198192\PLANRD01.dgn

REVISIONS				PROFESSIONAL TYPE		STATE OF FLORIDA DEPARTMENT OF TRANSPORTATION			<b>UTILITY CONTACT PLAN (5)</b>	SHEET NO.
DATE	DESCRIPTION	DATE	DESCRIPTION			ROAD NO.	COUNTY	FINANCIAL PROJECT ID		5
				WILLIAM EVANS LICENSE NUMBER: 45207 WGI, INC. 2035 VISTA PARKWAY WEST PALM BEACH, FL 33411		SR 5	INDIAN RIVER	441693-1-22-02		

THE OFFICIAL RECORD OF THIS SHEET IS THE ELECTRONIC FILE DIGITALLY SIGNED AND SEALED UNDER RULE 61G15-23.004, F.A.C.

CITY OF VERO BEACH AIRPORT

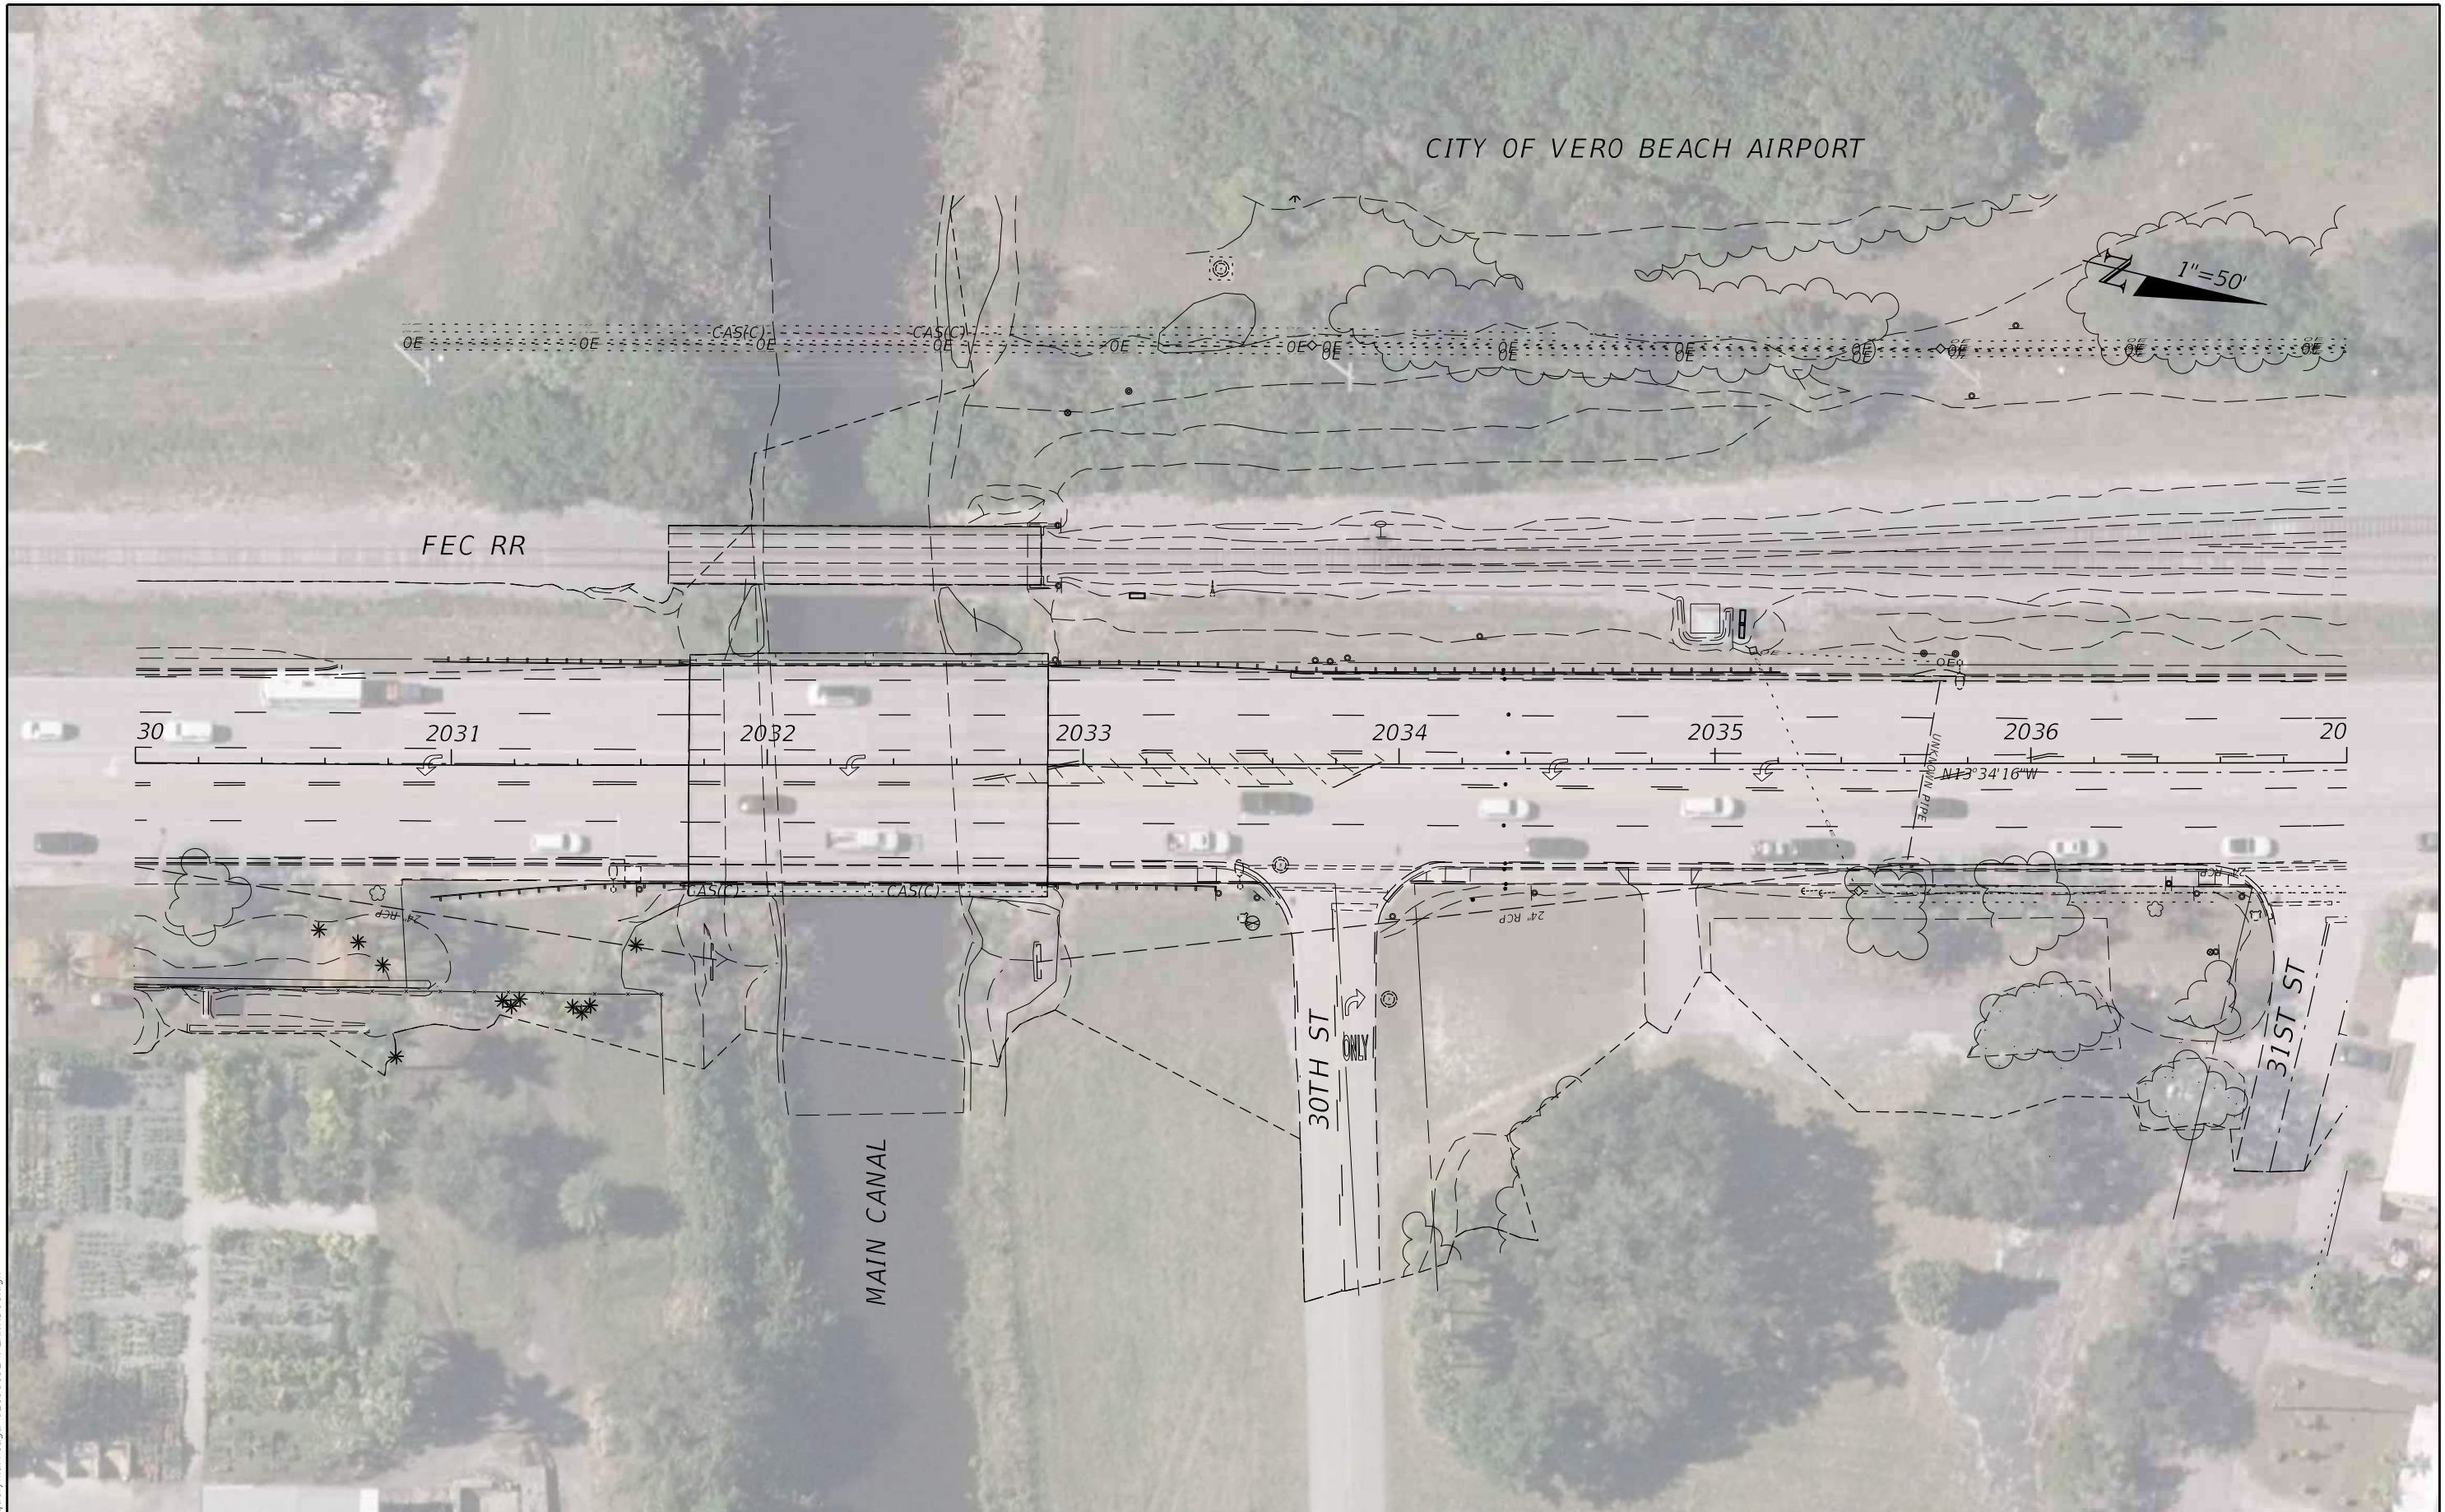


9/15/2022 11:01:04 AM Jacquelyn.Arreaga c:\pwworking\wgn\jacquelyn.arreaga\d2198192\PLANRD01.dgn

REVISIONS		PROFESSIONAL TYPE		STATE OF FLORIDA DEPARTMENT OF TRANSPORTATION			SHEET NO.
DATE	DESCRIPTION	DATE	DESCRIPTION	ROAD NO.	COUNTY	FINANCIAL PROJECT ID	
				SR 5	INDIAN RIVER	441693-1-22-02	6

**UTILITY CONTACT PLAN (6)**

THE OFFICIAL RECORD OF THIS SHEET IS THE ELECTRONIC FILE DIGITALLY SIGNED AND SEALED UNDER RULE 61G15-23.004, F.A.C.

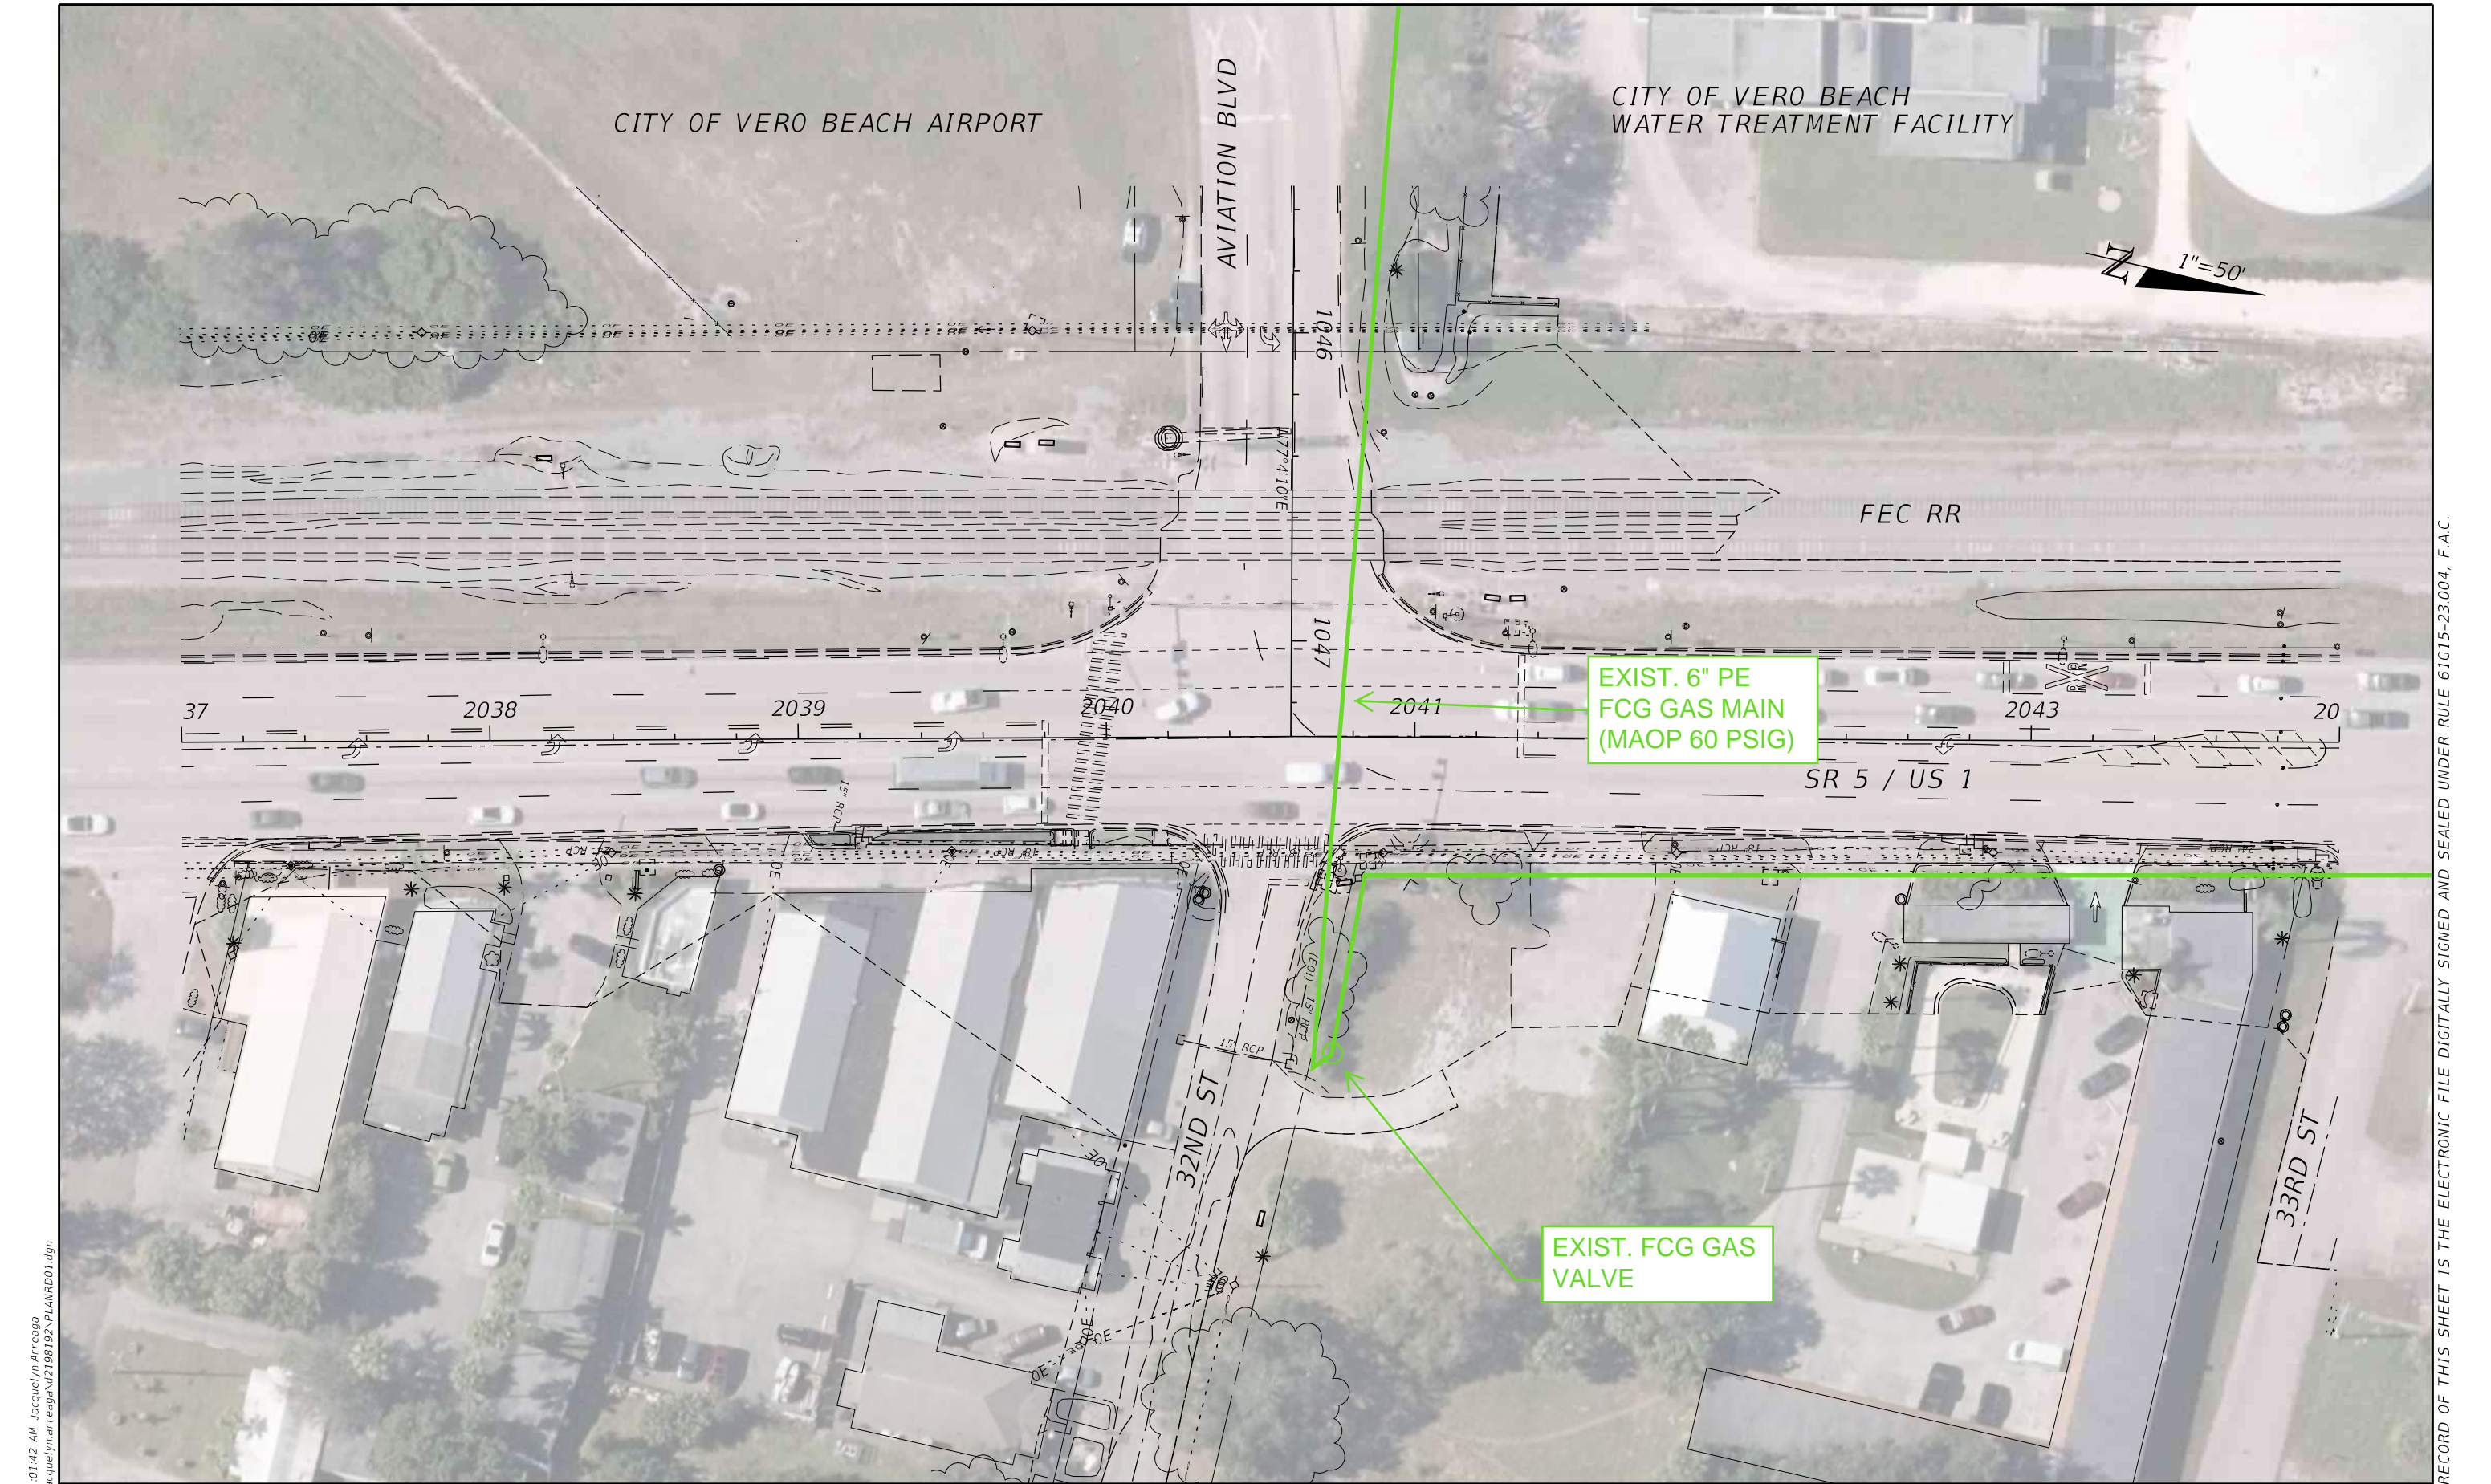


9/15/2022 11:01:42 AM Jacquelyn.Arreaga  
 c:\pwworking\wgn\jacquelyn.arreaga\d2198192\PLANRD01.dgn

REVISIONS		PROFESSIONAL TYPE		STATE OF FLORIDA DEPARTMENT OF TRANSPORTATION			SHEET NO.
DATE	DESCRIPTION	DATE	DESCRIPTION	ROAD NO.	COUNTY	FINANCIAL PROJECT ID	
				SR 5	INDIAN RIVER	441693-1-22-02	7
				<b>UTILITY CONTACT PLAN (7)</b>			

THE OFFICIAL RECORD OF THIS SHEET IS THE ELECTRONIC FILE DIGITALLY SIGNED AND SEALED UNDER RULE 61G15-23.004, F.A.C.

CITY OF VERO BEACH AIRPORT

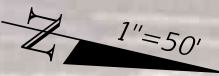

EXIST. 6" PE  
FCG GAS MAIN  
(MAOP 60 PSIG)

9/15/2022 11:02:24 AM Jacquelyn.Arreaga  
c:\pwworking\wgn\jacquelyn.arreaga\d2198192\PLANRD01.dgn

REVISIONS				PROFESSIONAL TYPE	STATE OF FLORIDA DEPARTMENT OF TRANSPORTATION			UTILITY CONTACT PLAN (8)	SHEET NO.  8
DATE	DESCRIPTION	DATE	DESCRIPTION		ROAD NO.	COUNTY	FINANCIAL PROJECT ID		
				WILLIAM EVANS LICENSE NUMBER: 45207 WGI, INC. 2035 VISTA PARKWAY WEST PALM BEACH, FL 33411	SR 5	INDIAN RIVER	441693-1-22-02		

THE OFFICIAL RECORD OF THIS SHEET IS THE ELECTRONIC FILE DIGITALLY SIGNED AND SEALED UNDER RULE 61G15-23.004, F.A.C.

CITY OF VERO BEACH AIRPORT



FEC RR

SR 5 / US 1

EXIST. 6" PE  
FCG GAS MAIN  
(MAOP 60 PSIG)

9/15/2022 11:02:50 AM Jacquelyn.Arreaga c:\pwworking\wgn\jacquelyn.arreaga\d2198192\PLANRD01.dgn

REVISIONS		PROFESSIONAL TYPE		STATE OF FLORIDA DEPARTMENT OF TRANSPORTATION			SHEET NO.
DATE	DESCRIPTION	DATE	DESCRIPTION	ROAD NO.	COUNTY	FINANCIAL PROJECT ID	
				SR 5	INDIAN RIVER	441693-1-22-02	9

UTILITY CONTACT PLAN (9)

THE OFFICIAL RECORD OF THIS SHEET IS THE ELECTRONIC FILE DIGITALLY SIGNED AND SEALED UNDER RULE 61G15-23.004, F.A.C.



CITY OF VERO BEACH AIRPORT



FEC RR

EXIST. 6" PE  
FCG GAS MAIN  
(MAOP 60 PSIG)

58 2059 2060 2061 2062 2063 2064 20

SR 5 / US 1

EXIST. FCG GAS  
VALVE

PICKERILL LN

EXIST. 2" PE  
FCG GAS MAIN  
(MAOP 60 PSIG)


9/15/2022 11:03:08 AM Jacquelyn.Arreaga  
c:\pwworking\wg\N\Jacquelyn.arreaga\d2198192\PLANRD01.dgn

REVISIONS		PROFESSIONAL TYPE		STATE OF FLORIDA DEPARTMENT OF TRANSPORTATION			UTILITY CONTACT PLAN (10)	SHEET NO.  10
DATE	DESCRIPTION	DATE	DESCRIPTION	ROAD NO.	COUNTY	FINANCIAL PROJECT ID		
				SR 5	INDIAN RIVER	441693-1-22-02		

WILLIAM EVANS  
LICENSE NUMBER: 45207  
WGI, INC.  
2035 VISTA PARKWAY  
WEST PALM BEACH, FL 33411

THE OFFICIAL RECORD OF THIS SHEET IS THE ELECTRONIC FILE DIGITALLY SIGNED AND SEALED UNDER RULE 61G15-23.004, F.A.C.

CITY OF VERO BEACH AIRPORT

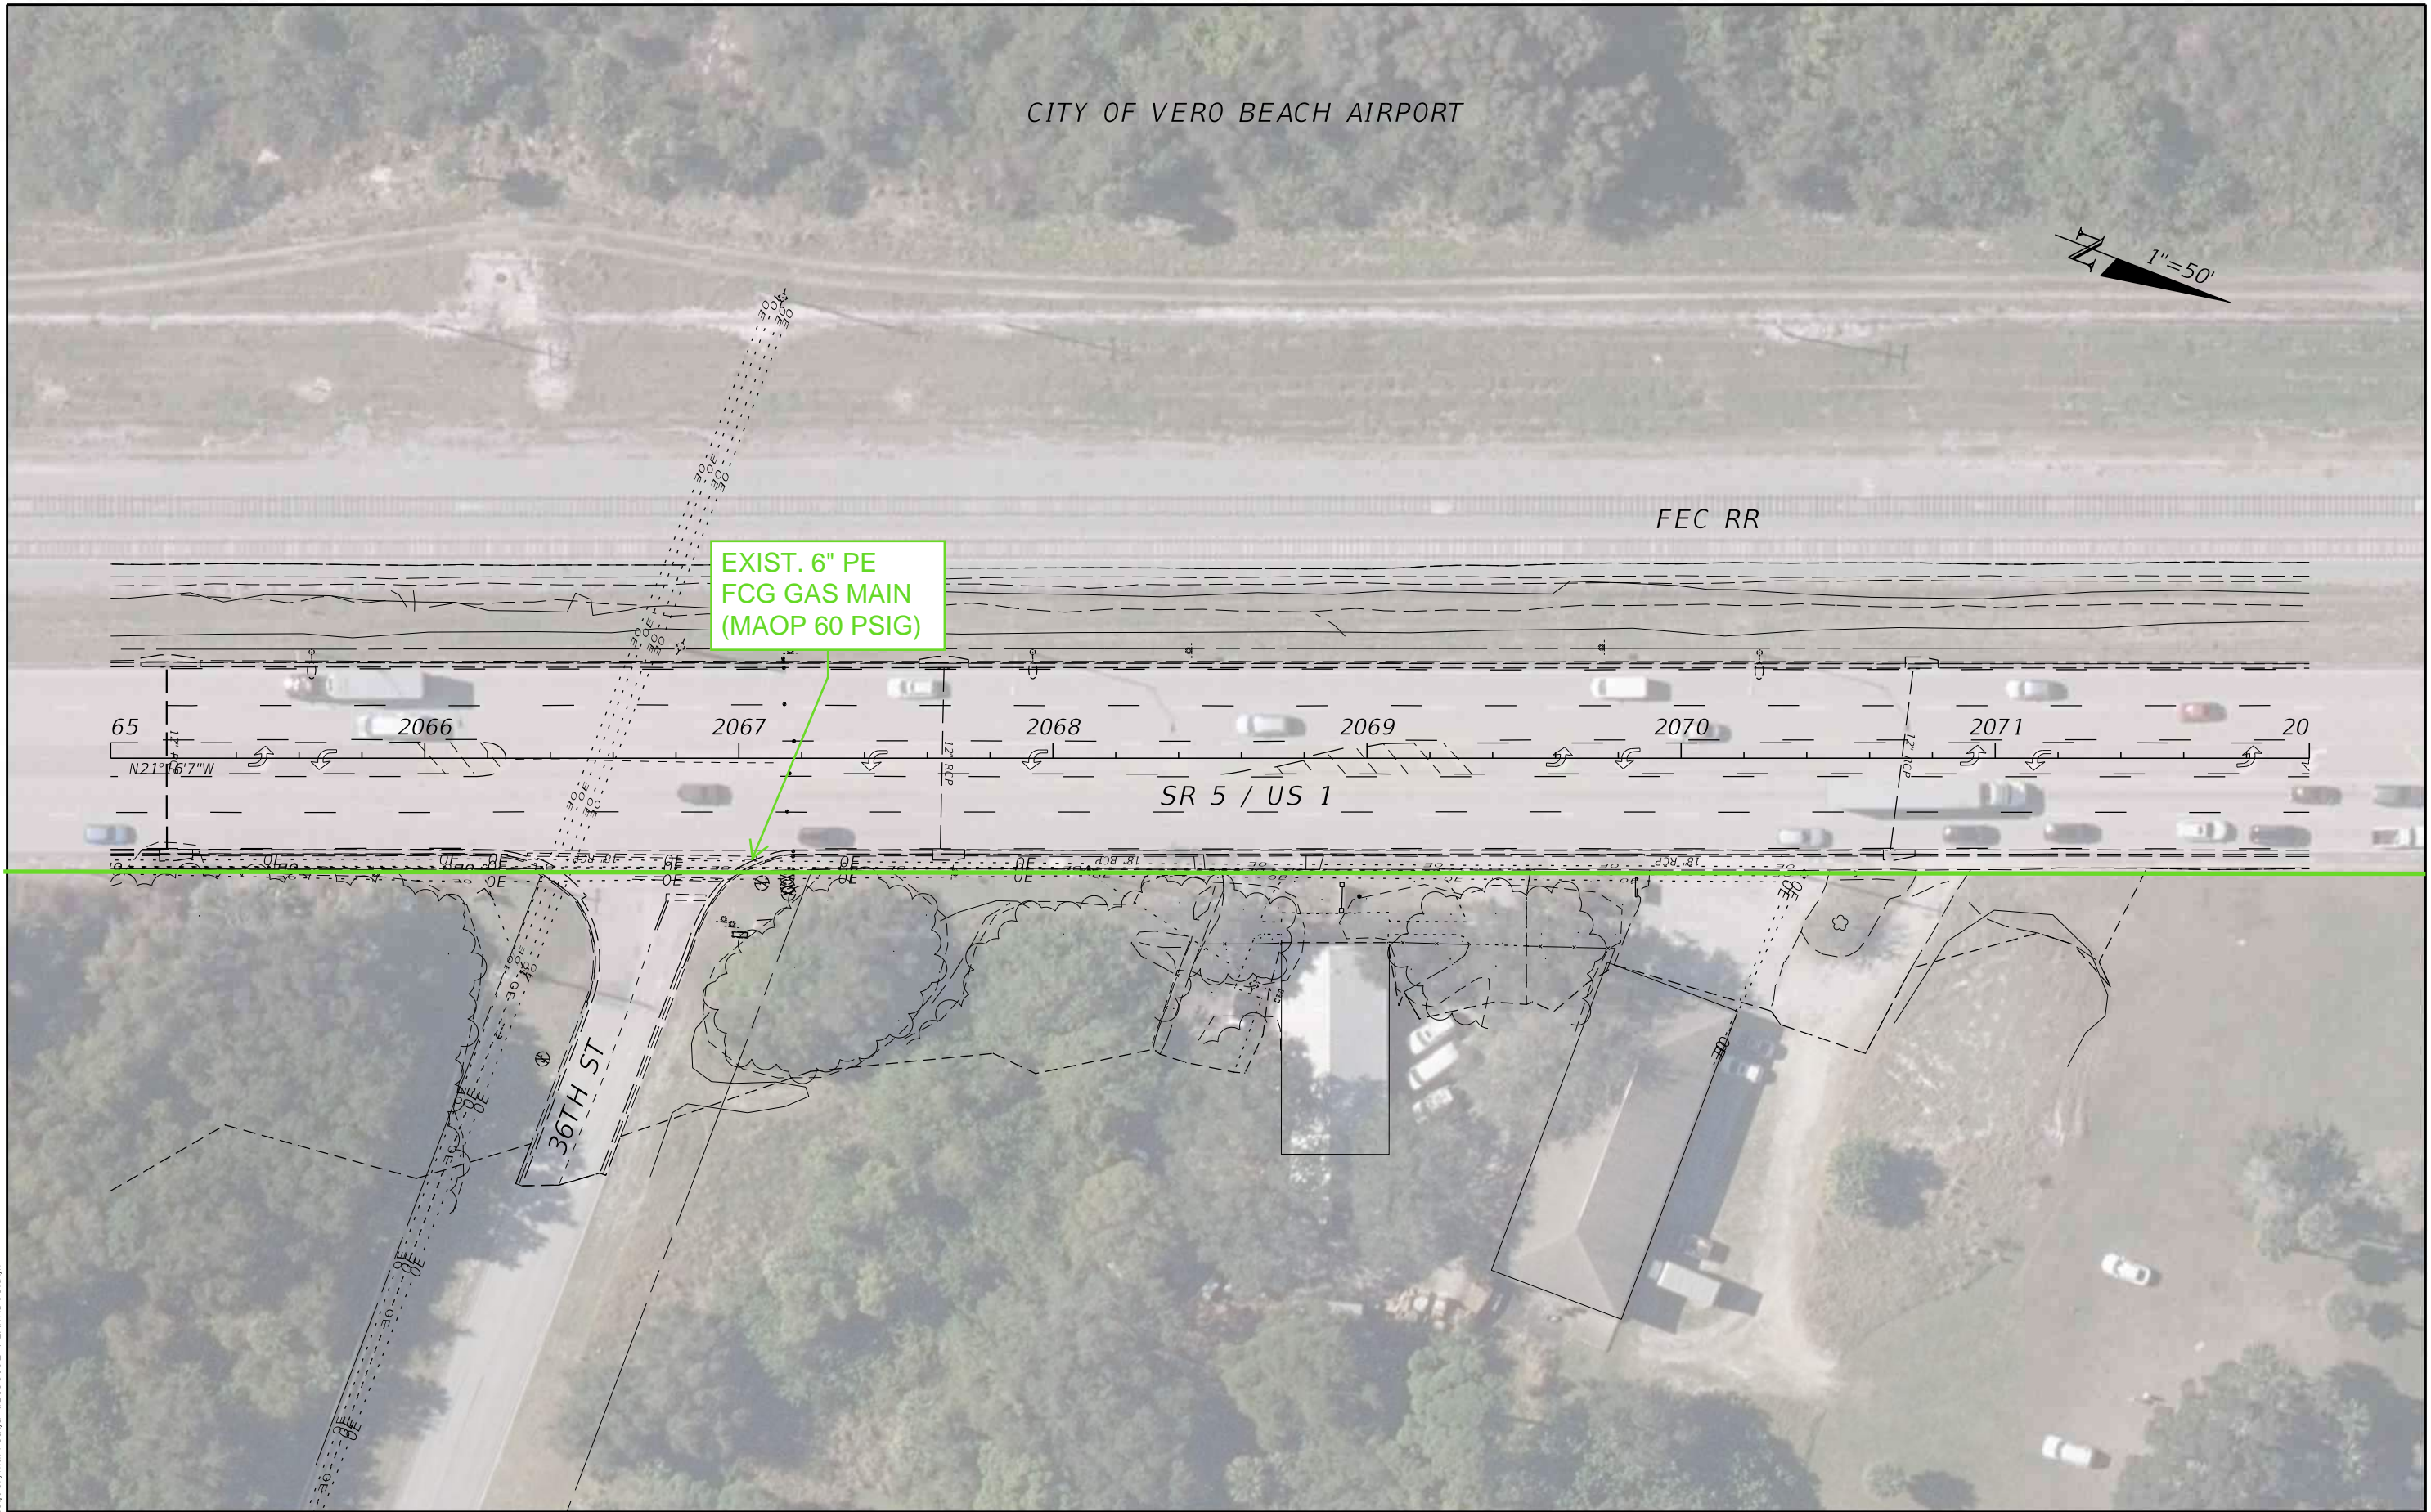

EXIST. 6" PE  
FCG GAS MAIN  
(MAOP 60 PSIG)

9/15/2022 11:03:42 AM Jacquelyn.Arreaga  
c:\pwworking\wgn\jacquelyn.arreaga\d2198192\PLANRD01.dgn

REVISIONS		PROFESSIONAL TYPE		STATE OF FLORIDA DEPARTMENT OF TRANSPORTATION			SHEET NO.
DATE	DESCRIPTION	DATE	DESCRIPTION	ROAD NO.	COUNTY	FINANCIAL PROJECT ID	
				SR 5	INDIAN RIVER	441693-1-22-02	11

UTILITY CONTACT PLAN (11)

THE OFFICIAL RECORD OF THIS SHEET IS THE ELECTRONIC FILE DIGITALLY SIGNED AND SEALED UNDER RULE 61G15-23.004, F.A.C.

CITY OF VERO BEACH AIRPORT



EXIST. 6" PE  
FCG GAS MAIN  
(MAOP 60 PSIG)

EXIST. 6" PE  
FCG GAS MAIN  
(MAOP 60 PSIG)

9/15/2022 11:04:09 AM Jacquelyn.Arreaga  
c:\pwworking\wg\N\Jacquelyn.arreaga\d2198192\PLANRD01.dgn

REVISIONS				PROFESSIONAL TYPE	STATE OF FLORIDA DEPARTMENT OF TRANSPORTATION			UTILITY CONTACT PLAN (12)	SHEET NO. 12
DATE	DESCRIPTION	DATE	DESCRIPTION		ROAD NO.	COUNTY	FINANCIAL PROJECT ID		
				WILLIAM EVANS LICENSE NUMBER: 45207 WGI, INC. 2035 VISTA PARKWAY WEST PALM BEACH, FL 33411	SR 5	INDIAN RIVER	441693-1-22-02		

THE OFFICIAL RECORD OF THIS SHEET IS THE ELECTRONIC FILE DIGITALLY SIGNED AND SEALED UNDER RULE 61G15-23.004, F.A.C.




EXIST. 6" PE  
FCG GAS MAIN  
(MAOP 60 PSIG)

1"=50'

9/15/2022 11:04:36 AM Jacquelyn.Arreaga  
c:\pwworking\wgn\jacquelyn.arreaga\d2198192\PLANRD01.dgn

REVISIONS		PROFESSIONAL TYPE		STATE OF FLORIDA DEPARTMENT OF TRANSPORTATION			UTILITY CONTACT PLAN (13)	SHEET NO. 13
DATE	DESCRIPTION	DATE	DESCRIPTION	ROAD NO.	COUNTY	FINANCIAL PROJECT ID		
				SR 5	INDIAN RIVER	441693-1-22-02		

THE OFFICIAL RECORD OF THIS SHEET IS THE ELECTRONIC FILE DIGITALLY SIGNED AND SEALED UNDER RULE 61G15-23.004, F.A.C.

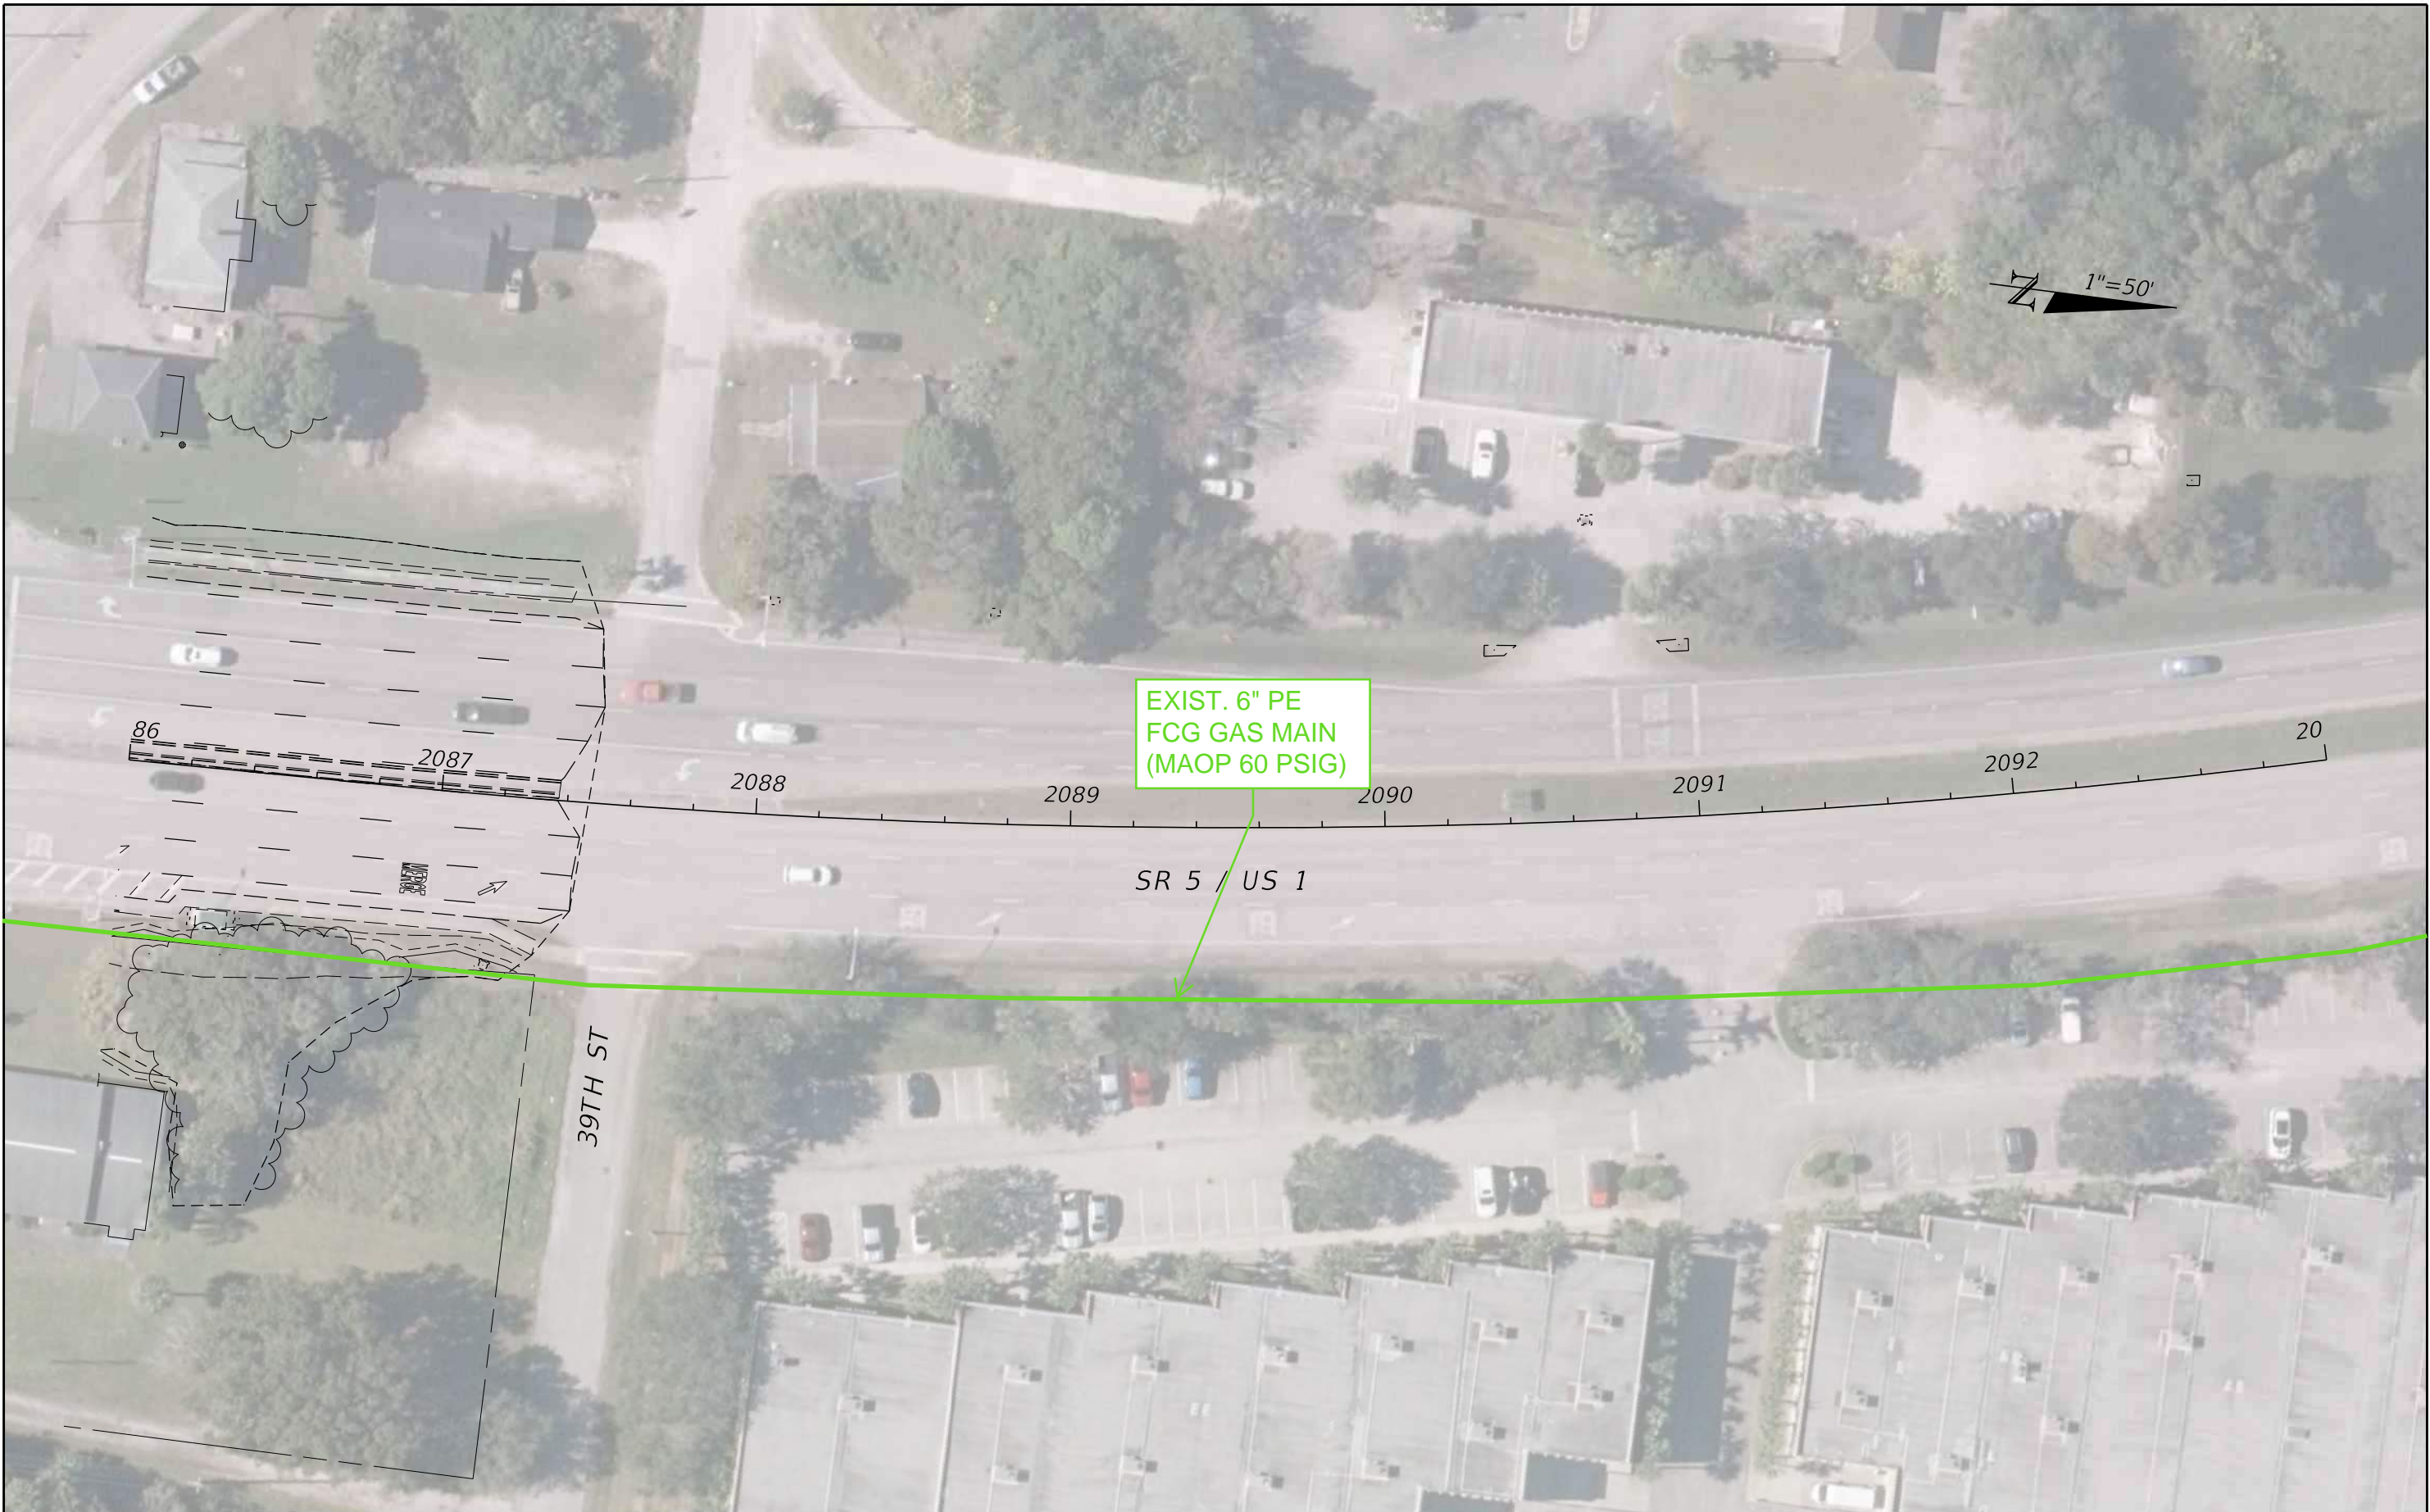

EXIST. 6" PE  
FCG GAS MAIN  
(MAOP 60 PSIG)

SR 5 / US 1

39TH ST

1"=50'

9/15/2022 11:05:04 AM Jacquelyn.Arreaga  
c:\pwworking\wgn\jacquelyn.arreaga\d2198192\PLANRD01.dgn

REVISIONS				PROFESSIONAL TYPE	STATE OF FLORIDA DEPARTMENT OF TRANSPORTATION			UTILITY CONTACT PLAN (14)	SHEET NO. 14
DATE	DESCRIPTION	DATE	DESCRIPTION		ROAD NO.	COUNTY	FINANCIAL PROJECT ID		
				WILLIAM EVANS LICENSE NUMBER: 45207 WGI, INC. 2035 VISTA PARKWAY WEST PALM BEACH, FL 33411	SR 5	INDIAN RIVER	441693-1-22-02		

THE OFFICIAL RECORD OF THIS SHEET IS THE ELECTRONIC FILE DIGITALLY SIGNED AND SEALED UNDER RULE 61G15-23.004, F.A.C.



93      2094      2095      2096      2097      2098      2099      21

N15°6'28"W

SR 5 / US 1

9/15/2022 11:05:51 AM Jacquelyn.Arreaga c:\pwworking\wgn\jacquelyn.arreaga\d2198192\PLANRD01.dgn

REVISIONS				PROFESSIONAL TYPE	STATE OF FLORIDA DEPARTMENT OF TRANSPORTATION			UTILITY CONTACT PLAN (15)	SHEET NO. 15
DATE	DESCRIPTION	DATE	DESCRIPTION		ROAD NO.	COUNTY	FINANCIAL PROJECT ID		
				WILLIAM EVANS LICENSE NUMBER: 45207 WGI, INC. 2035 VISTA PARKWAY WEST PALM BEACH, FL 33411	SR 5	INDIAN RIVER	441693-1-22-02		

THE OFFICIAL RECORD OF THIS SHEET IS THE ELECTRONIC FILE DIGITALLY SIGNED AND SEALED UNDER RULE 61G15-23.004, F.A.C.



EXIST. FCG GAS VALVE

EXIST. 6" PE FCG GAS MAIN (MAOP 60 PSIG)

EXIST. 6" PE FCG GAS MAIN (MAOP 60 PSIG)

END PROJECT

SR 5 / US 1

41ST ST

1"=50'

00


9/15/2022 11:06:09 AM Jacquelyn.Arreaga c:\pwworking\wg\N\jacquelyn.arreaga\2198192\PLAN\RD01.dgn

THE OFFICIAL RECORD OF THIS SHEET IS THE ELECTRONIC FILE DIGITALLY SIGNED AND SEALED UNDER RULE 61G15-23.004, F.A.C.

REVISIONS				PROFESSIONAL TYPE	STATE OF FLORIDA DEPARTMENT OF TRANSPORTATION			UTILITY CONTACT PLAN (16)	SHEET NO. 16
DATE	DESCRIPTION	DATE	DESCRIPTION		ROAD NO.	COUNTY	FINANCIAL PROJECT ID		
				WILLIAM EVANS LICENSE NUMBER: 45207 WGI, INC. 2035 VISTA PARKWAY WEST PALM BEACH, FL 33411	SR 5	INDIAN RIVER	441693-1-22-02		



SEE SHEET 6

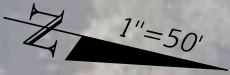

MAIN CANAL

30TH ST

31ST ST

13TH AVE

9/15/2022 11:06:48 AM Jacquelyn.Arreaga c:\pwworking\wg\Jacquelyn.arreaga\d2198192\PLANRD01.dgn

REVISIONS				PROFESSIONAL TYPE	STATE OF FLORIDA DEPARTMENT OF TRANSPORTATION			UTILITY CONTACT PLAN (17)	SHEET NO. 17
DATE	DESCRIPTION	DATE	DESCRIPTION		ROAD NO.	COUNTY	FINANCIAL PROJECT ID		
				WILLIAM EVANS LICENSE NUMBER: 45207 WGI, INC. 2035 VISTA PARKWAY WEST PALM BEACH, FL 33411	SR 5	INDIAN RIVER	441693-1-22-02		

THE OFFICIAL RECORD OF THIS SHEET IS THE ELECTRONIC FILE DIGITALLY SIGNED AND SEALED UNDER RULE 61G15-23.004, F.A.C.






9/15/2022 11:07:02 AM Jacquelyn.Arreaga  
 c:\pwworking\wgn\jacquelyn.arreaga\d2198192\PLANRD01.dgn

DATE		REVISIONS		PROFESSIONAL TYPE	STATE OF FLORIDA DEPARTMENT OF TRANSPORTATION			SHEET NO.
DATE	DESCRIPTION	DATE	DESCRIPTION		ROAD NO.	COUNTY	FINANCIAL PROJECT ID	
				WILLIAM EVANS LICENSE NUMBER: 45207 WGI, INC. 2035 VISTA PARKWAY WEST PALM BEACH, FL 33411	SR 5	INDIAN RIVER	441693-1-22-02	6

**UTILITY CONTACT PLAN (18)**

THE OFFICIAL RECORD OF THIS SHEET IS THE ELECTRONIC FILE DIGITALLY SIGNED AND SEALED UNDER RULE 61G15-23.004, F.A.C.

SEE SHEET 8

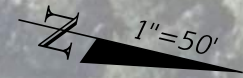

SEE SHEET 18

SEE SHEET 20

9/15/2022 11:17:13 AM Jacquelyn.Arreaga  
 c:\pwworking\wgn\jacquelyn.arreaga\d2198192\PLANRD01.dgn

REVISIONS				PROFESSIONAL TYPE	STATE OF FLORIDA DEPARTMENT OF TRANSPORTATION			UTILITY CONTACT PLAN (19)	SHEET NO.
DATE	DESCRIPTION	DATE	DESCRIPTION	WILLIAM EVANS LICENSE NUMBER: 45207 WGI, INC. 2035 VISTA PARKWAY WEST PALM BEACH, FL 33411	ROAD NO.	COUNTY	FINANCIAL PROJECT ID		19
					SR 5	INDIAN RIVER	441693-1-22-02		

THE OFFICIAL RECORD OF THIS SHEET IS THE ELECTRONIC FILE DIGITALLY SIGNED AND SEALED UNDER RULE 61G15-23.004, F.A.C.

9/15/2022 11:17:26 AM Jacquelyn.Arreaga  
 c:\pwworking\wgn\jacquelyn.arreaga\d2198192\PLANRD01.dgn




SEE SHEET 9



SEE SHEET 19

REVISIONS				PROFESSIONAL TYPE	STATE OF FLORIDA DEPARTMENT OF TRANSPORTATION			UTILITY CONTACT PLAN (20)	SHEET NO.
DATE	DESCRIPTION	DATE	DESCRIPTION	WILLIAM EVANS LICENSE NUMBER: 45207 WGI, INC. 2035 VISTA PARKWAY WEST PALM BEACH, FL 33411	ROAD NO.	COUNTY	FINANCIAL PROJECT ID		20
					SR 5	INDIAN RIVER	441693-1-22-02		

THE OFFICIAL RECORD OF THIS SHEET IS THE ELECTRONIC FILE DIGITALLY SIGNED AND SEALED UNDER RULE 61G15-23.004, F.A.C.

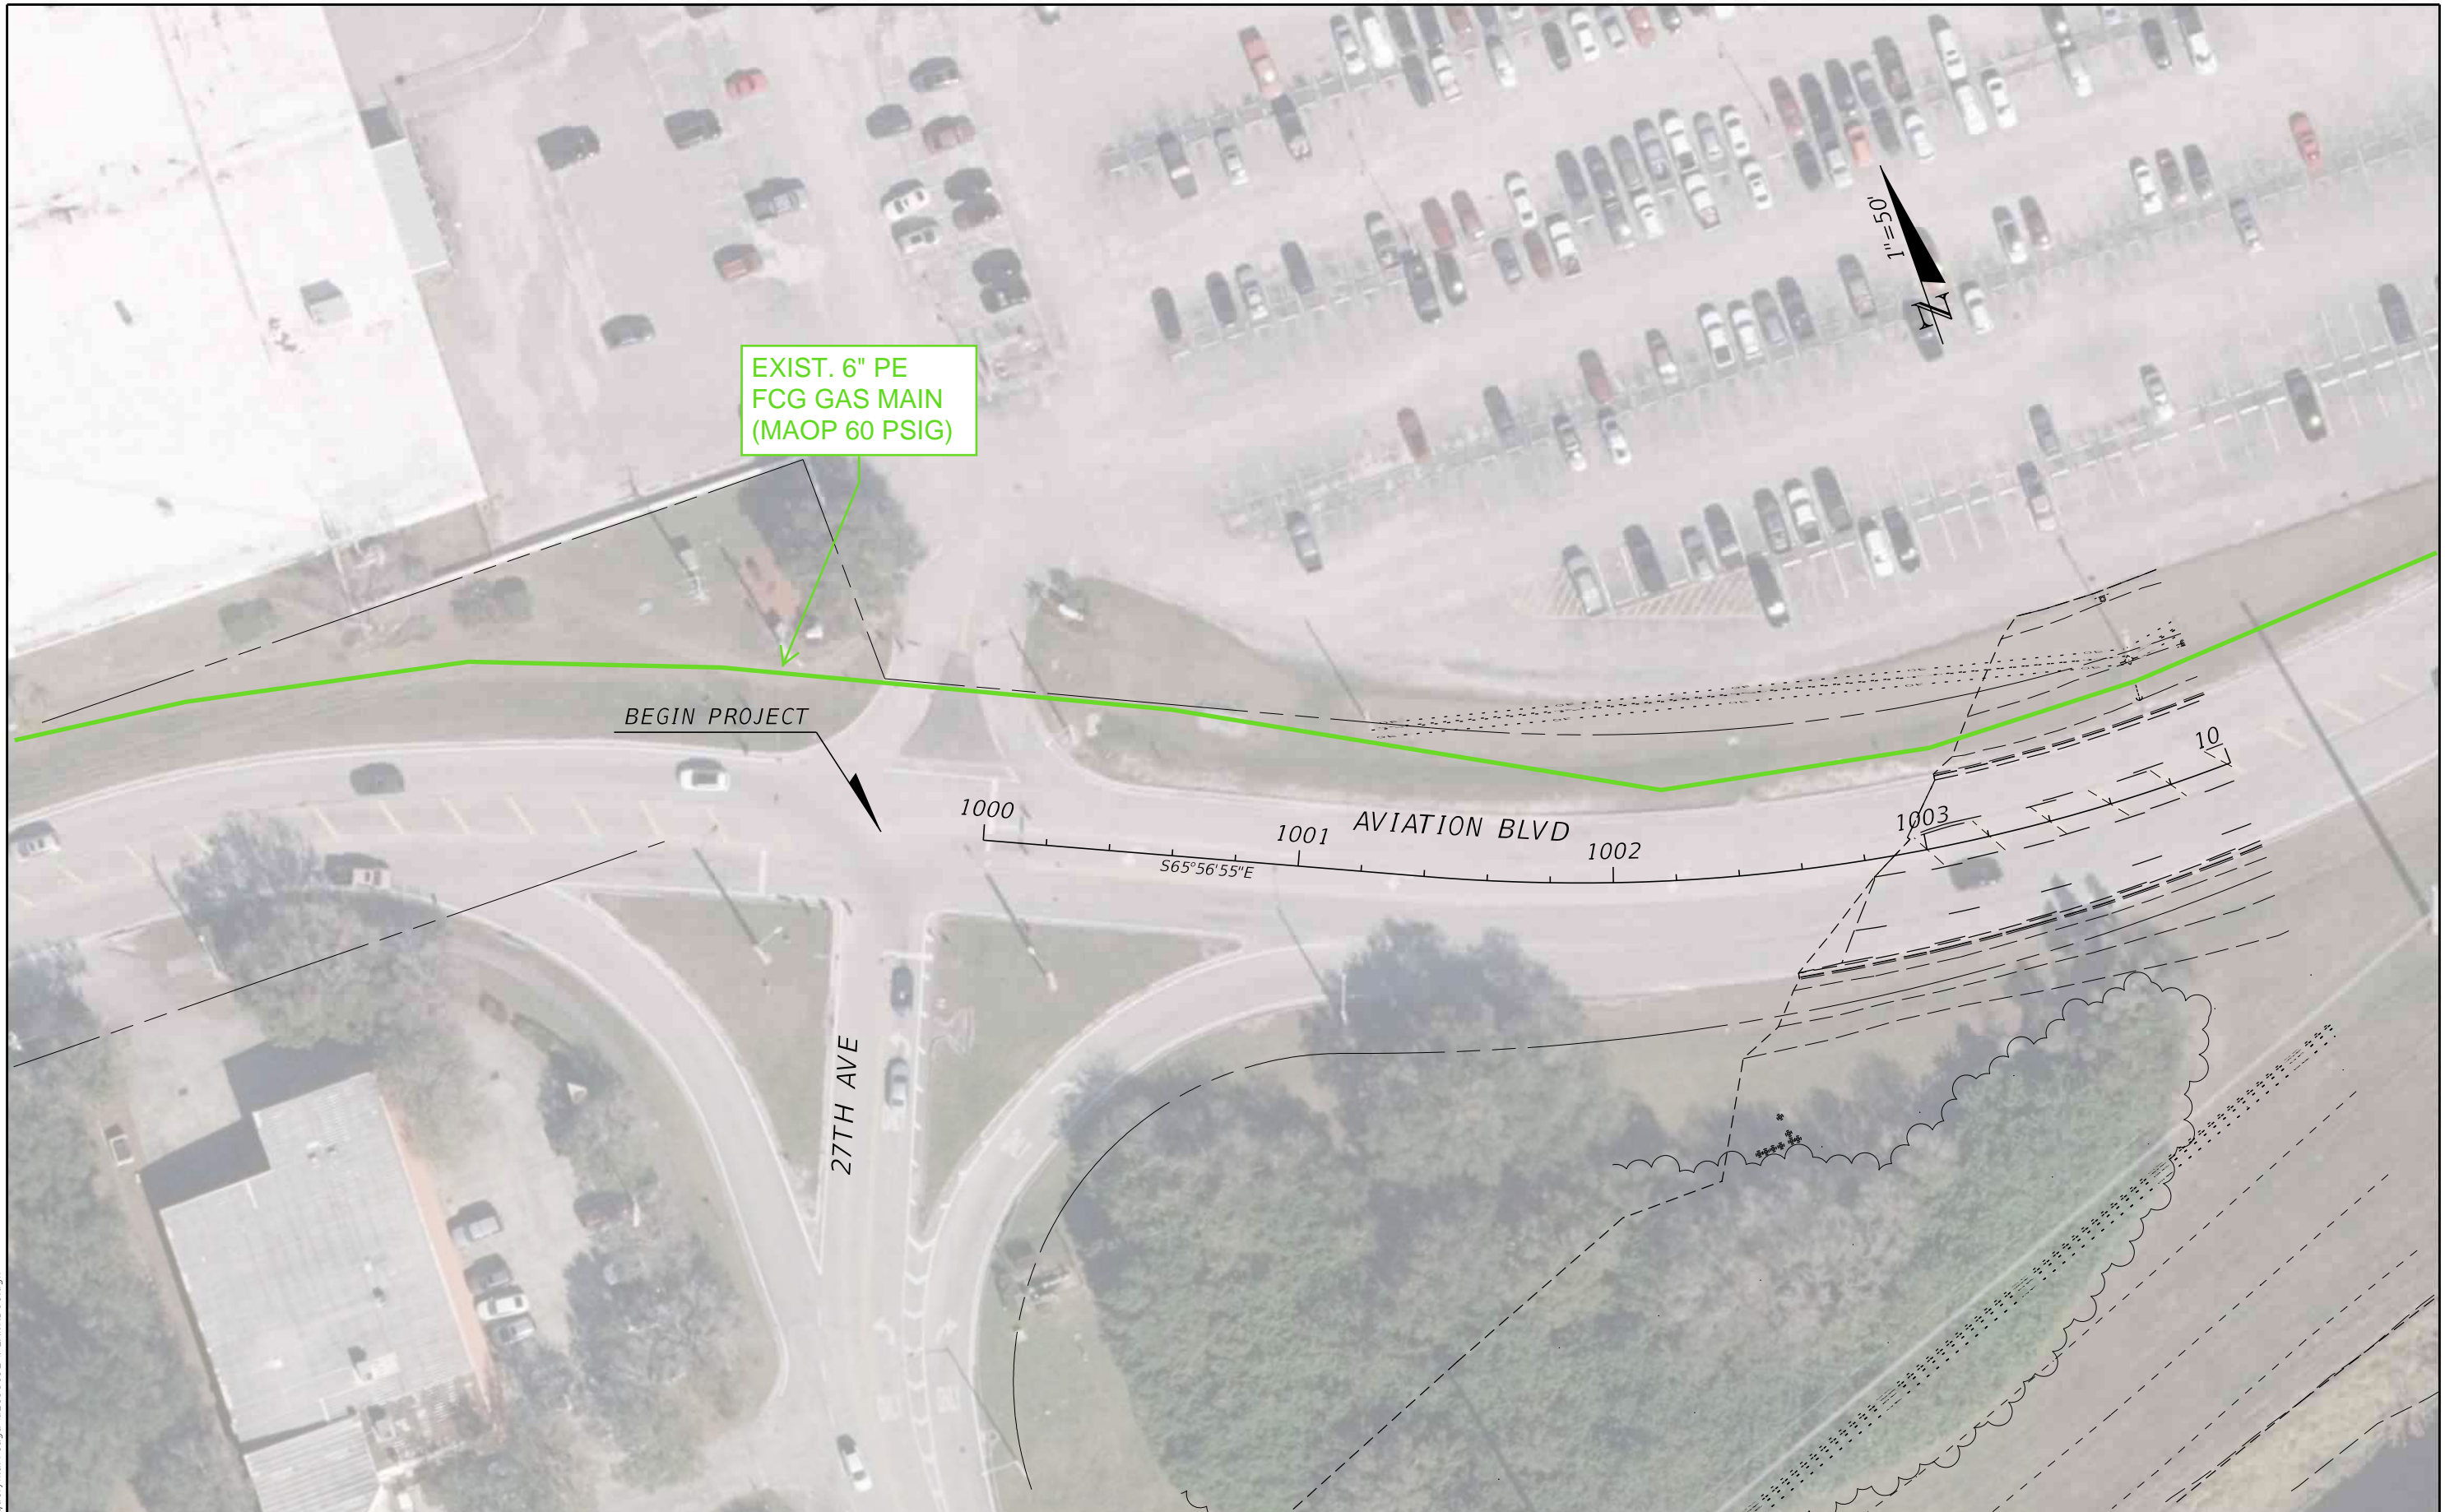

EXIST. 6" PE  
FCG GAS MAIN  
(MAOP 60 PSIG)

BEGIN PROJECT




9/15/2022 11:07:58 AM Jacquelyn.Arreaga c:\pwworking\wgn\jacquelyn.arreaga\d2198192\PLAN\ARD01.dgn

REVISIONS		PROFESSIONAL TYPE		STATE OF FLORIDA DEPARTMENT OF TRANSPORTATION			UTILITY CONTACT PLAN (21)	SHEET NO. 21
DATE	DESCRIPTION	DATE	DESCRIPTION	ROAD NO.	COUNTY	FINANCIAL PROJECT ID		
				SR 5	INDIAN RIVER	441693-1-22-02		

WILLIAM EVANS  
LICENSE NUMBER: 45207  
WGI, INC.  
2035 VISTA PARKWAY  
WEST PALM BEACH, FL 33411

THE OFFICIAL RECORD OF THIS SHEET IS THE ELECTRONIC FILE DIGITALLY SIGNED AND SEALED UNDER RULE 61G15-23.004, F.A.C.

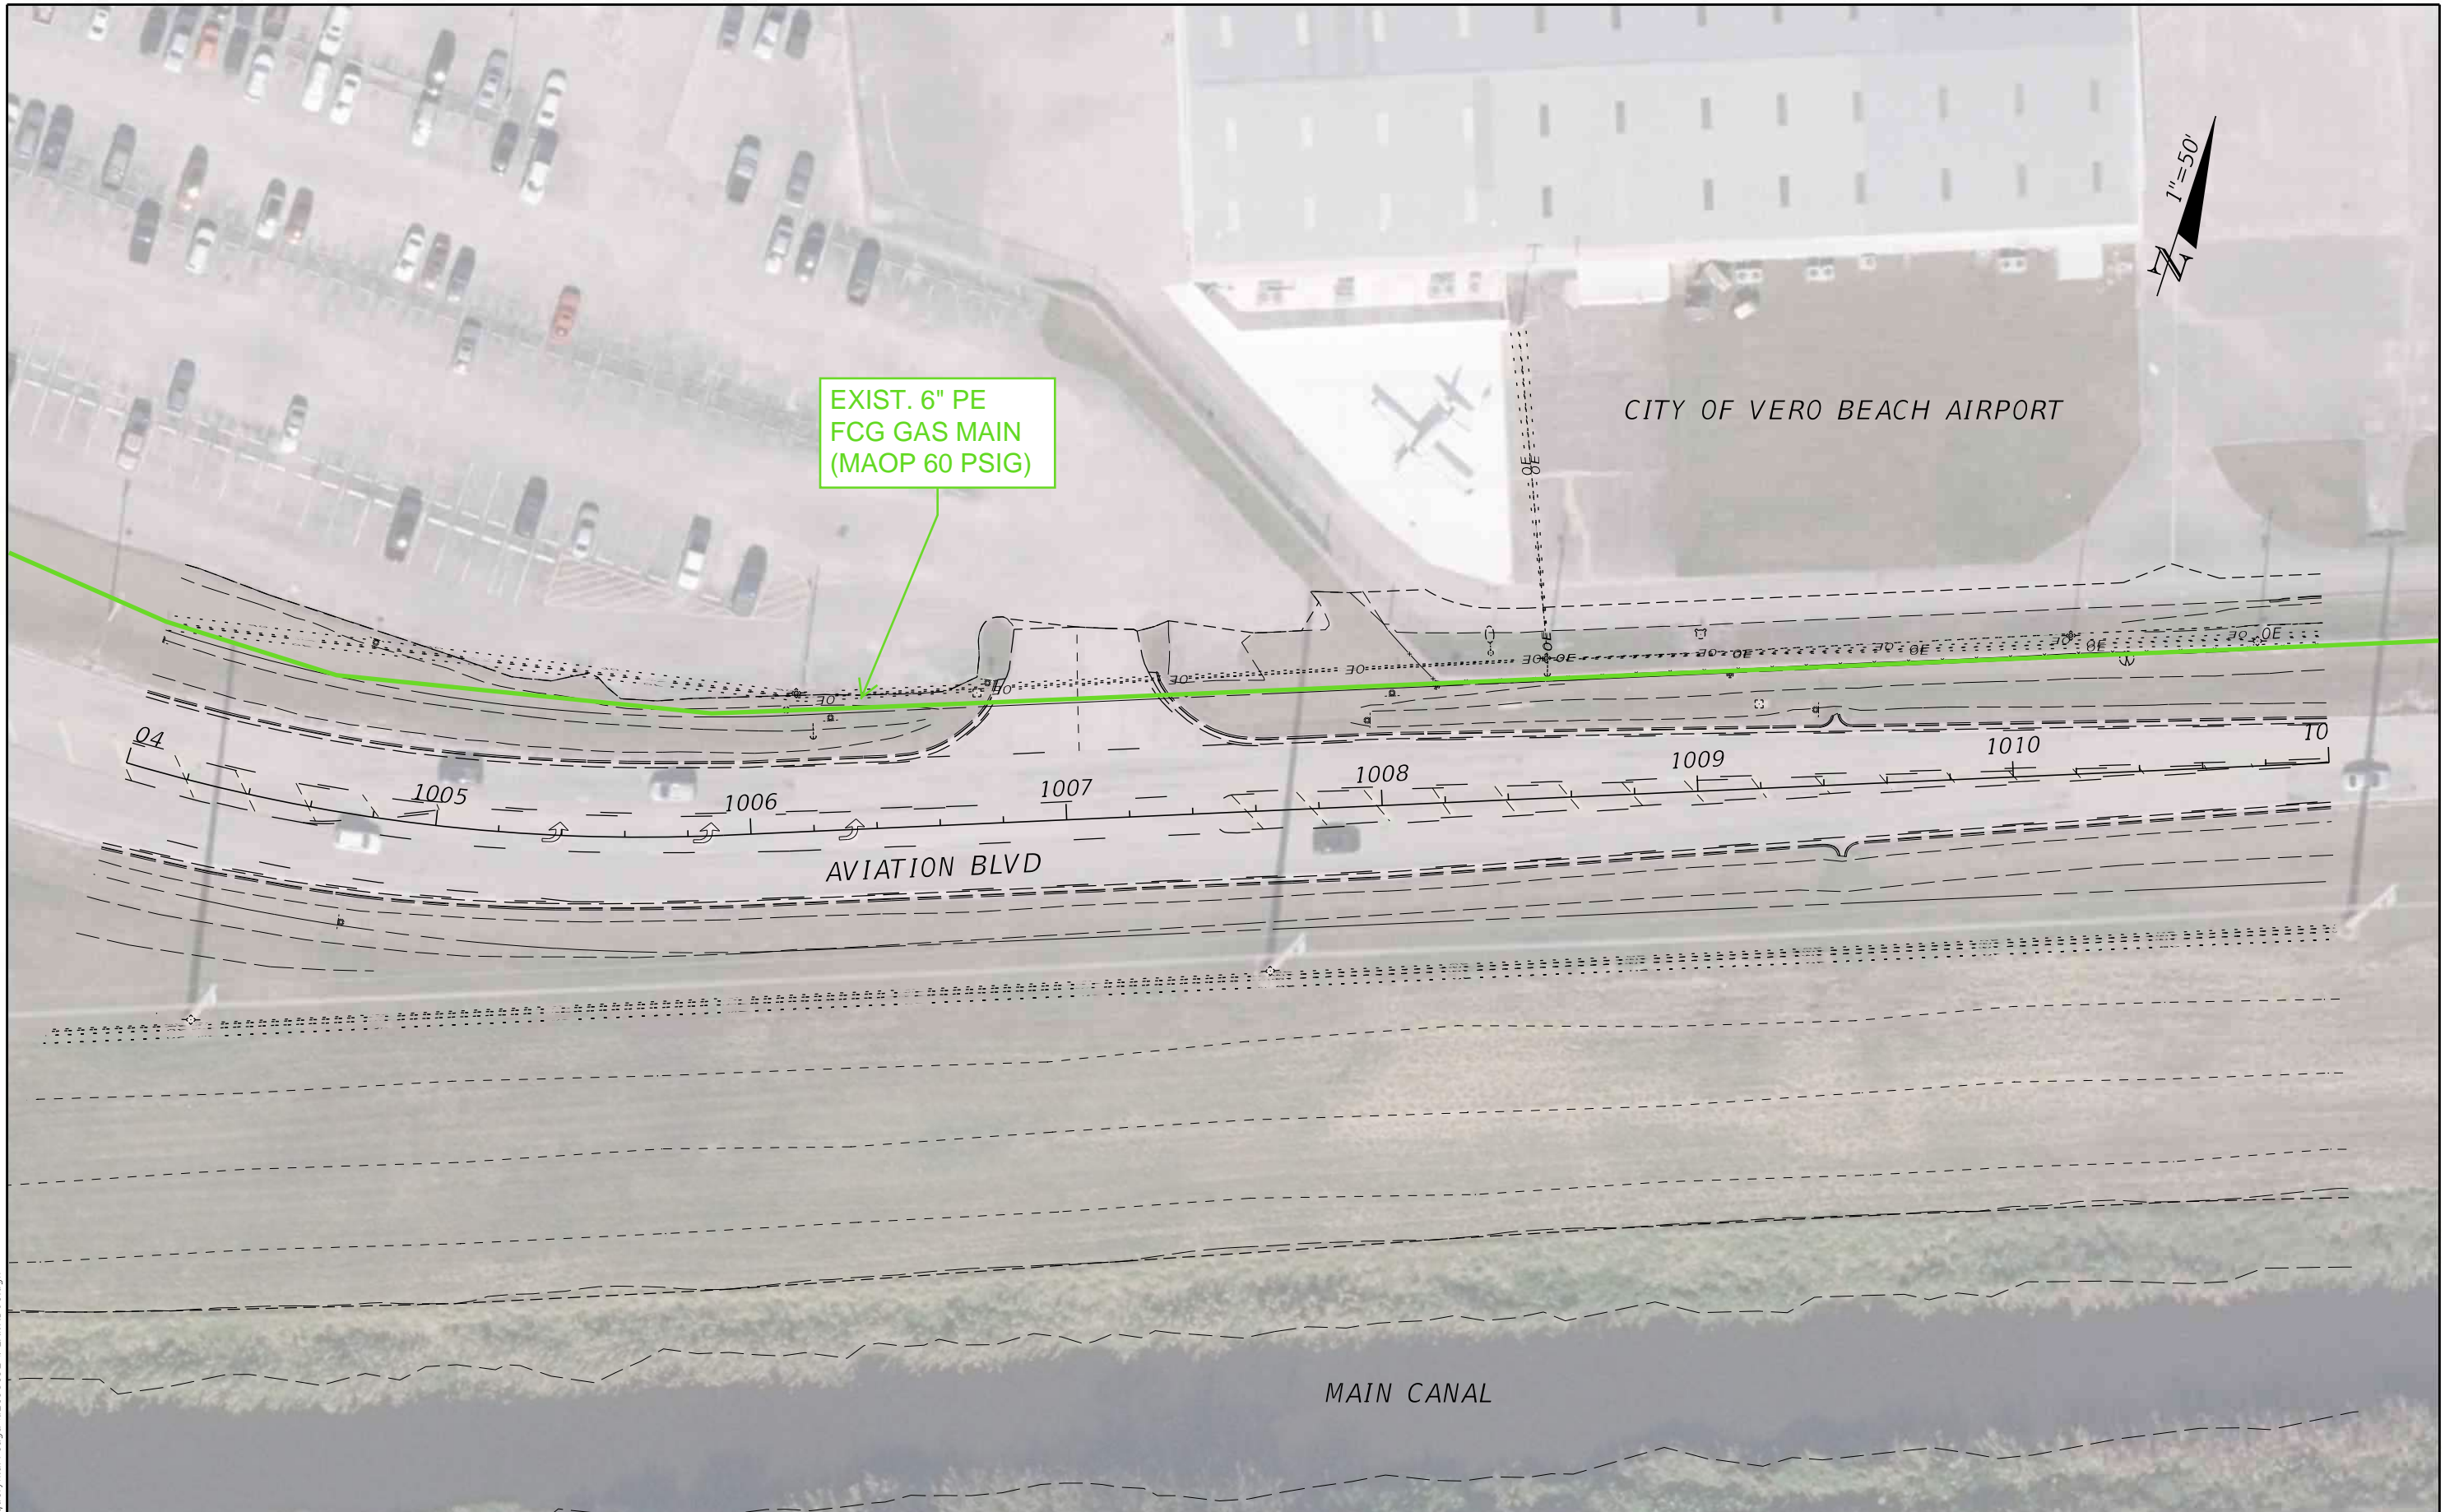

EXIST. 6" PE  
FCG GAS MAIN  
(MAOP 60 PSIG)

CITY OF VERO BEACH AIRPORT



AVIATION BLVD

MAIN CANAL

9/15/2022 11:08:27 AM Jacquelyn.Arreaga  
c:\pwworking\wgn\jacquelyn.arreaga\d2198192\PLANRD01.dgn


REVISIONS		PROFESSIONAL TYPE		STATE OF FLORIDA DEPARTMENT OF TRANSPORTATION			UTILITY CONTACT PLAN (22)	SHEET NO. 22
DATE	DESCRIPTION	DATE	DESCRIPTION	ROAD NO.	COUNTY	FINANCIAL PROJECT ID		
			WILLIAM EVANS LICENSE NUMBER: 45207 WGI, INC. 2035 VISTA PARKWAY WEST PALM BEACH, FL 33411	SR 5	INDIAN RIVER	441693-1-22-02		

THE OFFICIAL RECORD OF THIS SHEET IS THE ELECTRONIC FILE DIGITALLY SIGNED AND SEALED UNDER RULE 61G15-23.004, F.A.C.



CITY OF VERO BEACH AIRP

EXIST. 6" PE  
FCG GAS MAIN  
(MAOP 60 PSIG)

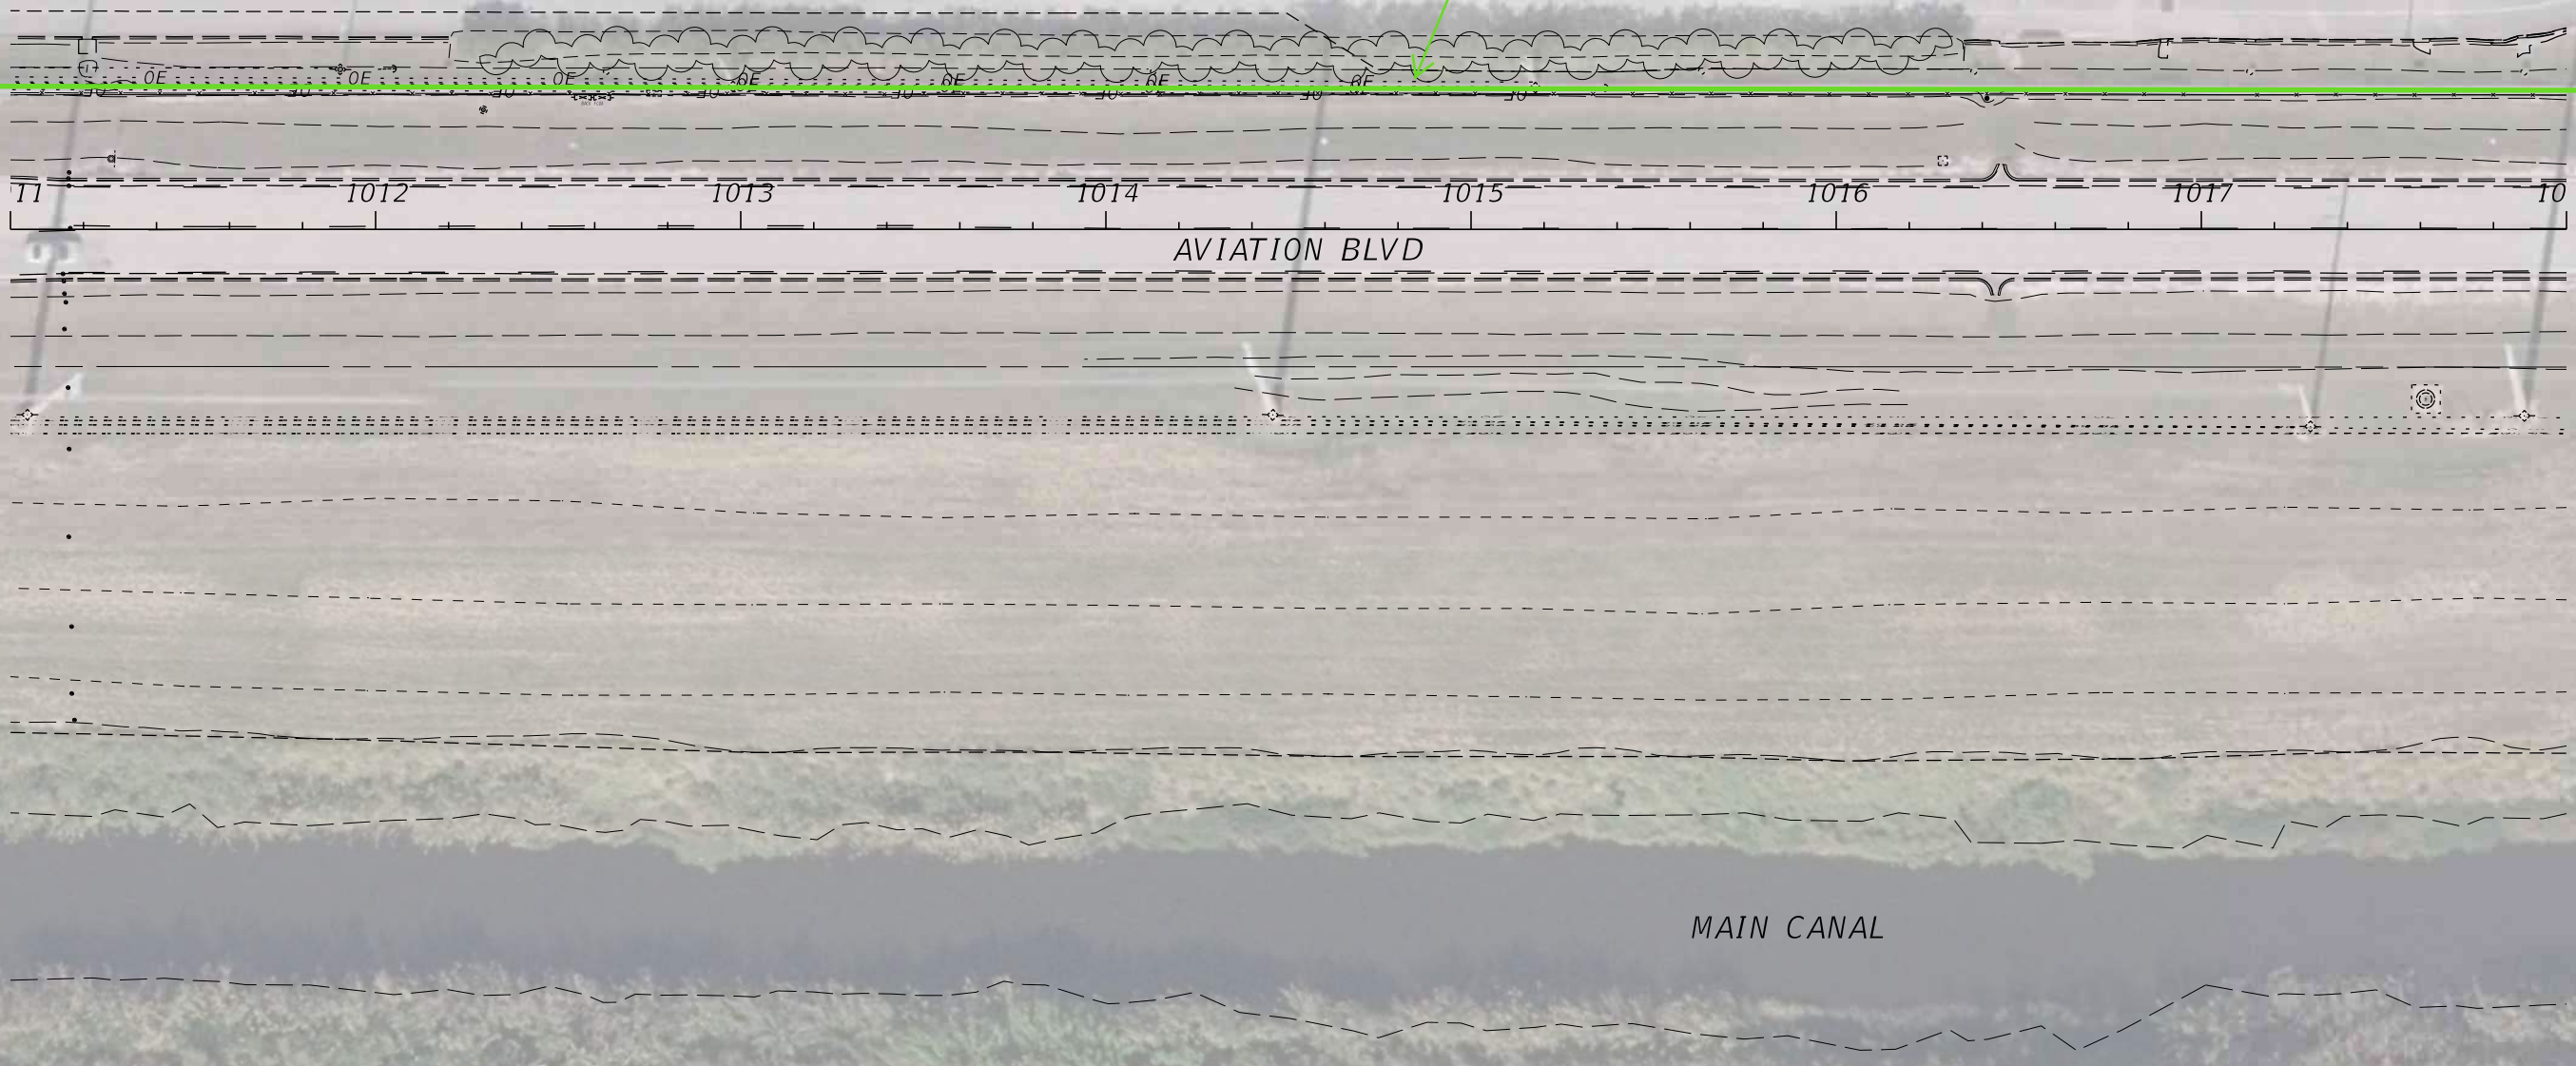

11 1012 1013 1014 1015 1016 1017 10

AVIATION BLVD

MAIN CANAL

9/15/2022 11:08:39 AM Jacquelyn.Arreaga c:\pwworking\wgn\jacquelyn.arreaga\d2198192\PLANRD01.dgn

REVISIONS				PROFESSIONAL TYPE	STATE OF FLORIDA DEPARTMENT OF TRANSPORTATION			UTILITY CONTACT PLAN (23)	SHEET NO. 23
DATE	DESCRIPTION	DATE	DESCRIPTION		ROAD NO.	COUNTY	FINANCIAL PROJECT ID		
				WILLIAM EVANS LICENSE NUMBER: 45207 WGI, INC. 2035 VISTA PARKWAY WEST PALM BEACH, FL 33411	SR 5	INDIAN RIVER	441693-1-22-02		

THE OFFICIAL RECORD OF THIS SHEET IS THE ELECTRONIC FILE DIGITALLY SIGNED AND SEALED UNDER RULE 61G15-23.004, F.A.C.



CITY OF VERO BEACH AIRPORT

EXIST. 6" PE  
FCG GAS MAIN  
(MAOP 60 PSIG)

18 1019 1020 1021 1022 1023 1024 10

N69°21'37"E

AVIATION BLVD

1" x 30" RC

MAIN CANAL

9/15/2022 11:08:55 AM Jacquelyn.Arreaga c:\pwworking\wgn\jacquelyn.arreaga\d2198192\PLANRD01.dgn

REVISIONS				PROFESSIONAL TYPE	STATE OF FLORIDA DEPARTMENT OF TRANSPORTATION			UTILITY CONTACT PLAN (24)	SHEET NO. 24
DATE	DESCRIPTION	DATE	DESCRIPTION		ROAD NO.	COUNTY	FINANCIAL PROJECT ID		
				WILLIAM EVANS LICENSE NUMBER: 45207 WGI, INC. 2035 VISTA PARKWAY WEST PALM BEACH, FL 33411	SR 5	INDIAN RIVER	441693-1-22-02		

THE OFFICIAL RECORD OF THIS SHEET IS THE ELECTRONIC FILE DIGITALLY SIGNED AND SEALED UNDER RULE 61G15-23.004, F.A.C.

CITY OF VERO BEACH AIRPORT



EXIST. 6" PE  
FCG GAS MAIN  
(MAOP 60 PSIG)




9/15/2022 11:09:17 AM Jacquelyn.Arreaga  
c:\pwworking\wgn\jacquelyn.arreaga\d2198192\PLAN\ARD01.dgn


REVISIONS		PROFESSIONAL TYPE		STATE OF FLORIDA DEPARTMENT OF TRANSPORTATION			UTILITY CONTACT PLAN (25)	SHEET NO. 25
DATE	DESCRIPTION	DATE	DESCRIPTION	ROAD NO.	COUNTY	FINANCIAL PROJECT ID		
				SR 5	INDIAN RIVER	441693-1-22-02		

THE OFFICIAL RECORD OF THIS SHEET IS THE ELECTRONIC FILE DIGITALLY SIGNED AND SEALED UNDER RULE 61G15-23.004, F.A.C.



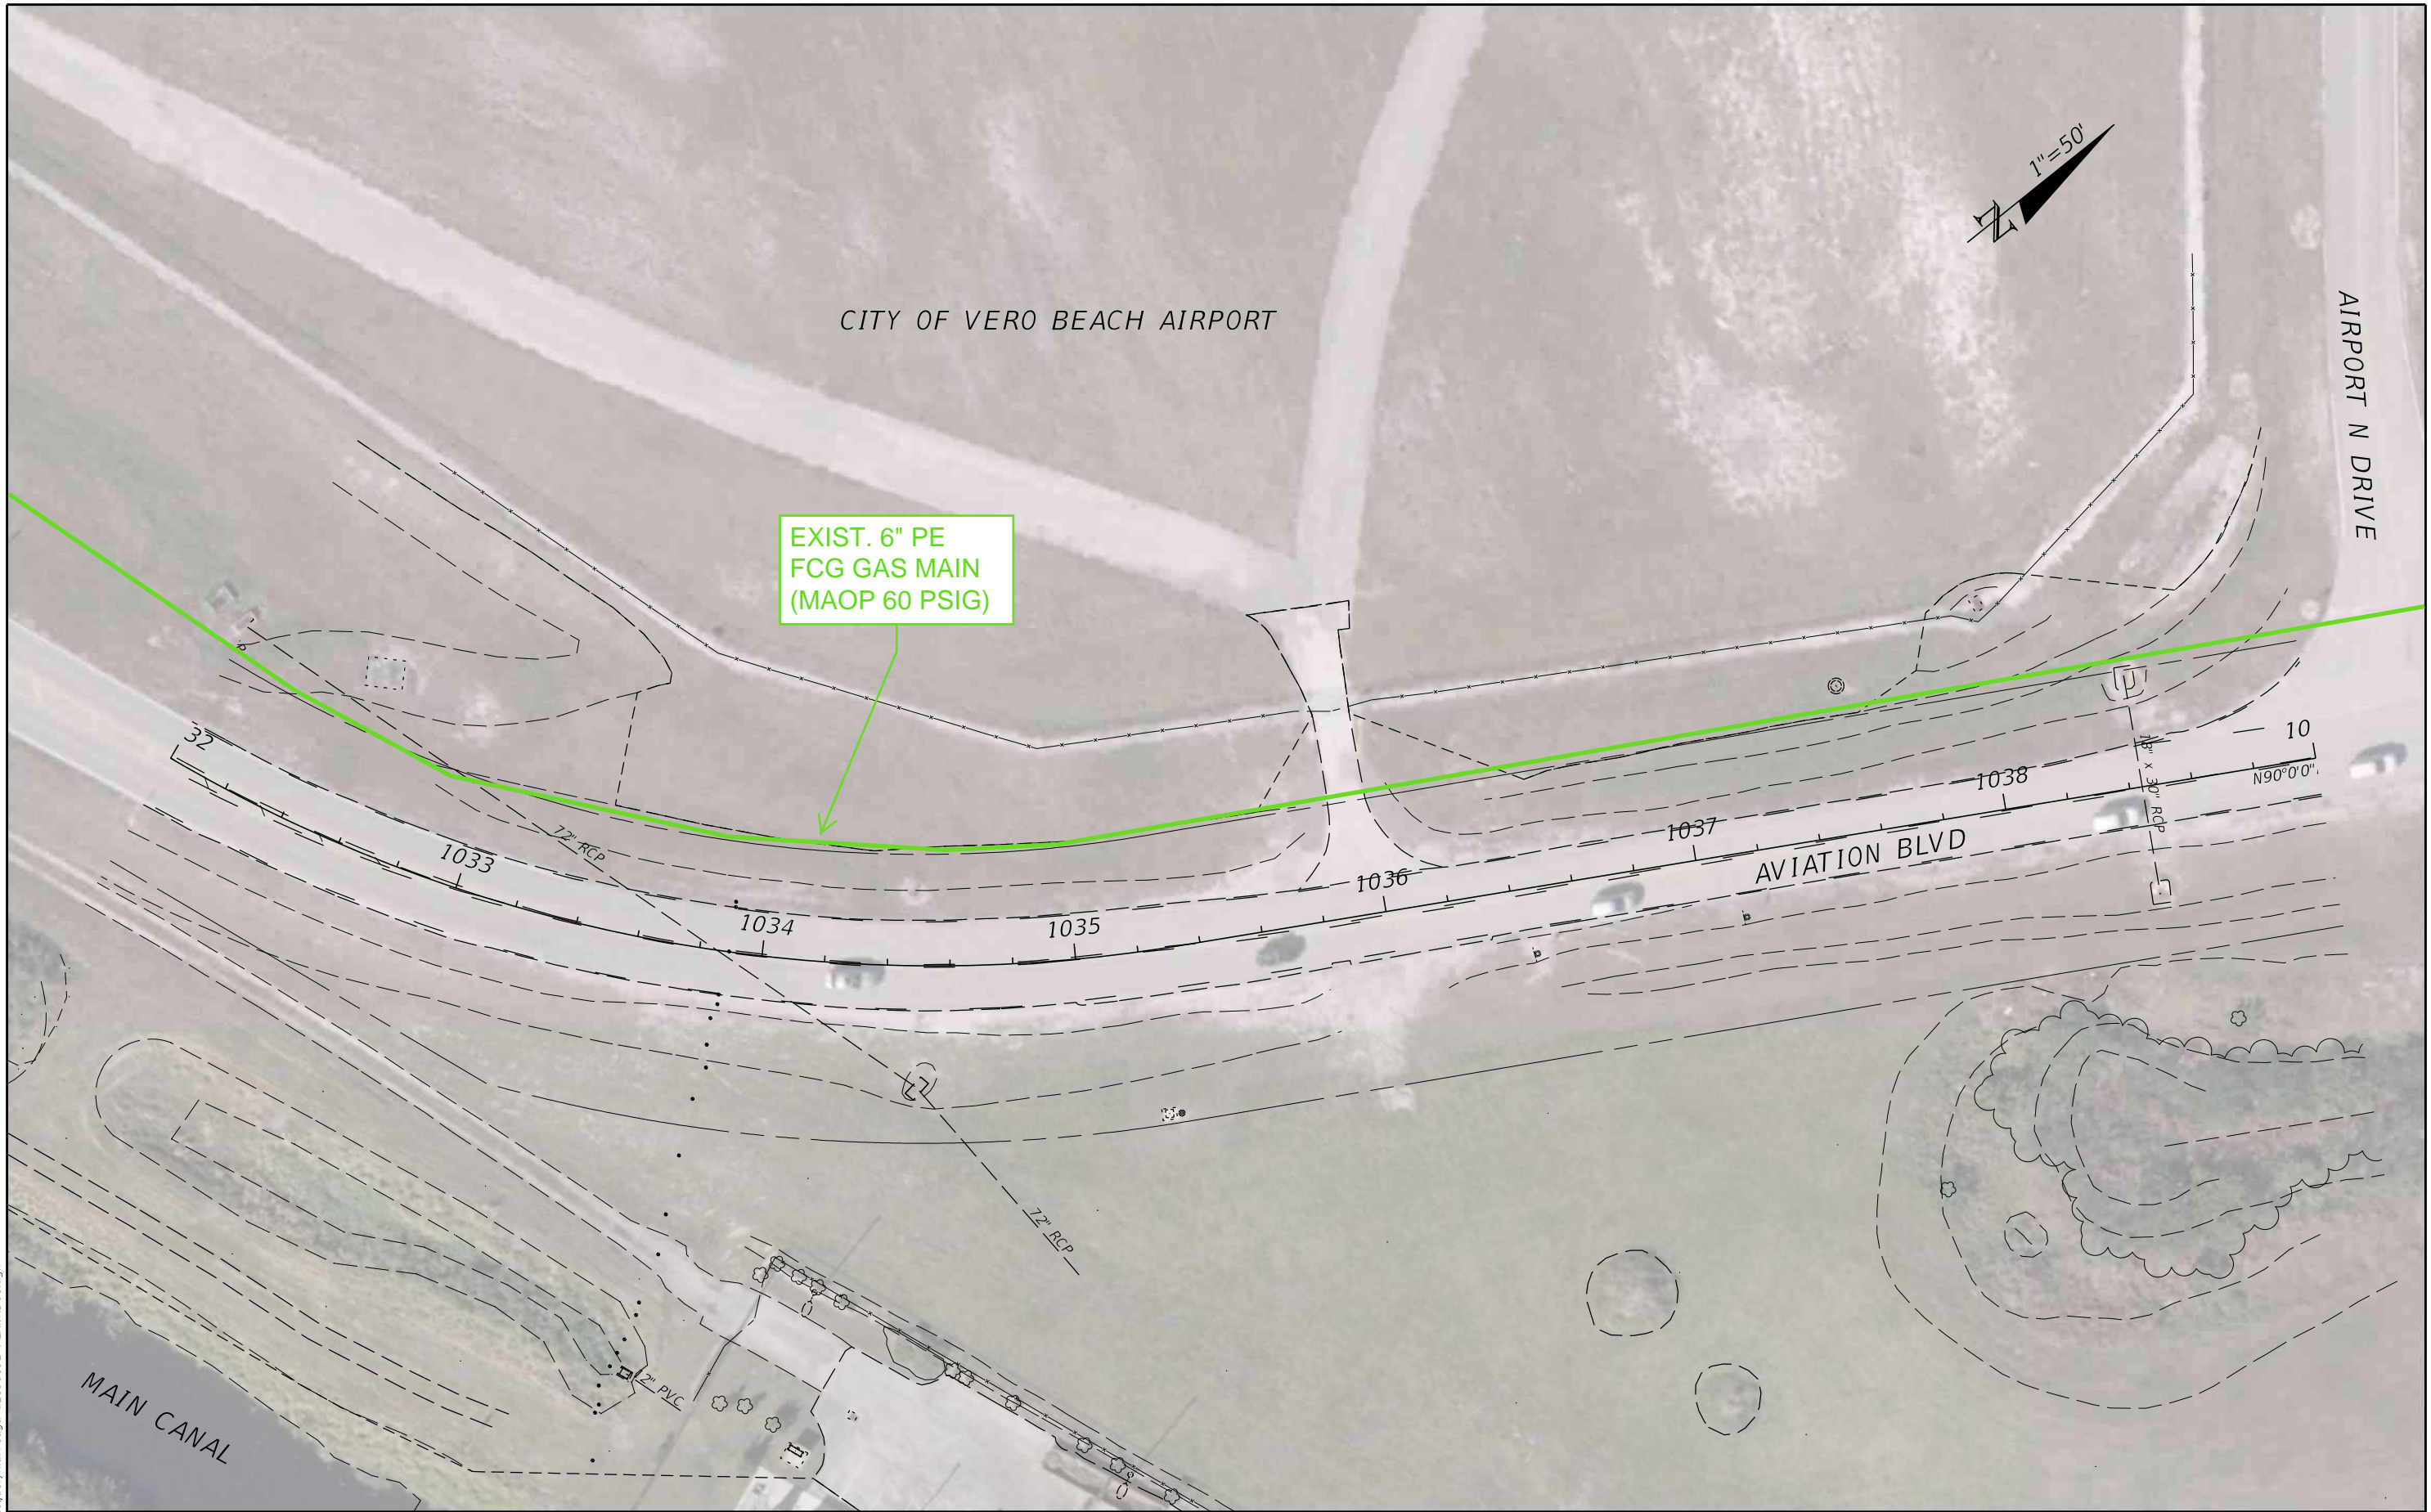

EXIST. 6" PE  
FCG GAS MAIN  
(MAOP 60 PSIG)

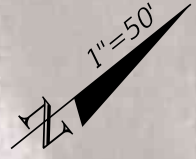

9/15/2022 11:09:30 AM Jacquelyn.Arreaga  
 c:\pwworking\wgn\jacquelyn.arreaga\d2198192\PLANARD01.dgn



THE OFFICIAL RECORD OF THIS SHEET IS THE ELECTRONIC FILE DIGITALLY SIGNED AND SEALED UNDER RULE 61G15-23.004, F.A.C.

REVISIONS				PROFESSIONAL TYPE	STATE OF FLORIDA DEPARTMENT OF TRANSPORTATION			UTILITY CONTACT PLAN (26)	SHEET NO.
DATE	DESCRIPTION	DATE	DESCRIPTION		ROAD NO.	COUNTY	FINANCIAL PROJECT ID		
				WILLIAM EVANS LICENSE NUMBER: 45207 WGI, INC. 2035 VISTA PARKWAY WEST PALM BEACH, FL 33411	SR 5	INDIAN RIVER	441693-1-22-02	26	

CITY OF VERO BEACH AIRPORT

EXIST. 6" PE  
FCG GAS MAIN  
(MAOP 60 PSIG)

EXIST. FCG GAS  
VALVE

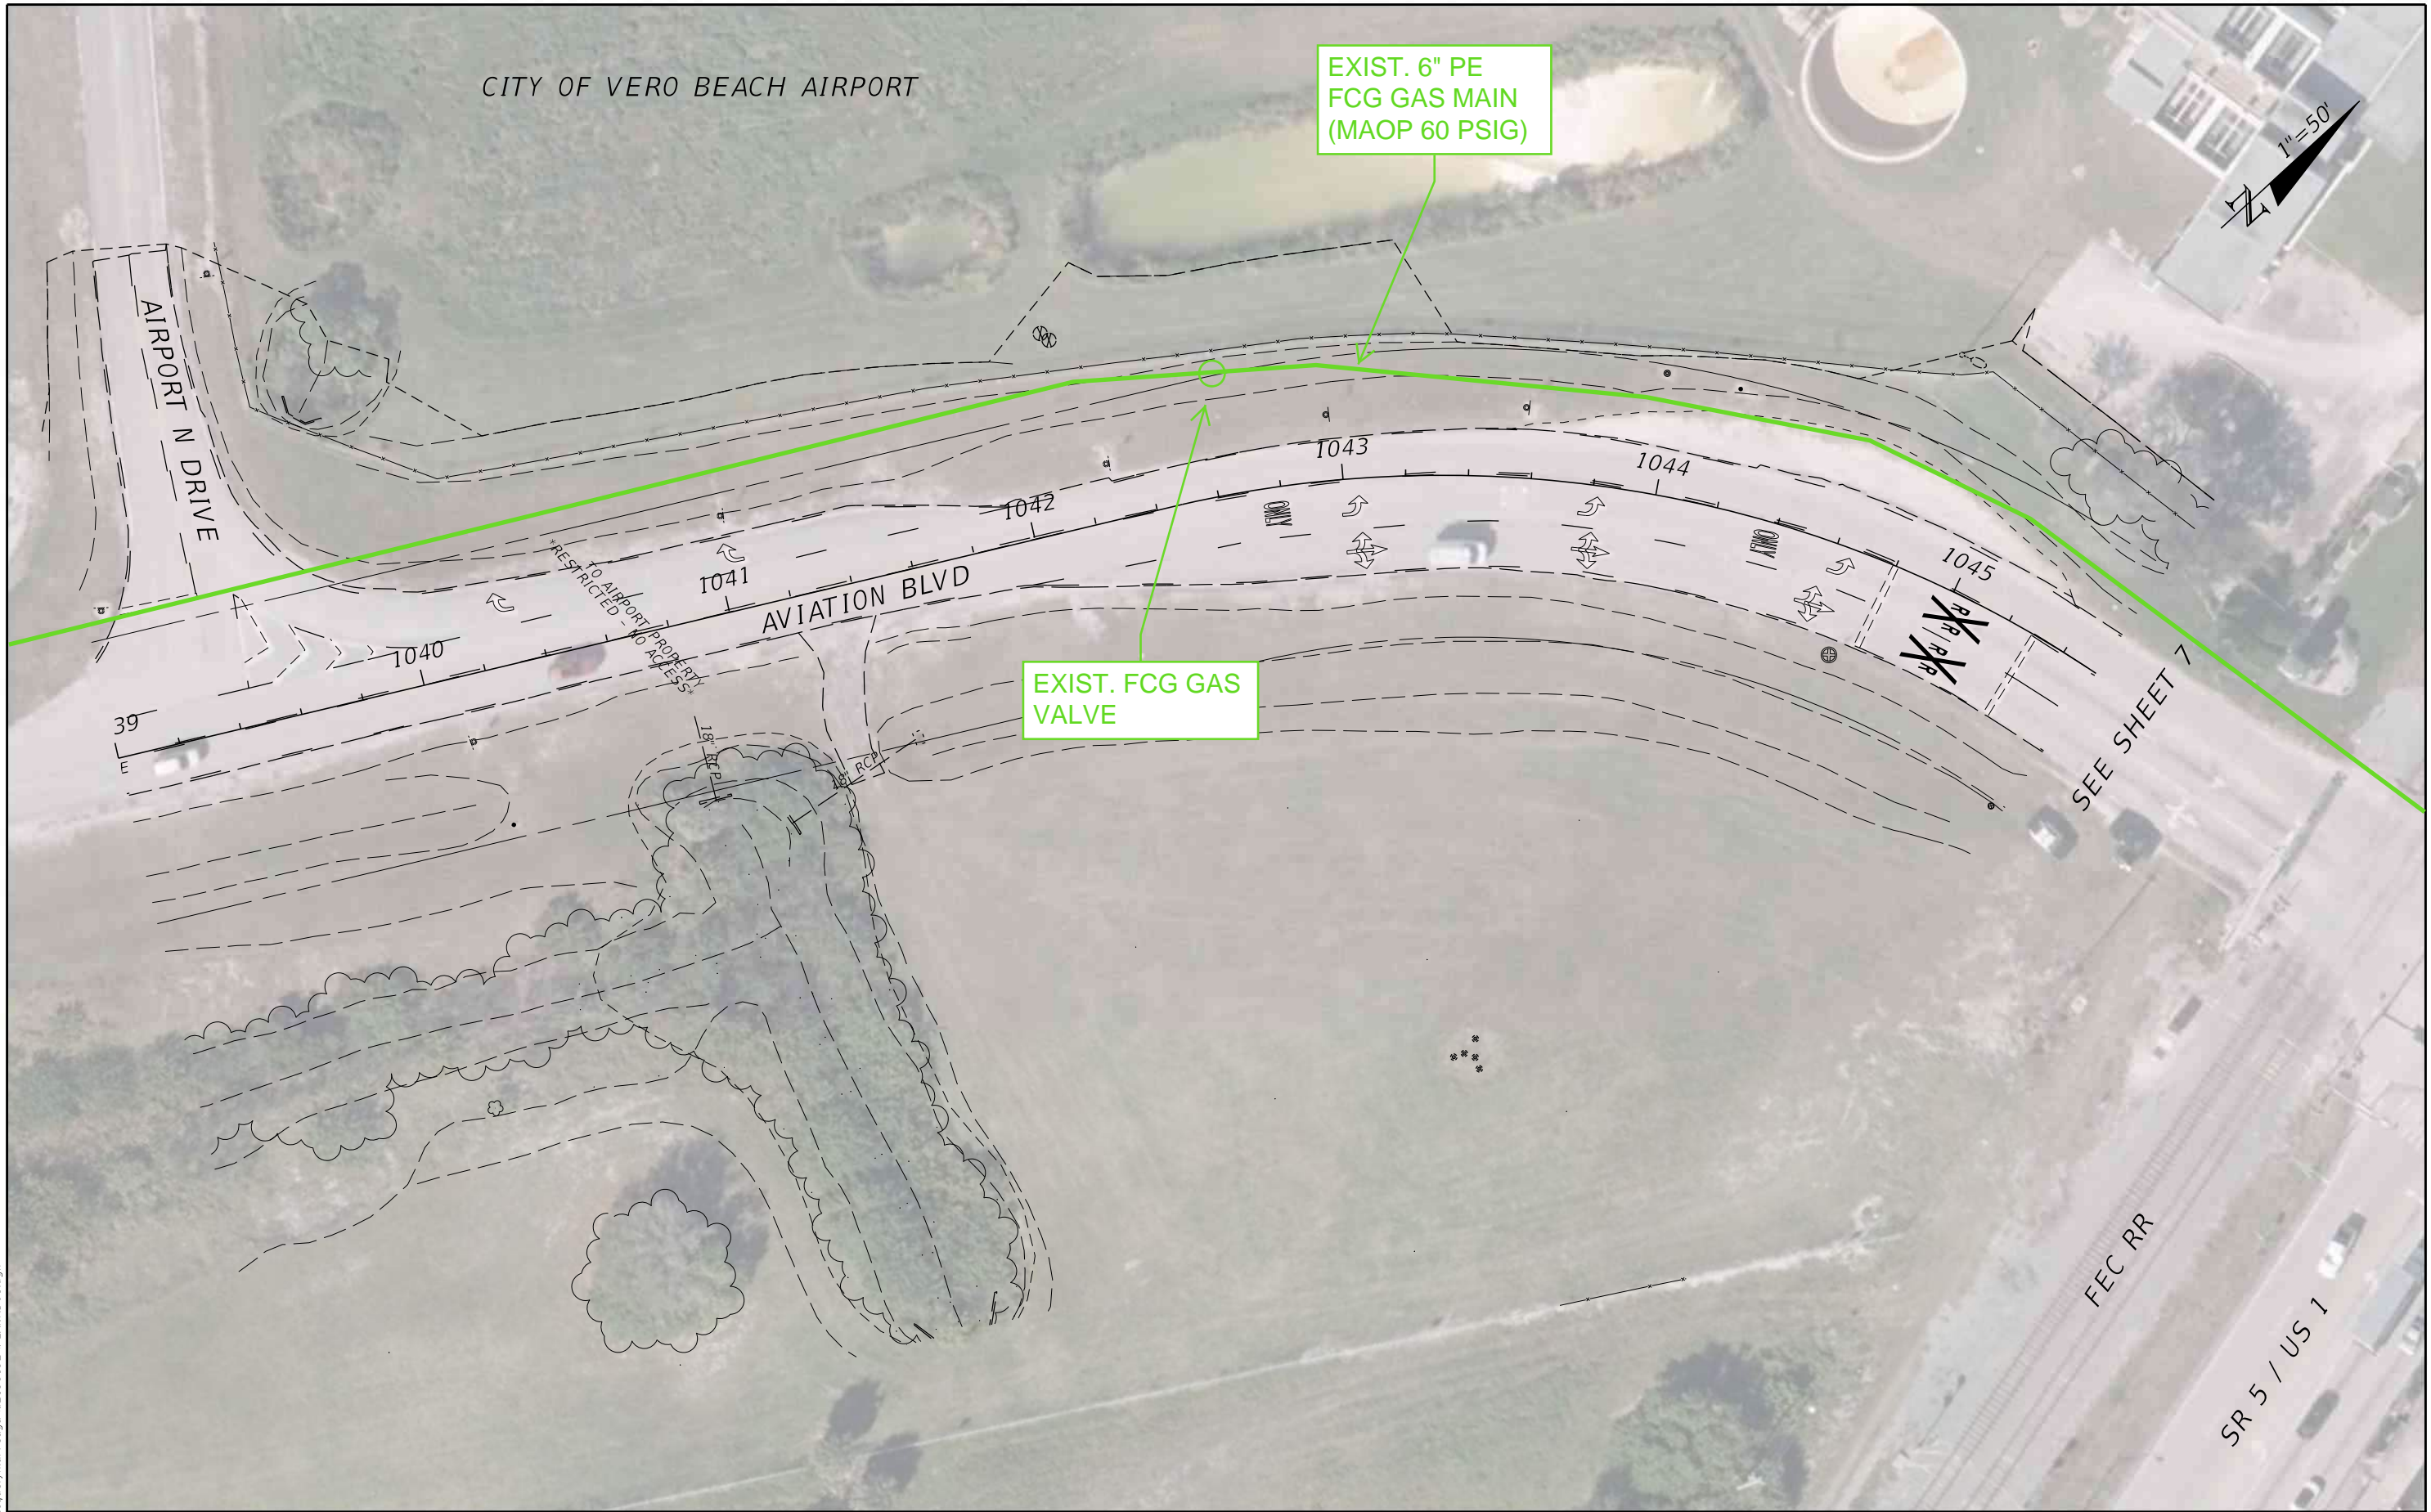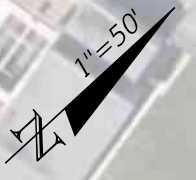

SEE SHEET 7

FEC RR

SR 5 / US 1

9/15/2022 11:09:43 AM Jacquelyn.Arreaga  
c:\pwworking\wg\N\Jacquelyn.arreaga\d2198192\PLANRD01.dgn

REVISIONS				PROFESSIONAL TYPE	STATE OF FLORIDA DEPARTMENT OF TRANSPORTATION			SHEET NO.
DATE	DESCRIPTION	DATE	DESCRIPTION		ROAD NO.	COUNTY	FINANCIAL PROJECT ID	
				WILLIAM EVANS LICENSE NUMBER: 45207 WGI, INC. 2035 VISTA PARKWAY WEST PALM BEACH, FL 33411	SR 5	INDIAN RIVER	441693-1-22-02	27

UTILITY CONTACT PLAN (27)

THE OFFICIAL RECORD OF THIS SHEET IS THE ELECTRONIC FILE DIGITALLY SIGNED AND SEALED UNDER RULE 61G15-23.004, F.A.C.


**Appendix D**

**FP&L Distribution**

Call before you dig! 1-800-432-4770

BB-0628

Confidential: For Florida Power & Light Company use only.

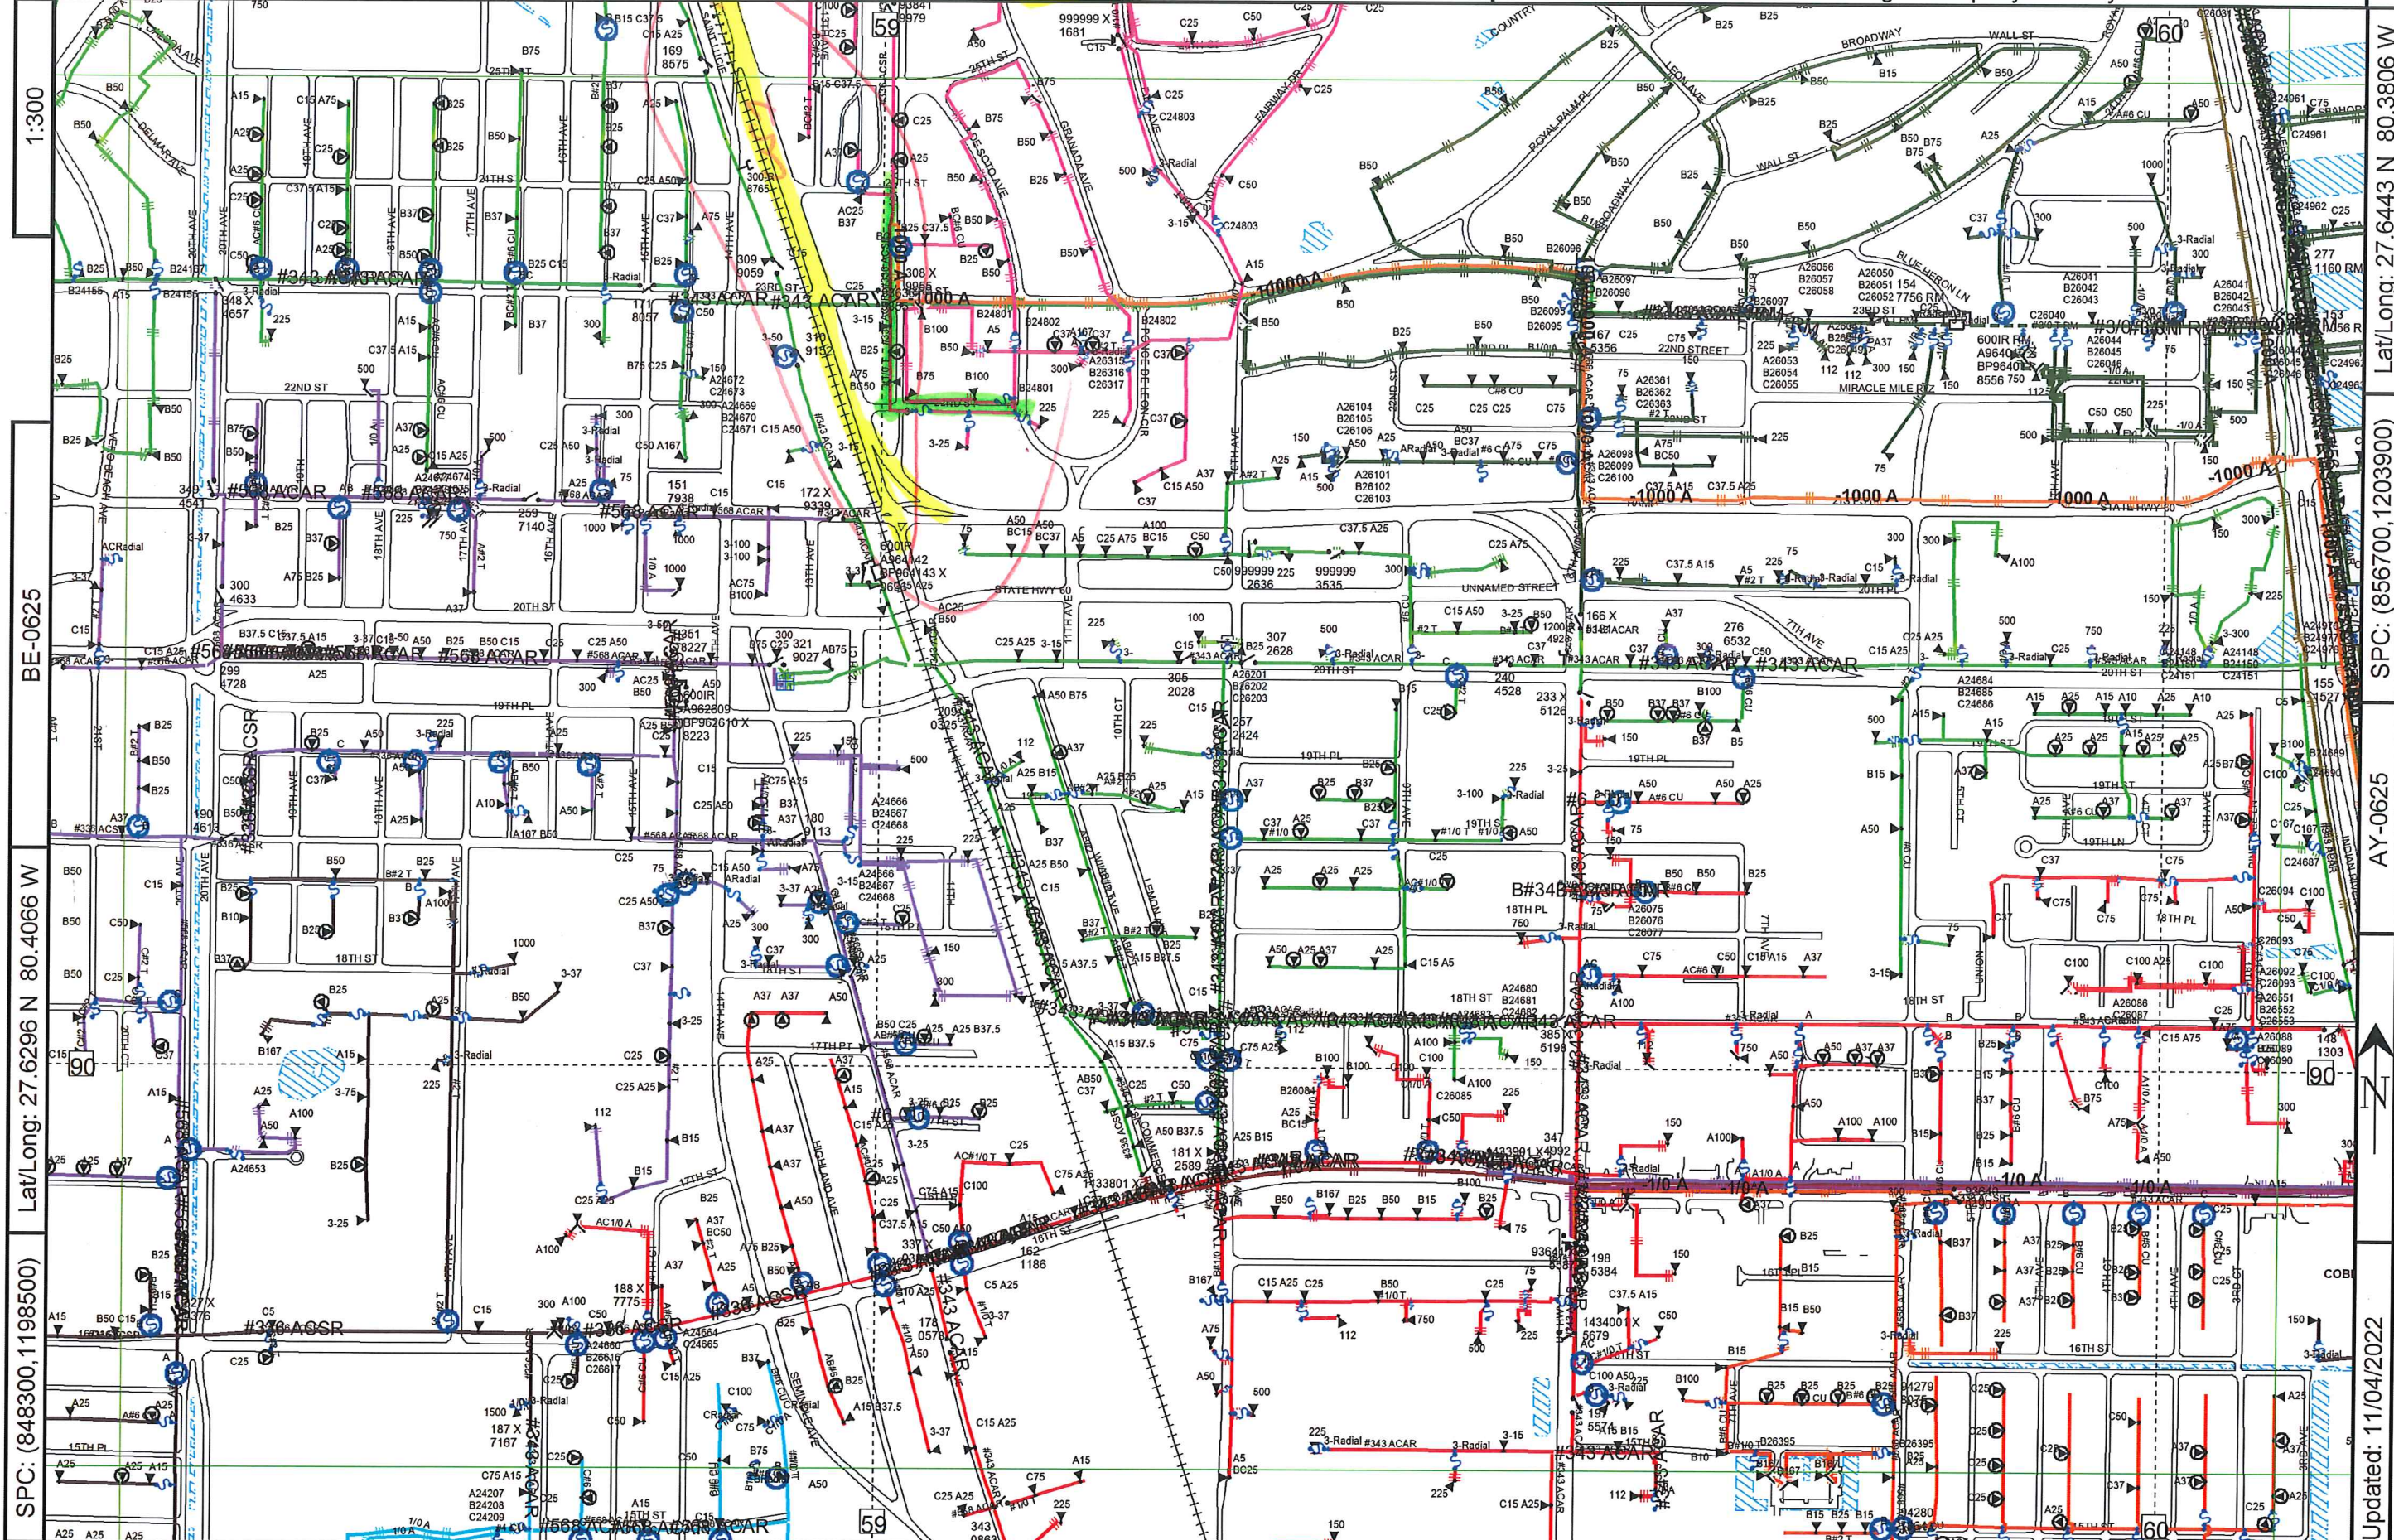

1:300

BE-0625

Lat/Long: 27.6296 N 80.4066 W

SPC: (848300,1198500)

Lat/Long: 27.6443 N 80.3806 W

SPC: (856700,1203900)

AY-0625

Updated: 11/04/2022

County: Indian River

Mgmt Area: Treasure Coast

Svc Ctr: St Lucie

BB-0622


0' 600' 1200'

Primary Map: BB-0625

Call before you dig! 1-800-432-4770

BB-0631

Confidential: For Florida Power & Light Company use only.

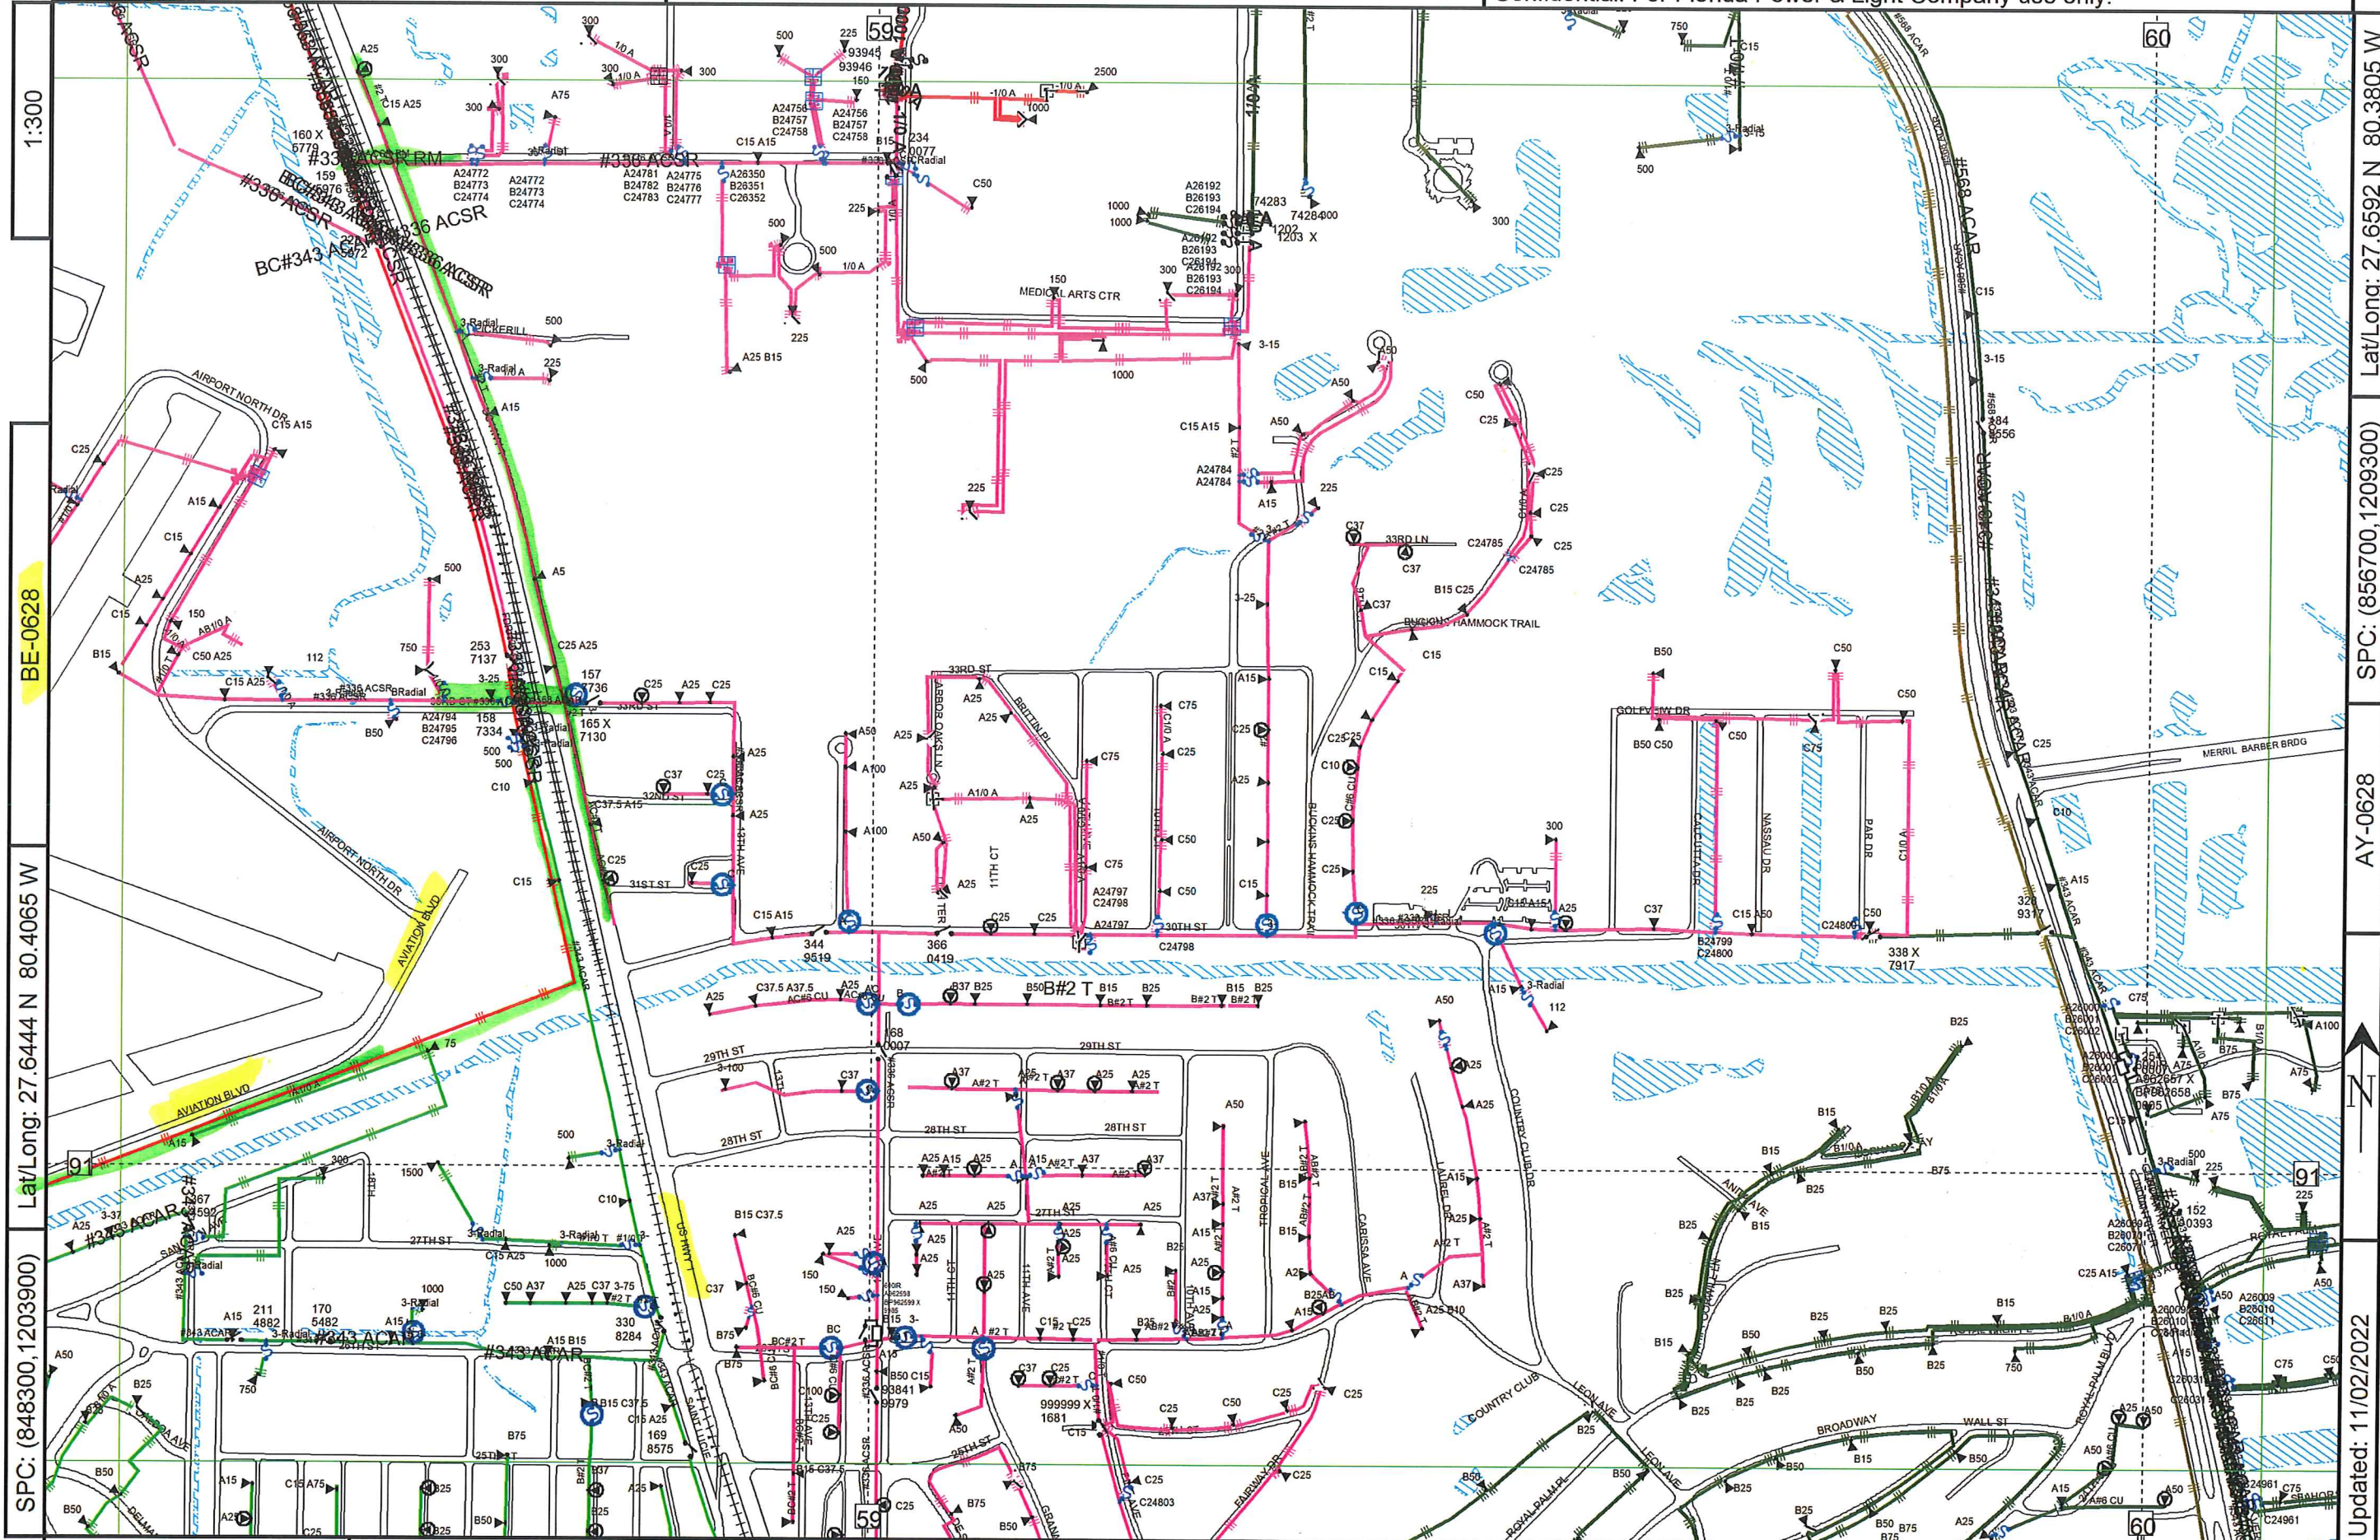

1:300

BE-0628

Lat/Long: 27.6444 N 80.4065 W

SPC: (848300,1203900)

Lat/Long: 27.6592 N 80.3805 W

SPC: (856700,1209300)

AY-0628

Updated: 11/02/2022

County: Indian River

Mgmt Area: Treasure Coast

Svc Ctr: St Lucie

BB-0625

Primary Map: BB-0628

BB062803

Call before you dig! 1-800-432-4770

BB-0634

Confidential: For Florida Power & Light Company use only.



1:300

BE-0631

Lat/Long: 27.6593 N 80.4065 W

SPC: (848300,1209300)

Lat/Long: 27.6740 N 80.3804 W

SPC: (856700,1214700)

AY-0631

Updated: 10/27/2022

County: Indian River

Mgmt Area: Treasure Coast

Svc Ctr: St Lucie

BB-0628

Primary Map: BB-0631

Call before you dig! 1-800-432-4770

BE-0631

Confidential: For Florida Power & Light Company use only.

1:300

BH-0628

Lat/Long: 27.6445 N 80.4325 W

SPC: (839900,1203900)

Lat/Long: 27.6593 N 80.4065 W

SPC: (848300,1209300)

BB-0628

Updated: 11/02/2022


County: Indian River

Mgmt Area: Treasure Coast

Svc Ctr: St Lucie

BE-0625


Primary Map: BE-0628

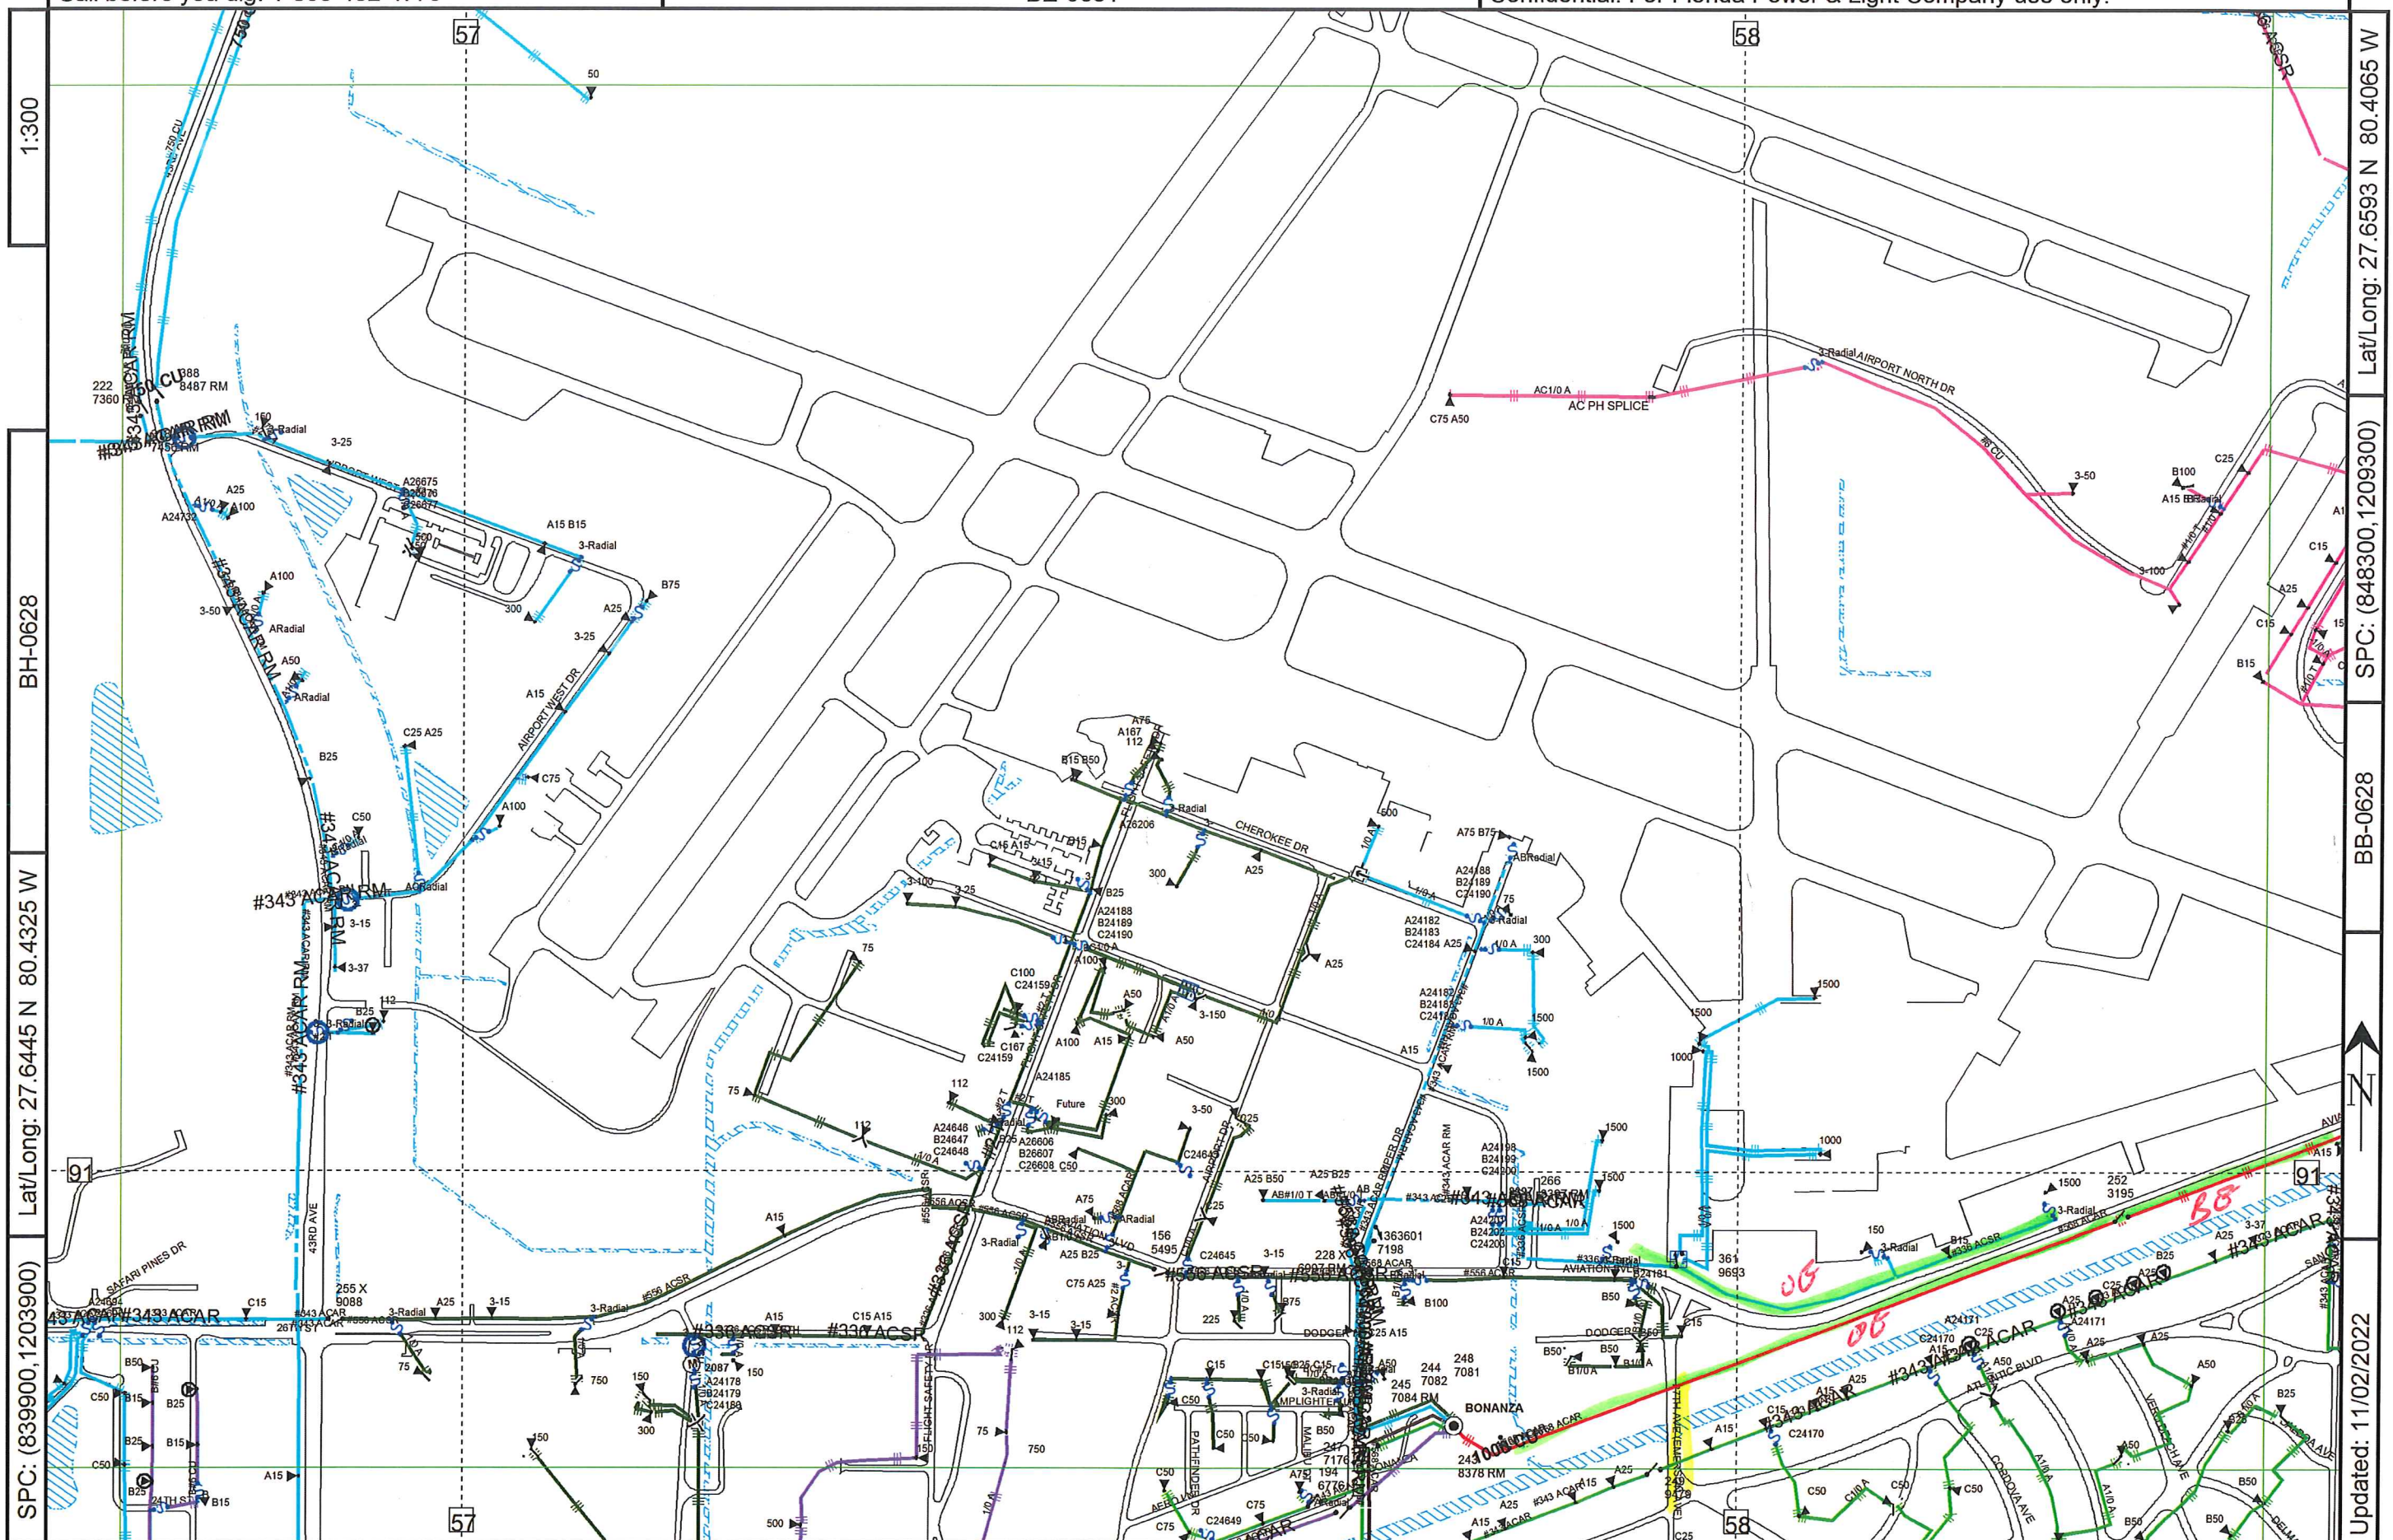

Call before you dig! 1-800-432-4770

BE-0634

Confidential: For Florida Power & Light Company use only.

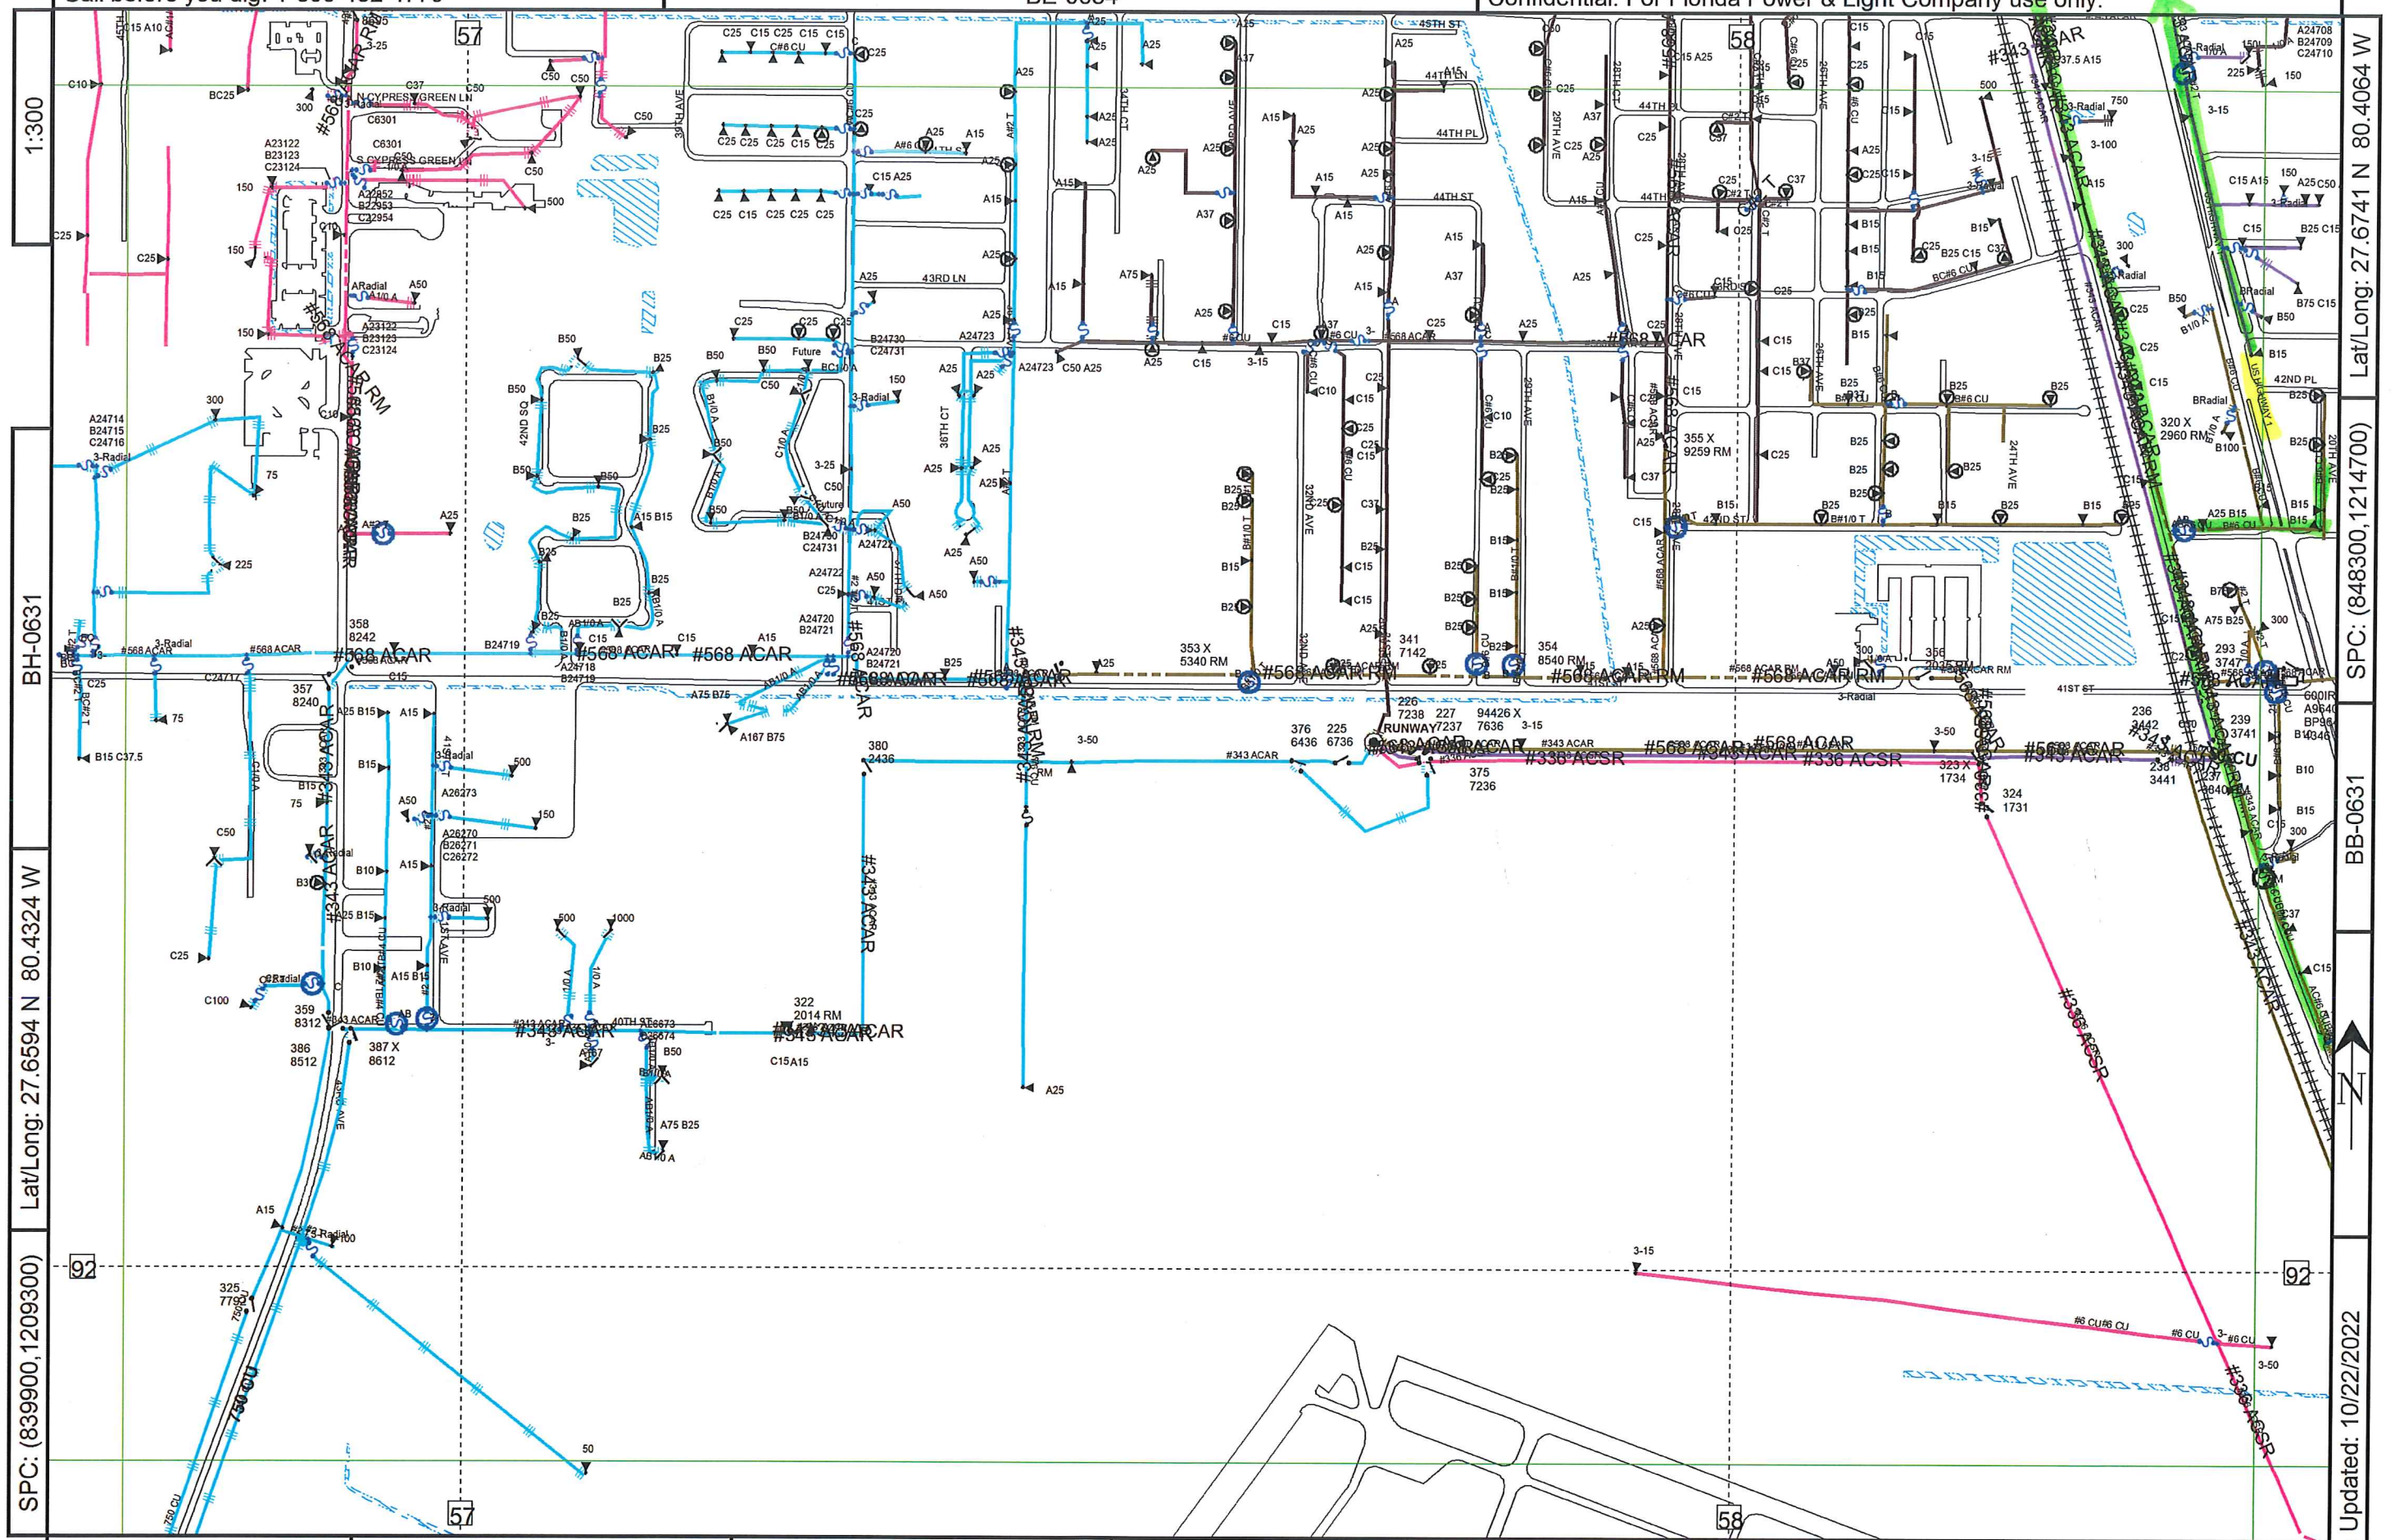

1:300

BH-0631

Lat/Long: 27.6594 N 80.4324 W

SPC: (839900,1209300)

Lat/Long: 27.6741 N 80.4064 W

BB-0631


Updated: 10/22/2022

County: Indian River

Mgmt Area: Treasure Coast


Svc Ctr: St Lucie

BE-0628

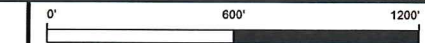

Primary Map: BE-0631



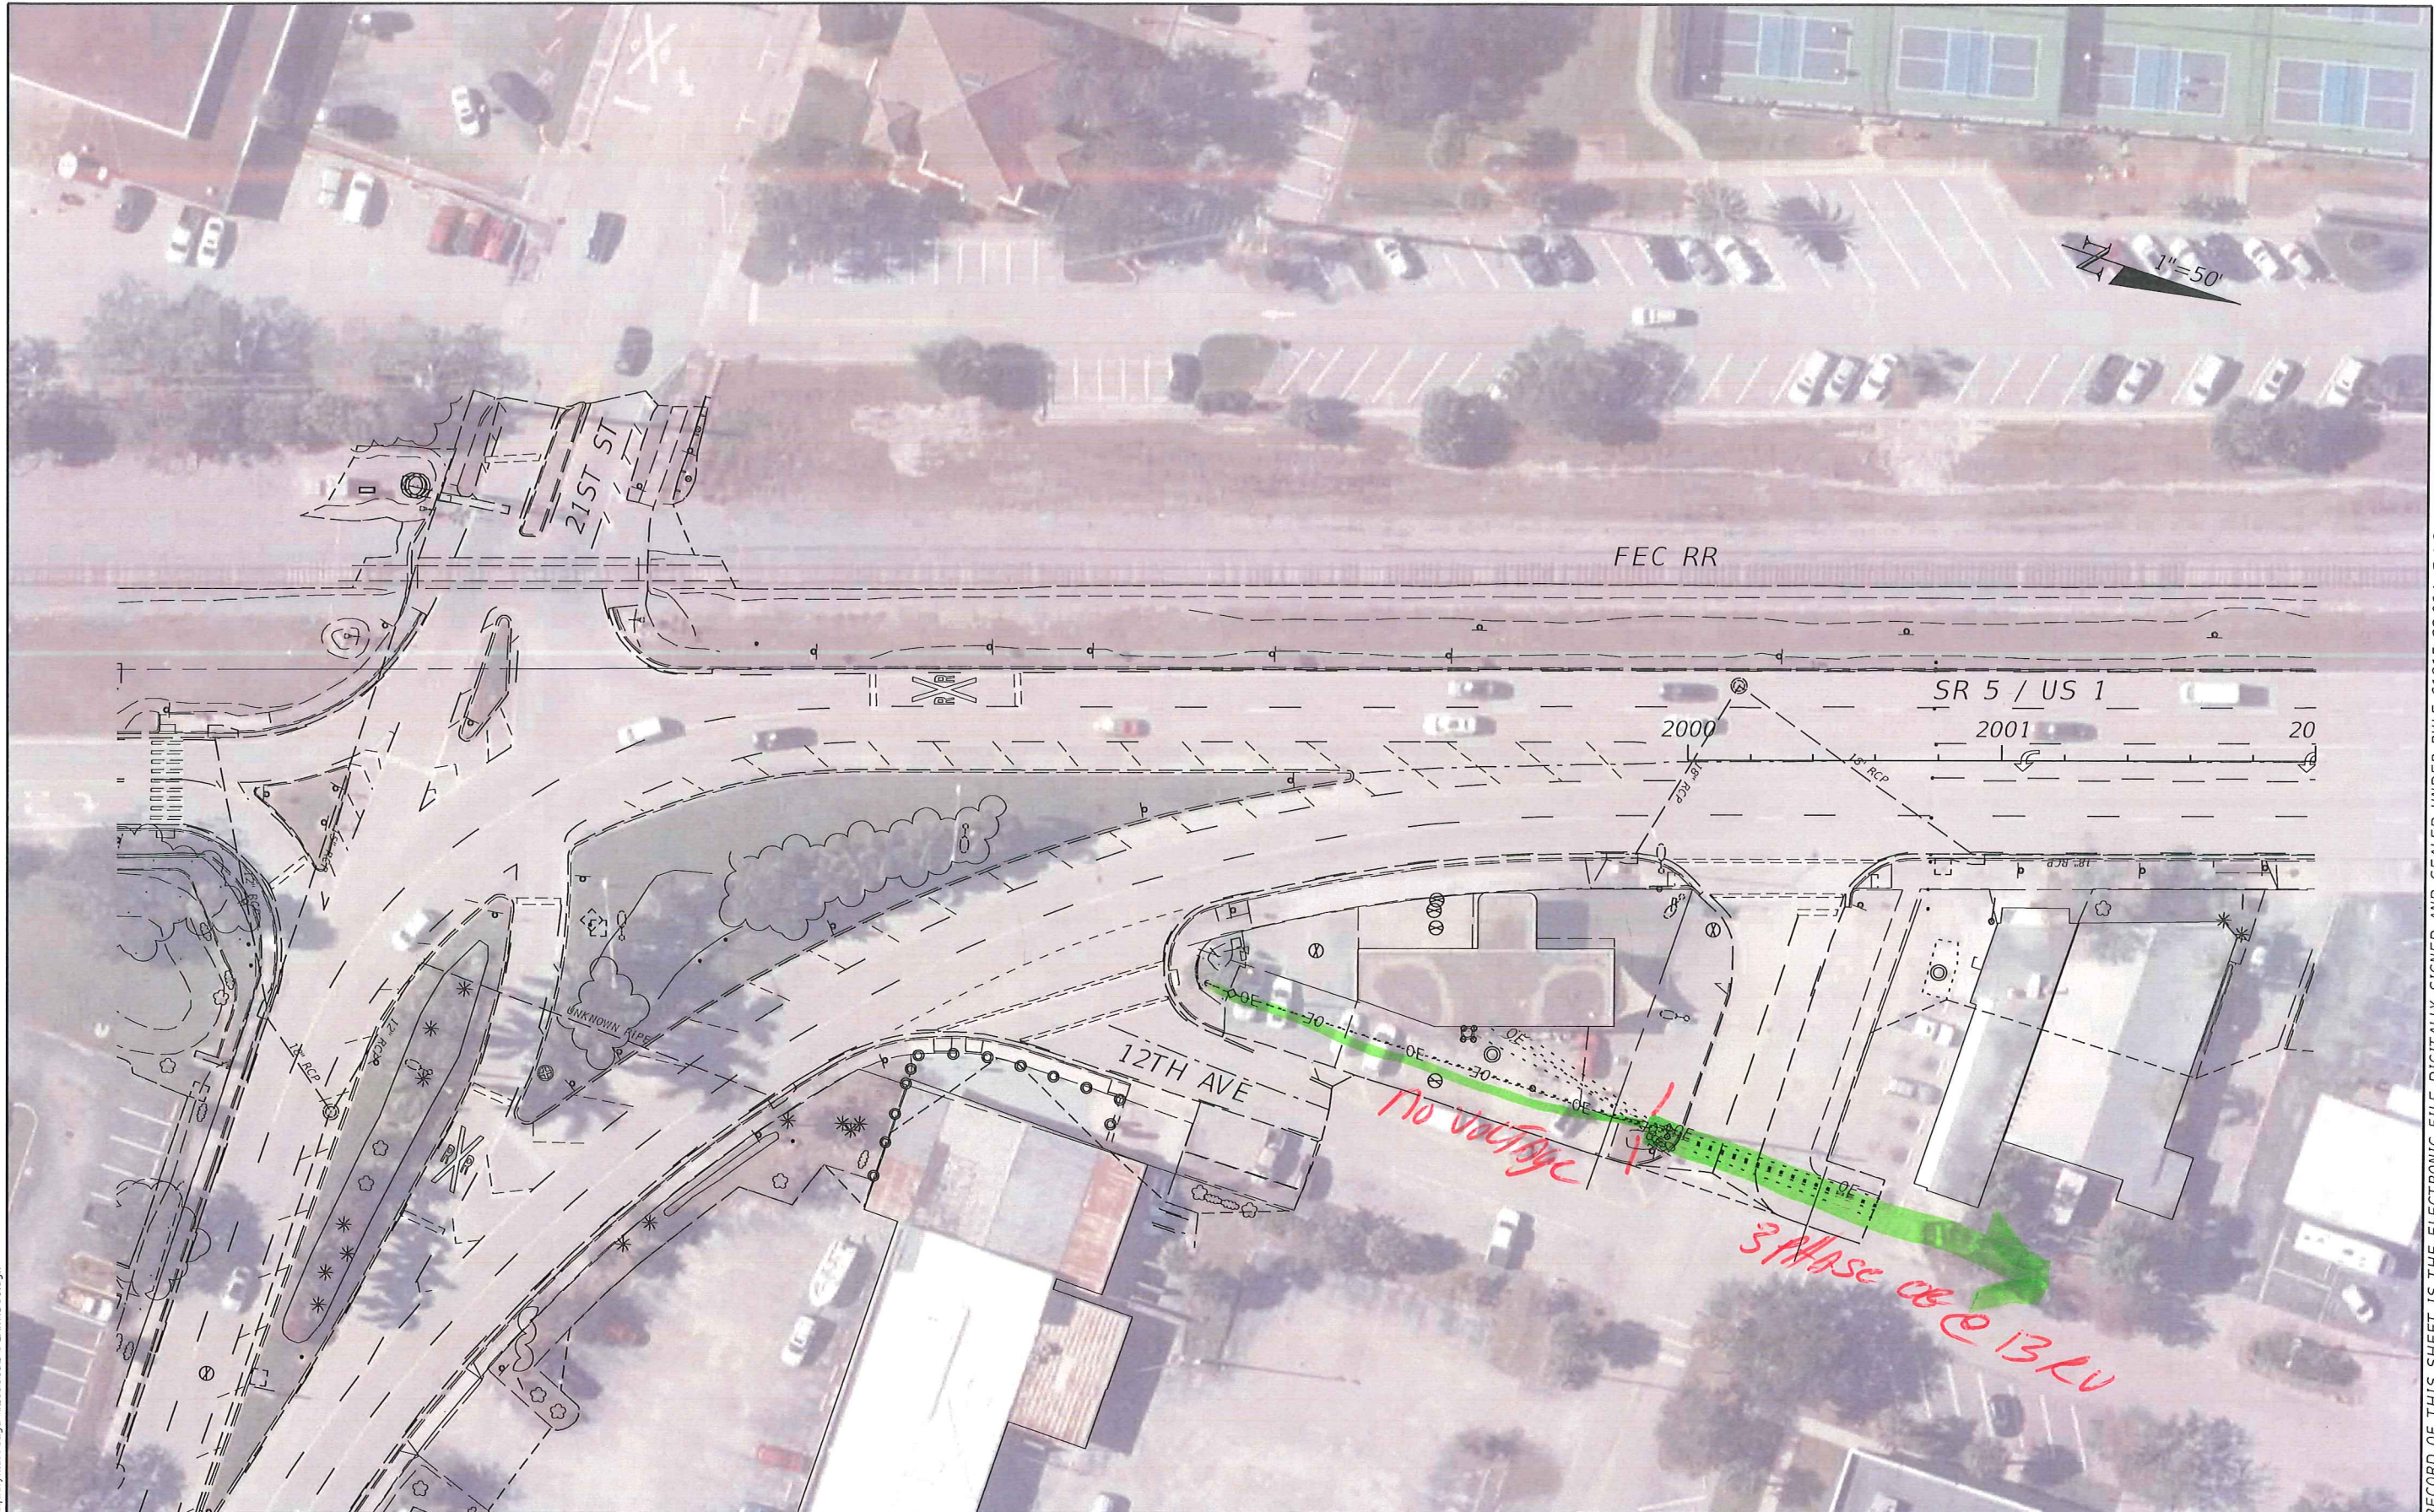

9/15/2022 10:58:52 AM Jacquelyn.Arreaga  
 c:\pwworking\wgi\jacquelyn.arreaga\d2198192\PLAN\ARDD01.dgn

REVISIONS		PROFESSIONAL TYPE	
DATE	DESCRIPTION	DATE	DESCRIPTION


WILLIAM EVANS  
 LICENSE NUMBER: 45207  
 WGI, INC.  
 2035 VISTA PARKWAY  
 WEST PALM BEACH, FL 33411

STATE OF FLORIDA DEPARTMENT OF TRANSPORTATION		
ROAD NO.	COUNTY	FINANCIAL PROJECT ID
SR 5	INDIAN RIVER	441693-1-22-02

**UTILITY CONTACT PLAN (1)**

SHEET NO.
1


THE OFFICIAL RECORD OF THIS SHEET IS THE ELECTRONIC FILE DIGITALLY SIGNED AND SEALED UNDER RULE 61G15-23.004, F.A.C.

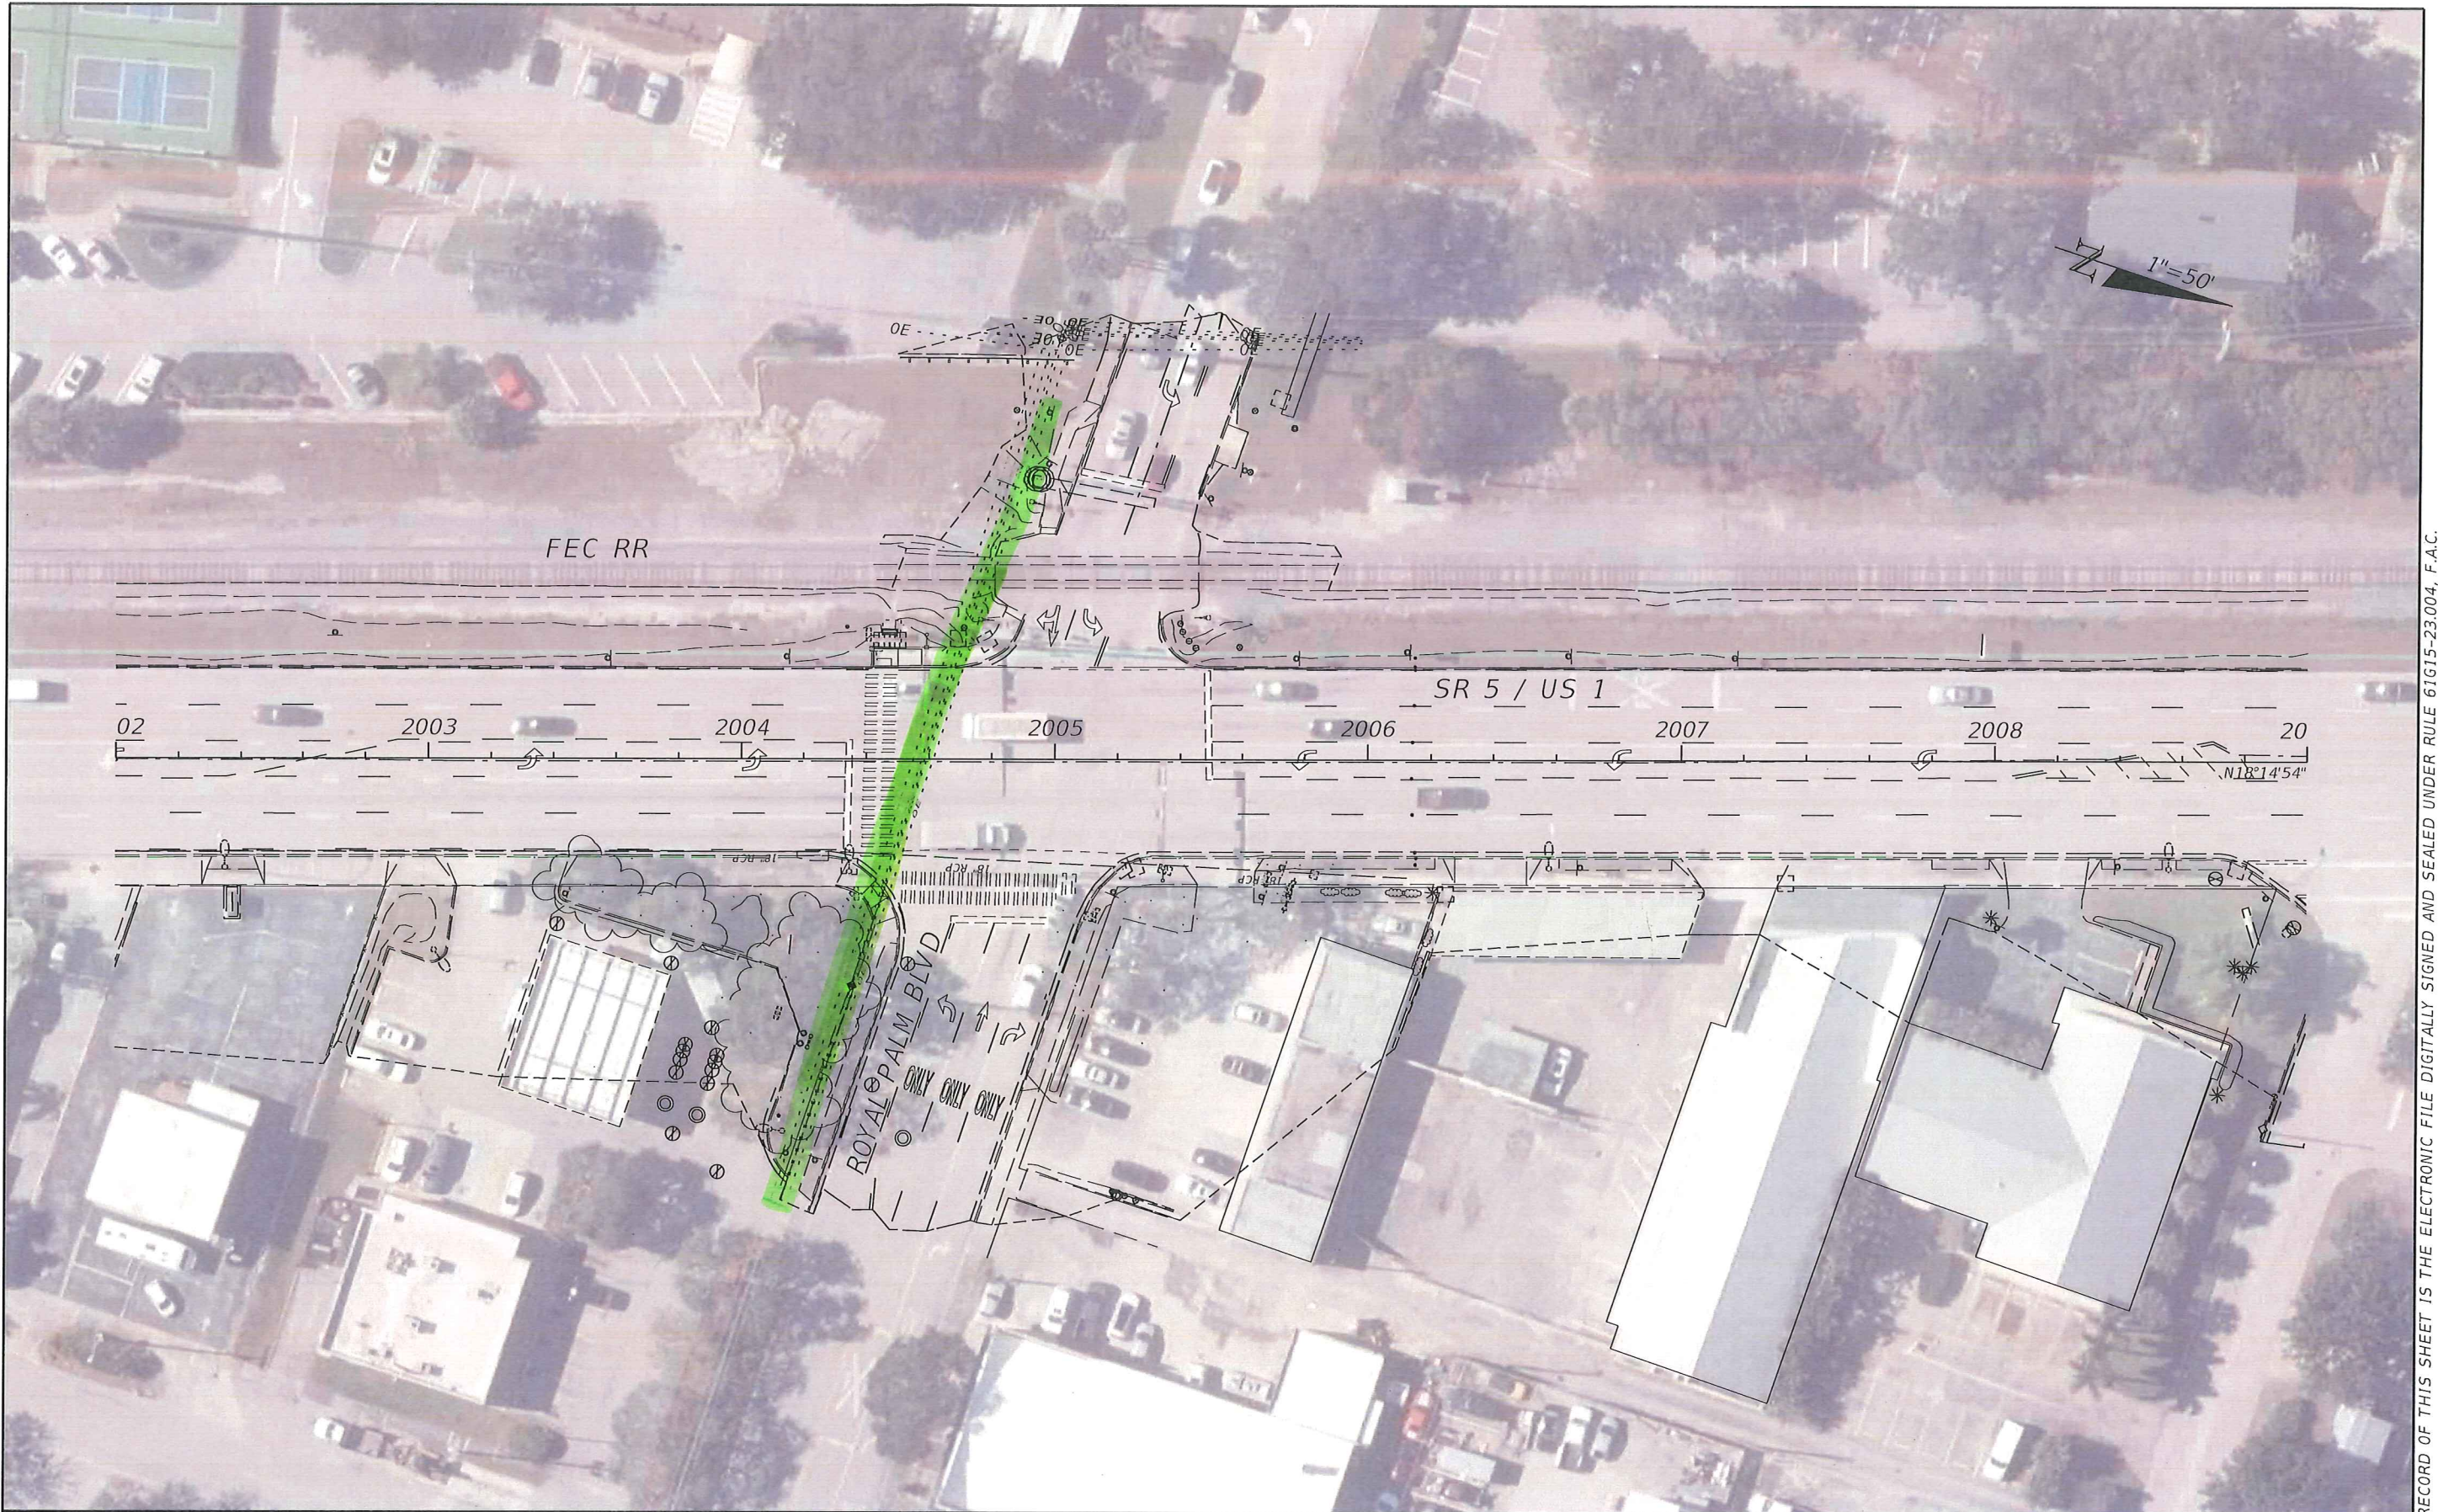

9/15/2022 10:59:58 AM jacquelyn.Arreaga  
 c:\networking\wg\jacquelyn.arreaga\d2198192\_PLA\RD01.dgn

REVISIONS		PROFESSIONAL TYPE		STATE OF FLORIDA DEPARTMENT OF TRANSPORTATION			UTILITY CONTACT PLAN (2)	SHEET NO.  2
DATE	DESCRIPTION	DATE	DESCRIPTION	ROAD NO.	COUNTY	FINANCIAL PROJECT ID		
				SR 5	INDIAN RIVER	441693-1-22-02		

THE OFFICIAL RECORD OF THIS SHEET IS THE ELECTRONIC FILE DIGITALLY SIGNED AND SEALED UNDER RULE 61G15-23.004, F.A.C.

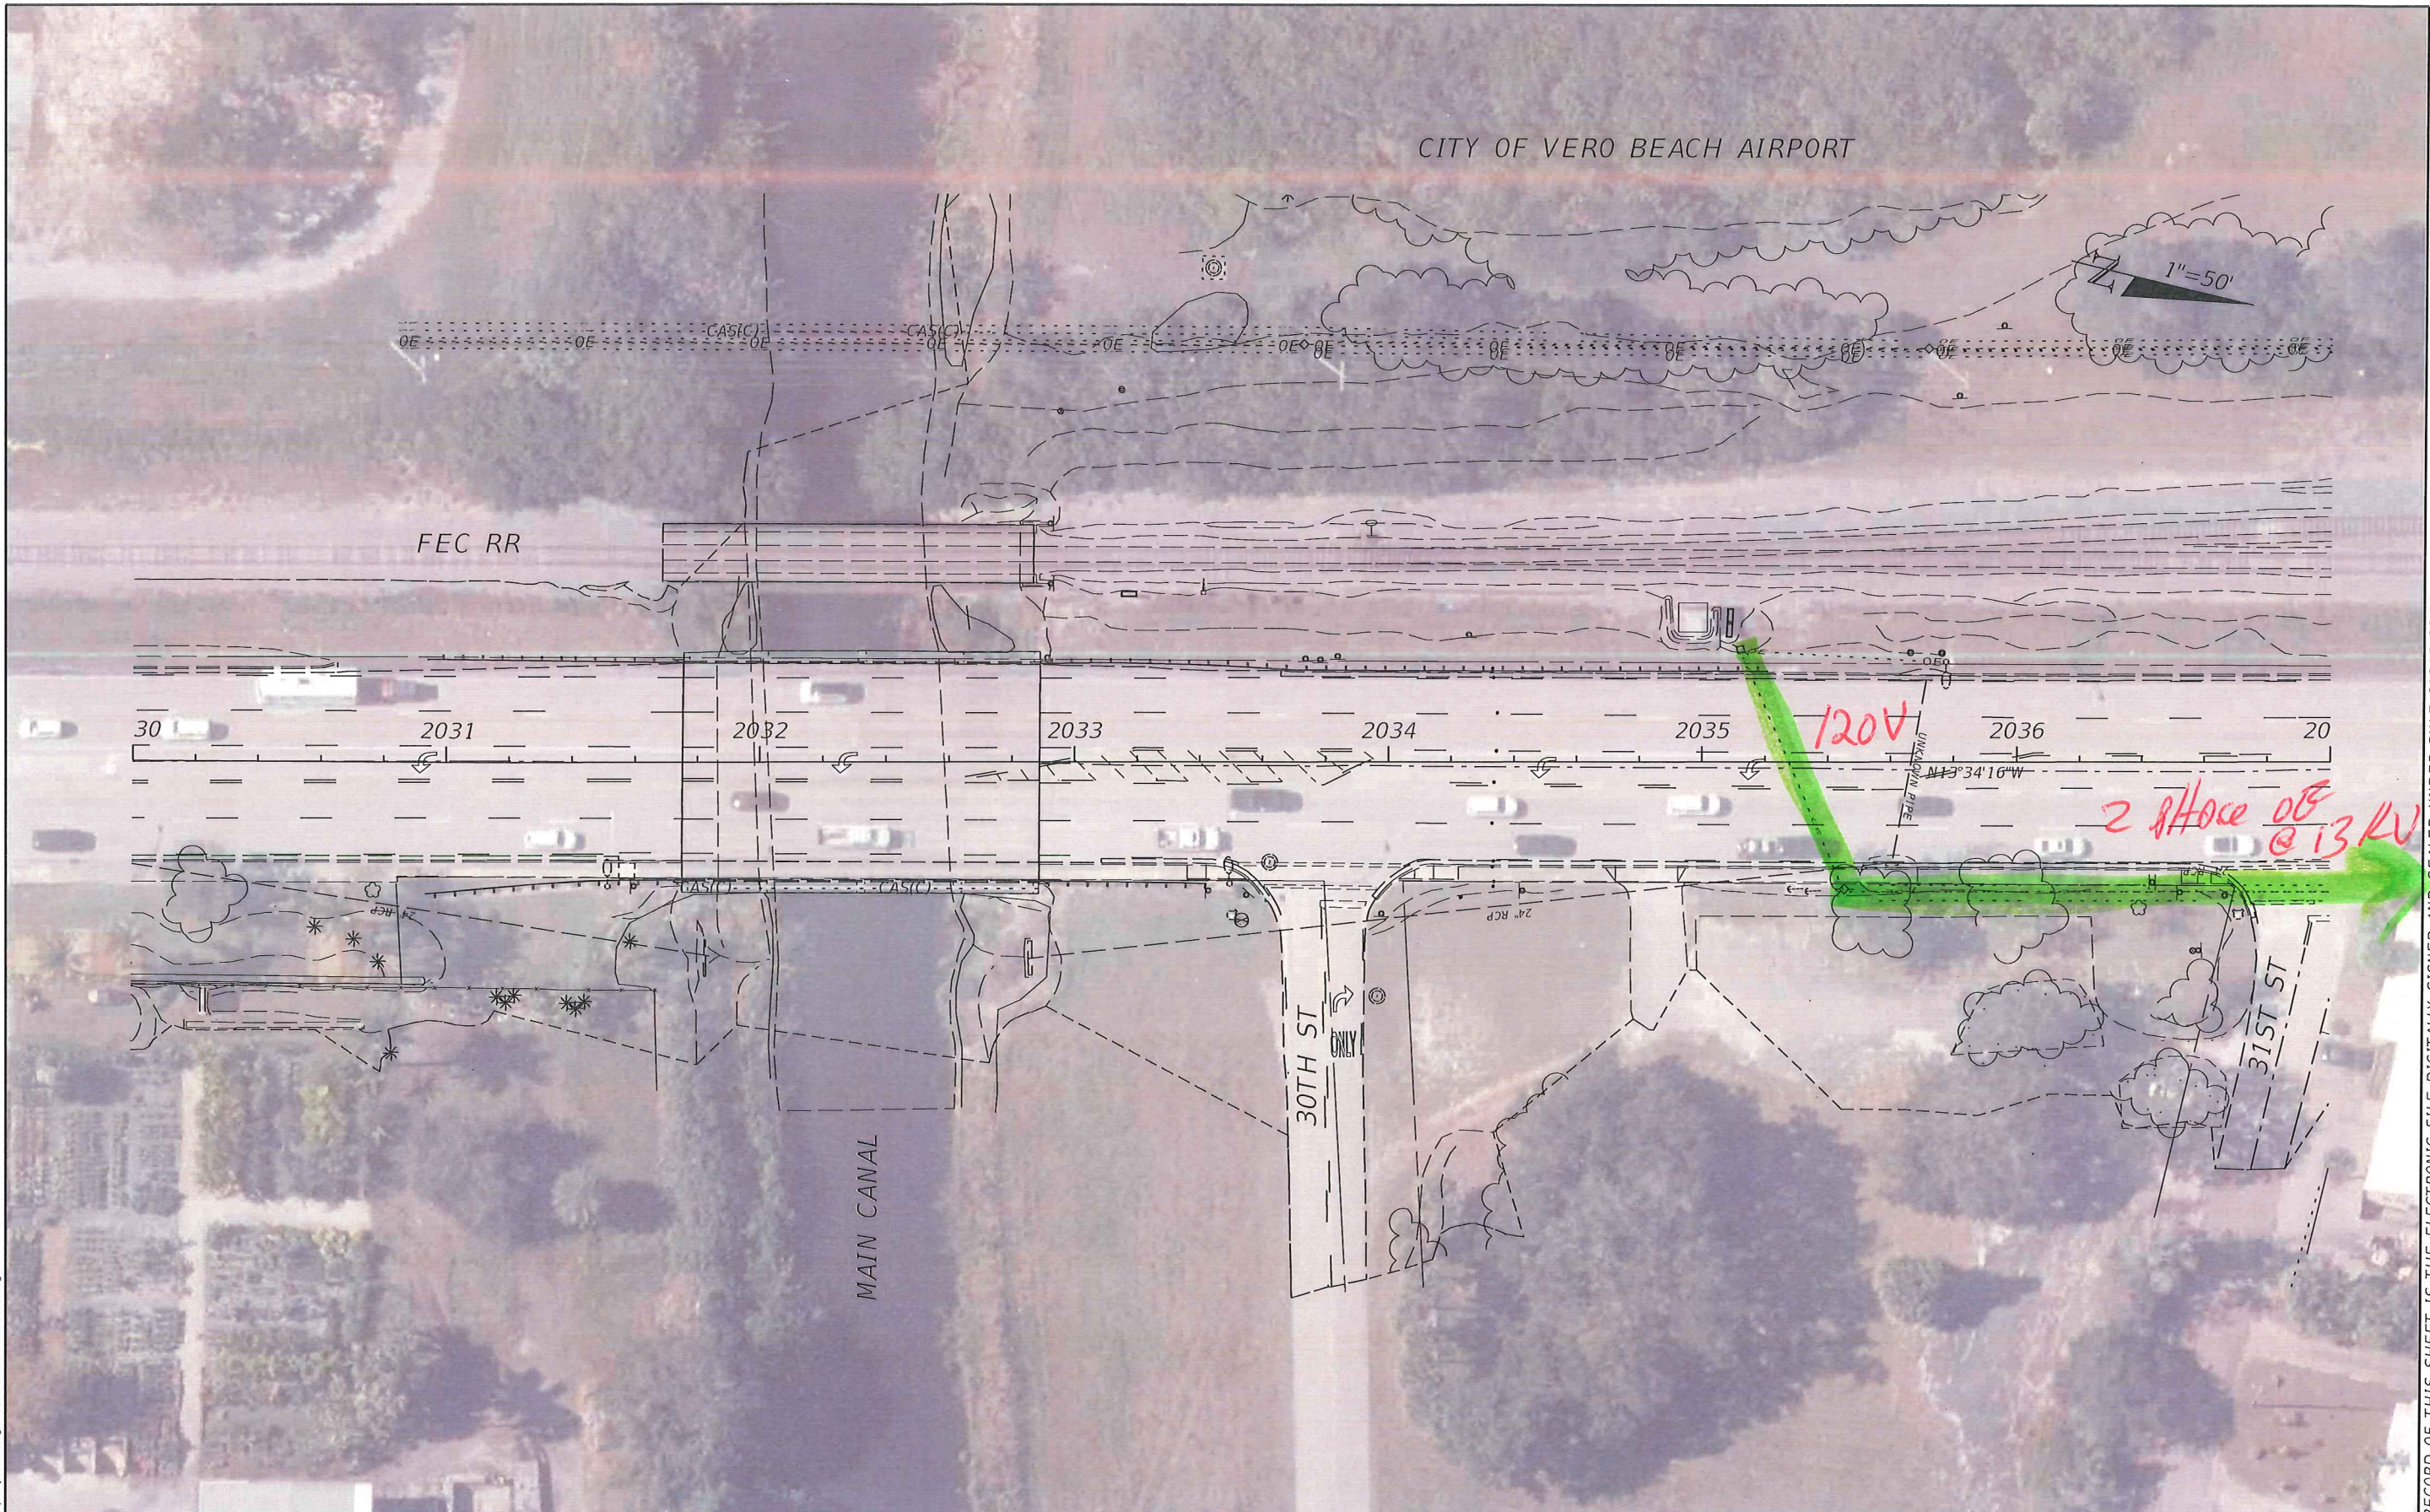

9/15/2022 11:01:04 AM Jacquelyn.Arreaga  
 c:\pwworking\wgi\jacquelyn.arreaga\d2198192\PLANRD01.dgn

REVISIONS		PROFESSIONAL TYPE		STATE OF FLORIDA DEPARTMENT OF TRANSPORTATION			SHEET NO.
DATE	DESCRIPTION	DATE	DESCRIPTION	ROAD NO.	COUNTY	FINANCIAL PROJECT ID	
				SR 5	INDIAN RIVER	441693-1-22-02	6

**UTILITY CONTACT PLAN (6)**

THE OFFICIAL RECORD OF THIS SHEET IS THE ELECTRONIC FILE DIGITALLY SIGNED AND SEALED UNDER RULE 61G15-23.004, F.A.C.

9/15/2022 11:01:42 AM Jacquelyn.Arreaga  
 c:\pwworking\wgi\jacquelyn.arreaga\d2198192\FLNRD01.dgn



REVISIONS		PROFESSIONAL TYPE		STATE OF FLORIDA DEPARTMENT OF TRANSPORTATION			SHEET NO.
DATE	DESCRIPTION	DATE	DESCRIPTION	ROAD NO.	COUNTY	FINANCIAL PROJECT ID	
				SR 5	INDIAN RIVER	441693-1-22-02	7

THE OFFICIAL RECORD OF THIS SHEET IS THE ELECTRONIC FILE DIGITALLY SIGNED AND SEALED UNDER RULE 61G15-23.004, F.A.C.

CITY OF VERO BEACH AIRPORT



3 PHASE OH @ 13KV

FEC RR

3 PHASE OB @ 13KV

SR 5 / US 1

N12°57'40"W

44 2045 2046 2047 2048 2049 2050 20


33RD ST

9/15/2022 11:02:24 AM Jacquelyn.Arreaga c:\pwworking\wgi\jacquelyn.arreaga\d2198192\FLNRD01.dgn

THE OFFICIAL RECORD OF THIS SHEET IS THE ELECTRONIC FILE DIGITALLY SIGNED AND SEALED UNDER RULE 61G15-23.004, F.A.C.

REVISIONS				PROFESSIONAL TYPE	STATE OF FLORIDA DEPARTMENT OF TRANSPORTATION			UTILITY CONTACT PLAN (8)	SHEET NO. 8
DATE	DESCRIPTION	DATE	DESCRIPTION		ROAD NO.	COUNTY	FINANCIAL PROJECT ID		
				WILLIAM EVANS LICENSE NUMBER: 45207 WGI, INC. 2035 VISTA PARKWAY WEST PALM BEACH, FL 33411	SR 5	INDIAN RIVER	441693-1-22-02		

CITY OF VERO BEACH AIRPORT

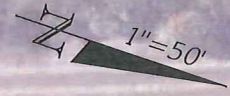

FEC RR

51 2052 2053 2054 2055 2056 2057 20

SR 5 / US 1


*3 Phase @ 13 KV*

9/15/2022 11:02:50 AM Jacquelyn.Arreaga  
c:\pwworking\wgi\jacquelyn.arreaga\d2198192\FLANRD01.dgn

REVISIONS				PROFESSIONAL TYPE	STATE OF FLORIDA DEPARTMENT OF TRANSPORTATION			UTILITY CONTACT PLAN (9)	SHEET NO. 9
DATE	DESCRIPTION	DATE	DESCRIPTION		ROAD NO.	COUNTY	FINANCIAL PROJECT ID		
				WILLIAM EVANS LICENSE NUMBER: 45207 WGI, INC. 2035 VISTA PARKWAY WEST PALM BEACH, FL 33411	SR 5	INDIAN RIVER	441693-1-22-02		

THE OFFICIAL RECORD OF THIS SHEET IS THE ELECTRONIC FILE DIGITALLY SIGNED AND SEALED UNDER RULE 61G15-23.004, F.A.C.

CITY OF VERO BEACH AIRPORT

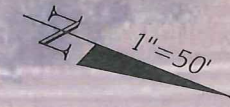

FEC RR

58 2059 2060 2061 2062 2063 2064 20

3 PHASE OE @ 13 KV SR 5 / US 1


PICKERILL LN

9/15/2022 11:03:08 AM Jacquelyn.Arreaga  
c:\pwworking\wgi\jacquelyn.arreaga\2198192\PLANRD01.dgn

REVISIONS		PROFESSIONAL TYPE		STATE OF FLORIDA DEPARTMENT OF TRANSPORTATION			UTILITY CONTACT PLAN (10)	SHEET NO. 10
DATE	DESCRIPTION	DATE	DESCRIPTION	ROAD NO.	COUNTY	FINANCIAL PROJECT ID		
			WILLIAM EVANS LICENSE NUMBER: 45207 WGI, INC. 2035 VISTA PARKWAY WEST PALM BEACH, FL 33411	SR 5	INDIAN RIVER	441693-1-22-02		

THE OFFICIAL RECORD OF THIS SHEET IS THE ELECTRONIC FILE DIGITALLY SIGNED AND SEALED UNDER RULE 61G15-23.004, F.A.C.

CITY OF VERO BEACH AIRPORT

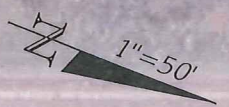


FEC RR

3 PHASE O&E @ 13 KV

SR 5 / US 1

O&E SDPS

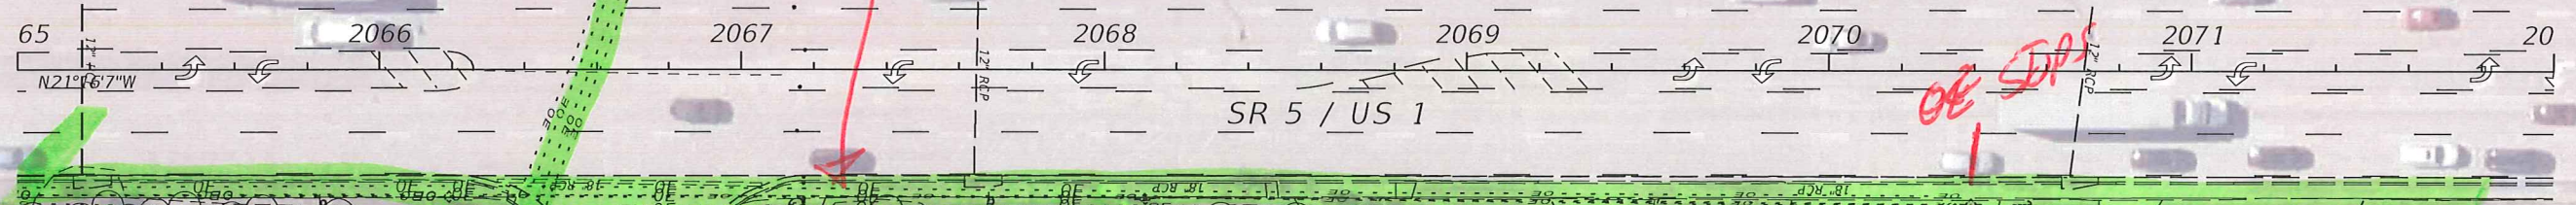



9/15/2022 11:03:42 AM Jacquelyn.Arreaga  
c:\pwworking\wgi\jacquelyn.arreaga\d2198192\PLANRD01.dgn

REVISIONS		PROFESSIONAL TYPE		STATE OF FLORIDA DEPARTMENT OF TRANSPORTATION			UTILITY CONTACT PLAN (11)	SHEET NO. 11
DATE	DESCRIPTION	DATE	DESCRIPTION	ROAD NO.	COUNTY	FINANCIAL PROJECT ID		
				SR 5	INDIAN RIVER	441693-1-22-02		

THE OFFICIAL RECORD OF THIS SHEET IS THE ELECTRONIC FILE DIGITALLY SIGNED AND SEALED UNDER RULE 61G15-23.004, F.A.C.



CITY OF VERO BEACH AIRPORT

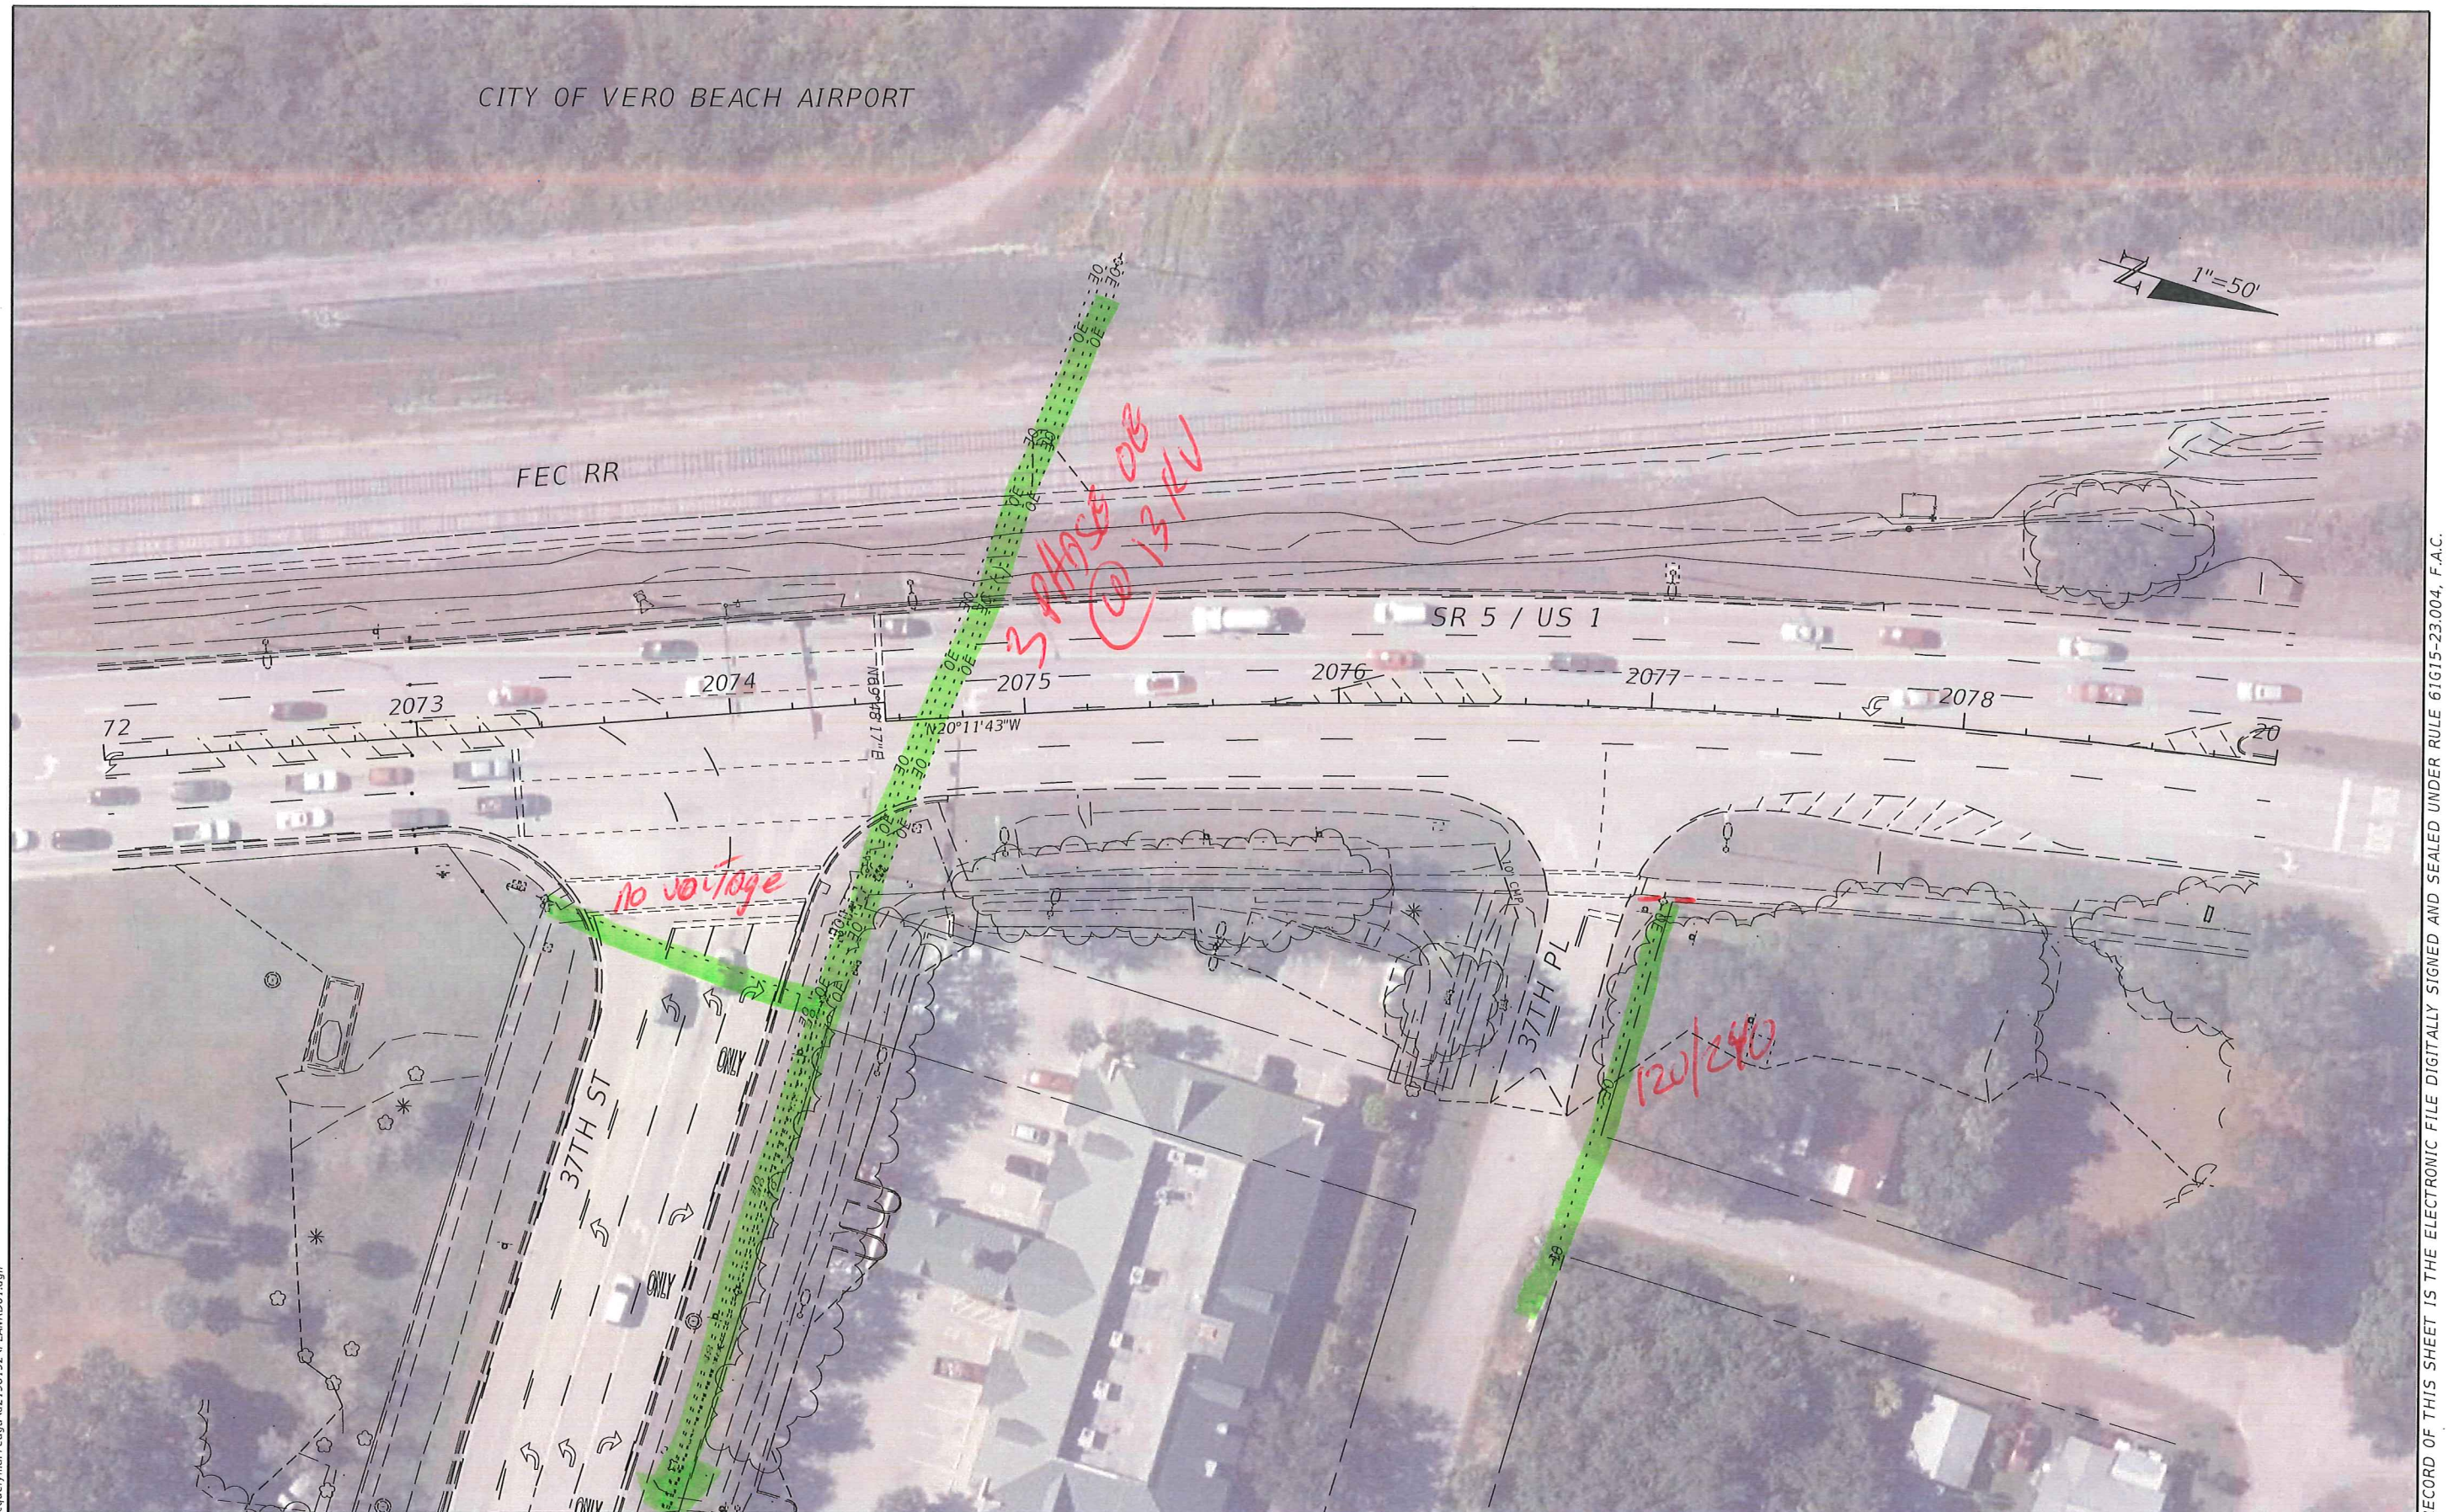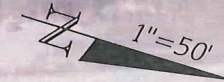


9/15/2022 11:04:09 AM Jacquelyn.Arreaga c:\pwworking\wg\jacquelyn.arreaga\d2198192\PLANRD01.dgn

REVISIONS		PROFESSIONAL TYPE		STATE OF FLORIDA DEPARTMENT OF TRANSPORTATION			UTILITY CONTACT PLAN (12)	SHEET NO. 12
DATE	DESCRIPTION	DATE	DESCRIPTION	ROAD NO.	COUNTY	FINANCIAL PROJECT ID		
			WILLIAM EVANS LICENSE NUMBER: 45207 WGI, INC. 2035 VISTA PARKWAY WEST PALM BEACH, FL 33411	SR 5	INDIAN RIVER	441693-1-22-02		

THE OFFICIAL RECORD OF THIS SHEET IS THE ELECTRONIC FILE DIGITALLY SIGNED AND SEALED UNDER RULE 61G15-23.004, F.A.C.

9/15/2022 11:04:36 AM Jacquelyn.Arreaga  
 c:\pwworking\wgi\jacquelyn.arreaga\d2198192\FLNRD01.dgn

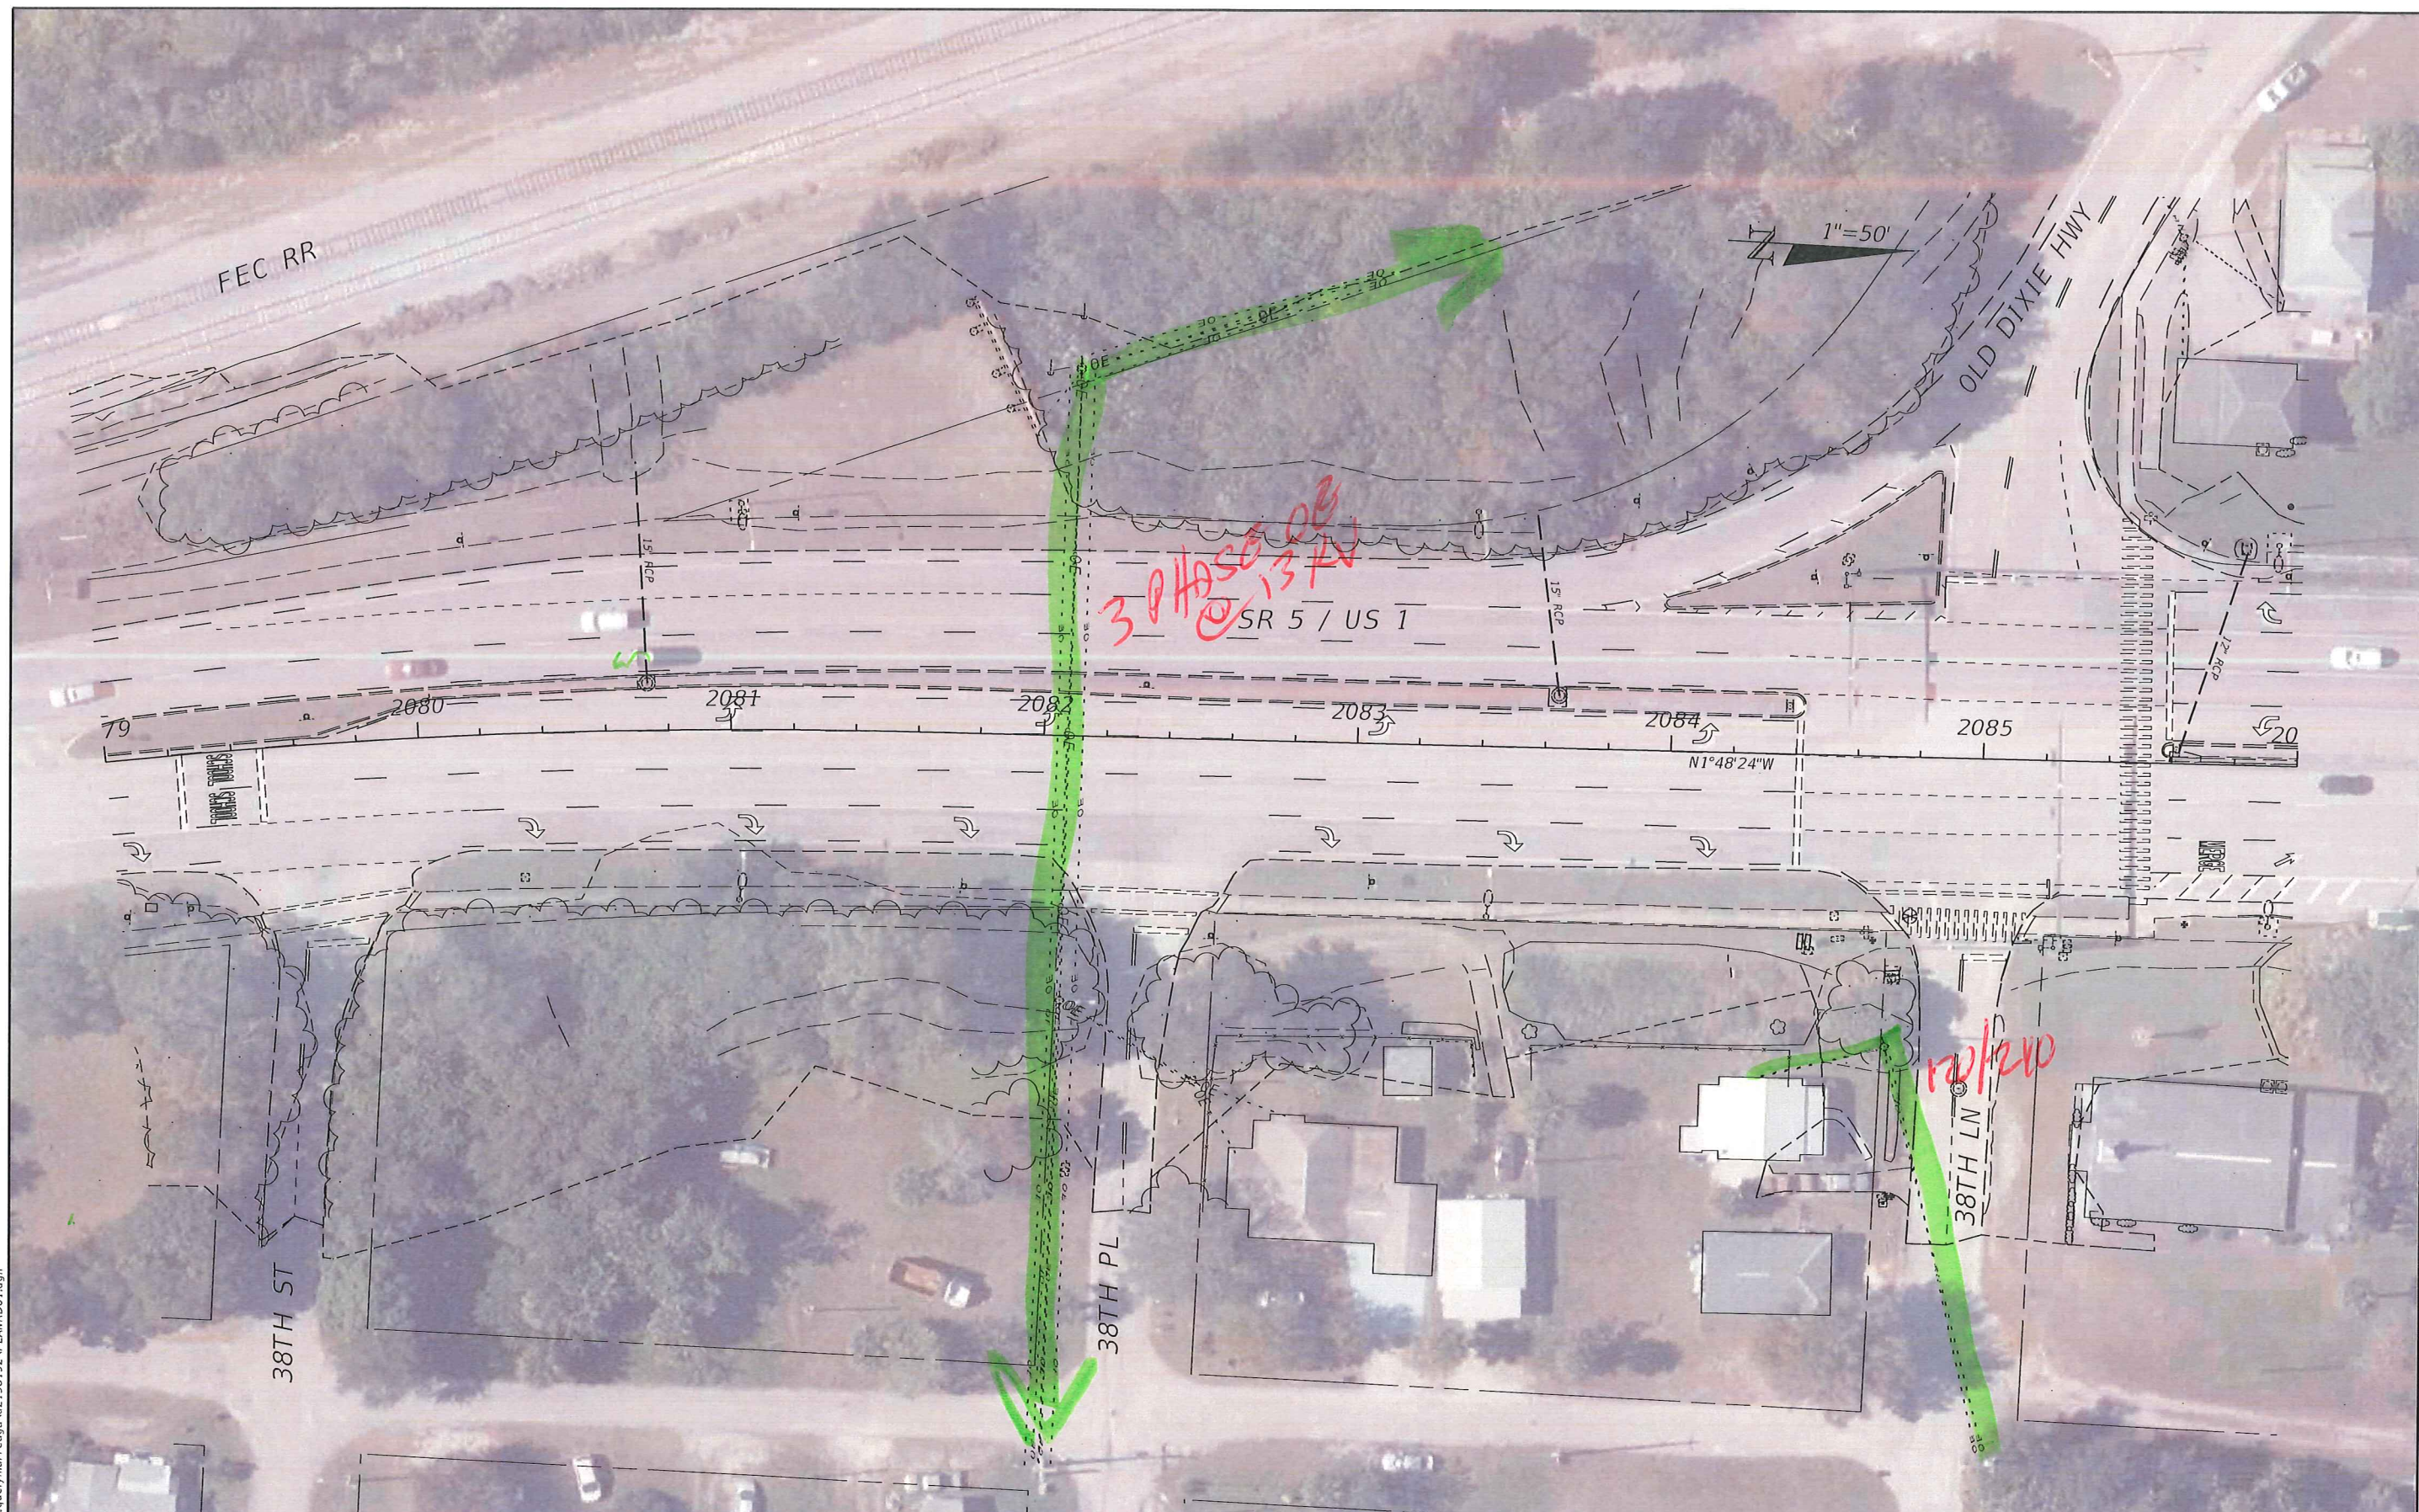


REVISIONS		PROFESSIONAL TYPE		STATE OF FLORIDA DEPARTMENT OF TRANSPORTATION			SHEET NO.
DATE	DESCRIPTION	DATE	DESCRIPTION	ROAD NO.	COUNTY	FINANCIAL PROJECT ID	
				SR 5	INDIAN RIVER	441693-1-22-02	13

UTILITY CONTACT PLAN (13)

THE OFFICIAL RECORD OF THIS SHEET IS THE ELECTRONIC FILE DIGITALLY SIGNED AND SEALED UNDER RULE 61G15-23.004, F.A.C.

SEE SHEET 6

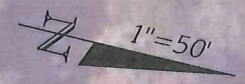

30TH ST

31ST ST

13TH AVE

MAIN CANAL

*OC 3 Phase @ 13KV*


*OC 3 Phase @ 13KV*

9/15/2022 11:06:48 AM Jacquelyn.Arreaga c:\pwworking\wg\Jacquelyn.arreaga\d2198192\PLANRD01.dgn

REVISIONS		PROFESSIONAL TYPE		STATE OF FLORIDA DEPARTMENT OF TRANSPORTATION			UTILITY CONTACT PLAN (17)	SHEET NO.  17
DATE	DESCRIPTION	DATE	DESCRIPTION	ROAD NO.	COUNTY	FINANCIAL PROJECT ID		
				SR 5	INDIAN RIVER	441693-1-22-02		

THE OFFICIAL RECORD OF THIS SHEET IS THE ELECTRONIC FILE DIGITALLY SIGNED AND SEALED UNDER RULE 61G15-23.004, F.A.C.

SEE SHEET 7

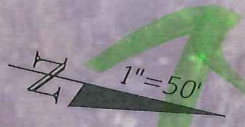

SEE SHEET 17

SEE SHEET 19




9/15/2022 11:07:02 AM Jacquelyn.Arreaga  
c:\pwworking\wg\Jacquelyn.arreaga\d2198192\PLANRD01.dgn

REVISIONS		PROFESSIONAL TYPE		STATE OF FLORIDA DEPARTMENT OF TRANSPORTATION			SHEET NO.
DATE	DESCRIPTION	DATE	DESCRIPTION	ROAD NO.	COUNTY	FINANCIAL PROJECT ID	
			WILLIAM EVANS LICENSE NUMBER: 45207 WGI, INC. 2035 VISTA PARKWAY WEST PALM BEACH, FL 33411	SR 5	INDIAN RIVER	441693-1-22-02	6

UTILITY CONTACT PLAN (18)

THE OFFICIAL RECORD OF THIS SHEET IS THE ELECTRONIC FILE DIGITALLY SIGNED AND SEALED UNDER RULE 61G15-23.004, F.A.C.

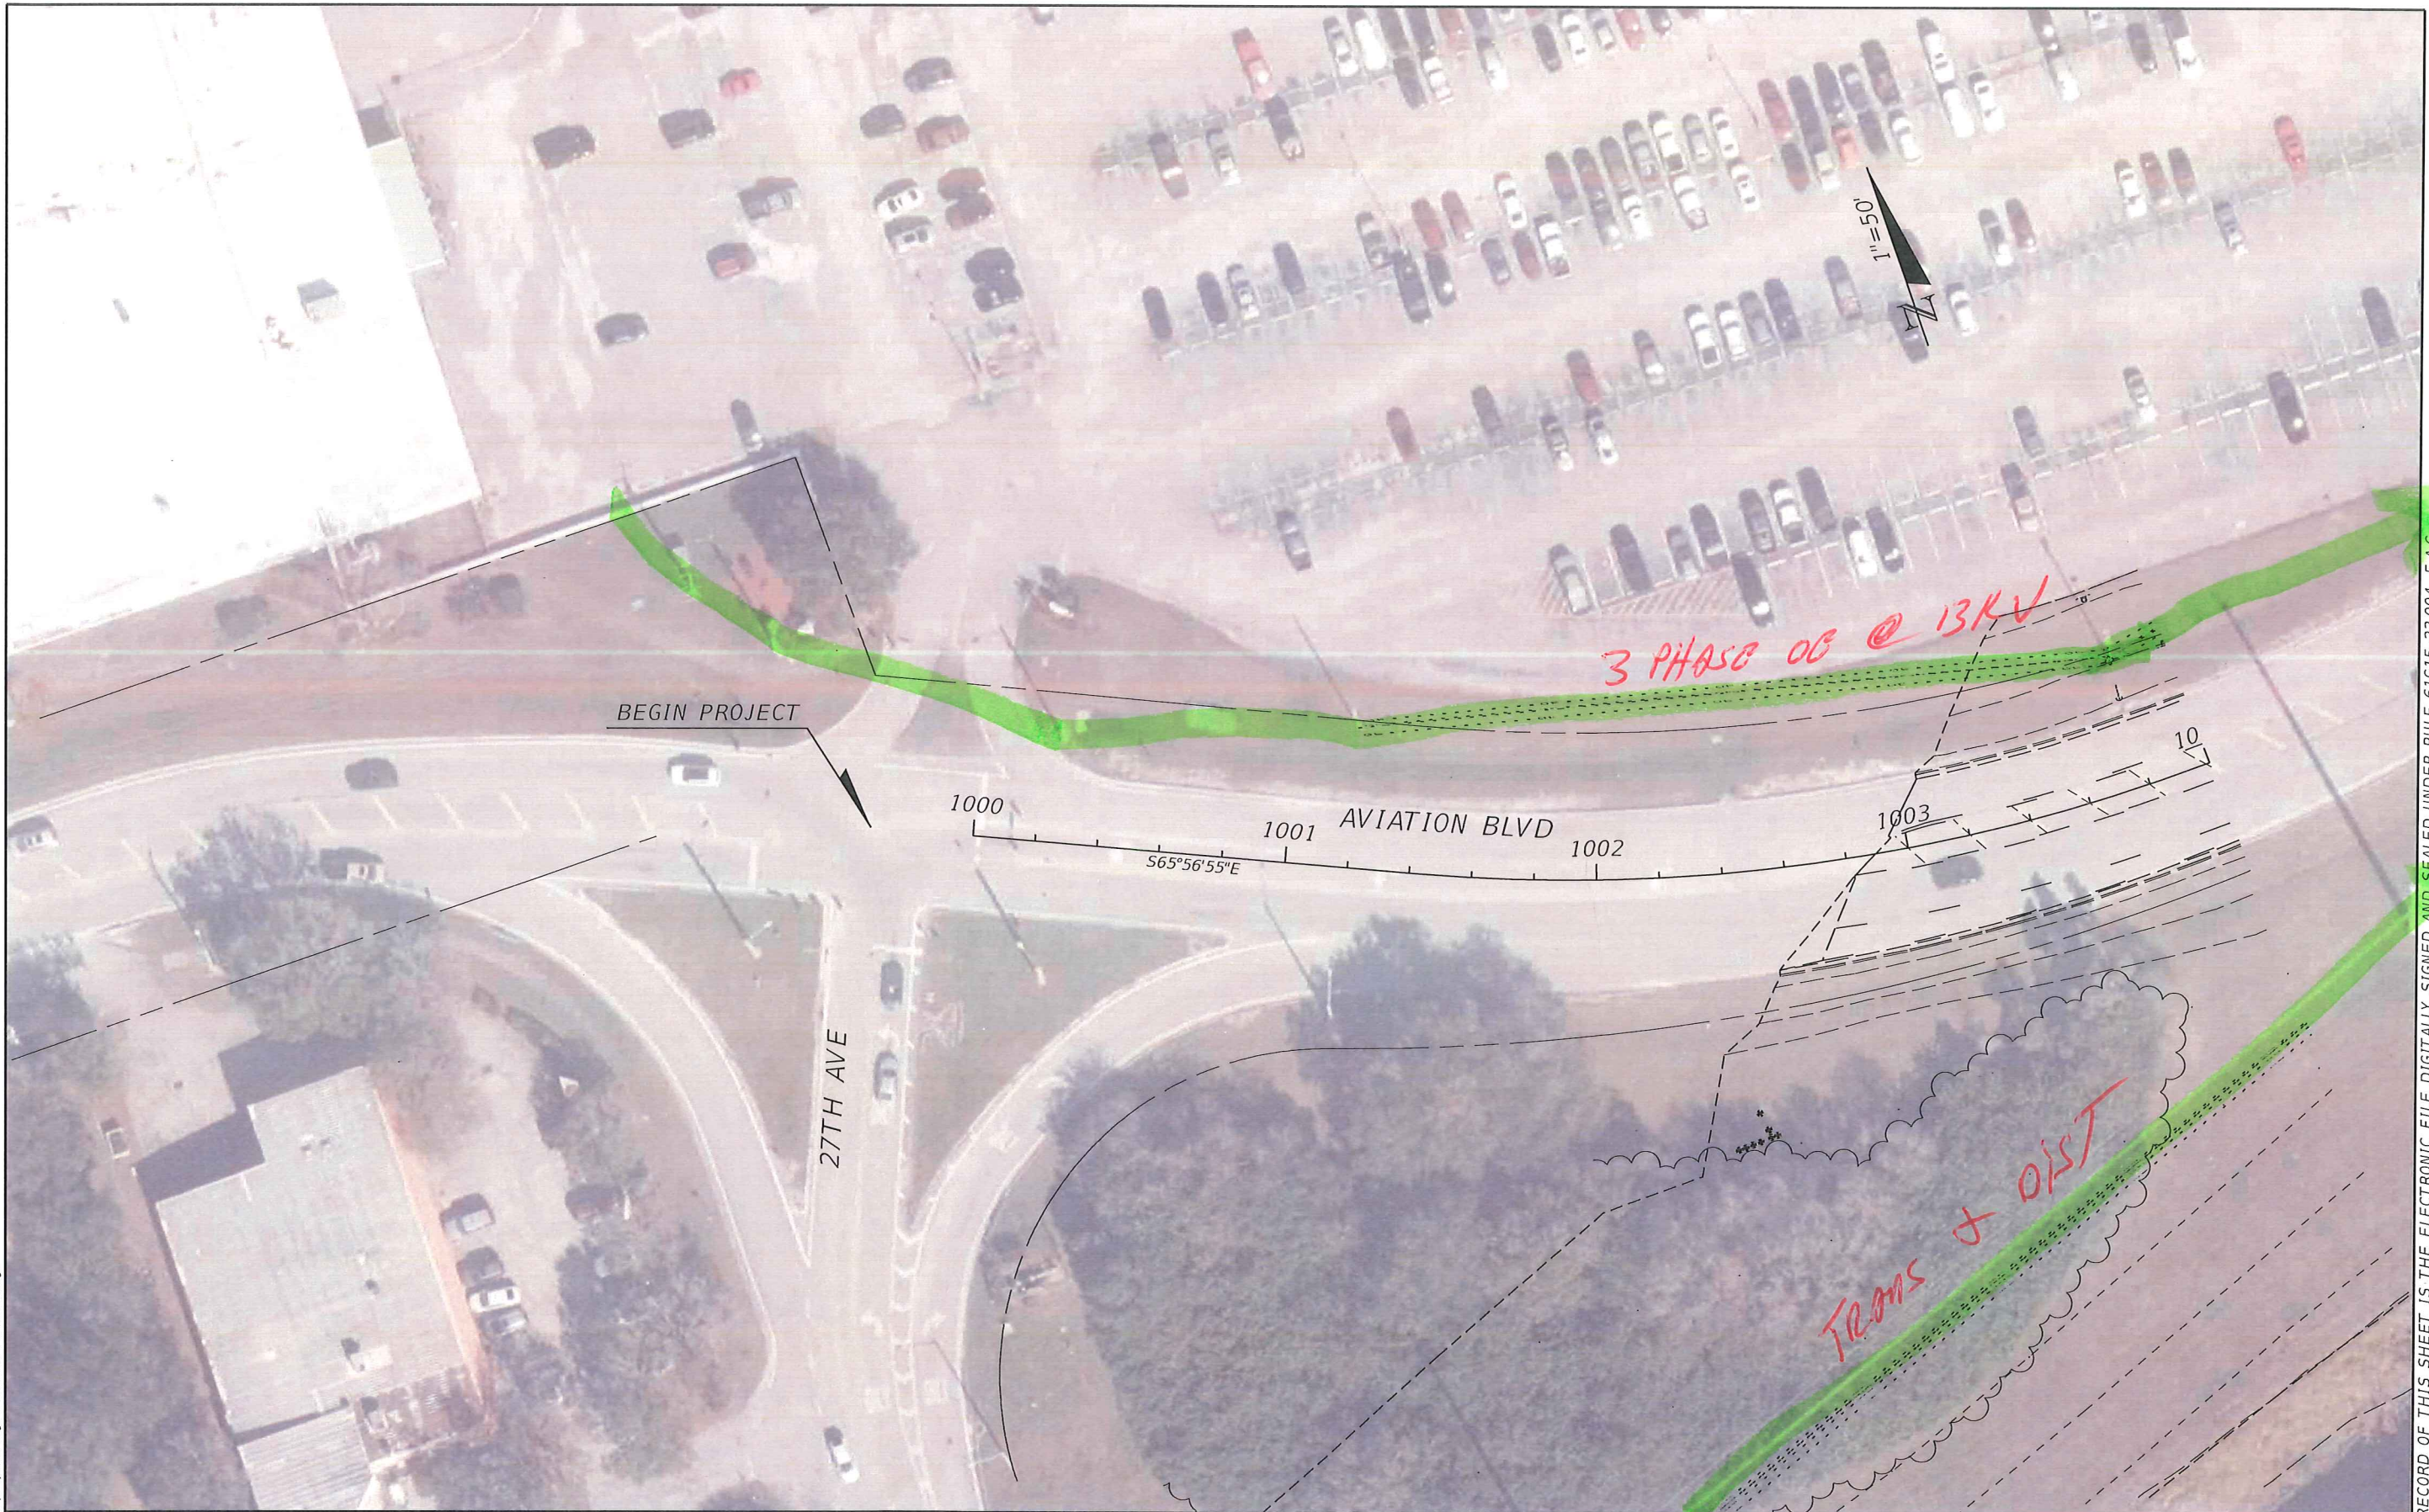

9/15/2022 11:07:56 AM Jacquelyn.Arreaga  
 c:\pwworking\wg\jacquelyn.arreaga\d2198192\PLANR001.dgn

REVISIONS	
DATE	DESCRIPTION


**PROFESSIONAL TYPE**  
 WILLIAM EVANS  
 LICENSE NUMBER: 45207  
 WGI, INC.  
 2035 VISTA PARKWAY  
 WEST PALM BEACH, FL 33411

STATE OF FLORIDA DEPARTMENT OF TRANSPORTATION		
ROAD NO.	COUNTY	FINANCIAL PROJECT ID
SR 5	INDIAN RIVER	441693-1-22-02

**UTILITY CONTACT PLAN (21)**

SHEET NO.
21

THE OFFICIAL RECORD OF THIS SHEET IS THE ELECTRONIC FILE DIGITALLY SIGNED AND SEALED UNDER RULE 61G15-23.004, F.A.C.

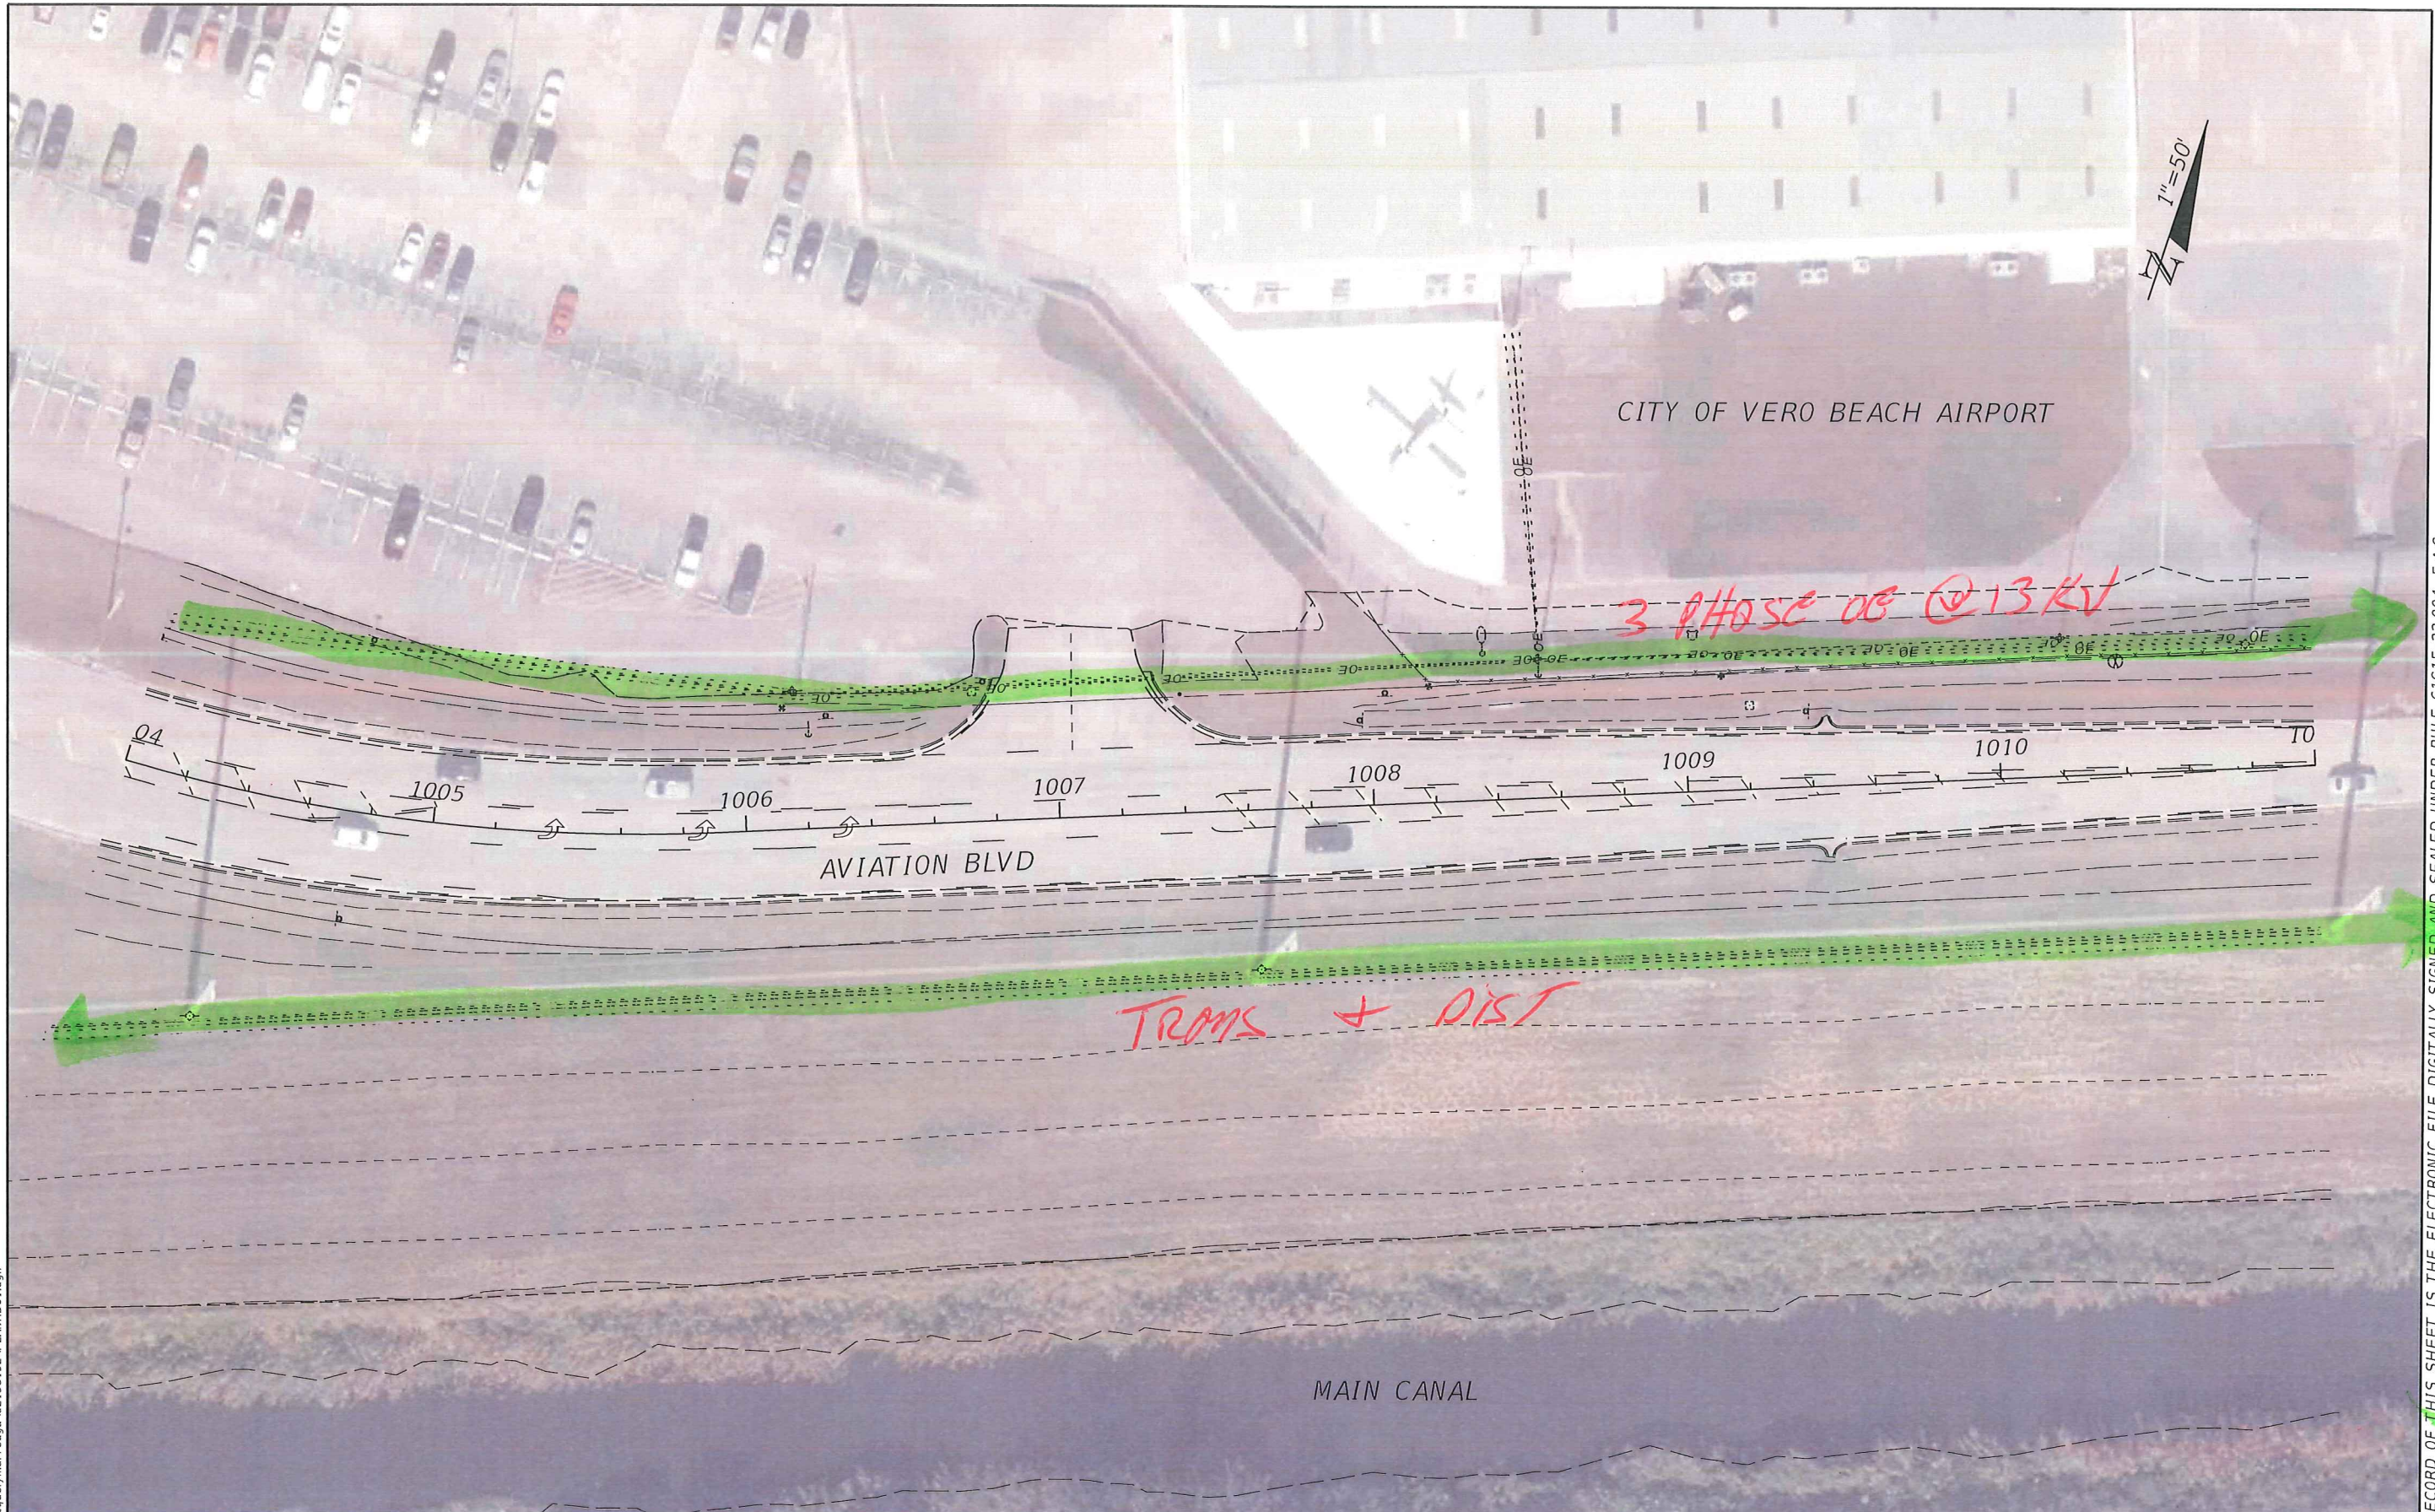

9/15/2022 11:06:27 AM Jacquelyn.Arreaga  
 c:\pwworking\wgi\jacquelyn.arreaga\d2198192\PLANRD01.dgn

REVISIONS		PROFESSIONAL TYPE		STATE OF FLORIDA DEPARTMENT OF TRANSPORTATION			SHEET NO.
DATE	DESCRIPTION	DATE	DESCRIPTION	ROAD NO.	COUNTY	FINANCIAL PROJECT ID	
			WILLIAM EVANS LICENSE NUMBER: 45207 WGI, INC. 2035 VISTA PARKWAY WEST PALM BEACH, FL 33411	SR 5	INDIAN RIVER	441693-1-22-02	22

**UTILITY CONTACT PLAN (22)**

THE OFFICIAL RECORD OF THIS SHEET IS THE ELECTRONIC FILE DIGITALLY SIGNED AND SEALED UNDER RULE 61G15-23.004, F.A.C.

9/15/2022 11:06:39 AM Jacquelyn.Arreaga  
 c:\pwworking\wgi\jacquelyn.arreaga\d2198192\PLANRD01.dgn




REVISIONS		PROFESSIONAL TYPE		STATE OF FLORIDA DEPARTMENT OF TRANSPORTATION			SHEET NO.
DATE	DESCRIPTION	DATE	DESCRIPTION	ROAD NO.	COUNTY	FINANCIAL PROJECT ID	
				SR 5	INDIAN RIVER	441693-1-22-02	23

UTILITY CONTACT PLAN (23)

THE OFFICIAL RECORD OF THIS SHEET IS THE ELECTRONIC FILE DIGITALLY SIGNED AND SEALED UNDER RULE 61G15-23.004, F.A.C.



CITY OF VERO BEACH AIRPORT

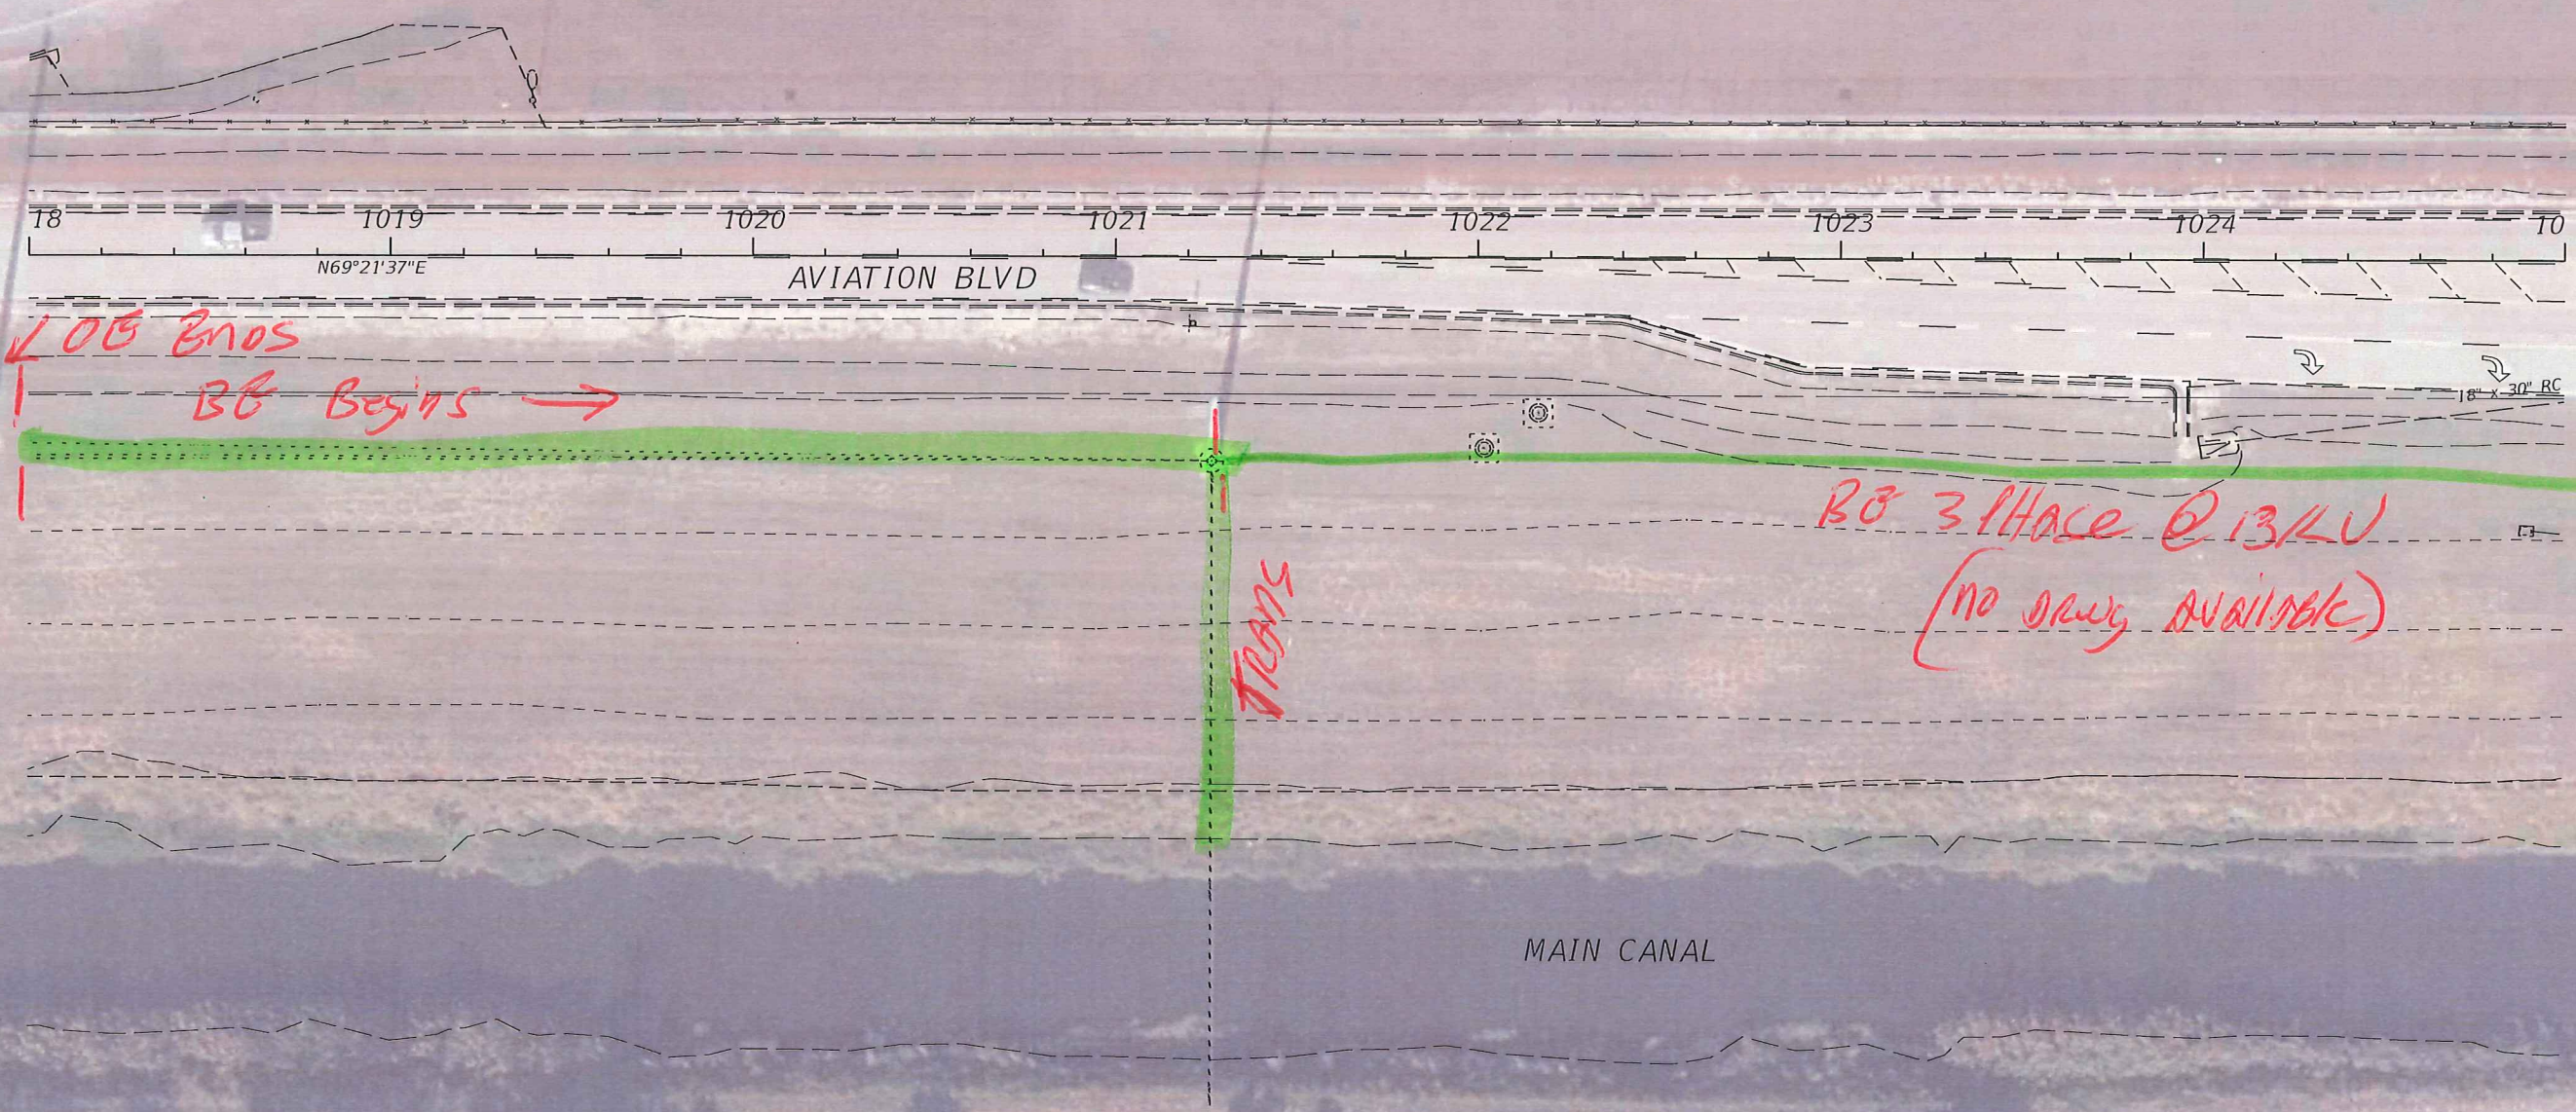


9/15/2022 11:08:55 AM Jacquelyn.Arreaga c:\pwworking\wg\jacquelyn.arreaga\d2198192\PLANRD01.dgn

REVISIONS				PROFESSIONAL TYPE	STATE OF FLORIDA DEPARTMENT OF TRANSPORTATION			UTILITY CONTACT PLAN (24)	SHEET NO.  24
DATE	DESCRIPTION	DATE	DESCRIPTION		ROAD NO.	COUNTY	FINANCIAL PROJECT ID		
				WILLIAM EVANS LICENSE NUMBER: 45207 WGI, INC. 2035 VISTA PARKWAY WEST PALM BEACH, FL 33411	SR 5	INDIAN RIVER	441693-1-22-02		

THE OFFICIAL RECORD OF THIS SHEET IS THE ELECTRONIC FILE DIGITALLY SIGNED AND SEALED UNDER RULE 61G15-23.004, F.A.C.



CITY OF VERO BEACH AIRPORT

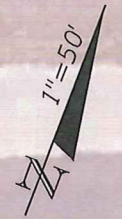

BB 3 PHASE  
@ 13 KV

\*RESTRICTED - NO ACCESS\*

9/15/2022 11:09:17 AM Jacquelyn.Arreaga  
c:\wworking\wg\jacquelyn.arreaga\d2198192\PLANRD01.dgn



REVISIONS		PROFESSIONAL TYPE		STATE OF FLORIDA DEPARTMENT OF TRANSPORTATION			UTILITY CONTACT PLAN (25)	SHEET NO. 25
DATE	DESCRIPTION	DATE	DESCRIPTION	ROAD NO.	COUNTY	FINANCIAL PROJECT ID		
				SR 5	INDIAN RIVER	441693-1-22-02		

WILLIAM EVANS  
LICENSE NUMBER: 45207  
WGI, INC.  
2035 VISTA PARKWAY  
WEST PALM BEACH, FL 33411

THE OFFICIAL RECORD OF THIS SHEET IS THE ELECTRONIC FILE DIGITALLY SIGNED AND SEALED UNDER RULE 61G15-23.004, F.A.C.



CITY OF VERO BEACH AIRPORT

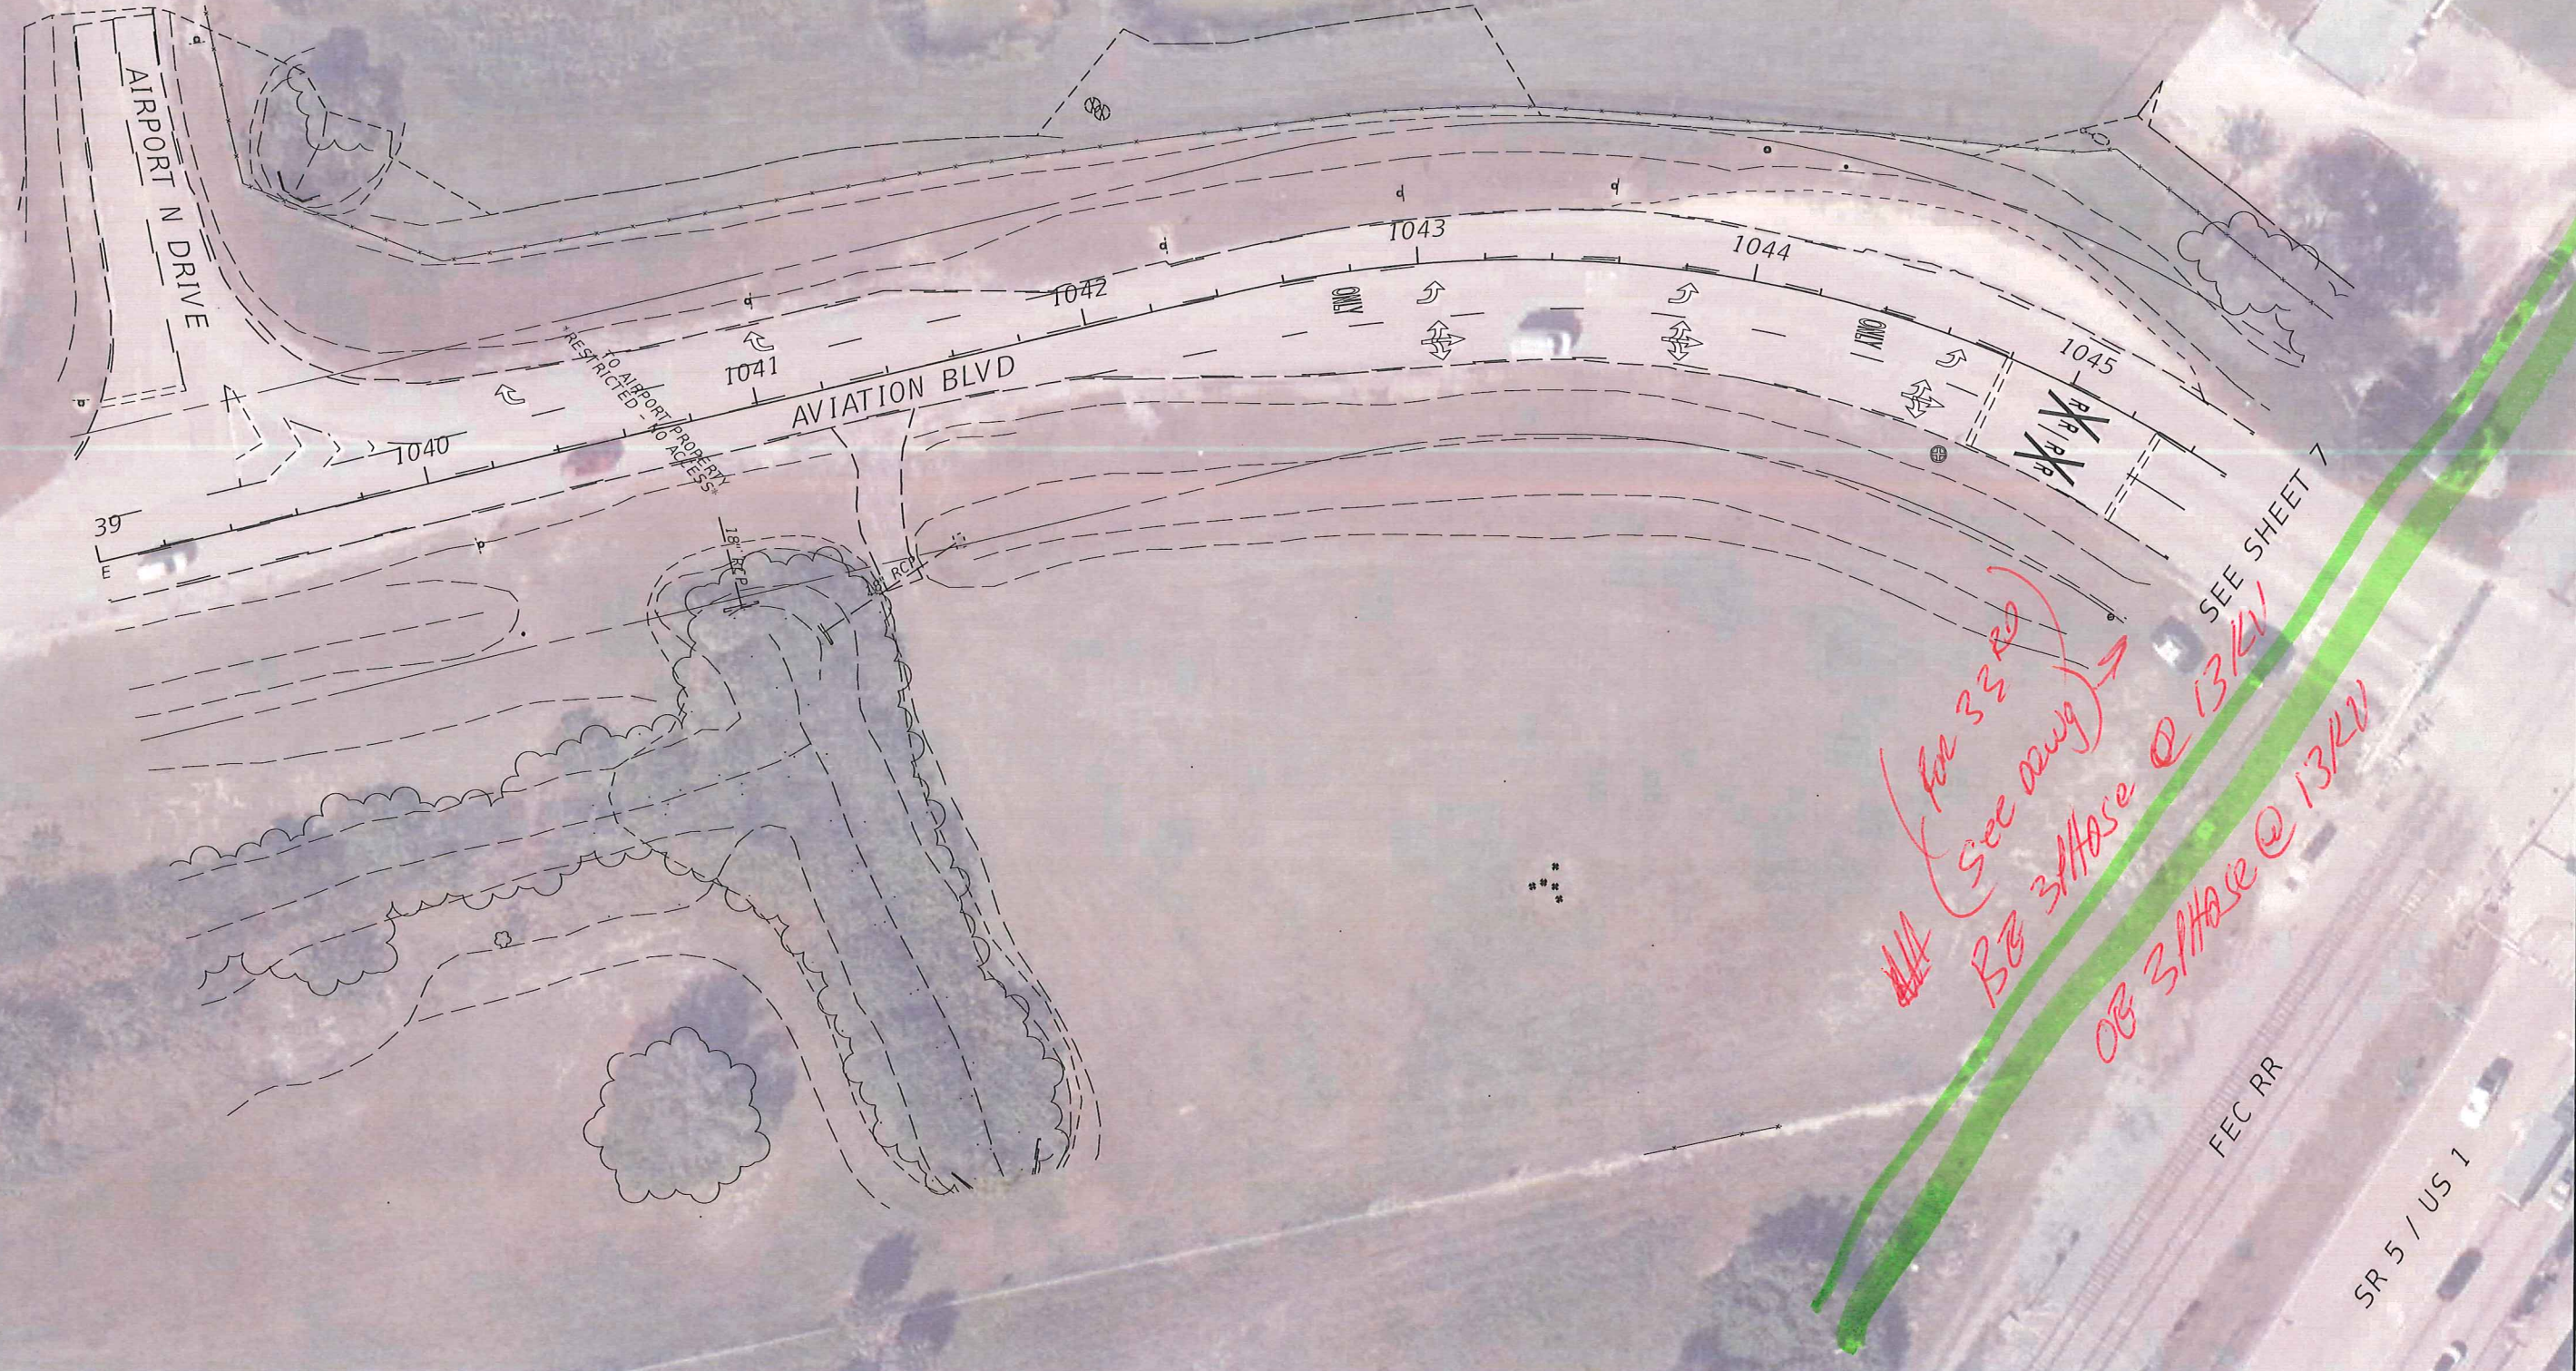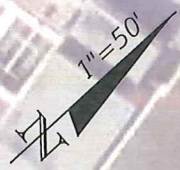

9/15/2022 11:09:43 AM Jacquelyn.Arreaga c:\pwworking\wgi\jacquelyn.arreaga\d2198192\PLANRD01.dgn

REVISIONS		PROFESSIONAL TYPE		STATE OF FLORIDA DEPARTMENT OF TRANSPORTATION			UTILITY CONTACT PLAN (27)	SHEET NO. 27
DATE	DESCRIPTION	DATE	DESCRIPTION	ROAD NO.	COUNTY	FINANCIAL PROJECT ID		
			WILLIAM EVANS LICENSE NUMBER: 45207 WGI, INC. 2035 VISTA PARKWAY WEST PALM BEACH, FL 33411	SR 5	INDIAN RIVER	441693-1-22-02		

THE OFFICIAL RECORD OF THIS SHEET IS THE ELECTRONIC FILE DIGITALLY SIGNED AND SEALED UNDER RULE 61G15-23.004, F.A.C.



FEEDERS: RUNWAY 13736

INACCESSIBLE

13KV

FUTURE 23KV


23KV

SALT SPRAY

ROCK



**MAJOR GRID: 6-5891**  
**NOTE: THESE FACILITIES WERE DESIGNED BY THE CITY OF VERO BEACH AND MAY NOT FOLLOW FPL DESIGN OR EQUIPEMENT STANDARDS**

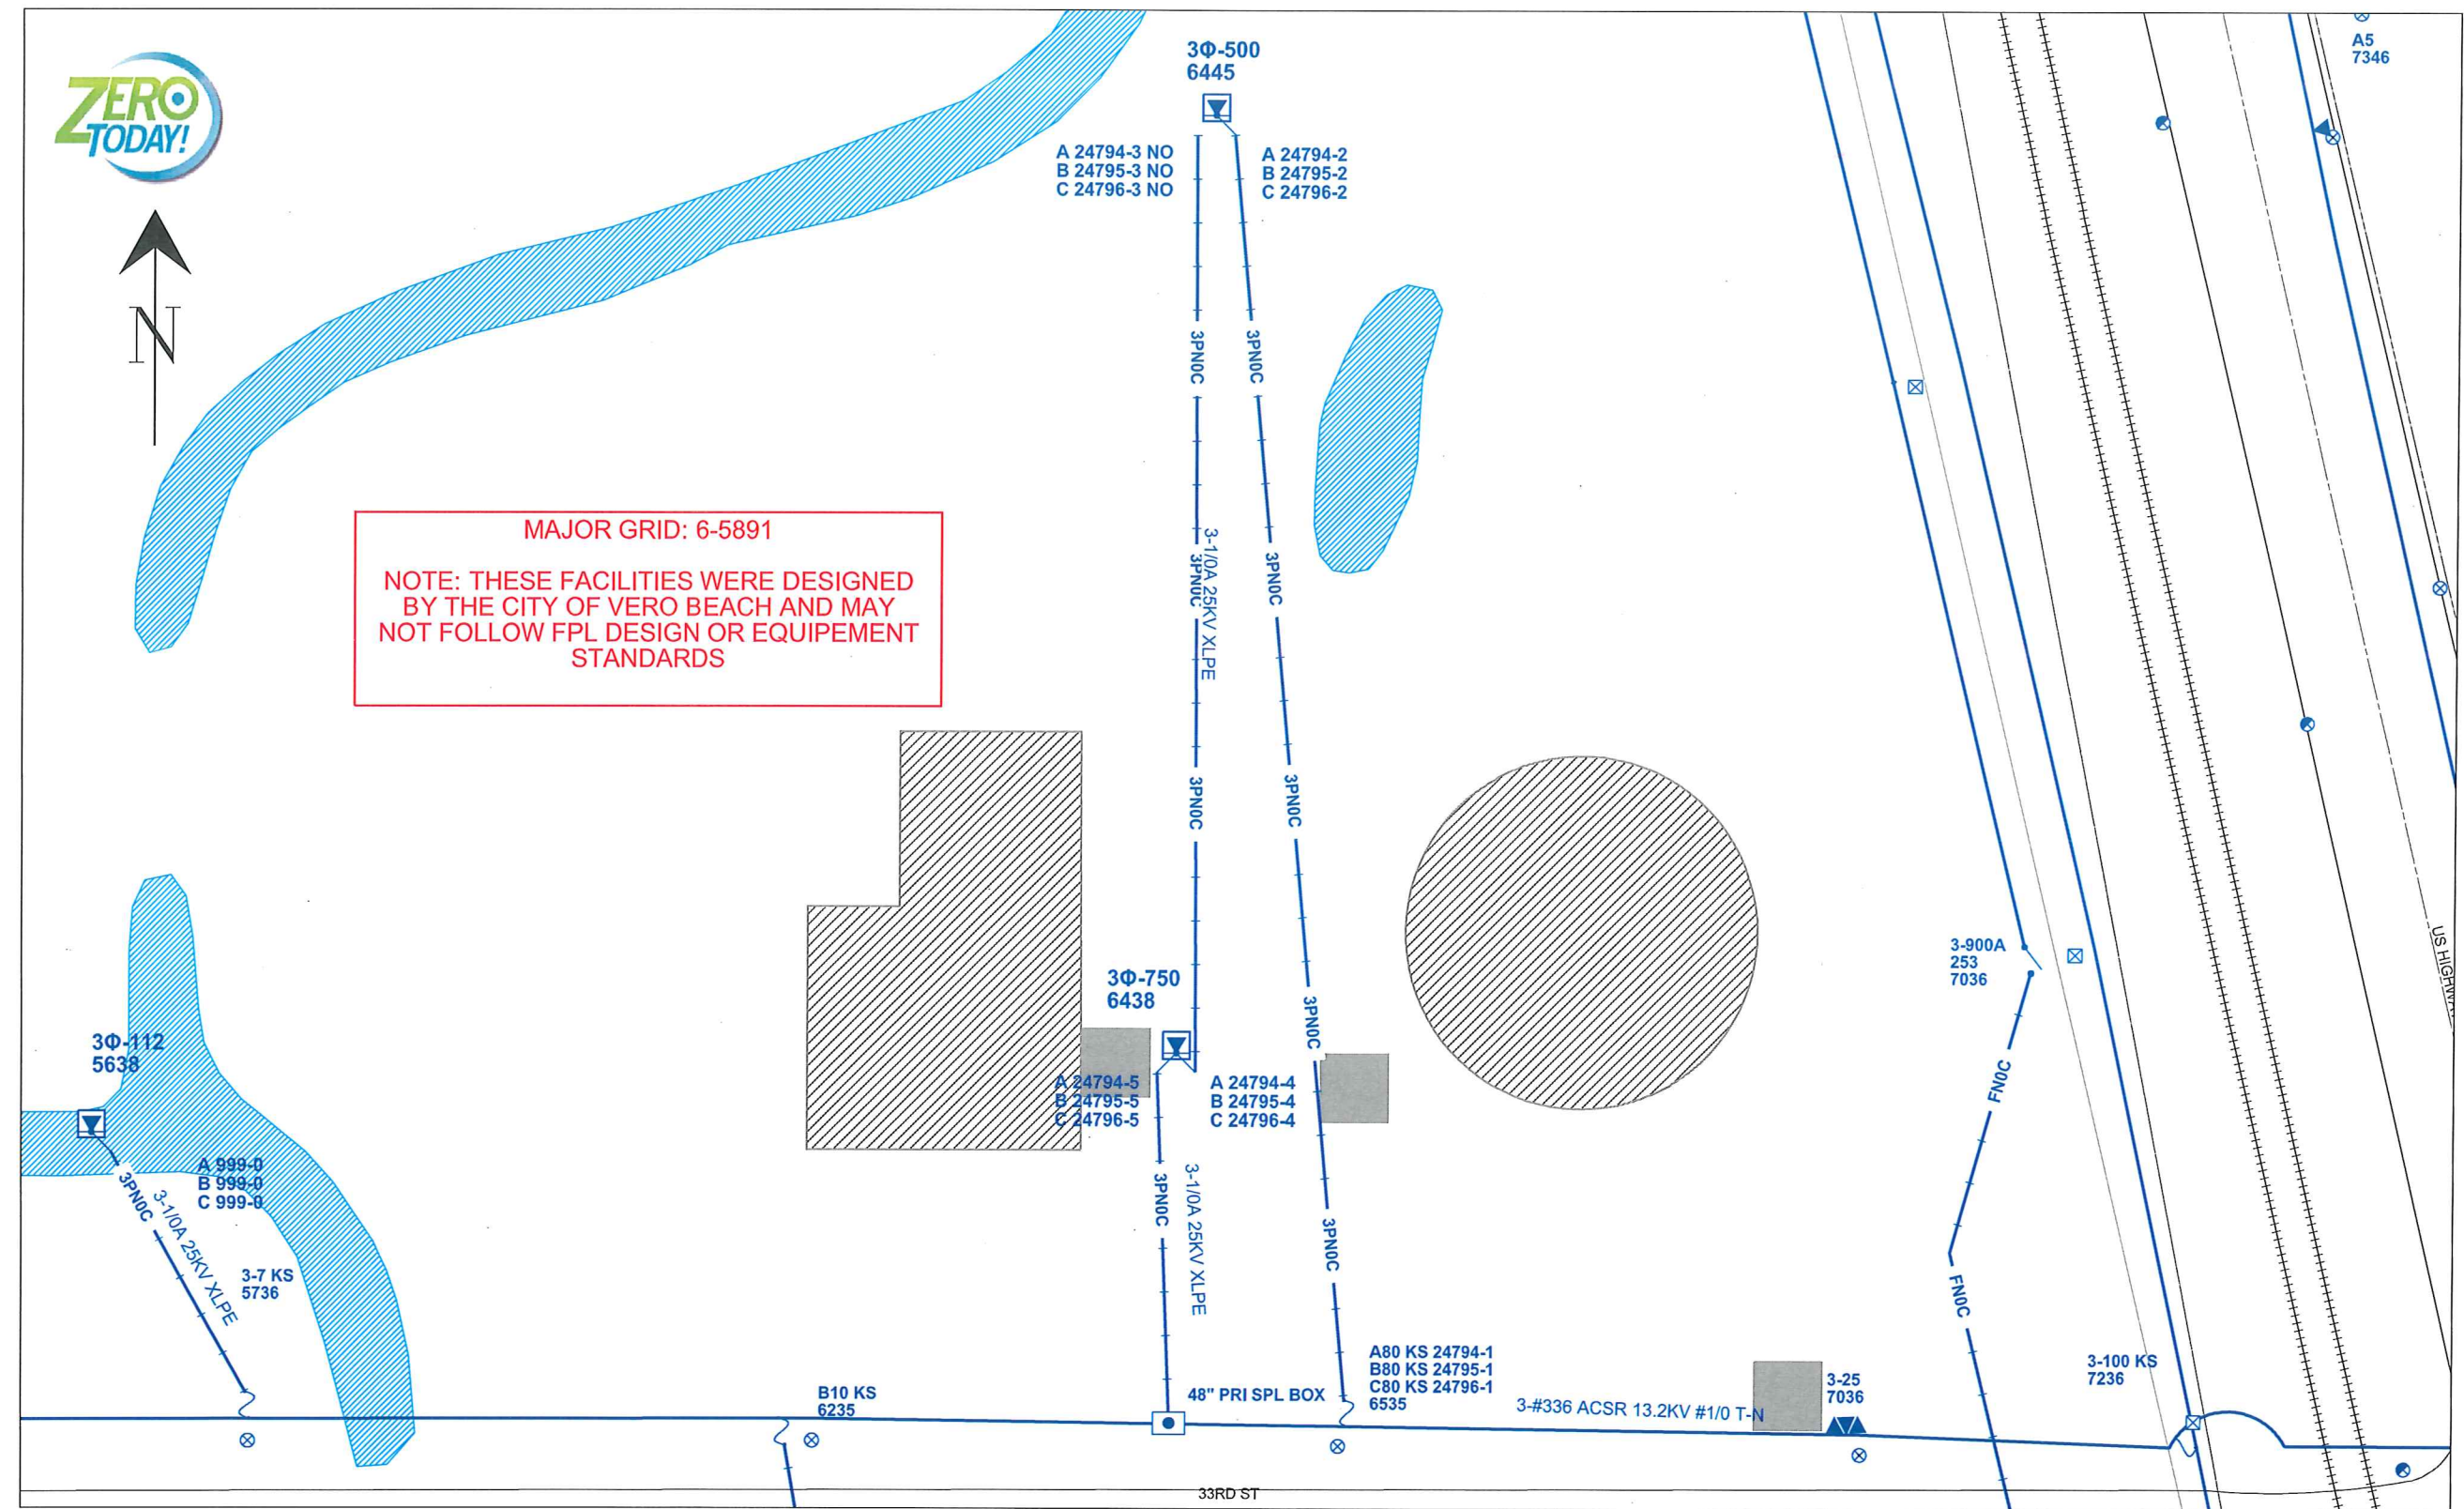

PRINTED BY: jz0065  
 PLOT DATE/TIME: 10/03/2018 08:14:26  
 Size: 18 x 24

4		
3		
2		
1		
IPC	DATE	REVISION

AS-BUILT CREW PRINT		Job CERTIFIED COMPLETED as shown on this AS-BUILT print. Material changes shown on ROS.	
Foreman's Signature	Date	Supervisor's Signature	Date
AS-BUILT COPY		All required ground rods have been driven & verified to be within FPL standards. Values are shown at all locations.	
Initials	Cert. Date	Foreman's Signature	Date


Easement? <input type="checkbox"/>	Tree Work? <input type="checkbox"/>	Tree Access? <input type="checkbox"/>	Tree Staking Req'd? <input type="checkbox"/>
Designer/Stake? <input type="checkbox"/>	CT/Special Mtr? <input type="checkbox"/>	Work with SMO? <input type="checkbox"/>	Survey/Stake? <input type="checkbox"/>
POLE LINE FT:	POLE LINE FT. ON TRANSM. POLES:	TRENCH FT:	DUCT BANK FT:
PERMIT REQ'D	CITY <input type="checkbox"/>	COUNTY RD <input type="checkbox"/>	COUNTY AIR <input type="checkbox"/>
WMD <input type="checkbox"/>	RR XING <input type="checkbox"/>	DR. DIST. <input type="checkbox"/>	STATE RD <input type="checkbox"/>
Requested Tel. Co. Set Poles? <input type="checkbox"/>	Requested Tel. Co. Transfer? <input type="checkbox"/>	Request CATV Transfer? <input type="checkbox"/>	FAA <input type="checkbox"/>
			TRANSM. <input type="checkbox"/>



Job Owner:	M/A:	Township: 32 Range: 39 Section 35
Designer: Jeremy Zahringer	VERO BEACH AIRPORT NORTH	
Date: 10/03/2018	2515 AIRPORT NORTH DR, VERO BEACH, FL 32960	
Original Size: 18 x 24	Dwg No. BB0628R3_COVB UG.xml	Map: BB0628
0' 40' 80'	WR: BB0628R3	Page 2 of 2

**Appendix D**

**FP&L Transmission**

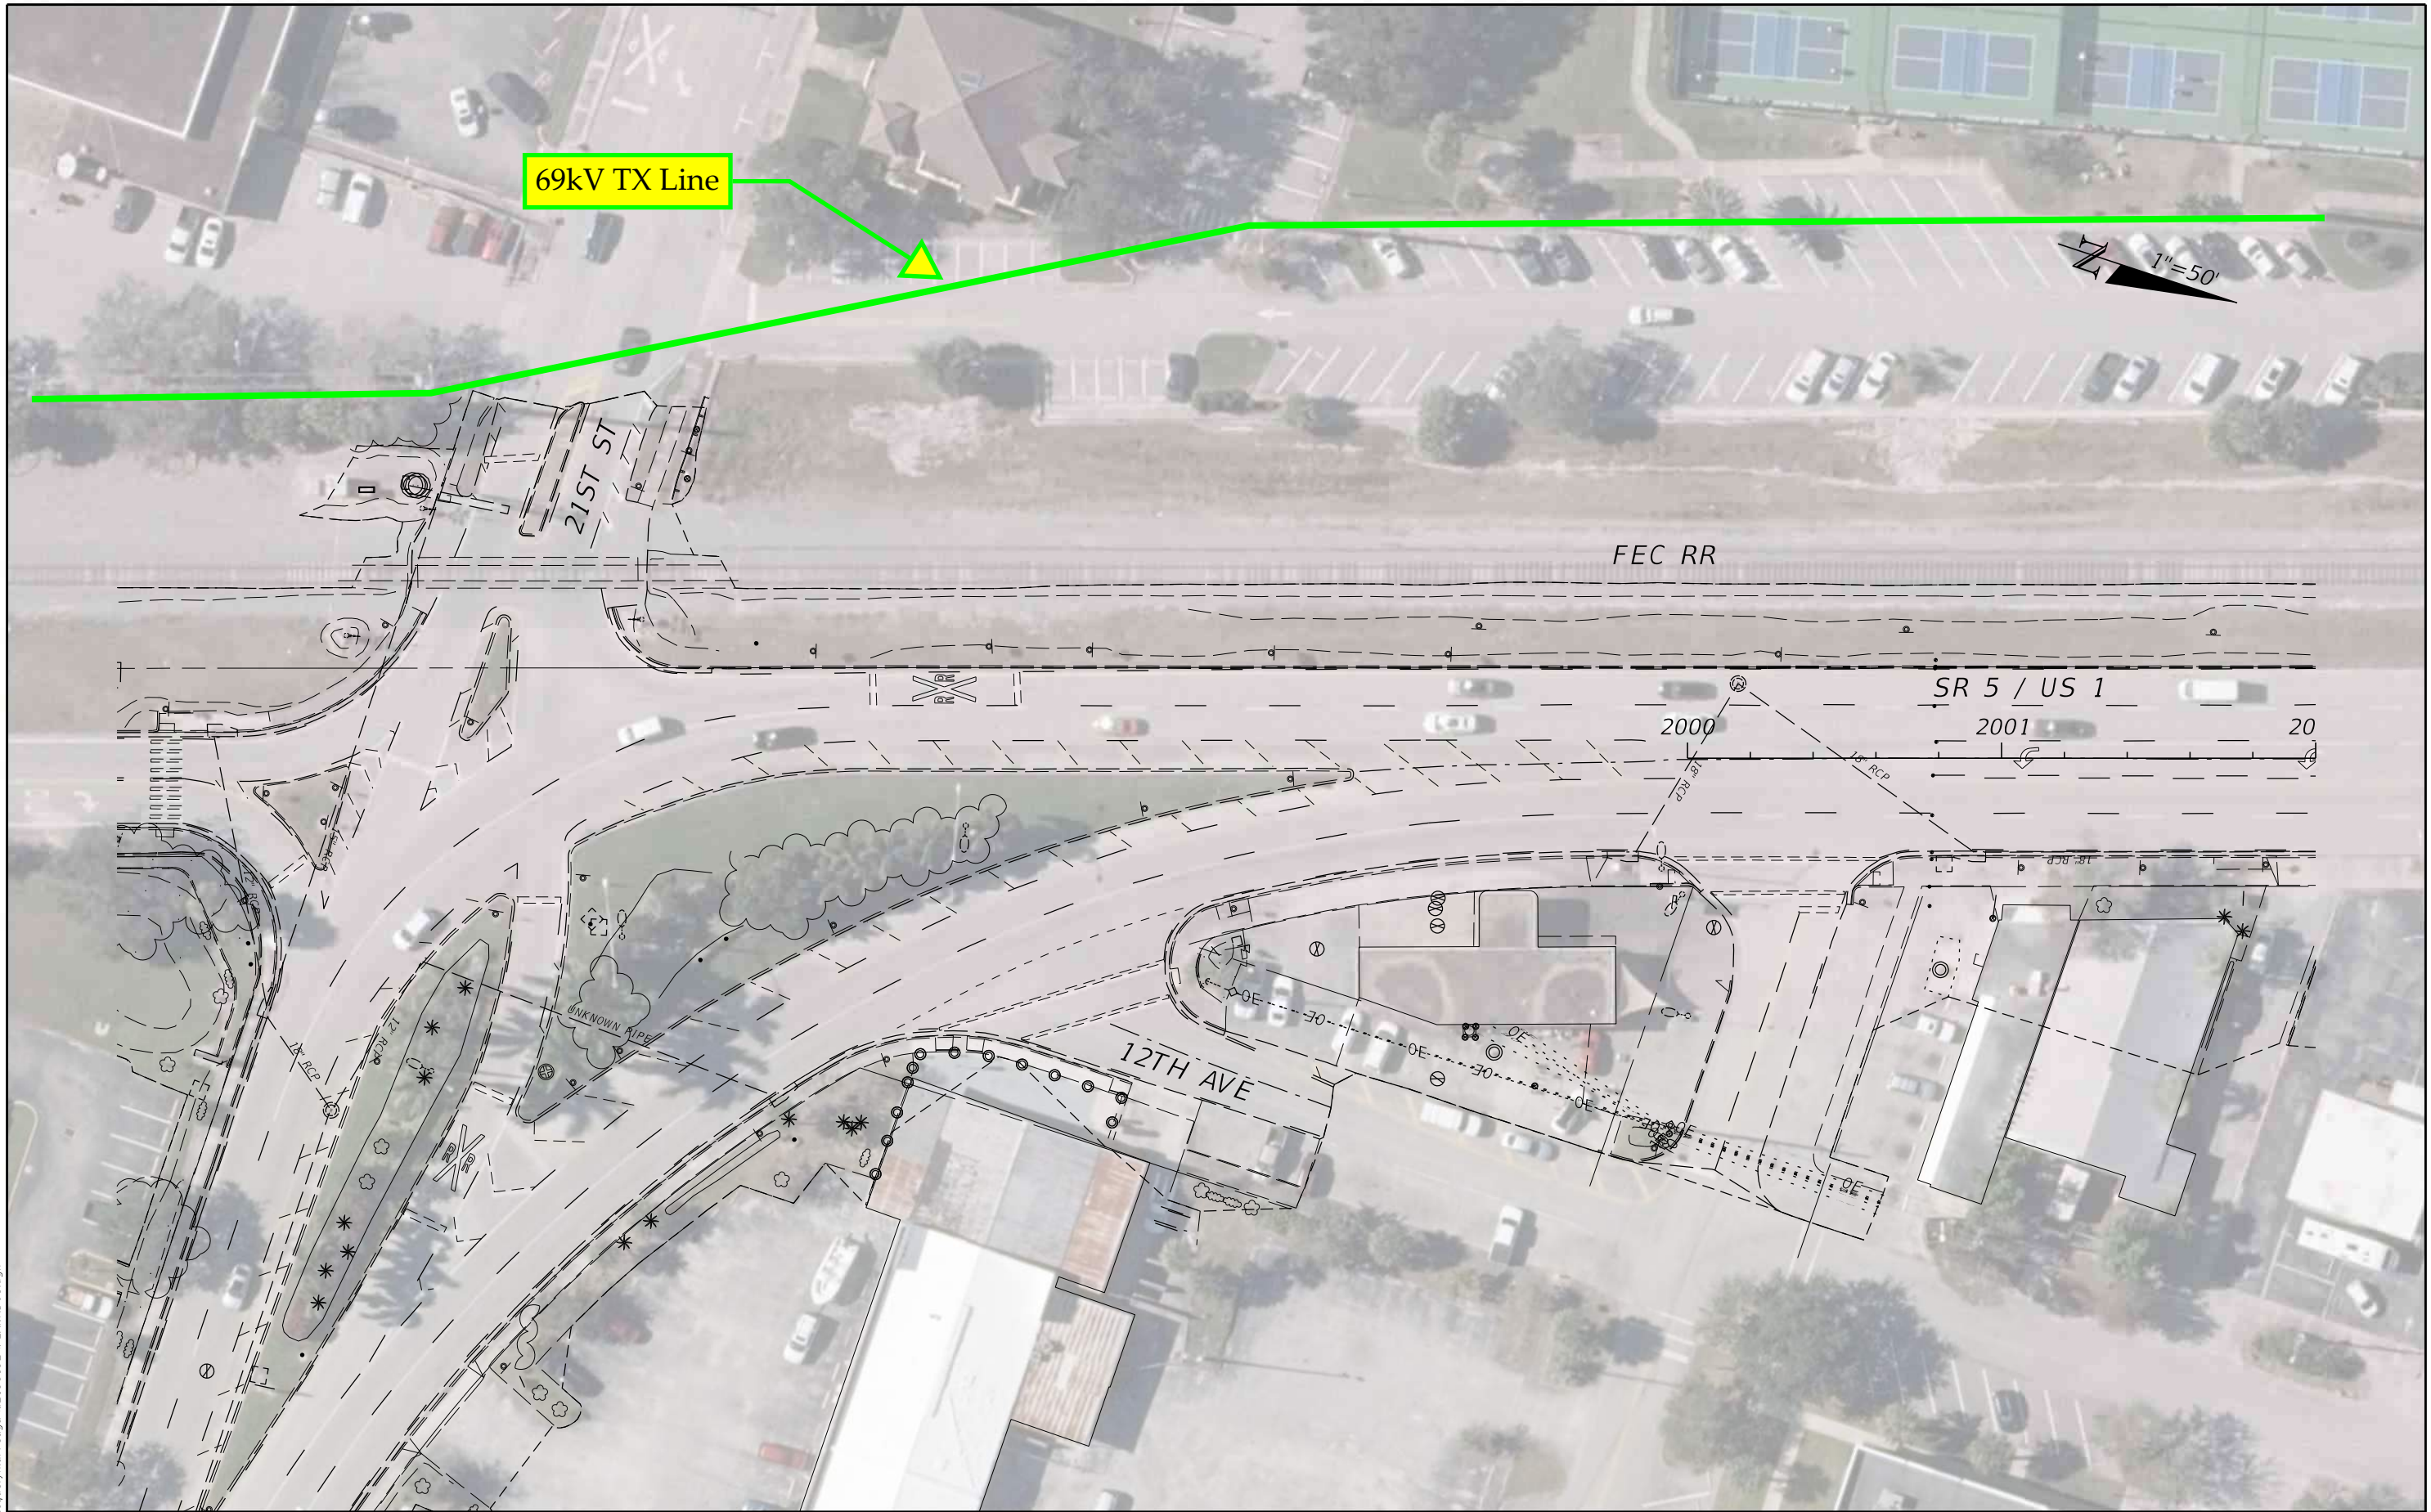

69kV TX Line

1"=50'

21ST ST

FEC RR

SR 5 / US 1


12TH AVE

9/15/2022 10:58:52 AM Jacquelyn.Arreaga c:\pwworking\wgi\jacquelyn.arreaga\d2198192\PLANRD01.dgn


REVISIONS		PROFESSIONAL TYPE		STATE OF FLORIDA DEPARTMENT OF TRANSPORTATION			UTILITY CONTACT PLAN (1)	SHEET NO. 1
DATE	DESCRIPTION	DATE	DESCRIPTION	ROAD NO.	COUNTY	FINANCIAL PROJECT ID		
				SR 5	INDIAN RIVER	441693-1-22-02		

WILLIAM EVANS  
LICENSE NUMBER: 45207  
WGI, INC.  
2035 VISTA PARKWAY  
WEST PALM BEACH, FL 33411

THE OFFICIAL RECORD OF THIS SHEET IS THE ELECTRONIC FILE DIGITALLY SIGNED AND SEALED UNDER RULE 61G15-23.004, F.A.C.

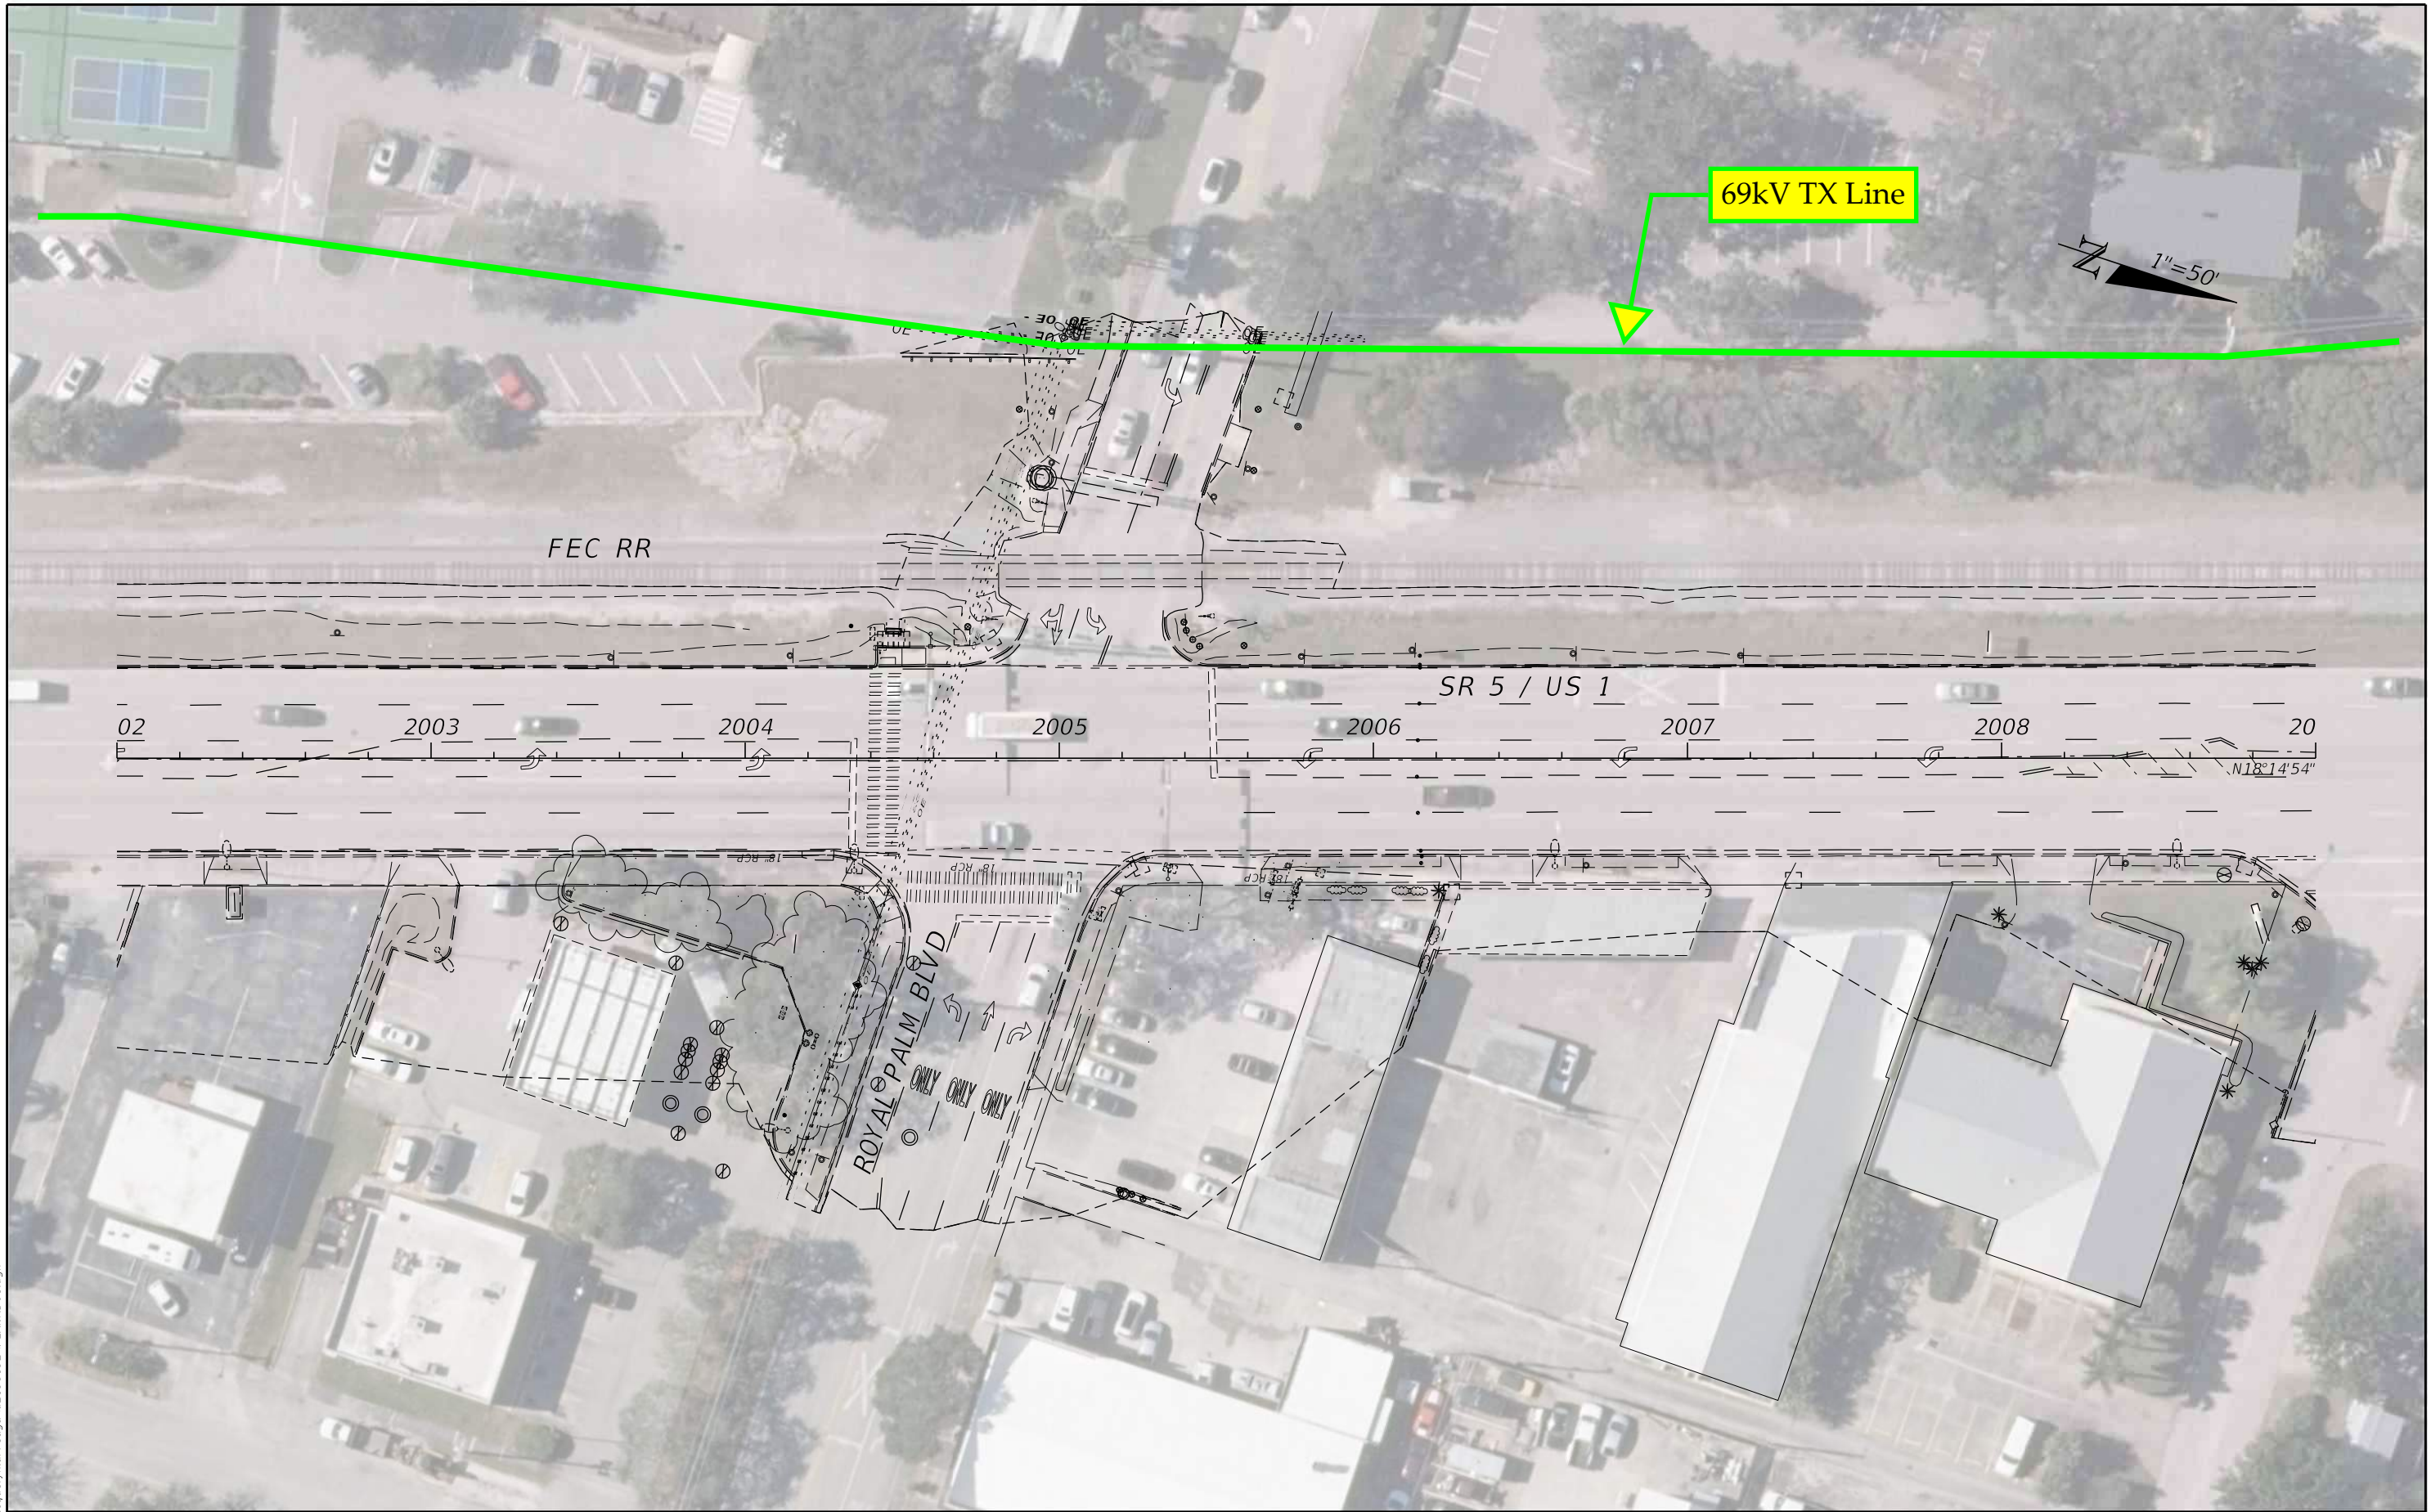

69kV TX Line

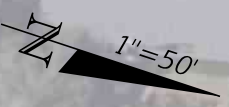

FEC RR

SR 5 / US 1

02      2003      2004      2005      2006      2007      2008      20

N18°14'54"

ROYAL PALM BLVD  
ONLY ONLY ONLY


9/15/2022 10:59:58 AM Jacquelyn.Arreaga c:\pwworking\wg\N\Jacquelyn.arreaga\d2198192\PLANRD01.dgn

REVISIONS		PROFESSIONAL TYPE		STATE OF FLORIDA DEPARTMENT OF TRANSPORTATION			UTILITY CONTACT PLAN (2)	SHEET NO. 2
DATE	DESCRIPTION	DATE	DESCRIPTION	ROAD NO.	COUNTY	FINANCIAL PROJECT ID		
				SR 5	INDIAN RIVER	441693-1-22-02		

WILLIAM EVANS  
LICENSE NUMBER: 45207  
WGI, INC.  
2035 VISTA PARKWAY  
WEST PALM BEACH, FL 33411

THE OFFICIAL RECORD OF THIS SHEET IS THE ELECTRONIC FILE DIGITALLY SIGNED AND SEALED UNDER RULE 61G15-23.004, F.A.C.



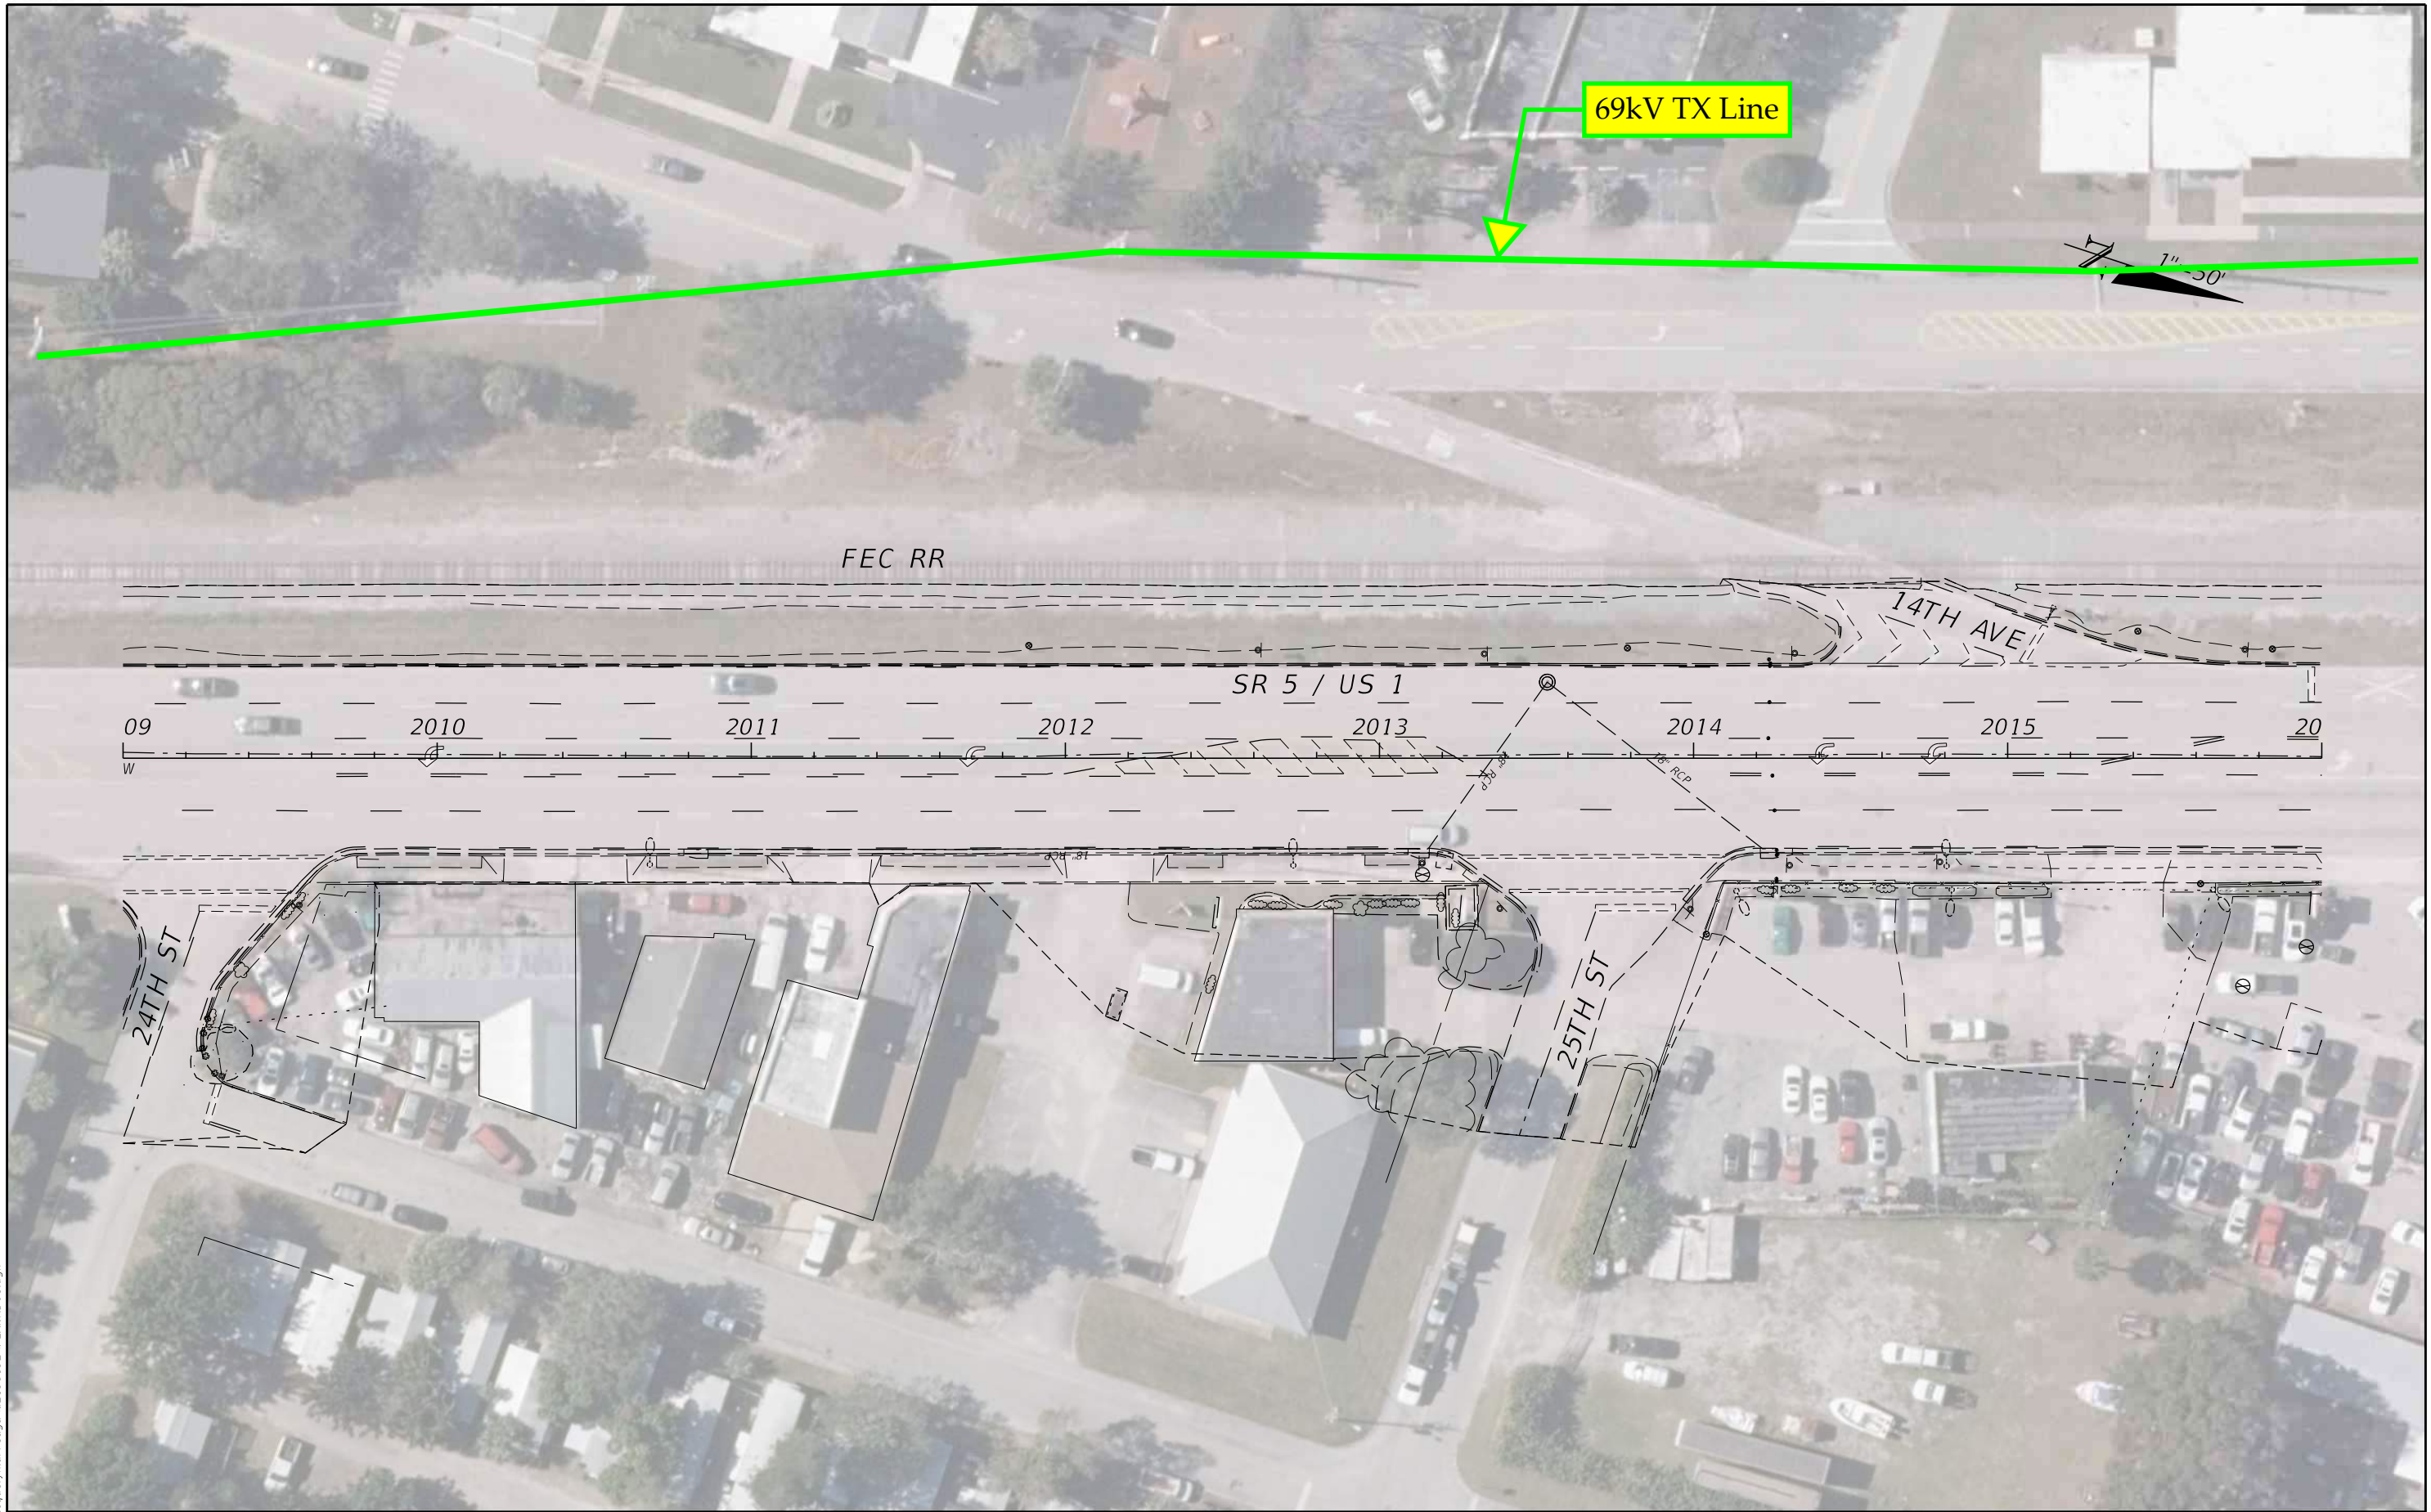


9/15/2022 11:00:13 AM Jacquelyn.Arreaga  
 c:\pwworking\wgn\jacquelyn.arreaga\d2198192\PLANRD01.dgn

DATE		REVISIONS		PROFESSIONAL TYPE	STATE OF FLORIDA DEPARTMENT OF TRANSPORTATION			SHEET NO.
DATE	DESCRIPTION	DATE	DESCRIPTION		ROAD NO.	COUNTY	FINANCIAL PROJECT ID	
				WILLIAM EVANS LICENSE NUMBER: 45207 WGI, INC. 2035 VISTA PARKWAY WEST PALM BEACH, FL 33411	SR 5	INDIAN RIVER	441693-1-22-02	3

*UTILITY CONTACT PLAN (3)*

THE OFFICIAL RECORD OF THIS SHEET IS THE ELECTRONIC FILE DIGITALLY SIGNED AND SEALED UNDER RULE 61G15-23.004, F.A.C.

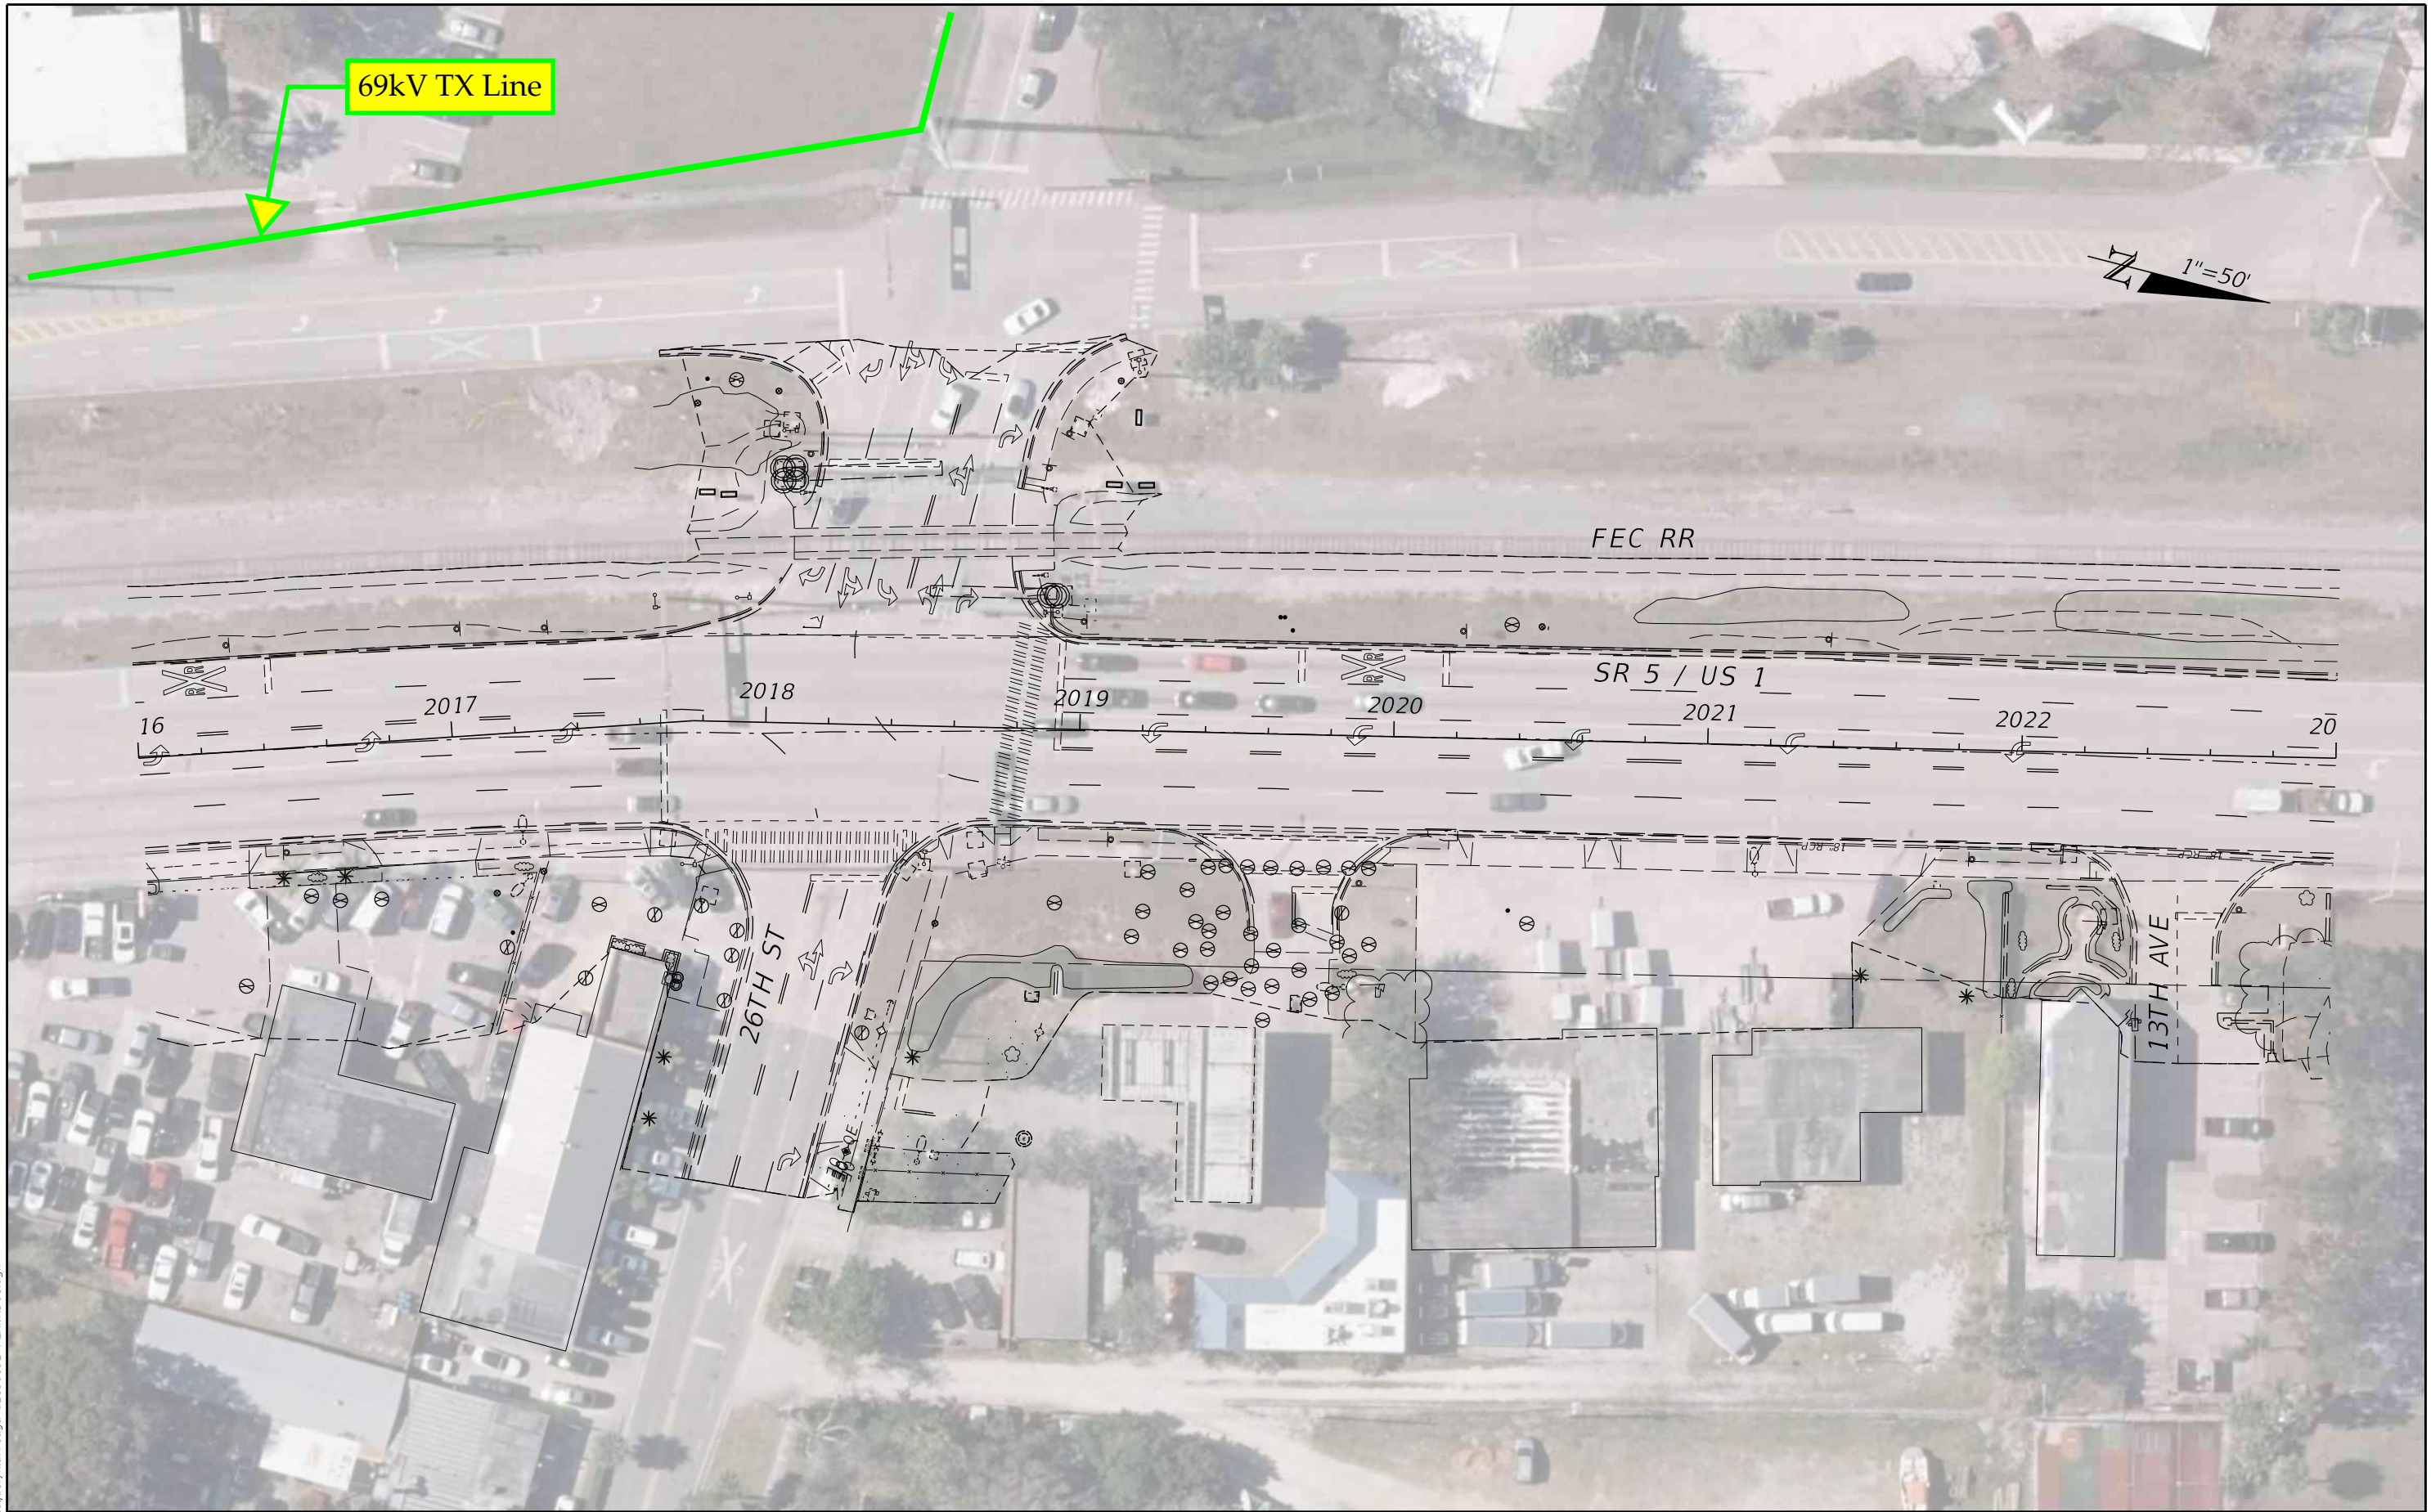

69kV TX Line

1"=50'

FEC RR

SR 5 / US 1

26TH ST


13TH AVE

9/15/2022 11:00:42 AM Jacquelyn.Arreaga c:\pwworking\wg\N\Jacquelyn.arreaga\d2198192\PLANRD01.dgn

THE OFFICIAL RECORD OF THIS SHEET IS THE ELECTRONIC FILE DIGITALLY SIGNED AND SEALED UNDER RULE 61G15-23.004, F.A.C.

REVISIONS		PROFESSIONAL TYPE		STATE OF FLORIDA DEPARTMENT OF TRANSPORTATION			UTILITY CONTACT PLAN (4)	SHEET NO. 4
DATE	DESCRIPTION	DATE	DESCRIPTION	ROAD NO.	COUNTY	FINANCIAL PROJECT ID		
				SR 5	INDIAN RIVER	441693-1-22-02		

WILLIAM EVANS  
LICENSE NUMBER: 45207  
WGI, INC.  
2035 VISTA PARKWAY  
WEST PALM BEACH, FL 33411

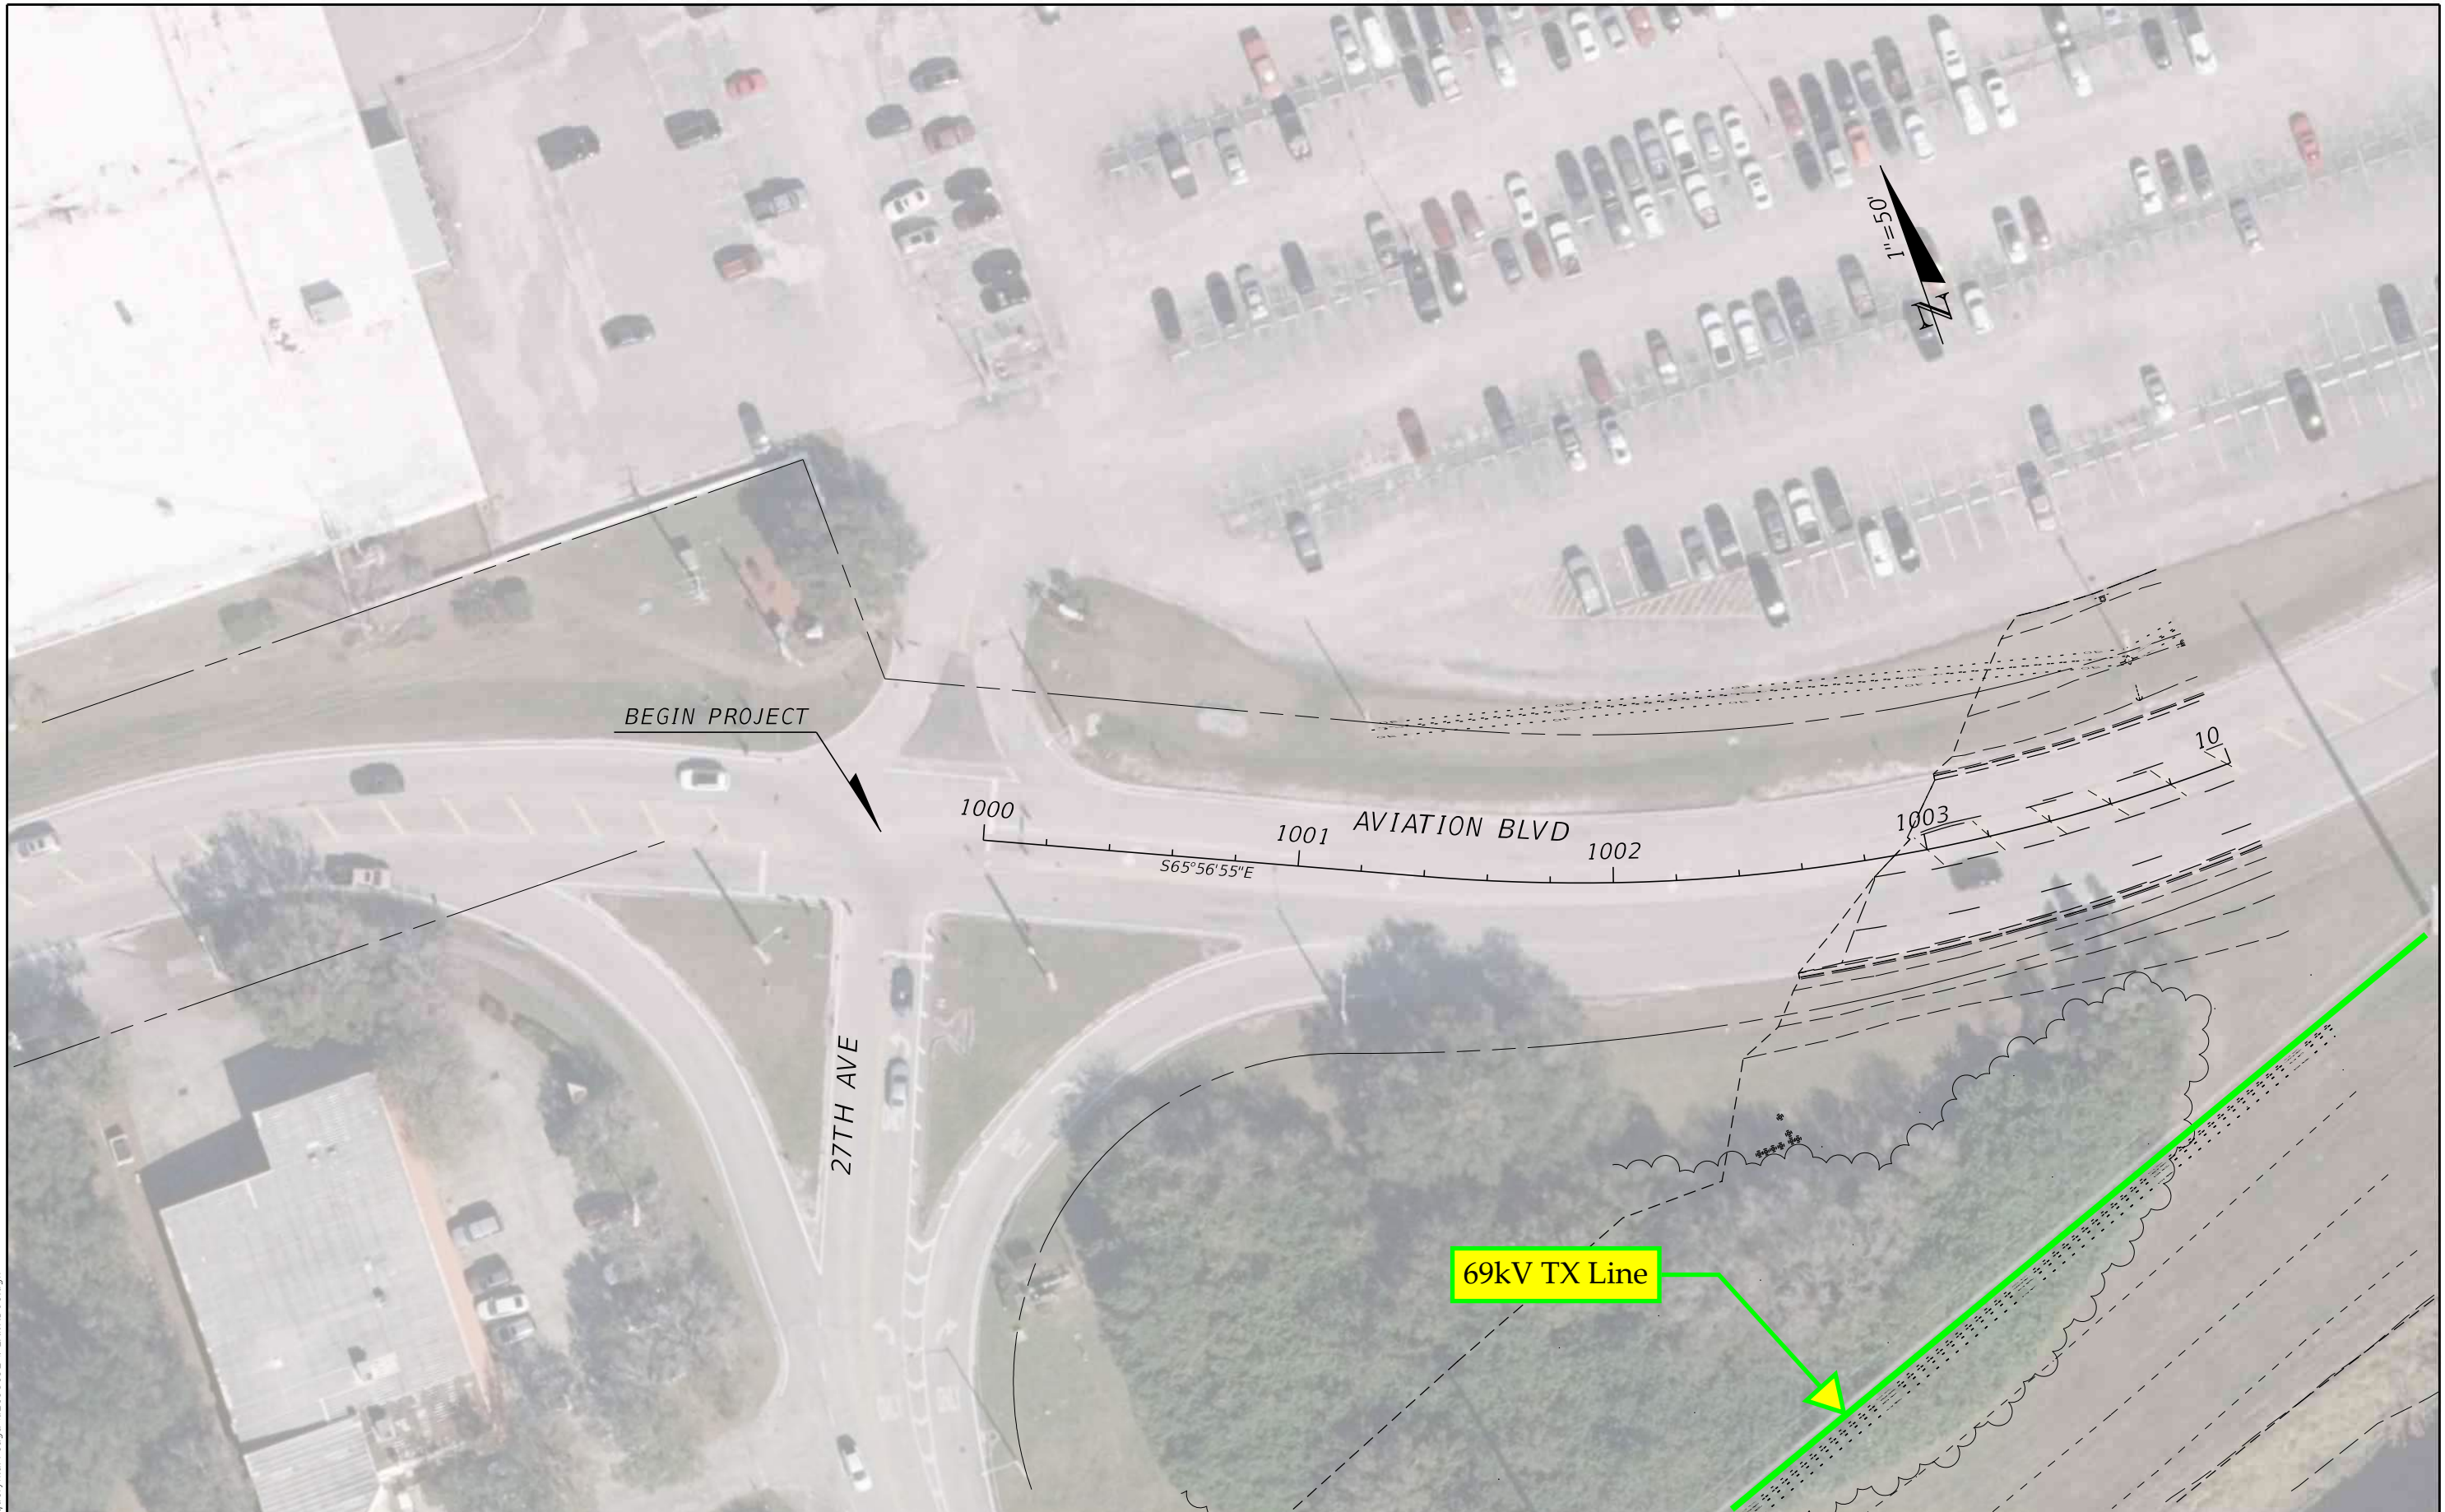

BEGIN PROJECT

27TH AVE

1000 1001 AVIATION BLVD 1002 1003


S65°56'55"E

69kV TX Line

9/15/2022 11:07:58 AM Jacquelyn.Arreaga c:\pwworking\wg\N\Jacquelyn.arreaga\d2198192\PLAN\ARD01.dgn

REVISIONS		PROFESSIONAL TYPE		STATE OF FLORIDA DEPARTMENT OF TRANSPORTATION			UTILITY CONTACT PLAN (21)	SHEET NO. 21
DATE	DESCRIPTION	DATE	DESCRIPTION	ROAD NO.	COUNTY	FINANCIAL PROJECT ID		
				SR 5	INDIAN RIVER	441693-1-22-02		

THE OFFICIAL RECORD OF THIS SHEET IS THE ELECTRONIC FILE DIGITALLY SIGNED AND SEALED UNDER RULE 61G15-23.004, F.A.C.

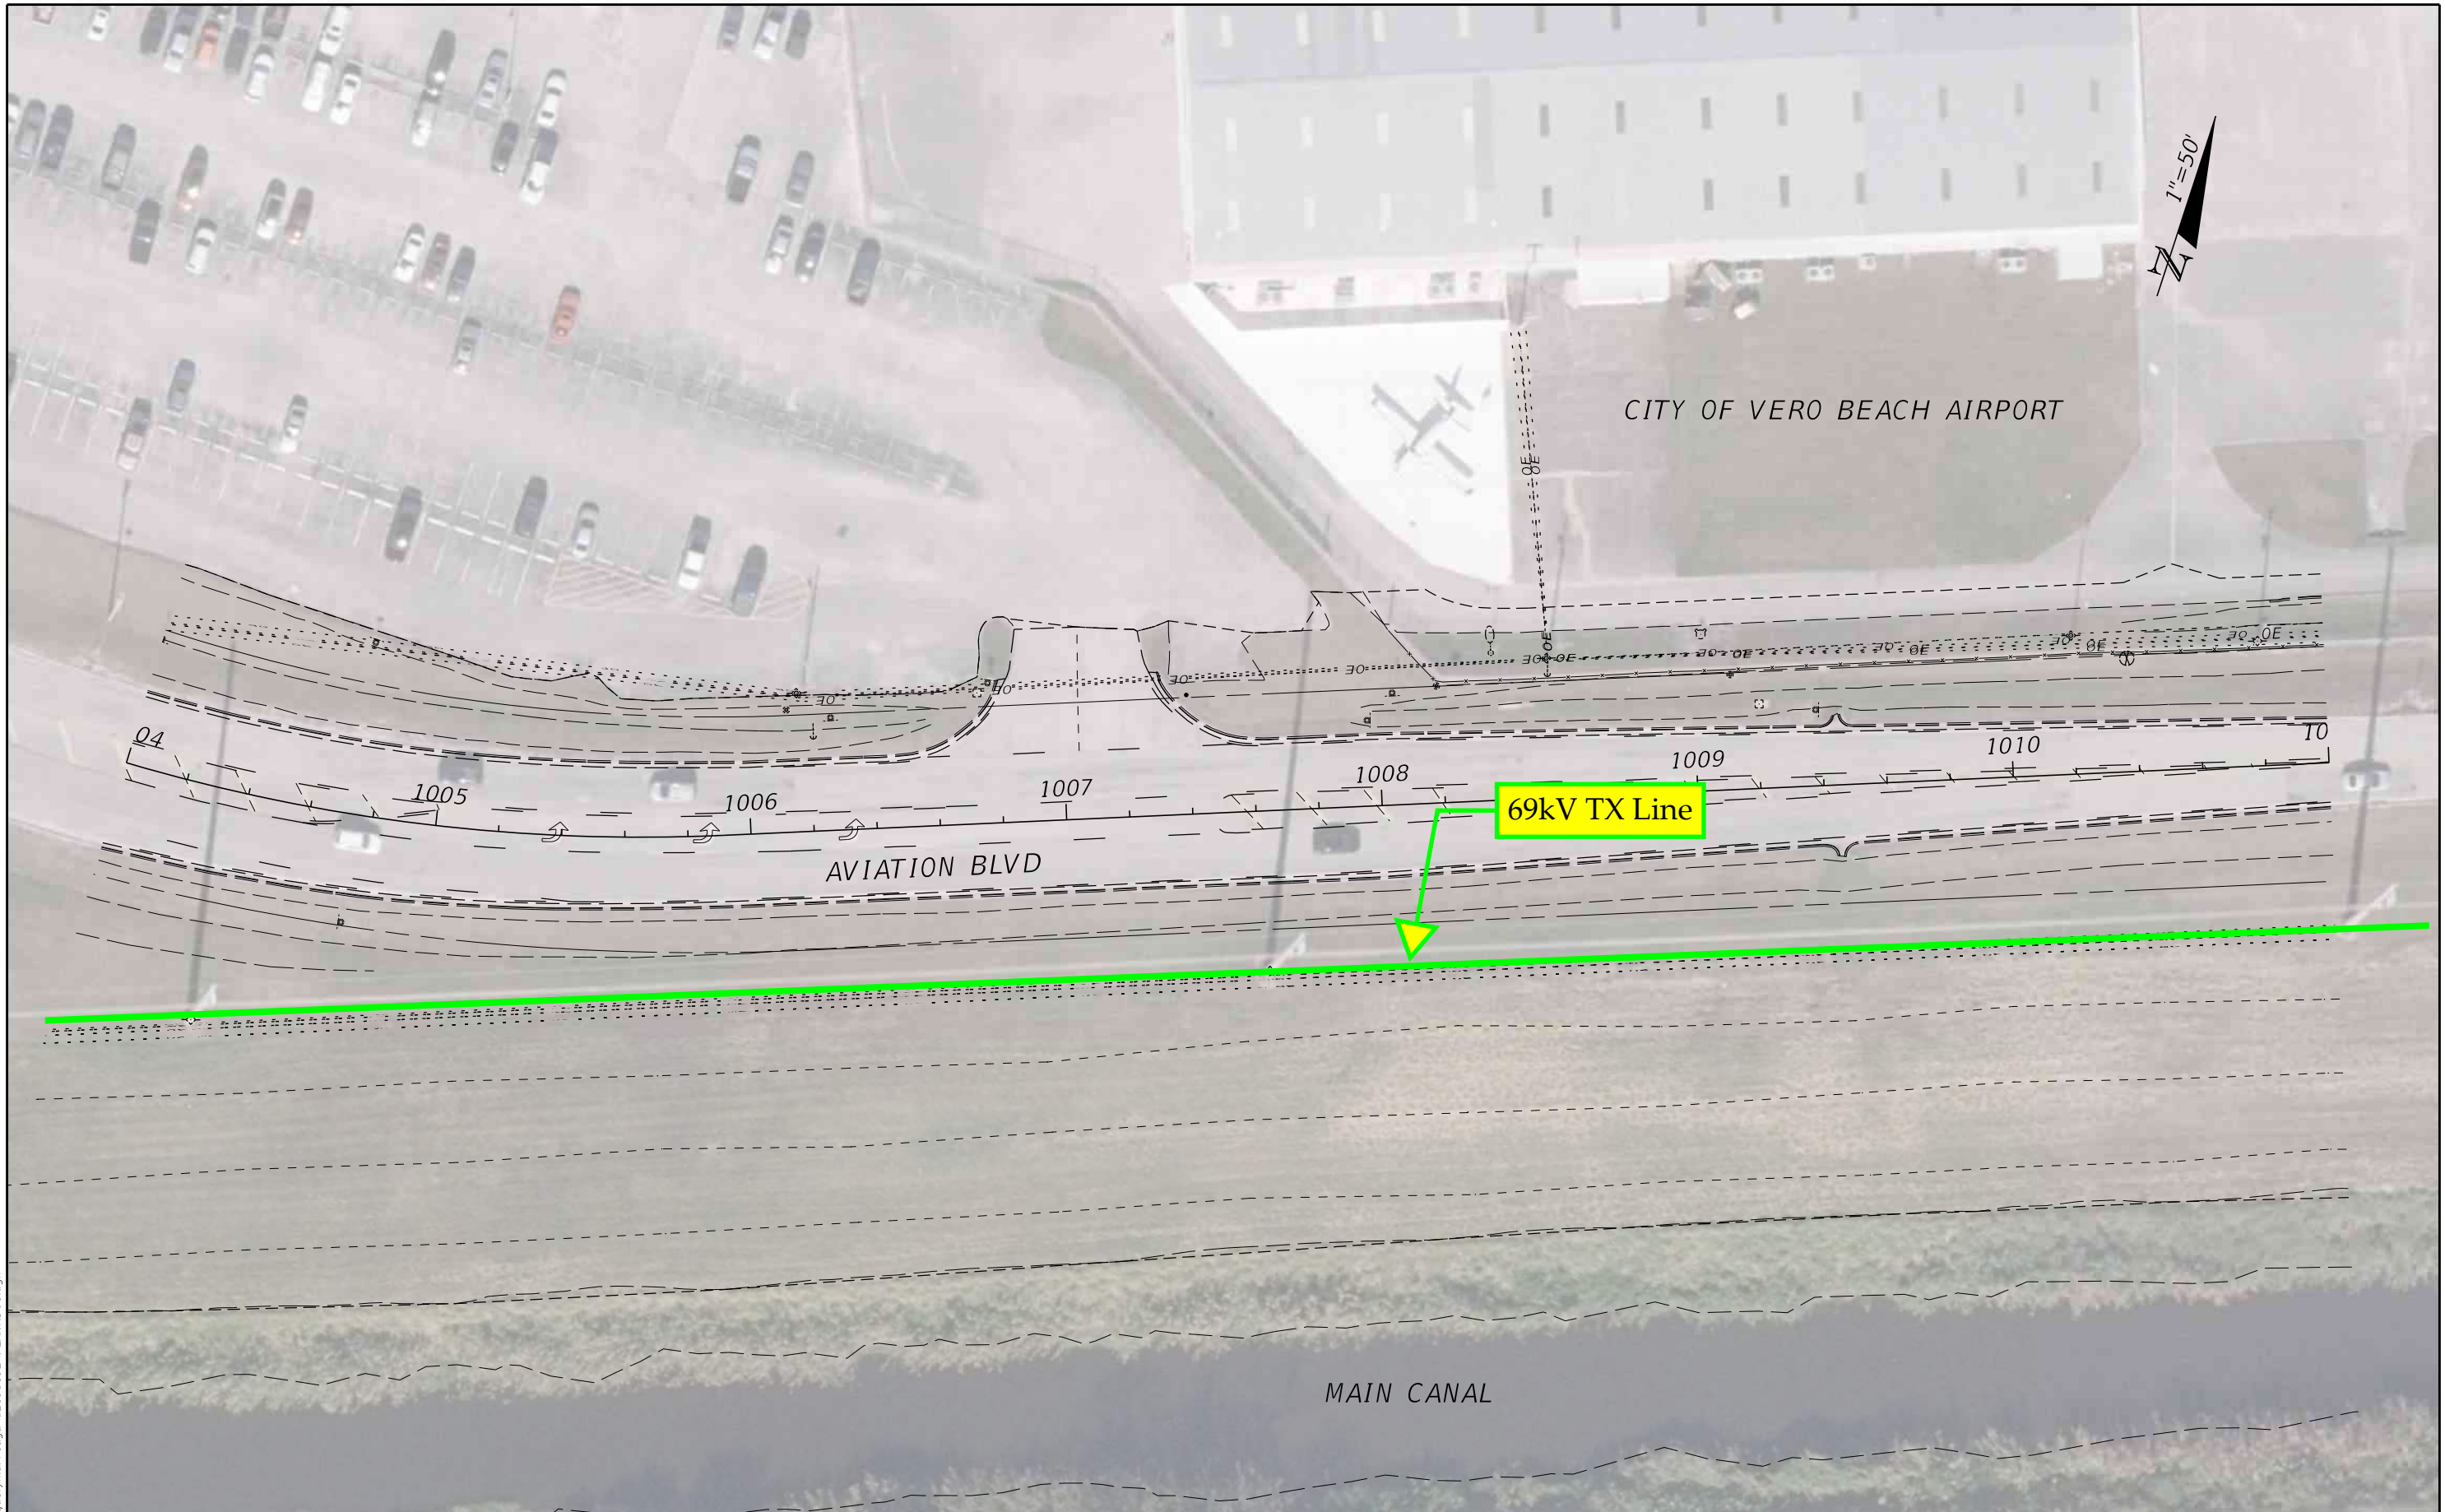

9/15/2022 11:08:27 AM Jacquelyn.Arreaga c:\pwworking\wgn\jacquelyn.arreaga\d2198192\PLANRD01.dgn


REVISIONS		PROFESSIONAL TYPE		STATE OF FLORIDA DEPARTMENT OF TRANSPORTATION			UTILITY CONTACT PLAN (22)	SHEET NO. 22
DATE	DESCRIPTION	DATE	DESCRIPTION	ROAD NO.	COUNTY	FINANCIAL PROJECT ID		
				SR 5	INDIAN RIVER	441693-1-22-02		

WILLIAM EVANS  
 LICENSE NUMBER: 45207  
 WGI, INC.  
 2035 VISTA PARKWAY  
 WEST PALM BEACH, FL 33411

THE OFFICIAL RECORD OF THIS SHEET IS THE ELECTRONIC FILE DIGITALLY SIGNED AND SEALED UNDER RULE 61G15-23.004, F.A.C.



CITY OF VERO BEACH AIRPORT

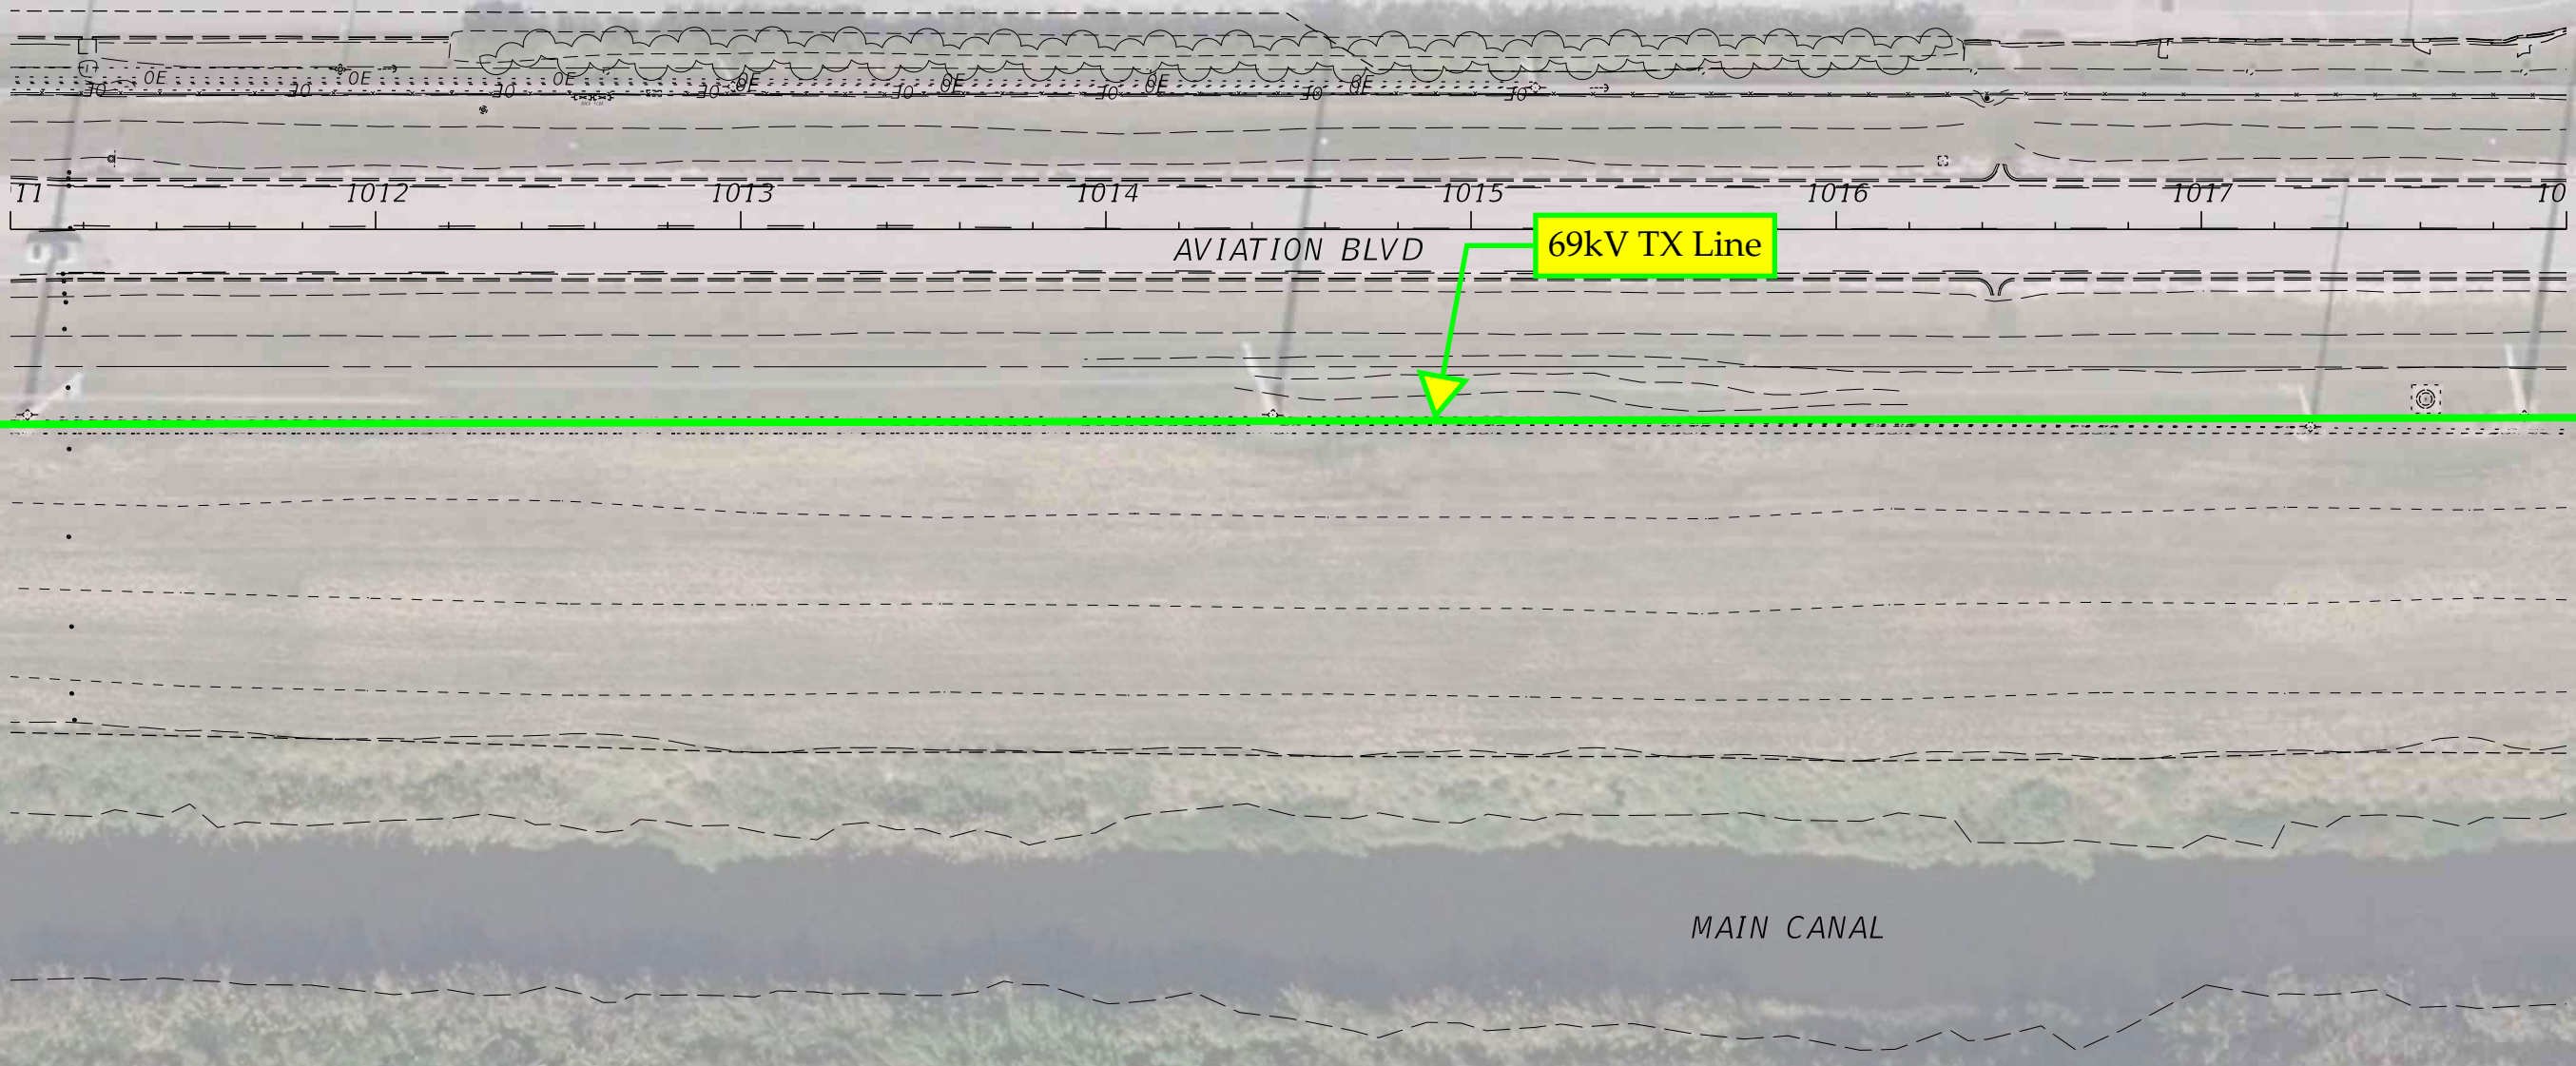


9/15/2022 11:08:39 AM Jacquelyn.Arreaga c:\pwworking\wgn\jacquelyn.arreaga\d2198192\PLANRD01.dgn

REVISIONS				PROFESSIONAL TYPE	STATE OF FLORIDA DEPARTMENT OF TRANSPORTATION			UTILITY CONTACT PLAN (23)	SHEET NO. 23
DATE	DESCRIPTION	DATE	DESCRIPTION		ROAD NO.	COUNTY	FINANCIAL PROJECT ID		
				WILLIAM EVANS LICENSE NUMBER: 45207 WGI, INC. 2035 VISTA PARKWAY WEST PALM BEACH, FL 33411	SR 5	INDIAN RIVER	441693-1-22-02		

THE OFFICIAL RECORD OF THIS SHEET IS THE ELECTRONIC FILE DIGITALLY SIGNED AND SEALED UNDER RULE 61G15-23.004, F.A.C.



CITY OF VERO BEACH AIRPORT

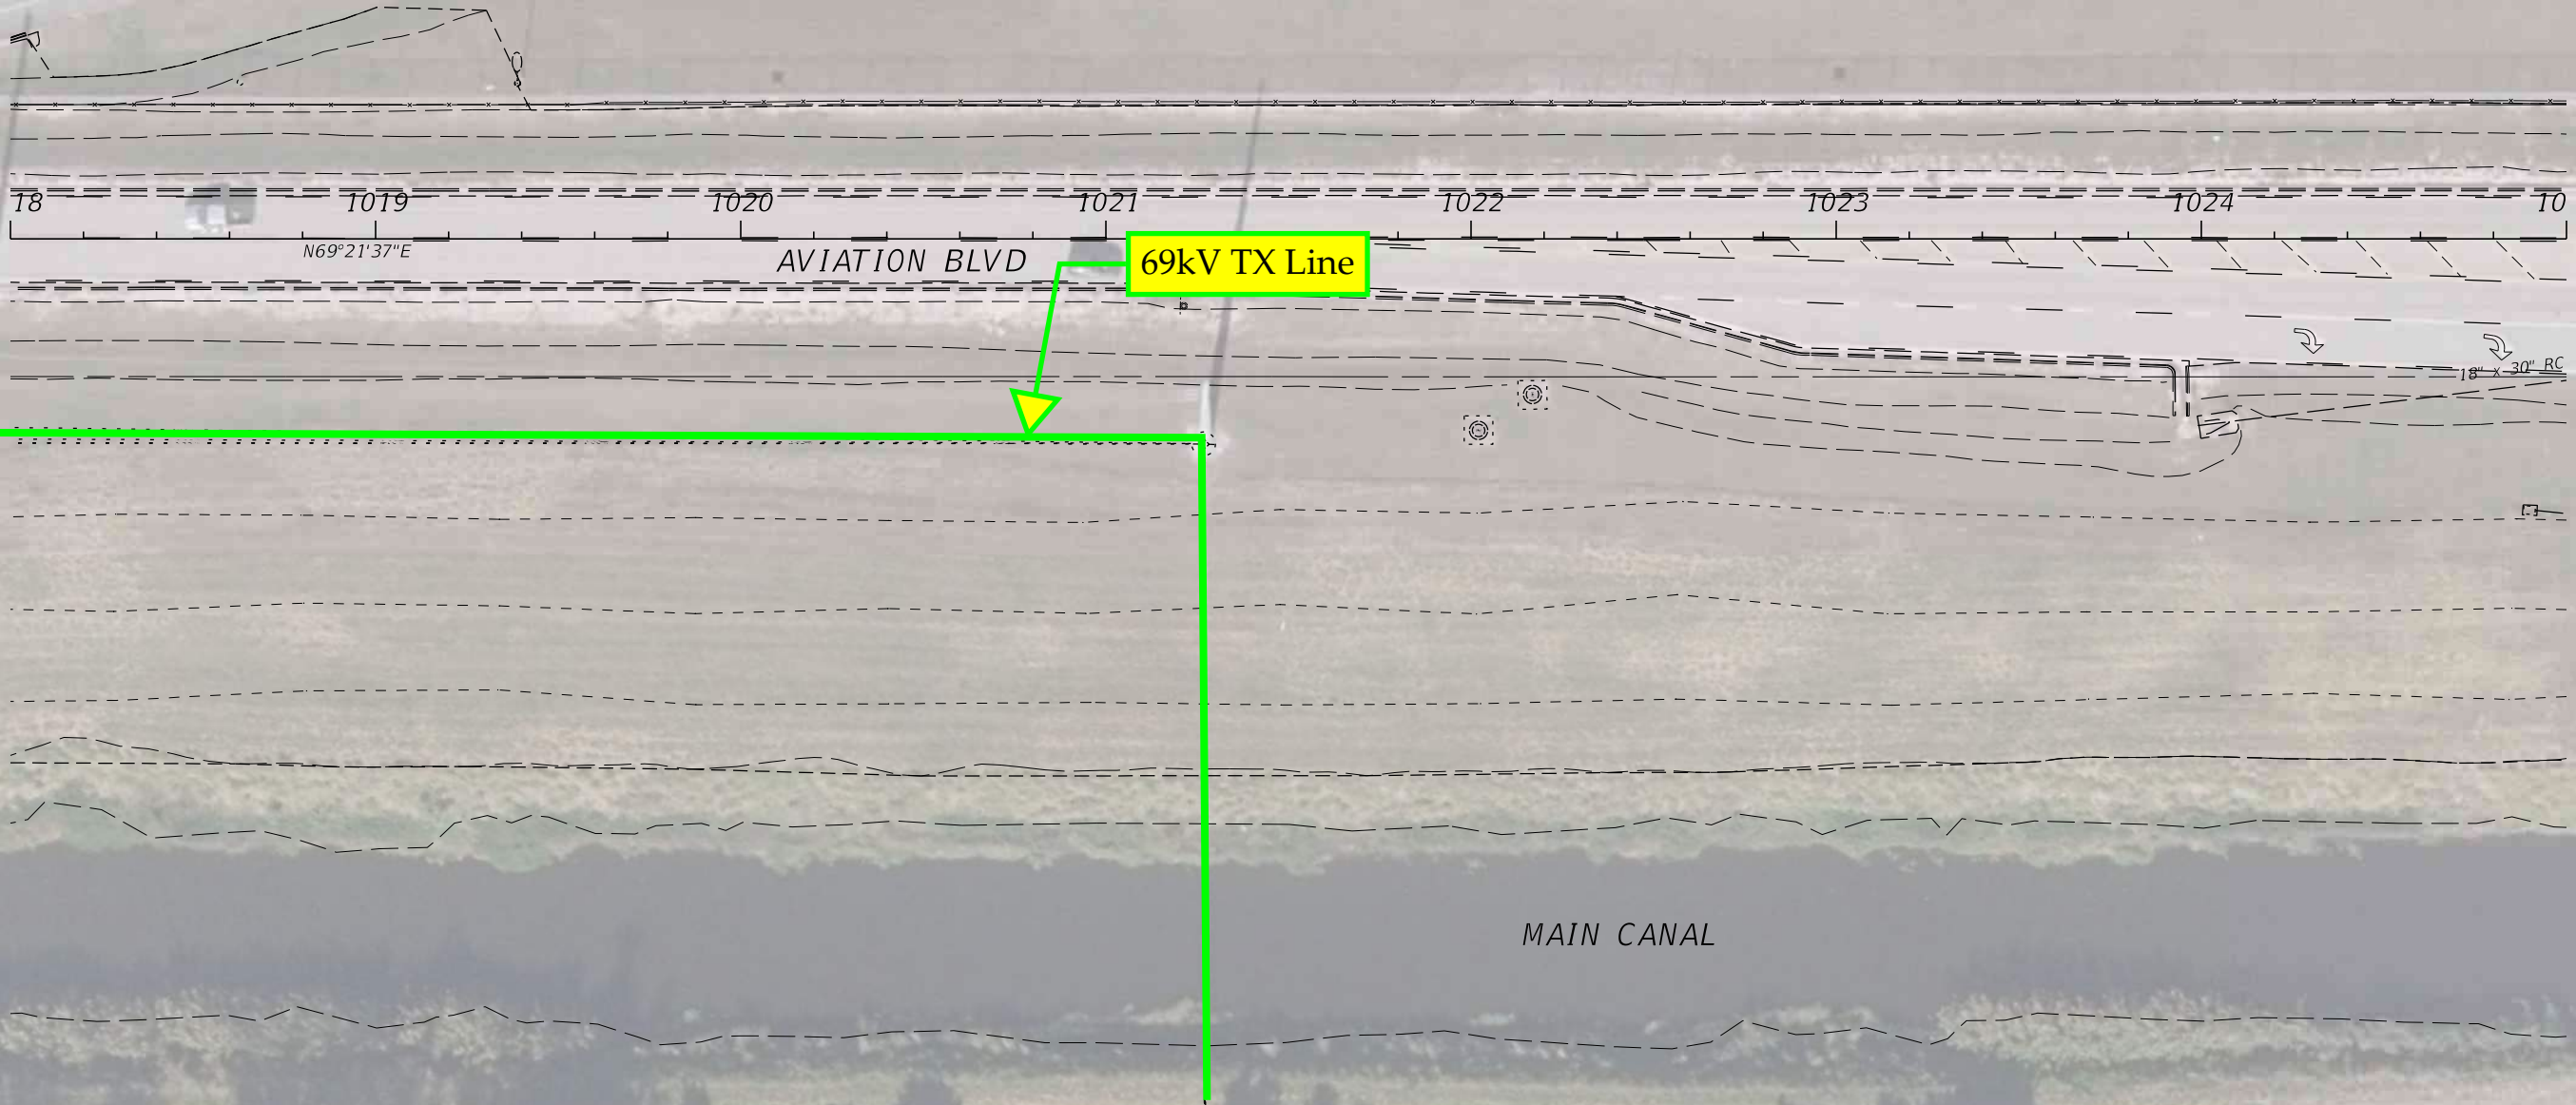


9/15/2022 11:08:55 AM Jacquelyn.Arreaga c:\pwworking\wgn\jacquelyn.arreaga\d2198192\PLANRD01.dgn

REVISIONS				PROFESSIONAL TYPE	STATE OF FLORIDA DEPARTMENT OF TRANSPORTATION			UTILITY CONTACT PLAN (24)	SHEET NO. 24
DATE	DESCRIPTION	DATE	DESCRIPTION		ROAD NO.	COUNTY	FINANCIAL PROJECT ID		
				WILLIAM EVANS LICENSE NUMBER: 45207 WGI, INC. 2035 VISTA PARKWAY WEST PALM BEACH, FL 33411	SR 5	INDIAN RIVER	441693-1-22-02		

THE OFFICIAL RECORD OF THIS SHEET IS THE ELECTRONIC FILE DIGITALLY SIGNED AND SEALED UNDER RULE 61G15-23.004, F.A.C.

**Appendix D**

**Indian River County Utilities**

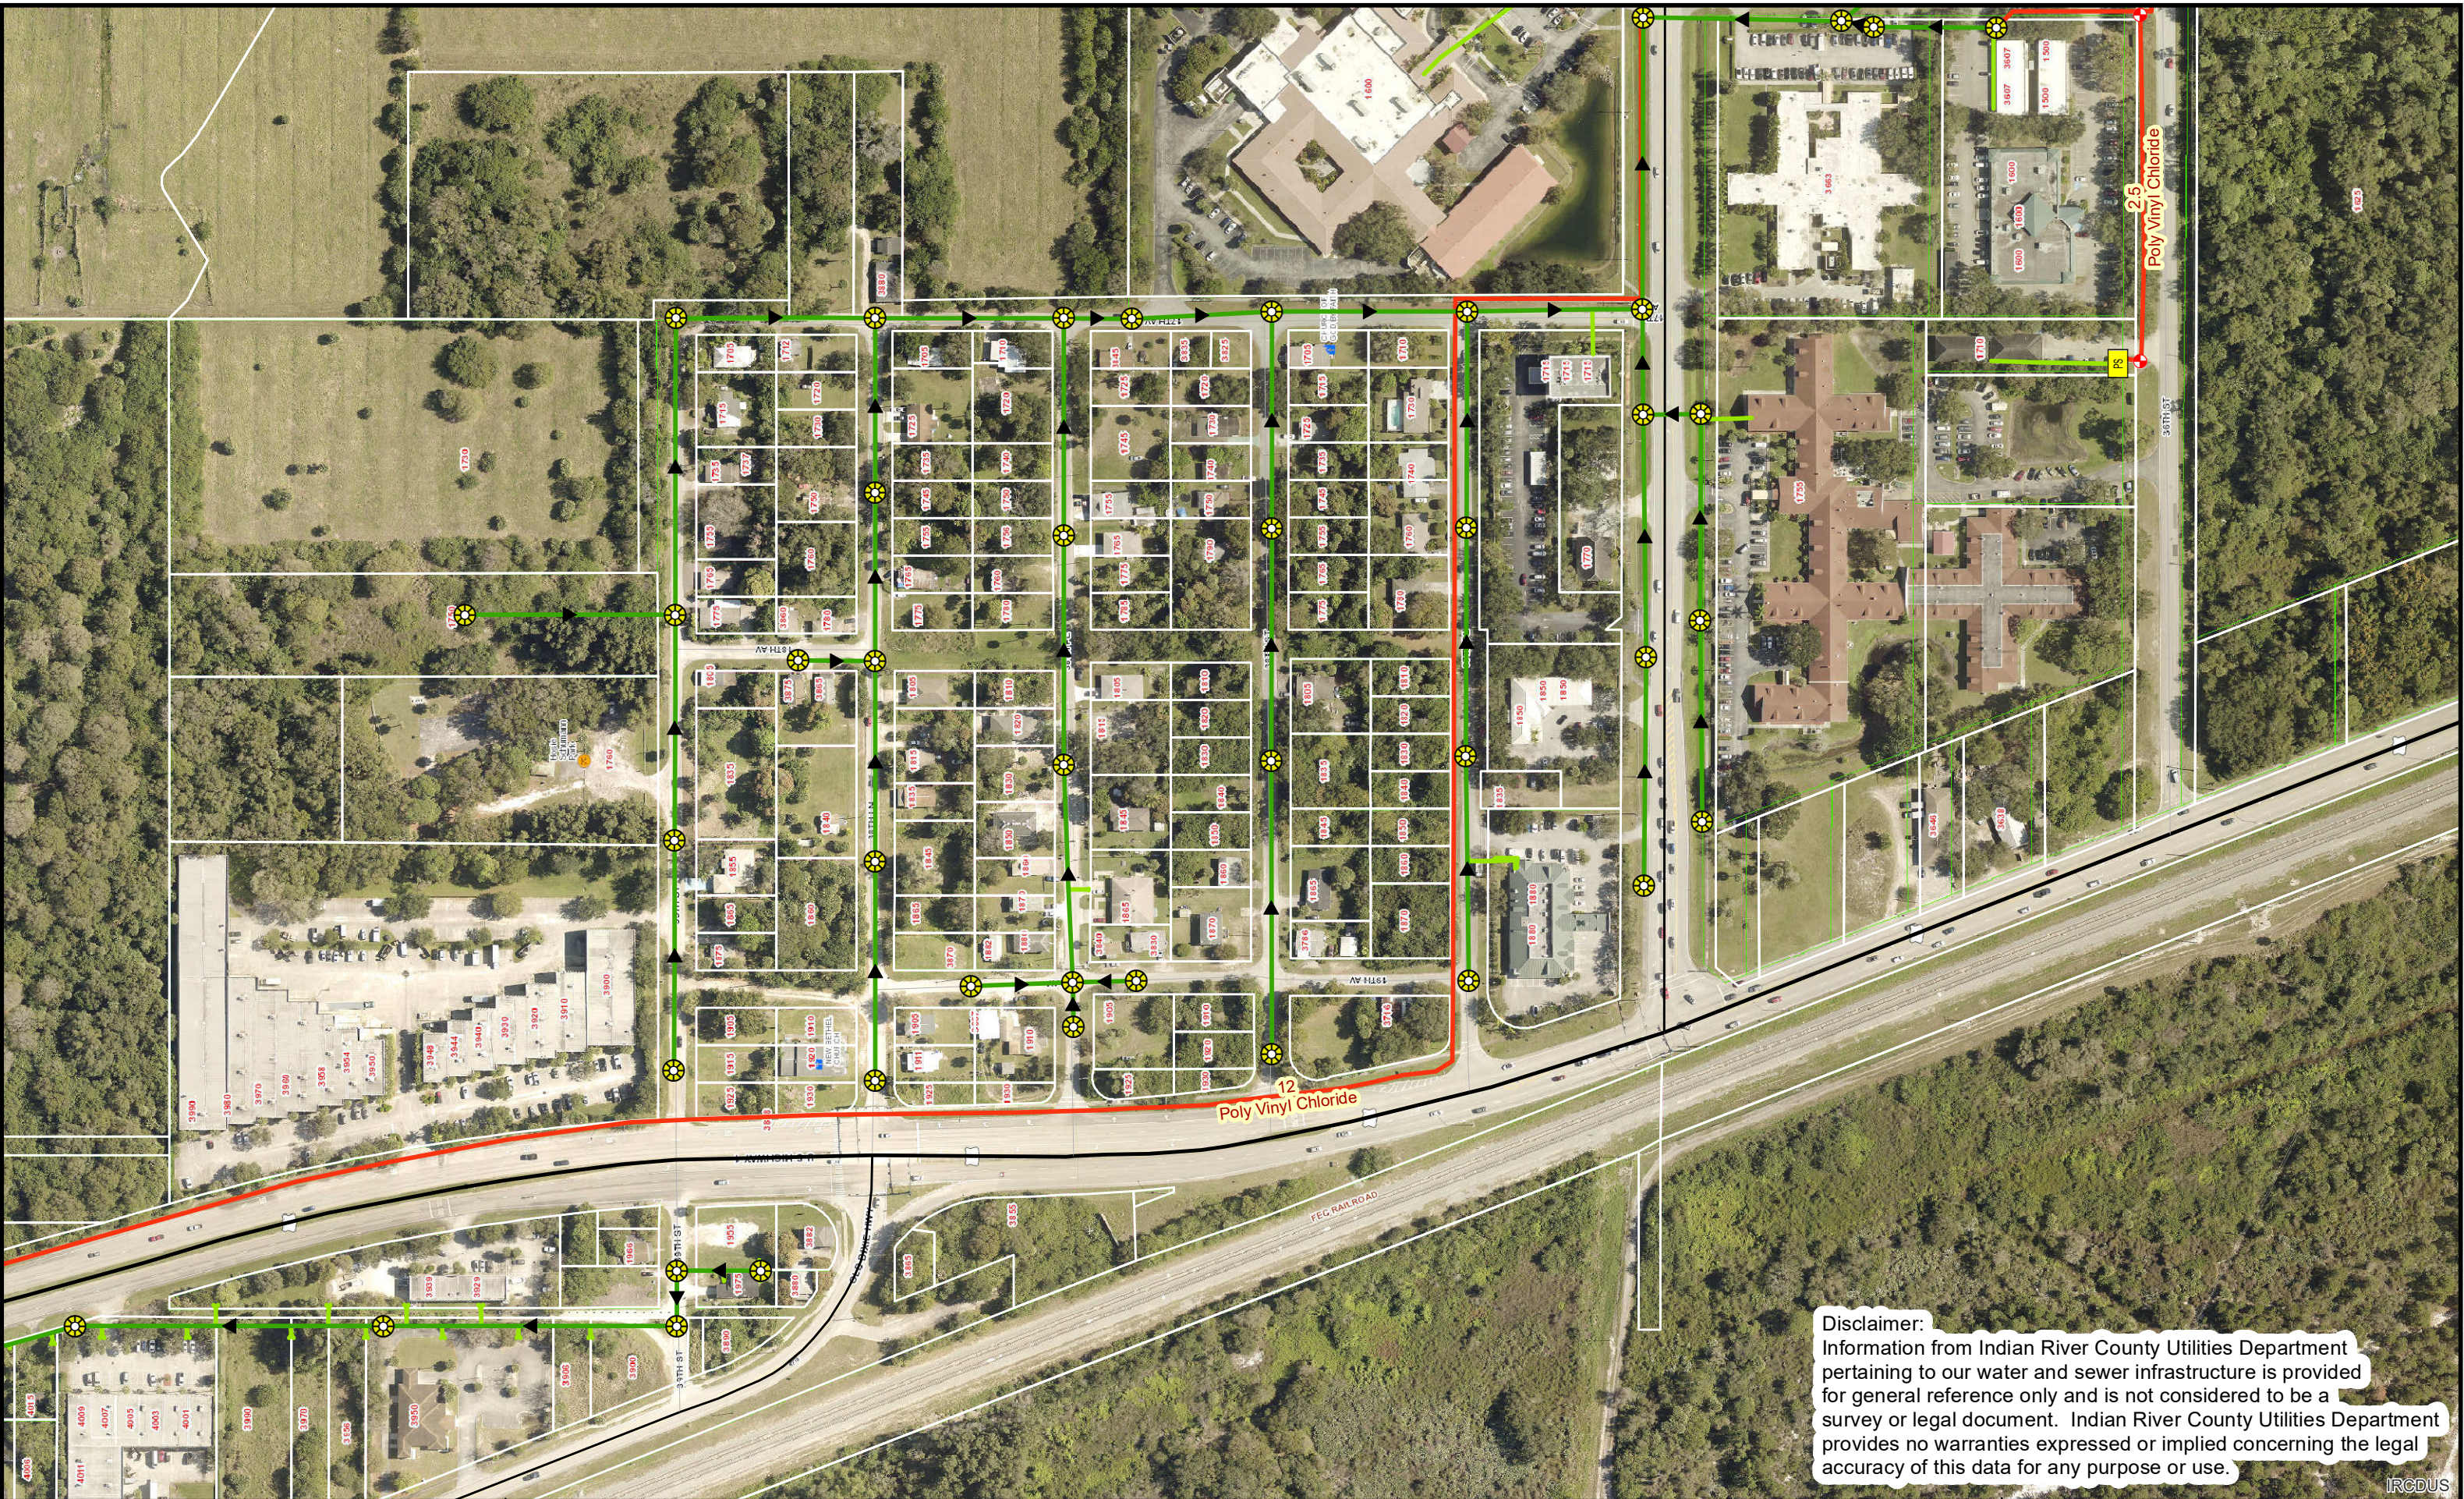


Disclaimer:  
 Information from Indian River County Utilities Department pertaining to our water and sewer infrastructure is provided for general reference only and is not considered to be a survey or legal document. Indian River County Utilities Department provides no warranties expressed or implied concerning the legal accuracy of this data for any purpose or use.


IRCDUS

**Legend**

- Existing Force Main
- Gravity Sewer
- Existing Manhole - Indian River County
- Existing Manhole - ABANDONED
- LiftStation, Indian River County
- LiftStation, Private

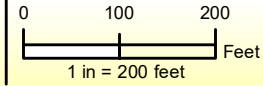



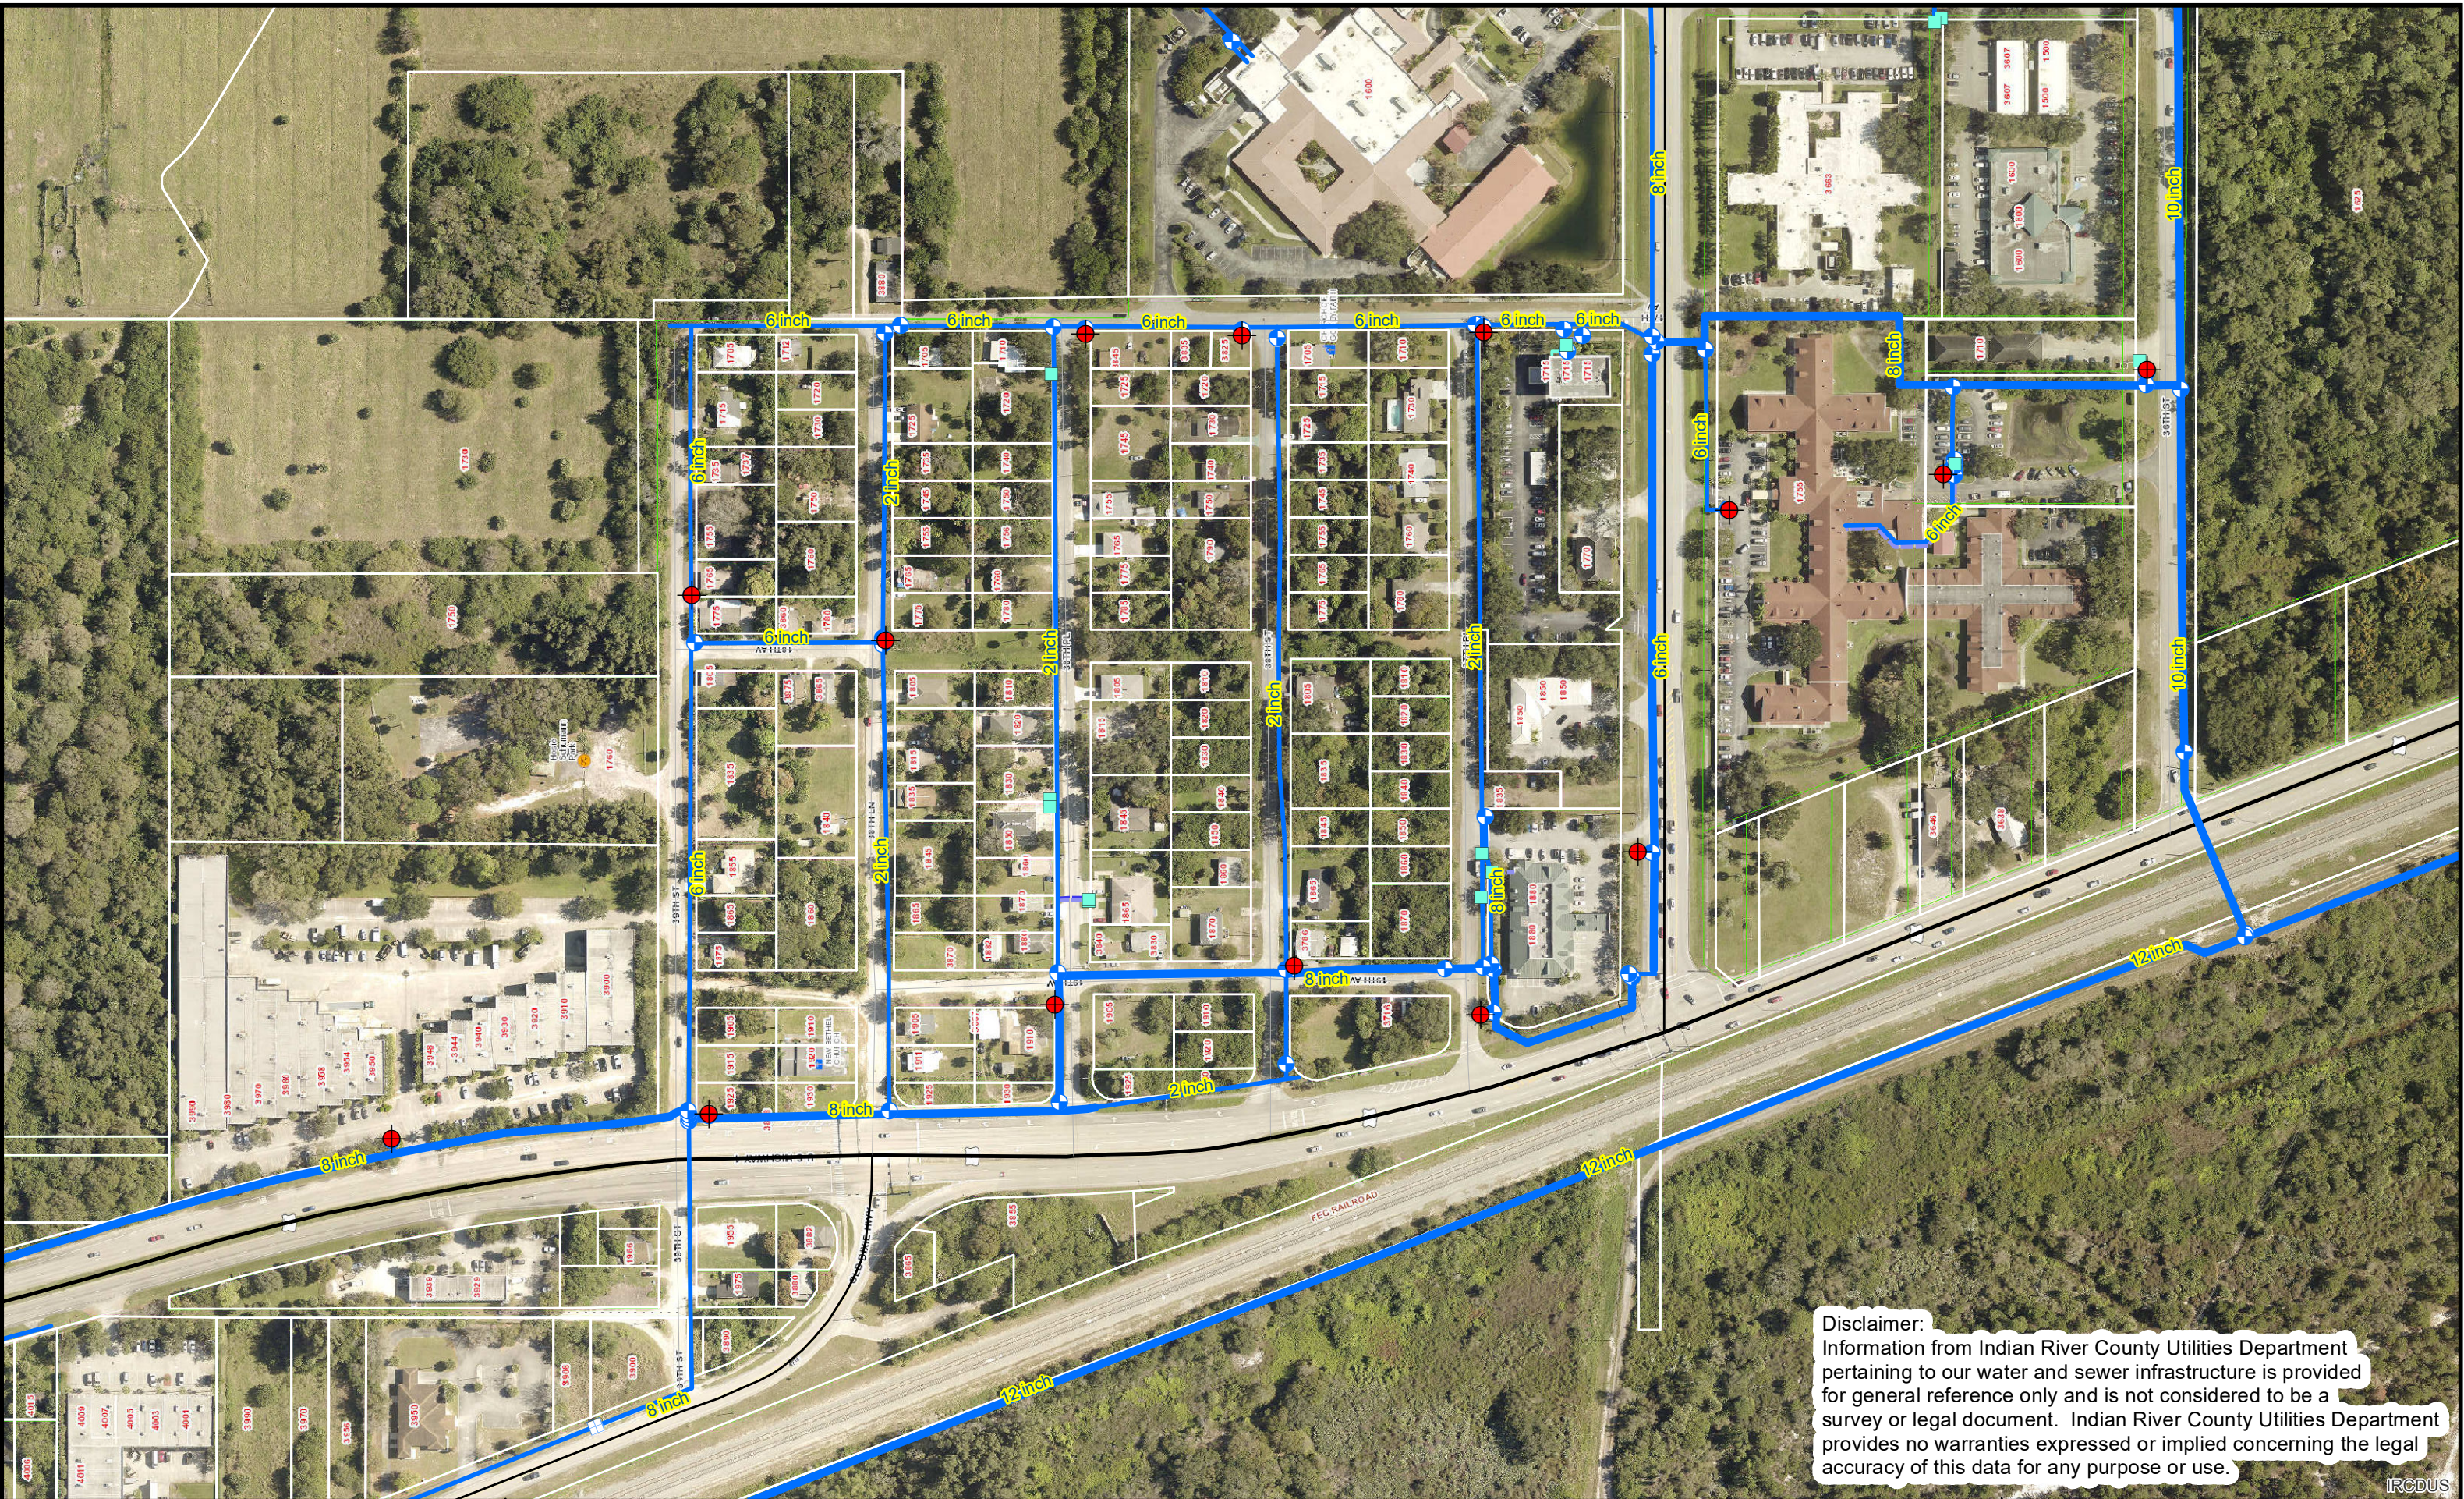

Disclaimer:  
 Information from Indian River County Utilities Department pertaining to our water and sewer infrastructure is provided for general reference only and is not considered to be a survey or legal document. Indian River County Utilities Department provides no warranties expressed or implied concerning the legal accuracy of this data for any purpose or use.


IRCDUS

# Indian River County



9/20/2023, 11:38:50 AM

- |                                     |  |
|-------------------------------------|--|
| wLateralLine                        | --- Fire, Private                        |
| --- Commercial, Indian River County | --- HydrantLaterals, Indian River County |
| --- Commercial, Private             | --- HydrantLaterals, Private             |
| --- Domestic, Indian River County   | --- HydrantLaterals, Private             |
| --- Domestic, Private               | ■ wSouthCountyWellLocations              |
| --- Domestic, Private               | ■ wNorthCountyWellLocations              |
| --- Fire, Indian River County       | ★ wWaterInterconnectLocations            |

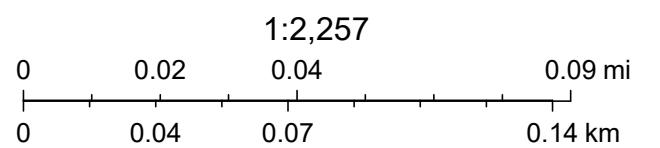


IRCGIS, FDOT, USDA  
IRCDUS  
IRCPA

**Appendix D**

**Lumen (CenturyLink)**



# LUMEN Relocate Utility Map

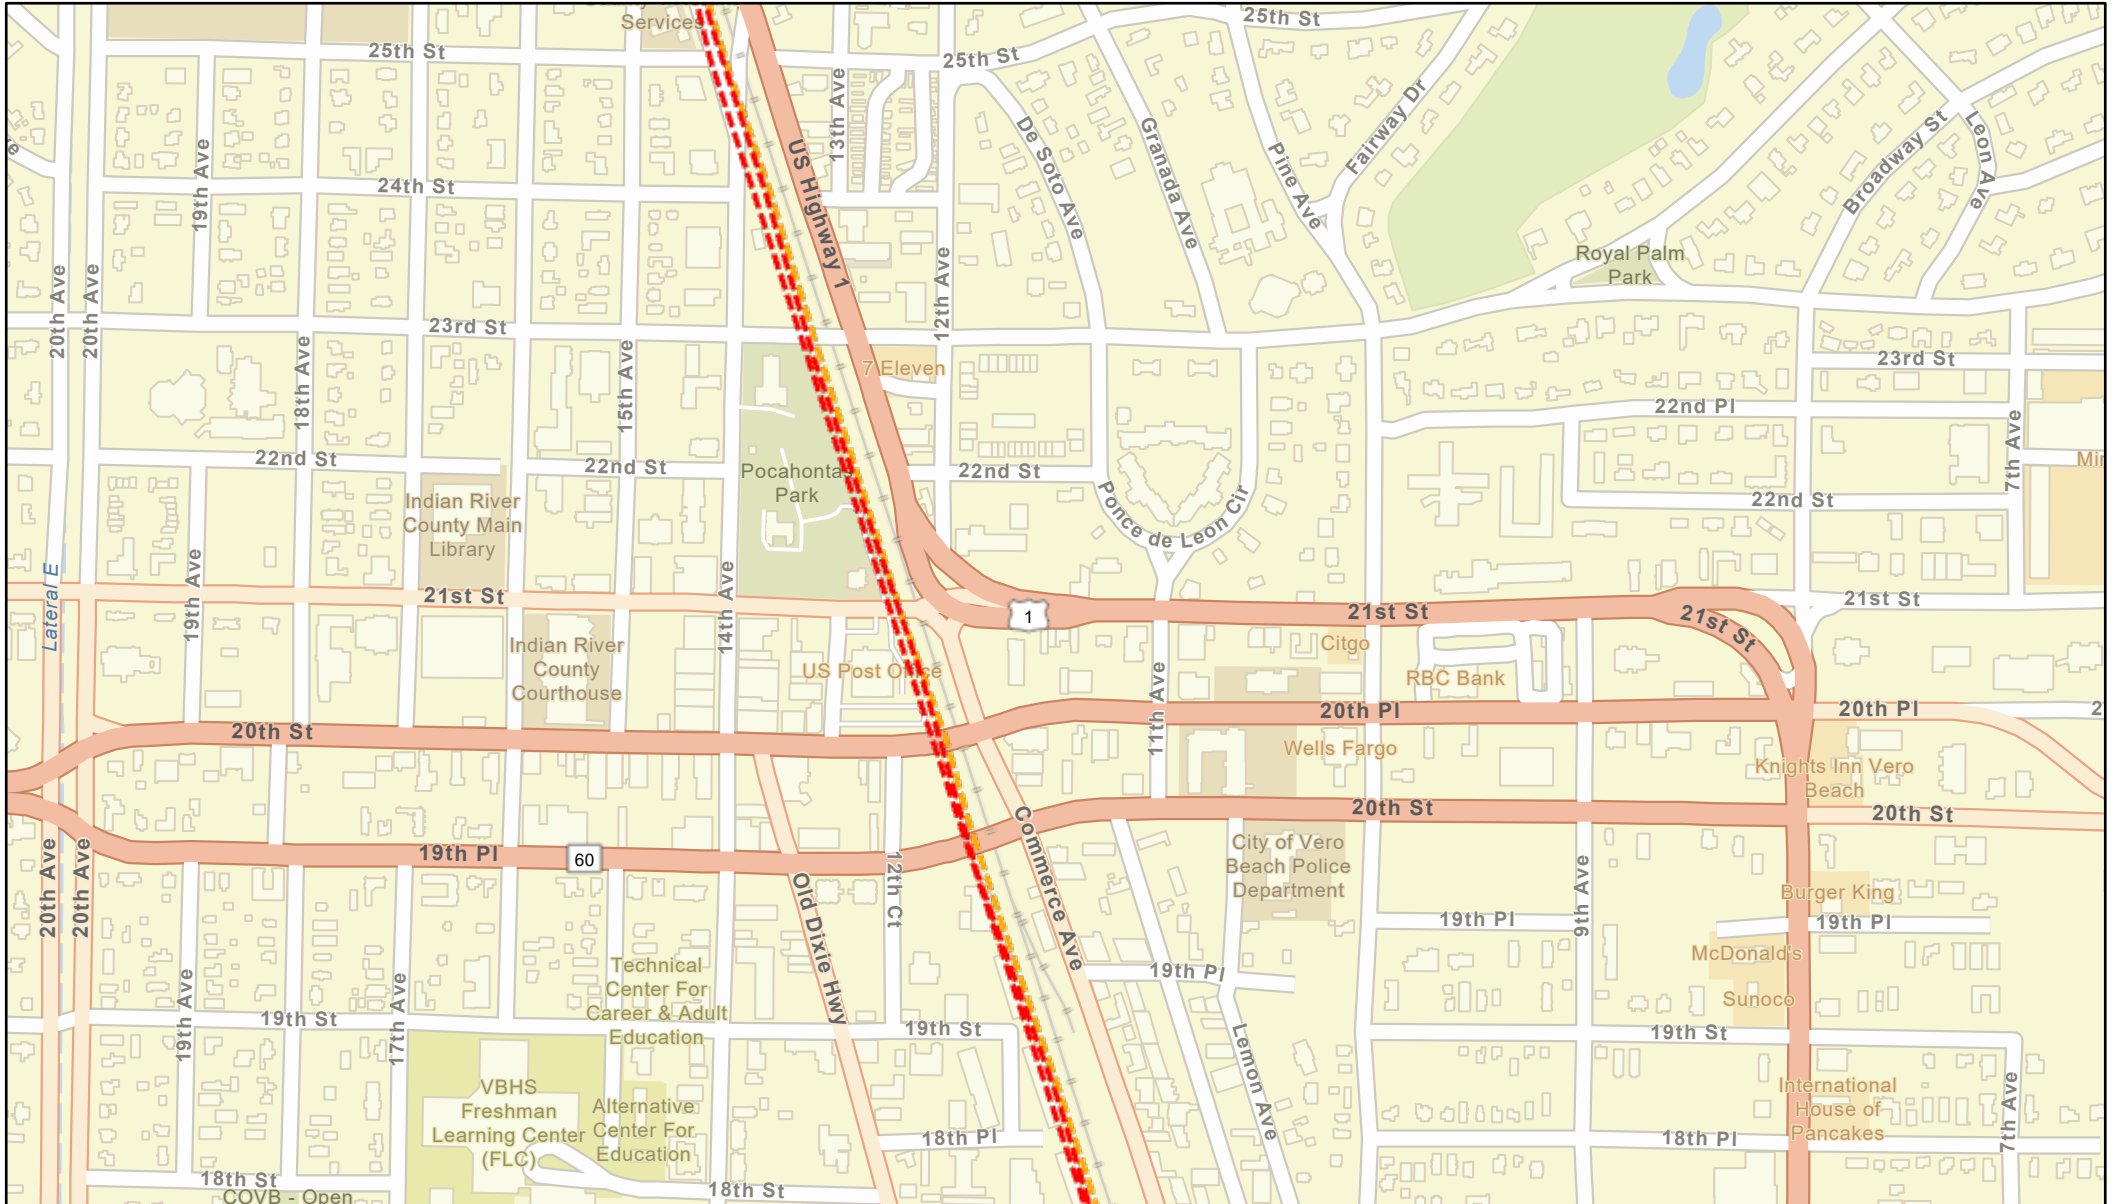

5/29/2023, 4:13:42 PM

Routes Leased

Routes Owned

- - - LONGHAUL, UNDERGROUND    
 - - - LONGHAUL, UNDERGROUND

1:8,025

0 0.05 0.1 0.2 mi

0 0.07 0.15 0.3 km

Esri Community Maps Contributors, Indian River County, FDEP, © OpenStreetMap, Microsoft, Esri, HERE, Garmin, SafeGraph, GeoTechnologies, Inc, METI/NASA, USGS, EPA, NPS, US Census Bureau, USDA



© map data Lumen

INTERNAL USE ONLY: This map data is for internal LUMEN use only and is NOT to be disseminated outside of LUMEN without authorization from RISK MANAGEMENT. Dissemination of this data outside of LUMEN without authorization will be considered a violation of company policy.

**Appendix D**

**Resurgence Infrastructure Group**

Intermetro Fiber (Resurgence/Allied AF2072) owns a 528 fiber cable in a 1.5" HDPE shared FECR Duct Bank. We are on the West side of the tracks, generally within 50' of the tracks, parallel to the tracks and do not exit FEC RR ROW. We will mark our facilities when tickets are called in.

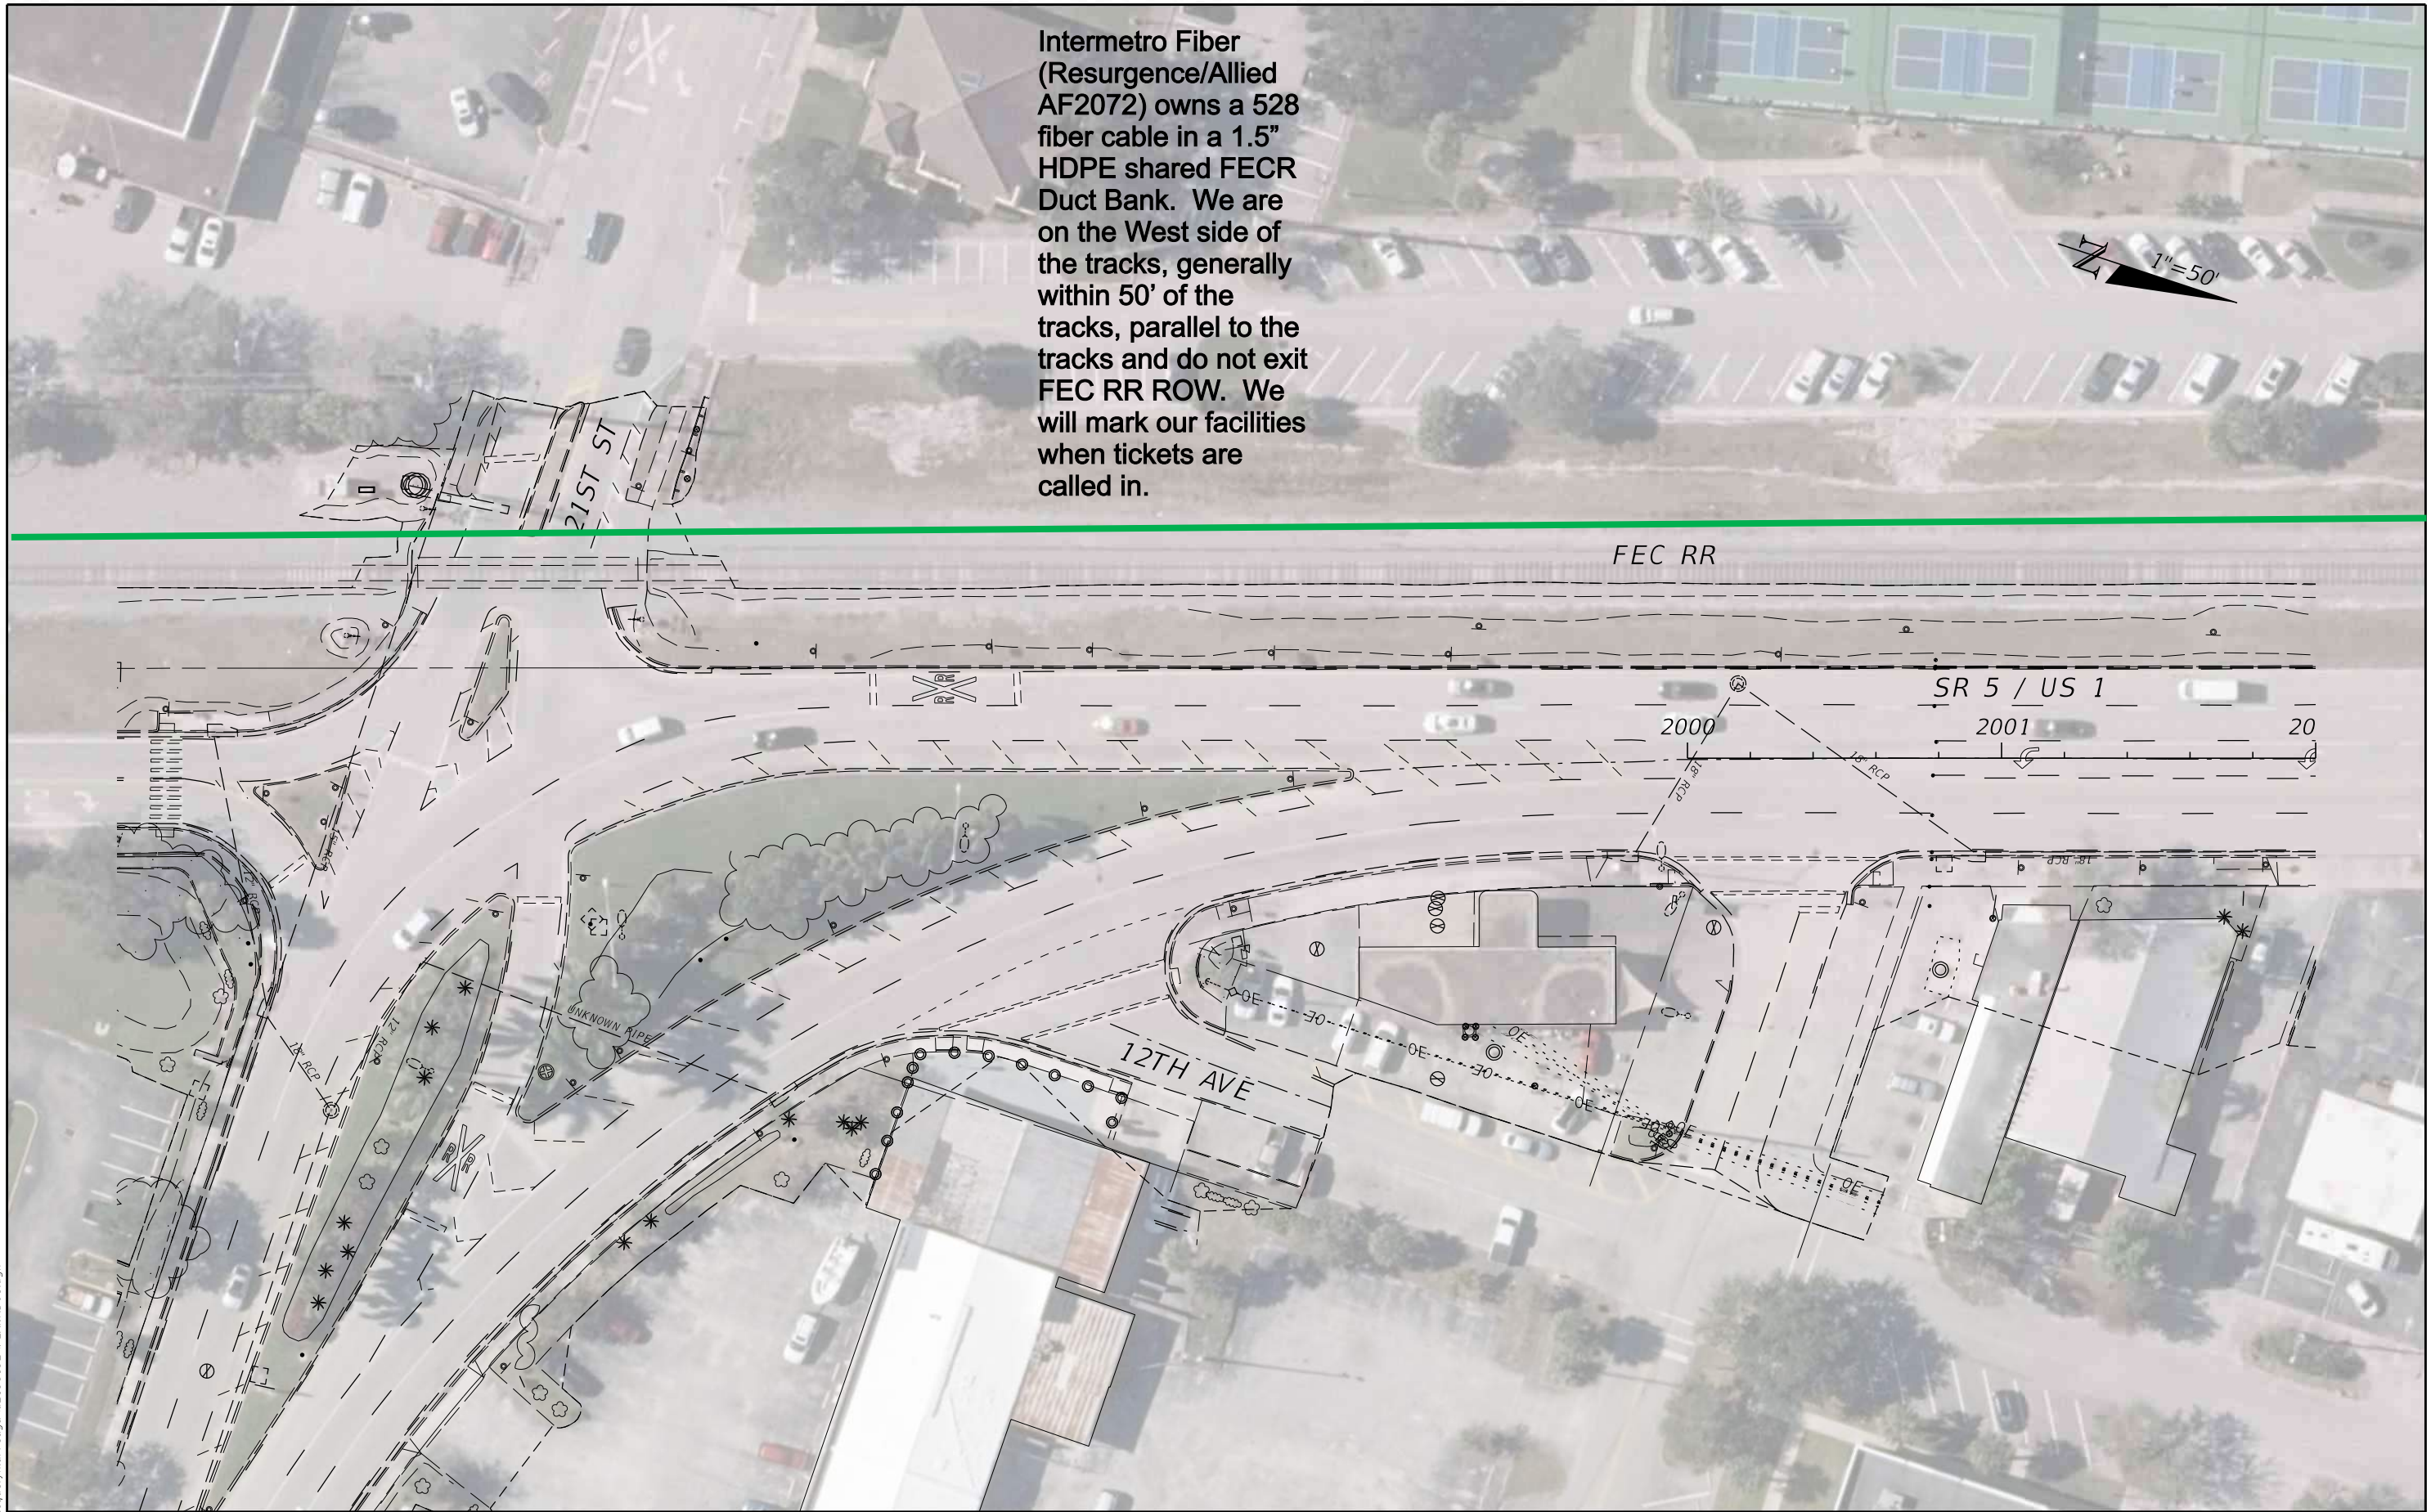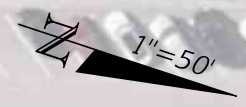


9/15/2022 10:58:52 AM Jacquelyn.Arreaga c:\pwworking\wgi\jacquelyn.arreaga\d2198192\PLANRD01.dgn

REVISIONS		PROFESSIONAL TYPE		STATE OF FLORIDA DEPARTMENT OF TRANSPORTATION			SHEET NO.
DATE	DESCRIPTION	DATE	DESCRIPTION	ROAD NO.	COUNTY	FINANCIAL PROJECT ID	
				SR 5	INDIAN RIVER	441693-1-22-02	1

**UTILITY CONTACT PLAN (1)**

THE OFFICIAL RECORD OF THIS SHEET IS THE ELECTRONIC FILE DIGITALLY SIGNED AND SEALED UNDER RULE 61G15-23.004, F.A.C.

Intermetro Fiber (Resurgence/Allied AF2072) owns a 528 fiber cable in a 1.5" HDPE shared FECR Duct Bank. We are on the West side of the tracks, generally within 50' of the tracks, parallel to the tracks and do not exit FEC RR ROW. We will mark our facilities when tickets are called in.

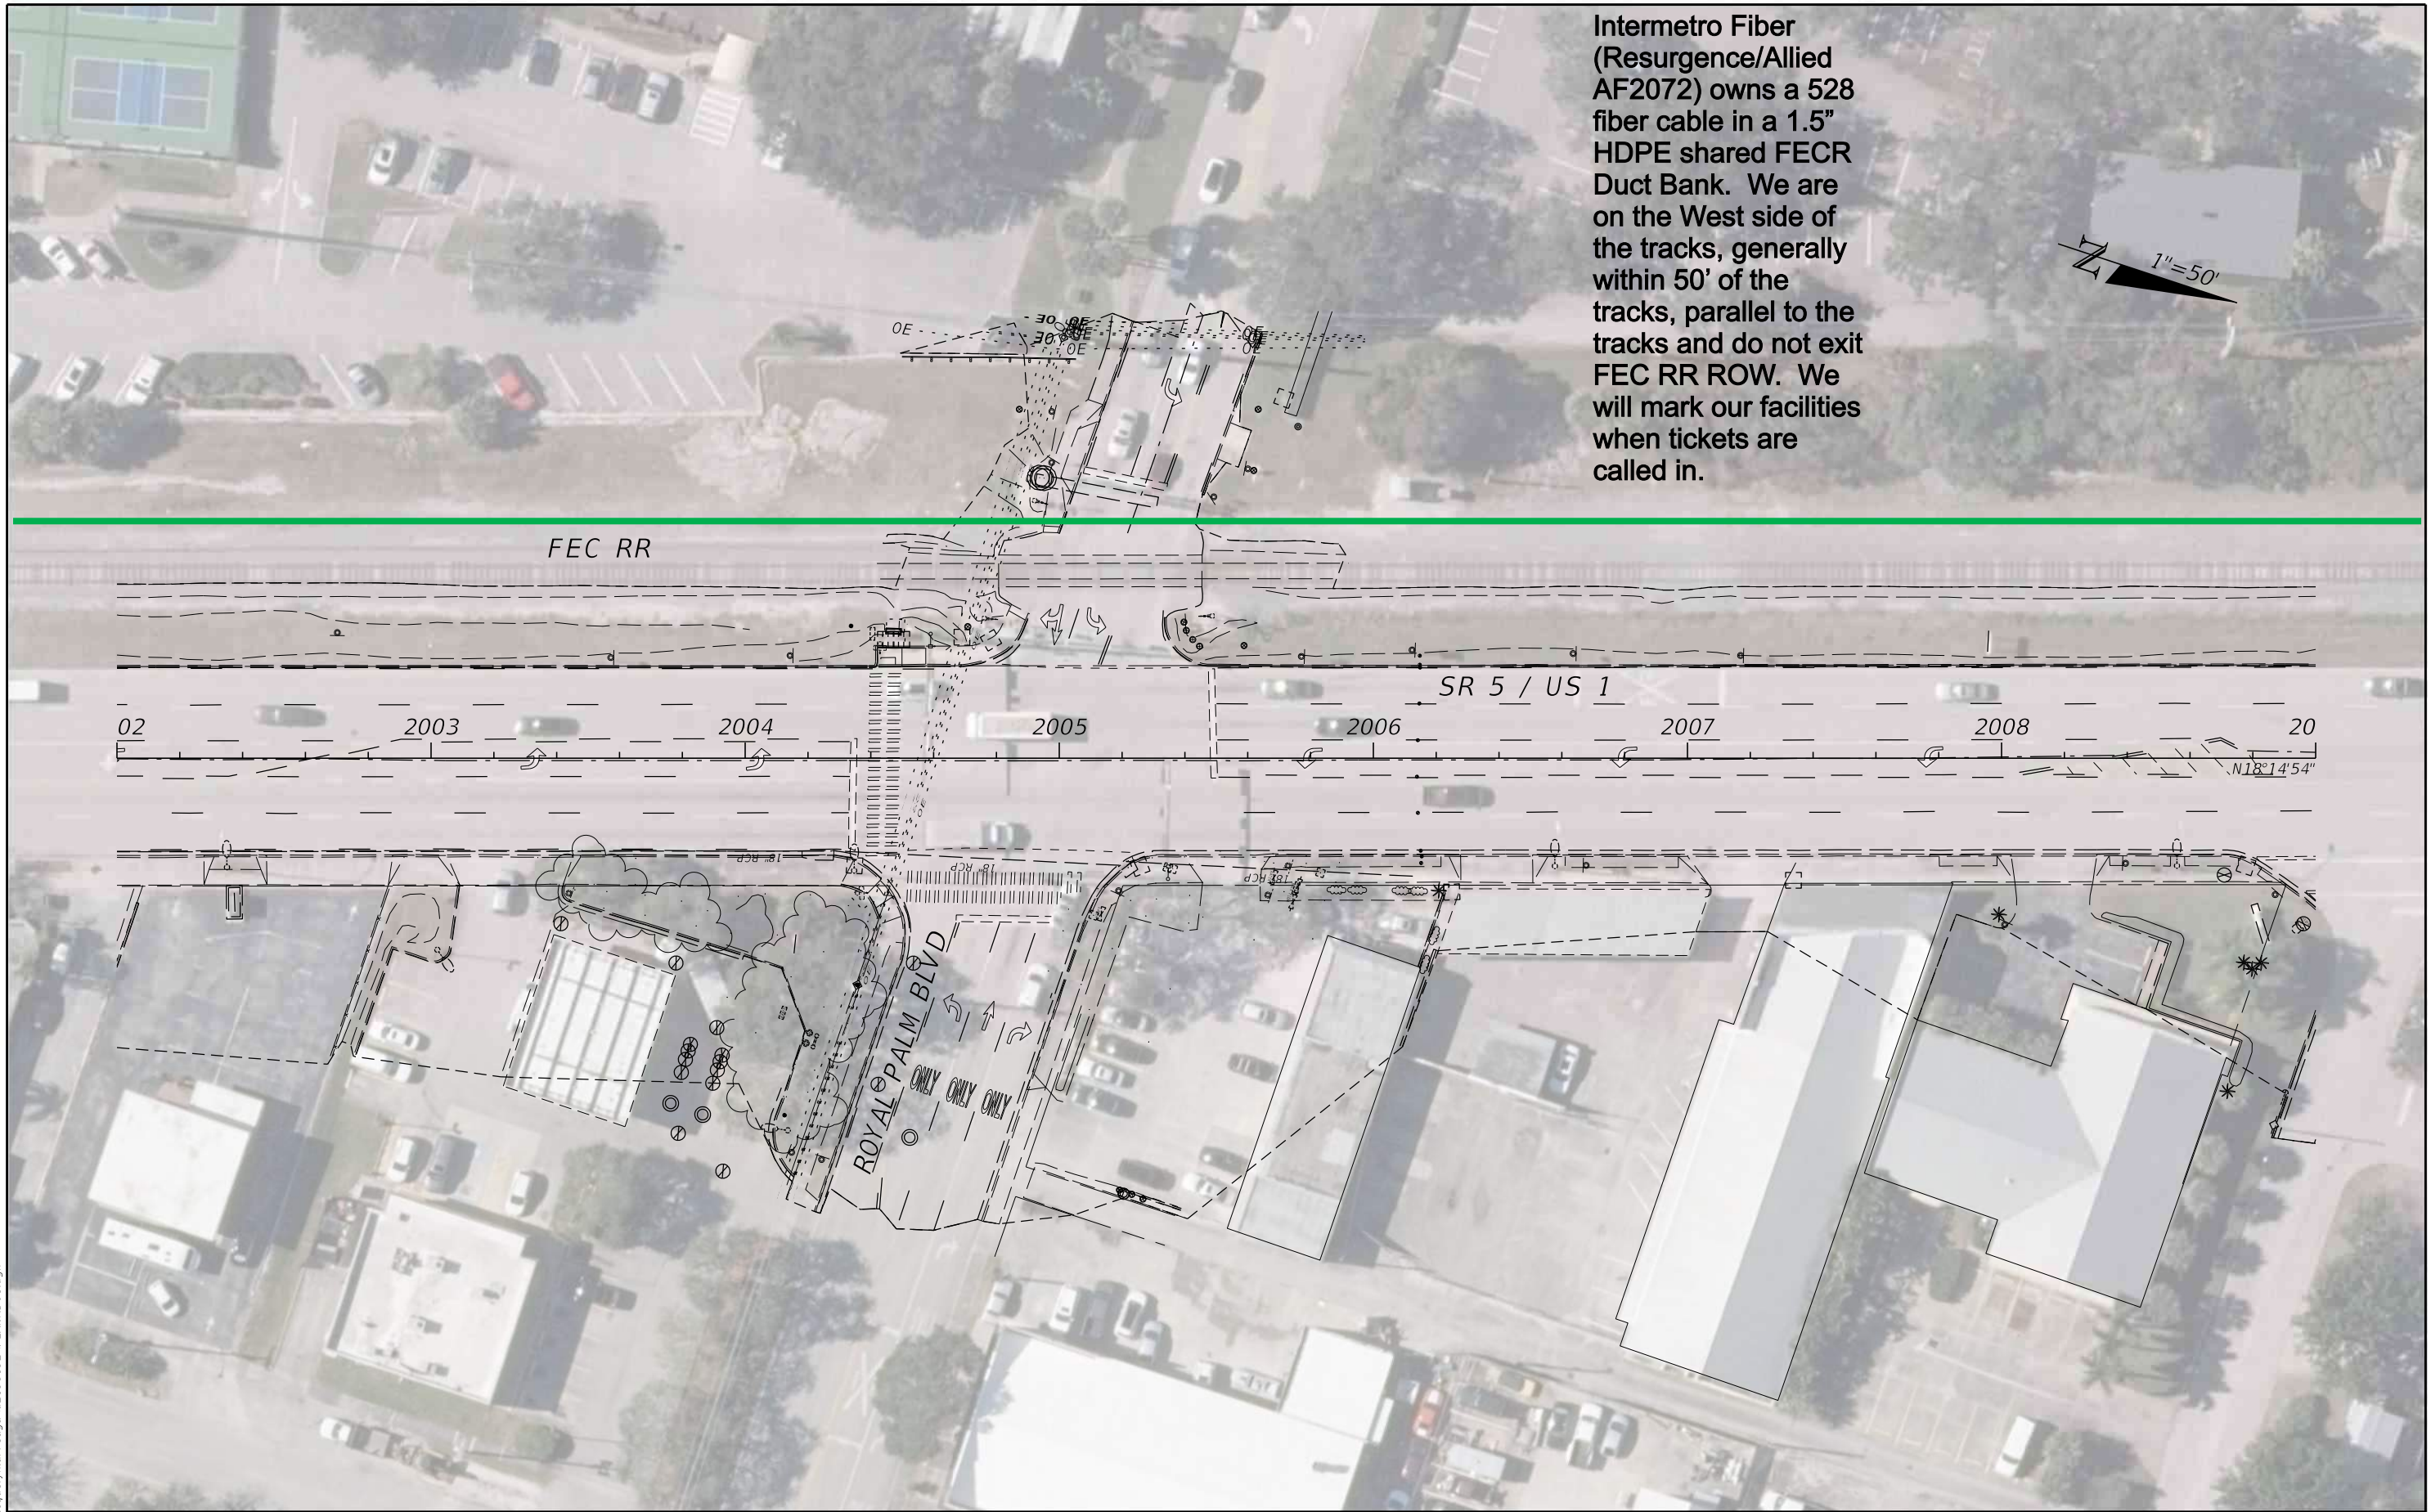



9/15/2022 10:59:58 AM Jacquelyn.Arreaga c:\pwworking\wgn\jacquelyn.arreaga\d2198192\PLANRD01.dgn

THE OFFICIAL RECORD OF THIS SHEET IS THE ELECTRONIC FILE DIGITALLY SIGNED AND SEALED UNDER RULE 61G15-23.004, F.A.C.

DATE		REVISIONS		PROFESSIONAL TYPE		STATE OF FLORIDA DEPARTMENT OF TRANSPORTATION			SHEET NO.
DATE	DESCRIPTION	DATE	DESCRIPTION			ROAD NO.	COUNTY	FINANCIAL PROJECT ID	
				WILLIAM EVANS LICENSE NUMBER: 45207 WGI, INC. 2035 VISTA PARKWAY WEST PALM BEACH, FL 33411		SR 5	INDIAN RIVER	441693-1-22-02	2
<b>UTILITY CONTACT PLAN (2)</b>									



Intermetro Fiber (Resurgence/Allied AF2072) owns a 528 fiber cable in a 1.5" HDPE shared FECR Duct Bank. We are on the West side of the tracks, generally within 50' of the tracks, parallel to the tracks and do not exit FEC RR ROW. We will mark our facilities when tickets are called in.

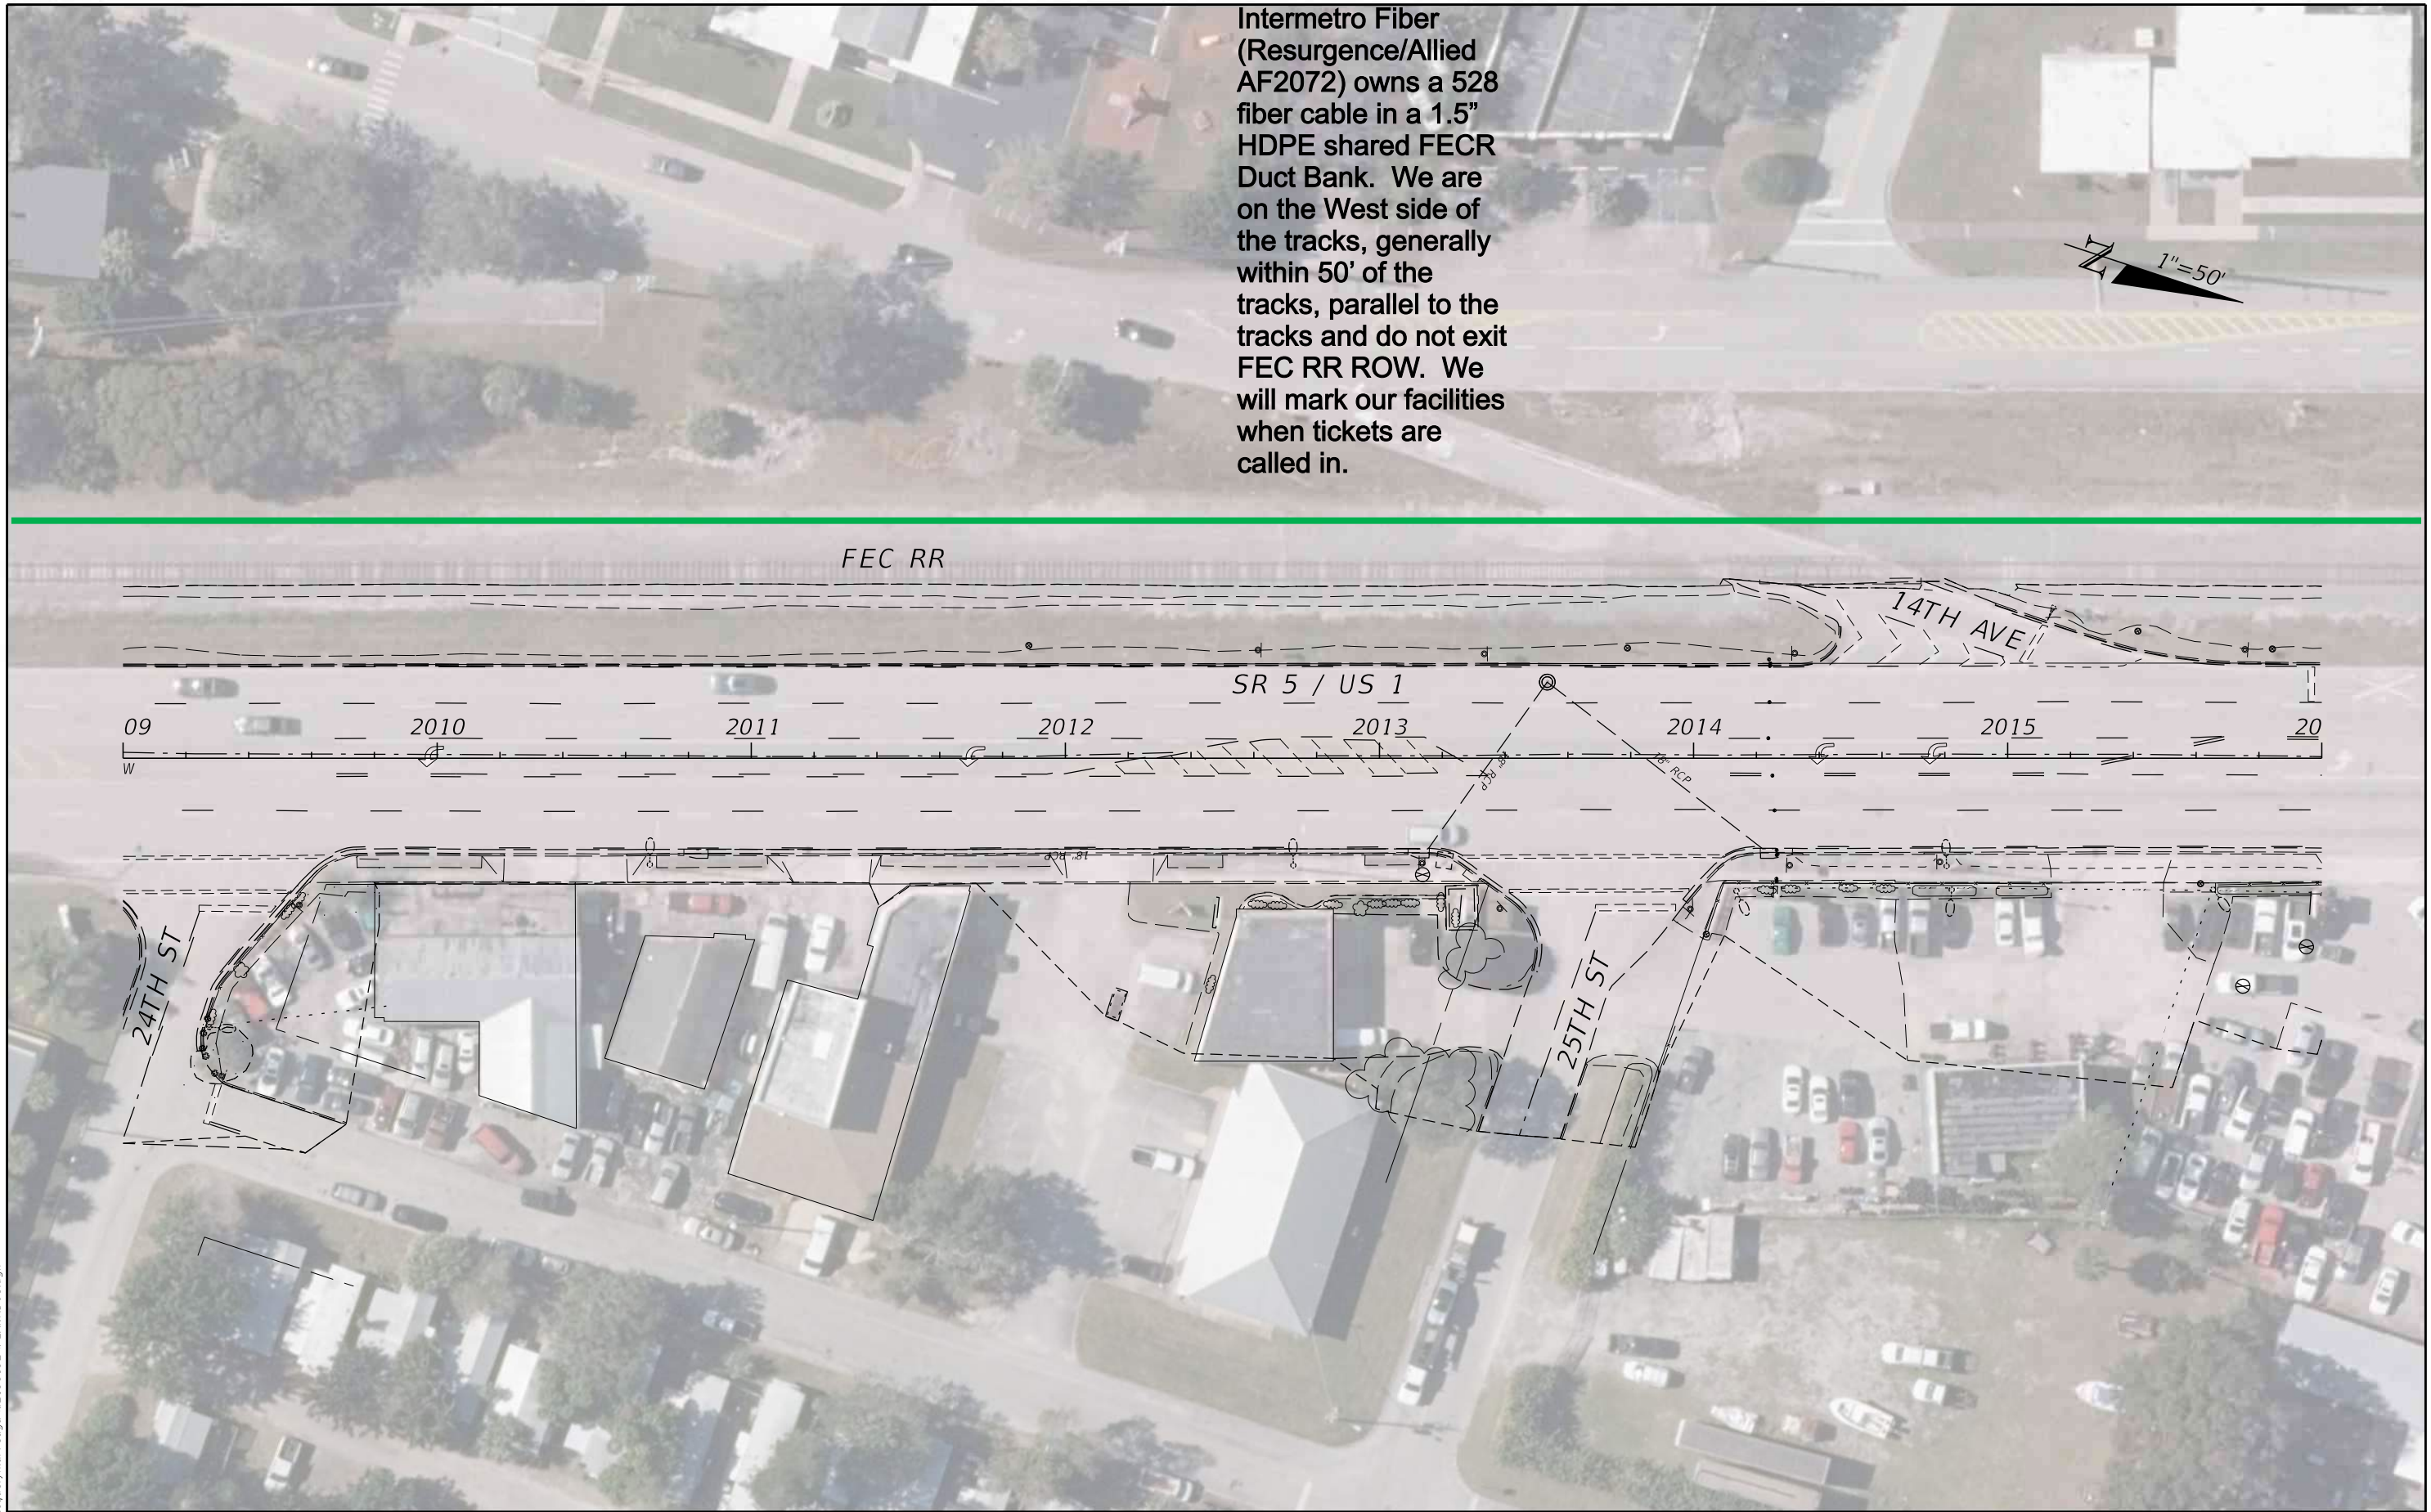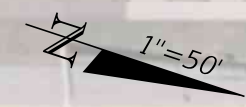


9/15/2022 11:00:13 AM Jacquelyn.Arreaga c:\pwworking\wg\N\Jacquelyn.arreaga\d2198192\PLAN\RD01.dgn

DATE		REVISIONS		PROFESSIONAL TYPE	STATE OF FLORIDA DEPARTMENT OF TRANSPORTATION			SHEET NO.
DATE	DESCRIPTION	DATE	DESCRIPTION		ROAD NO.	COUNTY	FINANCIAL PROJECT ID	
				WILLIAM EVANS LICENSE NUMBER: 45207 WGI, INC. 2035 VISTA PARKWAY WEST PALM BEACH, FL 33411	SR 5	INDIAN RIVER	441693-1-22-02	3

**UTILITY CONTACT PLAN (3)**

THE OFFICIAL RECORD OF THIS SHEET IS THE ELECTRONIC FILE DIGITALLY SIGNED AND SEALED UNDER RULE 61G15-23.004, F.A.C.

Intermetro Fiber (Resurgence/Allied AF2072) owns a 528 fiber cable in a 1.5" HDPE shared FECR Duct Bank. We are on the West side of the tracks, generally within 50' of the tracks, parallel to the tracks and do not exit FEC RR ROW. We will mark our facilities when tickets are called in.

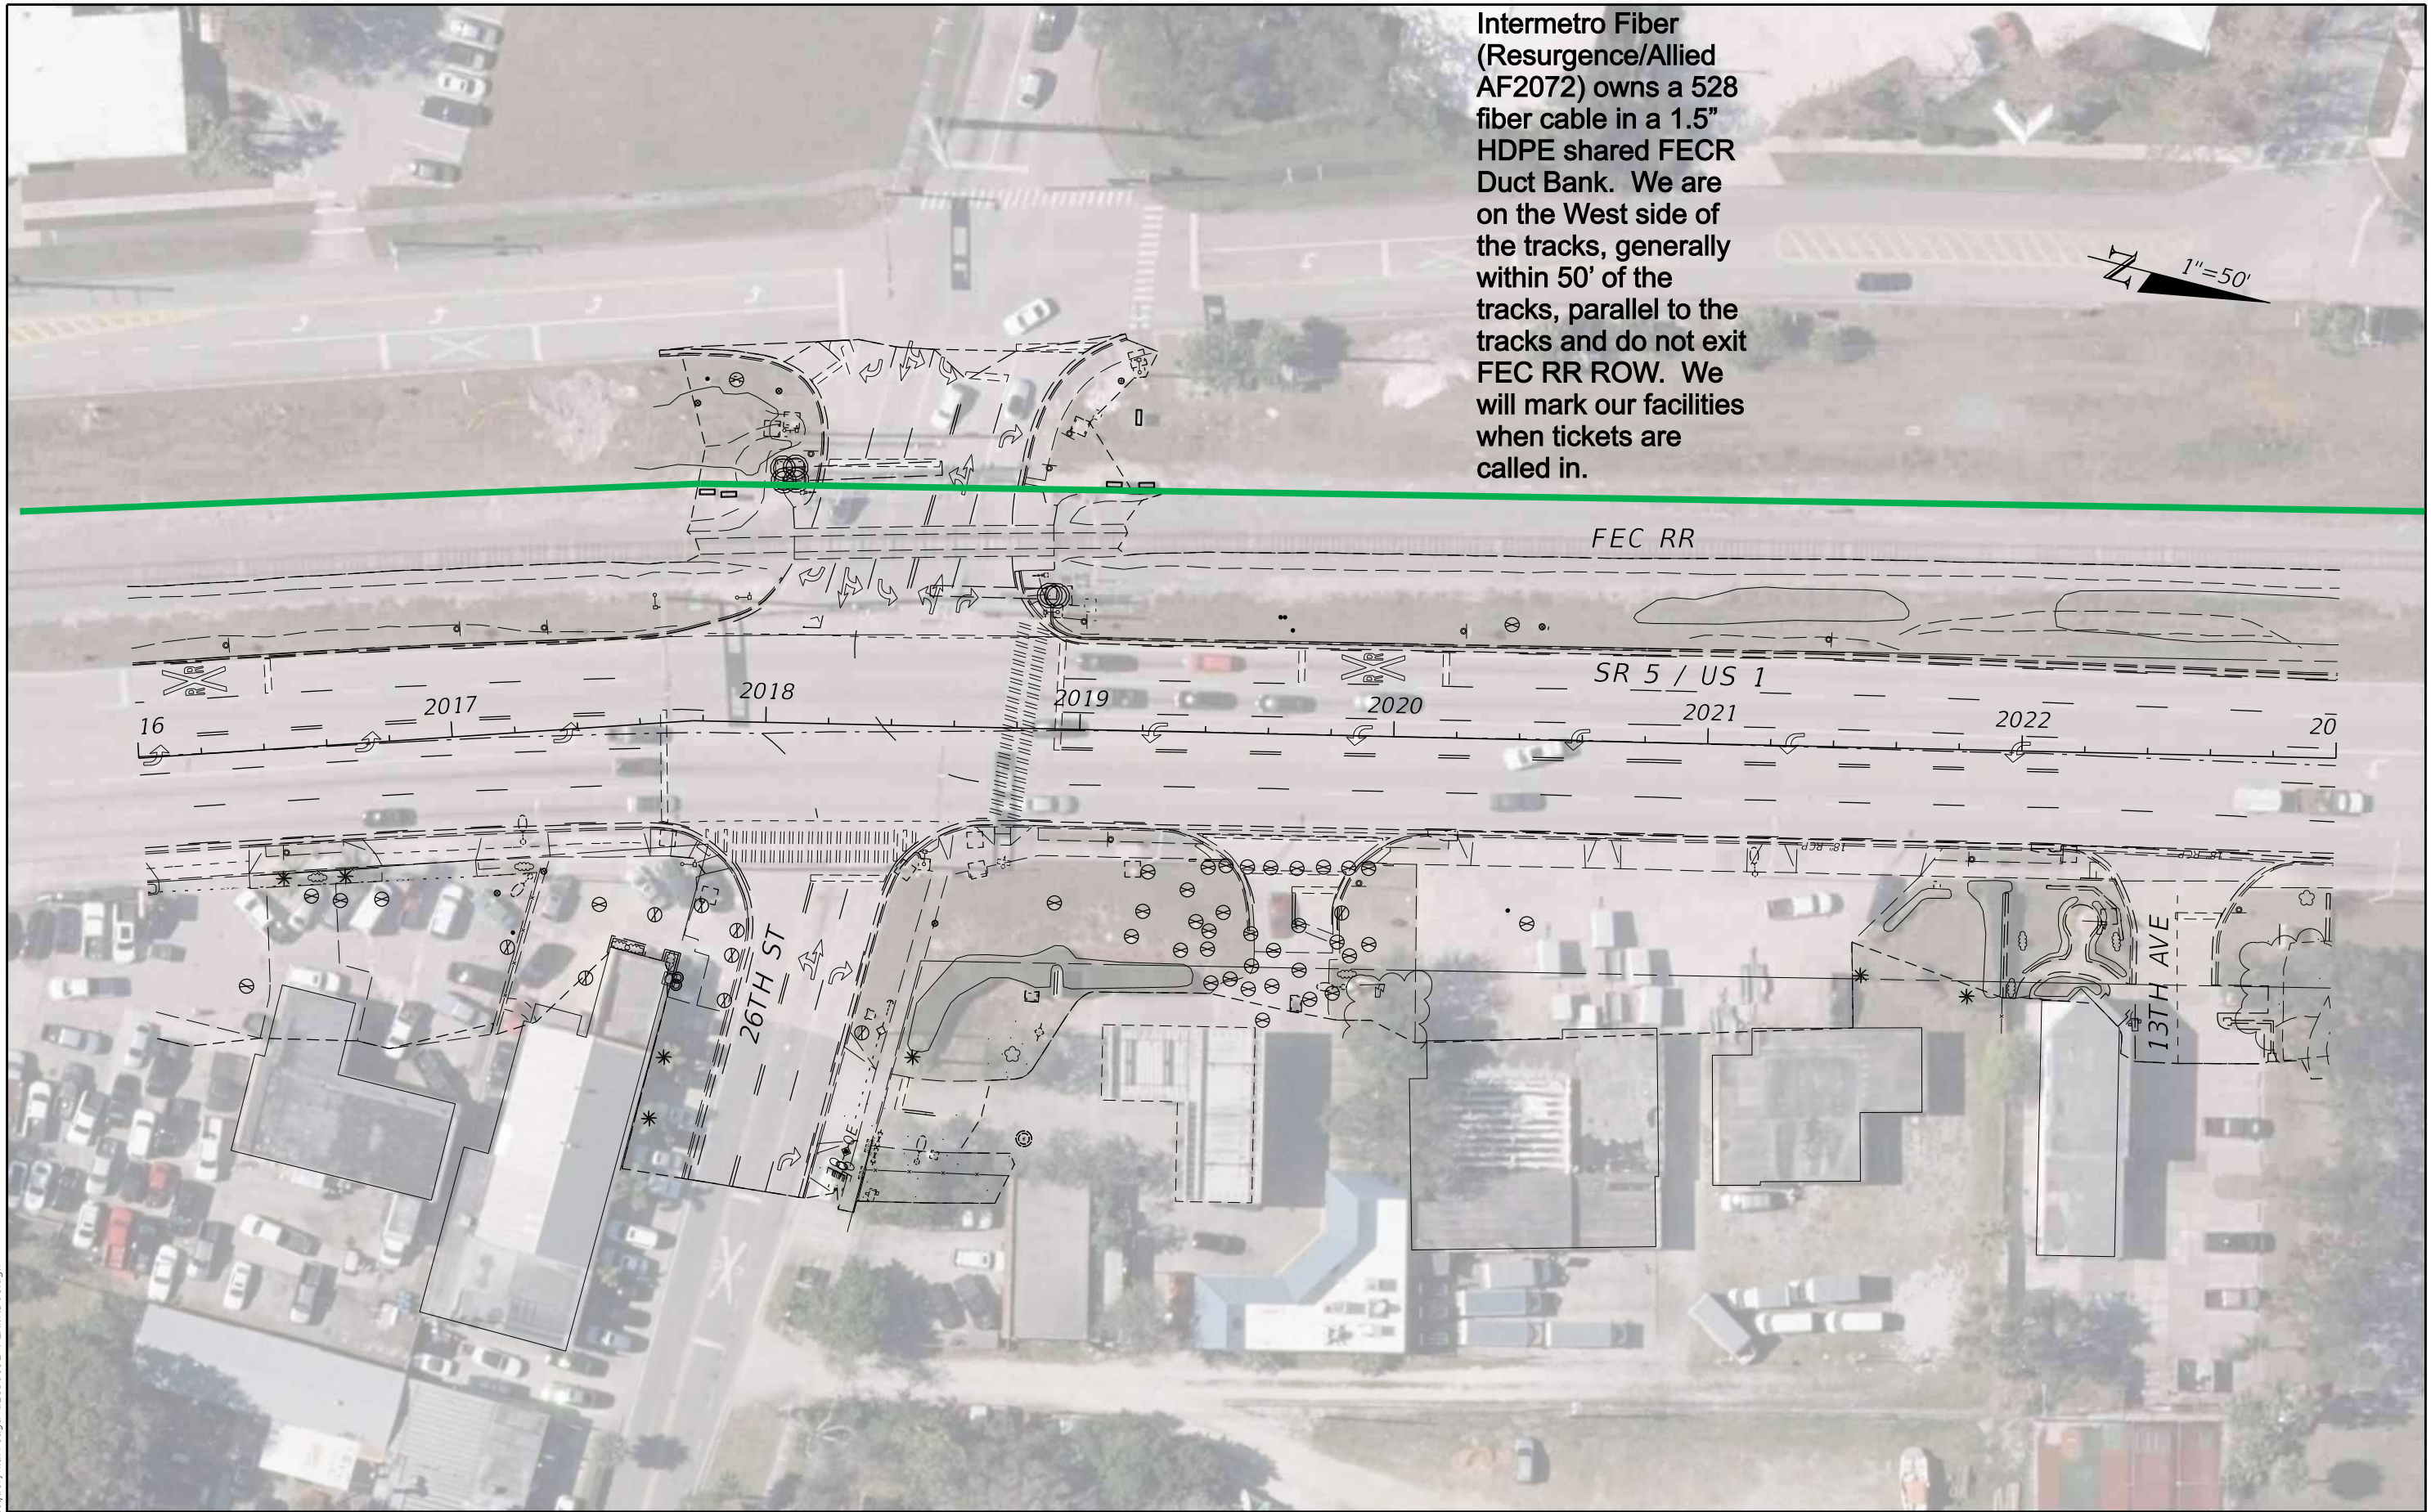

9/15/2022 11:00:42 AM Jacquelyn.Arreaga c:\pwworking\wgn\jacquelyn.arreaga\d2198192\PLANRD01.dgn



THE OFFICIAL RECORD OF THIS SHEET IS THE ELECTRONIC FILE DIGITALLY SIGNED AND SEALED UNDER RULE 61G15-23.004, F.A.C.

REVISIONS		PROFESSIONAL TYPE		STATE OF FLORIDA DEPARTMENT OF TRANSPORTATION			SHEET NO.
DATE	DESCRIPTION	DATE	DESCRIPTION	ROAD NO.	COUNTY	FINANCIAL PROJECT ID	
				SR 5	INDIAN RIVER	441693-1-22-02	4

**UTILITY CONTACT PLAN (4)**

WILLIAM EVANS  
LICENSE NUMBER: 45207  
WGI, INC.  
2035 VISTA PARKWAY  
WEST PALM BEACH, FL 33411

Intermetro Fiber (Resurgence/Allied AF2072) owns a 528 fiber cable in a 1.5" HDPE shared FECR Duct Bank. We are on the West side of the tracks & crossover to East side at 29th st, generally within 50' of the tracks, parallel to the tracks and do not exit FEC RR ROW. We will mark our facilities when tickets are called in.

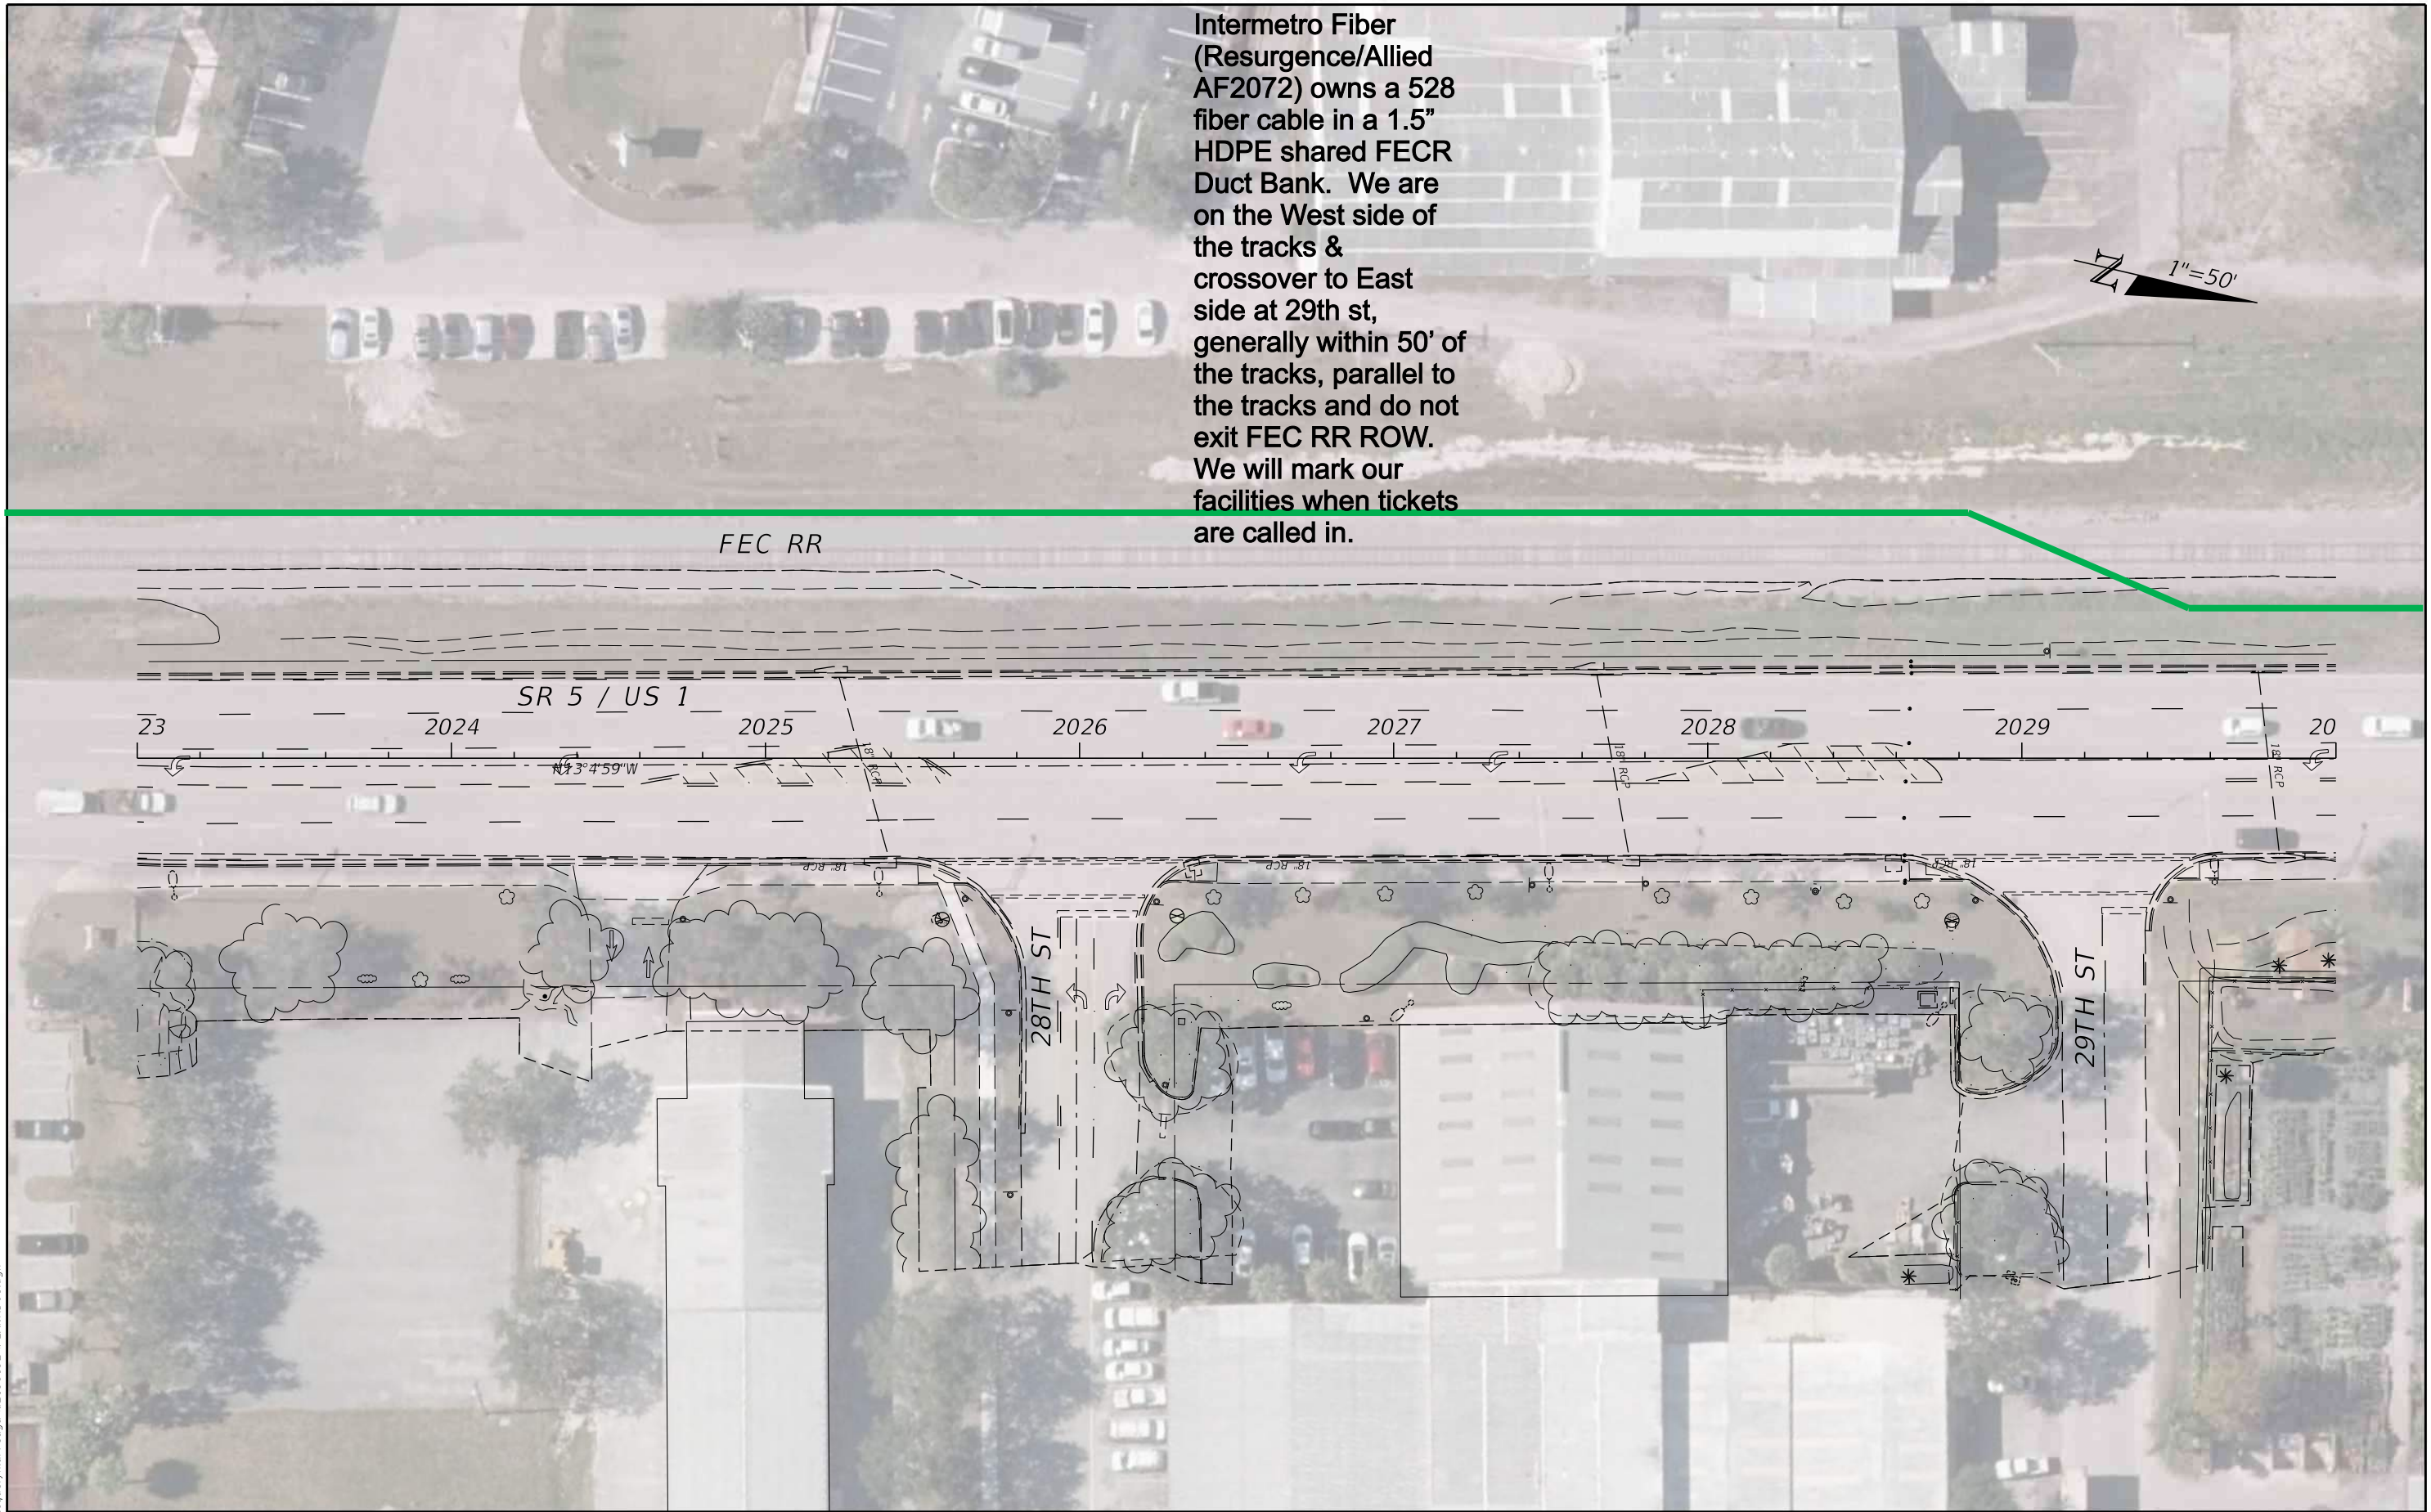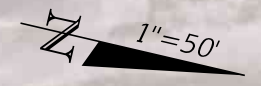

9/15/2022 11:00:51 AM Jacquelyn.Arreaga c:\pwworking\wgn\jacquelyn.arreaga\d2198192\PLANRD01.dgn


REVISIONS				PROFESSIONAL TYPE	STATE OF FLORIDA DEPARTMENT OF TRANSPORTATION			SHEET NO.
DATE	DESCRIPTION	DATE	DESCRIPTION		ROAD NO.	COUNTY	FINANCIAL PROJECT ID	
				WILLIAM EVANS LICENSE NUMBER: 45207 WGI, INC. 2035 VISTA PARKWAY WEST PALM BEACH, FL 33411	SR 5	INDIAN RIVER	441693-1-22-02	5

**UTILITY CONTACT PLAN (5)**

THE OFFICIAL RECORD OF THIS SHEET IS THE ELECTRONIC FILE DIGITALLY SIGNED AND SEALED UNDER RULE 61G15-23.004, F.A.C.

Intermetro Fiber (Resurgence/Allied AF2072) owns a 528 fiber cable in a 1.5" HDPE shared FECR Duct Bank. We are on the East side of the tracks, generally within 50' of the tracks, parallel to the tracks and do not exit FEC RR ROW. We will mark our facilities when tickets are called in.

CITY OF VERO BEACH AIRPORT

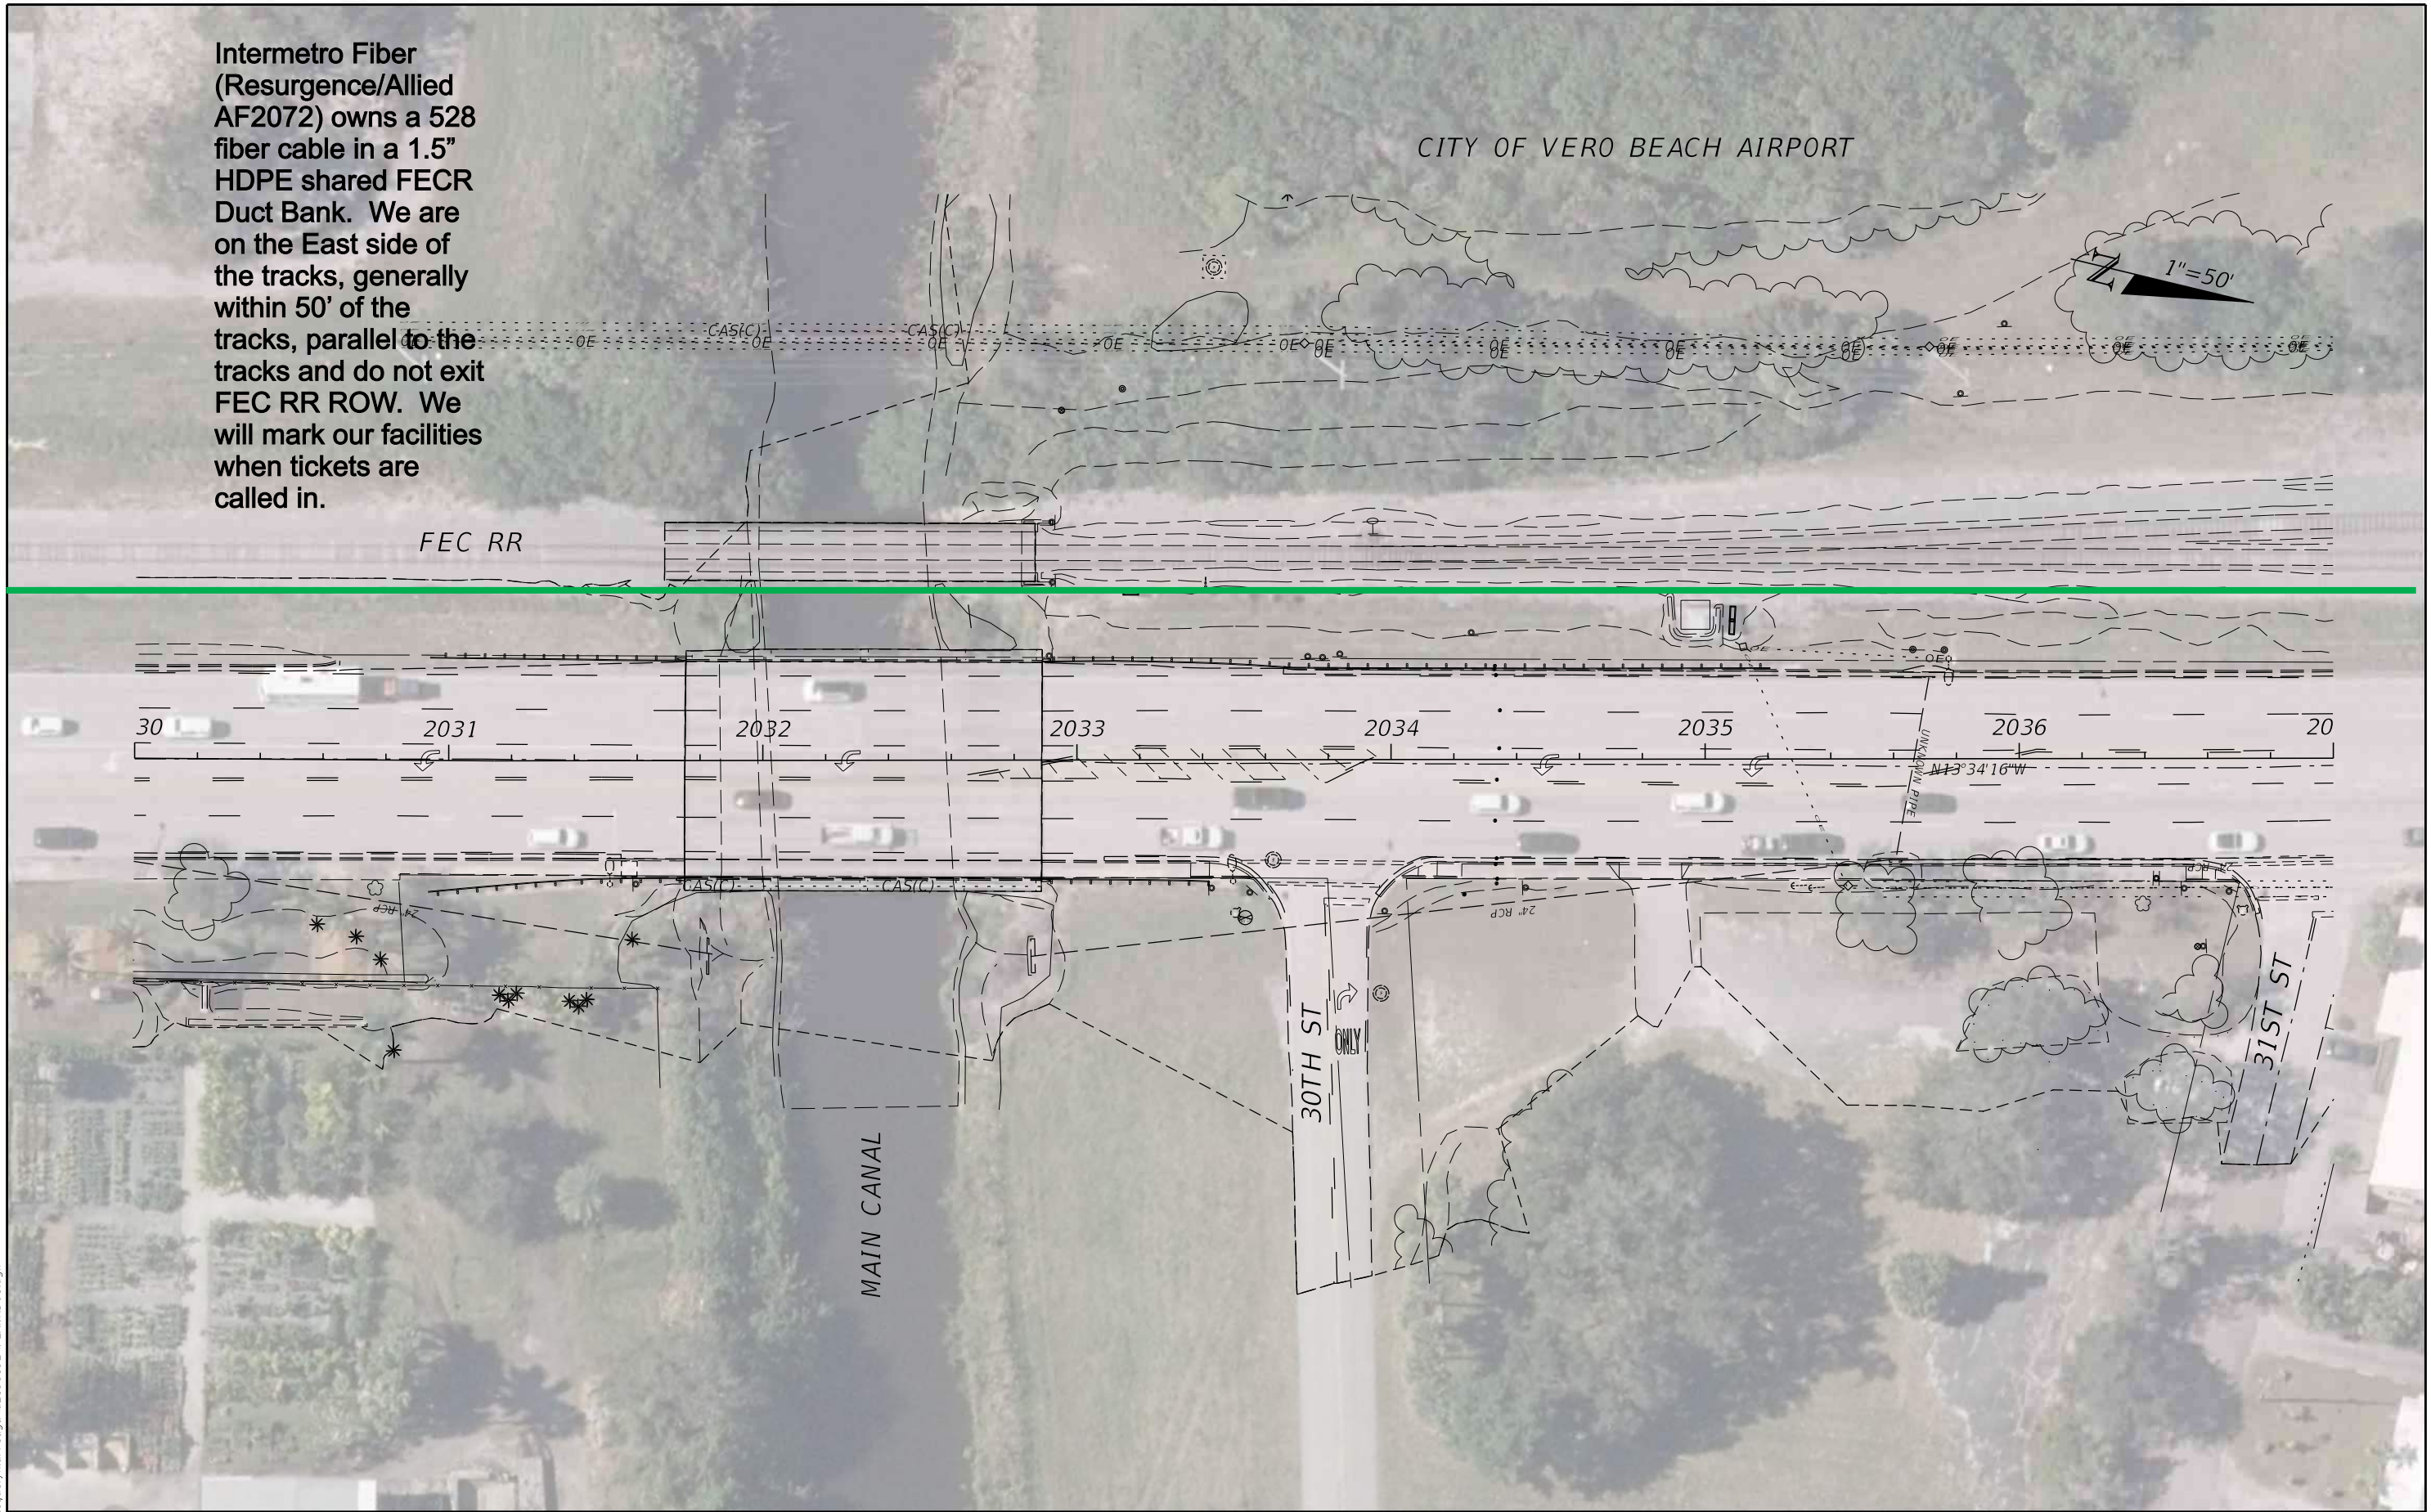


9/15/2022 11:01:04 AM Jacquelyn.Arreaga c:\pwworking\wgn\jacquelyn.arreaga\d2198192\PLANRD01.dgn


REVISIONS		PROFESSIONAL TYPE		STATE OF FLORIDA DEPARTMENT OF TRANSPORTATION			SHEET NO.
DATE	DESCRIPTION	DATE	DESCRIPTION	ROAD NO.	COUNTY	FINANCIAL PROJECT ID	
				SR 5	INDIAN RIVER	441693-1-22-02	6

**UTILITY CONTACT PLAN (6)**

THE OFFICIAL RECORD OF THIS SHEET IS THE ELECTRONIC FILE DIGITALLY SIGNED AND SEALED UNDER RULE 61G15-23.004, F.A.C.

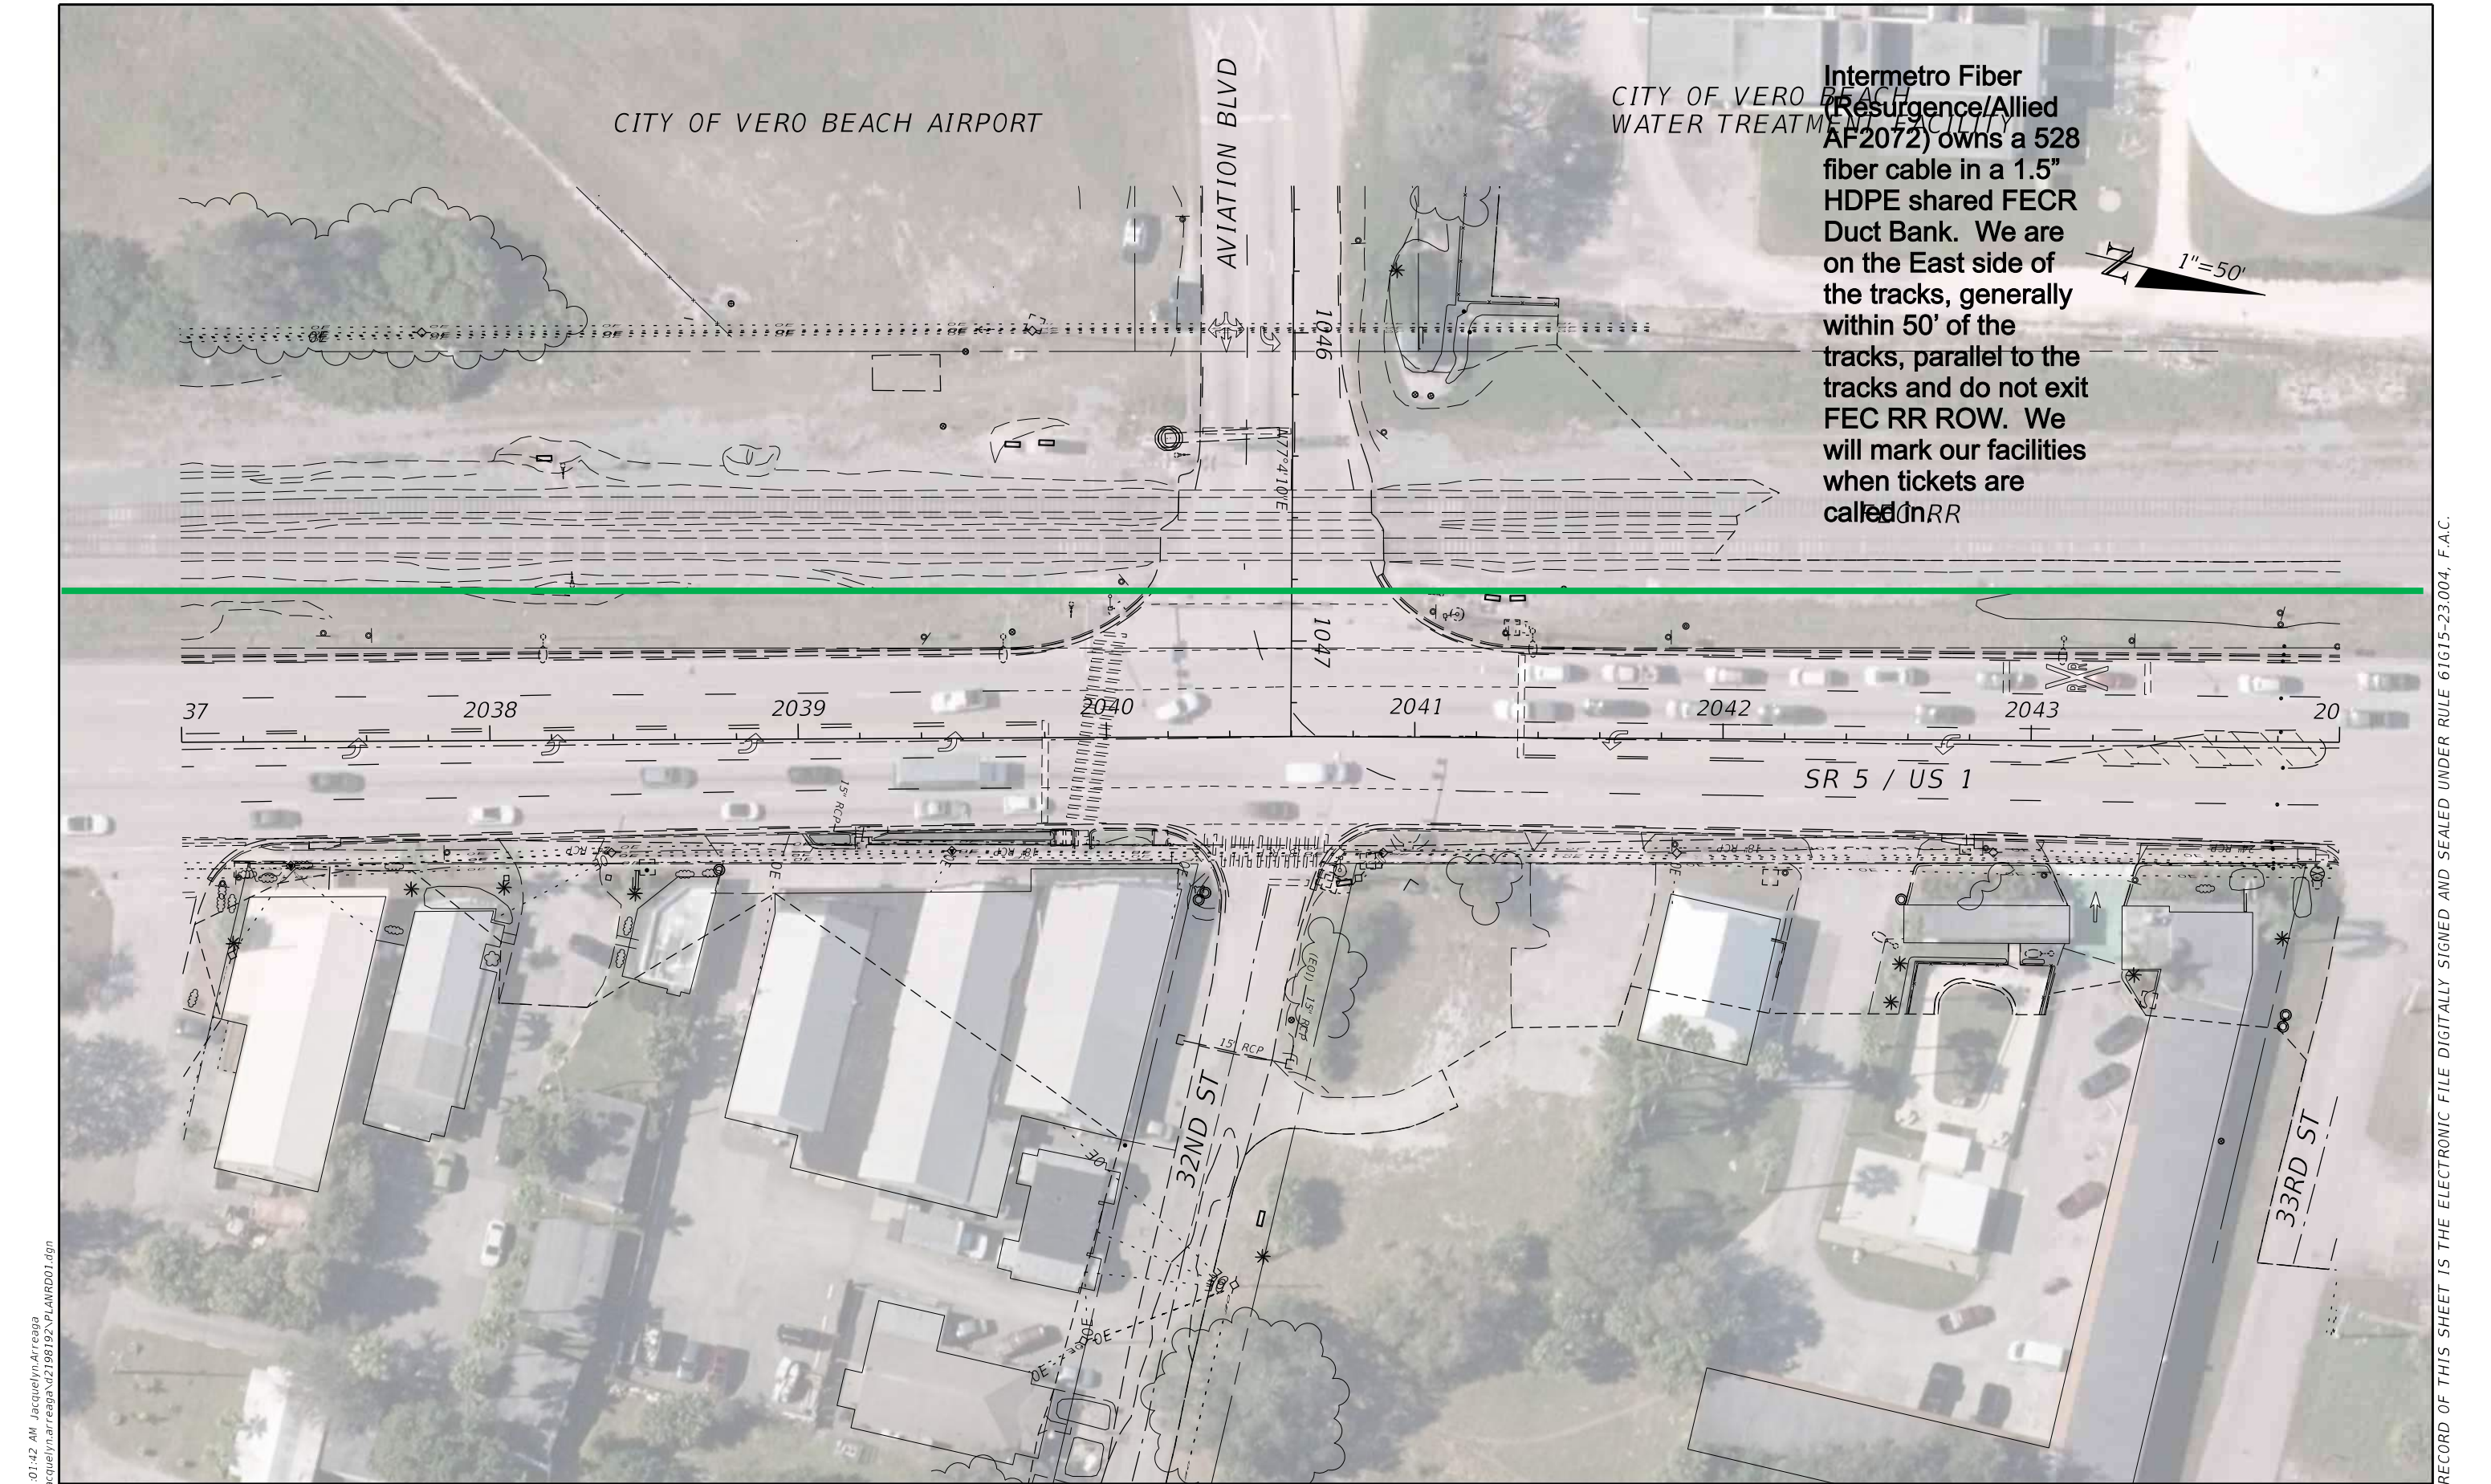

Intermetro Fiber (Resurgence/Allied AF2072) owns a 528 fiber cable in a 1.5" HDPE shared FECR Duct Bank. We are on the East side of the tracks, generally within 50' of the tracks, parallel to the tracks and do not exit FEC RR ROW. We will mark our facilities when tickets are called in RR

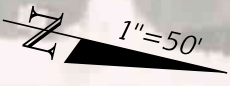

9/15/2022 11:01:42 AM Jacquelyn.Arreaga c:\pwworking\wgn\jacquelyn.arreaga\d2198192\PLAN\RD01.dgn


REVISIONS		PROFESSIONAL TYPE		STATE OF FLORIDA DEPARTMENT OF TRANSPORTATION			SHEET NO.
DATE	DESCRIPTION	DATE	DESCRIPTION	ROAD NO.	COUNTY	FINANCIAL PROJECT ID	
				SR 5	INDIAN RIVER	441693-1-22-02	7

**UTILITY CONTACT PLAN (7)**

THE OFFICIAL RECORD OF THIS SHEET IS THE ELECTRONIC FILE DIGITALLY SIGNED AND SEALED UNDER RULE 61G15-23.004, F.A.C.

CITY OF VERO BEACH AIRPORT

Intermetro Fiber (Resurgence/Allied AF2072) owns a 528 fiber cable in a 1.5" HDPE shared FECR Duct Bank. We are on the East side of the tracks, generally within 50' of the tracks, parallel to the tracks and do not exit FEC RR ROW. We will mark our facilities when tickets are called in.

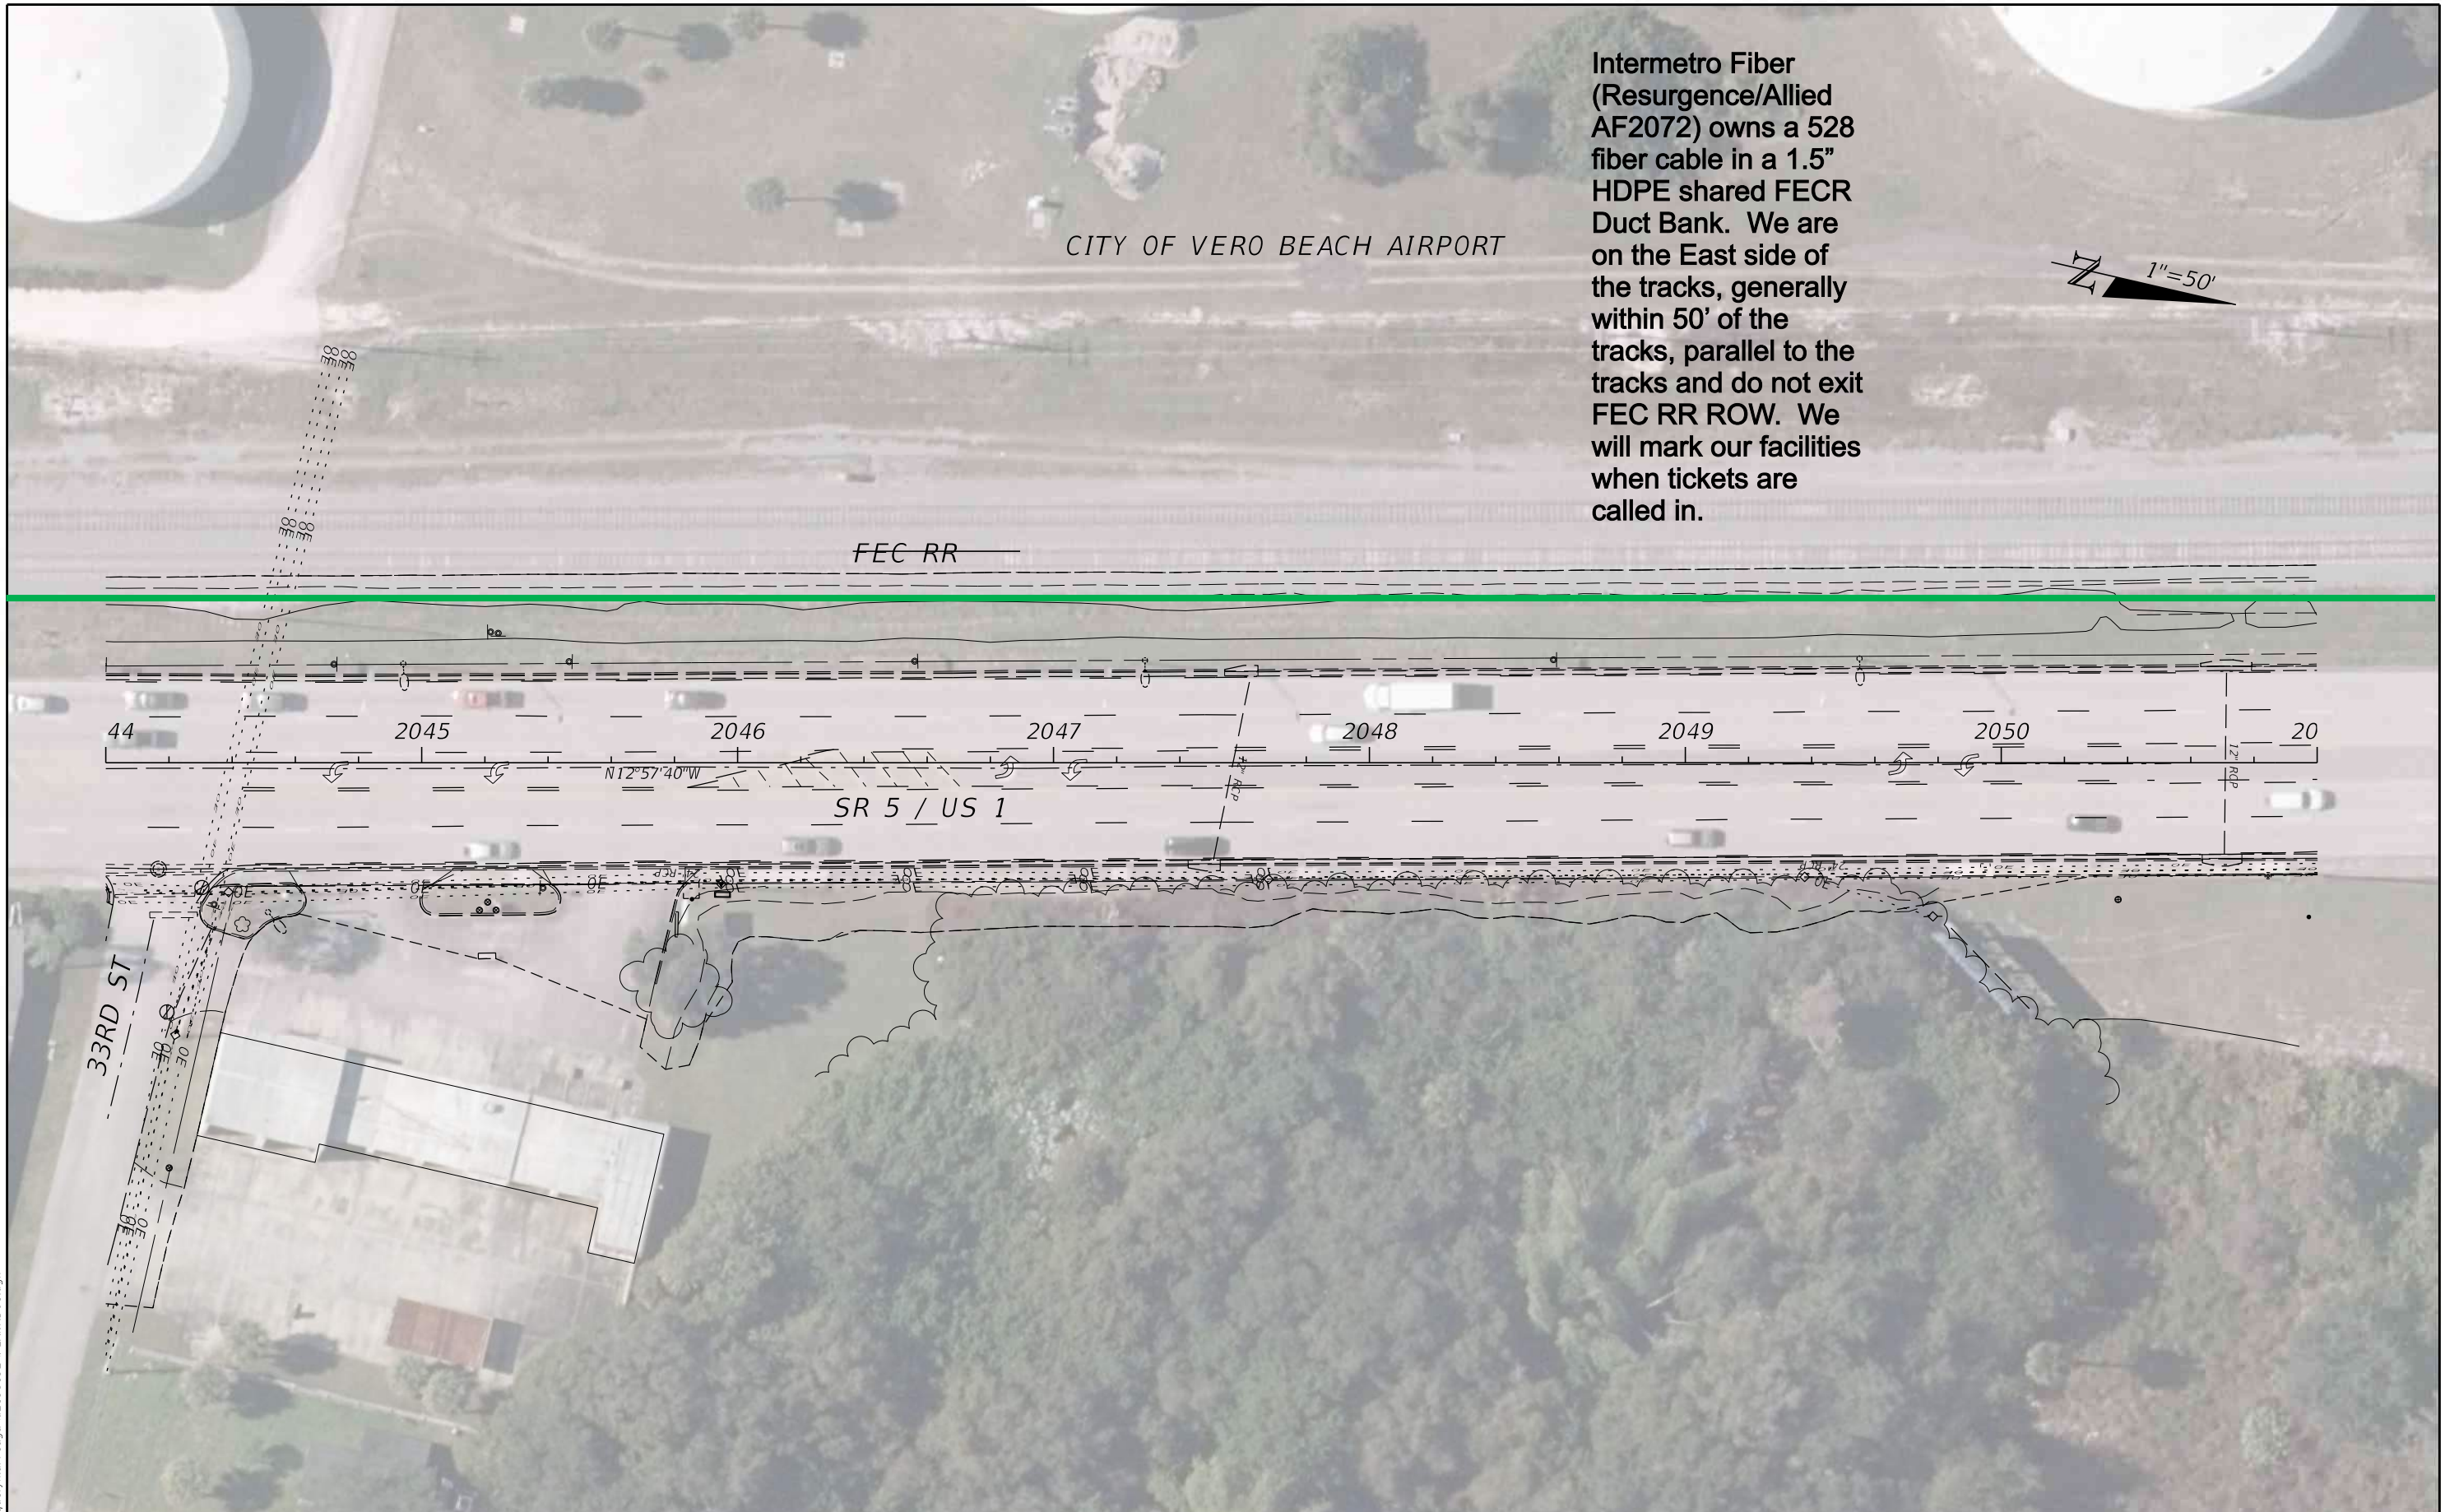

9/15/2022 11:02:24 AM Jacquelyn.Arreaga c:\pwworking\wg\Jacquelyn.arreaga\d2198192\PLANRD01.dgn

DATE		REVISIONS		PROFESSIONAL TYPE		STATE OF FLORIDA DEPARTMENT OF TRANSPORTATION			SHEET NO.
DATE	DESCRIPTION	DATE	DESCRIPTION			ROAD NO.	COUNTY	FINANCIAL PROJECT ID	
				WILLIAM EVANS LICENSE NUMBER: 45207 WGI, INC. 2035 VISTA PARKWAY WEST PALM BEACH, FL 33411		SR 5	INDIAN RIVER	441693-1-22-02	8

**UTILITY CONTACT PLAN (8)**

THE OFFICIAL RECORD OF THIS SHEET IS THE ELECTRONIC FILE DIGITALLY SIGNED AND SEALED UNDER RULE 61G15-23.004, F.A.C.


CITY OF VERO BEACH AIRPORT

Intermetro Fiber (Resurgence/Allied AF2072) owns a 528 fiber cable in a 1.5" HDPE shared FECR Duct Bank. We are on the East side of the tracks, generally within 50' of the tracks, parallel to the tracks and do not exit FEC RR ROW. We will mark our facilities when tickets are called in.



FEC RR

SR 5 / US 1

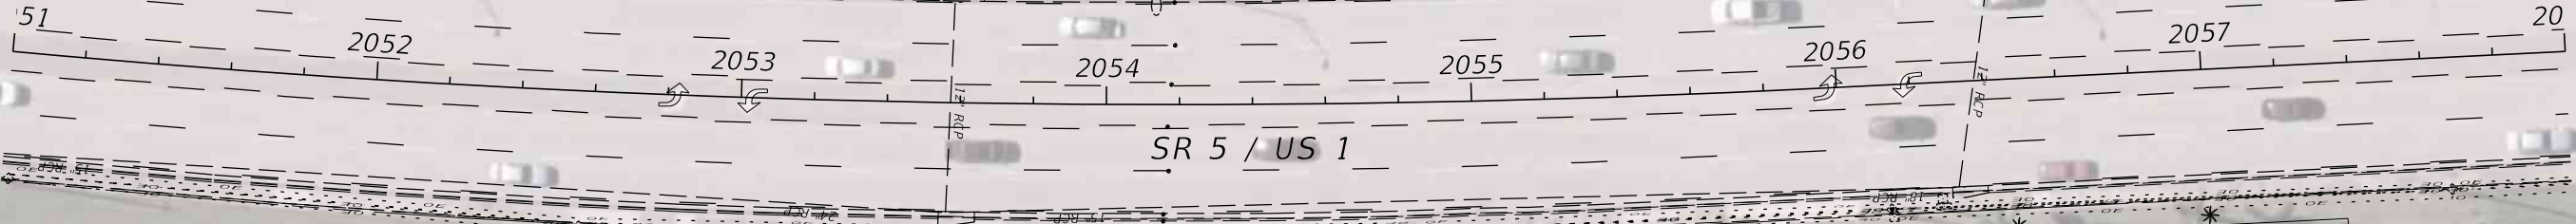

9/15/2022 11:02:50 AM Jacquelyn.Arreaga c:\pwworking\wg\Jacquelyn.arreaga\d2198192\PLANRD01.dgn

REVISIONS		PROFESSIONAL TYPE		STATE OF FLORIDA DEPARTMENT OF TRANSPORTATION			SHEET NO.
DATE	DESCRIPTION	DATE	DESCRIPTION	ROAD NO.	COUNTY	FINANCIAL PROJECT ID	
				SR 5	INDIAN RIVER	441693-1-22-02	9

UTILITY CONTACT PLAN (9)

THE OFFICIAL RECORD OF THIS SHEET IS THE ELECTRONIC FILE DIGITALLY SIGNED AND SEALED UNDER RULE 61G15-23.004, F.A.C.

CITY OF VERO BEACH AIRPORT

Intermetro Fiber (Resurgence/Allied AF2072) owns a 528 fiber cable in a 1.5" HDPE shared FECR Duct Bank. We are on the East side of the tracks, generally within 50' of the tracks, parallel to the tracks and do not exit FEC RR ROW. We will mark our facilities when tickets are called in.



FEC RR

SR 5 / US 1

PICKERILL LN

58 2059 2060 2061 2062 2063 2064 20

9/15/2022 11:03:08 AM Jacquelyn.Arreaga c:\pwworking\wg\N\Jacquelyn.arreaga\d2198192\PLANRD01.dgn

THE OFFICIAL RECORD OF THIS SHEET IS THE ELECTRONIC FILE DIGITALLY SIGNED AND SEALED UNDER RULE 61G15-23.004, F.A.C.


REVISIONS				PROFESSIONAL TYPE	STATE OF FLORIDA DEPARTMENT OF TRANSPORTATION			UTILITY CONTACT PLAN (10)	SHEET NO. 10
DATE	DESCRIPTION	DATE	DESCRIPTION		ROAD NO.	COUNTY	FINANCIAL PROJECT ID		
				WILLIAM EVANS LICENSE NUMBER: 45207 WGI, INC. 2035 VISTA PARKWAY WEST PALM BEACH, FL 33411	SR 5	INDIAN RIVER	441693-1-22-02		



CITY OF VERO BEACH AIRPORT

Intermetro Fiber (Resurgence/Allied AF2072) owns a 528 fiber cable in a 1.5" HDPE shared FECC Duct Bank. We are on the East side of the tracks, generally within 50' of the tracks, parallel to the tracks and do not exit FECC RR ROW. We will mark our facilities when tickets are called in.

FEC RR

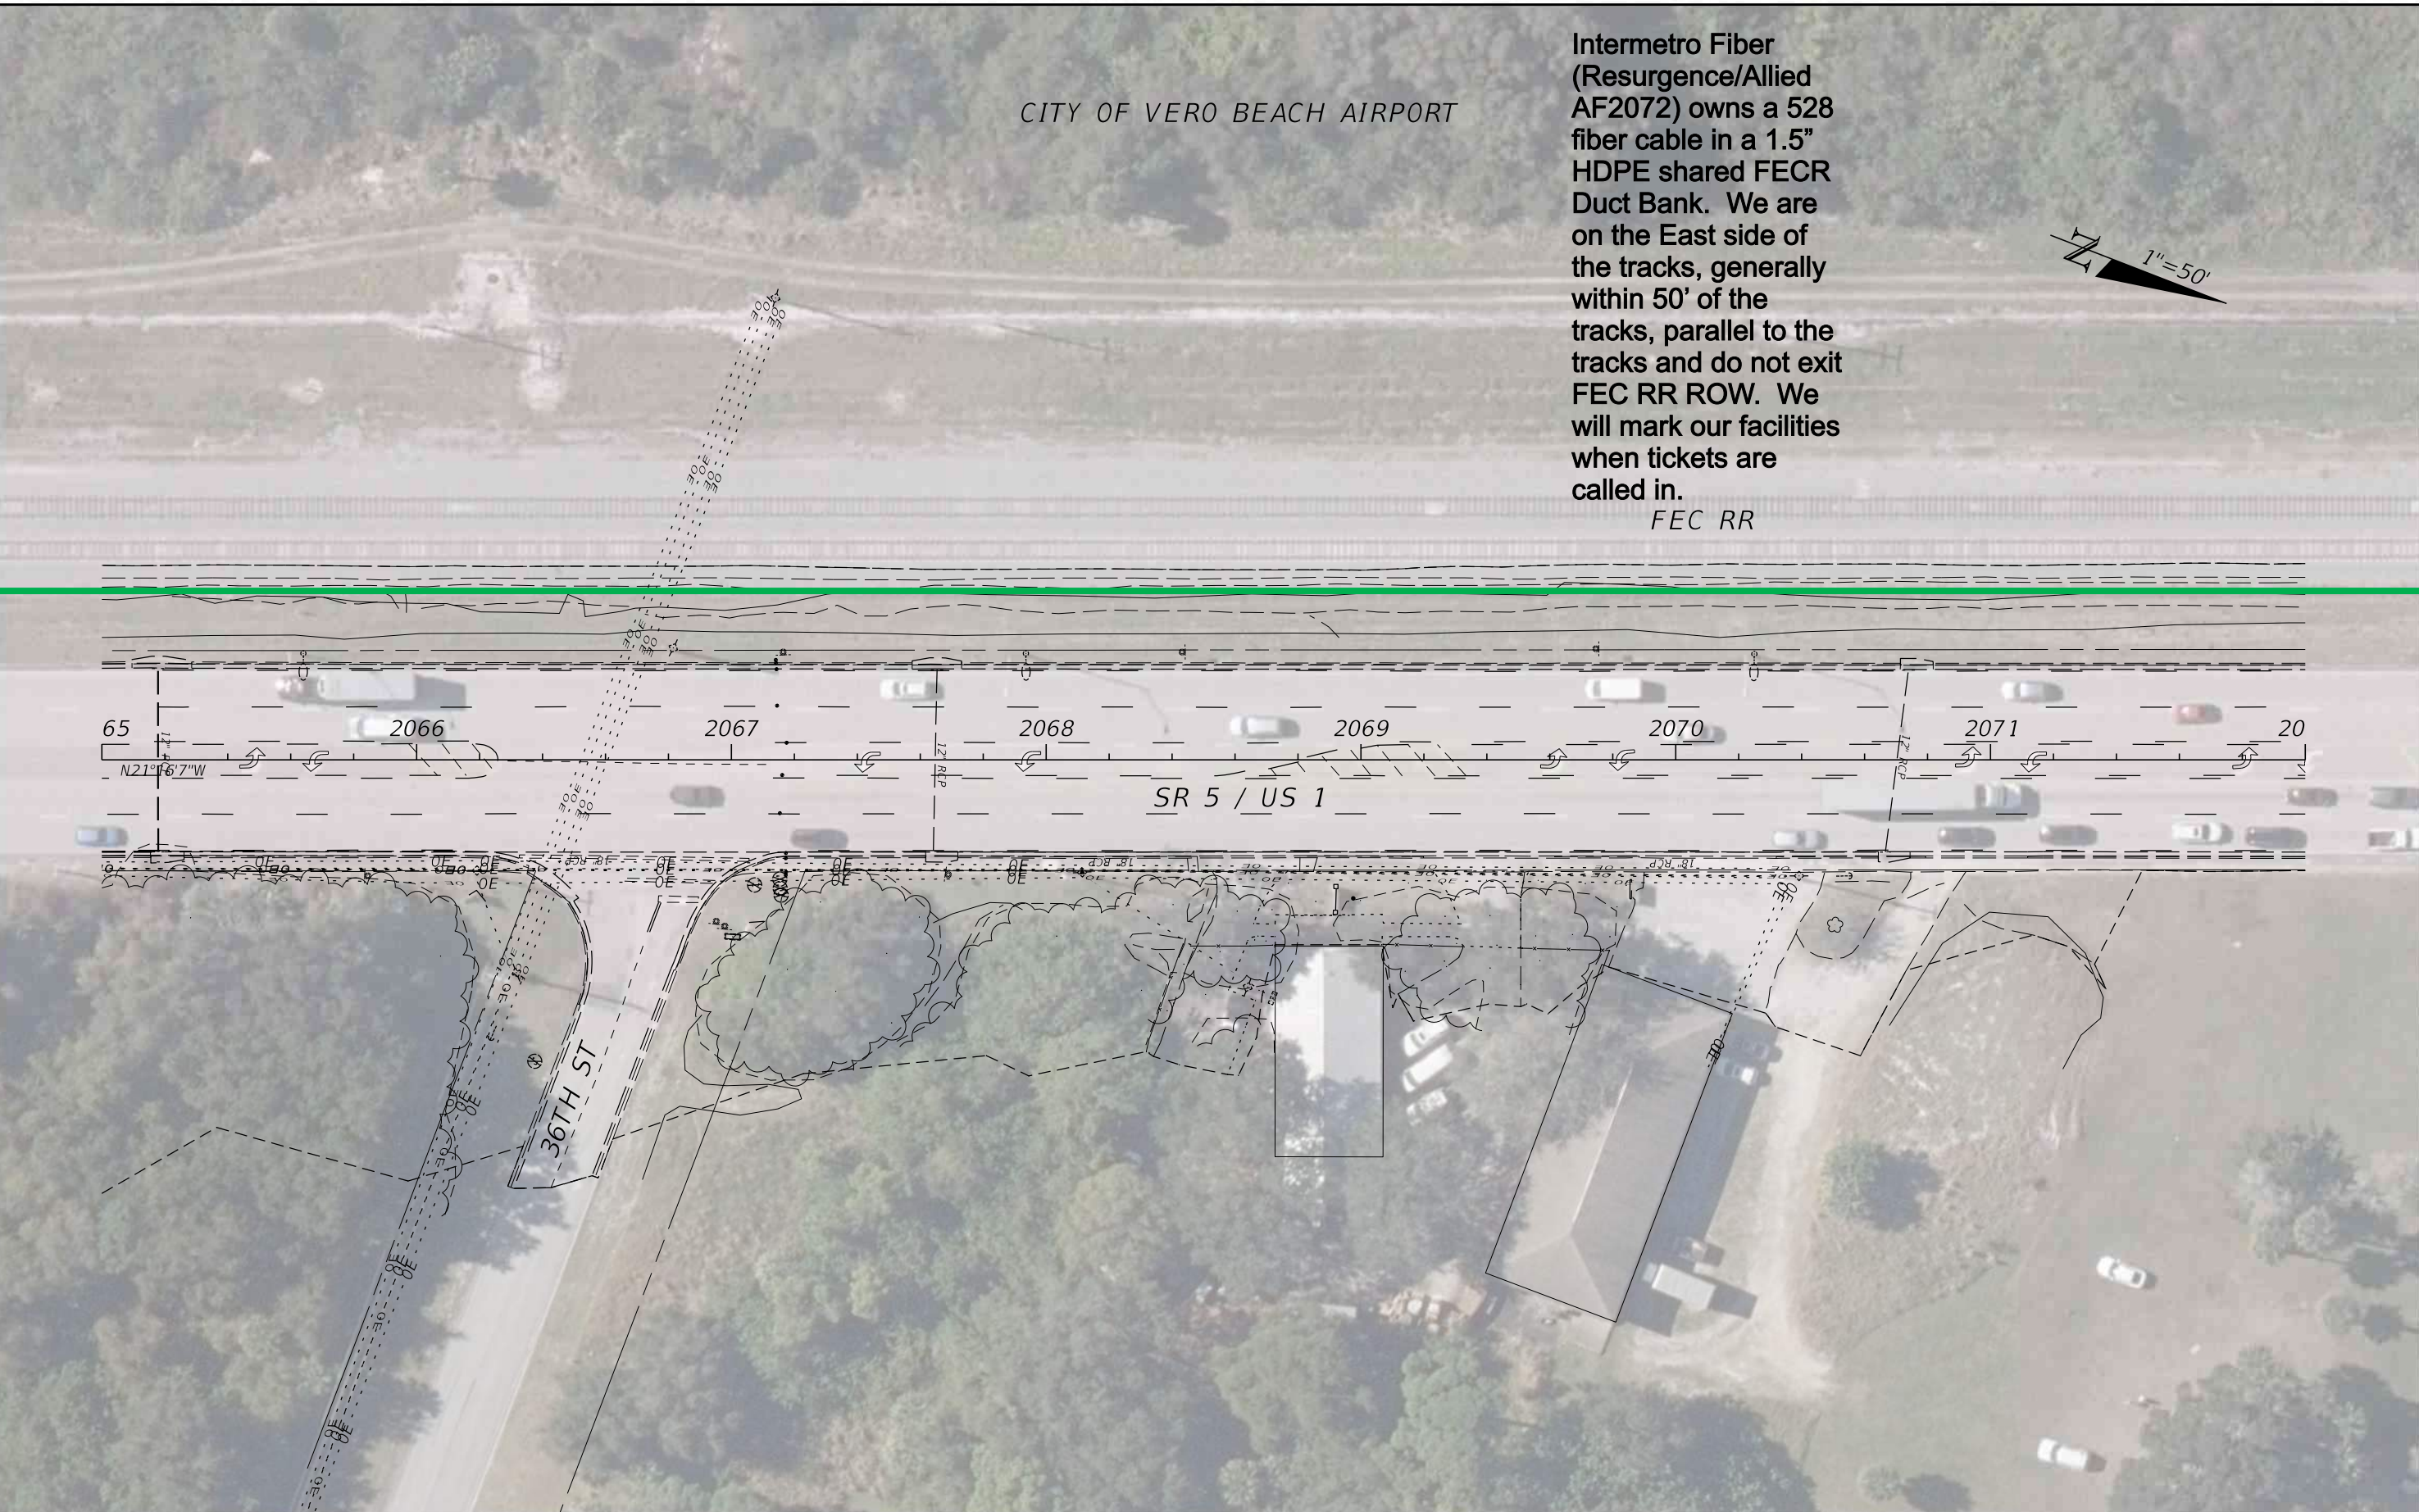



9/15/2022 11:03:42 AM Jacquelyn.Arreaga  
 c:\pwworking\wg\N\Jacquelyn.arreaga\d2198192\PLANRD01.dgn

DATE		DESCRIPTION		REVISIONS		PROFESSIONAL TYPE		STATE OF FLORIDA DEPARTMENT OF TRANSPORTATION			SHEET NO.
DATE	DESCRIPTION	DATE	DESCRIPTION	DATE	DESCRIPTION	WILLIAM EVANS LICENSE NUMBER: 45207 WGI, INC. 2035 VISTA PARKWAY WEST PALM BEACH, FL 33411	ROAD NO.	COUNTY	FINANCIAL PROJECT ID		
							SR 5	INDIAN RIVER	441693-1-22-02	UTILITY CONTACT PLAN (11)	11

THE OFFICIAL RECORD OF THIS SHEET IS THE ELECTRONIC FILE DIGITALLY SIGNED AND SEALED UNDER RULE 61G15-23.004, F.A.C.

Intermetro Fiber (Resurgence/Allied AF2072) owns a 528 fiber cable in a 1.5" HDPE shared FECR Duct Bank. We are on the East side of the tracks, generally within 50' of the tracks, parallel to the tracks and do not exit FEC RR ROW. We will mark our facilities when tickets are called in.

CITY OF VERO BEACH AIRPORT

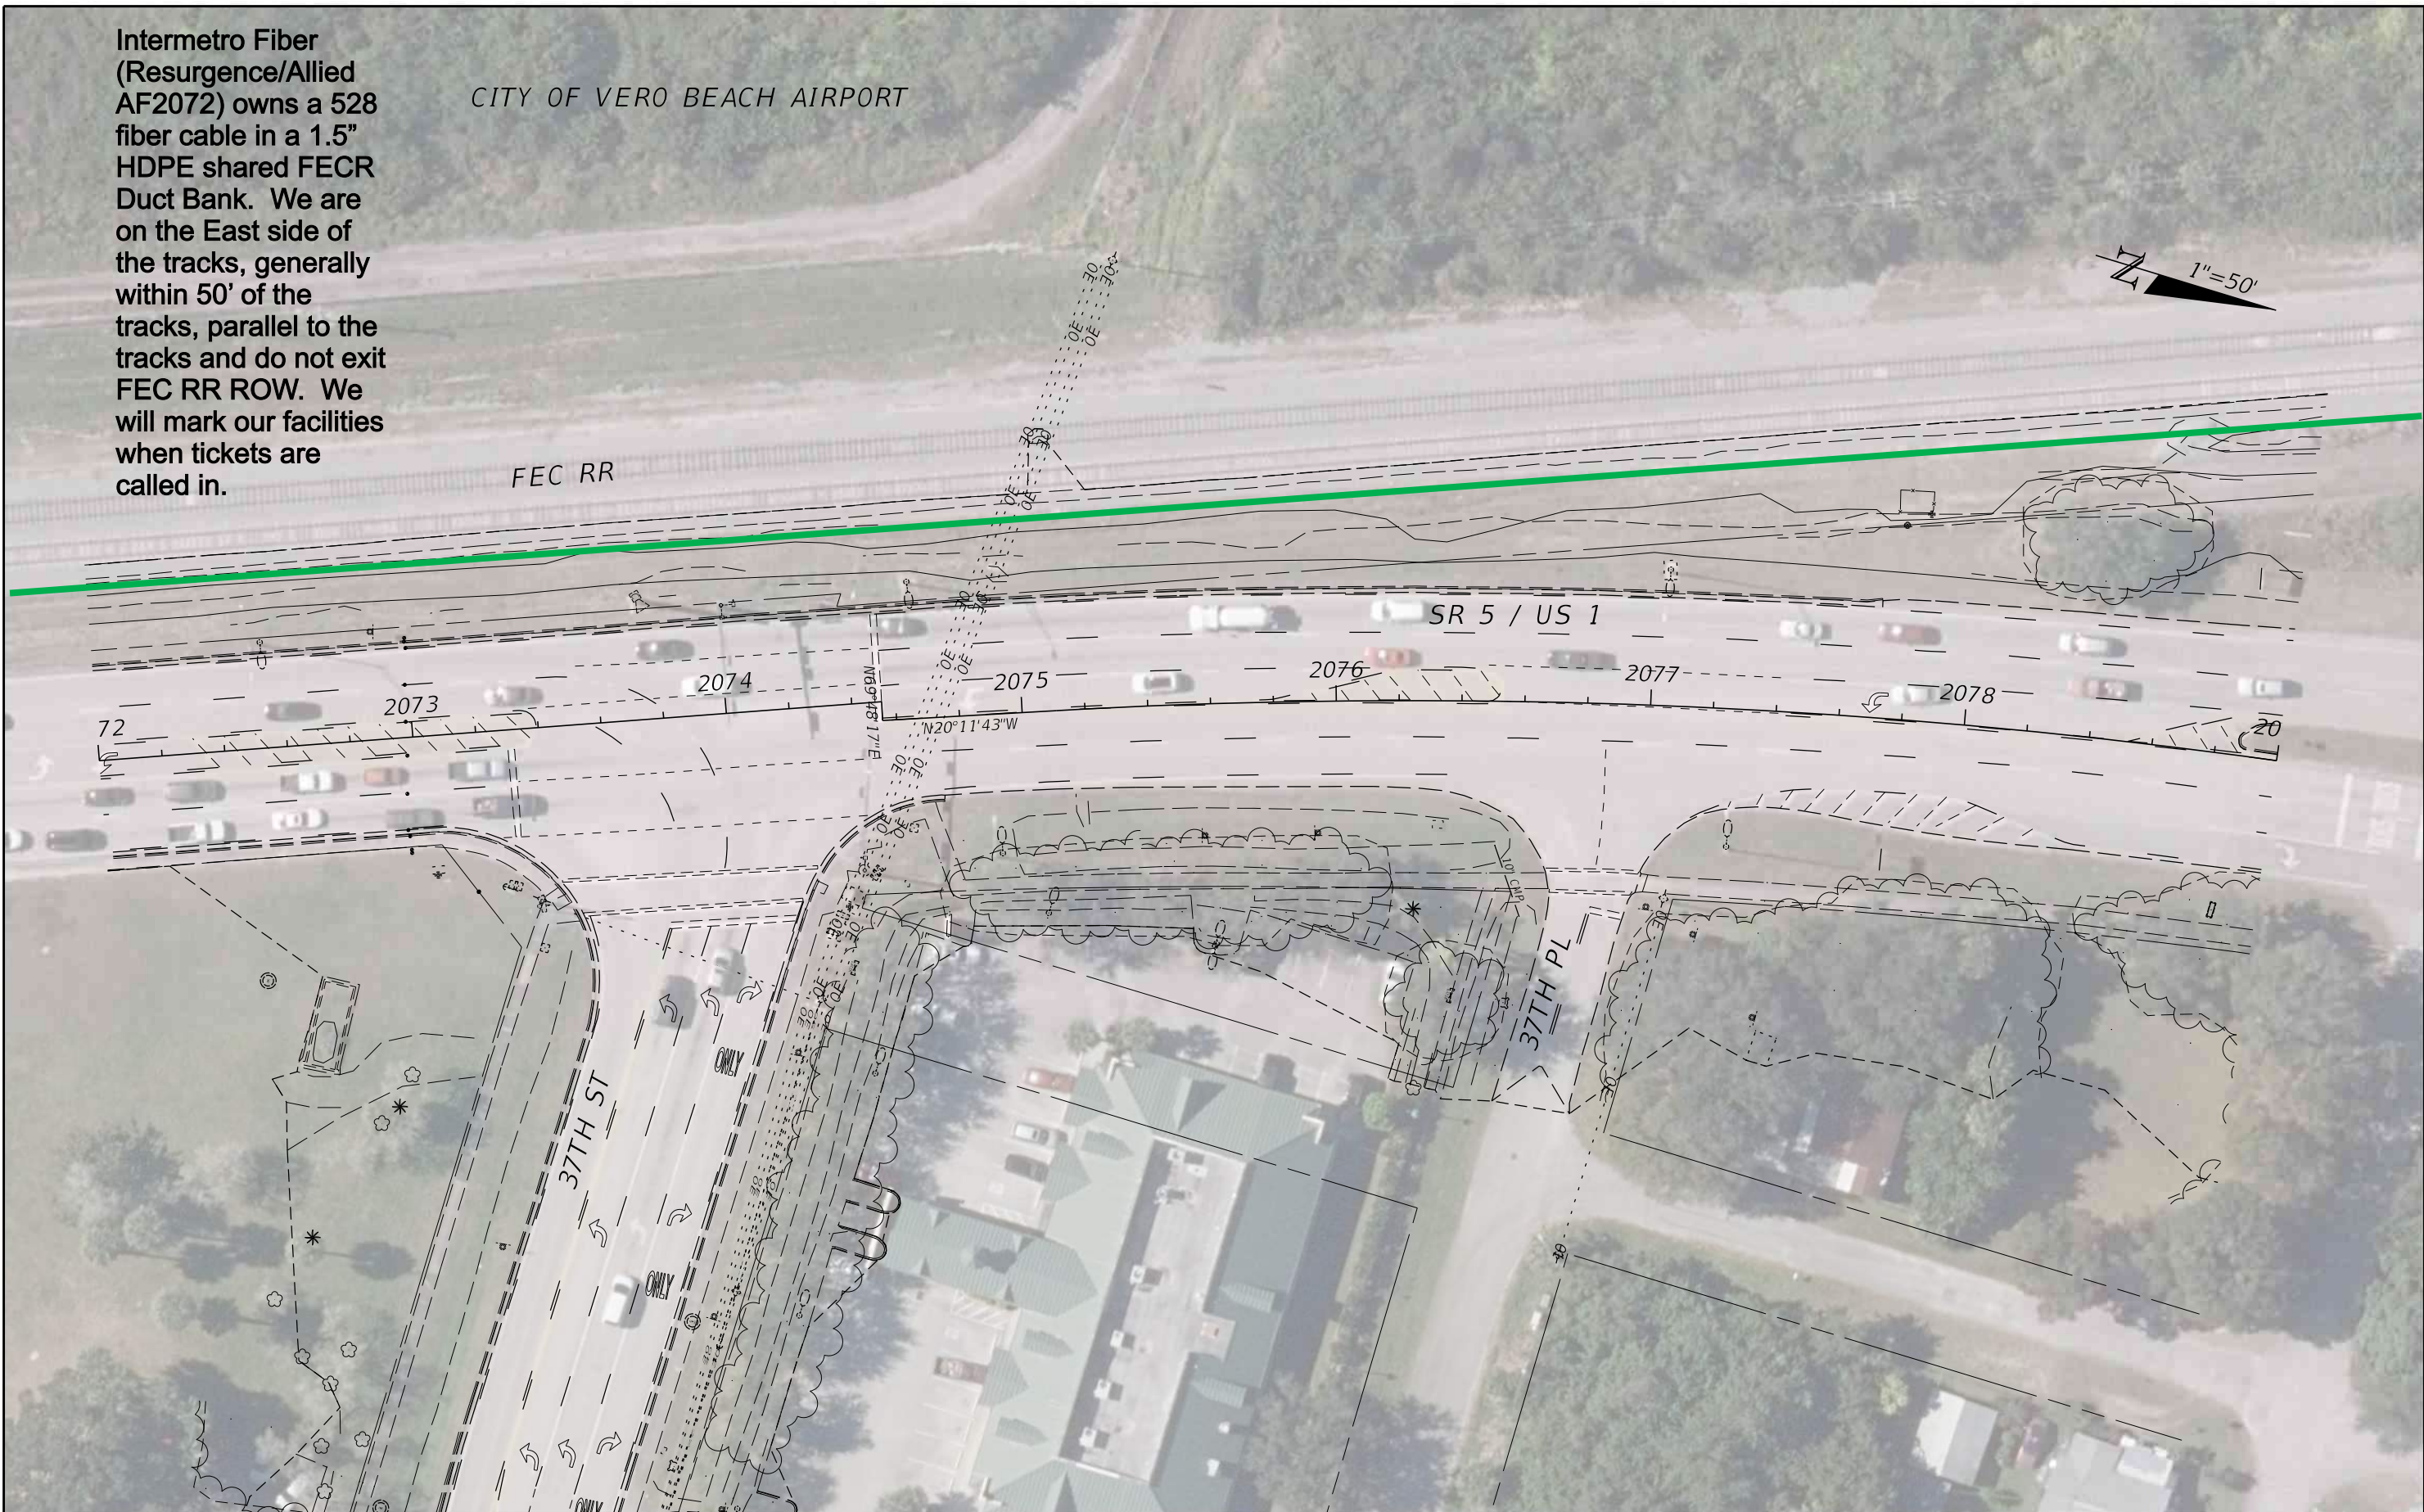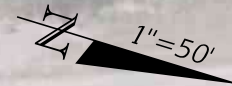


9/15/2022 11:04:09 AM Jacquelyn.Arreaga c:\pwworking\wg\N\Jacquelyn.arreaga\d2198192\PLANRD01.dgn

REVISIONS				PROFESSIONAL TYPE	STATE OF FLORIDA DEPARTMENT OF TRANSPORTATION			SHEET NO.
DATE	DESCRIPTION	DATE	DESCRIPTION		ROAD NO.	COUNTY	FINANCIAL PROJECT ID	
				WILLIAM EVANS LICENSE NUMBER: 45207 WGI, INC. 2035 VISTA PARKWAY WEST PALM BEACH, FL 33411	SR 5	INDIAN RIVER	441693-1-22-02	12

**UTILITY CONTACT PLAN (12)**

THE OFFICIAL RECORD OF THIS SHEET IS THE ELECTRONIC FILE DIGITALLY SIGNED AND SEALED UNDER RULE 61G15-23.004, F.A.C.

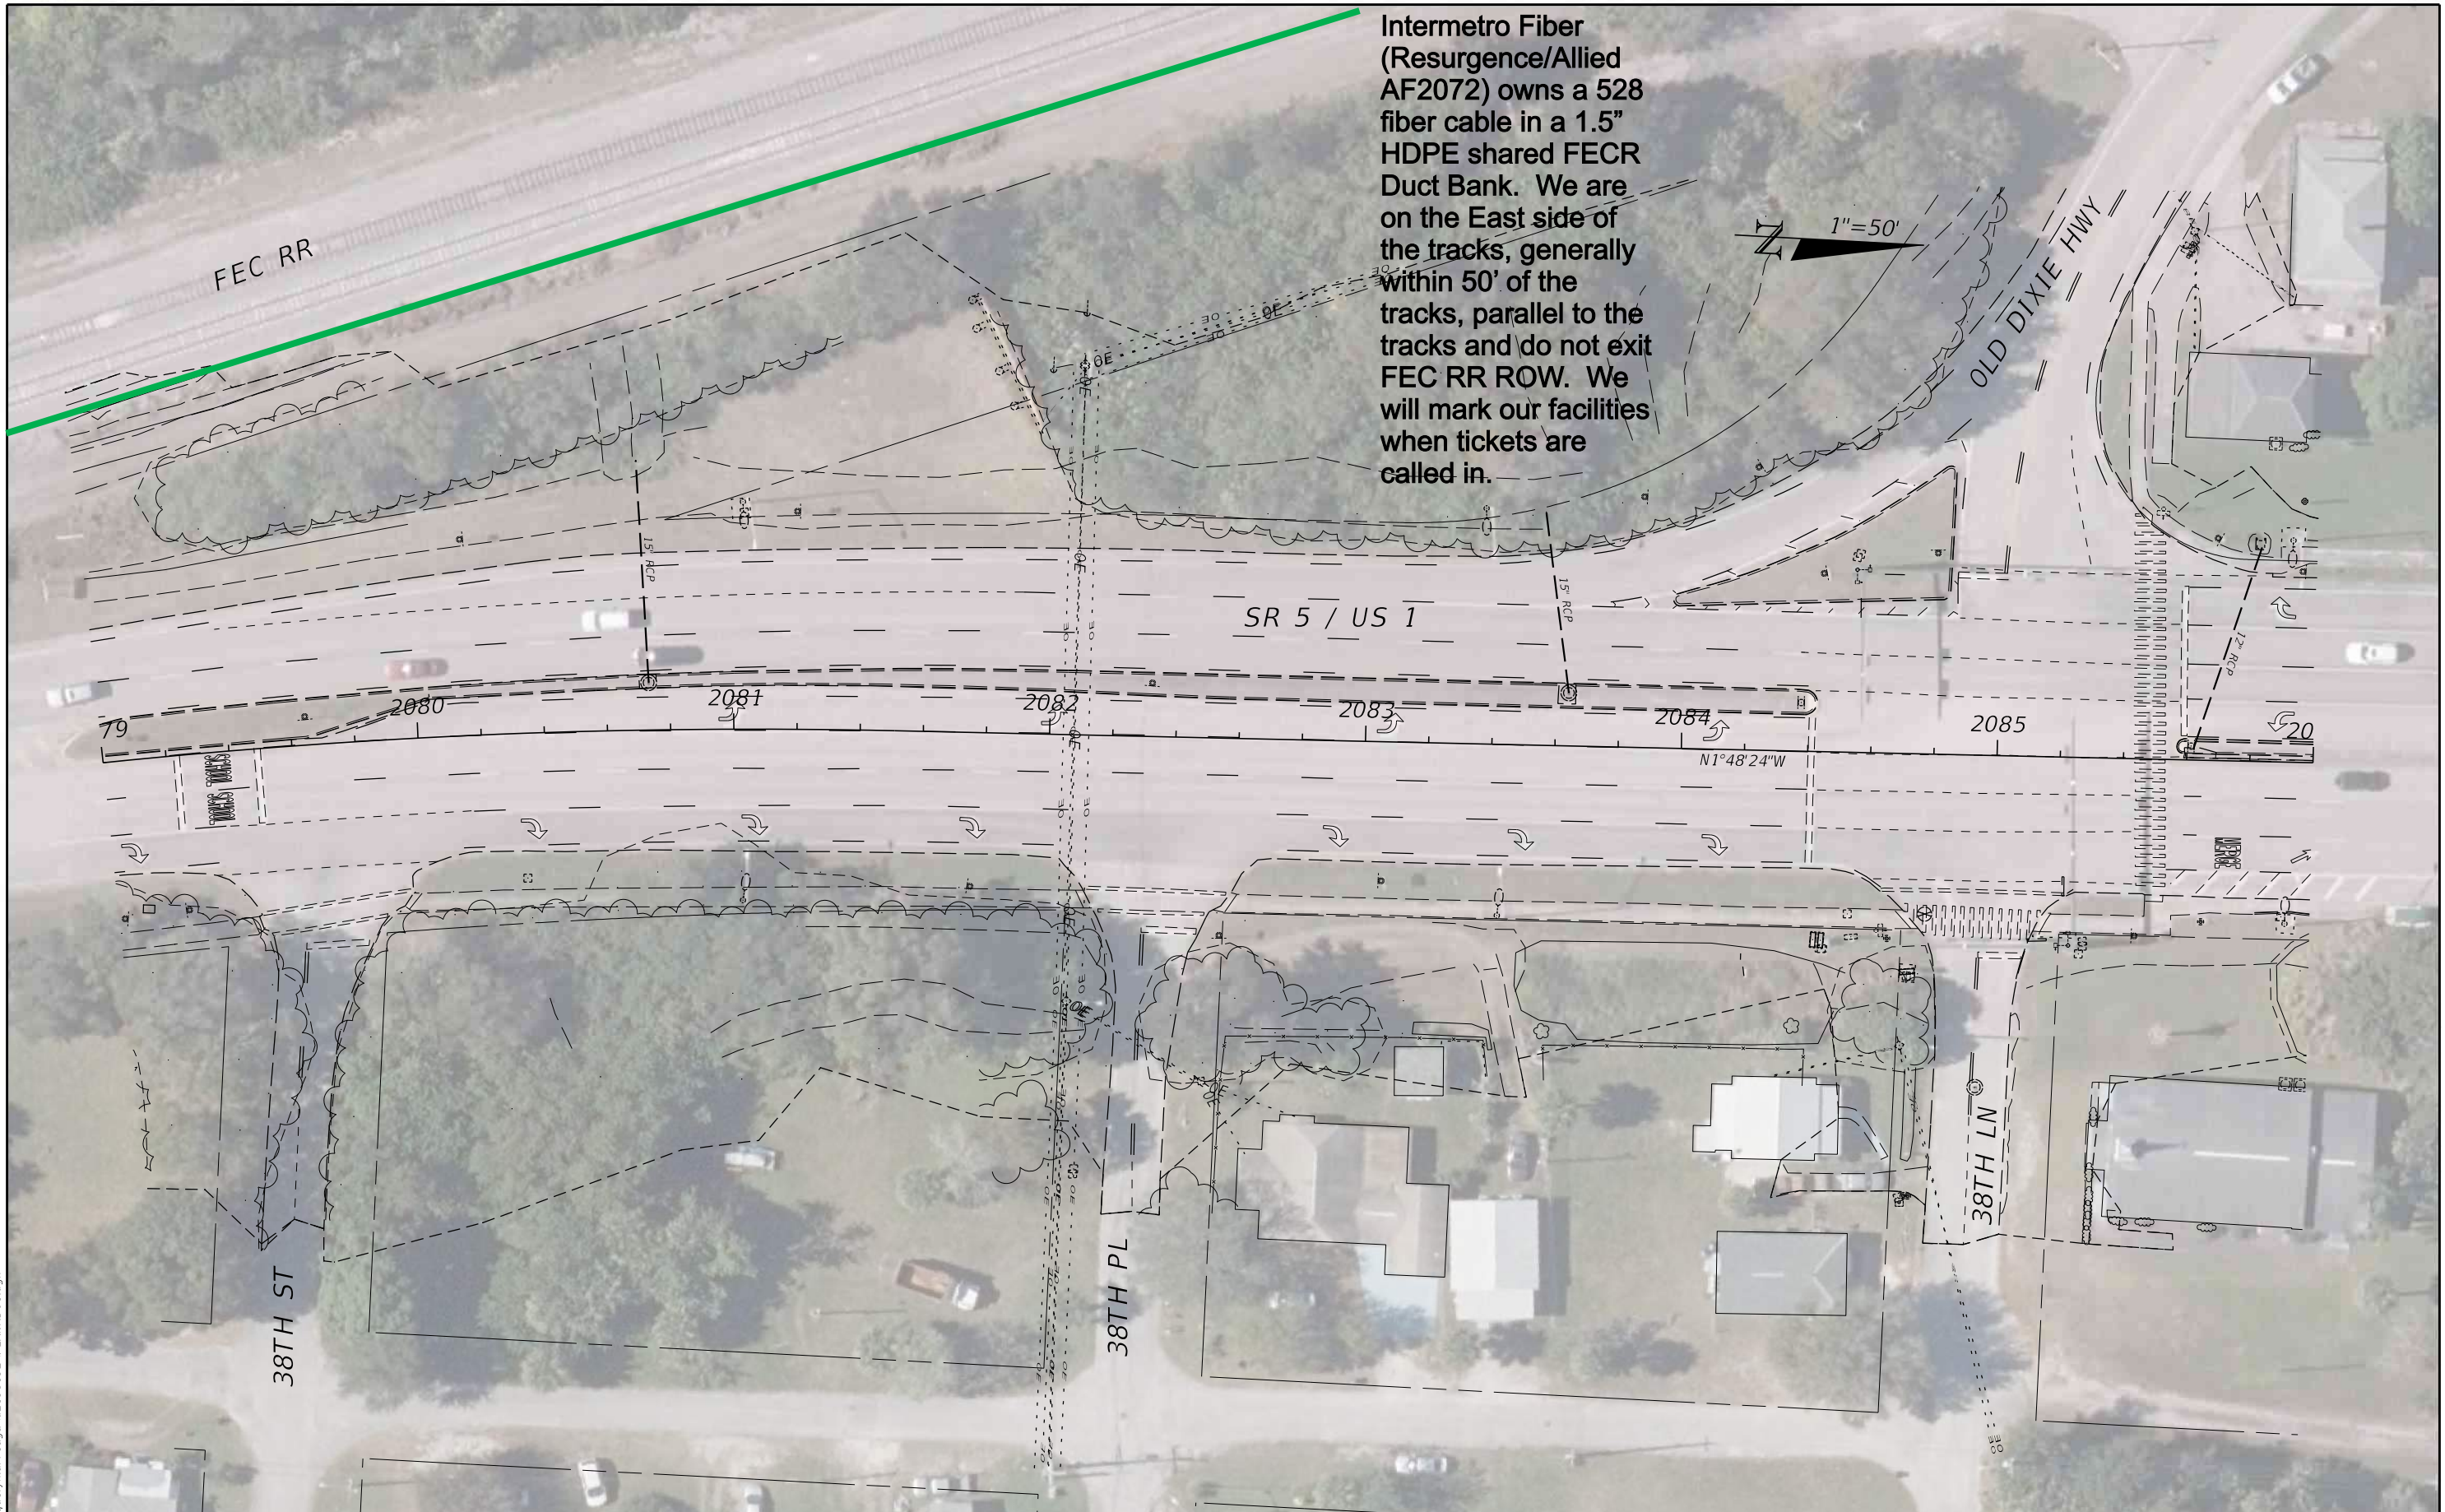



9/15/2022 11:04:36 AM Jacquelyn.Arreaga  
 c:\pwworking\wgn\jacquelyn.arreaga\d2198192\PLANRD01.dgn

REVISIONS		PROFESSIONAL TYPE		STATE OF FLORIDA DEPARTMENT OF TRANSPORTATION			UTILITY CONTACT PLAN (13)	SHEET NO. 13
DATE	DESCRIPTION	DATE	DESCRIPTION	ROAD NO.	COUNTY	FINANCIAL PROJECT ID		
				SR 5	INDIAN RIVER	441693-1-22-02		

WILLIAM EVANS  
 LICENSE NUMBER: 45207  
 WGI, INC.  
 2035 VISTA PARKWAY  
 WEST PALM BEACH, FL 33411

THE OFFICIAL RECORD OF THIS SHEET IS THE ELECTRONIC FILE DIGITALLY SIGNED AND SEALED UNDER RULE 61G15-23.004, F.A.C.

CITY OF VERO BEACH AIRPORT

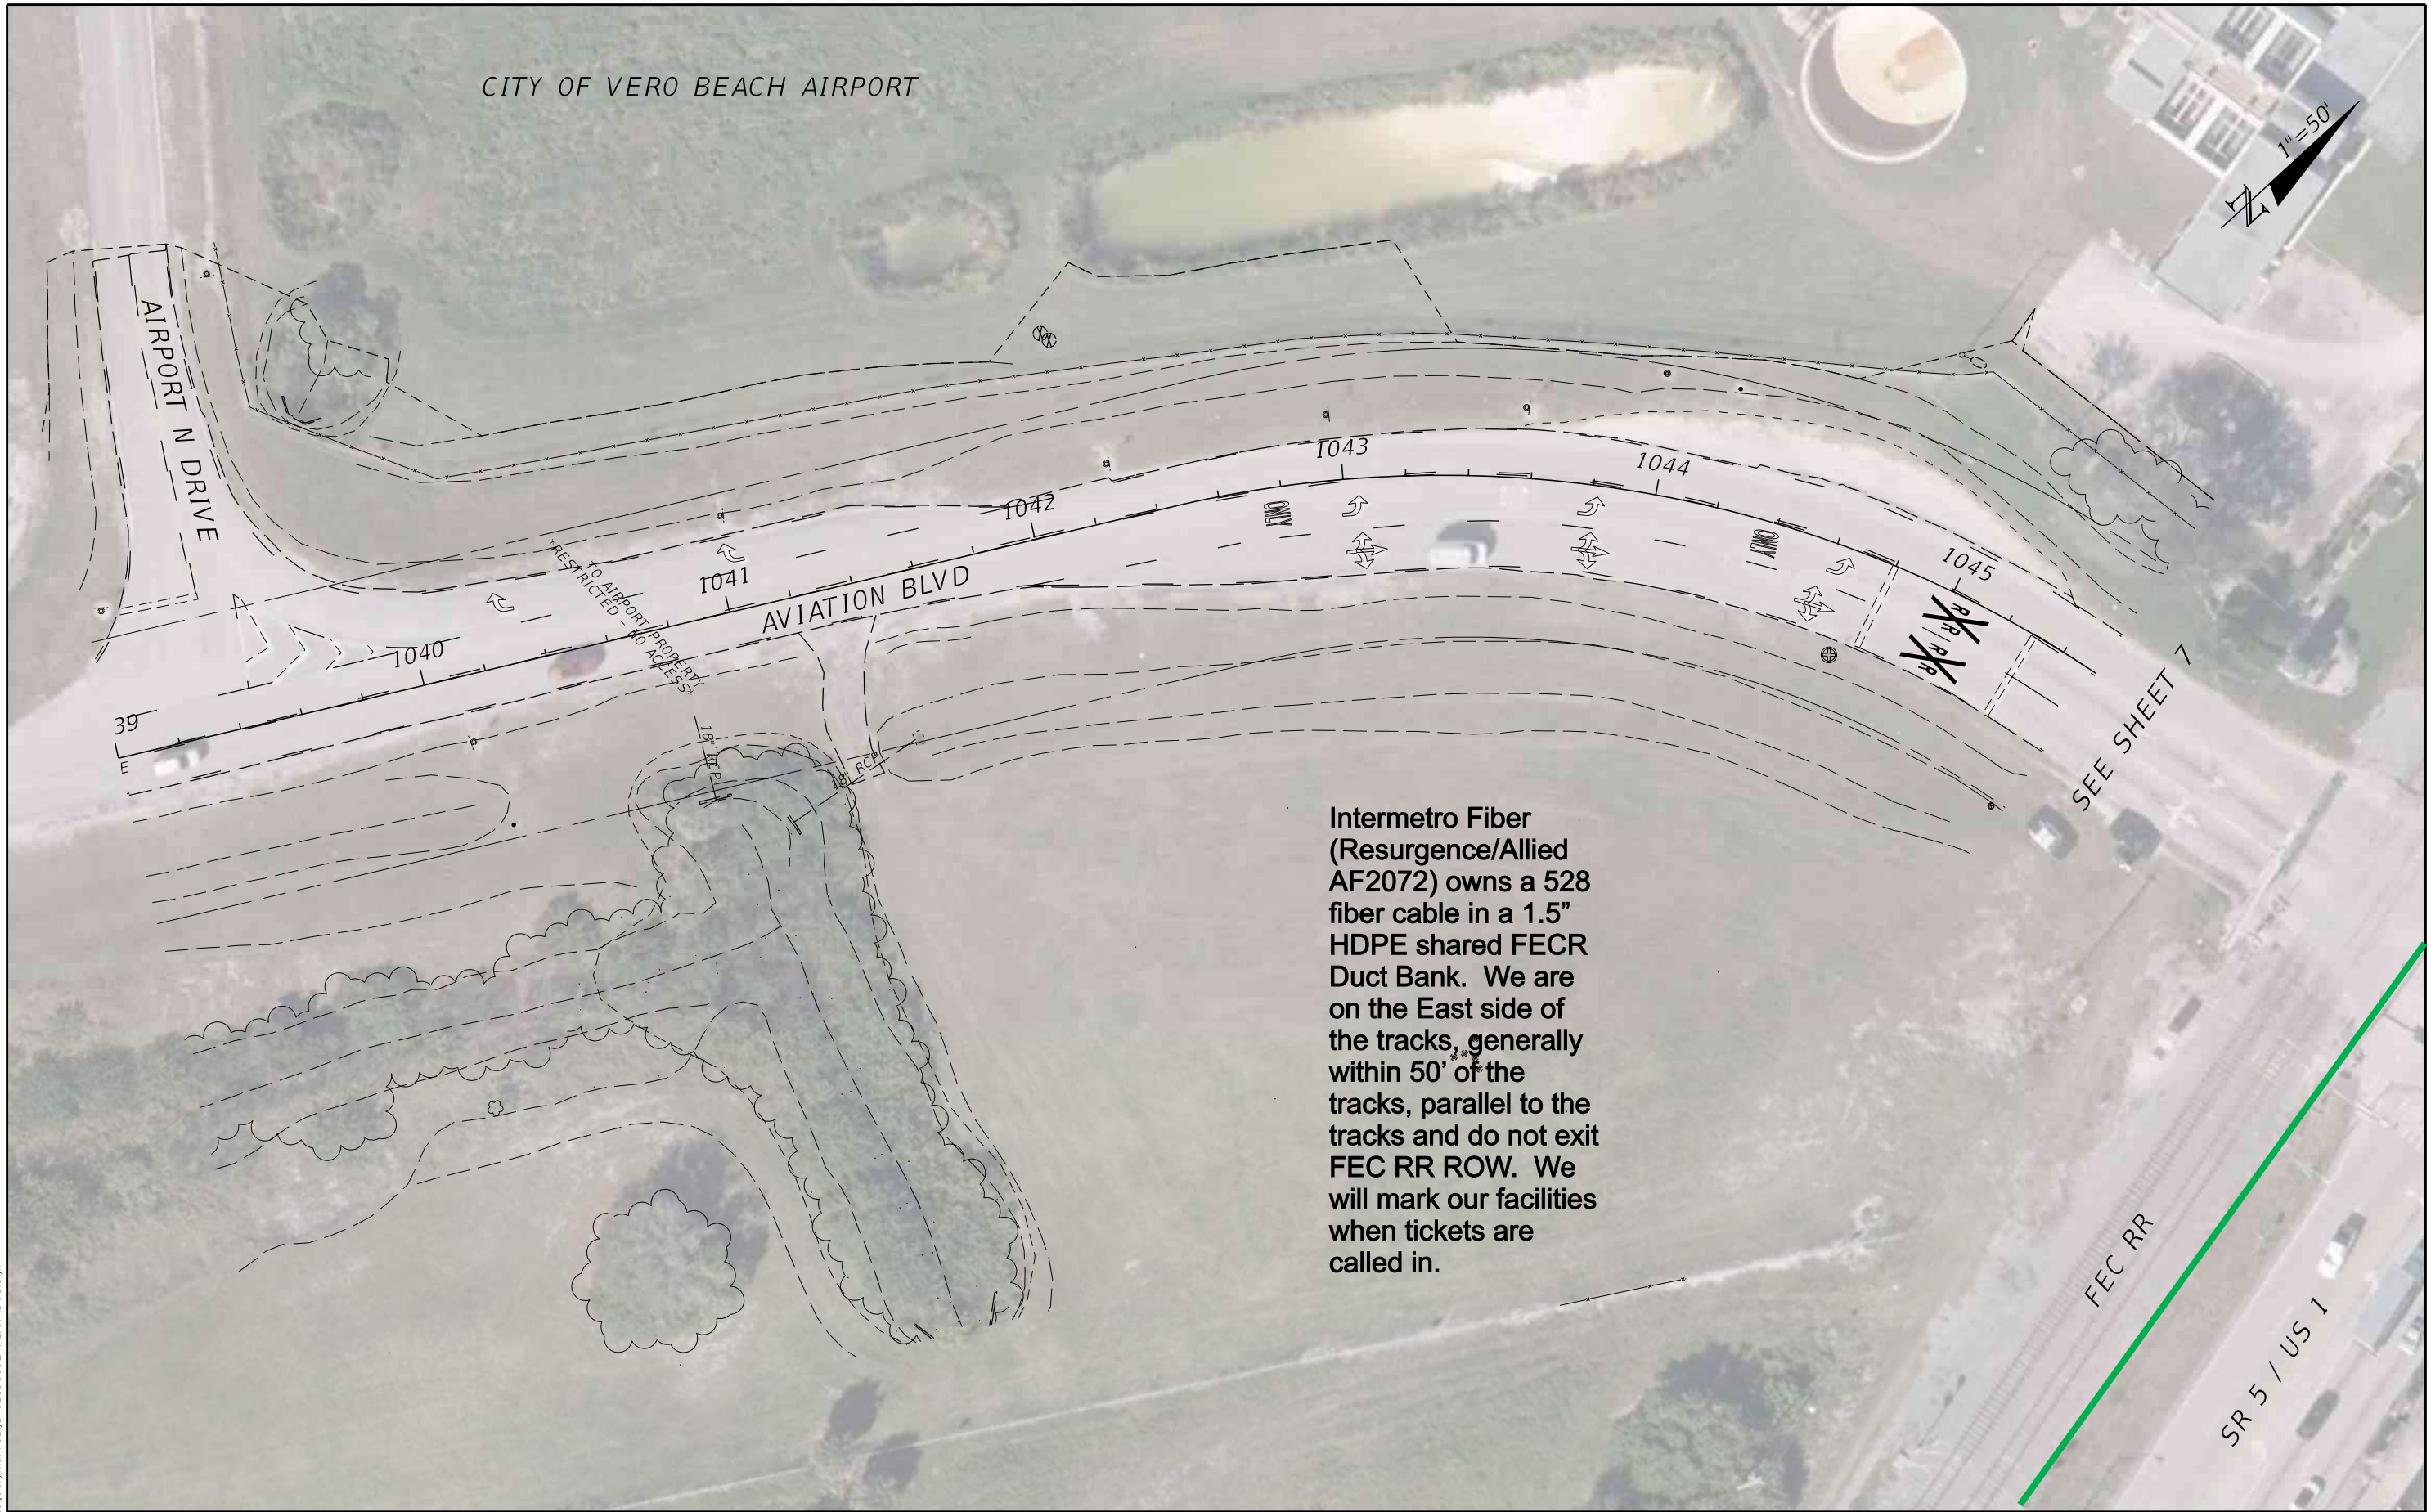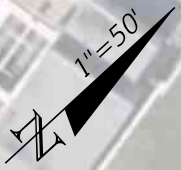

Intermetro Fiber (Resurgence/Allied AF2072) owns a 528 fiber cable in a 1.5" HDPE shared FECR Duct Bank. We are on the East side of the tracks, generally within 50' of the tracks, parallel to the tracks and do not exit FEC RR ROW. We will mark our facilities when tickets are called in.

FEC RR

SR 5 / US 1

SEE SHEET 7

9/15/2022 11:09:43 AM Jacquelyn.Arreaga c:\pwworking\wg\N\Jacquelyn.arreaga\d2198192\PLANRD01.dgn

REVISIONS				PROFESSIONAL TYPE	STATE OF FLORIDA DEPARTMENT OF TRANSPORTATION			SHEET NO.
DATE	DESCRIPTION	DATE	DESCRIPTION		ROAD NO.	COUNTY	FINANCIAL PROJECT ID	
				WILLIAM EVANS LICENSE NUMBER: 45207 WGI, INC. 2035 VISTA PARKWAY WEST PALM BEACH, FL 33411	SR 5	INDIAN RIVER	441693-1-22-02	27

UTILITY CONTACT PLAN (27)

THE OFFICIAL RECORD OF THIS SHEET IS THE ELECTRONIC FILE DIGITALLY SIGNED AND SEALED UNDER RULE 61G15-23.004, F.A.C.

**Appendices**

**Appendix D**

**Sprint**

## Owen Smith

---

**From:** Baker, Jon <jabaker@cogentco.com>  
**Sent:** Wednesday, June 7, 2023 11:19 AM  
**To:** Owen Smith  
**Subject:** [EXTERNAL] RE: FPID 441693-1-22-02: Aviation Blvd PD&E Study from 27th Ave to US1/SR5 and SR5 from 21st St. to 37th St - Utility Greenline Markup Request

Owen,

Sprint's only facilities are within FEC Right of Way in a leased FEC owned 2" conduit. If your project will be impacting FEC ,please reach out to them for as-builts and coordination. If your project will not be impacting FEC R/W then we anticipate no involvement.

Let me know if you have any questions or need anything else.

My apologies for the slow response.

Thank You,


**Jon A. Baker** *Outside Plant Engineering East*  
**Cogent Communications, Florida – Remote**  
Contact: 352-409-5095 [jabaker@cogentco.com](mailto:jabaker@cogentco.com)



**Appendices**

**Appendix D**

**Verizon /MCI**

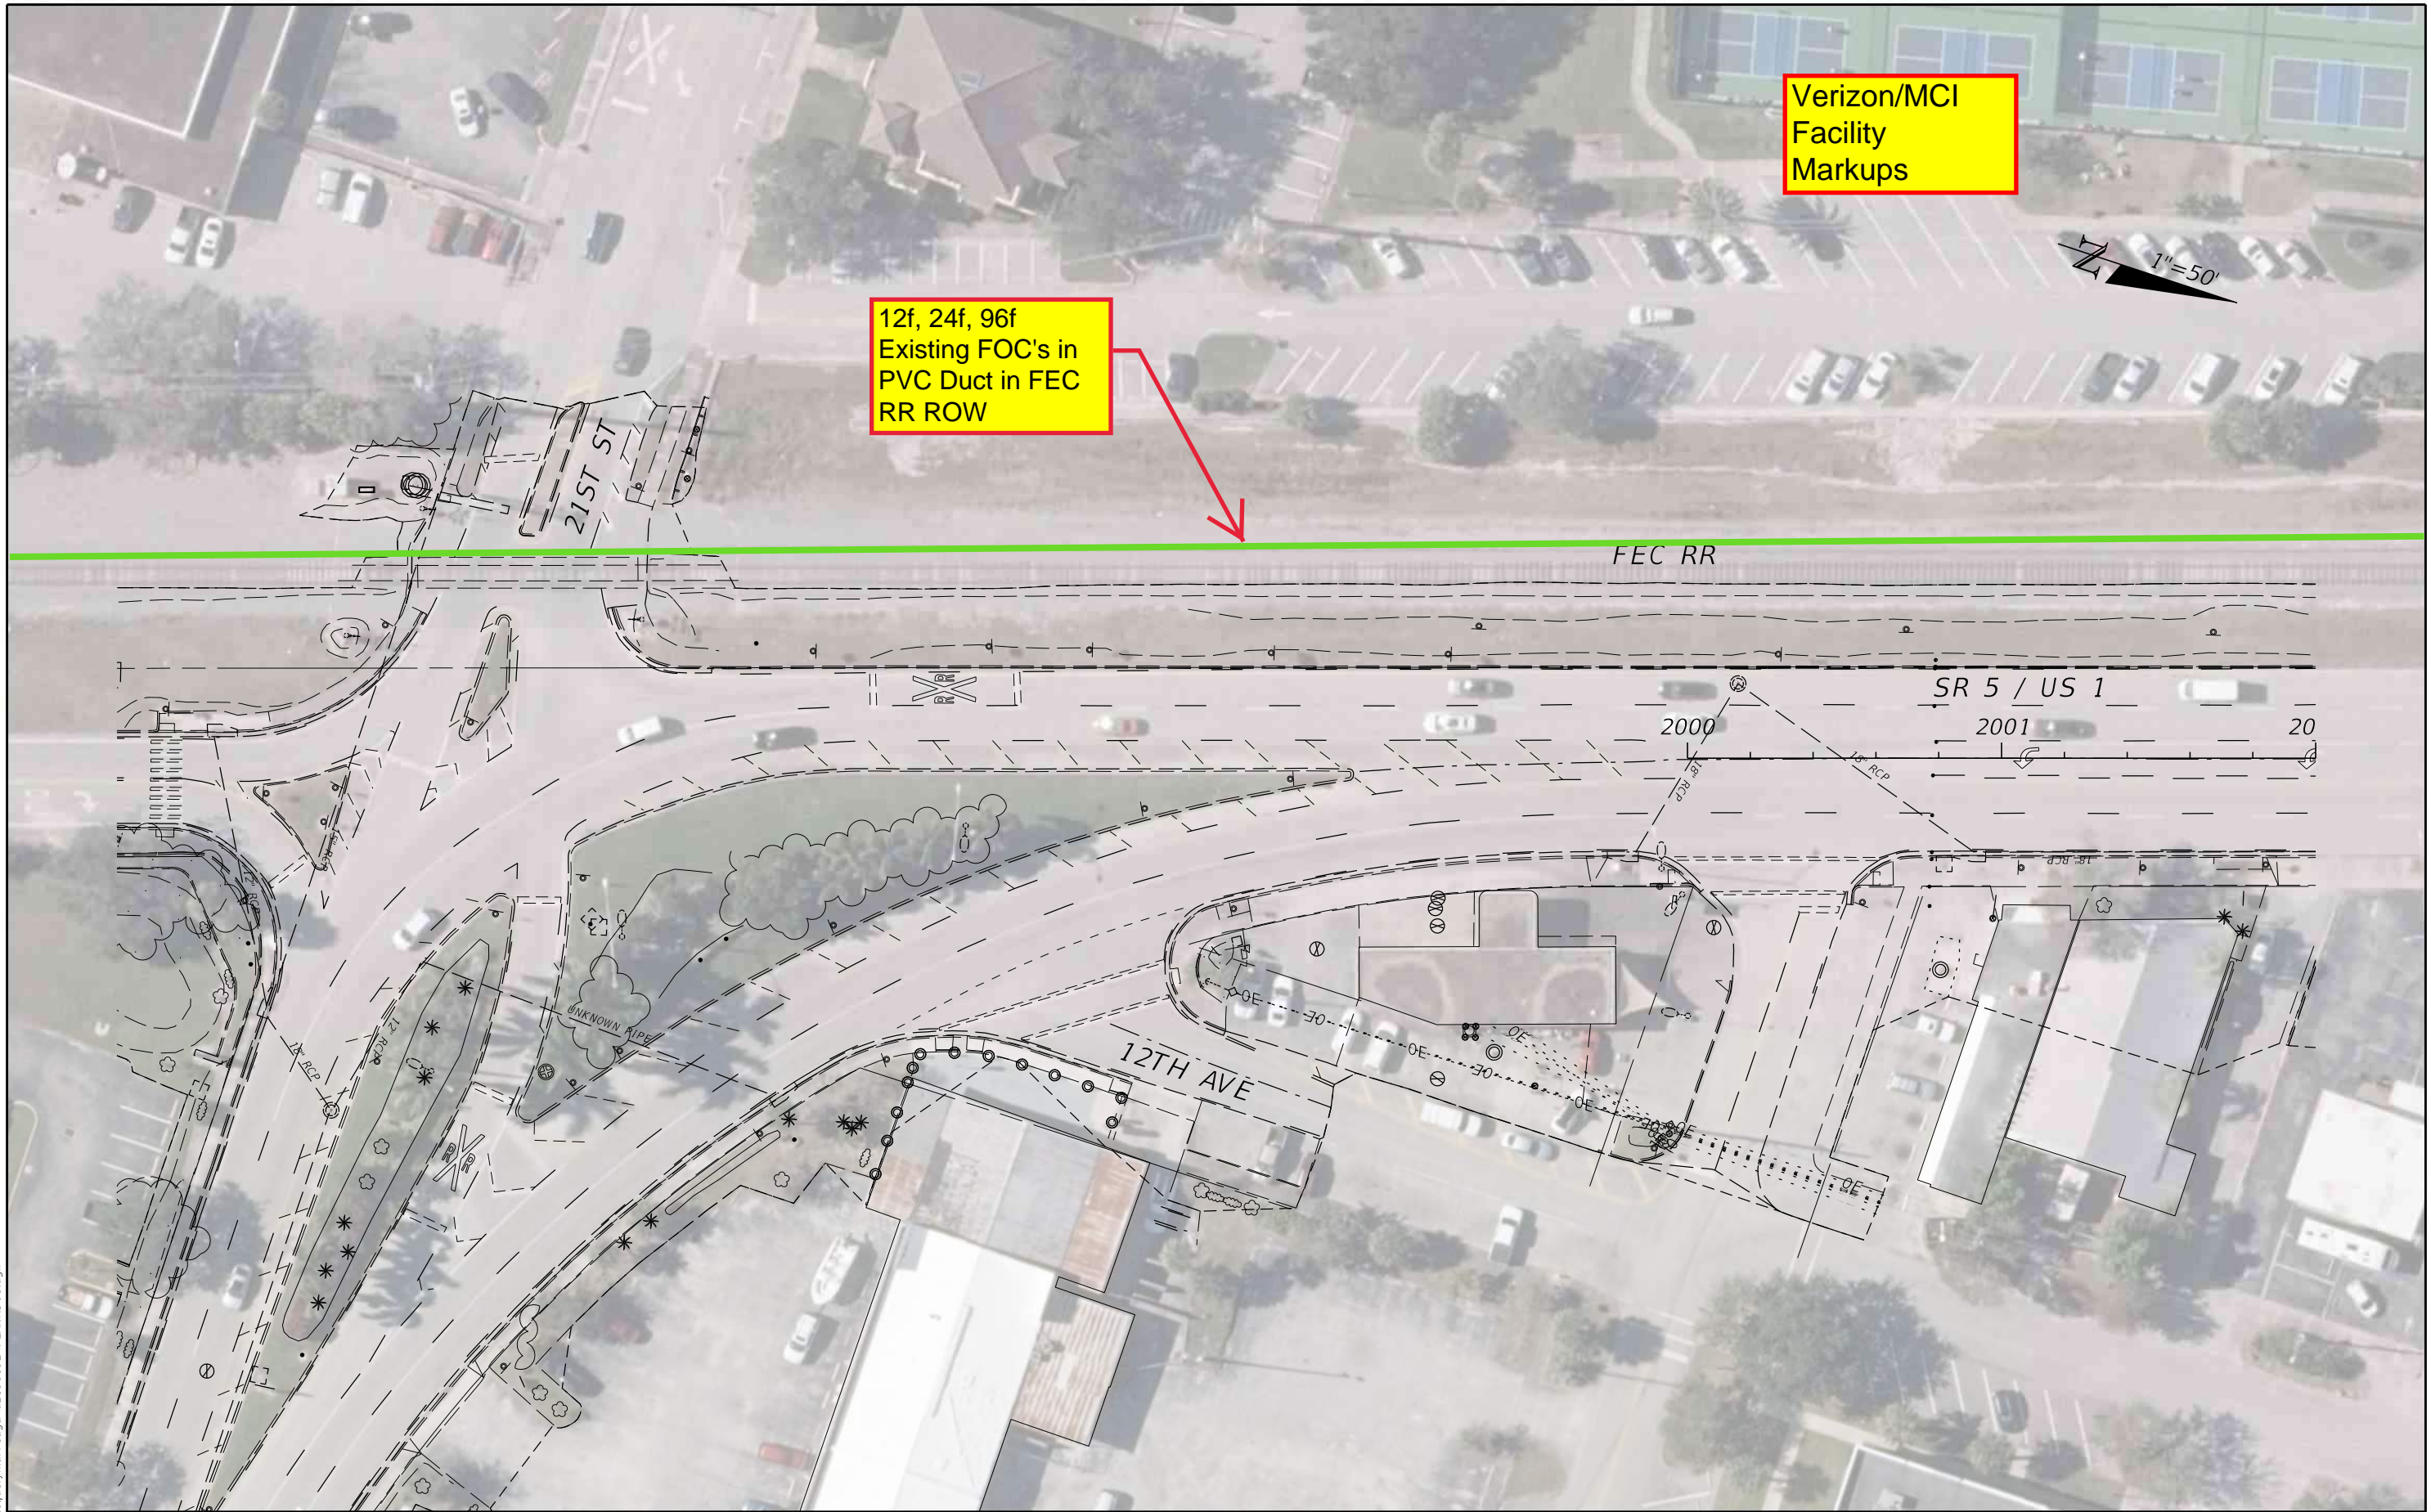

Verizon/MCI  
Facility  
Markups

12f, 24f, 96f  
Existing FOC's in  
PVC Duct in FEC  
RR ROW


1"=50'

9/15/2022 10:58:52 AM Jacquelyn.Arreaga  
c:\pwworking\wgi\jacquelyn.arreaga\d2198192\PLANRD01.dgn

REVISIONS		PROFESSIONAL TYPE		STATE OF FLORIDA DEPARTMENT OF TRANSPORTATION			UTILITY CONTACT PLAN (1)	SHEET NO.  1
DATE	DESCRIPTION	DATE	DESCRIPTION	ROAD NO.	COUNTY	FINANCIAL PROJECT ID		
				SR 5	INDIAN RIVER	441693-1-22-02		

THE OFFICIAL RECORD OF THIS SHEET IS THE ELECTRONIC FILE DIGITALLY SIGNED AND SEALED UNDER RULE 61G15-23.004, F.A.C.



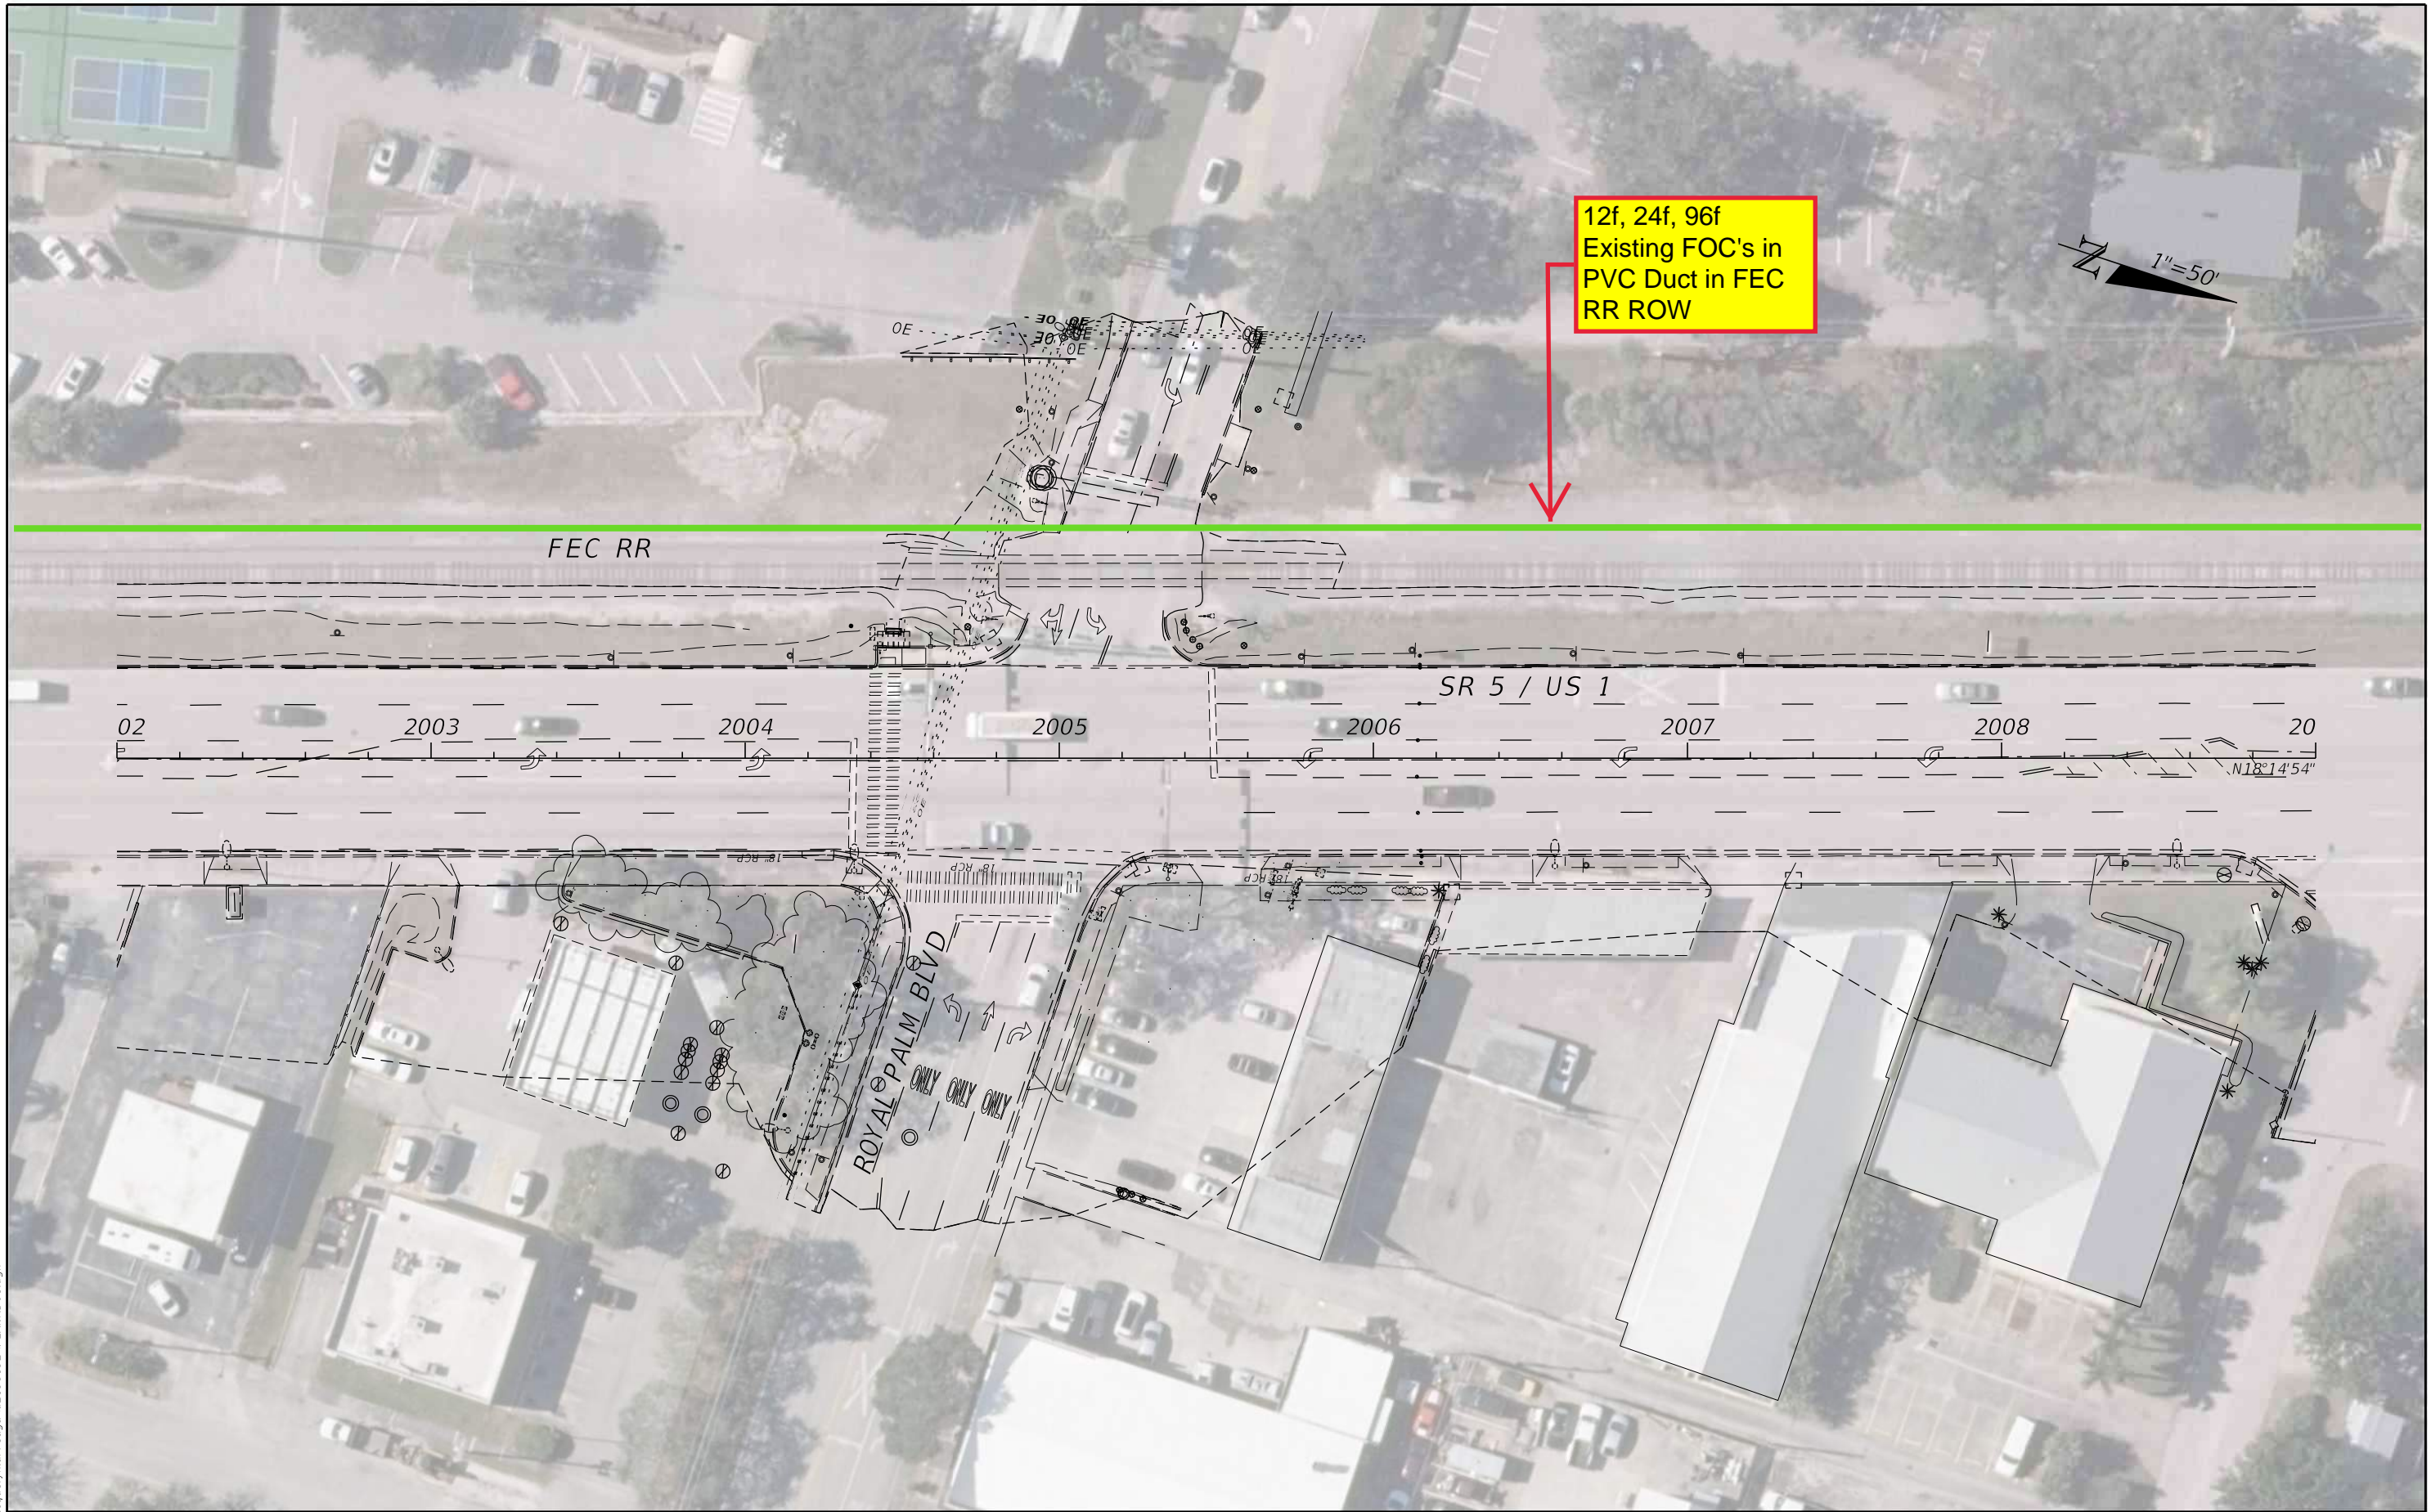

12f, 24f, 96f  
Existing FOC's in  
PVC Duct in FEC  
RR ROW

1"=50'

FEC RR

SR 5 / US 1

ROYAL PALM BLVD  
ONLY ONLY ONLY

02 2003 2004 2005 2006 2007 2008 20


N18°14'54"

9/15/2022 10:59:58 AM Jacquelyn.Arreaga  
c:\pwworking\wgn\jacquelyn.arreaga\d2198192\PLANRD01.dgn

REVISIONS		PROFESSIONAL TYPE		STATE OF FLORIDA DEPARTMENT OF TRANSPORTATION			UTILITY CONTACT PLAN (2)	SHEET NO. 2
DATE	DESCRIPTION	DATE	DESCRIPTION	ROAD NO.	COUNTY	FINANCIAL PROJECT ID		
				SR 5	INDIAN RIVER	441693-1-22-02		

WILLIAM EVANS  
LICENSE NUMBER: 45207  
WGI, INC.  
2035 VISTA PARKWAY  
WEST PALM BEACH, FL 33411

THE OFFICIAL RECORD OF THIS SHEET IS THE ELECTRONIC FILE DIGITALLY SIGNED AND SEALED UNDER RULE 61G15-23.004, F.A.C.

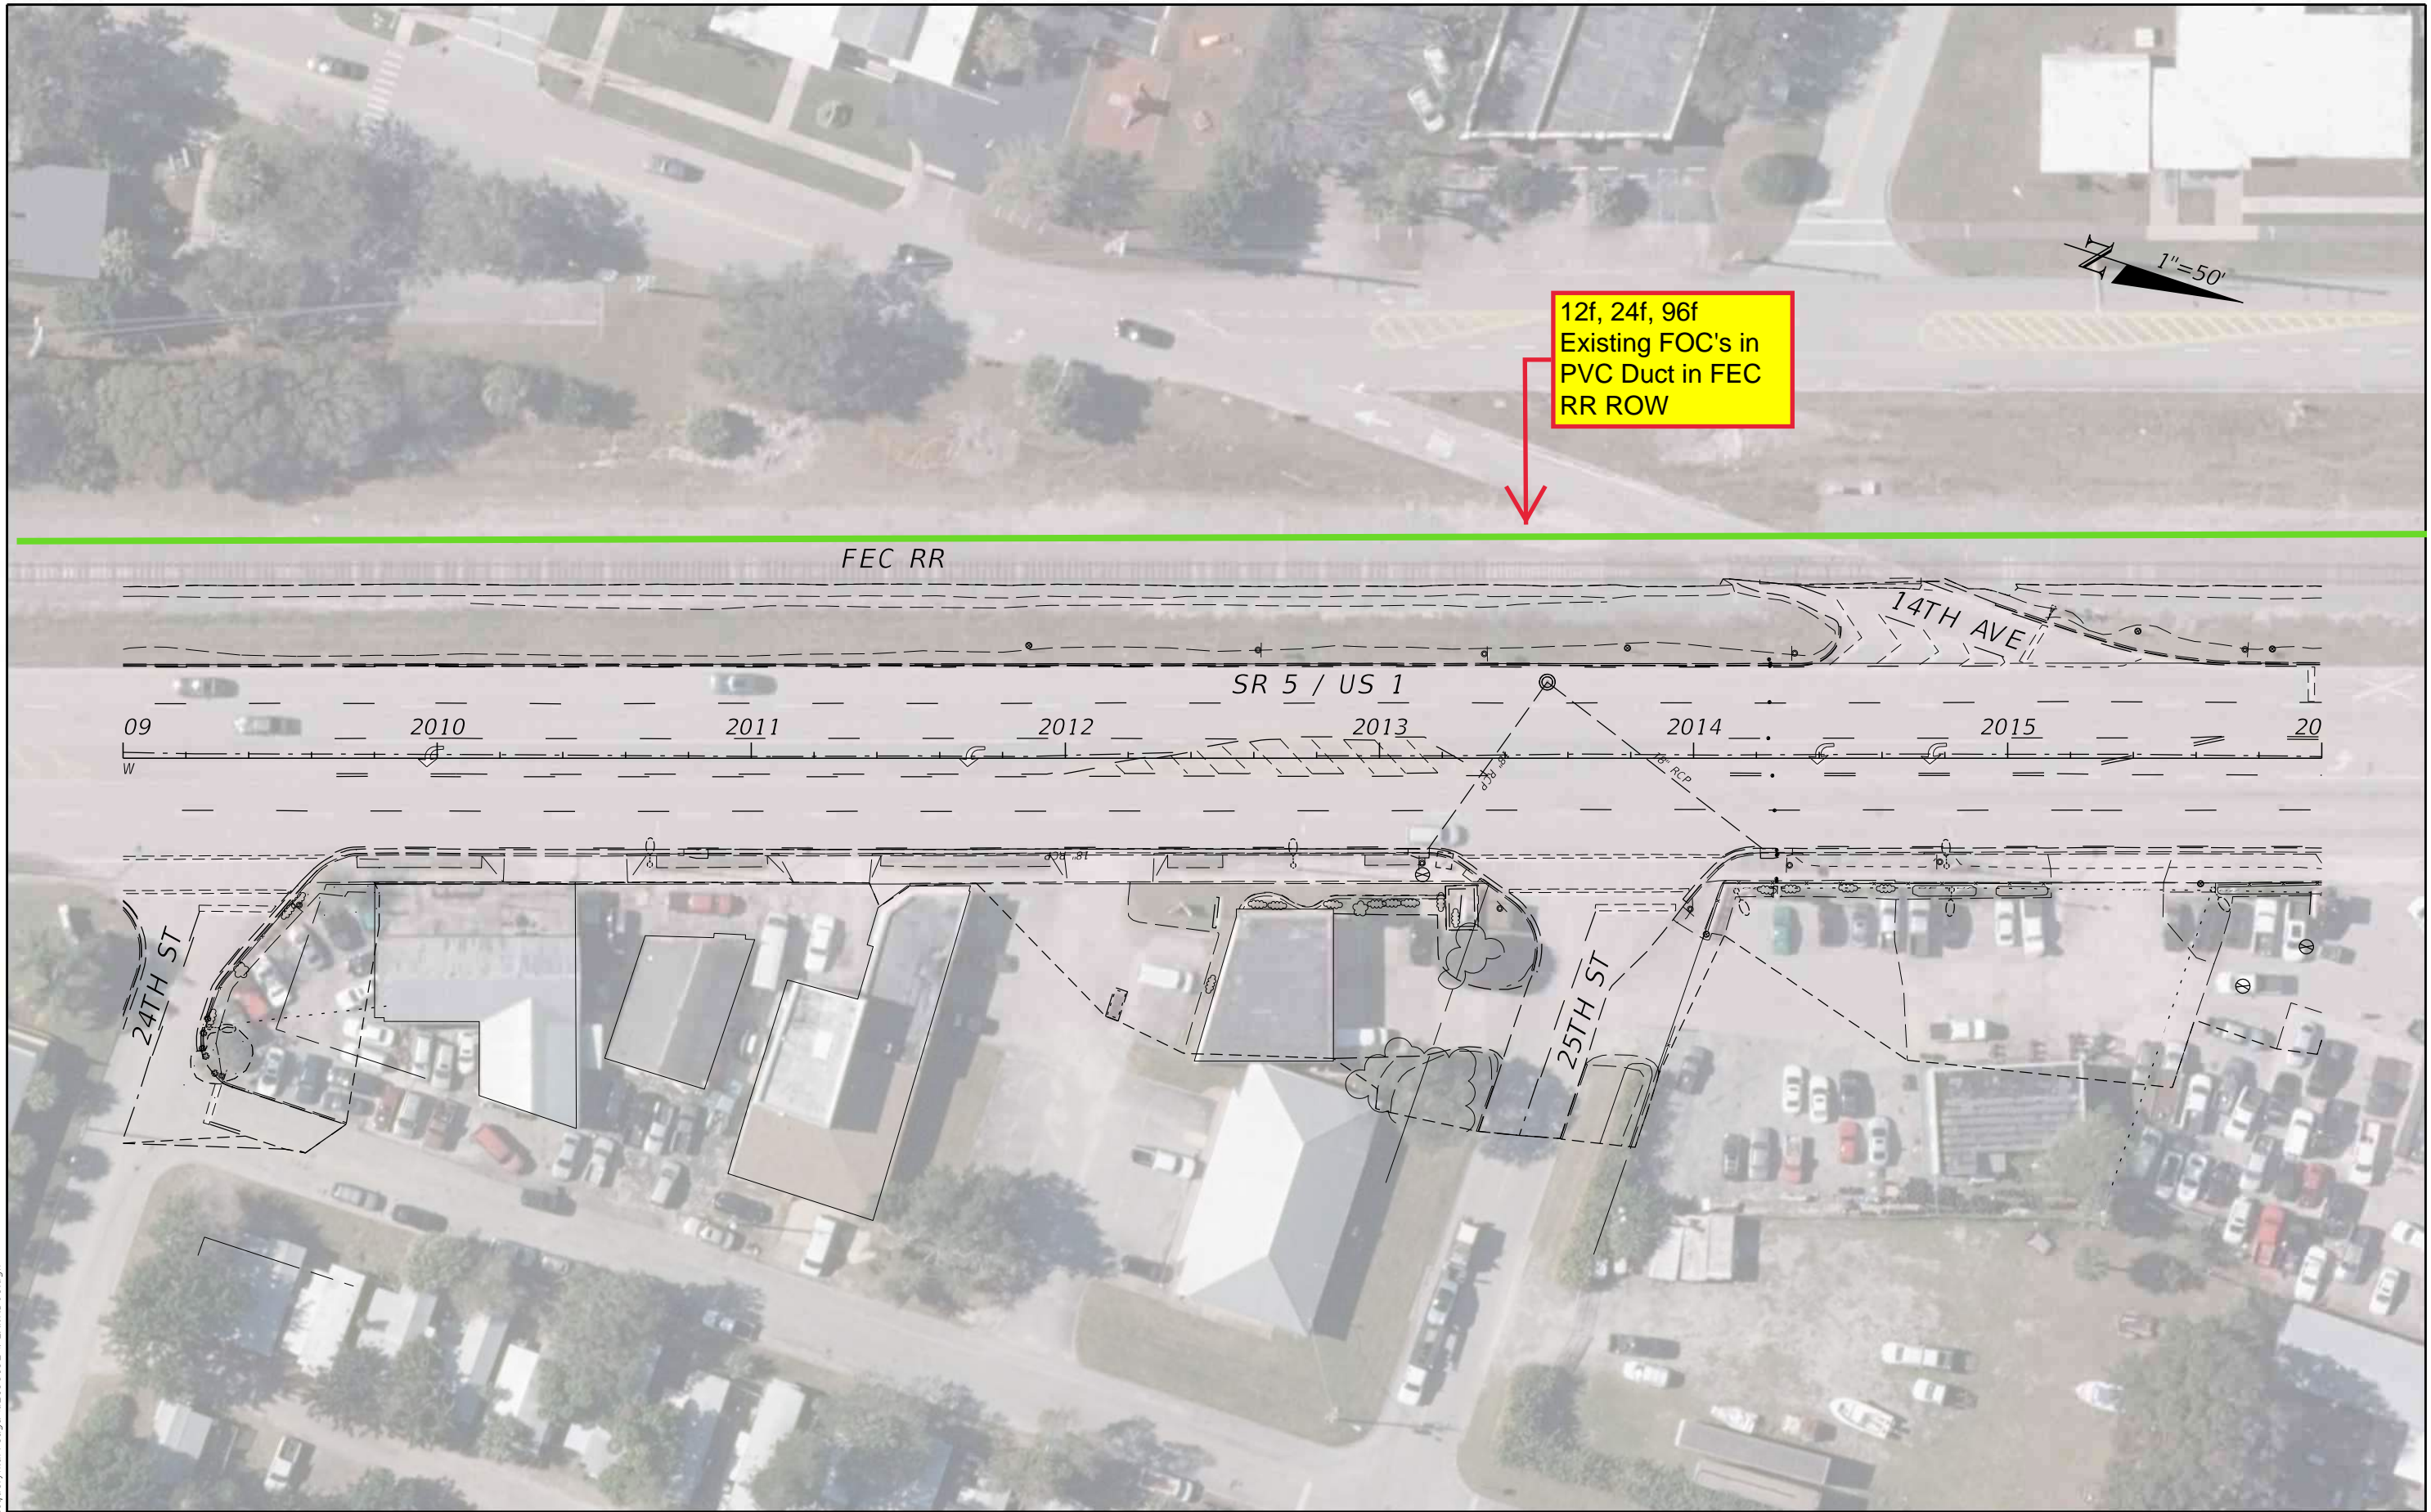

12f, 24f, 96f  
Existing FOC's in  
PVC Duct in FEC  
RR ROW

1"=50'

FEC RR

SR 5 / US 1

14TH AVE

09 2010 2011 2012 2013 2014 2015 20


24TH ST

25TH ST

9/15/2022 11:00:13 AM Jacquelyn.Arreaga  
c:\pwworking\wg\Jacquelyn.arreaga\d2198192\PLANRD01.dgn

DATE		REVISIONS		PROFESSIONAL TYPE	STATE OF FLORIDA DEPARTMENT OF TRANSPORTATION			UTILITY CONTACT PLAN (3)	SHEET NO.
DATE	DESCRIPTION	DATE	DESCRIPTION		ROAD NO.	COUNTY	FINANCIAL PROJECT ID		
				WILLIAM EVANS LICENSE NUMBER: 45207 WGI, INC. 2035 VISTA PARKWAY WEST PALM BEACH, FL 33411	SR 5	INDIAN RIVER	441693-1-22-02		3

THE OFFICIAL RECORD OF THIS SHEET IS THE ELECTRONIC FILE DIGITALLY SIGNED AND SEALED UNDER RULE 61G15-23.004, F.A.C.

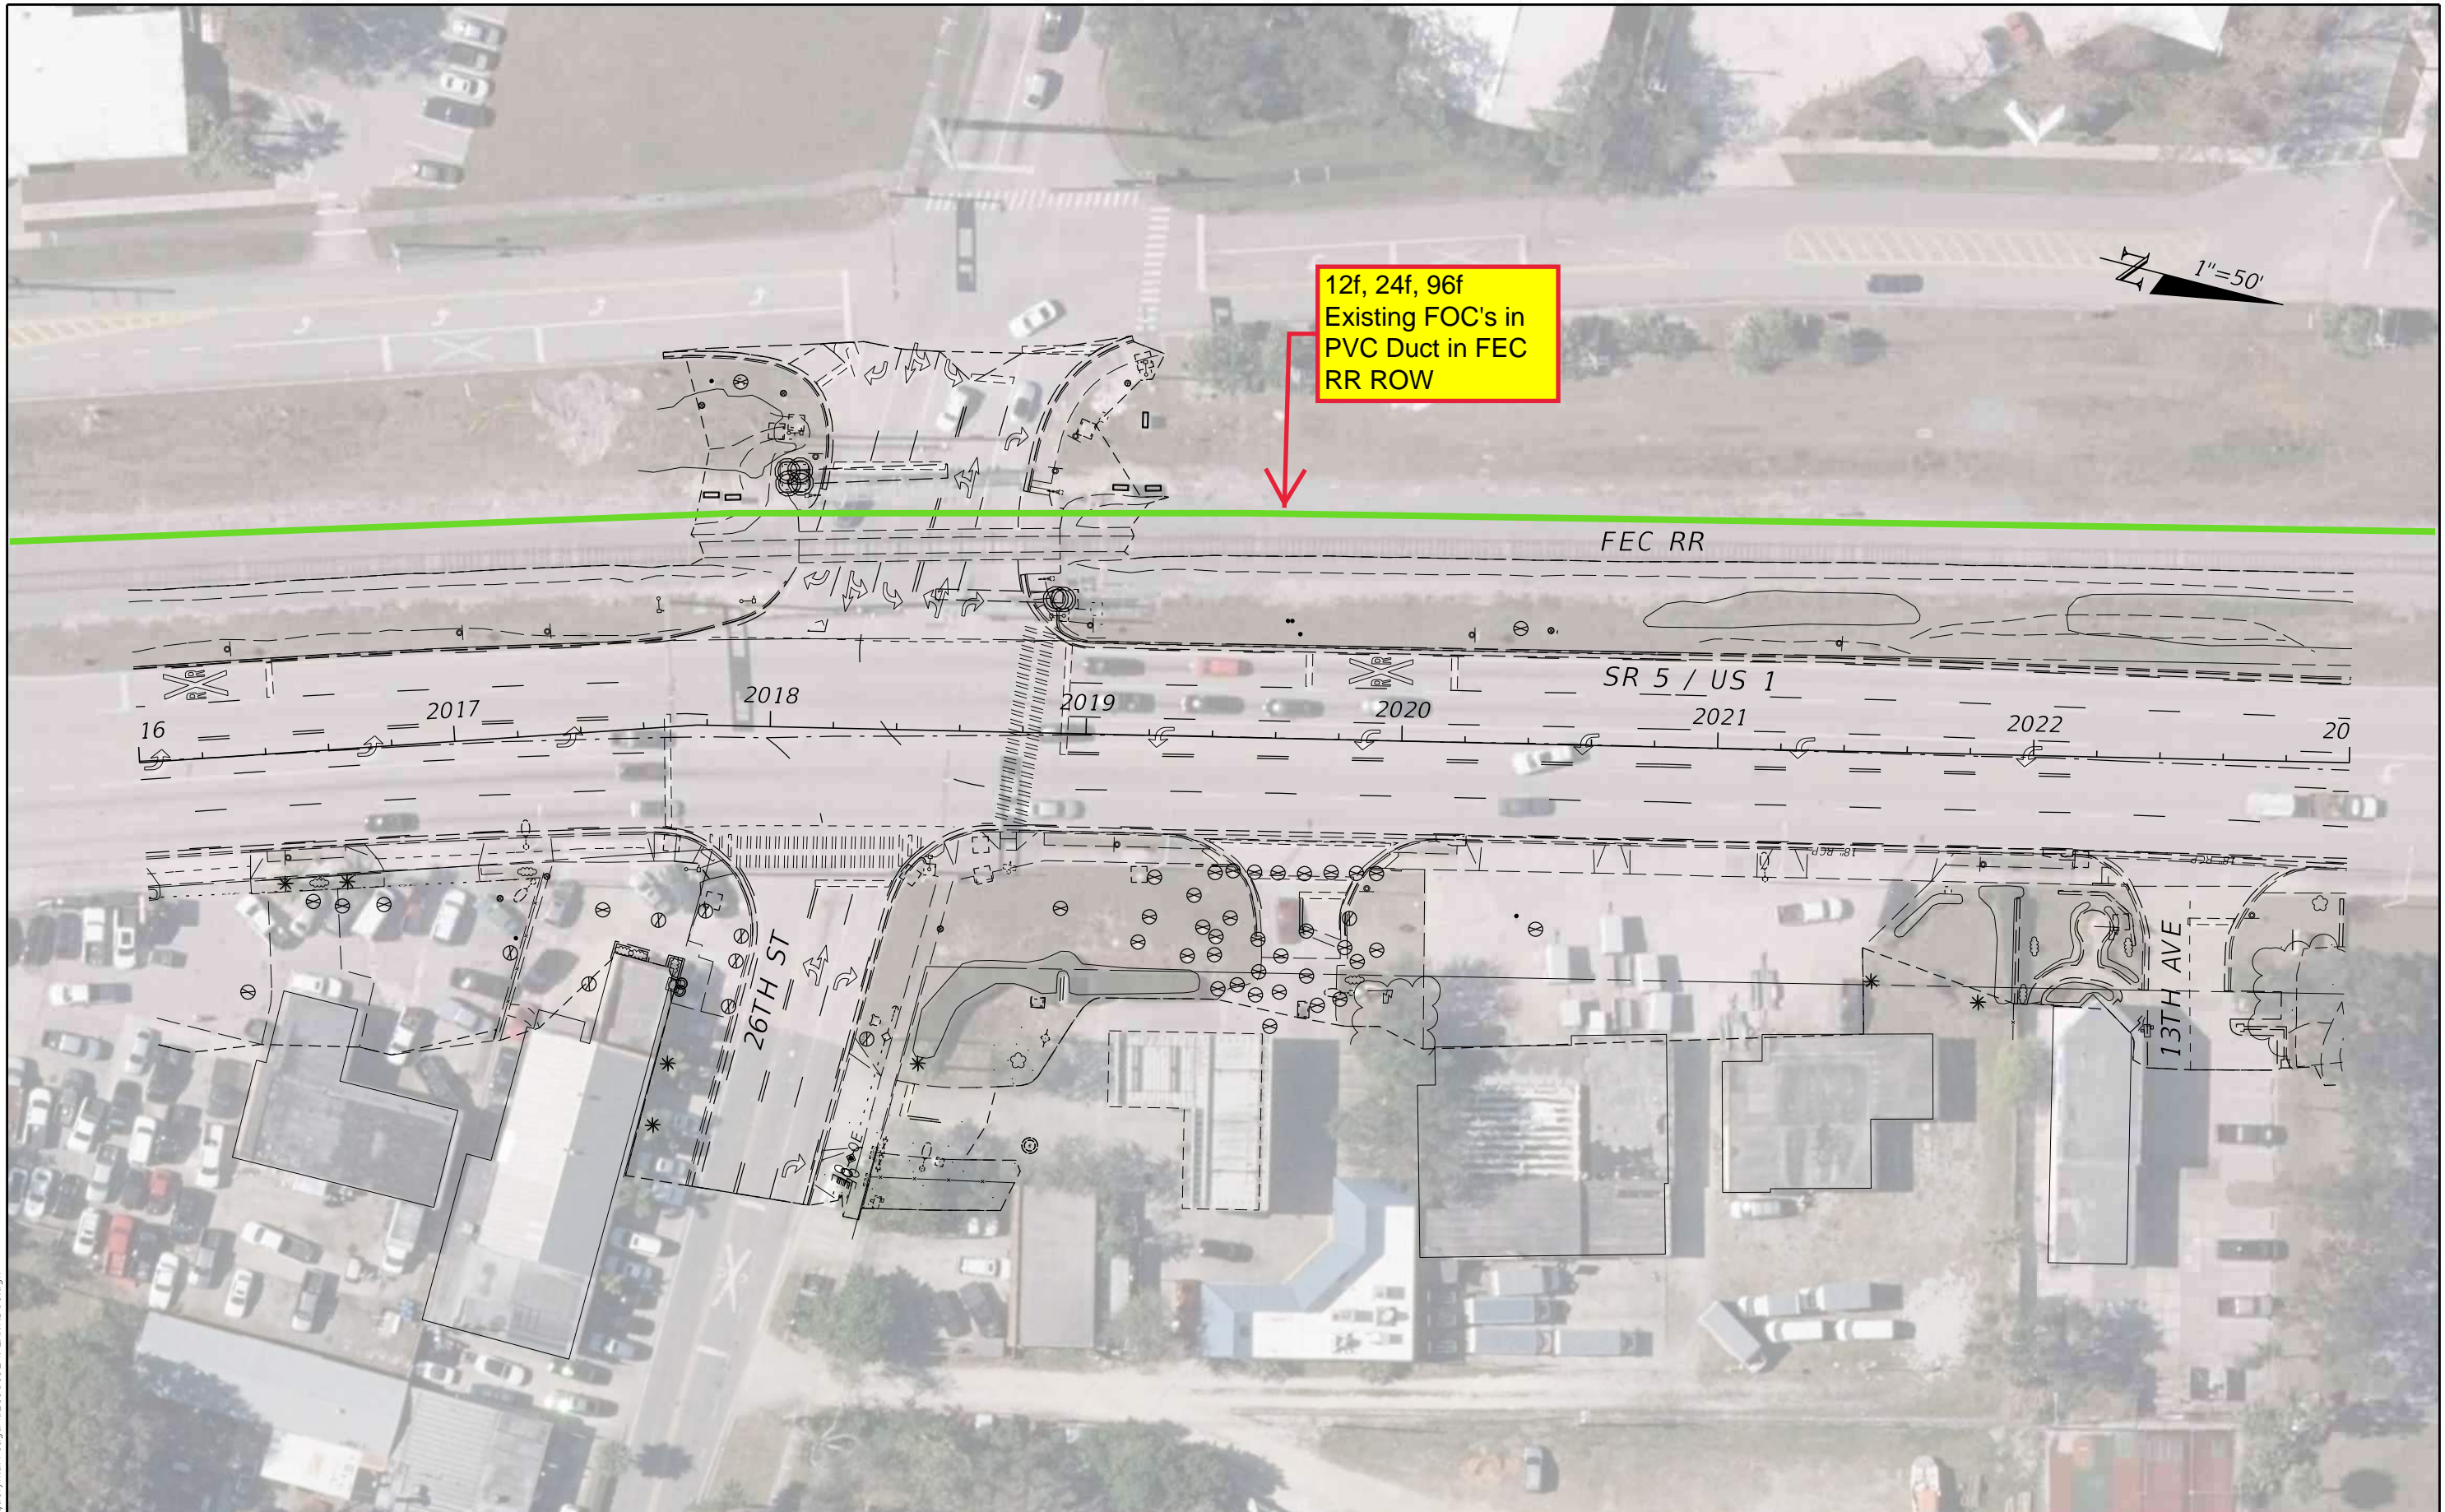

12f, 24f, 96f  
Existing FOC's in  
PVC Duct in FEC  
RR ROW

1"=50'

9/15/2022 11:00:42 AM Jacquelyn.Arreaga  
c:\pwworking\wgn\jacquelyn.arreaga\d2198192\PLANRD01.dgn

REVISIONS		PROFESSIONAL TYPE		STATE OF FLORIDA DEPARTMENT OF TRANSPORTATION			SHEET NO.
DATE	DESCRIPTION	DATE	DESCRIPTION	ROAD NO.	COUNTY	FINANCIAL PROJECT ID	
				SR 5	INDIAN RIVER	441693-1-22-02	4


UTILITY CONTACT PLAN (4)

THE OFFICIAL RECORD OF THIS SHEET IS THE ELECTRONIC FILE DIGITALLY SIGNED AND SEALED UNDER RULE 61G15-23.004, F.A.C.

12f, 24f, 96f  
Existing FOC's in  
PVC Duct in FEC  
RR ROW

12f & 24f Existing  
FOC's in PVC Duct  
in FEC RR ROW

96f Existing FOC in  
PVC Duct in FEC  
RR ROW

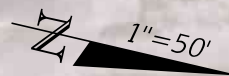

FEC RR

SR 5 / US 1

23 2024 2025 2026 2027 2028 2029 20

28TH ST

29TH ST

9/15/2022 11:00:51 AM Jacquelyn.Arreaga c:\pwworking\wgn\jacquelyn.arreaga\d2198192\PLANRD01.dgn

REVISIONS	
DATE	DESCRIPTION

PROFESSIONAL TYPE
WILLIAM EVANS LICENSE NUMBER: 45207 WGI, INC. 2035 VISTA PARKWAY WEST PALM BEACH, FL 33411

STATE OF FLORIDA DEPARTMENT OF TRANSPORTATION		
ROAD NO.	COUNTY	FINANCIAL PROJECT ID
SR 5	INDIAN RIVER	441693-1-22-02

UTILITY CONTACT PLAN (5)	
SHEET NO.	
5	


THE OFFICIAL RECORD OF THIS SHEET IS THE ELECTRONIC FILE DIGITALLY SIGNED AND SEALED UNDER RULE 61G15-23.004, F.A.C.

CITY OF VERO BEACH AIRPORT



12f & 24f Existing  
FOC's in PVC Duct  
in FEC RR ROW

96f Existing FOC in  
PVC Duct in FEC  
RR ROW

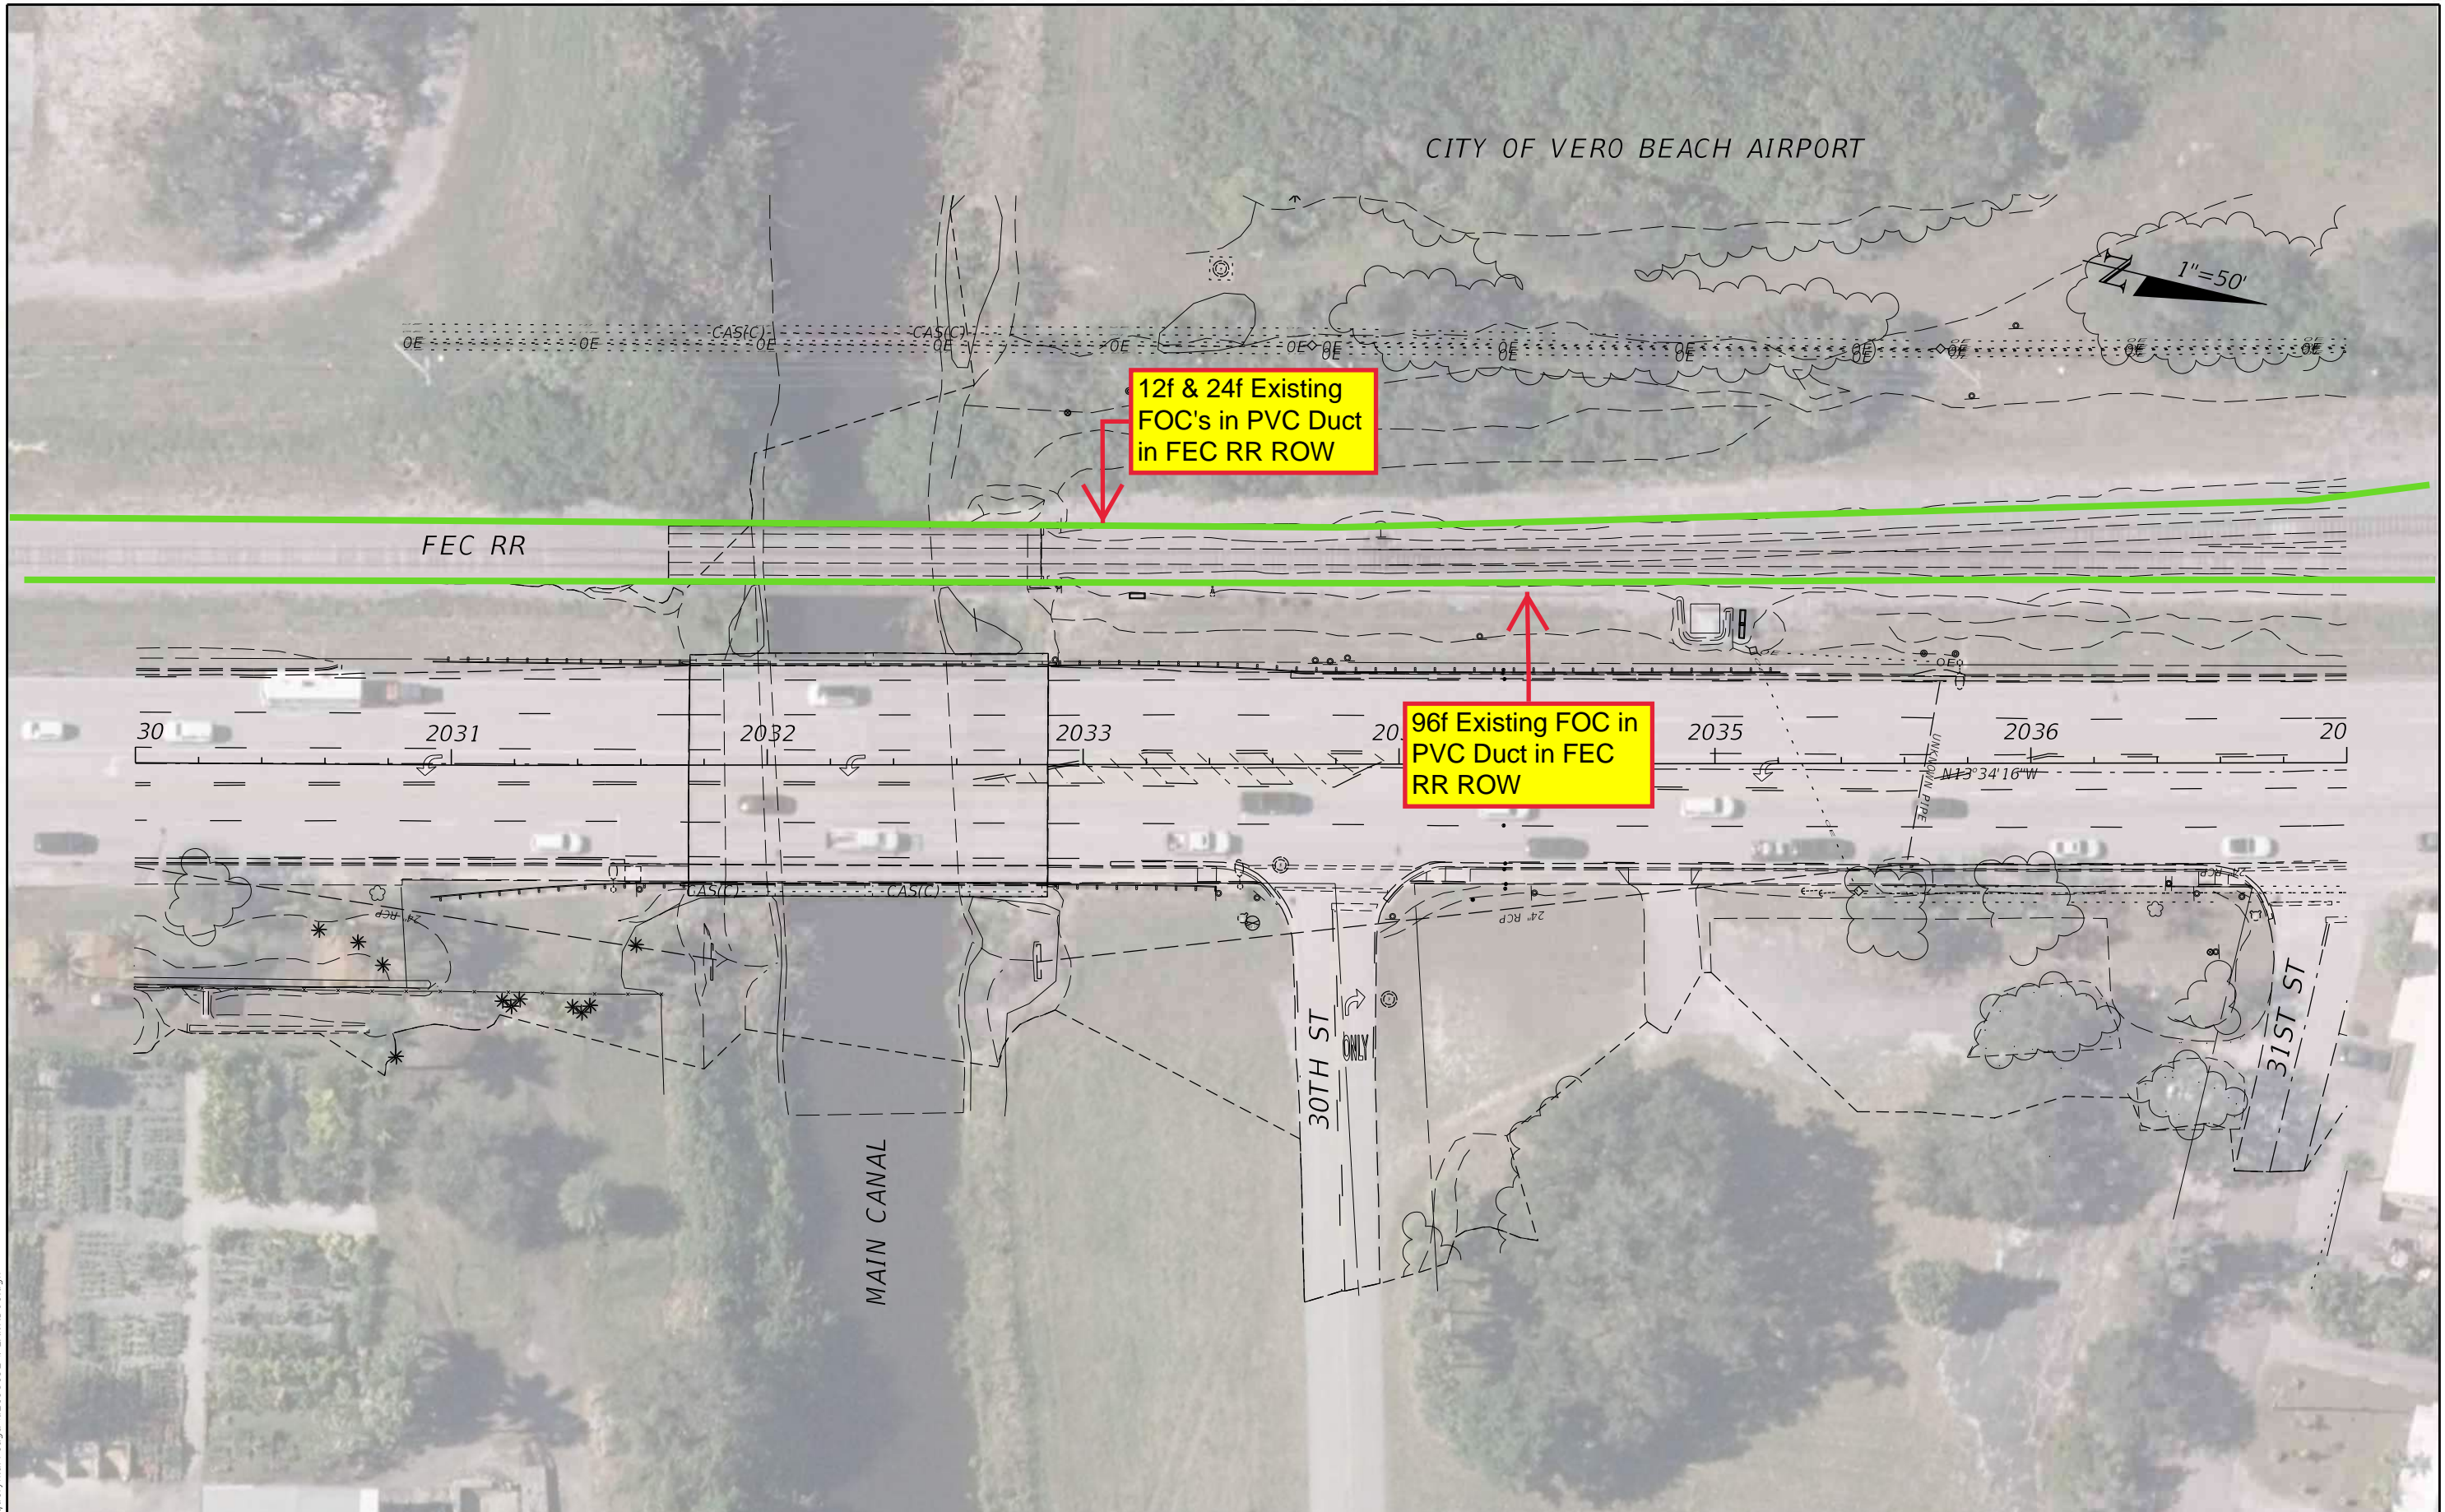


9/15/2022 11:01:04 AM Jacquelyn.Arreaga  
c:\pwworking\wgn\jacquelyn.arreaga\d2198192\PLANRD01.dgn

REVISIONS		PROFESSIONAL TYPE		STATE OF FLORIDA DEPARTMENT OF TRANSPORTATION			SHEET NO.
DATE	DESCRIPTION	DATE	DESCRIPTION	ROAD NO.	COUNTY	FINANCIAL PROJECT ID	
				SR 5	INDIAN RIVER	441693-1-22-02	6

UTILITY CONTACT PLAN (6)

THE OFFICIAL RECORD OF THIS SHEET IS THE ELECTRONIC FILE DIGITALLY SIGNED AND SEALED UNDER RULE 61G15-23.004, F.A.C.

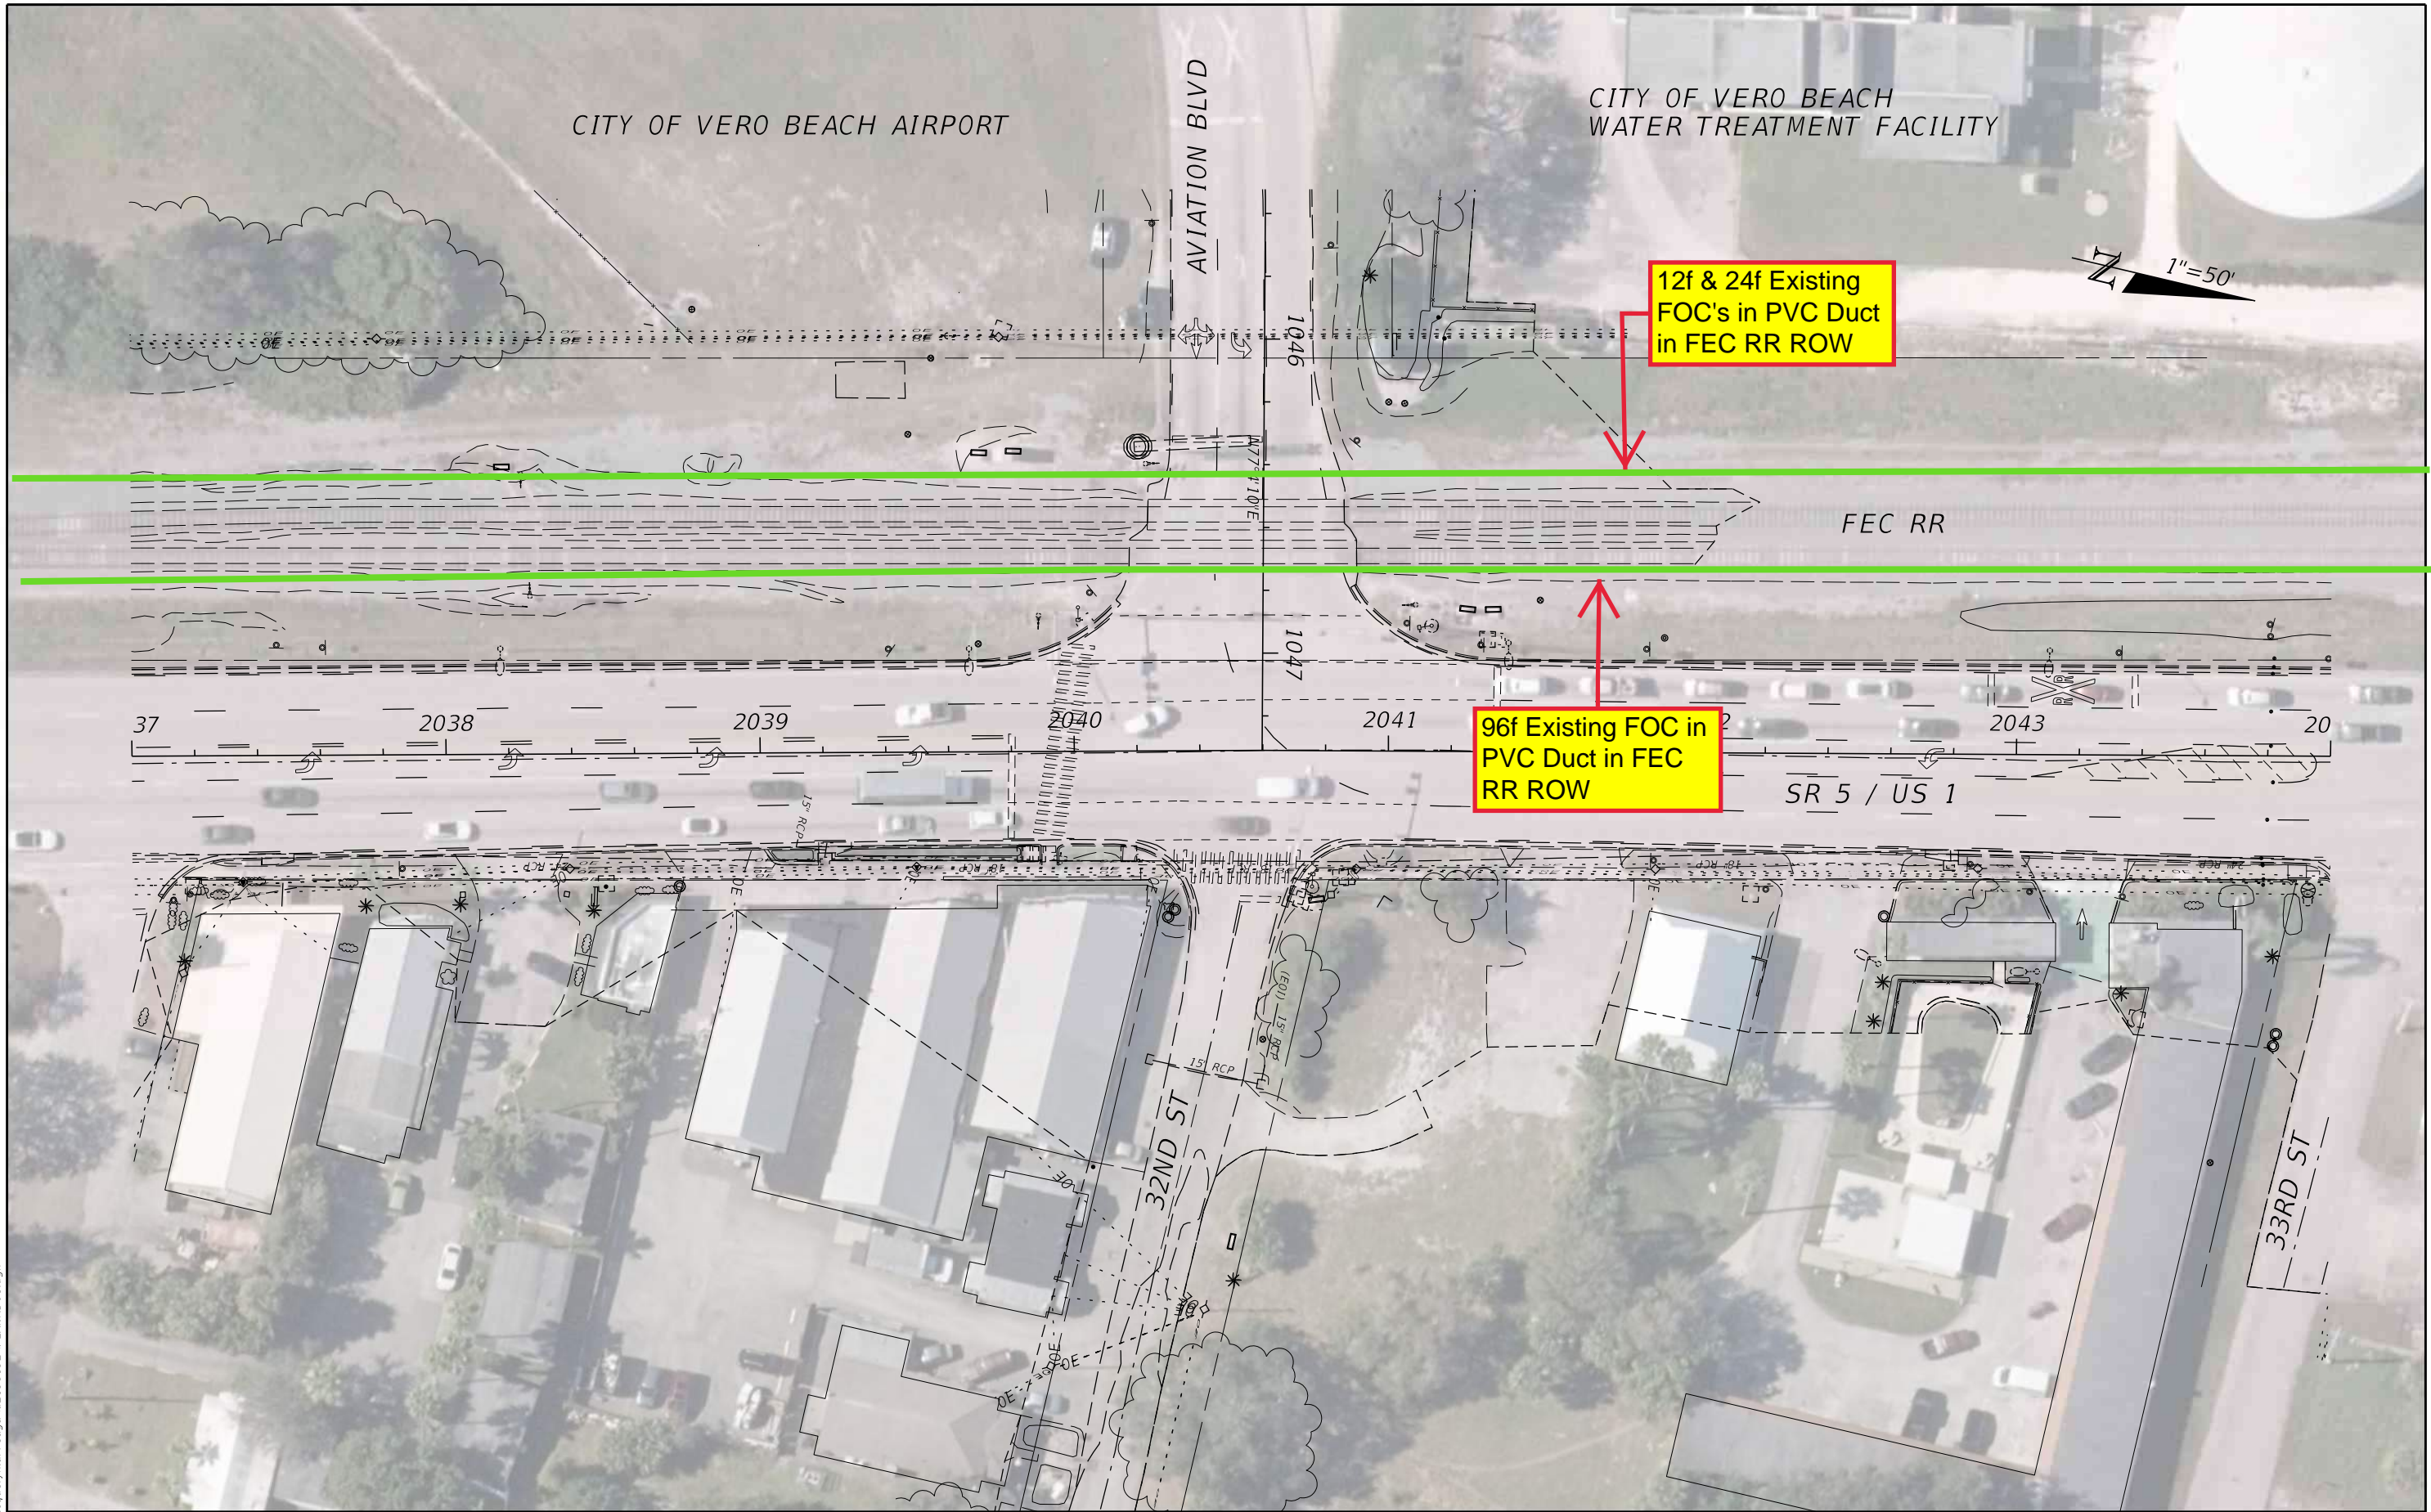

9/15/2022 11:01:42 AM Jacquelyn.Arreaga  
 c:\pwworking\wgn\jacquelyn.arreaga\d2198192\PLANRD01.dgn

REVISIONS		PROFESSIONAL TYPE		STATE OF FLORIDA DEPARTMENT OF TRANSPORTATION			SHEET NO.
DATE	DESCRIPTION	DATE	DESCRIPTION	ROAD NO.	COUNTY	FINANCIAL PROJECT ID	
				SR 5	INDIAN RIVER	441693-1-22-02	7

**UTILITY CONTACT PLAN (7)**

THE OFFICIAL RECORD OF THIS SHEET IS THE ELECTRONIC FILE DIGITALLY SIGNED AND SEALED UNDER RULE 61G15-23.004, F.A.C.


CITY OF VERO BEACH AIRPORT



12f & 24f Existing  
FOC's in PVC Duct  
in FEC RR ROW



96f Existing FOC in  
PVC Duct in FEC  
RR ROW

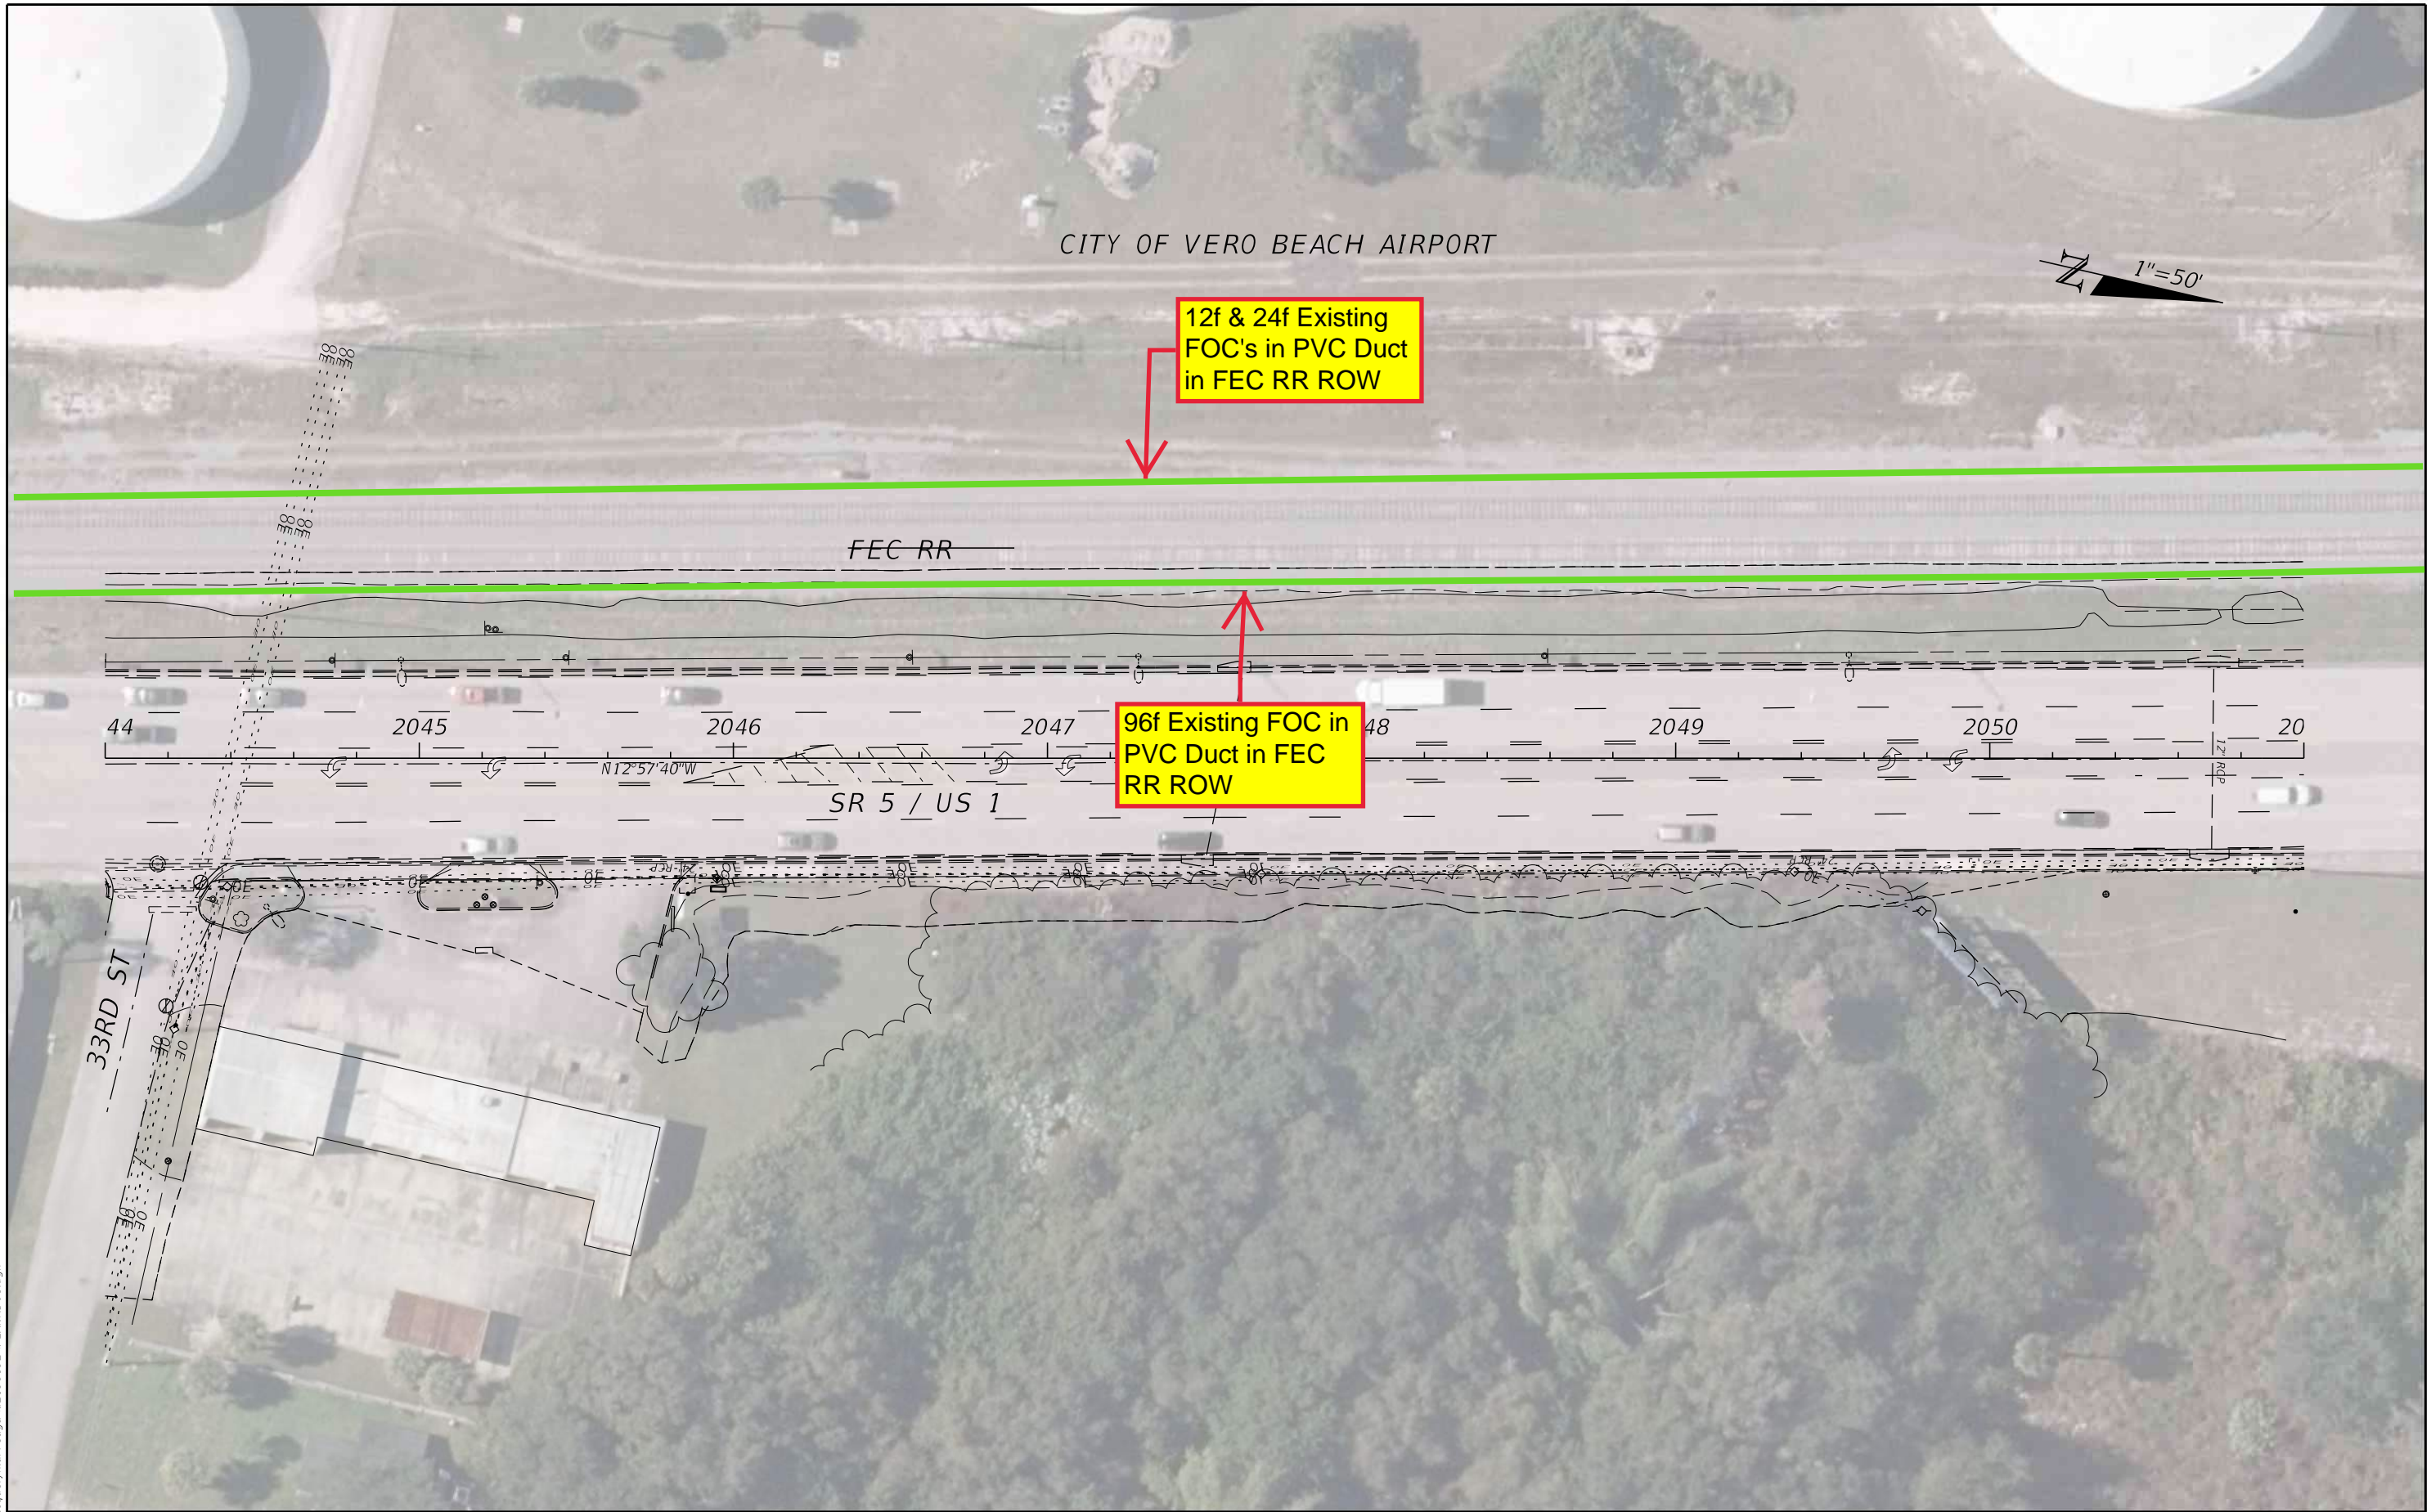

9/15/2022 11:02:24 AM Jacquelyn.Arreaga  
c:\pwworking\wgn\jacquelyn.arreaga\d2198192\PLANRD01.dgn

REVISIONS				PROFESSIONAL TYPE	STATE OF FLORIDA DEPARTMENT OF TRANSPORTATION			UTILITY CONTACT PLAN (8)	SHEET NO.  8
DATE	DESCRIPTION	DATE	DESCRIPTION		ROAD NO.	COUNTY	FINANCIAL PROJECT ID		
				WILLIAM EVANS LICENSE NUMBER: 45207 WGI, INC. 2035 VISTA PARKWAY WEST PALM BEACH, FL 33411	SR 5	INDIAN RIVER	441693-1-22-02		

THE OFFICIAL RECORD OF THIS SHEET IS THE ELECTRONIC FILE DIGITALLY SIGNED AND SEALED UNDER RULE 61G15-23.004, F.A.C.


CITY OF VERO BEACH AIRPORT



12f & 24f Existing  
FOC's in PVC Duct  
in FEC RR ROW

FEC RR

96f Existing FOC in  
PVC Duct in FEC  
RR ROW

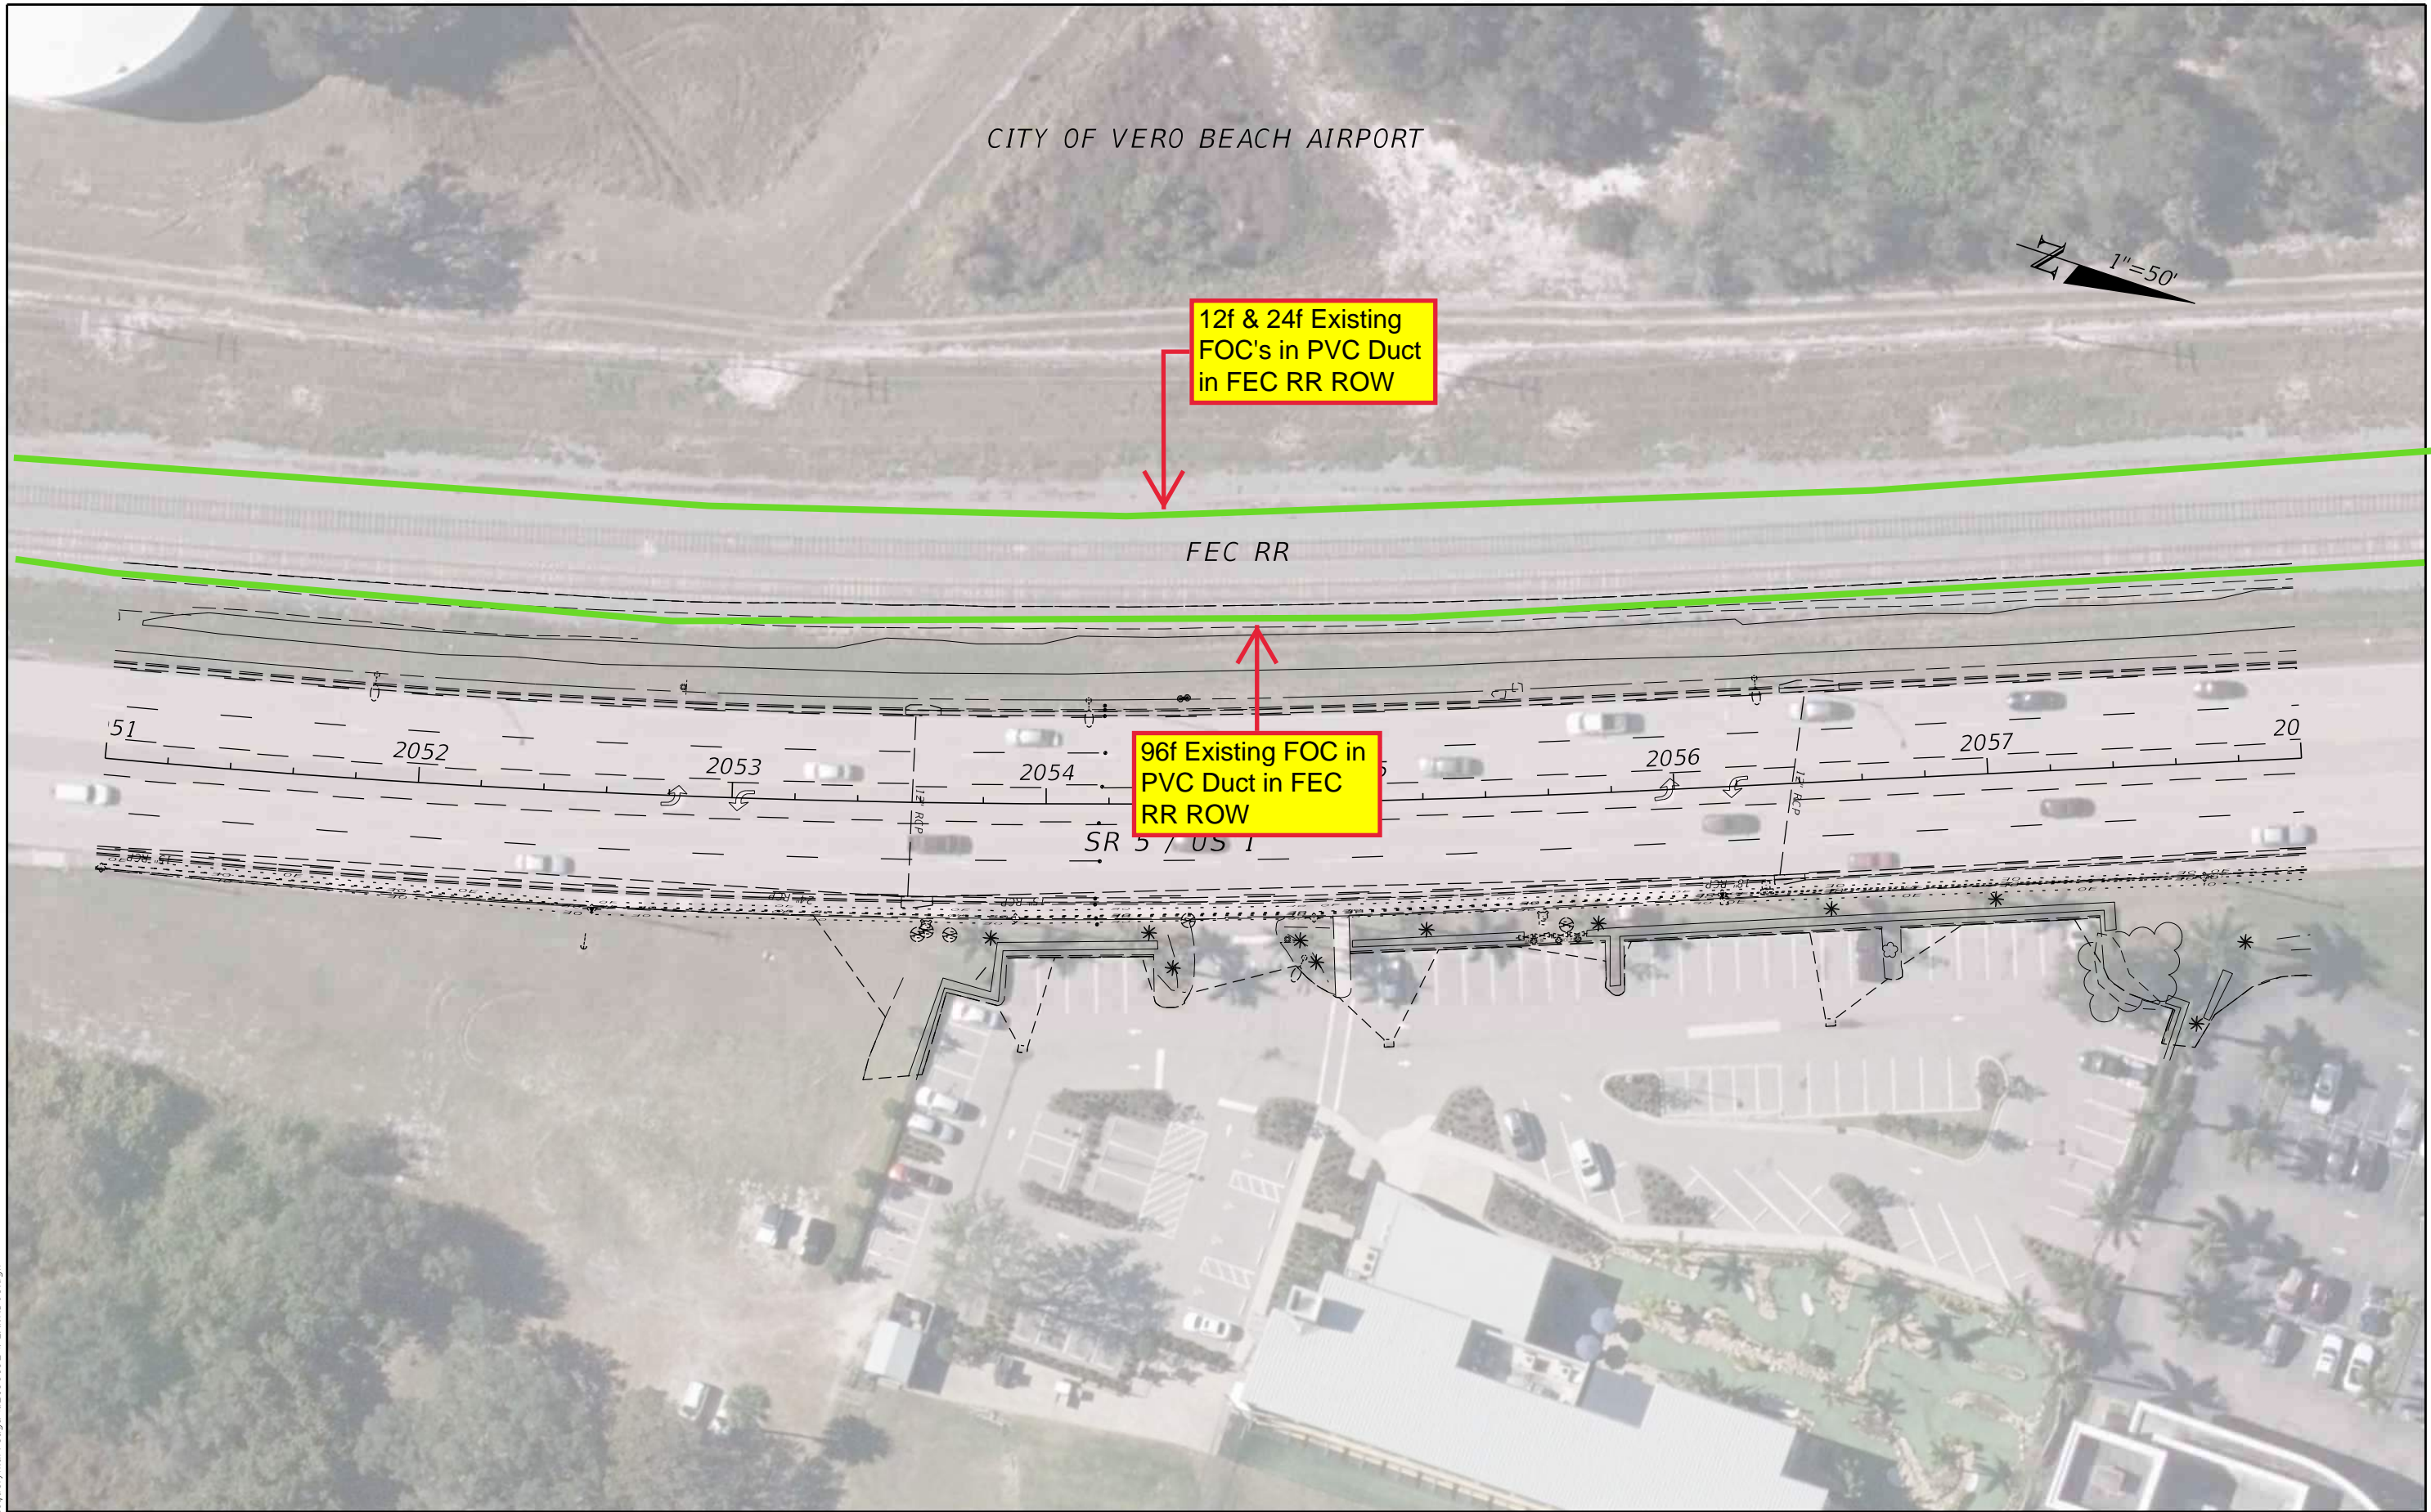

9/15/2022 11:02:50 AM Jacquelyn.Arreaga  
c:\pwworking\wgn\jacquelyn.arreaga\d2198192\PLANRD01.dgn

REVISIONS		PROFESSIONAL TYPE		STATE OF FLORIDA DEPARTMENT OF TRANSPORTATION			SHEET NO.
DATE	DESCRIPTION	DATE	DESCRIPTION	ROAD NO.	COUNTY	FINANCIAL PROJECT ID	
				SR 5	INDIAN RIVER	441693-1-22-02	9

**UTILITY CONTACT PLAN (9)**

THE OFFICIAL RECORD OF THIS SHEET IS THE ELECTRONIC FILE DIGITALLY SIGNED AND SEALED UNDER RULE 61G15-23.004, F.A.C.



CITY OF VERO BEACH AIRPORT



12f & 24f Existing  
FOC's in PVC Duct  
in FEC RR ROW

FEC RR

96f Existing FOC in  
PVC Duct in FEC  
RR ROW

SR 5 / US 1

PICKERILL LN

58 2059 2060 2062 2063 2064 20

9/15/2022 11:03:08 AM Jacquelyn.Arreaga c:\pwworking\wgn\jacquelyn.arreaga\d2198192\PLANRD01.dgn

REVISIONS		PROFESSIONAL TYPE		STATE OF FLORIDA DEPARTMENT OF TRANSPORTATION			UTILITY CONTACT PLAN (10)	SHEET NO.  10
DATE	DESCRIPTION	DATE	DESCRIPTION	ROAD NO.	COUNTY	FINANCIAL PROJECT ID		
				SR 5	INDIAN RIVER	441693-1-22-02		

THE OFFICIAL RECORD OF THIS SHEET IS THE ELECTRONIC FILE DIGITALLY SIGNED AND SEALED UNDER RULE 61G15-23.004, F.A.C.

CITY OF VERO BEACH AIRPORT




12f & 24f Existing  
FOC's in PVC Duct  
in FEC RR ROW

FEC RR

96f Existing FOC in  
PVC Duct in FEC  
RR ROW

SR 5 / US 1

36TH ST

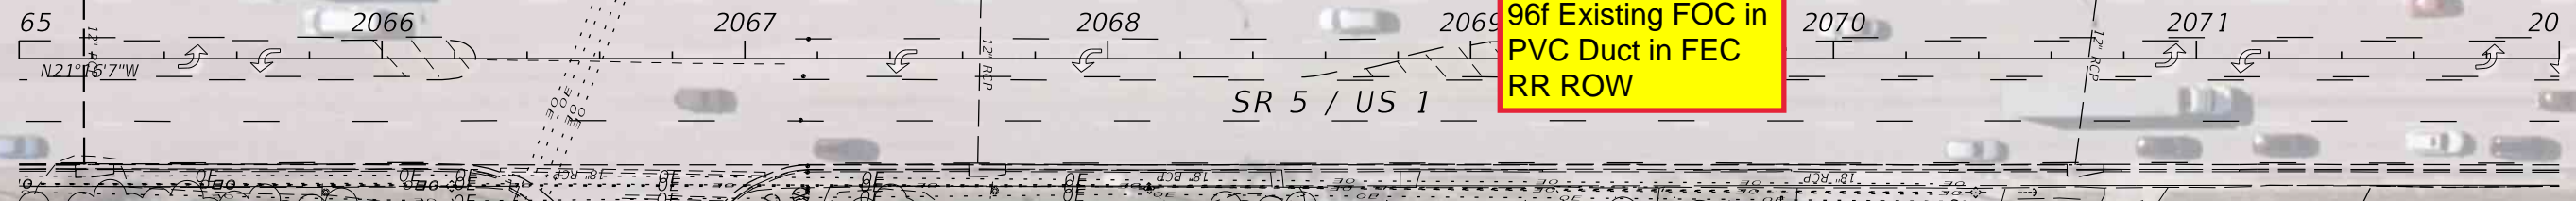

9/15/2022 11:03:42 AM Jacquelyn.Arreaga  
c:\pwworking\wgn\jacquelyn.arreaga\d2198192\PLANRD01.dgn

REVISIONS		PROFESSIONAL TYPE		STATE OF FLORIDA DEPARTMENT OF TRANSPORTATION			UTILITY CONTACT PLAN (11)	SHEET NO.  11
DATE	DESCRIPTION	DATE	DESCRIPTION	ROAD NO.	COUNTY	FINANCIAL PROJECT ID		
				SR 5	INDIAN RIVER	441693-1-22-02		

THE OFFICIAL RECORD OF THIS SHEET IS THE ELECTRONIC FILE DIGITALLY SIGNED AND SEALED UNDER RULE 61G15-23.004, F.A.C.

CITY OF VERO BEACH AIRPORT

12f & 24f Existing  
FOC's in PVC Duct  
in FEC RR ROW

96f Existing FOC in  
PVC Duct in FEC  
RR ROW

1"=50'

FEC RR

SR 5 / US 1

72

2073

2074

2075

2076

2078

37TH ST

37TH PL

9/15/2022 11:04:09 AM Jacquelyn.Arreaga  
c:\pwworking\wg\N\Jacquelyn.arreaga\d2198192\PLANRD01.dgn

REVISIONS		REVISIONS	
DATE	DESCRIPTION	DATE	DESCRIPTION

PROFESSIONAL TYPE  
WILLIAM EVANS  
LICENSE NUMBER: 45207  
WGI, INC.  
2035 VISTA PARKWAY  
WEST PALM BEACH, FL 33411

STATE OF FLORIDA DEPARTMENT OF TRANSPORTATION		
ROAD NO.	COUNTY	FINANCIAL PROJECT ID
SR 5	INDIAN RIVER	441693-1-22-02


**UTILITY CONTACT PLAN (12)**

SHEET NO.  
12

THE OFFICIAL RECORD OF THIS SHEET IS THE ELECTRONIC FILE DIGITALLY SIGNED AND SEALED UNDER RULE 61G15-23.004, F.A.C.

12f & 24f Existing  
FOC's in PVC Duct  
in FEC RR ROW

96f Existing FOC in  
PVC Duct in FEC  
RR ROW

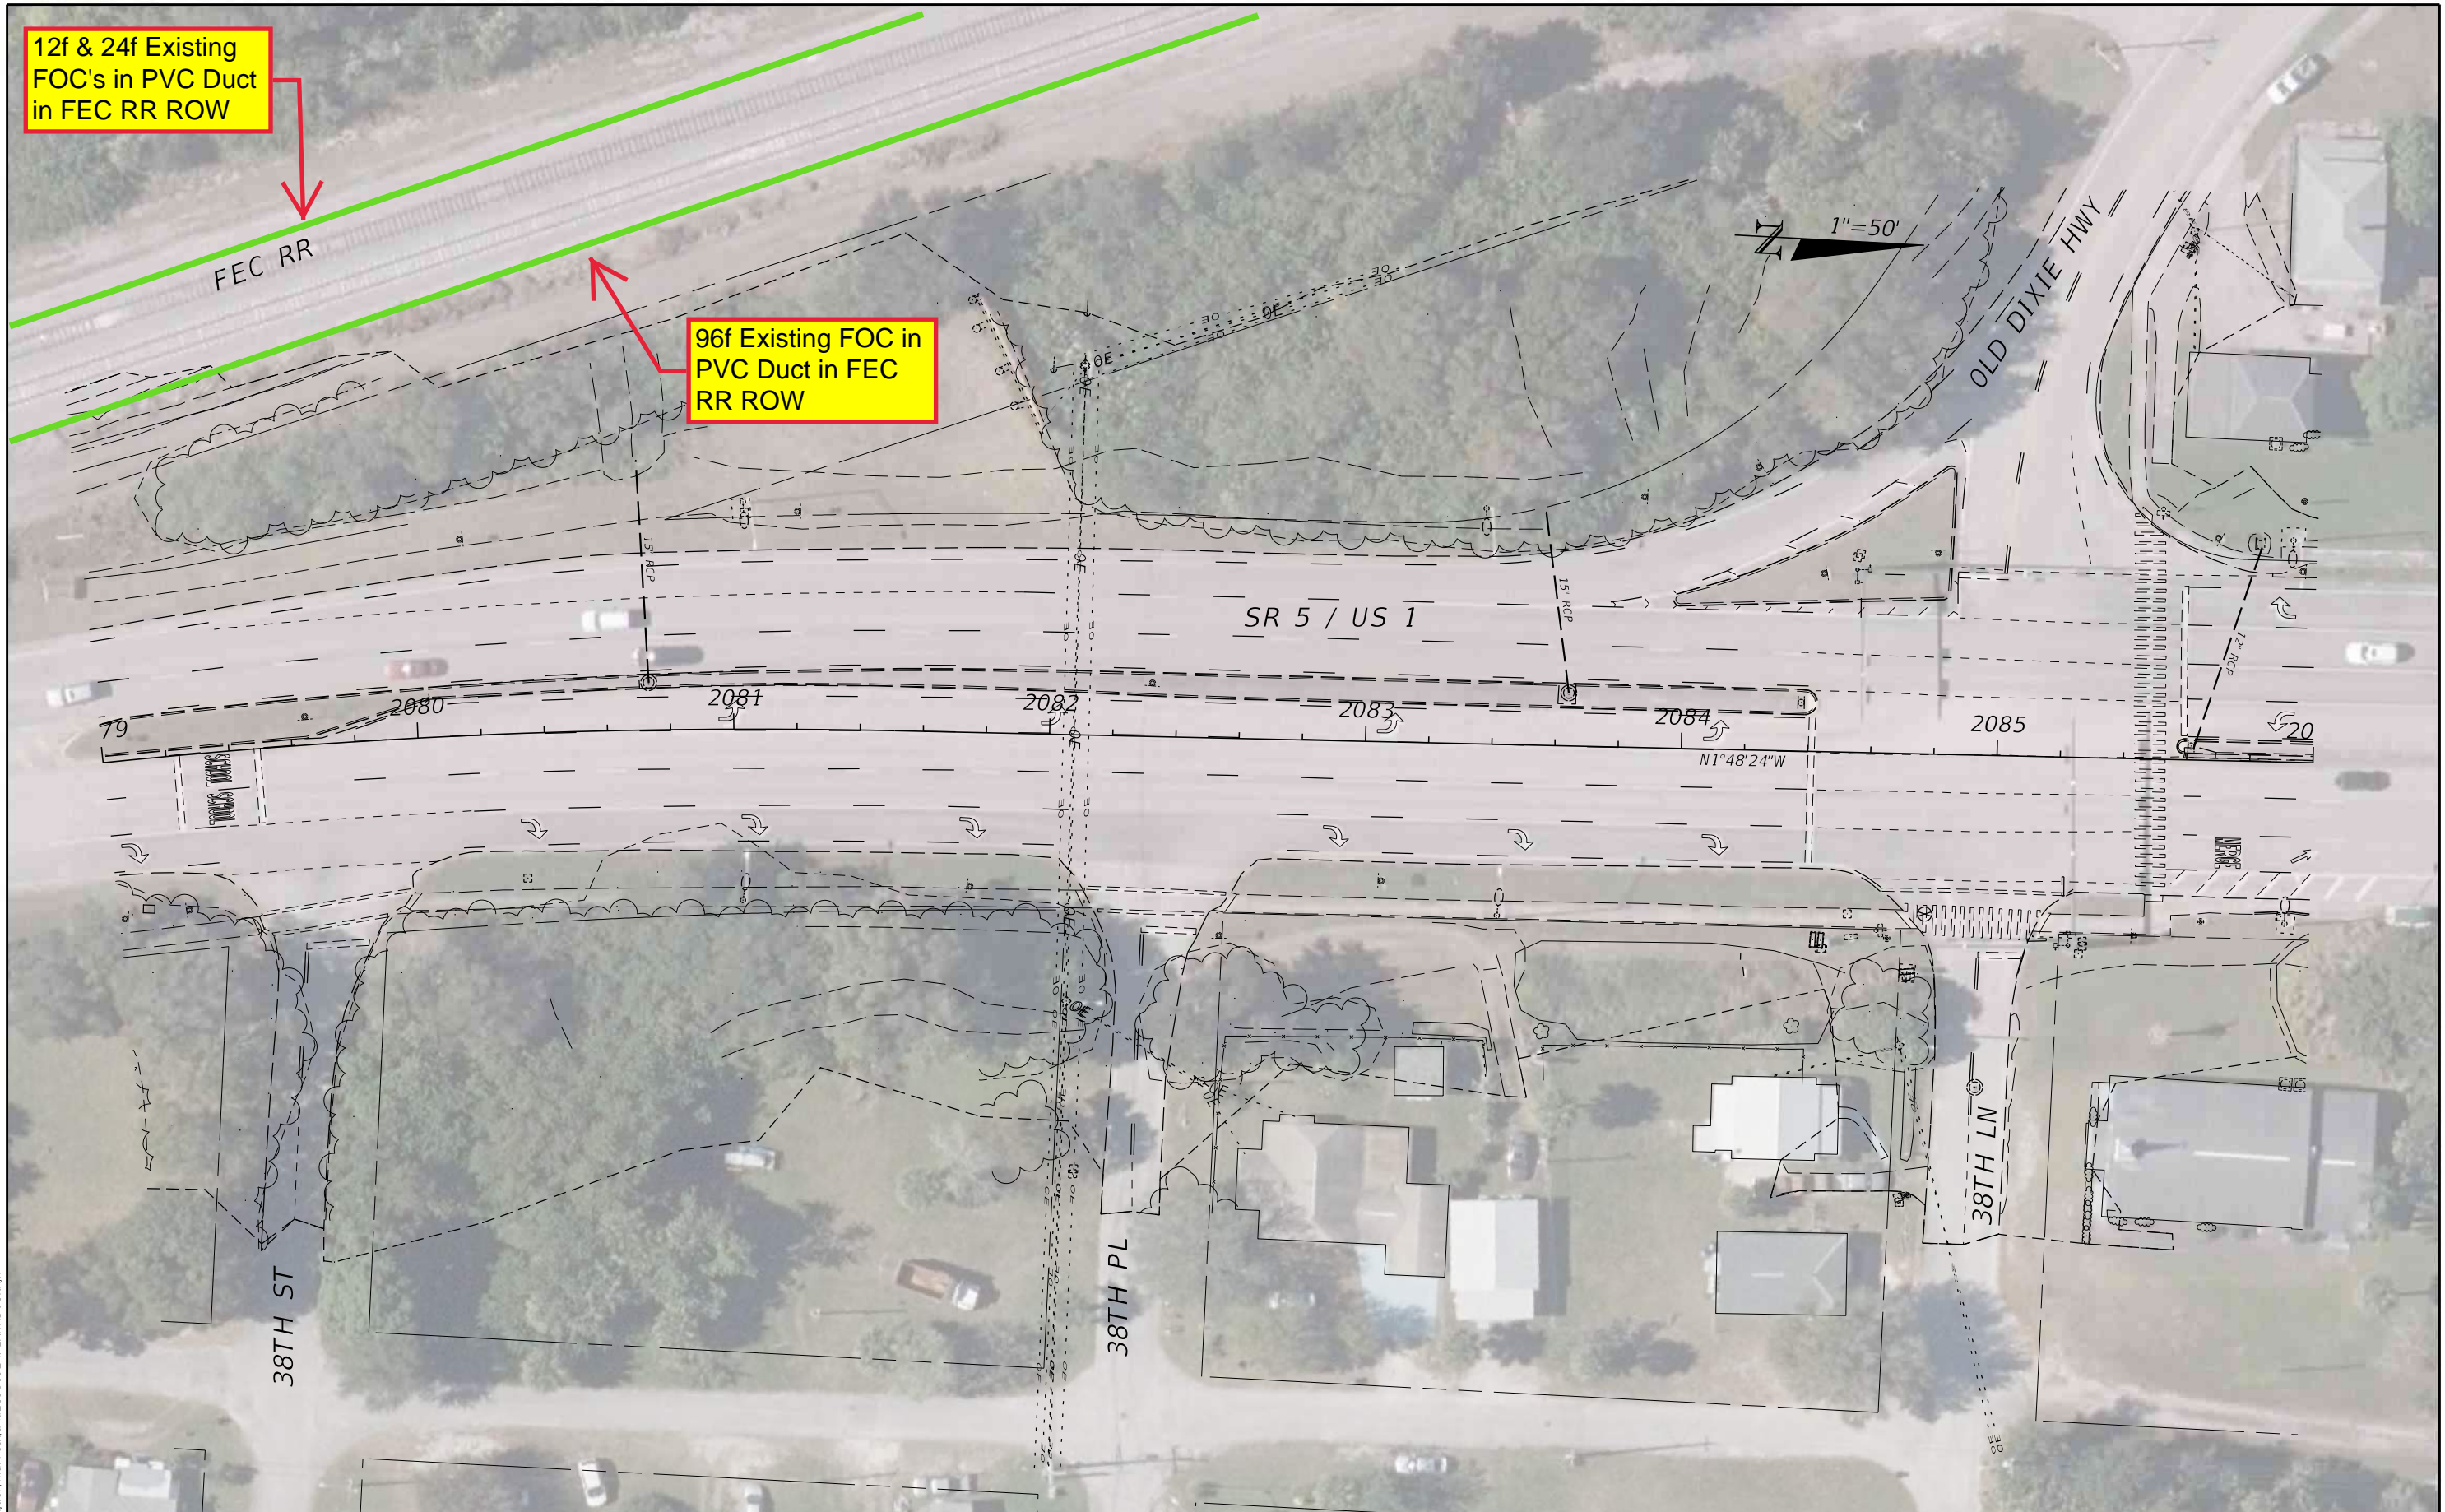

9/15/2022 11:04:36 AM Jacquelyn.Arreaga  
c:\pwworking\wgn\jacquelyn.arreaga\d2198192\PLANRD01.dgn

REVISIONS		REVISIONS	
DATE	DESCRIPTION	DATE	DESCRIPTION

PROFESSIONAL TYPE  
WILLIAM EVANS  
LICENSE NUMBER: 45207  
WGI, INC.  
2035 VISTA PARKWAY  
WEST PALM BEACH, FL 33411

STATE OF FLORIDA DEPARTMENT OF TRANSPORTATION		
ROAD NO.	COUNTY	FINANCIAL PROJECT ID
SR 5	INDIAN RIVER	441693-1-22-02


**UTILITY CONTACT PLAN (13)**

SHEET NO.
13

THE OFFICIAL RECORD OF THIS SHEET IS THE ELECTRONIC FILE DIGITALLY SIGNED AND SEALED UNDER RULE 61G15-23.004, F.A.C.



No Verizon/MCI  
Facilities This  
Sheet

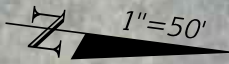

86

2087

2088

2089

2090

2091

2092

20

SR 5 / US 1

39TH ST


9/15/2022 11:05:04 AM Jacquelyn.Arreaga  
c:\pwworking\wgn\jacquelyn.arreaga\d2198192\PLANRD01.dgn

REVISIONS				PROFESSIONAL TYPE	STATE OF FLORIDA DEPARTMENT OF TRANSPORTATION			UTILITY CONTACT PLAN (14)	SHEET NO.  14
DATE	DESCRIPTION	DATE	DESCRIPTION		ROAD NO.	COUNTY	FINANCIAL PROJECT ID		
				WILLIAM EVANS LICENSE NUMBER: 45207 WGI, INC. 2035 VISTA PARKWAY WEST PALM BEACH, FL 33411	SR 5	INDIAN RIVER	441693-1-22-02		

THE OFFICIAL RECORD OF THIS SHEET IS THE ELECTRONIC FILE DIGITALLY SIGNED AND SEALED UNDER RULE 61G15-23.004, F.A.C.



No Verizon/MCI  
Facilities This  
Sheet

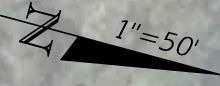

93      2094      2095      2096      2097      2098      2099      21

N15°6'28"W

SR 5 / US 1

9/15/2022 11:05:51 AM Jacquelyn.Arreaga c:\pwworking\wg\N\jacquelyn.arreaga\2198192\PLANRD01.dgn

REVISIONS				PROFESSIONAL TYPE	STATE OF FLORIDA DEPARTMENT OF TRANSPORTATION			UTILITY CONTACT PLAN (15)	SHEET NO.
DATE	DESCRIPTION	DATE	DESCRIPTION	WILLIAM EVANS LICENSE NUMBER: 45207 WGI, INC. 2035 VISTA PARKWAY WEST PALM BEACH, FL 33411	ROAD NO.	COUNTY	FINANCIAL PROJECT ID		15
						SR 5	INDIAN RIVER		

THE OFFICIAL RECORD OF THIS SHEET IS THE ELECTRONIC FILE DIGITALLY SIGNED AND SEALED UNDER RULE 61G15-23.004, F.A.C.



9/15/2022 11:06:09 AM Jacquelyn.Arreaga c:\pwworking\wg\N\jacquelyn.arreaga\d2198192\PLANRD01.dgn

THE OFFICIAL RECORD OF THIS SHEET IS THE ELECTRONIC FILE DIGITALLY SIGNED AND SEALED UNDER RULE 61G15-23.004, F.A.C.

REVISIONS				PROFESSIONAL TYPE	STATE OF FLORIDA DEPARTMENT OF TRANSPORTATION			UTILITY CONTACT PLAN (16)	SHEET NO.
DATE	DESCRIPTION	DATE	DESCRIPTION	WILLIAM EVANS LICENSE NUMBER: 45207 WGI, INC. 2035 VISTA PARKWAY WEST PALM BEACH, FL 33411	ROAD NO.	COUNTY	FINANCIAL PROJECT ID		16
					SR 5	INDIAN RIVER	441693-1-22-02		



No Verizon/MCI  
Facilities This  
Sheet

SEE SHEET 6

1"=50'

MAIN CANAL

30TH ST

13TH AVE

31ST ST


9/15/2022 11:06:48 AM Jacquelyn.Arreaga  
c:\pwworking\wg\N\jacquelyn.arreaga\2198192\PLAN\RD01.dgn

REVISIONS		PROFESSIONAL TYPE		STATE OF FLORIDA DEPARTMENT OF TRANSPORTATION			UTILITY CONTACT PLAN (17)	SHEET NO.  17
DATE	DESCRIPTION	DATE	DESCRIPTION	ROAD NO.	COUNTY	FINANCIAL PROJECT ID		
				SR 5	INDIAN RIVER	441693-1-22-02		

WILLIAM EVANS  
LICENSE NUMBER: 45207  
WGI, INC.  
2035 VISTA PARKWAY  
WEST PALM BEACH, FL 33411

THE OFFICIAL RECORD OF THIS SHEET IS THE ELECTRONIC FILE DIGITALLY SIGNED AND SEALED UNDER RULE 61G15-23.004, F.A.C.



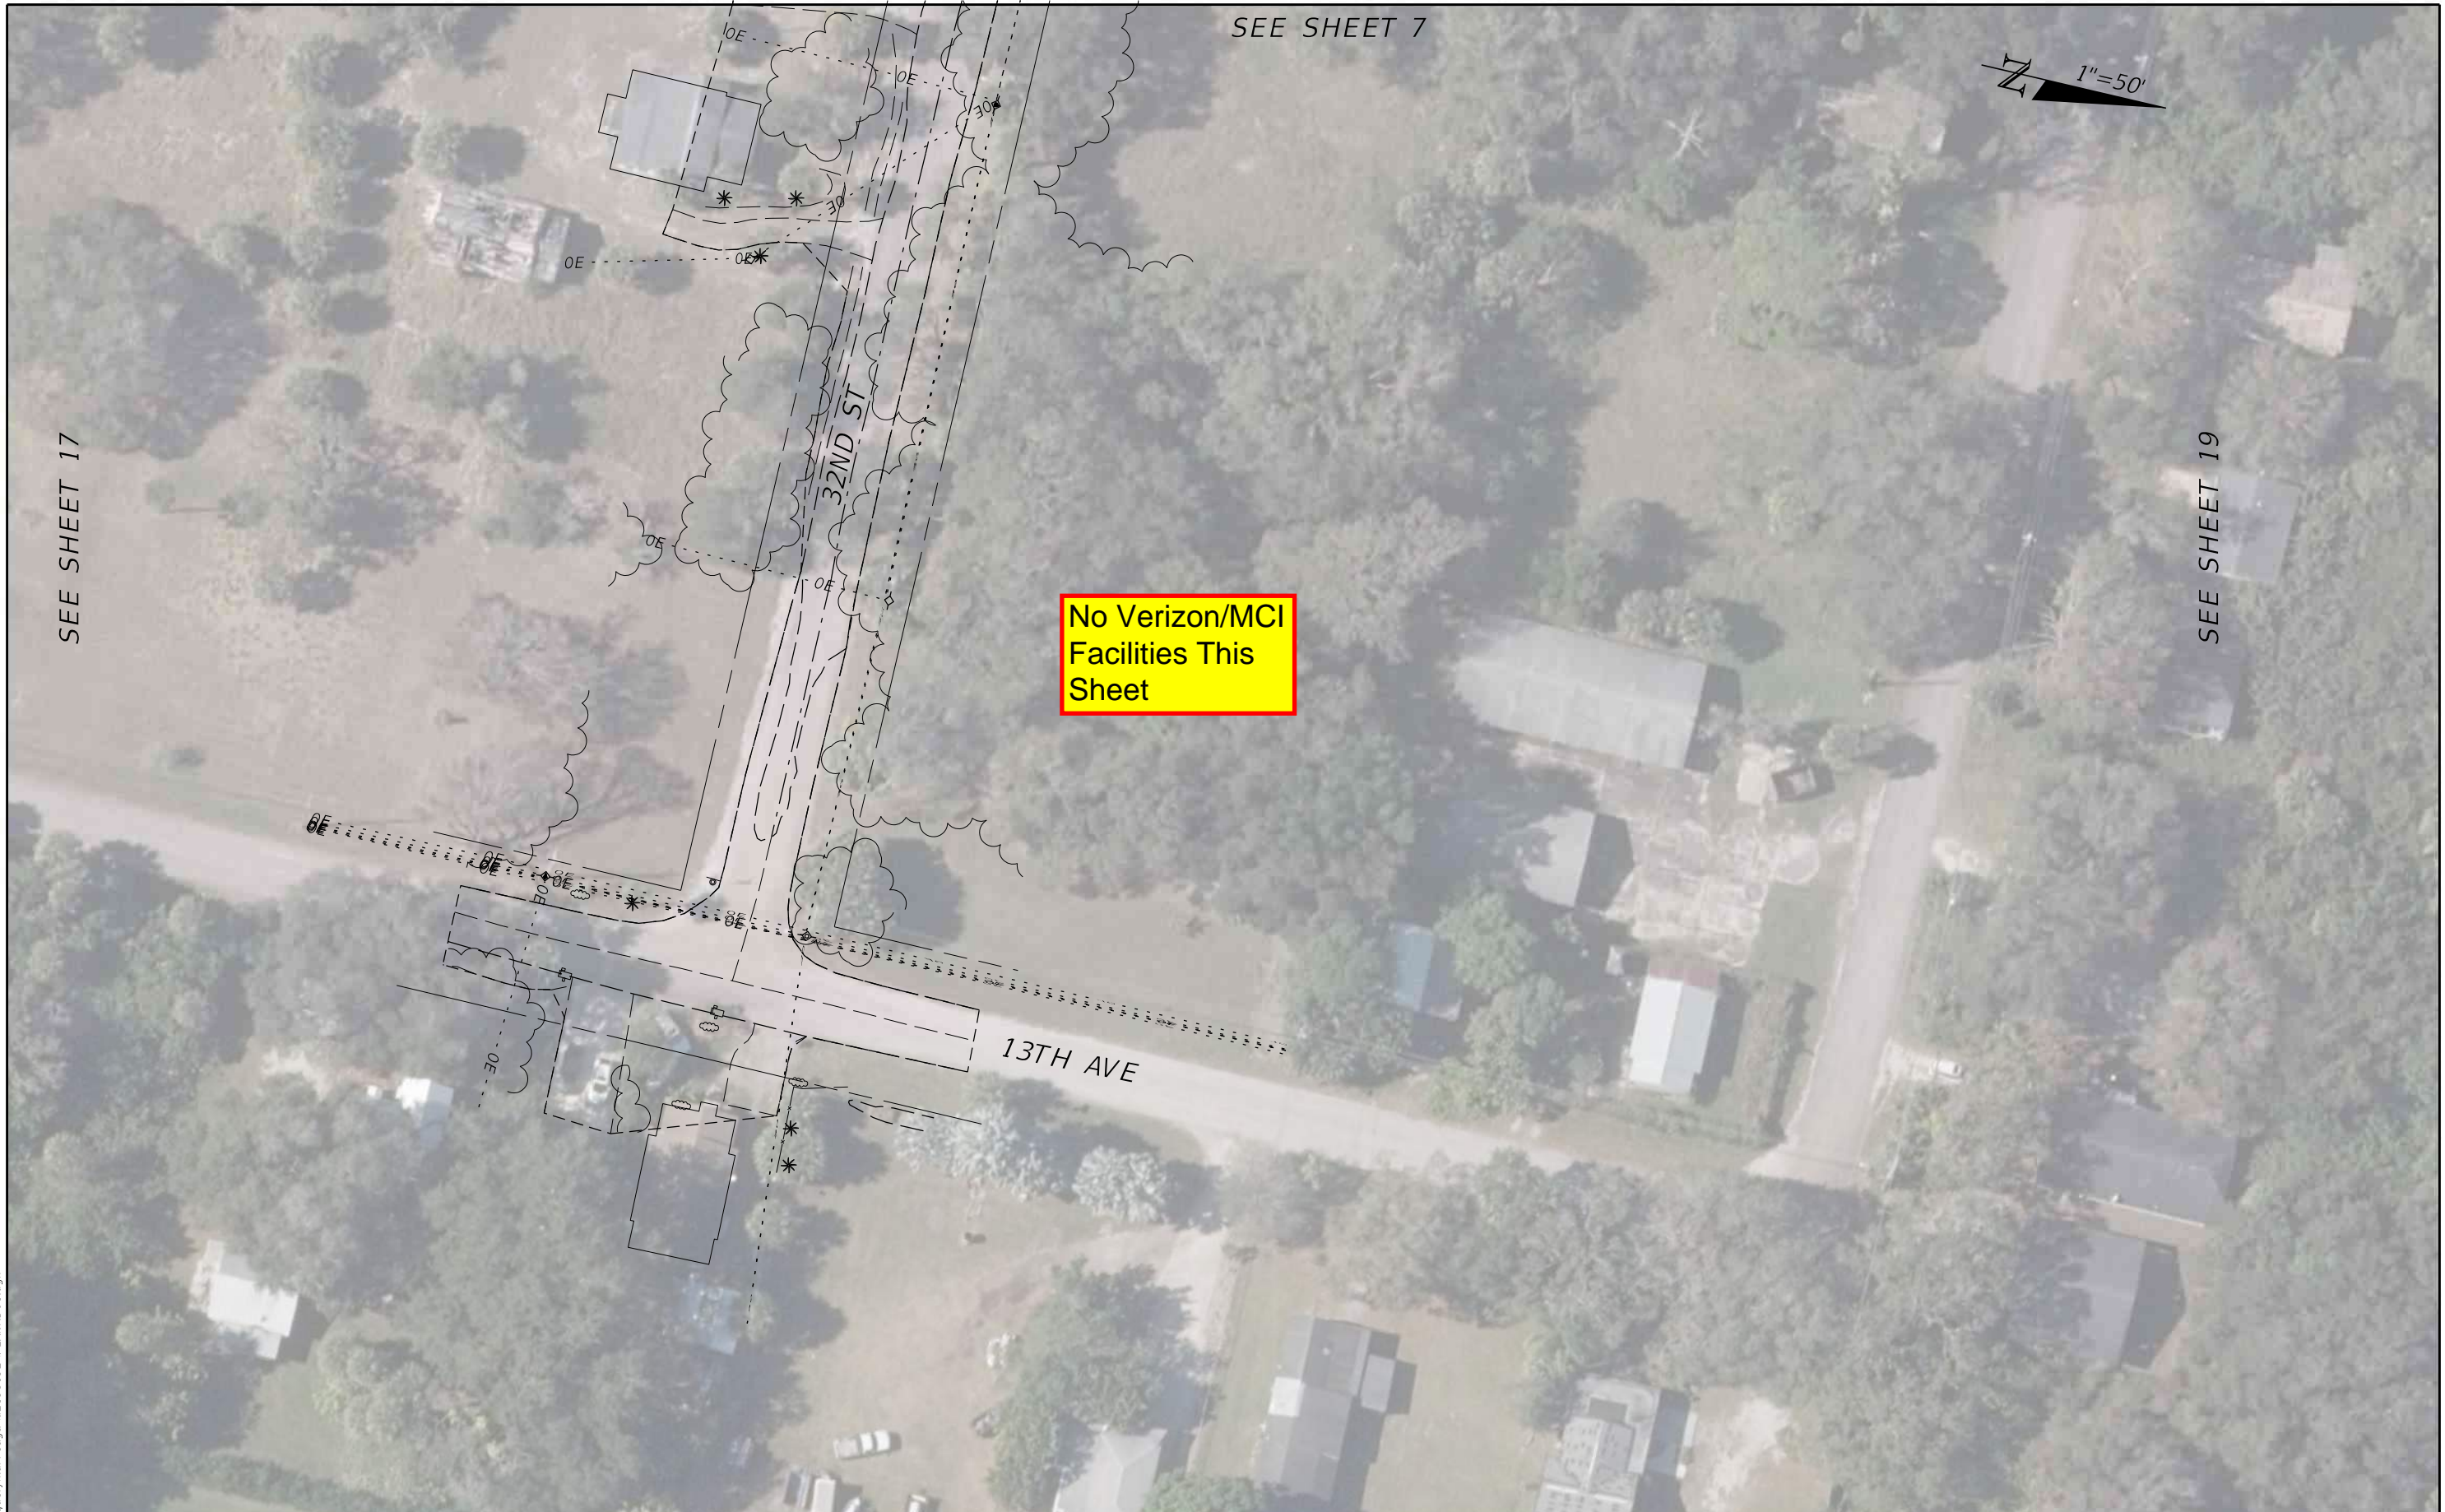


9/15/2022 11:07:02 AM Jacquelyn.Arreaga  
 c:\pwworking\wg\N\Jacquelyn.arreaga\d2198192\PLANRD01.dgn

REVISIONS		PROFESSIONAL TYPE		STATE OF FLORIDA DEPARTMENT OF TRANSPORTATION			UTILITY CONTACT PLAN (18)	SHEET NO. 6
DATE	DESCRIPTION	DATE	DESCRIPTION	ROAD NO.	COUNTY	FINANCIAL PROJECT ID		
				SR 5	INDIAN RIVER	441693-1-22-02		

WILLIAM EVANS  
 LICENSE NUMBER: 45207  
 WGI, INC.  
 2035 VISTA PARKWAY  
 WEST PALM BEACH, FL 33411

THE OFFICIAL RECORD OF THIS SHEET IS THE ELECTRONIC FILE DIGITALLY SIGNED AND SEALED UNDER RULE 61G15-23.004, F.A.C.

SEE SHEET 8

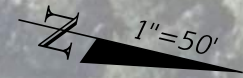

SEE SHEET 18

No Verizon/MCI  
Facilities This  
Sheet

SEE SHEET 20

9/15/2022 11:17:13 AM Jacquelyn.Arreaga  
c:\pwworking\wg\N\jacquelyn.arreaga\d2198192\PLANRD01.dgn

REVISIONS				PROFESSIONAL TYPE	STATE OF FLORIDA DEPARTMENT OF TRANSPORTATION			UTILITY CONTACT PLAN (19)	SHEET NO.
DATE	DESCRIPTION	DATE	DESCRIPTION	WILLIAM EVANS LICENSE NUMBER: 45207 WGI, INC. 2035 VISTA PARKWAY WEST PALM BEACH, FL 33411	ROAD NO.	COUNTY	FINANCIAL PROJECT ID		19
					SR 5	INDIAN RIVER	441693-1-22-02		

THE OFFICIAL RECORD OF THIS SHEET IS THE ELECTRONIC FILE DIGITALLY SIGNED AND SEALED UNDER RULE 61G15-23.004, F.A.C.



No Verizon/MCI  
Facilities This  
Sheet

SEE SHEET 9


SEE SHEET 19

1"=50'

9/15/2022 11:17:26 AM Jacquelyn.Arreaga  
c:\pwworking\wgn\jacquelyn.arreaga\d2198192\PLANRD01.dgn

REVISIONS				PROFESSIONAL TYPE	STATE OF FLORIDA DEPARTMENT OF TRANSPORTATION			UTILITY CONTACT PLAN (20)	SHEET NO.
DATE	DESCRIPTION	DATE	DESCRIPTION	WILLIAM EVANS LICENSE NUMBER: 45207 WGI, INC. 2035 VISTA PARKWAY WEST PALM BEACH, FL 33411	ROAD NO.	COUNTY	FINANCIAL PROJECT ID		20
						SR 5	INDIAN RIVER		441693-1-22-02

THE OFFICIAL RECORD OF THIS SHEET IS THE ELECTRONIC FILE DIGITALLY SIGNED AND SEALED UNDER RULE 61G15-23.004, F.A.C.

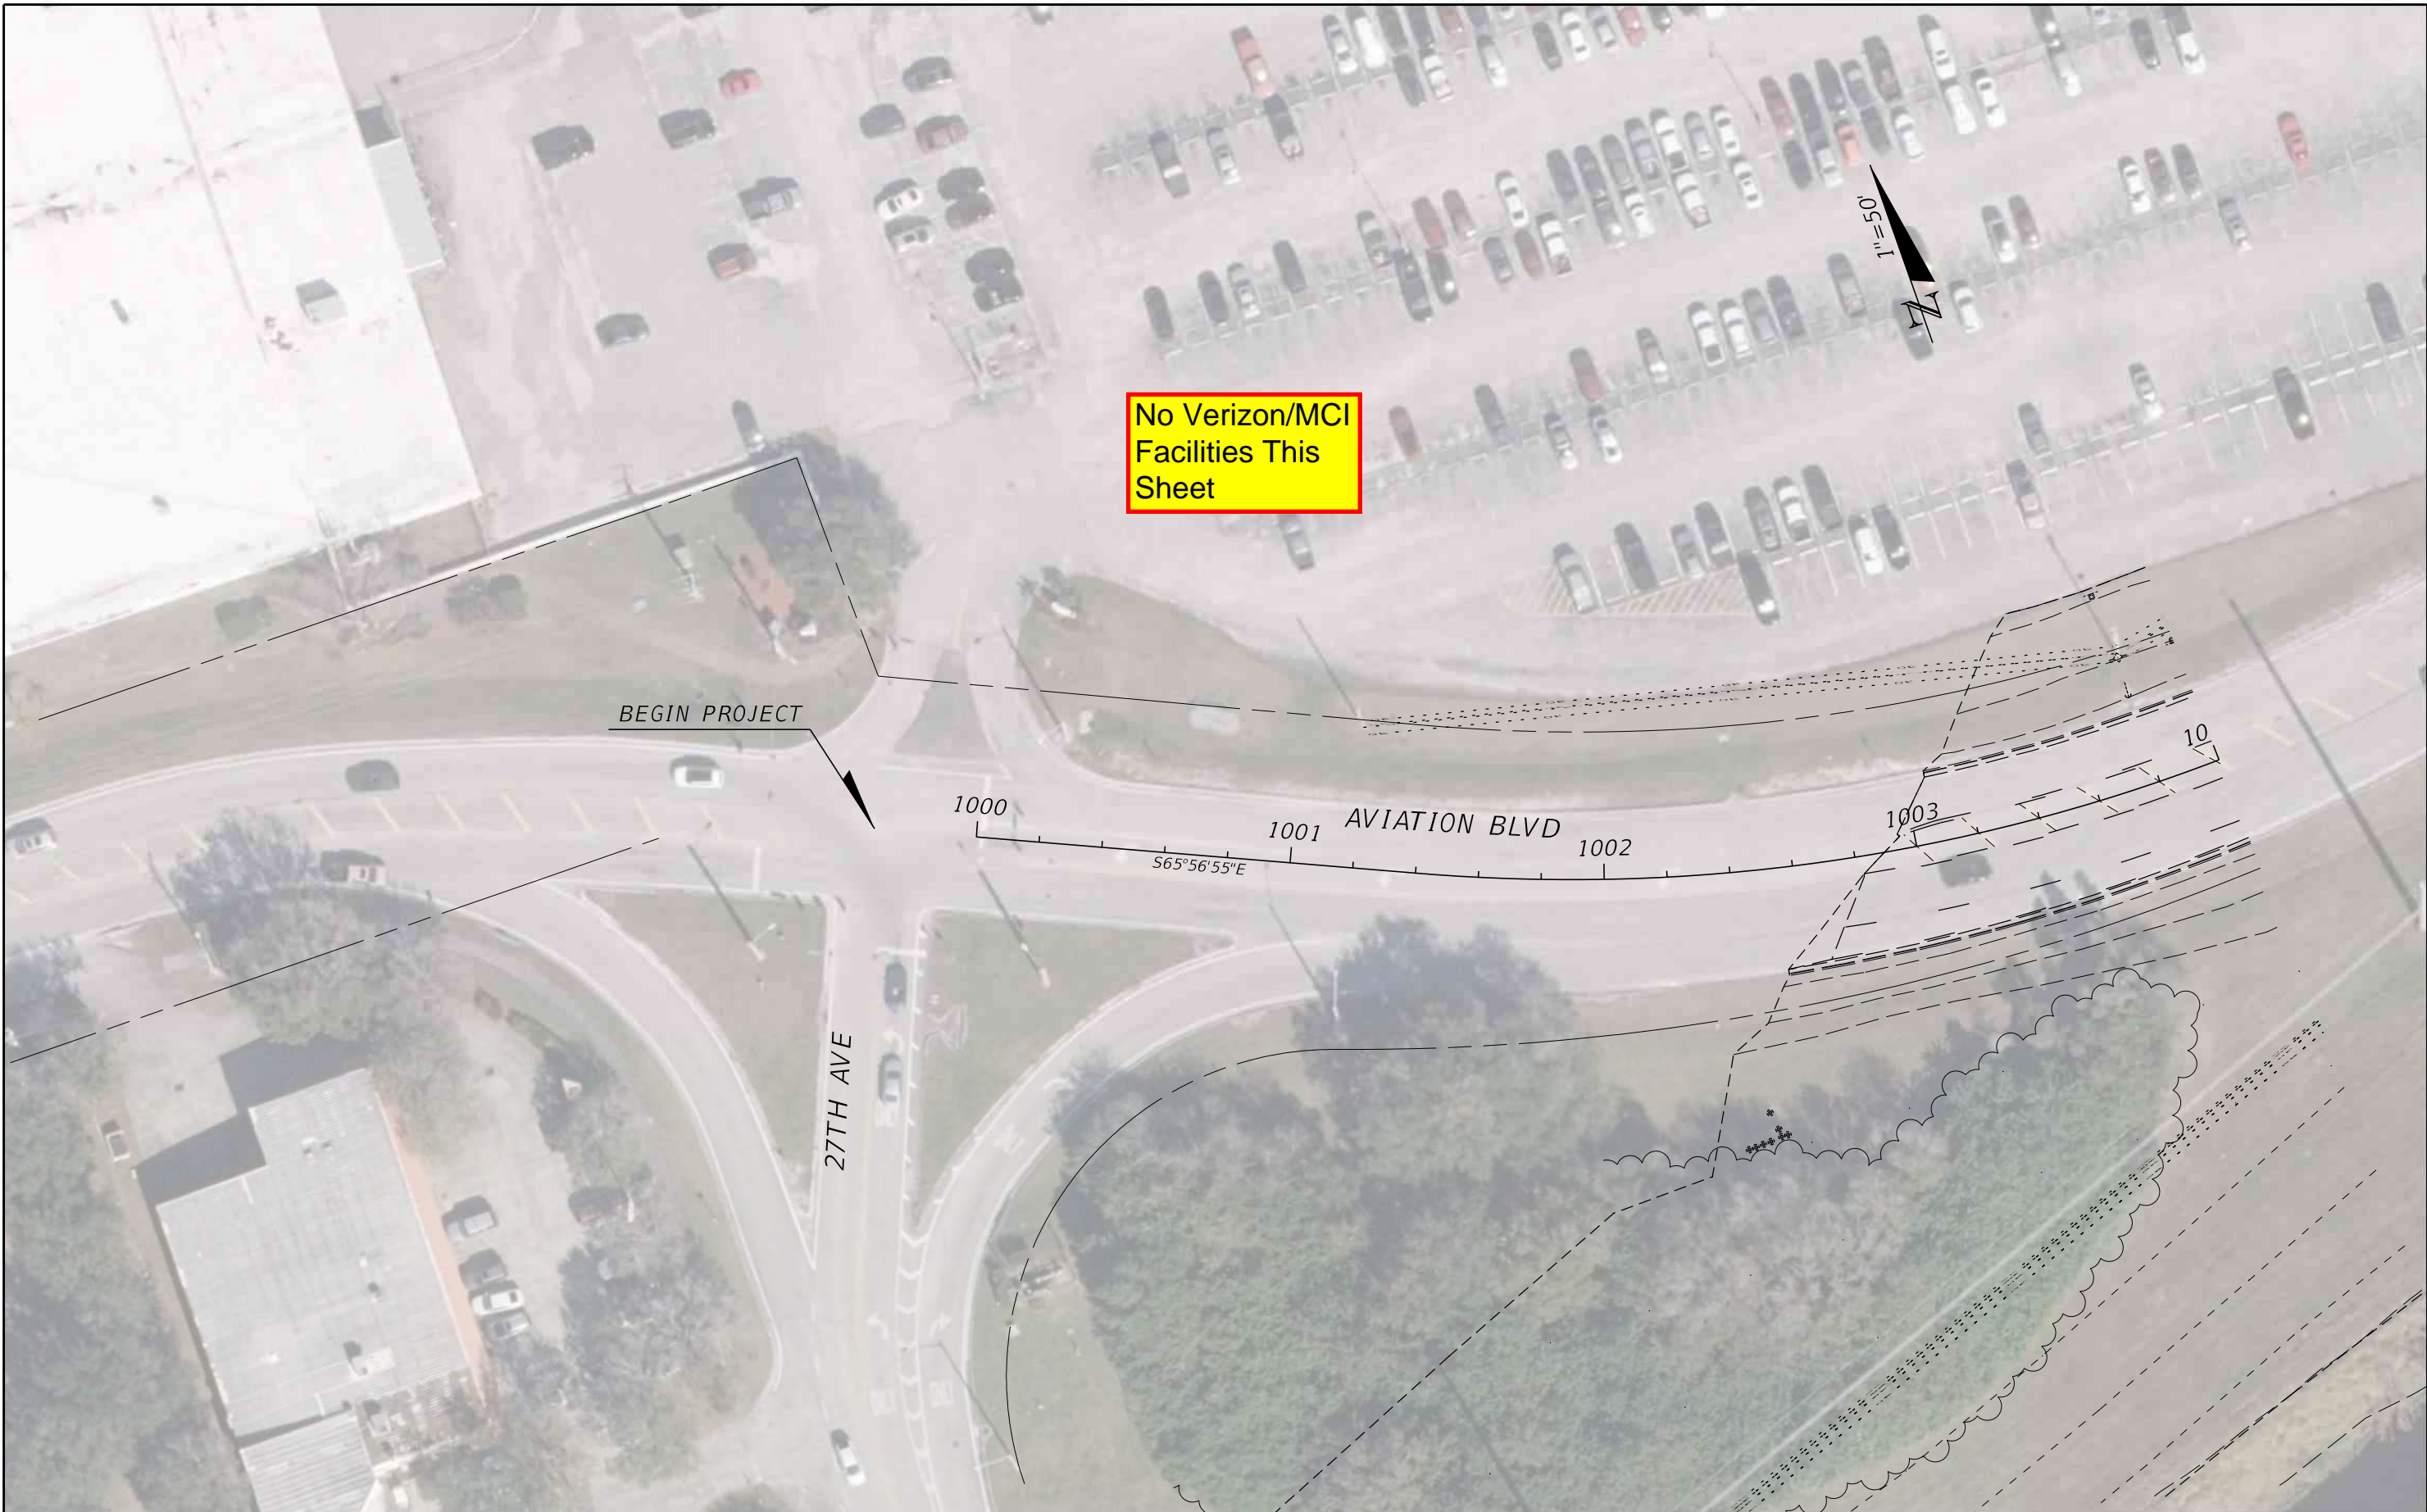

No Verizon/MCI  
Facilities This  
Sheet

BEGIN PROJECT




9/15/2022 11:07:58 AM Jacquelyn.Arreaga  
c:\pwworking\wg\N\jacquelyn.arreaga\d2198192\PLAN\RD01.dgn

REVISIONS		PROFESSIONAL TYPE		STATE OF FLORIDA DEPARTMENT OF TRANSPORTATION			UTILITY CONTACT PLAN (21)	SHEET NO.  21
DATE	DESCRIPTION	DATE	DESCRIPTION	ROAD NO.	COUNTY	FINANCIAL PROJECT ID		
				SR 5	INDIAN RIVER	441693-1-22-02		

WILLIAM EVANS  
LICENSE NUMBER: 45207  
WGI, INC.  
2035 VISTA PARKWAY  
WEST PALM BEACH, FL 33411

THE OFFICIAL RECORD OF THIS SHEET IS THE ELECTRONIC FILE DIGITALLY SIGNED AND SEALED UNDER RULE 61G15-23.004, F.A.C.

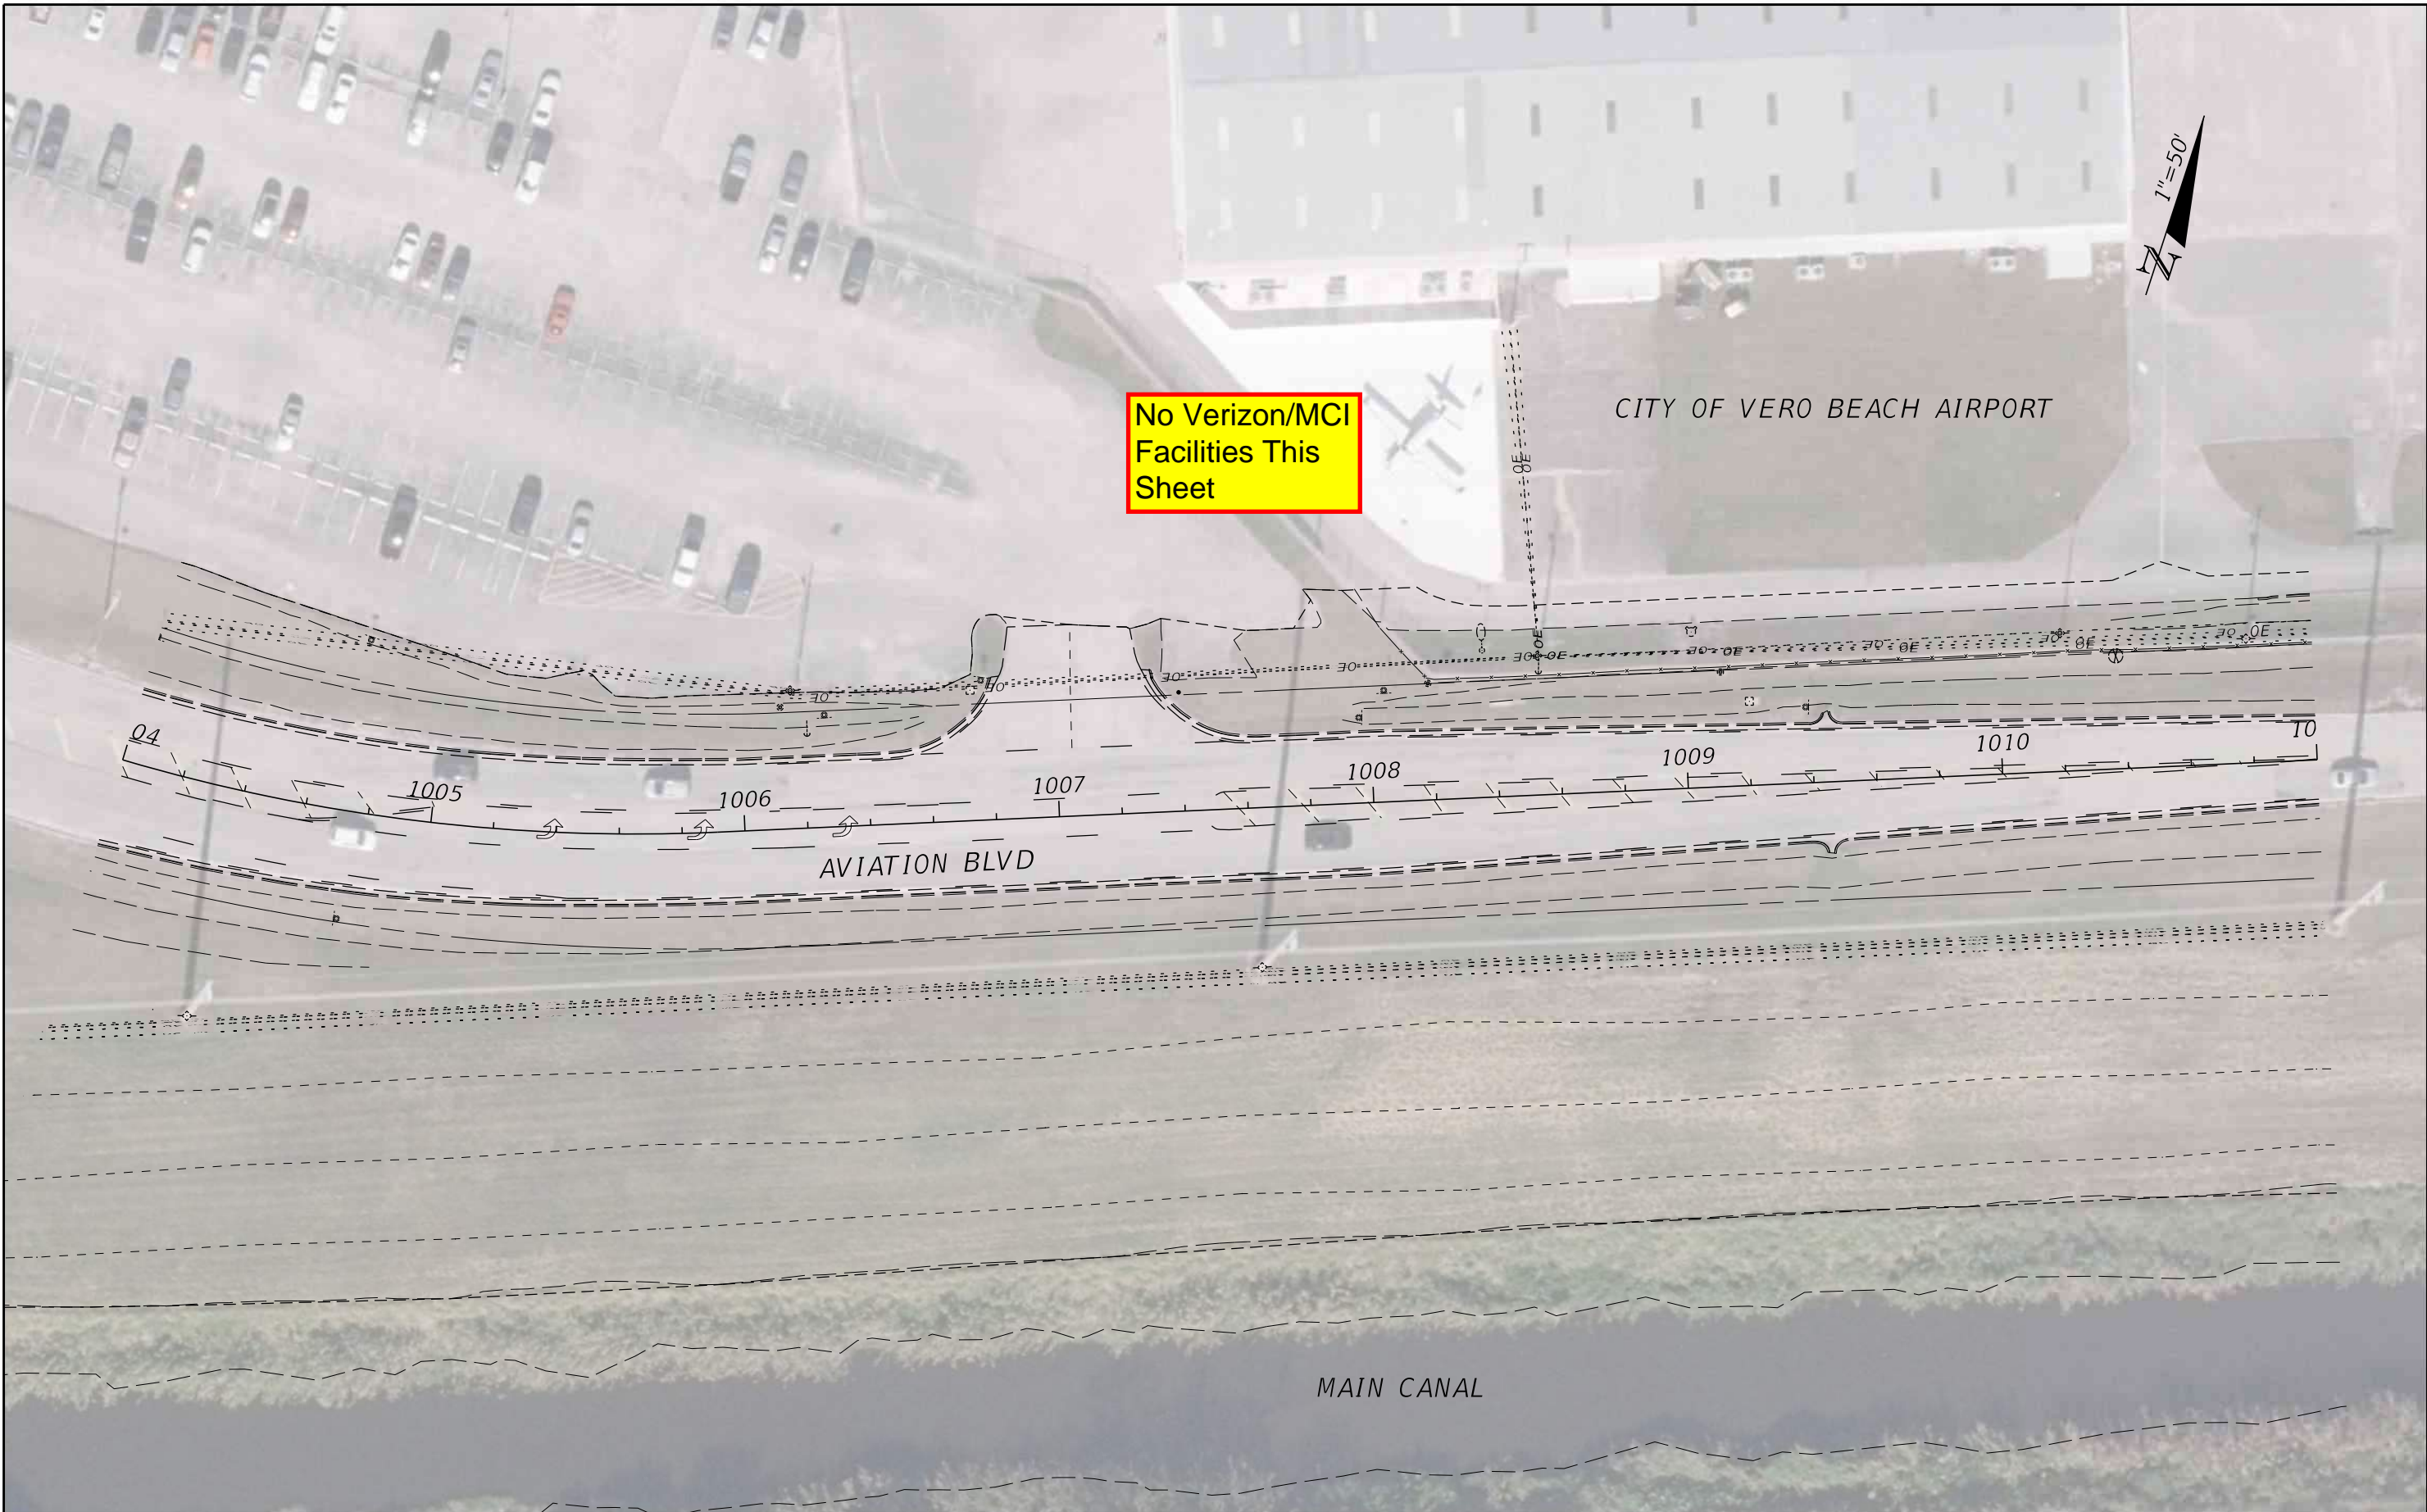

No Verizon/MCI  
Facilities This  
Sheet



CITY OF VERO BEACH AIRPORT

AVIATION BLVD

MAIN CANAL

9/15/2022 11:08:27 AM Jacquelyn.Arreaga  
c:\pwworking\wgn\jacquelyn.arreaga\d2198192\PLANRD01.dgn

REVISIONS		PROFESSIONAL TYPE		STATE OF FLORIDA DEPARTMENT OF TRANSPORTATION			UTILITY CONTACT PLAN (22)	SHEET NO.  22
DATE	DESCRIPTION	DATE	DESCRIPTION	ROAD NO.	COUNTY	FINANCIAL PROJECT ID		
				SR 5	INDIAN RIVER	441693-1-22-02		


WILLIAM EVANS  
LICENSE NUMBER: 45207  
WGI, INC.  
2035 VISTA PARKWAY  
WEST PALM BEACH, FL 33411

THE OFFICIAL RECORD OF THIS SHEET IS THE ELECTRONIC FILE DIGITALLY SIGNED AND SEALED UNDER RULE 61G15-23.004, F.A.C.



CITY OF VERO BEACH AIRPORT

No Verizon/MCI  
Facilities This  
Sheet

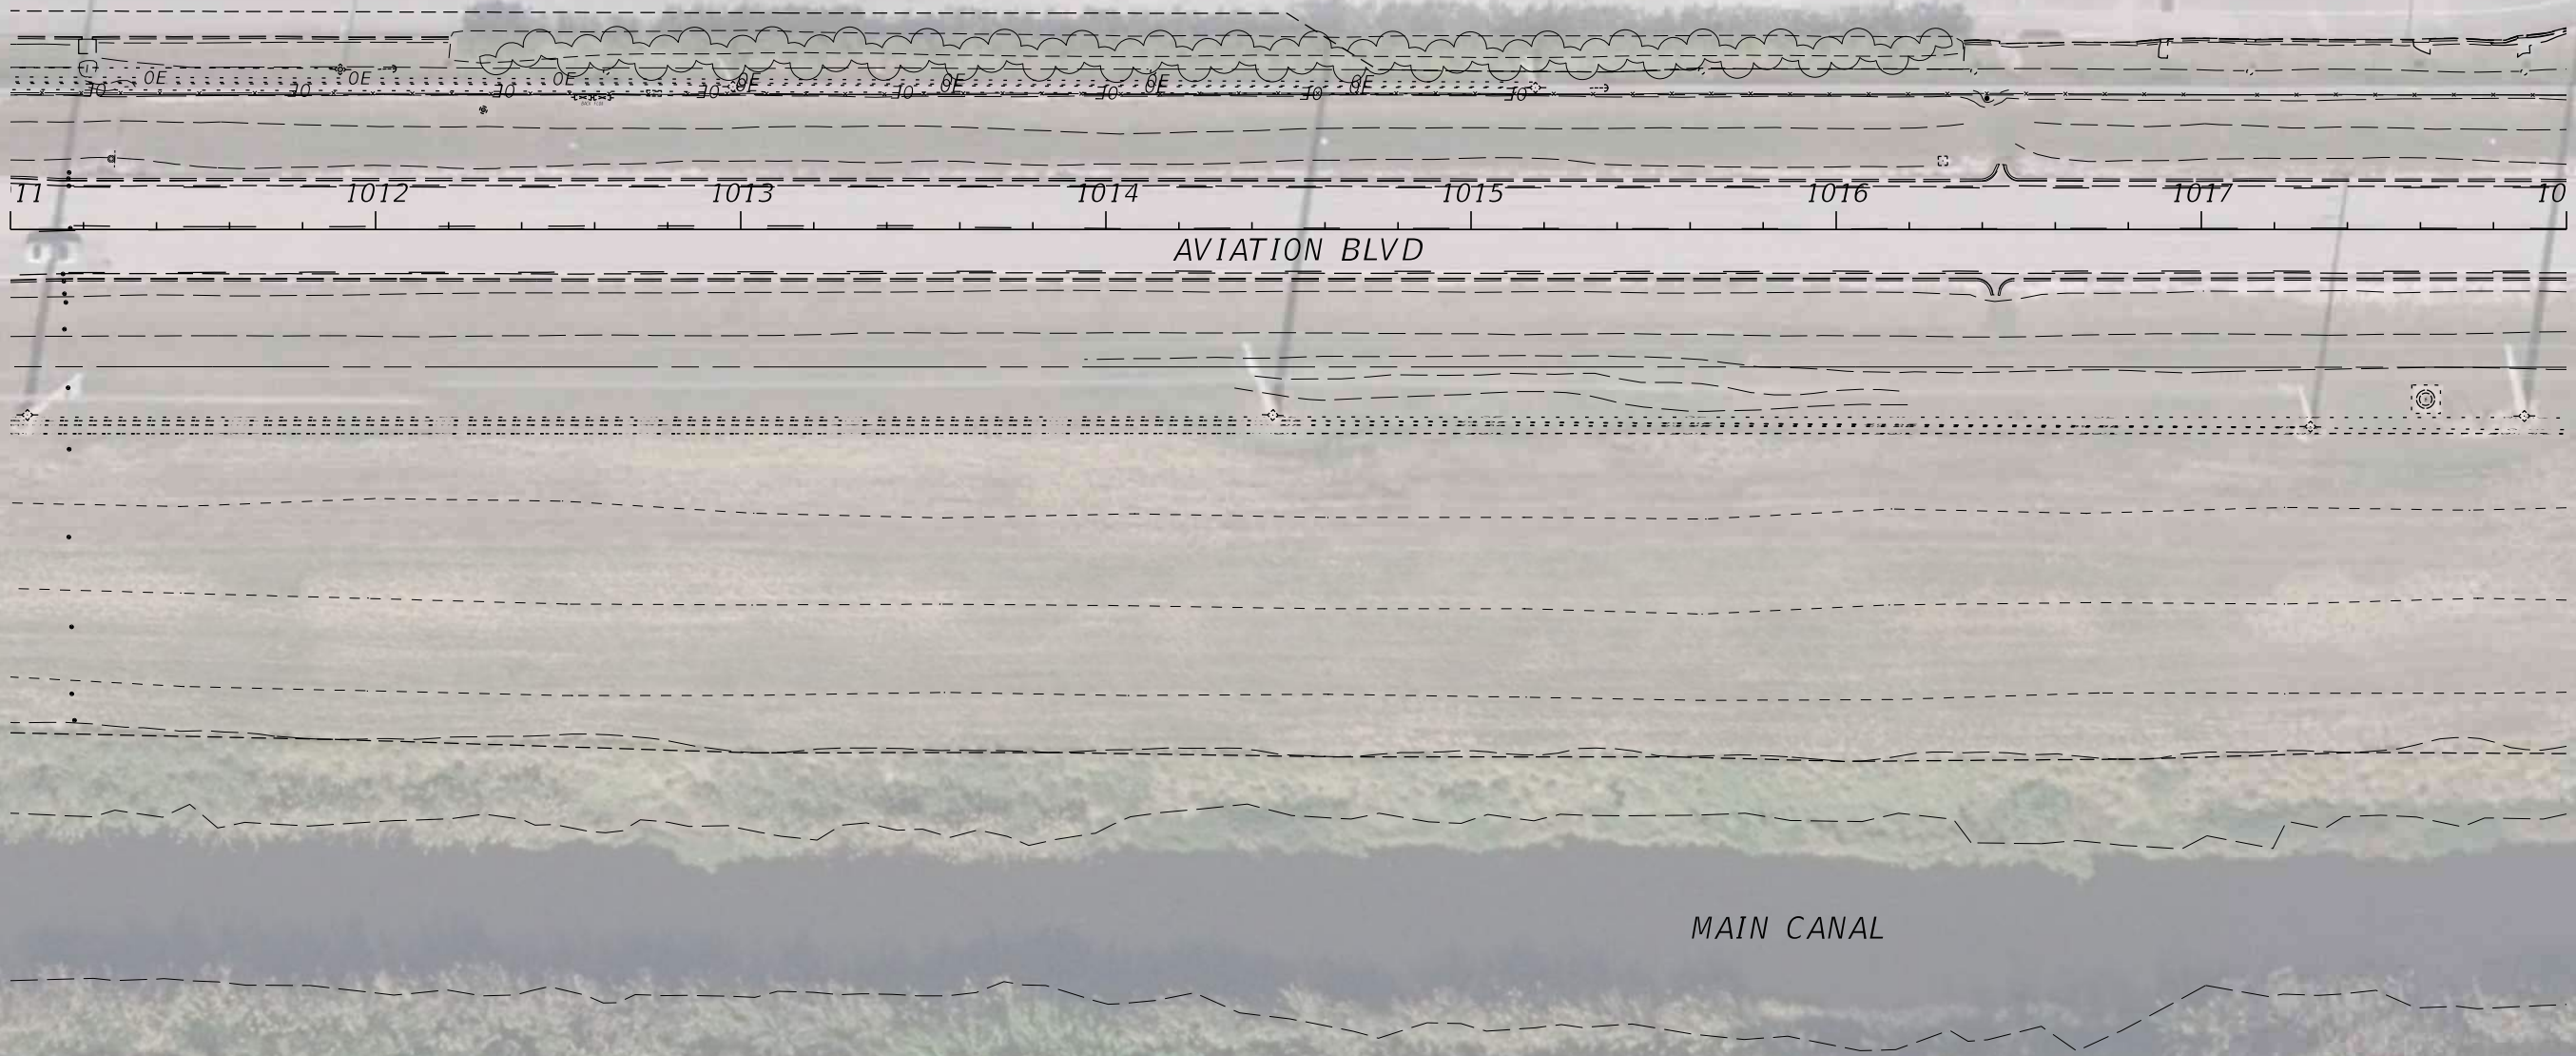

9/15/2022 11:08:39 AM Jacquelyn.Arreaga c:\pwworking\wgn\jacquelyn.arreaga\d2198192\PLANRD01.dgn

REVISIONS				PROFESSIONAL TYPE	STATE OF FLORIDA DEPARTMENT OF TRANSPORTATION			SHEET NO.
DATE	DESCRIPTION	DATE	DESCRIPTION		ROAD NO.	COUNTY	FINANCIAL PROJECT ID	
				WILLIAM EVANS LICENSE NUMBER: 45207 WGI, INC. 2035 VISTA PARKWAY WEST PALM BEACH, FL 33411	SR 5	INDIAN RIVER	441693-1-22-02	23


UTILITY CONTACT PLAN (23)

THE OFFICIAL RECORD OF THIS SHEET IS THE ELECTRONIC FILE DIGITALLY SIGNED AND SEALED UNDER RULE 61G15-23.004, F.A.C.



CITY OF VERO BEACH AIRPORT

No Verizon/MCI  
Facilities This  
Sheet

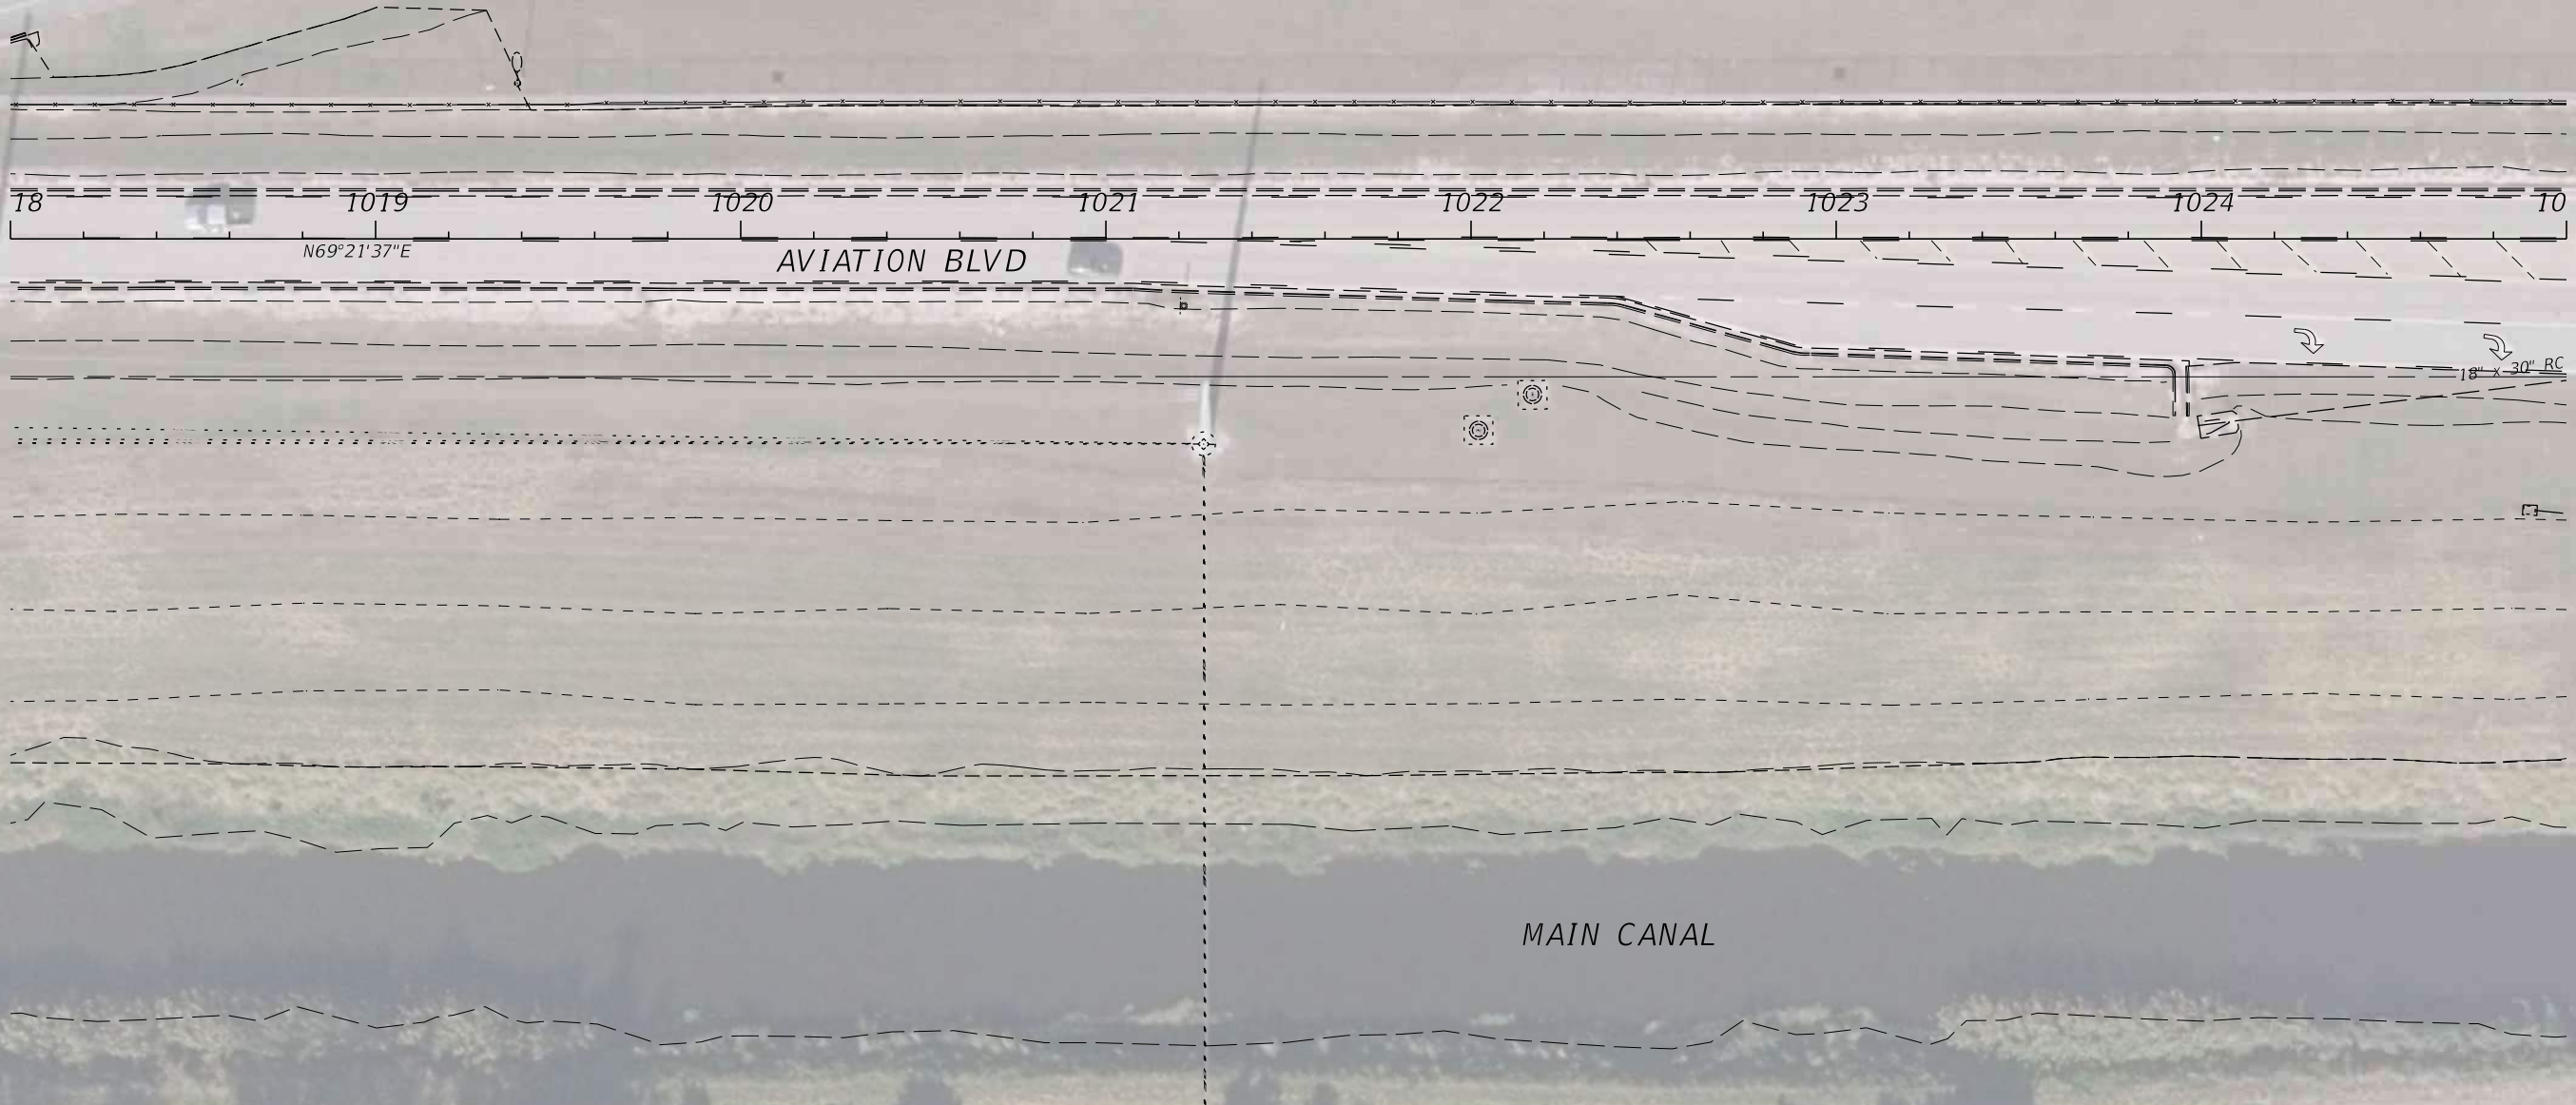

9/15/2022 11:08:55 AM Jacquelyn.Arreaga c:\pwworking\wg\N\Jacquelyn.arreaga\d2198192\PLANRD01.dgn

REVISIONS				PROFESSIONAL TYPE	STATE OF FLORIDA DEPARTMENT OF TRANSPORTATION			UTILITY CONTACT PLAN (24)	SHEET NO.  24
DATE	DESCRIPTION	DATE	DESCRIPTION		ROAD NO.	COUNTY	FINANCIAL PROJECT ID		
				WILLIAM EVANS LICENSE NUMBER: 45207 WGI, INC. 2035 VISTA PARKWAY WEST PALM BEACH, FL 33411	SR 5	INDIAN RIVER	441693-1-22-02		


THE OFFICIAL RECORD OF THIS SHEET IS THE ELECTRONIC FILE DIGITALLY SIGNED AND SEALED UNDER RULE 61G15-23.004, F.A.C.

CITY OF VERO BEACH AIRPORT



No Verizon/MCI  
Facilities This  
Sheet

TO AIRPORT PROPERTY  
RESTRICTED - NO ACCESS

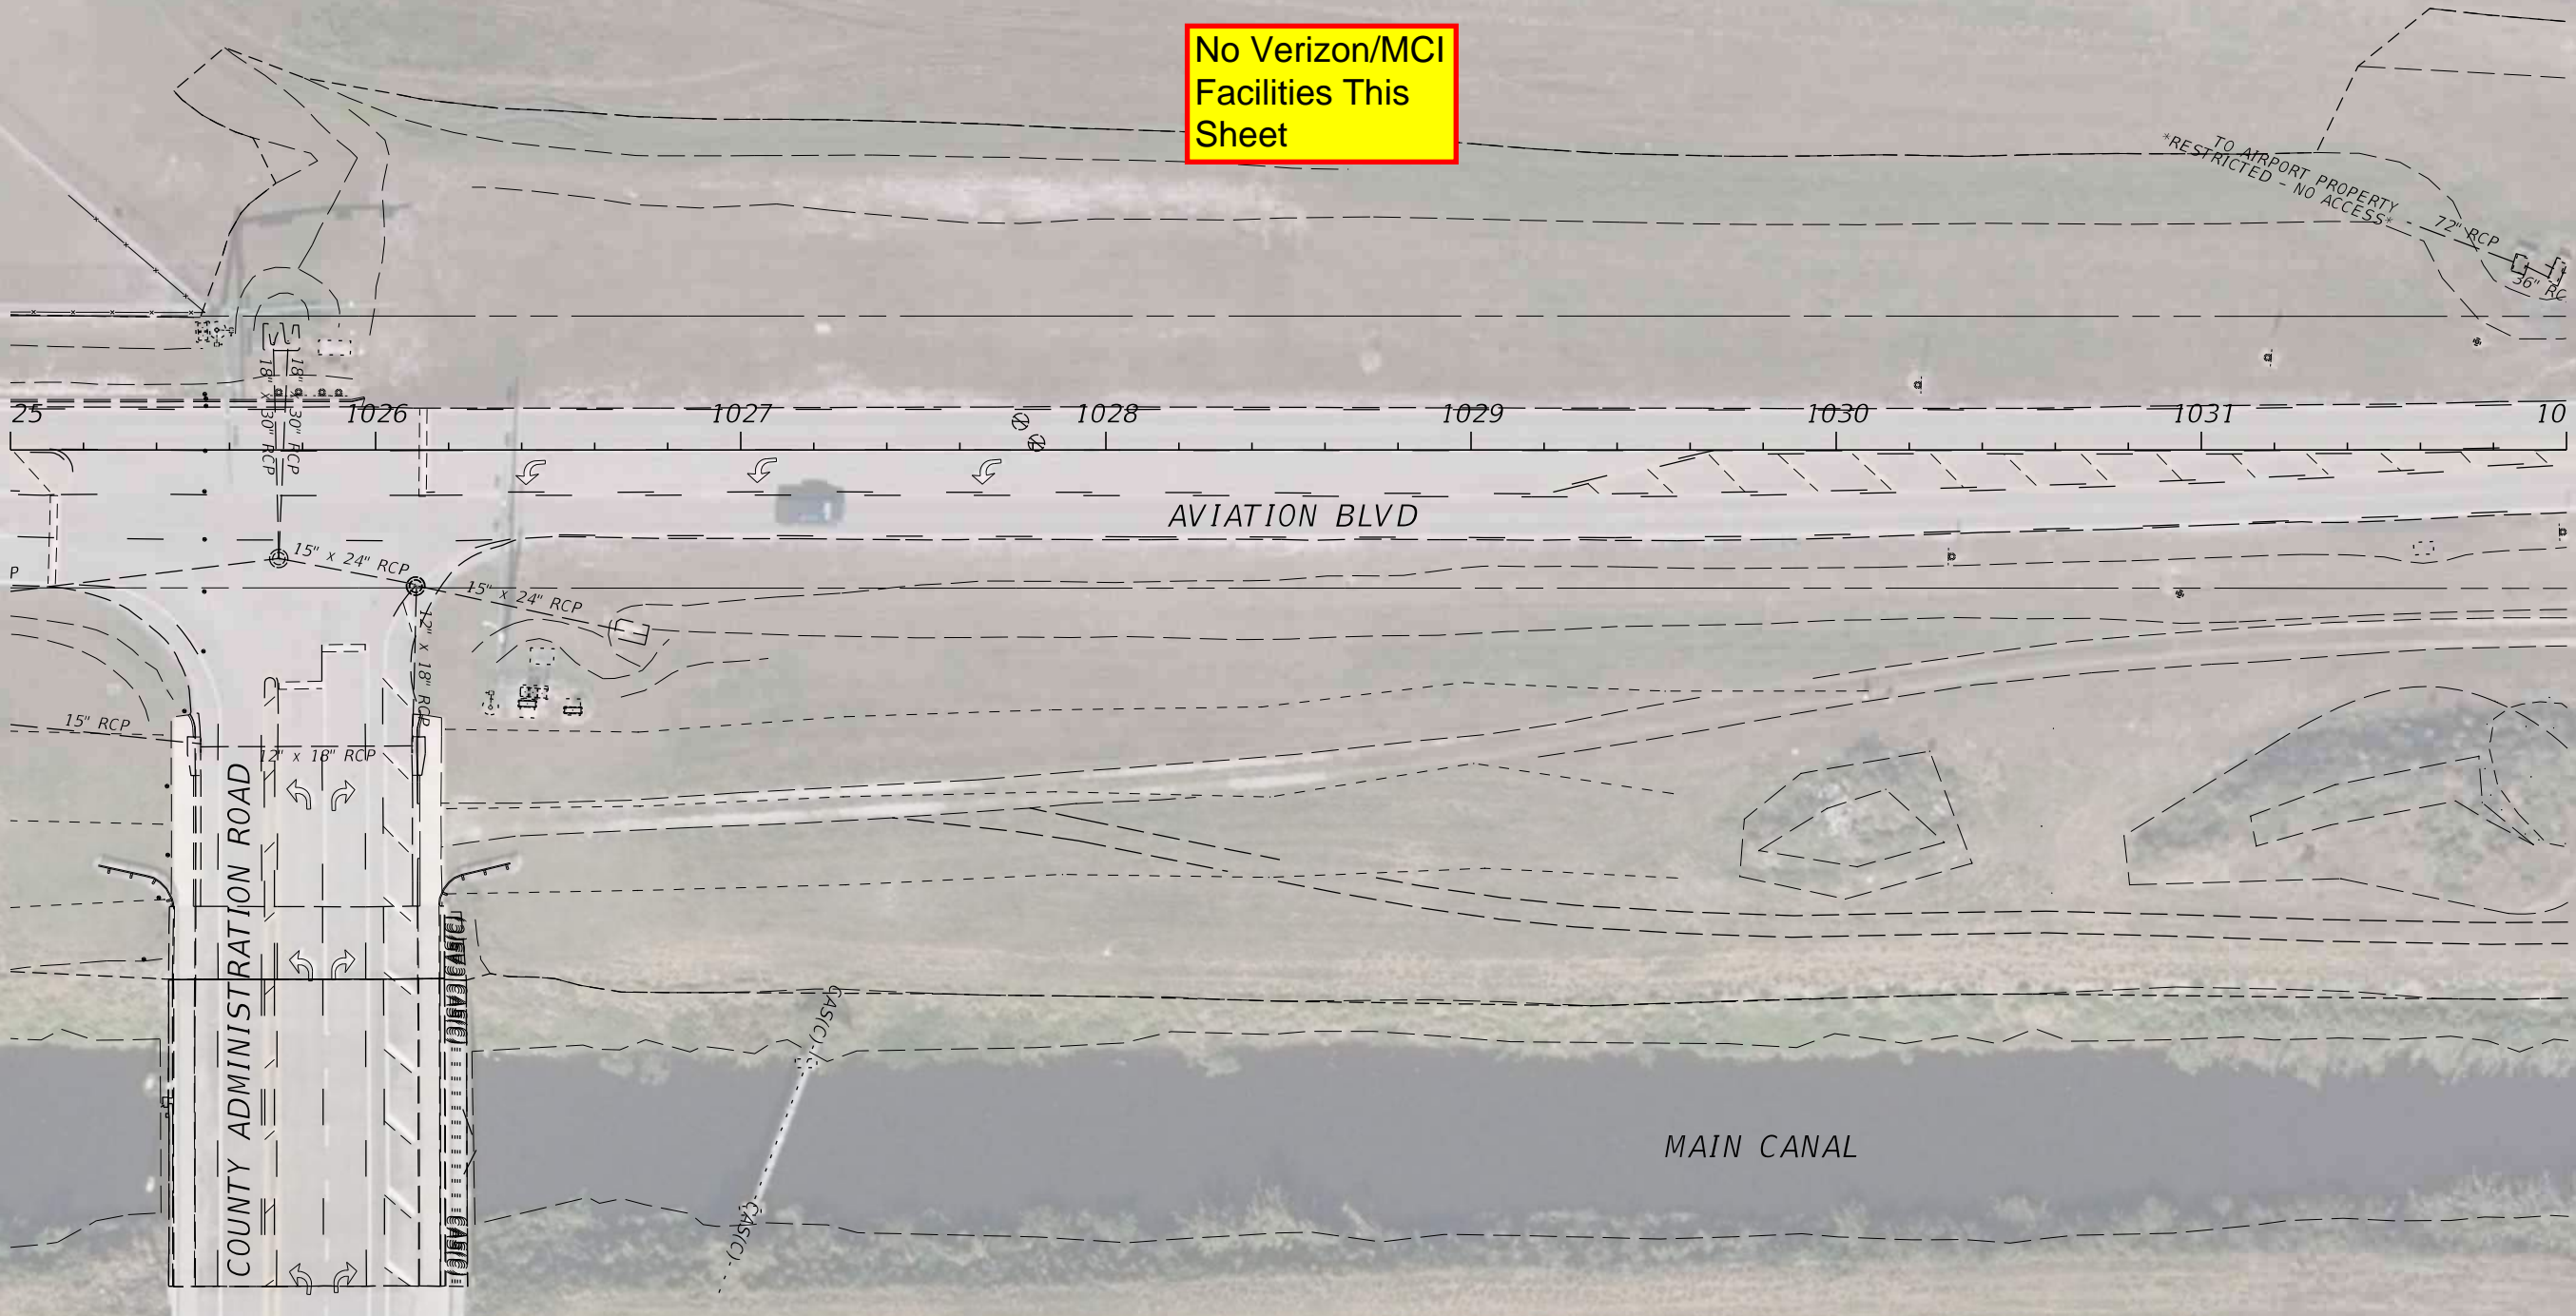

9/15/2022 11:09:17 AM Jacquelyn.Arreaga  
c:\pwworking\wgn\jacquelyn.arreaga\d2198192\PLAN\RD01.dgn


REVISIONS		PROFESSIONAL TYPE		STATE OF FLORIDA DEPARTMENT OF TRANSPORTATION			UTILITY CONTACT PLAN (25)	SHEET NO. 25
DATE	DESCRIPTION	DATE	DESCRIPTION	ROAD NO.	COUNTY	FINANCIAL PROJECT ID		
				SR 5	INDIAN RIVER	441693-1-22-02		

THE OFFICIAL RECORD OF THIS SHEET IS THE ELECTRONIC FILE DIGITALLY SIGNED AND SEALED UNDER RULE 61G15-23.004, F.A.C.




CITY OF VERO BEACH AIRPORT

No Verizon/MCI  
Facilities This  
Sheet

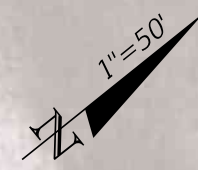

AIRPORT N DRIVE

AVIATION BLVD

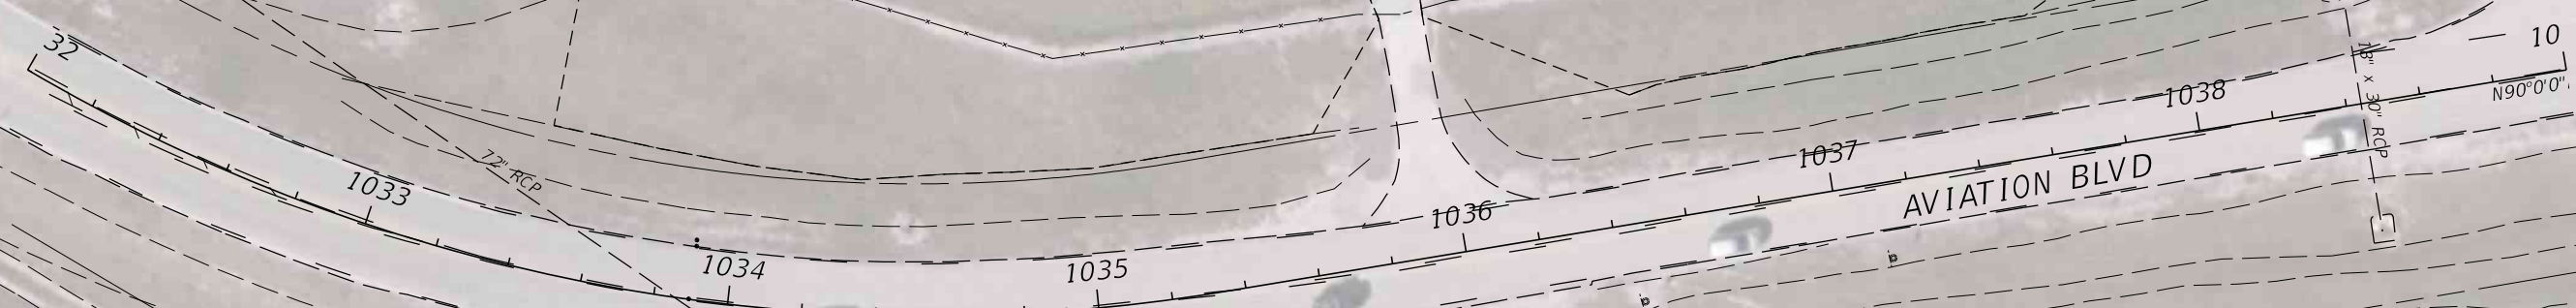



MAIN CANAL

9/15/2022 11:09:30 AM Jacquelyn.Arreaga  
c:\pwworking\wg\N\Jacquelyn.arreaga\d2198192\PLANARD01.dgn

REVISIONS				PROFESSIONAL TYPE	STATE OF FLORIDA DEPARTMENT OF TRANSPORTATION			UTILITY CONTACT PLAN (26)	SHEET NO. 26
DATE	DESCRIPTION	DATE	DESCRIPTION		ROAD NO.	COUNTY	FINANCIAL PROJECT ID		
				WILLIAM EVANS LICENSE NUMBER: 45207 WGI, INC. 2035 VISTA PARKWAY WEST PALM BEACH, FL 33411	SR 5	INDIAN RIVER	441693-1-22-02		

THE OFFICIAL RECORD OF THIS SHEET IS THE ELECTRONIC FILE DIGITALLY SIGNED AND SEALED UNDER RULE 61G15-23.004, F.A.C.

CITY OF VERO BEACH AIRPORT

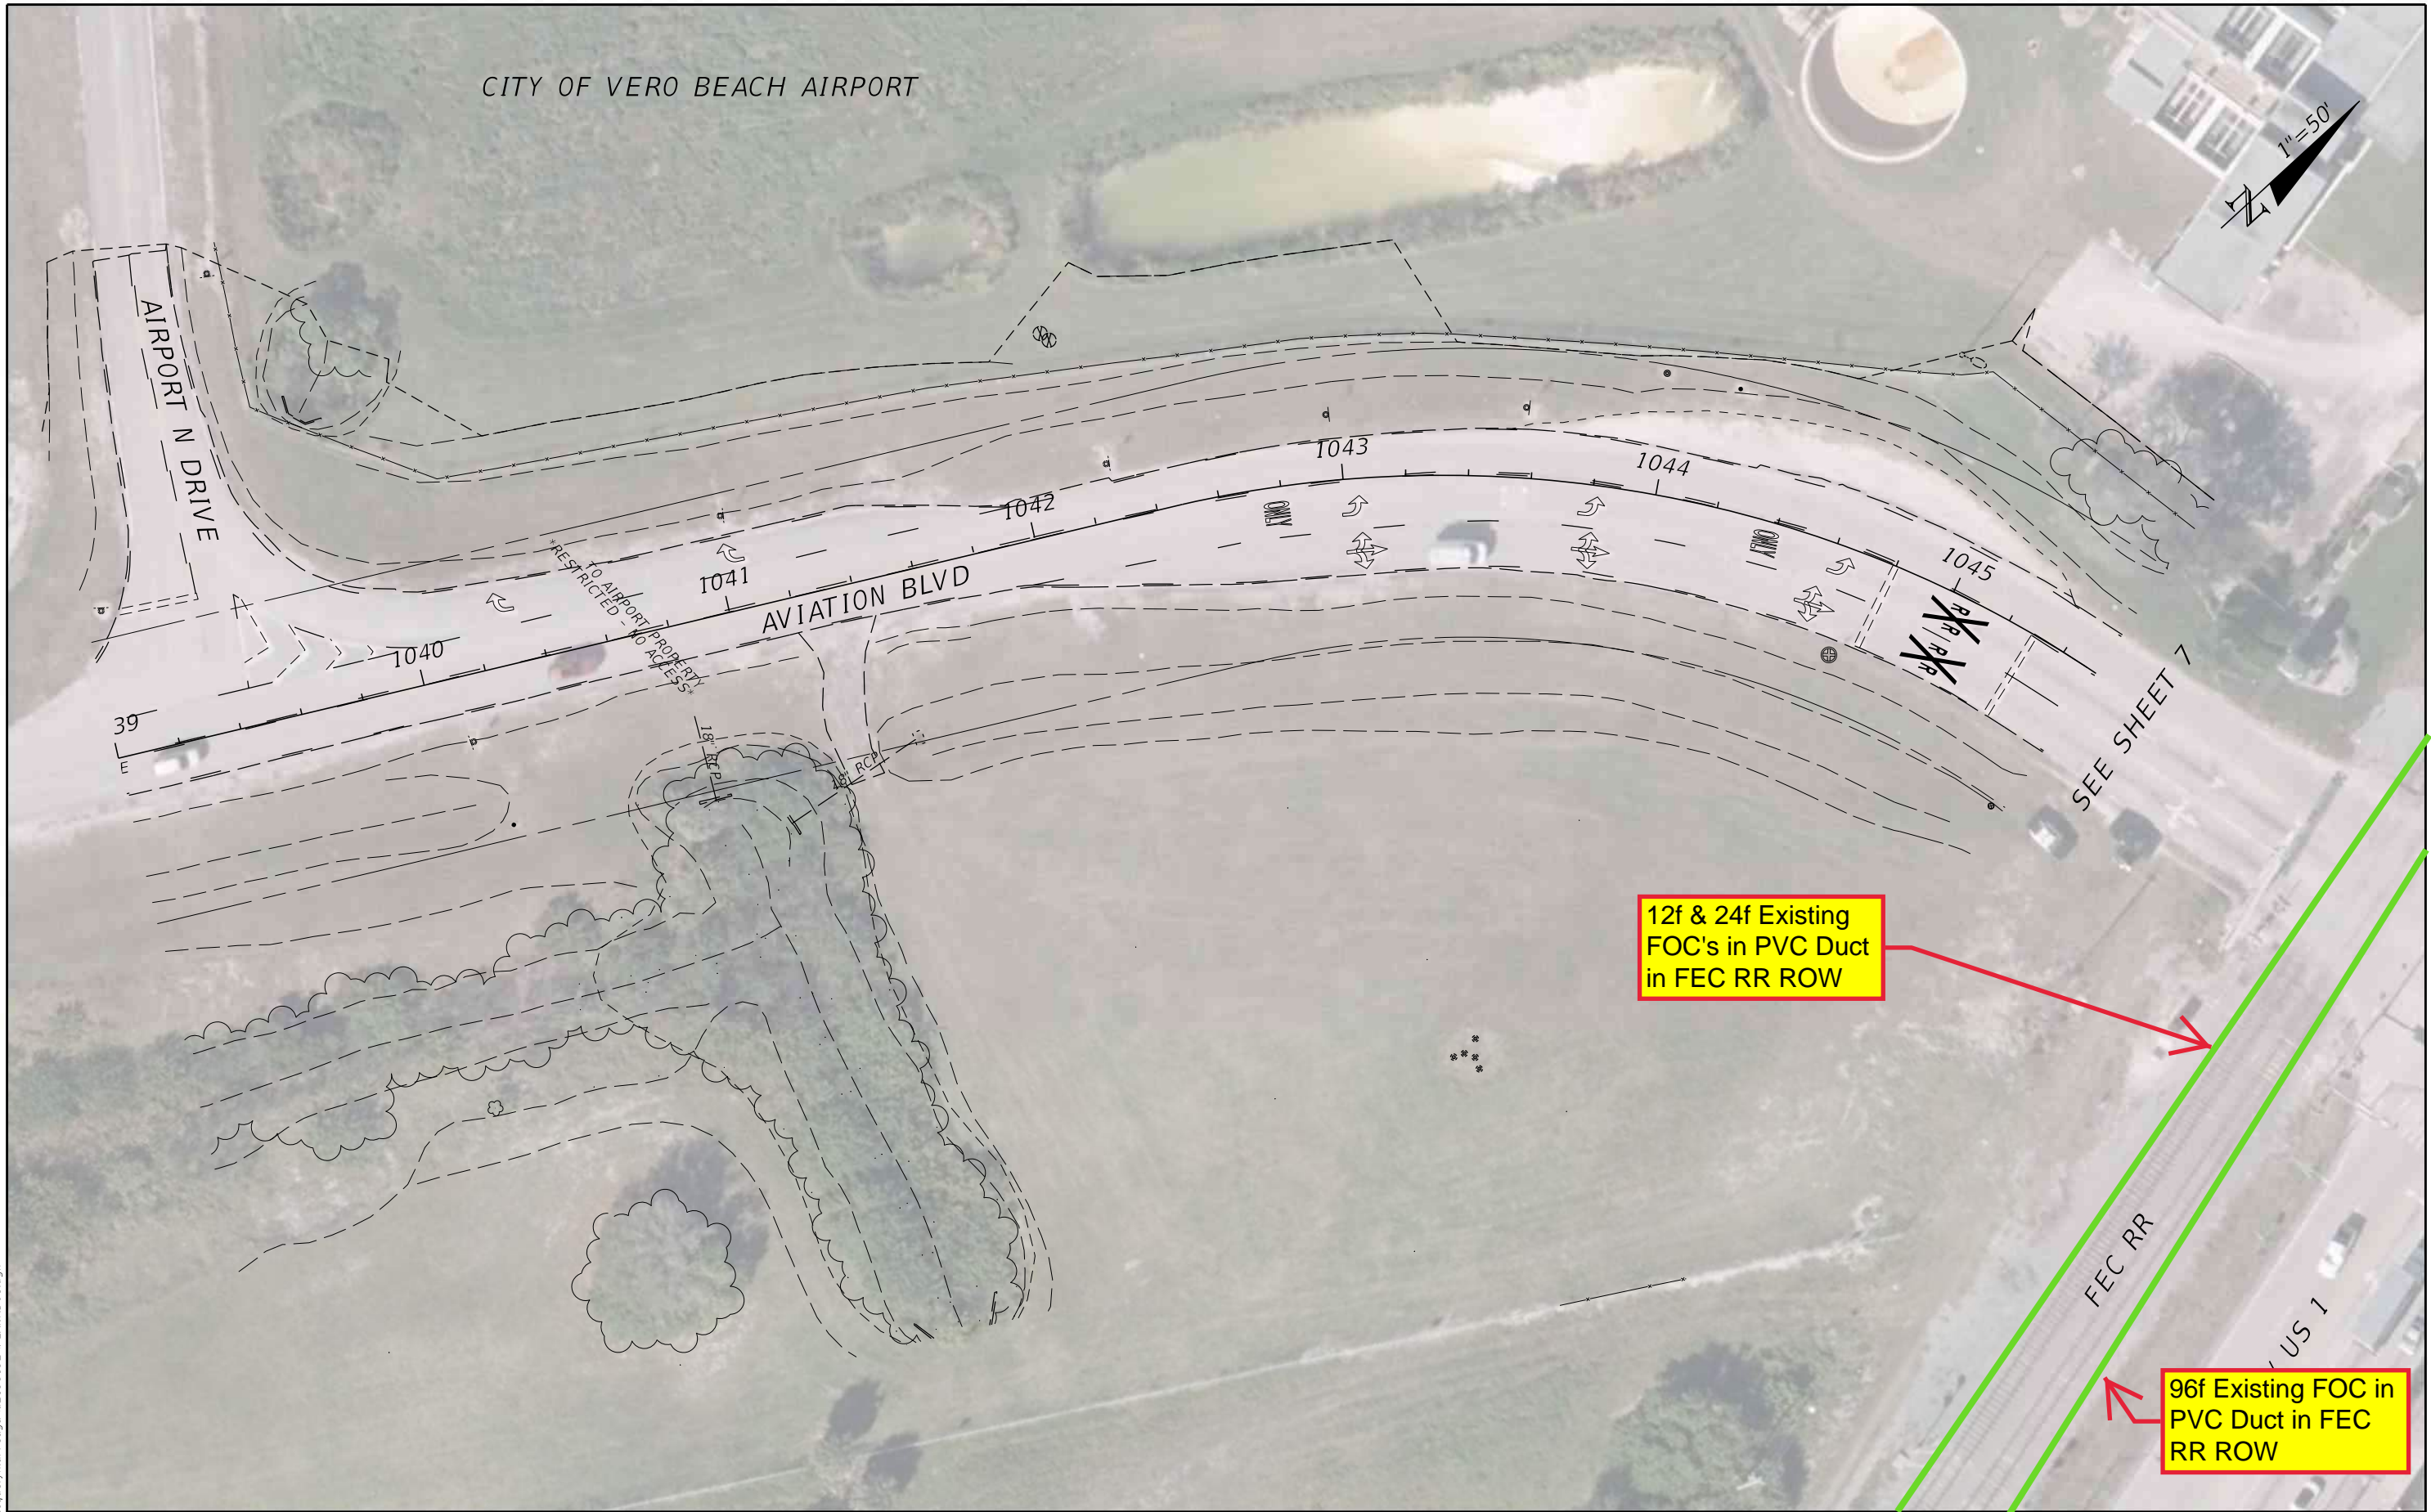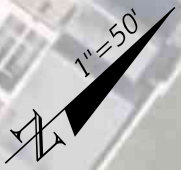

9/15/2022 11:09:43 AM Jacquelyn.Arreaga c:\pwworking\wgn\jacquelyn.arreaga\d2198192\PLAN\RRD01.dgn

REVISIONS		PROFESSIONAL TYPE		STATE OF FLORIDA DEPARTMENT OF TRANSPORTATION			UTILITY CONTACT PLAN (27)	SHEET NO. 27
DATE	DESCRIPTION	DATE	DESCRIPTION	ROAD NO.	COUNTY	FINANCIAL PROJECT ID		
				SR 5	INDIAN RIVER	441693-1-22-02		

THE OFFICIAL RECORD OF THIS SHEET IS THE ELECTRONIC FILE DIGITALLY SIGNED AND SEALED UNDER RULE 61G15-23.004, F.A.C.