

## Local Road Access Modification



- All residences and businesses that currently have access to SW 10<sup>th</sup> Street will retain access to local SW 10th Street (during construction and also with all of the Build Alternatives).
- The exact configuration of driveways and access points will be determined during the Final Design.
- Local SW 10<sup>th</sup> Street will retain similar access to / from I-95, Sawgrass Expressway, and Florida's Turnpike as they have today.

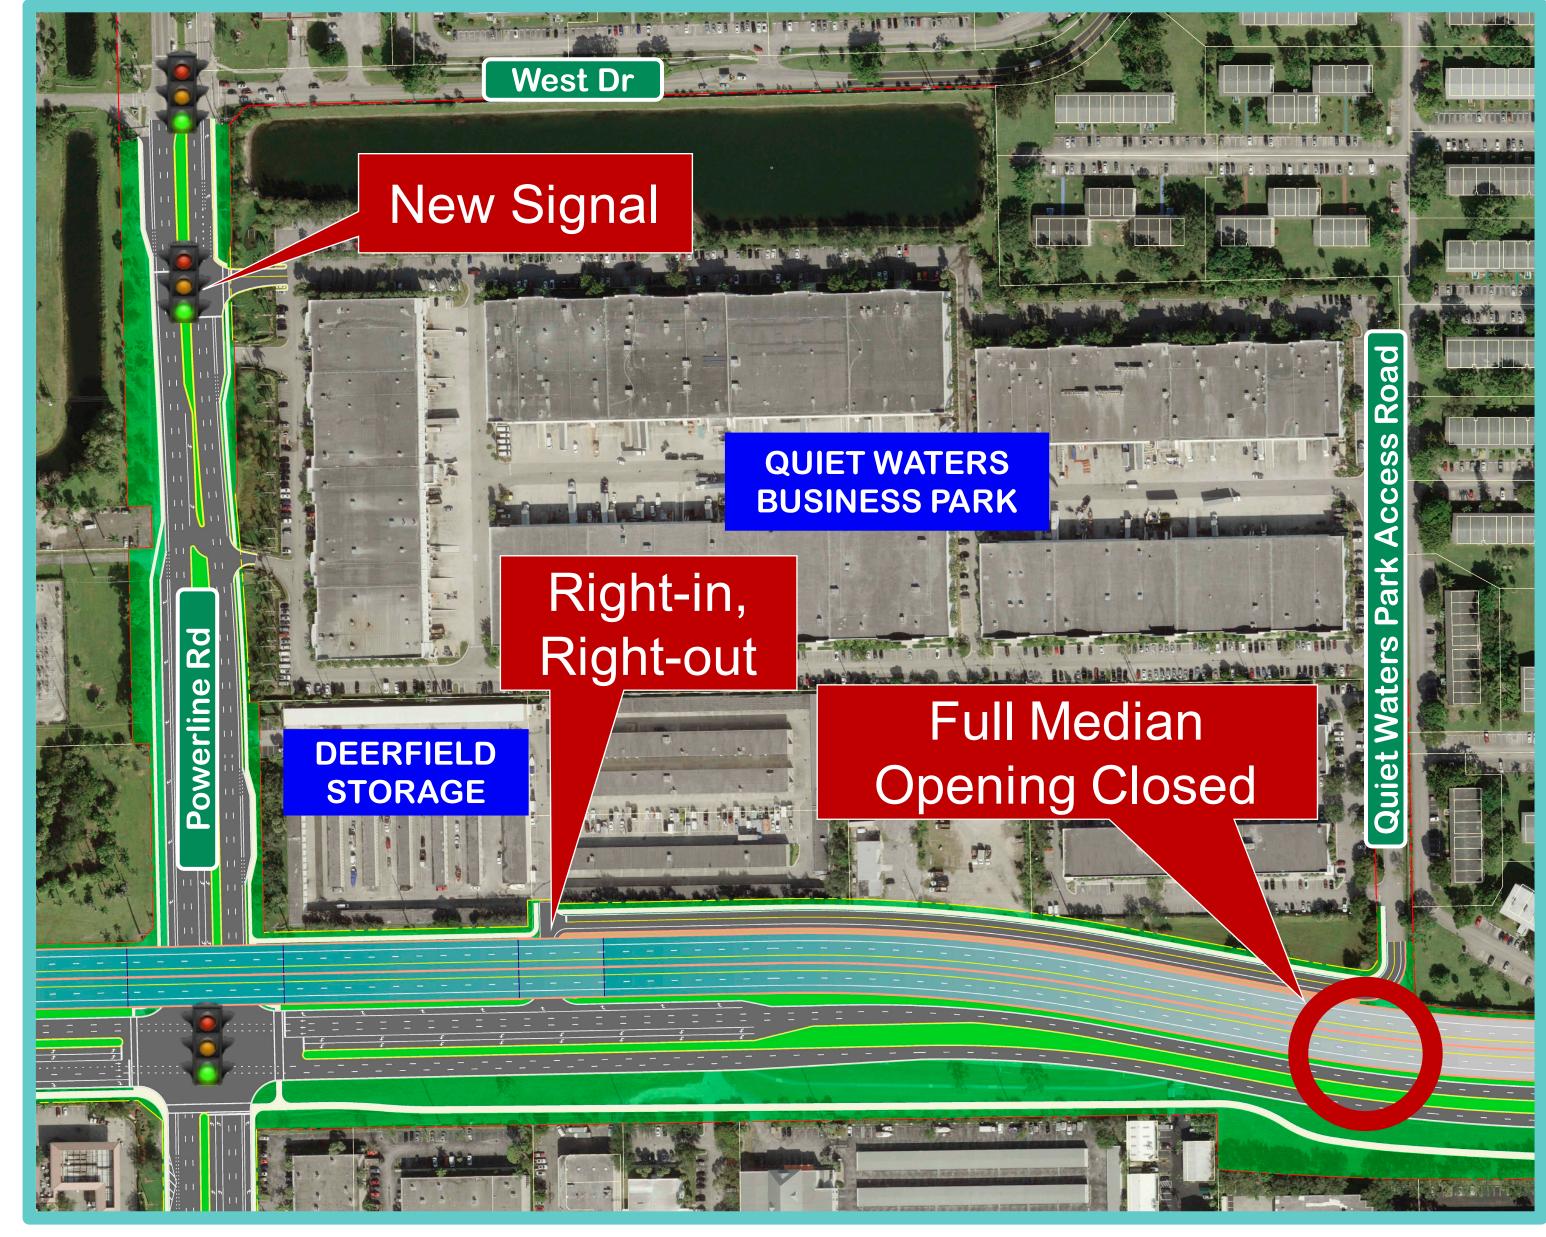

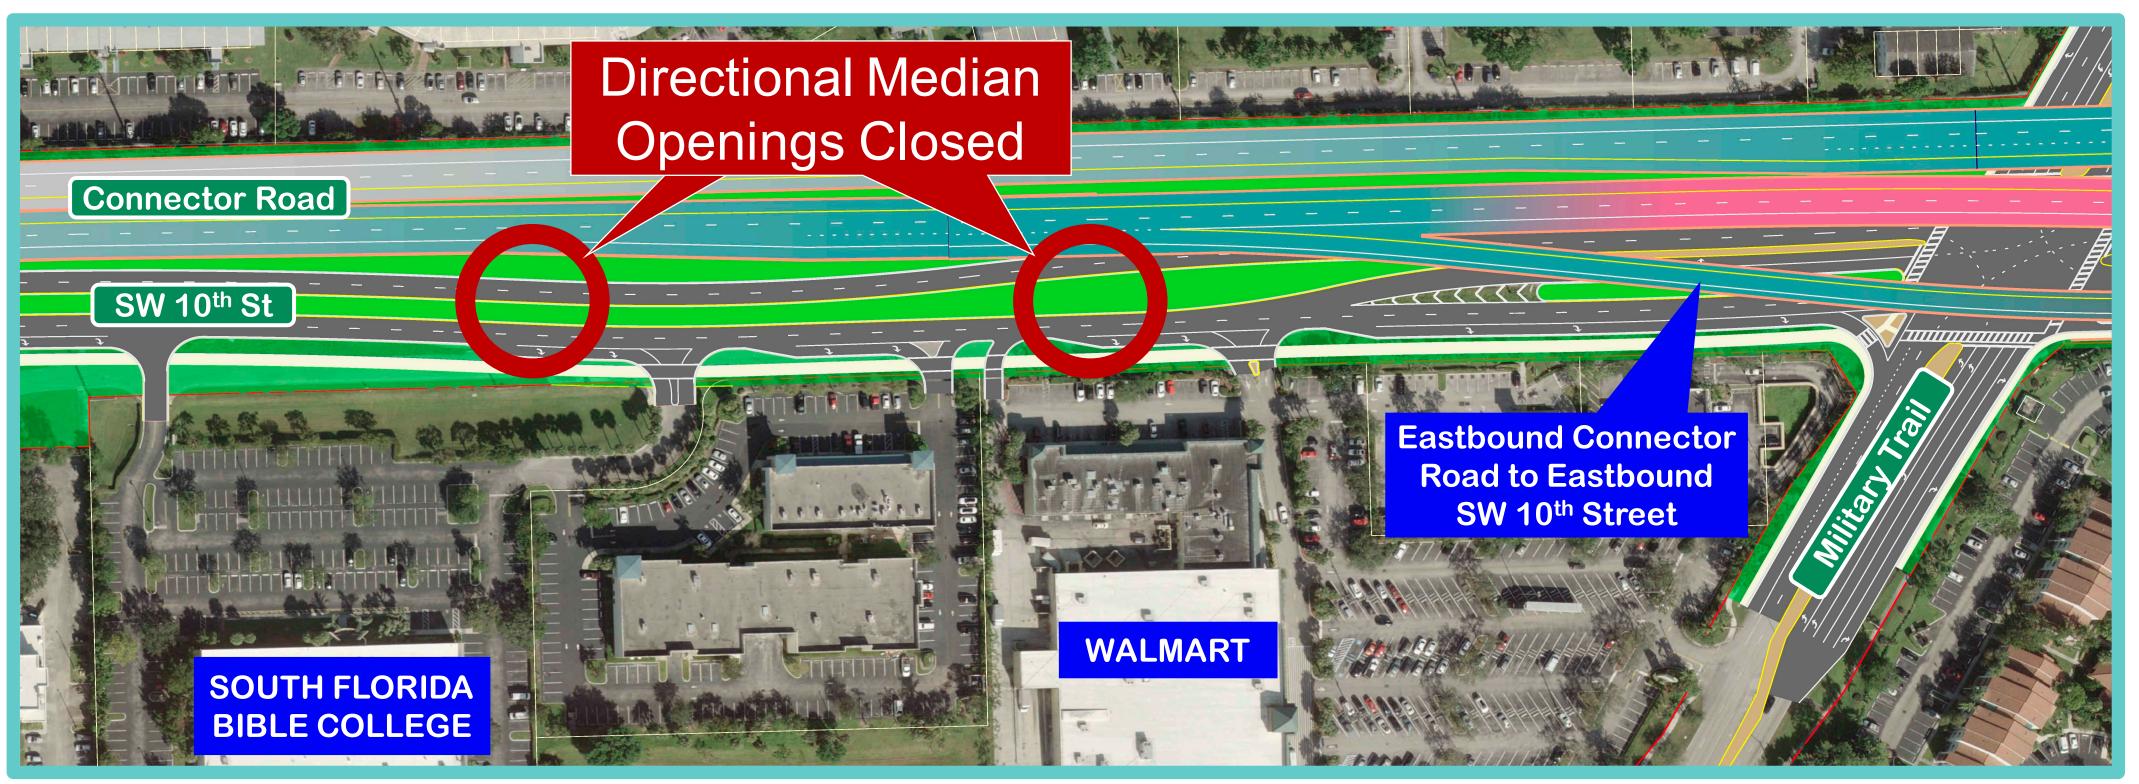

Proposed Median Opening Changes