



# EQUIPMENT SITE SCHEMATIC

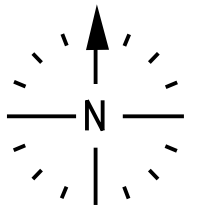

TO RTMC VIA I-75

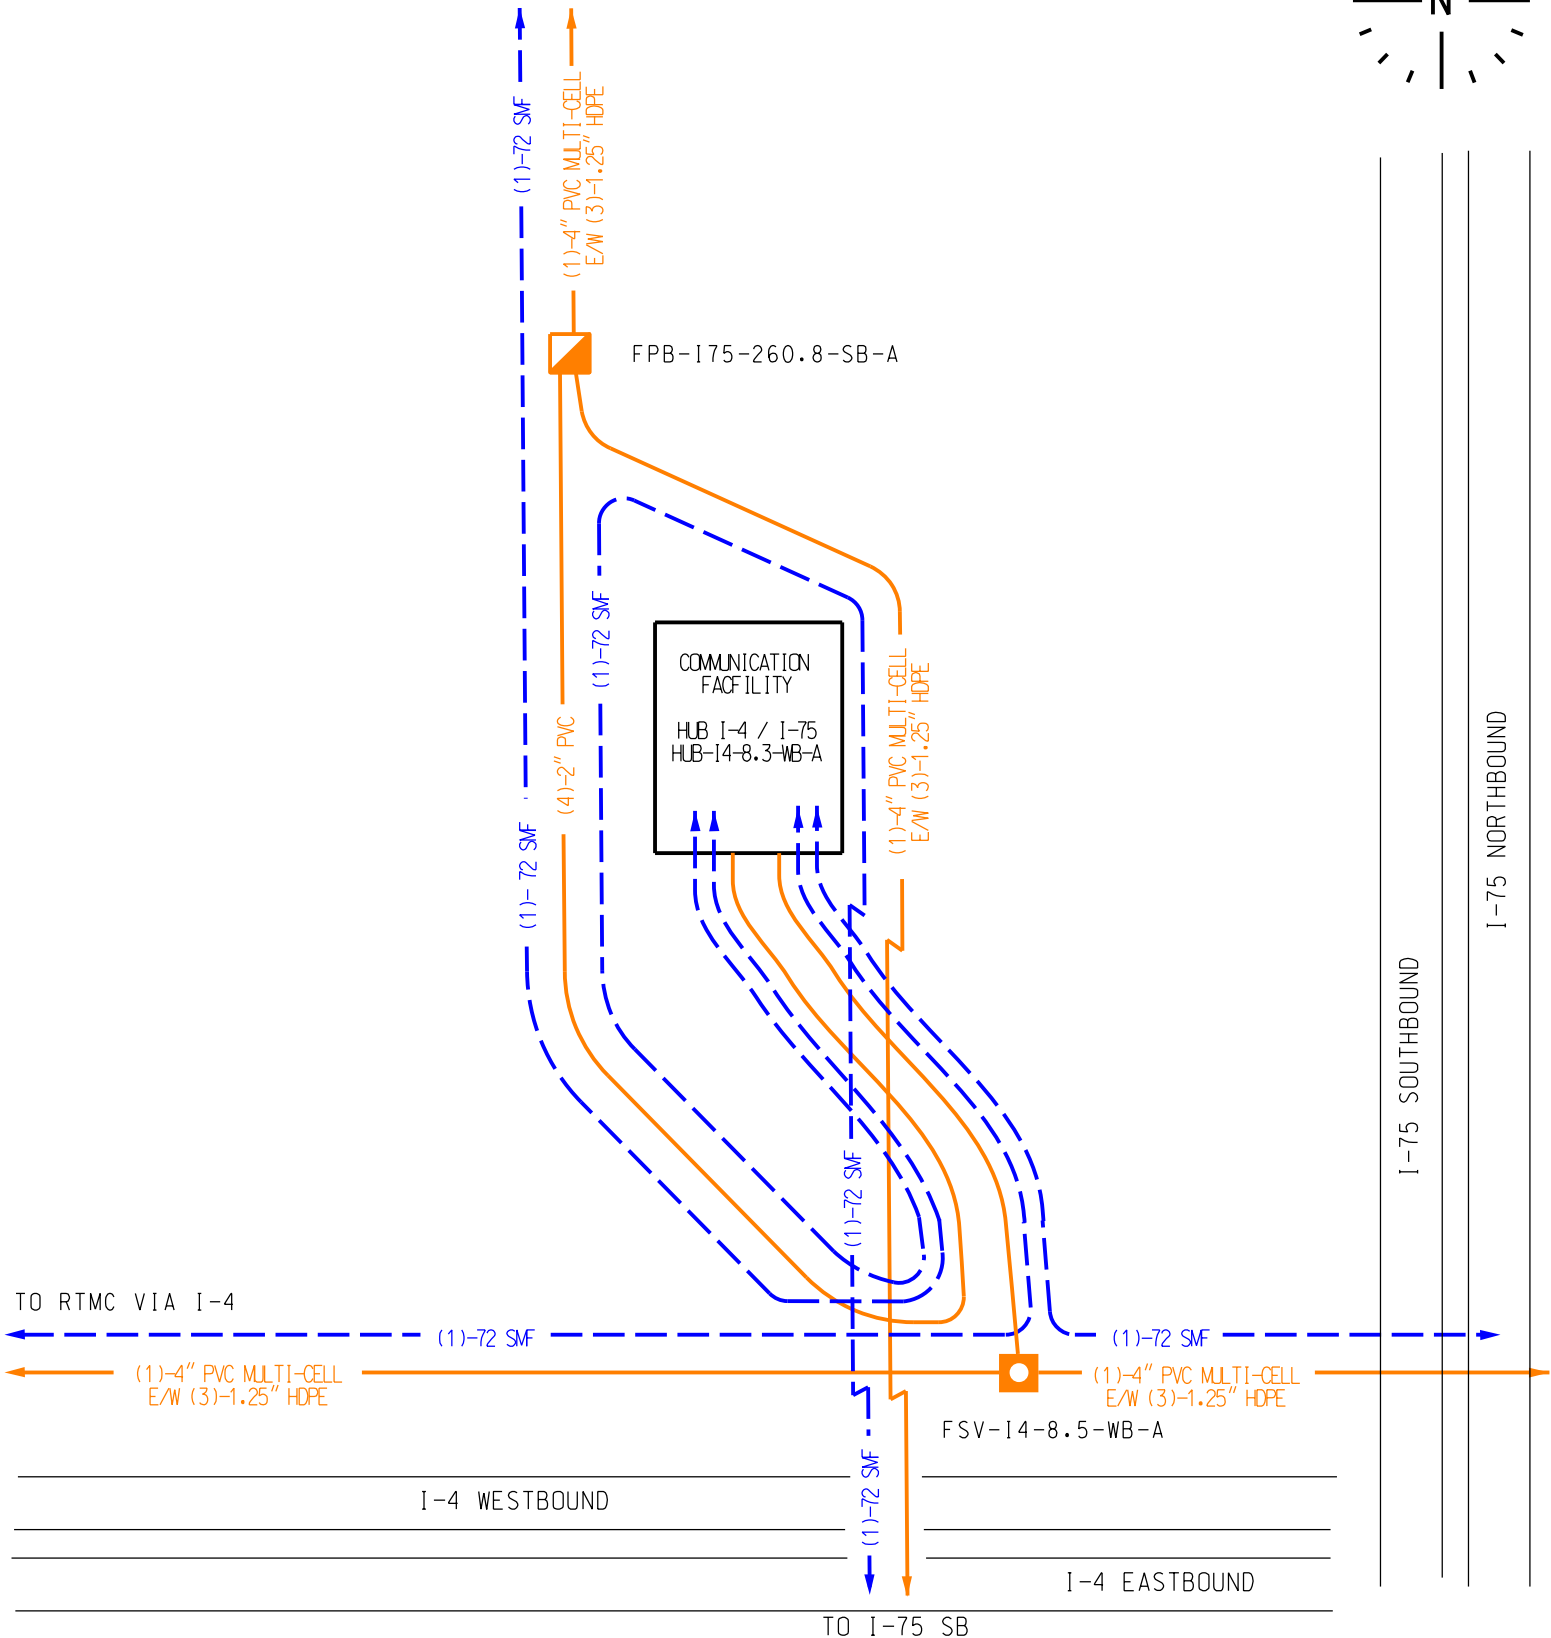


LEGEND	
	FIBER SPLICE VAULT
	FIBER PULLBOX
	ELECTRIC PULLBOX
	ELECTRIC SITE
	UTILITY DEMARC SITE
	CABINET - POLE MOUNT
	CABINET - PAD MOUNT
	POLE
	BUTTERFLY
	CANTILEVER
	OVERHEAD SPAN
	UTILITY POLE

EQUIPMENT SITE SCHEMATIC	
ROADWAY NAME:	<u>I-75</u>
PREPARED BY:	<u>JANE DOE</u>
DATE:	<u>01/01/2021</u>


ITSFM DATA COLLECTION FORM
ITSFM057 REV. 11/21
SHEET <u>1</u> OF <u>3</u>

# EQUIPMENT SITE SCHEMATIC

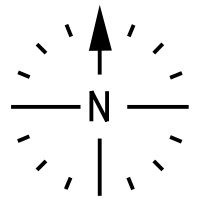

## CABLE REFERENCE

- (A) (3) COMPOSITE CABLES
- COMPOSITE CABLE #1  
 12 - COPPER  
 0 - FIBER  
 1 - COAXIAL
- COMPOSITE CABLE #2  
 12 - COPPER  
 0 - FIBER  
 0 - COAXIAL
- COMPOSITE CABLE #3  
 12 - COPPER  
 0 - FIBER  
 0 - COAXIAL

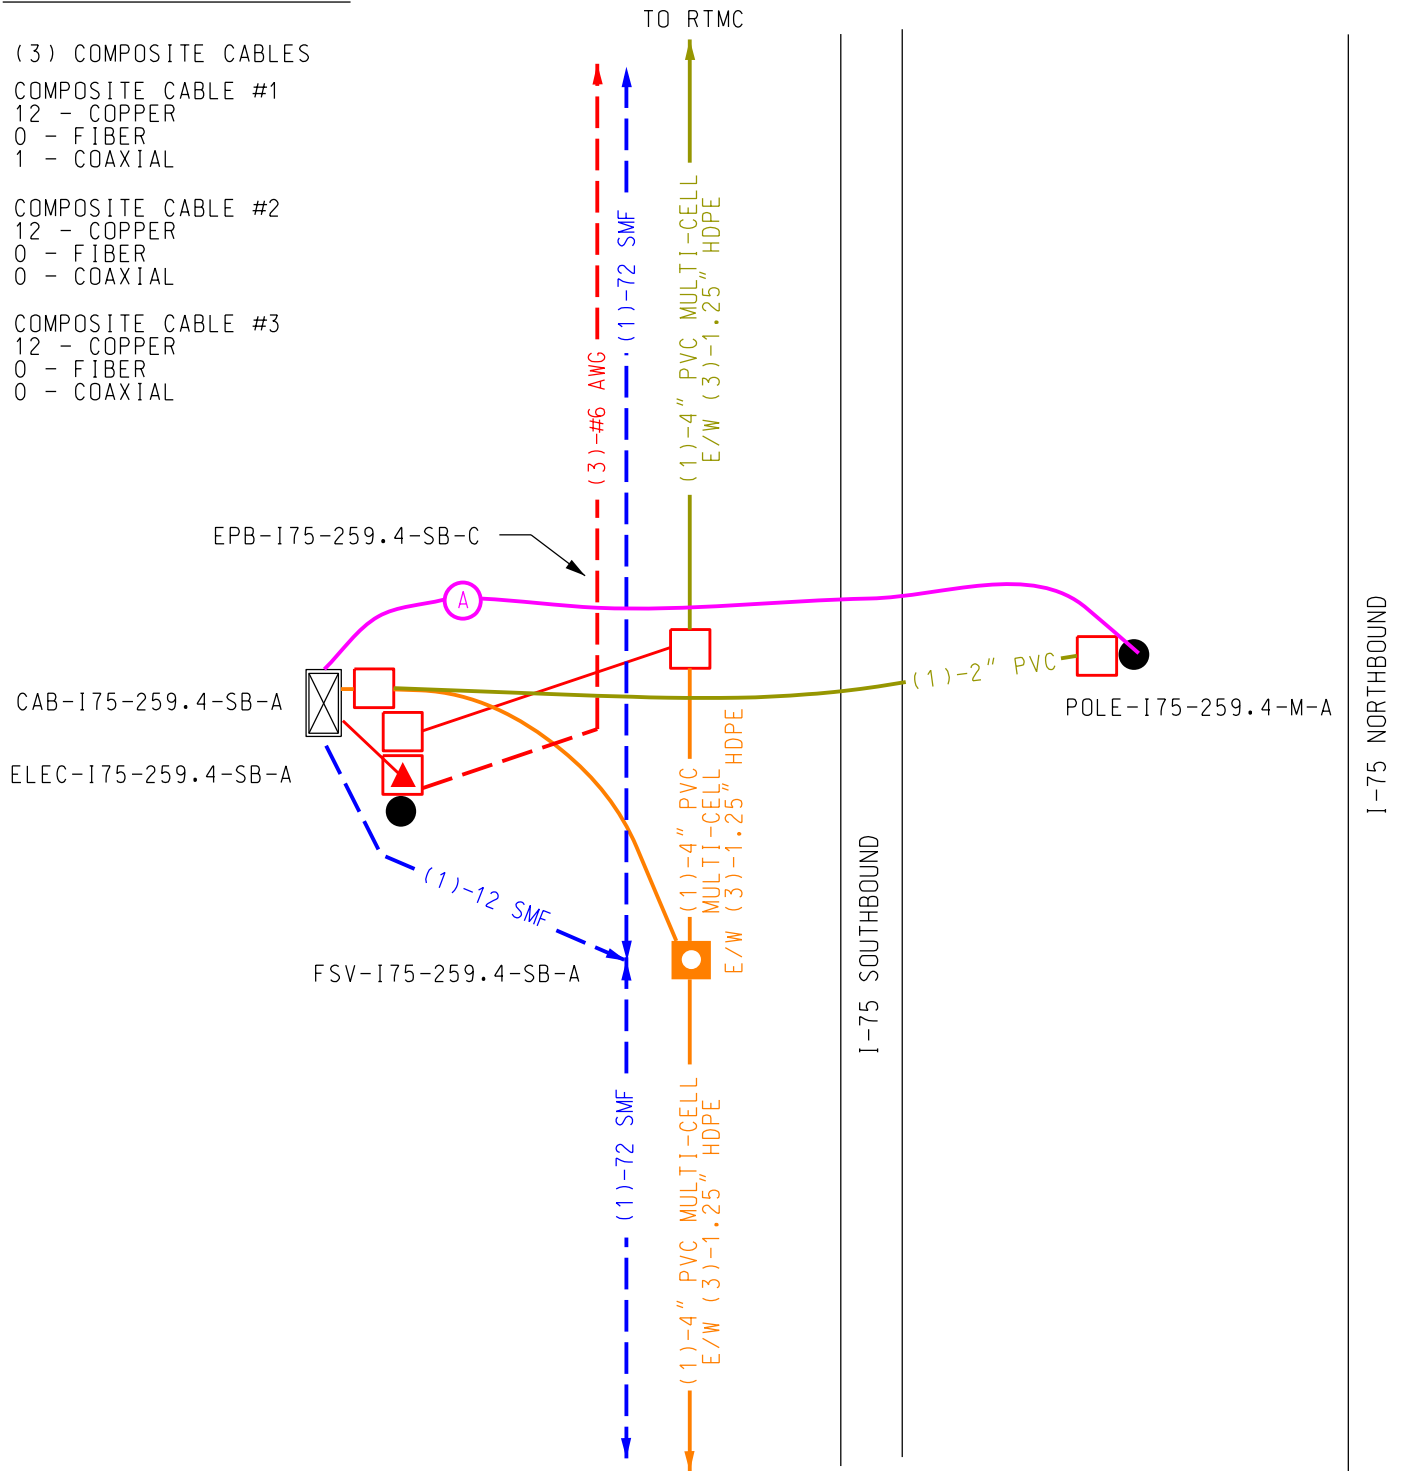

## LEGEND

- FIBER SPLICE VAULT
- FIBER PULLBOX
- ELECTRIC PULLBOX
- ELECTRIC SITE
- UTILITY DEMARC SITE
- CABINET - POLE MOUNT
- CABINET - PAD MOUNT
- POLE
- BUTTERFLY
- CANTILEVER
- OVERHEAD SPAN
- UTILITY POLE

## EQUIPMENT SITE SCHEMATIC

ROADWAY NAME: I-75

PREPARED BY: JANE DOE



DATE: 01/01/2021

ITSFM  
DATA  
COLLECTION  
FORM







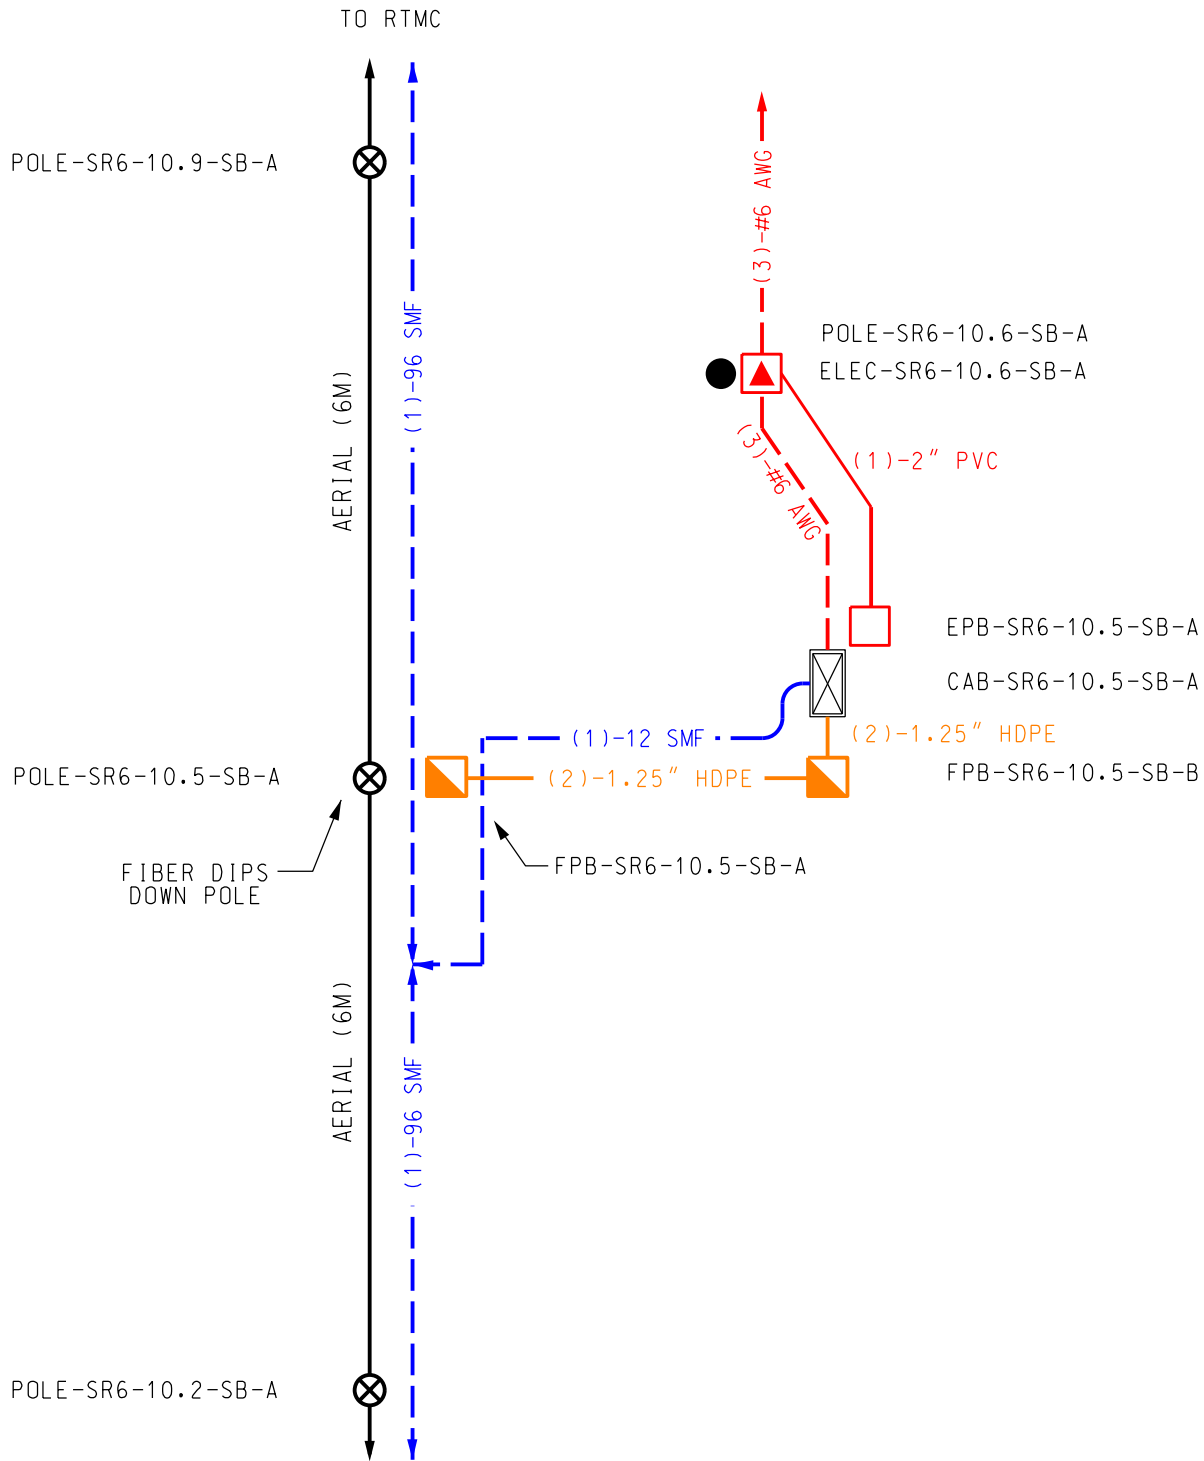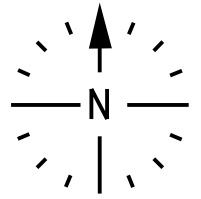





ITSFM057  
REV. 11/21

SHEET 2 OF 3

# EQUIPMENT SITE SCHEMATIC



## LEGEND

-  FIBER SPLICE VAULT
-  FIBER PULLBOX
-  ELECTRIC PULLBOX
-  ELECTRIC SITE
-  UTILITY DEMARC SITE
-  CABINET - POLE MOUNT
-  CABINET - PAD MOUNT
-  POLE
-  BUTTERFLY
-  CANTILEVER
-  OVERHEAD SPAN
-  UTILITY POLE

## EQUIPMENT SITE SCHEMATIC

ROADWAY NAME: SR-6

PREPARED BY: JANE DOE


DATE: 01/01/2021

ITSFM  
DATA  
COLLECTION  
FORM







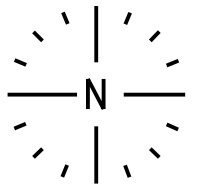



 

ITSFM057  
REV. 11/21

SHEET 3 OF 3

# EQUIPMENT SITE SCHEMATIC

 

## LEGEND

-  FIBER SPLICE VAULT
  -  FIBER PULLBOX
  -  ELECTRIC PULLBOX
  -  ELECTRIC SITE
  -  UTILITY DEMARC SITE
  -  CABINET - POLE MOUNT
  -  CABINET - PAD MOUNT
-  POLE
  -  BUTTERFLY
  -  CANTILEVER
  -  OVERHEAD SPAN
  -  UTILITY POLE

## EQUIPMENT SITE SCHEMATIC

ROADWAY NAME: \_\_\_\_\_

PREPARED BY: \_\_\_\_\_


DATE: \_\_\_\_\_

ITSFM  
DATA  
COLLECTION  
FORM

ITSFM057  
REV. 11/21

SHEET \_\_\_\_ OF \_\_\_\_

# EQUIPMENT SITE SCHEMATIC

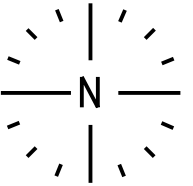

### LEGEND

- |                    |                      |               |
|--------------------|----------------------|---------------|
| FIBER SPLICE VAULT | UTILITY DEMARC SITE  | POLE          |
| FIBER PULLBOX      | CABINET - POLE MOUNT | BUTTERFLY     |
| ELECTRIC PULLBOX   | CABINET - PAD MOUNT  | CANTILEVER    |
| ELECTRIC SITE      | UTILITY POLE         | OVERHEAD SPAN |

### ABBREVIATIONS

- |                     |                             |
|---------------------|-----------------------------|
| 96 SMF / (3)-#6 AWG | CABLE SIZE/TYPE             |
| 908' (4) 1.25" HDPE | CONDUIT LENGTH, COUNT, TYPE |
| FSV-195-258.9-NB-A  | SITE ID NAME                |
| SEO =               | CABLE SEQUENTIAL READING    |
| 6M/6.6M/10M         | AERIAL STRAND WIRE SIZES    |

### EQUIPMENT SITE SCHEMATIC

ROADWAY NAME: \_\_\_\_\_

PREPARED BY: \_\_\_\_\_

DATE: \_\_\_\_\_

ITSFM  
DATA  
COLLECTION  
FORM

ITSFM057  
REV. 11/21

SHEET \_\_\_\_ OF \_\_\_\_