



EQUIPMENT SITE SCHEMATIC

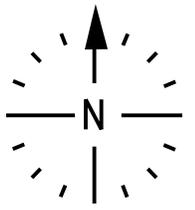

TO RTMC VIA I-75

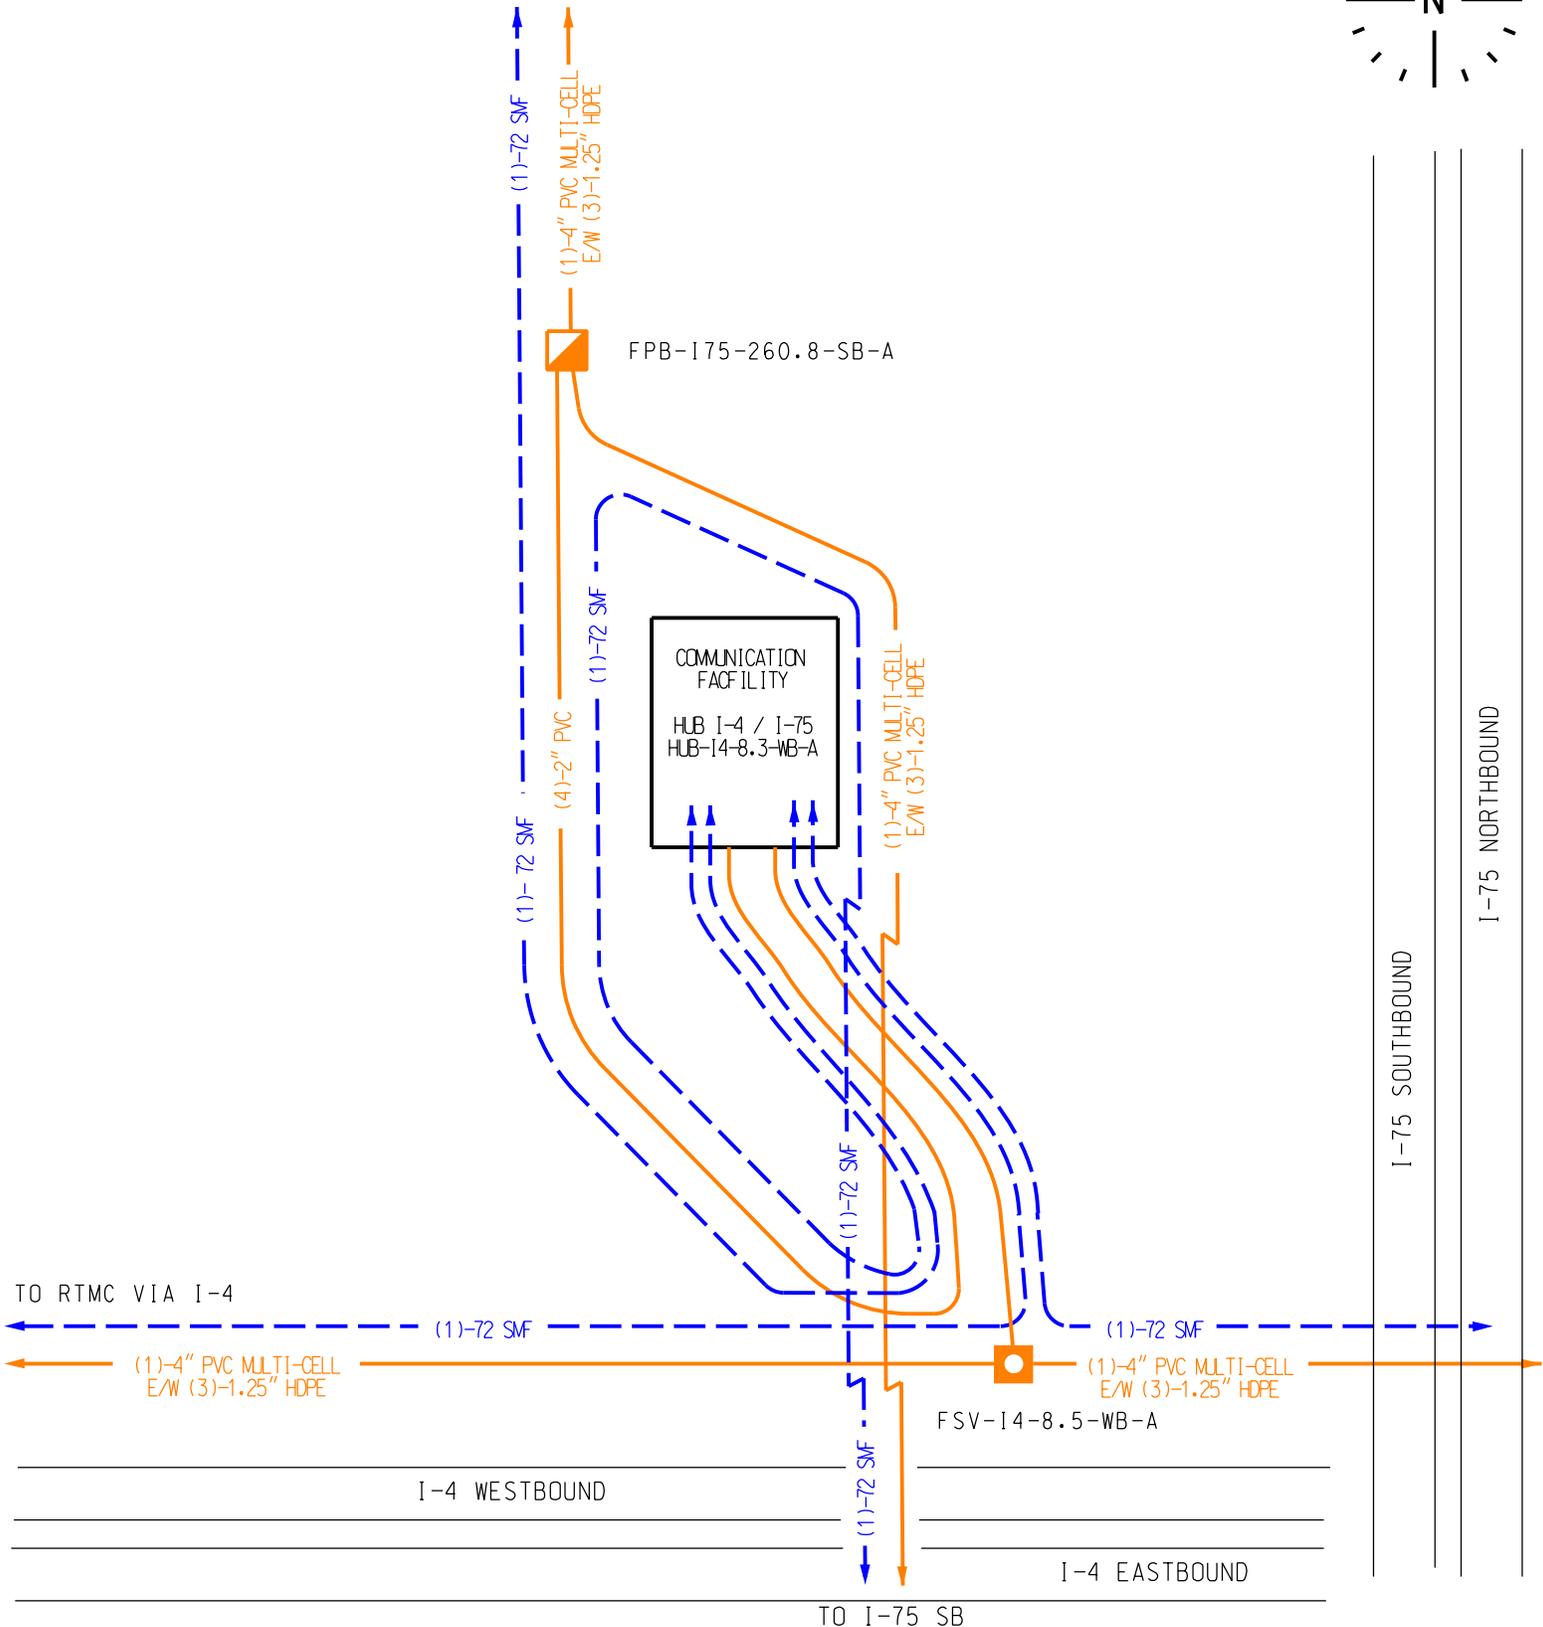

LEGEND

- | | | | |
|--|----------------------|--|---------------|
| | FIBER SPLICE VAULT | | POLE |
| | FIBER PULLBOX | | BUTTERFLY |
| | ELECTRIC PULLBOX | | CANTILEVER |
| | ELECTRIC SITE | | OVERHEAD SPAN |
| | UTILITY DEMARC SITE | | UTILITY POLE |
| | CABINET - POLE MOUNT | | |
| | CABINET - PAD MOUNT | | |

EQUIPMENT SITE SCHEMATIC


ROADWAY NAME: I-75

PREPARED BY: JANE DOE

DATE: 01/01/2021


ITSFM
DATA
COLLECTION
FORM
ITSFM057
REV. 11/21

EQUIPMENT SITE SCHEMATIC

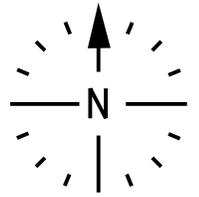

CABLE REFERENCE

- (A) (3) COMPOSITE CABLES
- COMPOSITE CABLE #1
 12 - COPPER
 0 - FIBER
 1 - COAXIAL
- COMPOSITE CABLE #2
 12 - COPPER
 0 - FIBER
 0 - COAXIAL
- COMPOSITE CABLE #3
 12 - COPPER
 0 - FIBER
 0 - COAXIAL

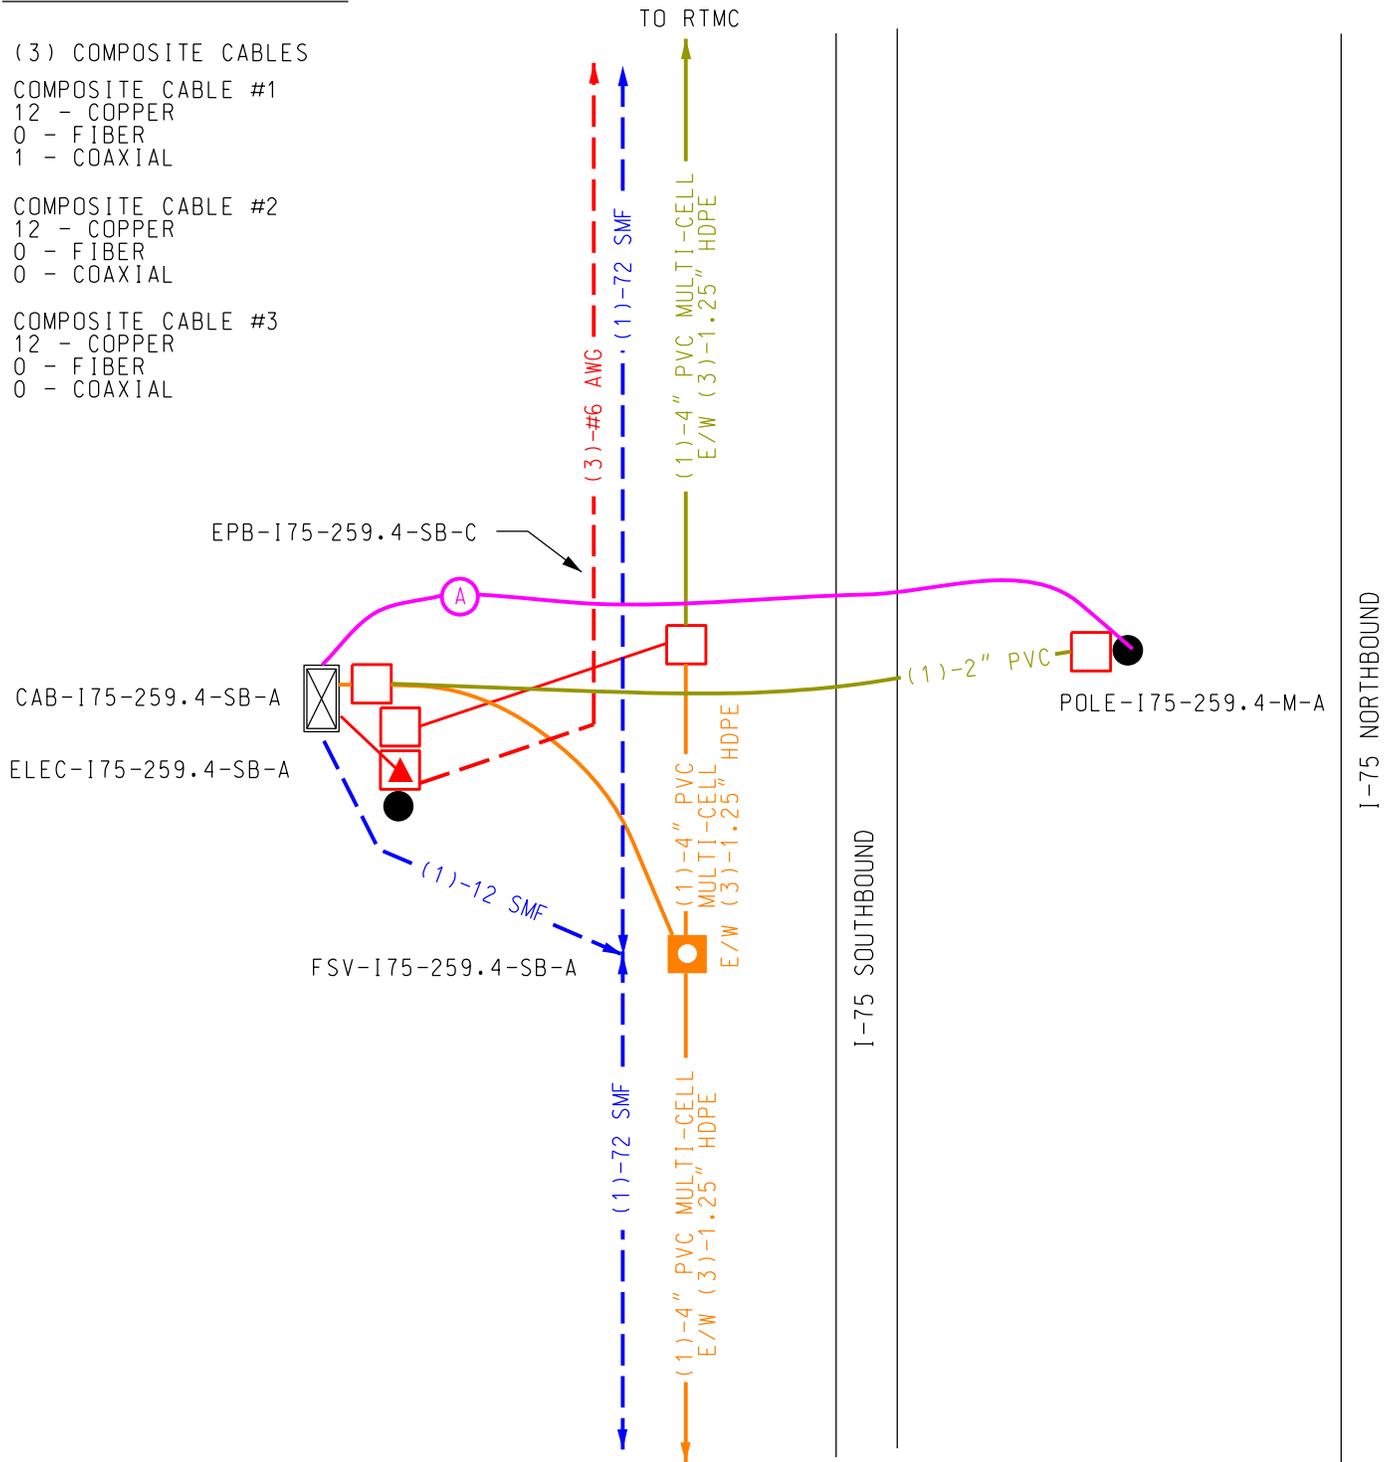

LEGEND

-  FIBER SPLICE VAULT
-  FIBER PULLBOX
-  ELECTRIC PULLBOX
-  ELECTRIC SITE
-  UTILITY DEMARC SITE
-  CABINET - POLE MOUNT
-  CABINET - PAD MOUNT
-  POLE
-  BUTTERFLY
-  CANTILEVER
-  OVERHEAD SPAN
-  UTILITY POLE

EQUIPMENT SITE SCHEMATIC

ROADWAY NAME: I-75

PREPARED BY: JANE DOE



DATE: 01/01/2021

ITSFM
DATA
COLLECTION
FORM

ITSFM057
REV. 11/21

SHEET 2 OF 3

EQUIPMENT SITE SCHEMATIC

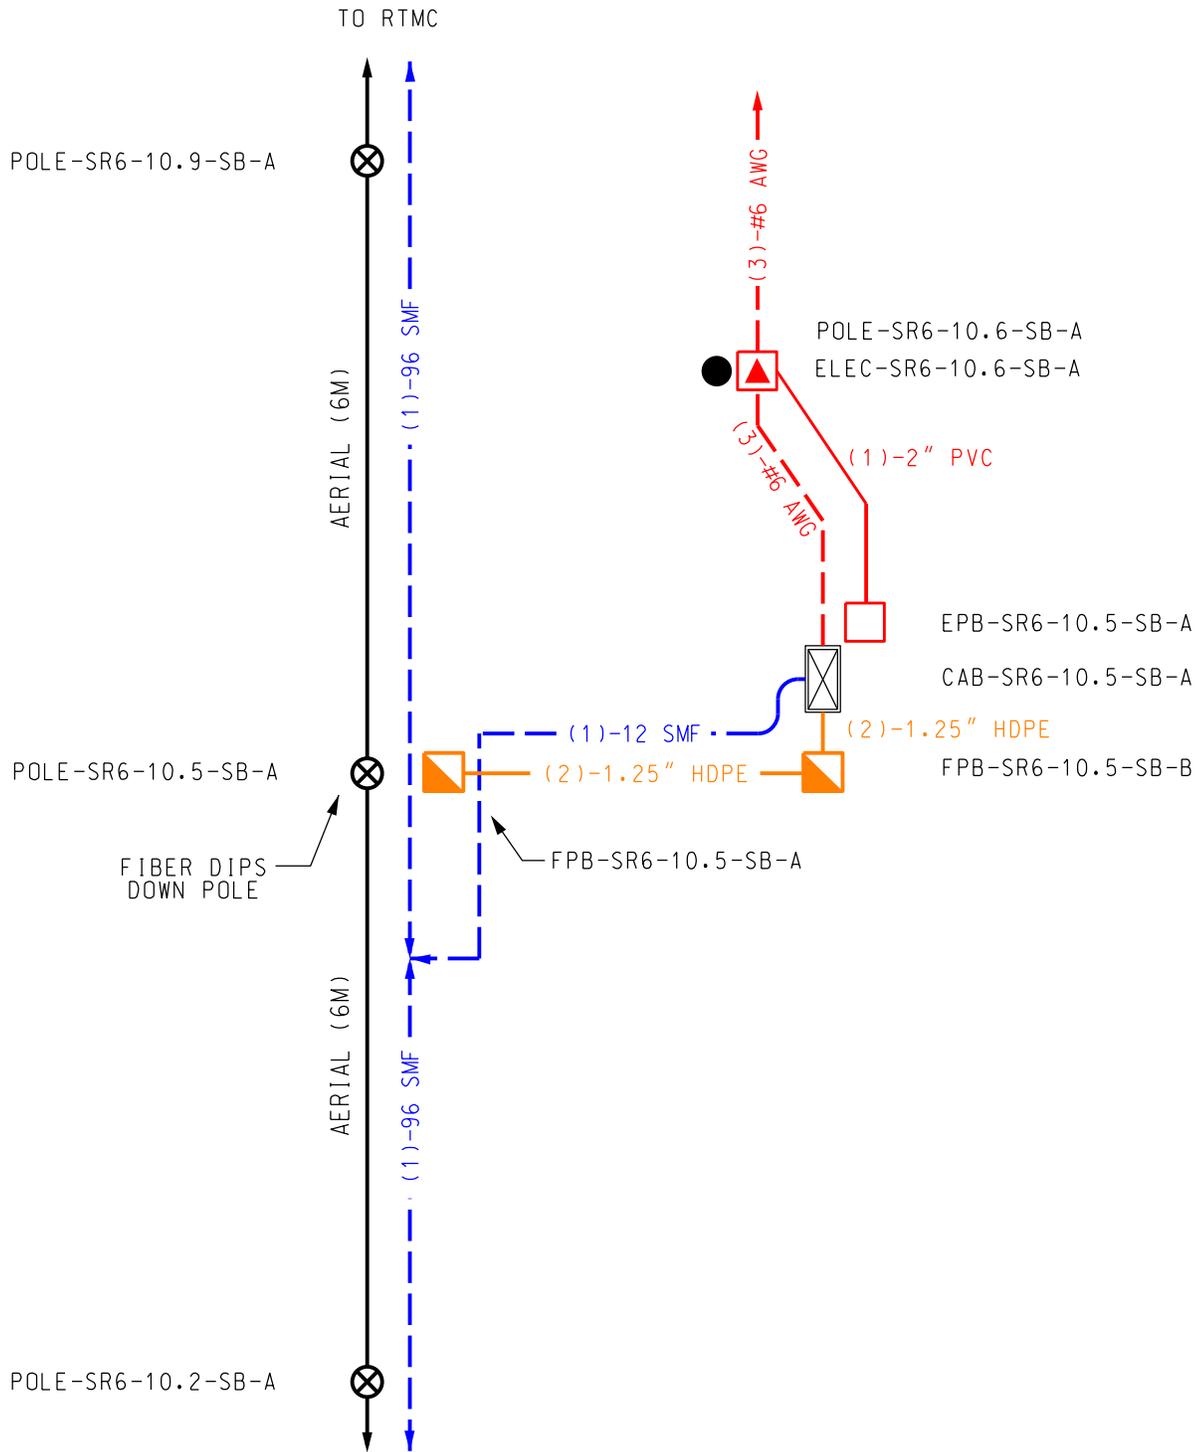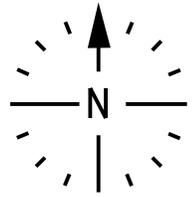

SR-6 SOUTHBOUND

SR-6 NORTHBOUND

LEGEND

-  FIBER SPLICE VAULT
-  FIBER PULLBOX
-  ELECTRIC PULLBOX
-  ELECTRIC SITE
-  UTILITY DEMARC SITE
-  CABINET - POLE MOUNT
-  CABINET - PAD MOUNT
-  POLE
-  BUTTERFLY
-  CANTILEVER
-  OVERHEAD SPAN
-  UTILITY POLE

EQUIPMENT SITE SCHEMATIC

ROADWAY NAME: SR-6

PREPARED BY: JANE DOE


DATE: 01/01/2021

ITSFM
DATA
COLLECTION
FORM

ITSFM057
REV. 11/21

SHEET 3 OF 3

EQUIPMENT SITE SCHEMATIC

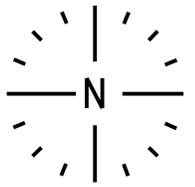

LEGEND

-  FIBER SPLICE VAULT
-  FIBER PULLBOX
-  ELECTRIC PULLBOX
-  ELECTRIC SITE
-  UTILITY DEMARC SITE
-  CABINET - POLE MOUNT
-  CABINET - PAD MOUNT
-  POLE
-  BUTTERFLY
-  CANTILEVER
-  OVERHEAD SPAN
-  UTILITY POLE

EQUIPMENT SITE SCHEMATIC

ROADWAY NAME: _____

PREPARED BY: _____


DATE: _____

ITSFM
DATA
COLLECTION
FORM

ITSFM057
REV. 11/21

SHEET ____ OF ____

EQUIPMENT SITE SCHEMATIC

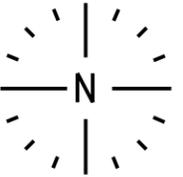

LEGEND

- | | | |
|--------------------|----------------------|---------------|
| FIBER SPLICE VAULT | UTILITY DEMARC SITE | POLE |
| FIBER PULLBOX | CABINET - POLE MOUNT | BUTTERFLY |
| ELECTRIC PULLBOX | CABINET - PAD MOUNT | CANTILEVER |
| ELECTRIC SITE | UTILITY POLE | OVERHEAD SPAN |

ABBREVIATIONS

- | | |
|---------------------|-----------------------------|
| 96 SMF / (3)-#6 AWG | CABLE SIZE/TYPE |
| 908' (4) 1.25" HDPE | CONDUIT LENGTH, COUNT, TYPE |
| FSV-195-258.9-NB-A | SITE ID NAME |
| SEO = | CABLE SEQUENTIAL READING |
| 6M/6.6M/10M | AERIAL STRAND WIRE SIZES |

EQUIPMENT SITE SCHEMATIC

ROADWAY NAME: _____

PREPARED BY: _____

DATE: _____

ITSFM
DATA
COLLECTION
FORM

ITSFM057
REV. 11/21

SHEET ____ OF ____